

CONTEXT PLAN
Scale: 1:1000

	Side Yard [East]	0.23 m	0.00 m	
	Residential Use Details			
	Total Number of Units	1	5	
	Unit Types	Single Family	1 Rental   4 Strata refer to unit summary	
VIC ADDRESS: 1125 FORT STREET, VICTORIA B.C.	Ground-Orientated Units	2	2	
GAL: WESTERLY 20 FEET OF LOT 1111  AND THE EASTERLY 20 FEET OF LOT 1112.	Minimum Floor Area	~~~~~~~~~~~~~~~~~~~~~~~~~~~~~~~~~~~~~~	106 m <sup>2</sup>	

ZONING INFORMATION				
LOT INFORMATION	EXISTING	PROPOSED		
Zone	R3-1	Site Specific		
Site Area	420.6 m <sup>2</sup>	unchanged		
Total Floor Area	371 m <sup>2</sup>	808 m <sup>2</sup>		
FSR	0.88 : 1	1.92 : 1		
Site Coverage	35%	81%		
Open Site Space	59%	16%		
Height of Existing Dwelling	existing	unchanged		
Height of Addition	<del></del>	12.43 m		
Number of Storeys [Existing Dwelling]	3 storeys	unchanged		
Number of Storeys [Addition]	<del></del>	4		
Parking Stalls	1	4 variance required		
Bicycle Parking	_	Existing Dwelling: No required bike parking per Schedule C 3.2.1(b)		
		Addition:  1.25 spaces per dwelling unit > 45 m² x 3 4 required 8 provided + 6 short term		
Setbacks	***************************************	~~~~~~~		
Front Yard [Fort Street]	5.33 m	2.60 m		

0.00 m

371 m<sup>2</sup>


0.00 m

659 m<sup>2</sup>

12.18 m 1.74 m

UNIT	AREA	TYPE
Existing		•
Unit B01	106 m <sup>2</sup>	2 bed 1 bath
Unit 100	220 m <sup>2</sup>	3 bed 3 bath
Addition		
Unit 101	115 m <sup>2</sup>	2 bed 2 bath
Unit 201	111 m <sup>2</sup>	2 bed 2 bath
Unit 301	107 m <sup>2</sup>	2 bed 2 bath


SUITE MIX		
TYPE	NUMBER	
2 bed 1 bath	1	
2 bed 2 bath	3	
3 bed 3 bath 1		
Total 5		

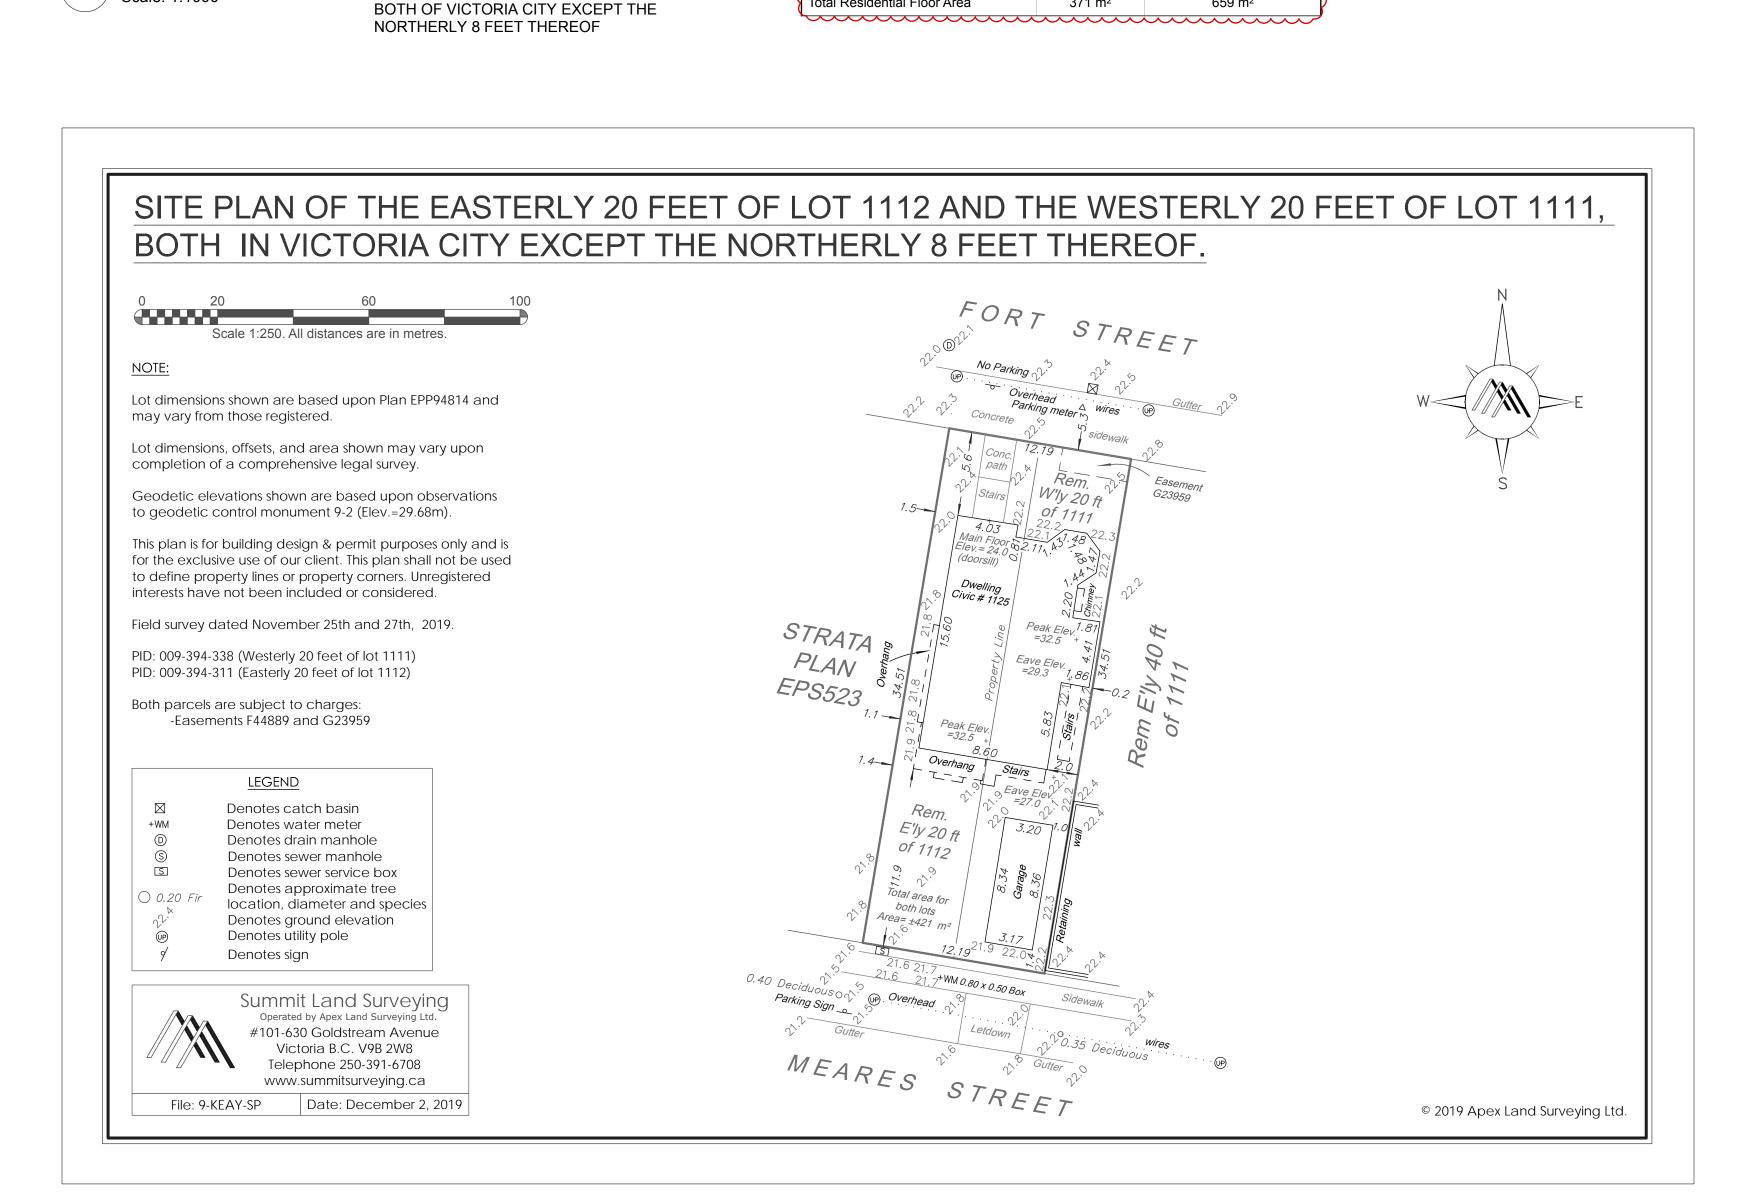



Rear Yard [Meares Street]


Total Residential Floor Area


Side Yard [West]

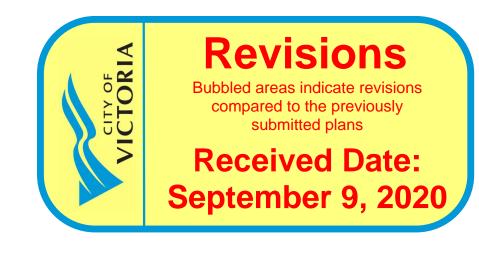


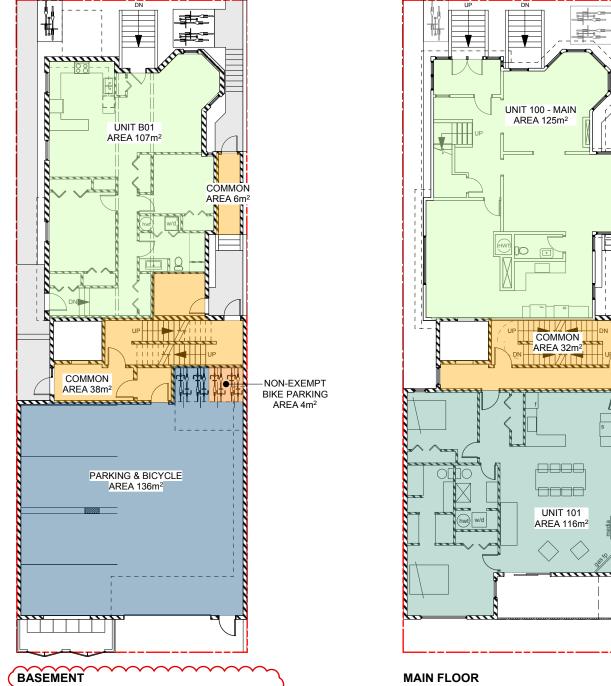


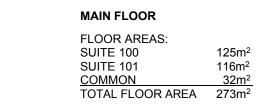

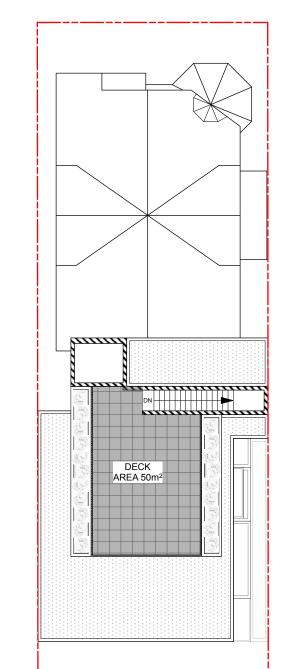

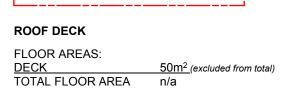

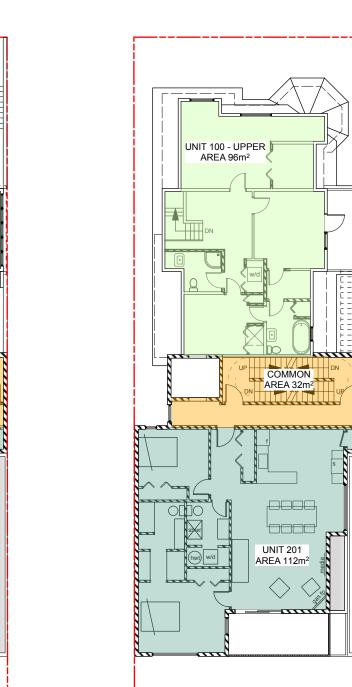

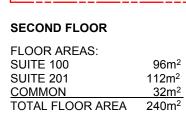

# keay architecture Itd


2nd Floor, 1124 Fort Street, Victoria, BC, V8V 3K8 o. 250-382-3823 e. info@keayarchitecture.com

COMMENTS			
No.	DESCRIPTION	DATE	BY
1	PRELIMINARY DESIGN	18/11/04	JK
2	PRELIMINARY DESIGN	19/01/03	JK
3	REZONING SUBMISSION	19/08/15	JA
4	REZONING SUBMISSION REVISIONS	20/03/02	NS
5	REZONING SUBMISSION REVISIONS	20/09/08	NS

GENERAL NOTES

Use of these drawings is limited to that identified in the issue/revision column. Do not construct from these drawings unless marked " issued for construction". All drawings, plans, models, designs, specifications and other documents prepared by Keay Architecture Ltd, (KA) and used in connection with this project remain the property of KA whether the "work" is executed or not. KA reserves the copyright in them and in the work executed from them.

These drawings or other may not be reproduced or used in part or in whole, without the expressed and written consent of KA.

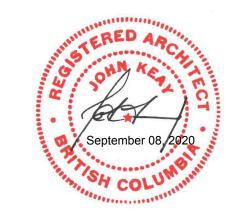

### **DRAWING LIST**

A-1.0 PROJECT INFORMATION A-1.1 SITE PLAN A-2.0 BASEMENT, FIRST, AND SECOND FLOOR PLANS A-2.1 THIRD FLOOR AND ROOF PLAN A-3.0 ELEVATIONS

A-5.0 COLOUR BOARD

A-4.0 SECTIONS AND STREETSCAPES

PROJECT


PROPOSED DEVELOPMENT 1125 FORT STREET **VICTORIA** 

SHEET TITLE

PROJECT INFORMATION

SCALE	JOB No.
AS SHOWN	1741
PLOT DATE Sep 08, 2020	
DRAWN JK/NS	A-1.0



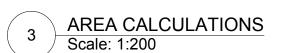

COMMON 32m<sup>2</sup>
TOTAL FLOOR AREA 140m<sup>2</sup>

THIRD FLOOR

FLOOR AREAS:

SUITE 301


FLOOR AREAS:

PARKING AND BIKE 136m<sup>2</sup> (excluded from total)

TOTAL FLOOR AREA 155m<sup>2</sup>

UNIT B01

COMMON

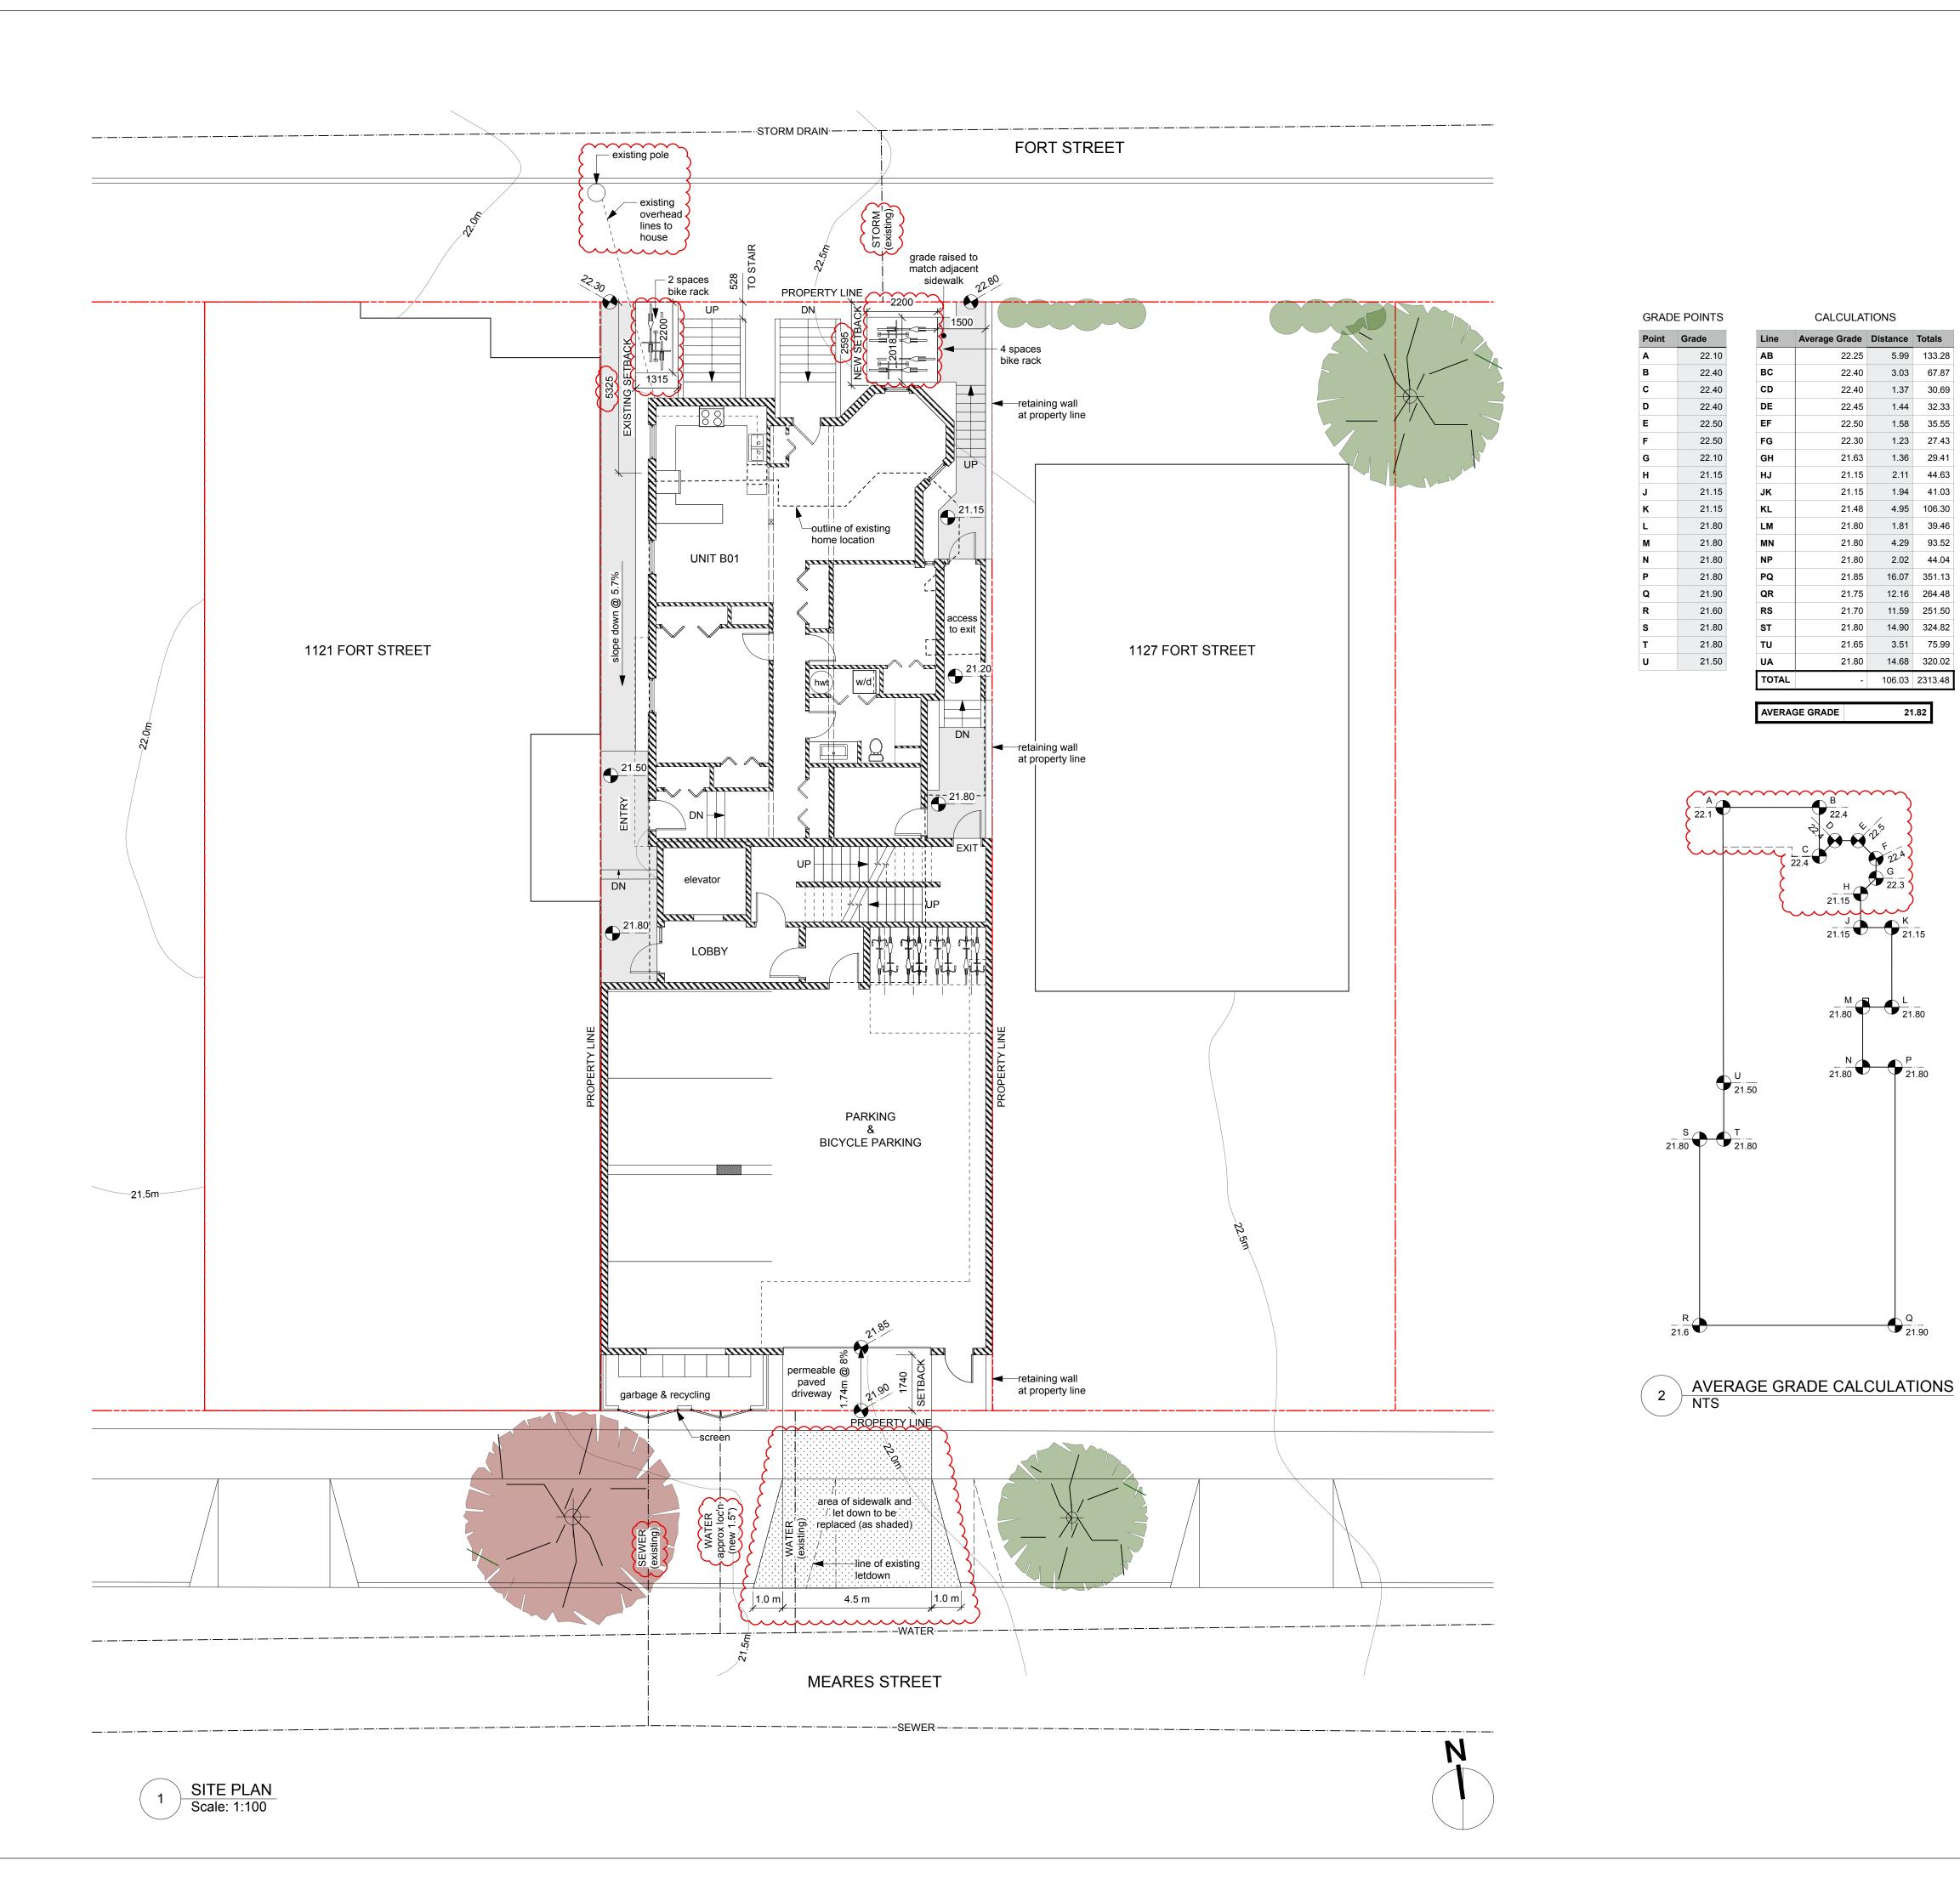

# architecture Itd.

2nd Floor, 1124 Fort Street, Victoria, BC, V8V 3K8 o. 250-382-3823 e. info@keayarchitecture.com

CALCULATIONS

22.40

22.40

22.45

22.50

22.30

22.10

22.40

22.40

22.40

22.50

22.50

22.10

21.15

21.15

21.15

21.80

21.80

21.80

21.80

21.90

21.60

21.80

21.80

21.50

CD

FG

GH

HJ

LM

UA

AVERAGE GRADE

Average Grade Distance Totals

22.25 5.99 133.28

21.63 1.36 29.41

21.15 2.11 44.63 21.15 1.94 41.03

21.48 4.95 106.30

21.80 1.81 39.46

21.80 4.29 93.52

21.80 2.02 44.04 21.85 16.07 351.13

21.75 12.16 264.48

21.70 11.59 251.50

21.80 14.90 324.82

21.65 3.51 75.99

21.80 14.68 320.02

106.03 2313.48

21.82

	COMMENTS		
No.	DESCRIPTION	DATE	В
1	PRELIMINARY DESIGN	18/11/04	JI
2	PRELIMINARY DESIGN	19/01/03	J
3	REZONING SUBMISSION	19/08/15	J.
4	REZONING SUBMISSION REVISIONS	20/03/02	N
5	REZONING SUBMISSION REVISIONS	20/09/08	N

GENERAL NOTES

Use of these drawings is limited to that identified in the issue/revision column.

Do not construct from these drawings unless marked " issued for construction". All drawings, plans, models, designs, specifications and other documents prepared by Keay Architecture Ltd, (KA) and used in connection

with this project remain the property of KA
whether the "work" is executed or not. KA reserves
the copyright in them and in the work executed
from them. These drawings or other may not be reproduced or used in part or in whole, without the expressed and written consent of KA.



PROJECT

PROPOSED DEVELOPMENT 1125 FORT STREET VICTORIA

SHEET TITLE

SITE PLAN

SCALE AS SHOWN	JOB No. 1741
PLOT DATE Sep 08, 2020	
DRAWN JK/NS	A-1.1



# keay architecture ltd.

2nd Floor, 1124 Fort Street, Victoria, BC, V8V 3K8 o. 250-382-3823 e. info@keayarchitecture.com

	COMMENTS		
No.	DESCRIPTION	DATE	В
1	PRELIMINARY DESIGN	18/11/04	JI
2	PRELIMINARY DESIGN	19/01/03	J
3	REZONING SUBMISSION	19/08/15	J
4	REZONING SUBMISSION REVISIONS	20/03/02	N
5	REZONING SUBMISSION REVISIONS	20/09/08	Ν

GENERAL NOTES

- Use of these drawings is limited to that identified in the issue/revision column.

  Do not construct from these drawings unless marked " issued for construction".

  All drawings, plans, models, designs, specifications and other documents prepared by
- All drawings, plans, models, designs, specifications and other documents prepared by Keay Architecture Ltd, (KA) and used in connection with this project remain the property of KA whether the "work" is executed or not. KA reserves the copyright in them and in the work executed from them.
- These drawings or other may not be reproduced or used in part or in whole, without the expressed and written consent of KA.



PROJECT

PROPOSED DEVELOPMENT


1125 FORT STREET

VICTORIA

SHEET TITLE

BASEMENT FIRST AND SECOND FLOOR PLANS

SCALE	JOB No.
AS SHOWN	1741
PLOT DATE Sep 08, 2020	
DRAWN JK/NS	A-2.0

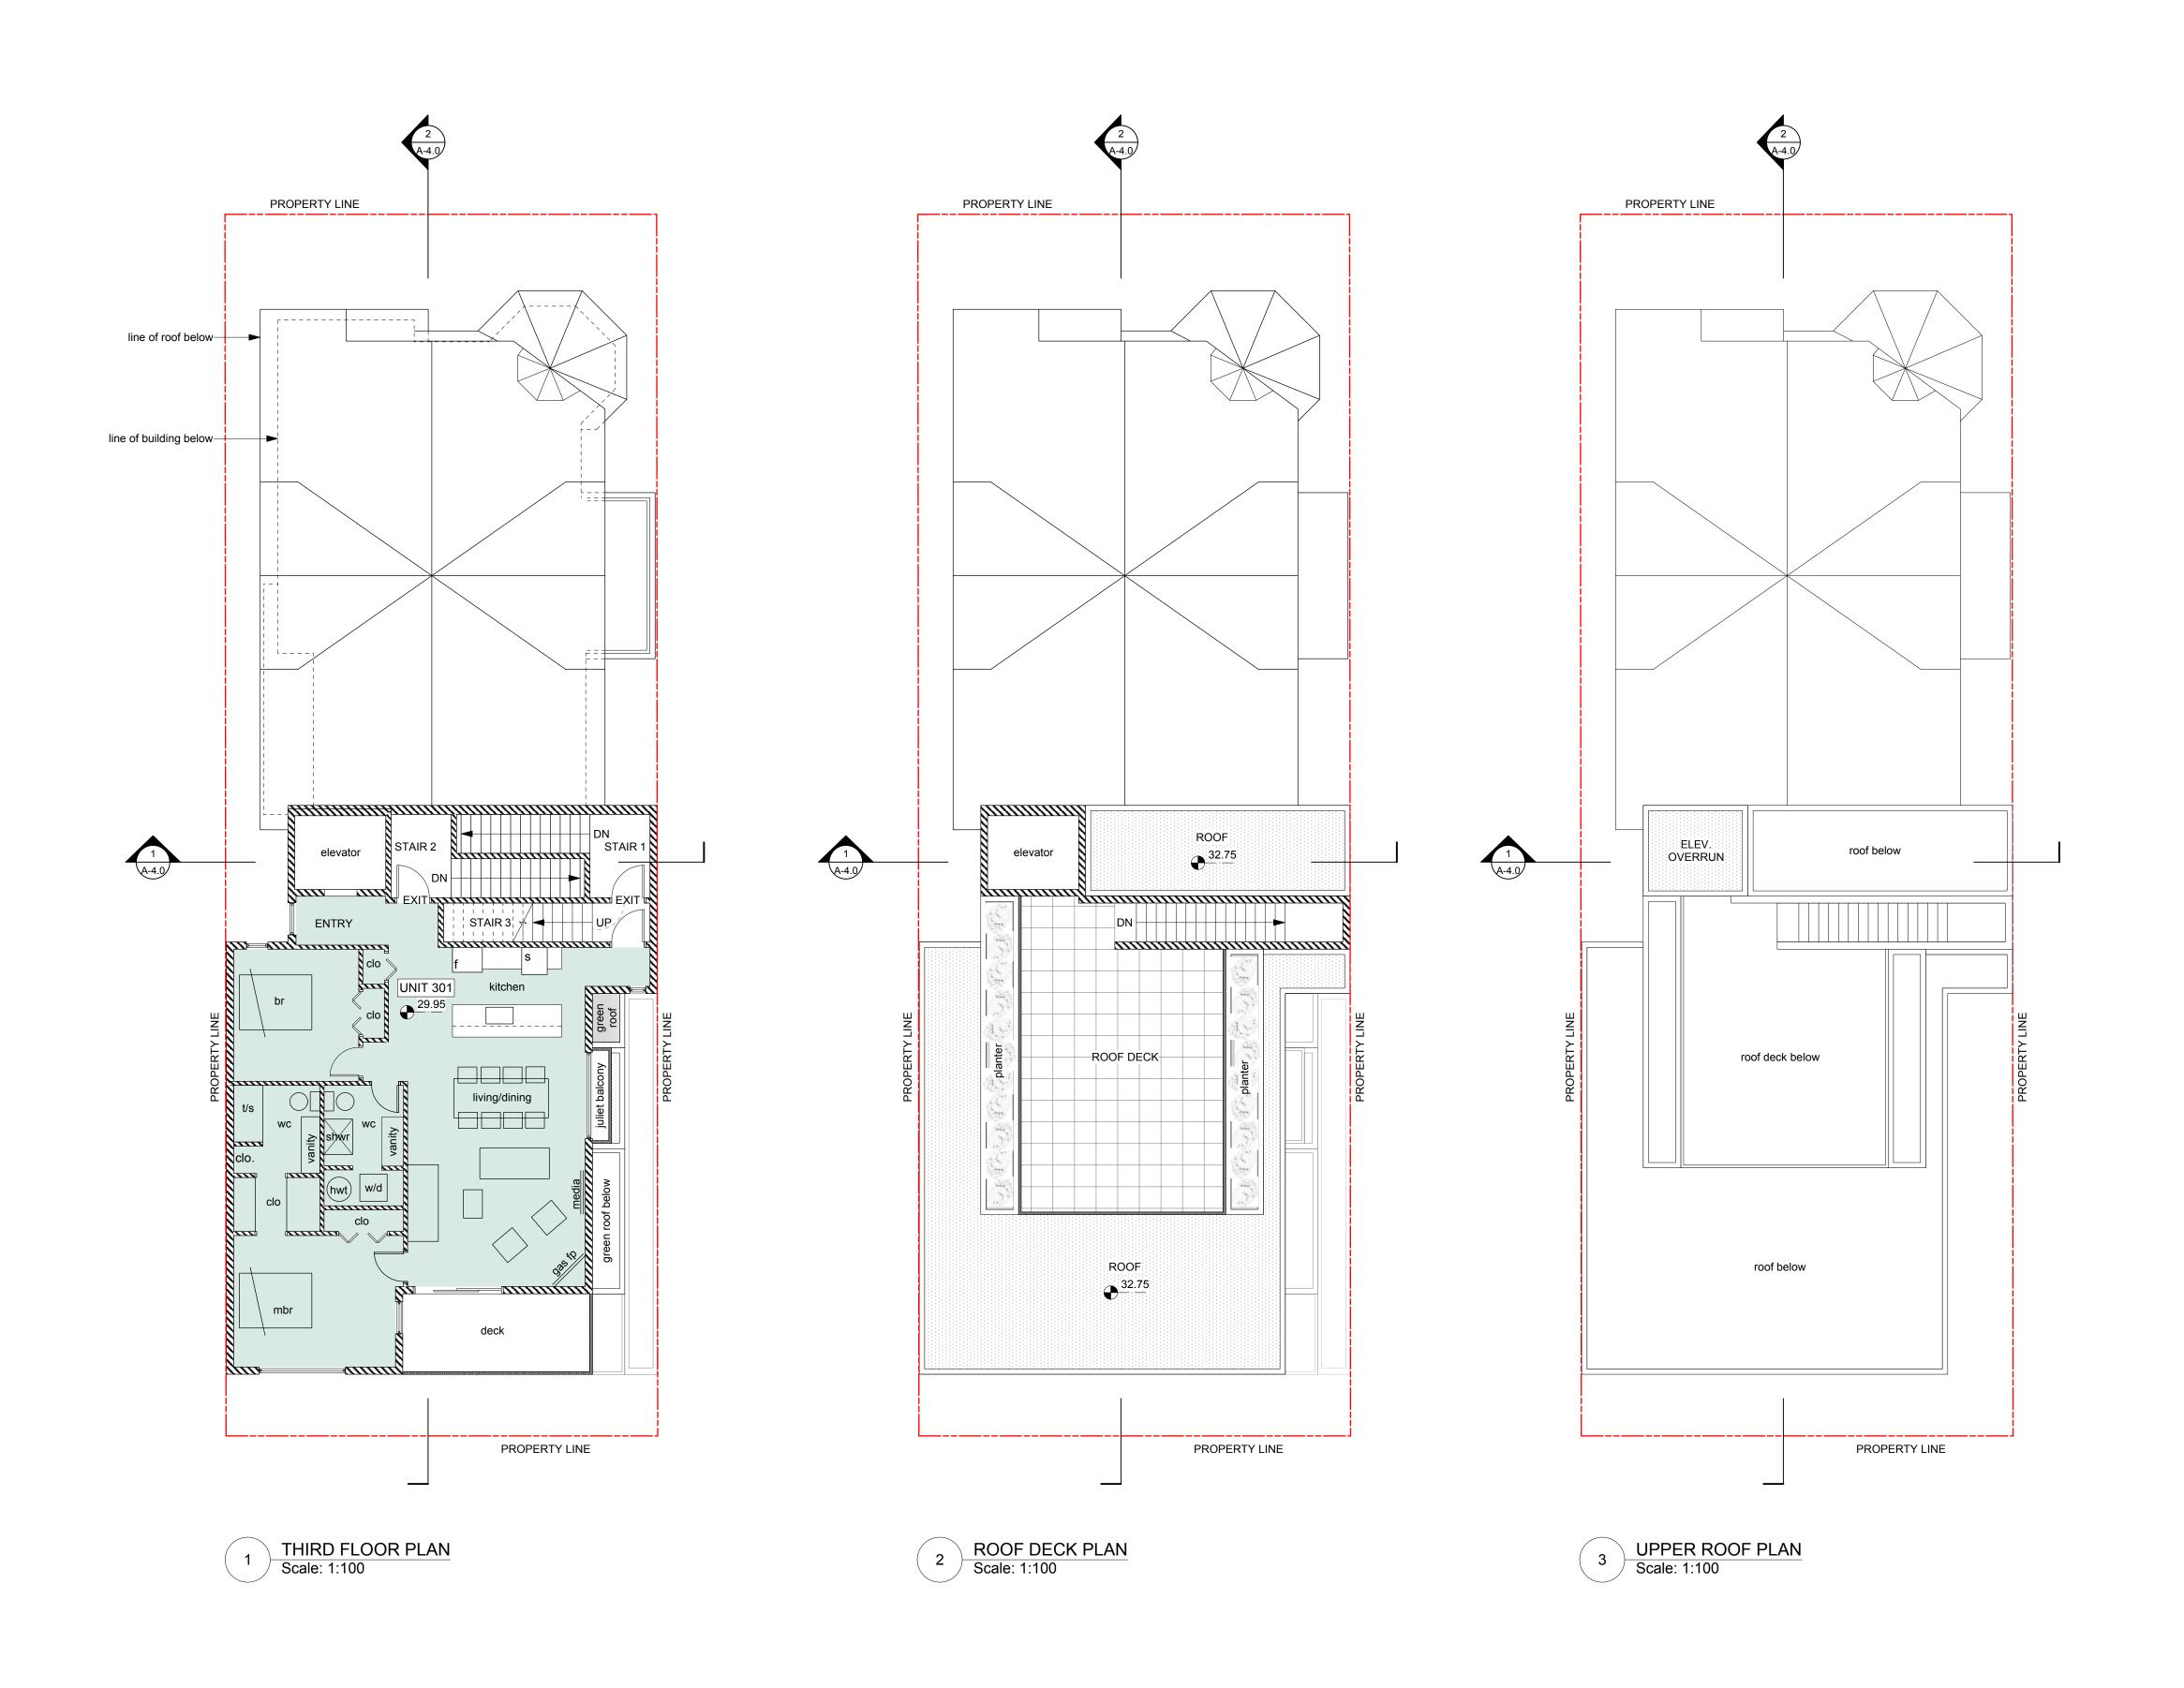

# architecture Itd.

2nd Floor, 1124 Fort Street, Victoria, BC, V8V 3K8 o. 250-382-3823 e. info@keayarchitecture.com

	T	T
No.	DESCRIPTION	DATE
1	PRELIMINARY DESIGN	18/11/04
2	PRELIMINARY DESIGN	19/01/0
3	REZONING SUBMISSION	19/08/1
4	REZONING SUBMISSION REVISIONS	20/03/0
5	REZONING SUBMISSION REVISIONS	20/09/08

#### GENERAL NOTES

- Use of these drawings is limited to that identified in the issue/revision column.
  Do not construct from these drawings unless marked " issued for construction".
  All drawings, plans, models, designs, specifications and other documents prepared by Keay Architecture Ltd, (KA) and used in connection with this project remain the property of KA whether the "work" is executed or not. KA reserves the copyright in them and in the work executed from them.
  These drawings or other may not be reproduced or used in part or in whole, without the expressed and written consent of KA.



#### PROJECT


PROPOSED DEVELOPMENT 1125 FORT STREET VICTORIA

SHEET TITLE


THIRD FLOOR AND **ROOF PLANS** 

SCALE	JOB No.
AS SHOWN	1741
PLOT DATE Sep 08, 2020	
DRAWN JK/NS	A-2.1



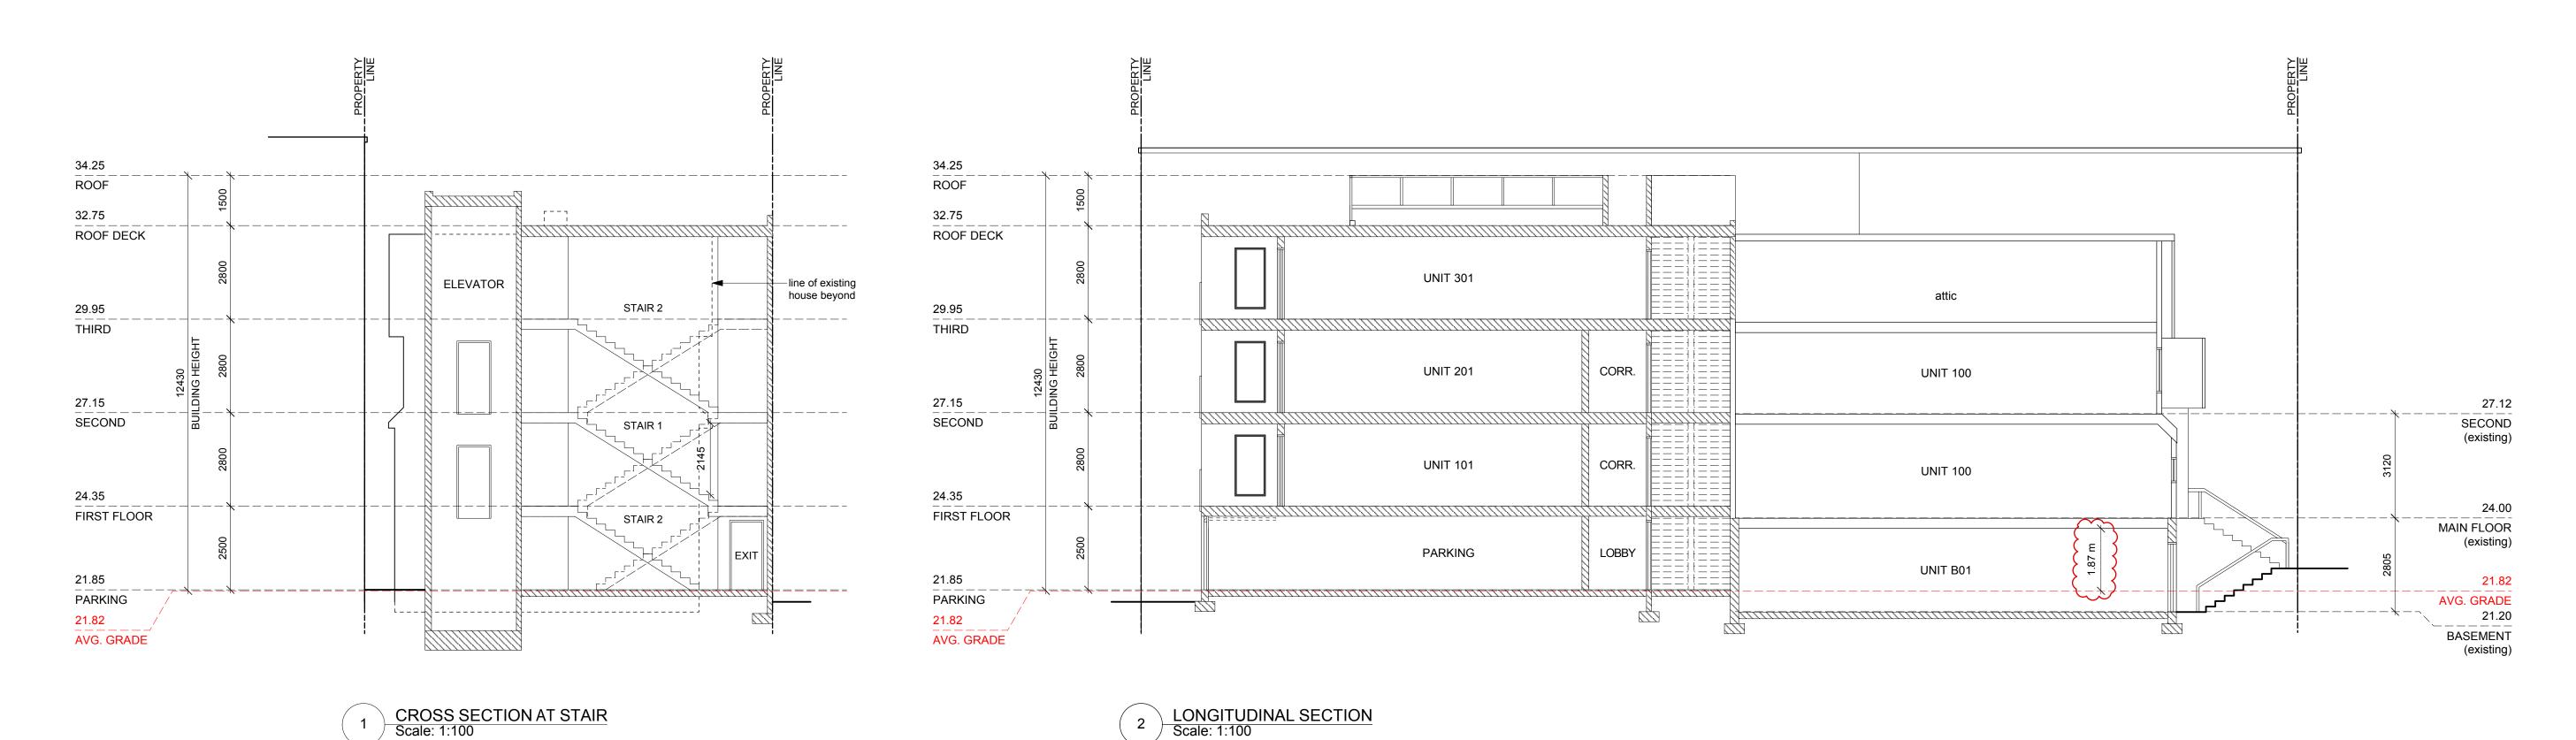



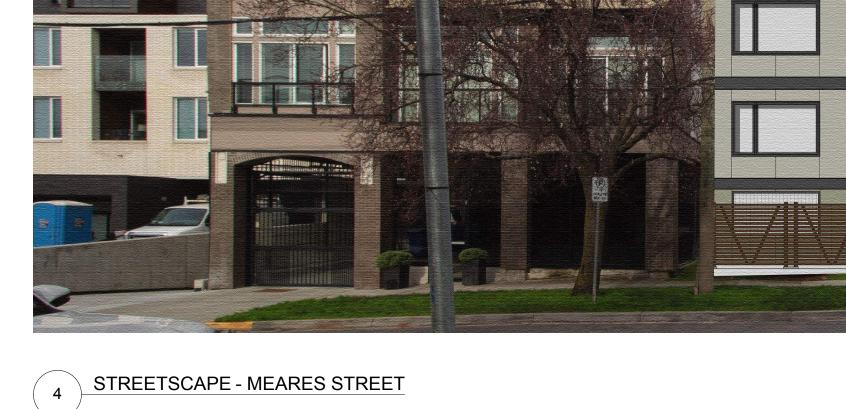

keay architecture ltd.

2nd Floor, 1124 Fort Street, Victoria, BC, V8V 3K8 o. 250-382-3823 e. info@keayarchitecture.com

	COMMENTS				
DESCRIPTION	DATE	В			
PRELIMINARY DESIGN	18/11/04	JI			
PRELIMINARY DESIGN	19/01/03	J			
REZONING SUBMISSION	19/08/15	J			
REZONING SUBMISSION REVISIONS	20/03/02	N			
REZONING SUBMISSION REVISIONS	20/09/08	N			
	PRELIMINARY DESIGN PRELIMINARY DESIGN REZONING SUBMISSION REZONING SUBMISSION REVISIONS	PRELIMINARY DESIGN 18/11/04 PRELIMINARY DESIGN 19/01/03 REZONING SUBMISSION 19/08/15 REZONING SUBMISSION REVISIONS 20/03/02			

GENERAL NOTES

Use of these drawings is limited to that identified in the issue/revision column.
Do not construct from these drawings unless marked " issued for construction".
All drawings, plans, models, designs, specifications and other documents prepared by Keay Architecture Ltd, (KA) and used in connection with this project remain the property of KA whether the "work" is executed or not. KA reserves the copyright in them and in the work executed from them.
These drawings or other may not be reproduced or used in part or in whole, without the expressed and written consent of KA.





PROJECT

PROPOSED DEVELOPMENT


1125 FORT STREET

VICTORIA

SHEET TITLE

SECTIONS AND STREETSCAPES

JOB No. 1741
A-4.0

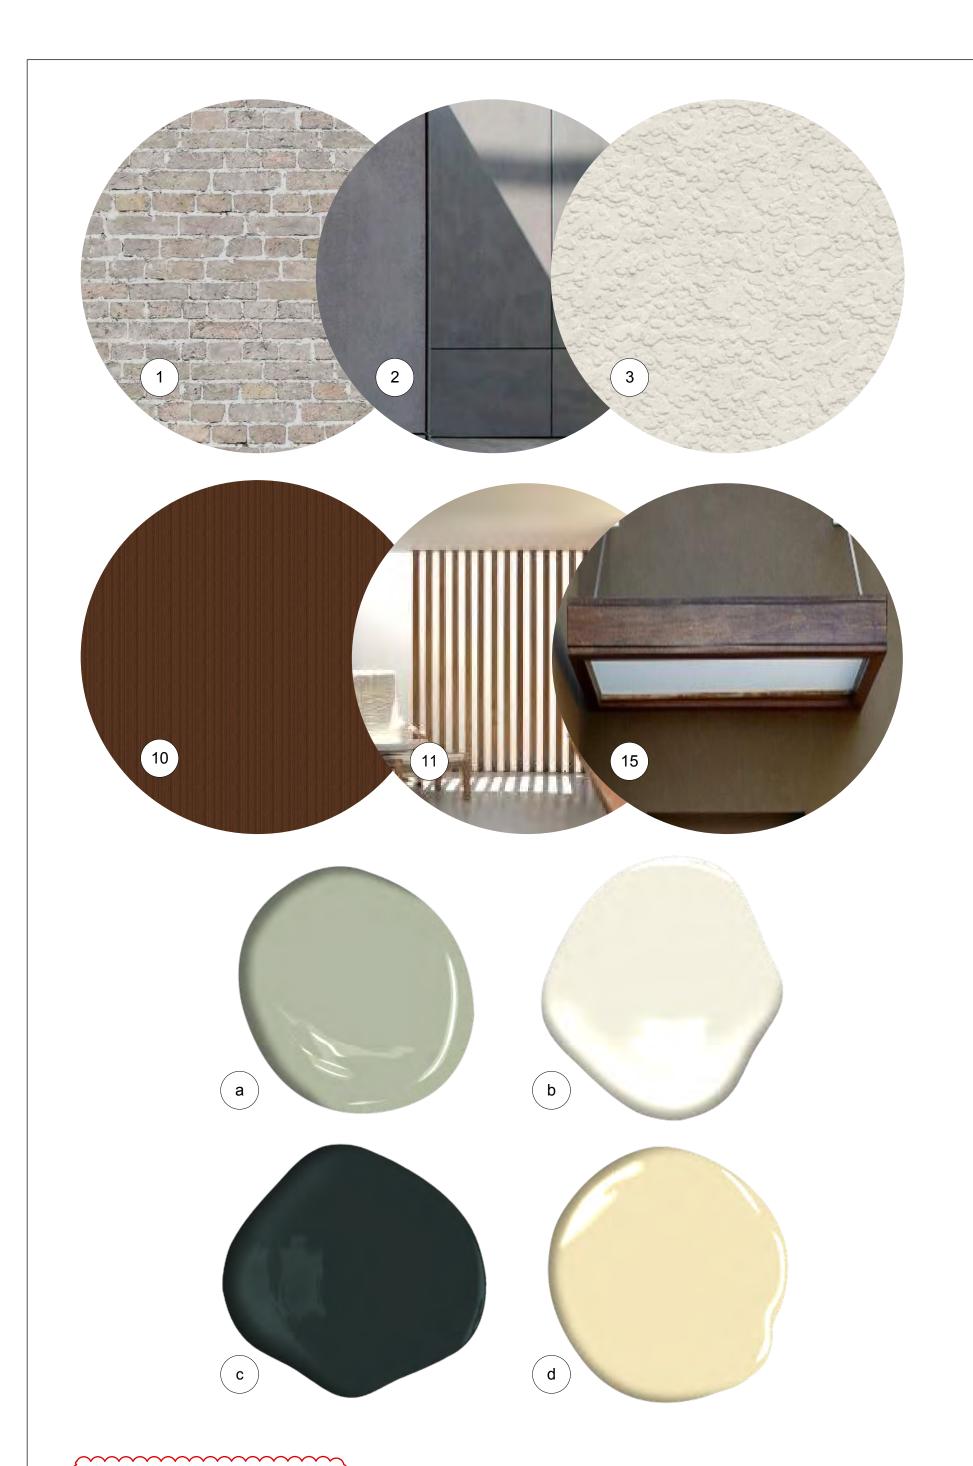

### MATERIALS SCHEDULE

## MATERIALS

1 BRICK OR ALIKE CLADDING MUTUAL MATERIALS - SEA GREY (SMOOTH)

- (or similar cement board panel)
- (or similar cement board panel)
- 3 SOFT TEXTURED STUCCO PAINTED (BM-VC-1 : OXFORD IVORY)
- (4) CONCRETE BLOCK
- (5) VINYL WINDOWS CHARCOAL
- (6) VINYL SLIDING DOORS CHARCOAL
- METAL DOOR PAINTED (BM-VC-20 : VANCOUVER GREEN)
- (8) ALUMINUM AND GLAZED DOOR CHARCOAL
- ALUMINUM AND FROSTED GLASS GUARDS CHARCOAL
- (10) STAINED CEDAR SOFFITS
- (11) STAINED CEDAR SCREENING WITH GATES
- (12) ALUMINUM FLASHING CHARCOAL
- (13) ALUMINUM AND GLASS OVERHEAD DOOR
- (14) ASPHALT SHINGLES CHARCOAL
- (15) WOOD AND METAL CANOPY



- a BM-VC-16: COMOX SAGE BENJAMIN MOORE VANCOUVER COLLECTION
- BM-VC-1 : OXFORD IVORY ( b ) BENJAMIN MOORE - VANCOUVER COLLECTION (or similar precoloured stucco)
- BM-VC-20 : VANCOUVER GREEN
  BENJAMIN MOORE VANCOUVER COLLECTION
- d BM-VC-7 : EDWARDIAN CREAM BENJAMIN MOORE VANCOUVER COLLECTION




(2.1)



MEARES STREET (REAR) SOUTH ELEVATION



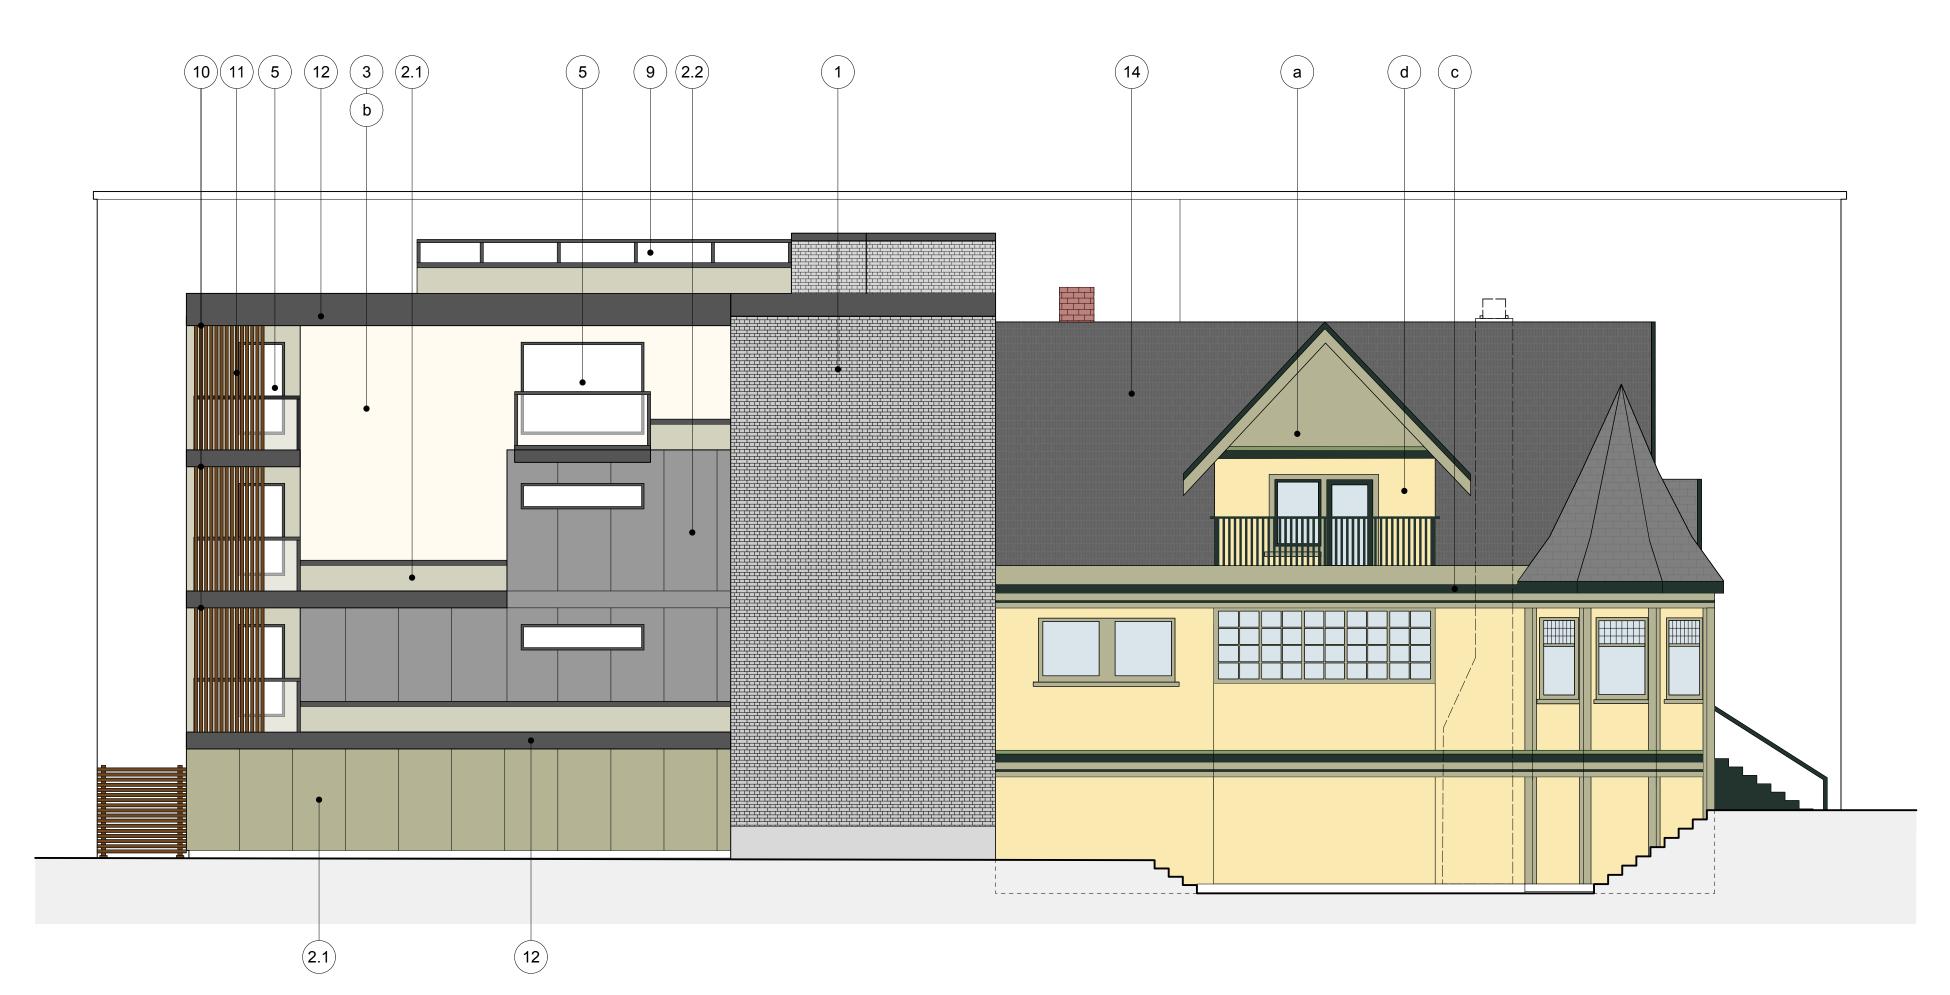

## keay architecture Itd.

2nd Floor, 1124 Fort Street, Victoria, BC, V8V 3K8 o. 250-382-3823 e. info@keayarchitecture.com

COMMENTS			
No.	DESCRIPTION	DATE	
1	PRELIMINARY DESIGN	18/11/04	
2	PRELIMINARY DESIGN	19/01/03	
3	REZONING SUBMISSION	19/08/15	
4	REZONING SUBMISSION REVISIONS	20/03/02	
5	REZONING SUBMISSION REVISIONS	20/09/08	

GENERAL NOTES

- Use of these drawings is limited to that identified in the issue/revision column.

  Do not construct from these drawings unless marked " issued for construction".
- All drawings, plans, models, designs, specifications and other documents prepared by Keay Architecture Ltd, (KA) and used in connection with this project remain the property of KA whether the "work" is executed or not. KA reserves the copyright in them and in the work executed from them.
- These drawings or other may not be reproduced or used in part or in whole, without the expressed and written consent of KA.



PROJECT

PROPOSED DEVELOPMENT 1125 FORT STREET VICTORIA


SHEET TITLE

**COLOUR BOARD** 

SCALE AS SHOWN	JOB No. 1741
PLOT DATE Sep 08, 2020	
DRAWN JK/NS	A-5.0

EAST ELEVATION

### FORT STREET

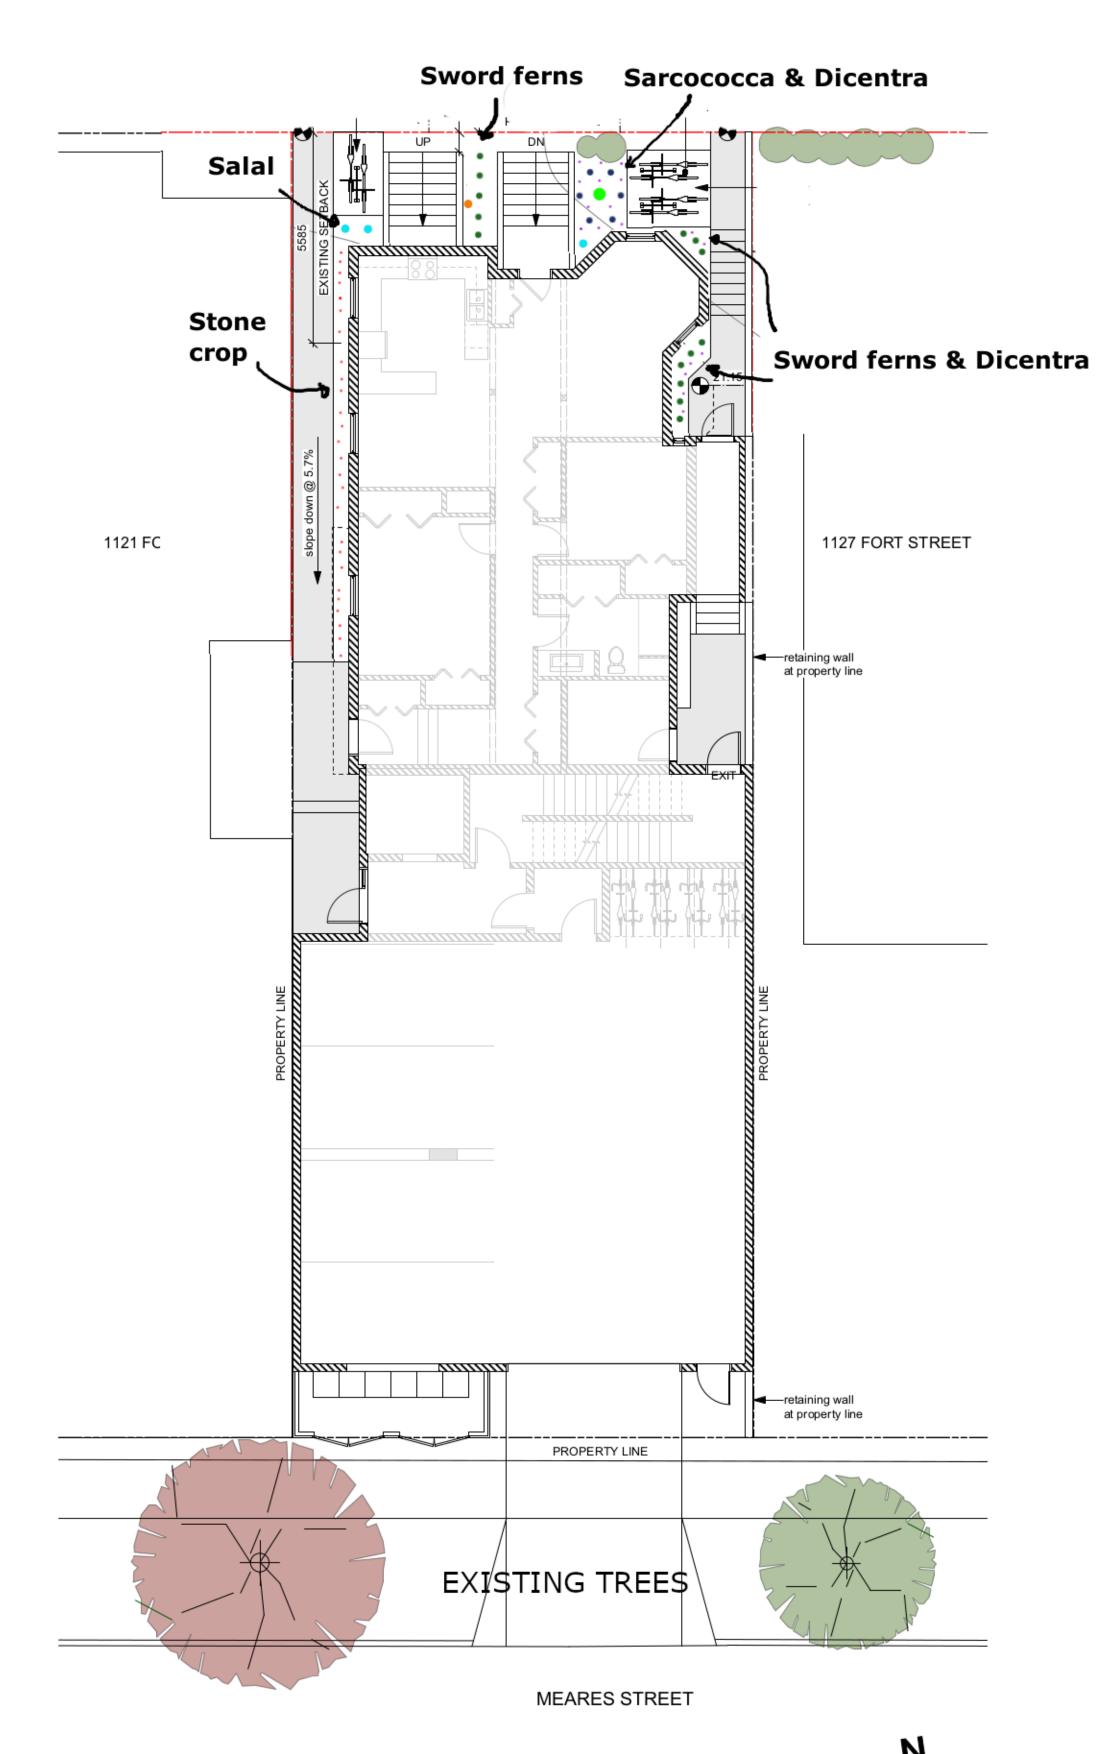

LANDSCAPE - SITE PLAN Scale: 1:100

\*Note: Refer to 1/A-1.1 for site grading information.

Hose bib irrigation system 1/2" Drip line

LANDSCAPE - ROOF DECK PLAN
Scale: 1:100

Indian plum





keay architecture Itd.

2nd Floor, 1124 Fort Street, Victoria, BC, V8V 3K8 o. 250-382-3823 e. info@keayarchitecture.com

Plant List COMMENTS No. DESCRIPTION DATE BY 11 - 3 Gal - Sword Ferns (Polystichum munitum) 1 - 3 Gal - Virginia Creeper (Parthenocissus quinquefolia) 6 - 3 Gal - Sweet Boxwood (Sarcoccoca hookeriana) 2 - Flats - Broad-leaved Stonecrop (Sedum spathifolium 3 - 3 Gal - Salal (Gaultheria shallon) 1 - 5 Gal - Indian Plum (Oemleria cerasiformis) 16 - 1 Gal - Bleeding Heart (Dicentra formosa R 34 - 1 Gal - Boxwoods - Roof top planting

> This landscape plan was designed by Vision Landscaping. The front yard will have a simple modern appearance. The use of drought-tolerant natives is key in this design. Sword ferns create an elegant west coast feel while providing evergreen interest all year round. Virginia creeper will climb the up staircase turning the concrete into a beautiful yet simple living wall. The use of live walls brings a sense of lushness and happiness to the environment. An Indian plum lies to the left of the eastern bike rack. The Indian plum is one of the first flowering native shrubs. It has a small white flower that marks the beginning of spring and invites hummingbirds to drink from its nectar. The rest of this area will be filled with Sarcoccoca and Pacific Bleeding hearts. The former is a beautiful native herbaceous flower that will bring a floral element to the landscape (see below for attached picture). This flower will bring a lot of beauty to the landscape and invite hummingbirds to the environment. The Sarcoccoca is the one nonnative plant we have elected to use in this garden. It brings year-round interest as an evergreen shrub however it shines during the winter when its flowers bloom and release an amazing sweet scent into the

Salal is a great plant to fill the west bike rack garden bed, drought-tolerant, native, evergreen. Broadleaf stonecrop will be used to fill the small shaded bed along the eastern side of the building. All planted areas will be finished with a dark rich fish mulch to

suppress weeds and reduce maintenance. The eastern rooftop gardens on the first, second and third floors will be covered with a Sedum mat. This is an excellent product that requires very little maintenance and watering.
The topmost roof deck will be completed with a row of boxwoods.

## Rooftop plantings:

following rooftop planters. First Floor - 7.2 m2 Second Floor - 3.1 m2 Third Floor - 1.1 m2

Roof Deck - 12.2 m2 (1 @ 6.7m2 + 1 @ 5.5m2) 34 boxwoods - 1 Gal - Spacing every 18" - 131 ft2



## Contact:

Vision Landscaping 250-812-3311 info@visionlandscapingvictoria.ca

PROJECT

PROPOSED DEVELOPMENT 1125 FORT STREET VICTORIA

SHEET TITLE

LANDSCAPE PLAN

SCALE	
AS SHOWN	
PLOT DATE March 2, 2020	
	L-1.0
	AS SHOWN PLOT DATE