ZONING INFORMATION - LOT 469

CIVIC ADDRESS: 506 Herald Street, Victoria, BC

ZONE (EXISTING):

PROPOSED ZONE:

No change to zone. No change of use

SITE AREA (m²):

Lot 469:

FLOOR AREA (m²):

TOTAL:

171 m² (no change) Mezzanine: 67 m² (proposed)

237 m² (proposed)

COMMERCIAL FLOOR AREA (m²):

FLOOR SPACE RATIO: .35: 1

SITE COVERAGE (%): **HEIGHT OF BUILDING (m):** 8.6 m

NUMBER OF STOREYS: 2 (one storey plus mezzanine, and rooftop patio)

PARKING STALLS ON SITE: 8 (existing, no change)

PARKING STALLS REQUIRED: none

LOT 486

LOT 469

685 sq. m.

EXISTING PARKING

506 HERALD STREET

AREA A =

311.9 m²

BICYCLE PARKING NUMBER (CLASS 1 & CLASS 2): none (4 provided)

LOT 485

18418

LOT 470

687 sq. m.

81.1 m2

EXISTING

AREA C = 137.8 m²

4.8 m2

AREA 8 = 111.1 m²

88" GET 22"."

72, 163

BUILDING SETBACKS (m)

OTD-1 Zone, therefore, no setbacks required.

ZONING INFORMATION - LOT 470

CIVIC ADDRESS: 506 Herald Street, Victoria, BC **ZONE (EXISTING):**

OTD-1

PROPOSED ZONE: No change to zone. No change of use

SITE AREA (m²): 687 m² Lot 470:

FLOOR AREA (m2):

76 m² (no change) Mezzanine: 16 m² (proposed) 92 m² (proposed)

COMMERCIAL FLOOR AREA (m²):

FLOOR SPACE RATIO: .13: 1

SITE COVERAGE (%): 12%

HEIGHT OF BUILDING (m): 8.6 m

NUMBER OF STOREYS: 2 (one storey plus mezzanine, and rooftop patio)

(a) (a) (b) (b) (c)

AREA E = 364.7 m²

LOT 483

LOT 472

AREA F = 597.5 m²

EXISTING BUILDING

PARKING STALLS ON SITE: 4 (existing, no change)

PARKING STALLS REQUIRED: none

LOT 484

ME NO AND FIRE EXIT 24.2 ME

EXISTING BUILDING

HERALD STREET

AREA 0 = 295.4 m²

BICYCLE PARKING NUMBER (CLASS 1 & CLASS 2): none

BUILDING SETBACKS (m)

OTD-1 Zone, therefore, no setbacks required.

PROJECT INFORMATION

REGISTERED OWNER

Mike & Lee Spence 5067 Cordova Bay Road

tel: 250.818.5465 Victoria, BC

V8Y 2K1 lee.spence.112@gmail.com

ARCHITECT

LOT 482

LOT 473

dHKiarchitects 977 Fort Street Charles Kierulf tel: 250.658.3367 Victoria, BC V8V 3K3 crk@dhk.ca

STRUCTURAL CONSULTANT

Sorensen TRILOGY Engineering Ltd. 215 - 737 Goldstream Avenue Brian Lang

Victoria, BC tel: 250.880.2117 V9B 2X4 brianl@sorensenTRILOGY.ca

MECHANICAL CONSULTANT

Avalon Mechanical Consultants Ltd. 300 - 1245 Esquimalt Road Mirek Demidow Victoria, BC tel: 250.384.4128 V9A 3P2 fax: 250.384.4134

ELECTRICAL CONSULTANT

Williams Engineering Michael Phillips 202-31 Bastion Square tel: 778.406.0023 ext.6001 Victoria, BC MPhillips@williamsengineering.com V8W 1J1

SIGNAGE BYLAW SUMMARY

REFERENCED DOCUMENT: CITY OF VICTORIA SIGNAGE BYLAW 14-097

ZONE 1

Arterial Commercial 1:1 Ratio Permitted (maximum total area: 9 m²)

SIGN TYPE

Combination Sign: Business name painted on facade (mural style).

SIGN AREA AS SHOWN

8.9 sq m

Note: Final sign design to be done by others in

compliance to current sign bylaws.

DRAWING LIST

Architectural

A001 Project Data & Site Plan

A201 Level 1 & Mezzanine Floor Plan A202 Roof Top Plan

A203 Seating Plan

A401 Elevations & Materials

A501 Sections

22 MARCH, 2021 - REVISIONS

Ironworks residential building.

2200 high screen with tempered glass, corrugated metal and wood posts added to the north side of the patio to provide acoustic and visual screening to the adjacent

BUILDING CODE SUMMARY - 506 Herald Street, Victoria, BC

■ REFERENCED DOCUMENT: BRITISH COLUMBIA BUILDING CODE 2018 - PART 3

BUILDING AREA [Building Footprint]: 1900 m2 overall, 260 m² for A-2 506 Herald Street

BUILDING HEIGHT: Two (2) storey

NUMBER OF STREETS FACING: One (1)

SPRINKLERED: Yes

MAJOR OCCUPANCY CLASSIFICATIONS: Group E (3.2.2.67) and A2 (3.2.2.27). 3.2.2.67 is more restrictive.

SEPARATION OF MAJOR OCCUPANCIES: (3.1.3.1)

• Minimum fire-resistance rating of fire separation, Group E to A-2: 2 hours., Group A-2 to A-2 - none.

CONSTRUCTION TYPE (3.1.4): Combustible Heavy Timber Construction

OCCUPANT LOAD (3.1.17):

1.2 m²/person for dining and beverage.

4.6 m² /person for process rooms.

Ground Floor: Gross Floor Area 260 m² (served by 2 exits front and rear) Total Load: 123 people

Ground Floor Restaurant Area: $124 \text{ m}^2 = 103 \text{ people}$

Ground Floor Process Area: $73 \text{ m}^2 = 16 \text{ people}$ $19 \text{ m}^2 = 4 \text{ people}$ Cooler:

Mezzanine:

Gross Floor Area 83 m² (served by 1 stair down to Ground Floor) Total Load: 67 people

Mezzanine Restaurant Area: $56 \text{ m}^2 = 67 \text{ people}$

Rooftop:

Gross Area 167 m² (served by 2 exits front and rear) Total Load: 200 people (seasonal).

Rooftop Restaurant Area: $167 \text{ m}^2 = 200 \text{ people}$

Total Calculated Occupant Load: 390; Occupant load limited and posted per 3.1.17.1.2) to 277 people.

CONSTRUCTION REQUIREMENTS (3.2.2.67):

Group E, up to 3 storeys, Sprinklered

• 1) A building classified as Group E is permitted to conform to Sentence(2) provided

a) except as permitted by Sentences 3.2.2.7.(1) and 3.2.2.18.(2), the building is sprinklered throughout, b) it is not more than 3 storeys in building height, and

c) it has abuilding area not more than

i) 7 200 m2 if 1 storey in building height,

2) The building referred to in Sentence (1) is permitted to be of combustible construction or noncombustible construction used singly or in combination, and

a) floor assemblies shall be fire separations with a fire - resistance rating not less than 45min,

b) mezzanines shall have, if of combustible construction, a fire-resistance rating not less than 45 min, c) loadbearing walls, columns and arches supporting an assembly required to have a fire-resistance rating shall

i) have a fire-resistance rating not less than 45 min, or ii) be of noncombustible construction, and

d) loadbearing walls, columns and arches supporting a fire separation shall have a fire-resistance rating not less than that required for the fire separation.

FIRE ALARM AND DETECTION SYSTEMS (3.2.4):

• Signal to Fire Department required, 2 stage. Will notify that an alert signal has been initiated (3.2.4.8.3) • Building is one storey and less than 2000 m², and therefore can be one fire zone. An annunciator is not

required if there is only one zone (3.2.4.9(2,3))

Visual and audible trouble signal to be provided at main entrance (3.2.4.4)

• Electrical supervision of fire alarm system required (3.2.4.10)

 Smoke detectors not required (3.2.4.12) • Fire alarm system monitoring required (3.2.4.16)

Manual pull stations required at exits (3.2.4.17)

EXITS AND EGRESS:

Travel Distance to an exit is 45 m maximum (3.4.2.5); 8.5 m (Ground Floor), 13 m (Mezzanine), 29 m (Roof) actual.

Minimum Width of Exits (3.4.3.2): Exit corridor / passageway: 1100 mm 900 mm

Doorways: **WASHROOMS**:

• Building occupancy is limited to 178 people as per approved liquor licence, with an additional 99 people on the roof (unlicensed) for a total of 277 people. Total Number of water closets provided (3.7.2.2.A) is 9. All water closet stalls are private and unisex. Sign with occupant limit to be posted on site.

800 mm

Accessible washroom provided is ground floor universal washroom (3.7.2.10).

VICTORIA

Revisions

submitted plans **Received Date** September 1, 2021

Bubbled areas indicate revisions

compared to the previously

Acoustic/Privacy Screen Update - For Review 10 NOV 2020 21 JAN 2020 Re-Issued for Development Perm Re-Issued for Development Pern 22 MAR 2021

RE-ISSUED FOR DEVELOPMENT



Project Name

102-5190 Dublin Way Nanaimo BC V9T 2K8 T 1•250•585•5810

Address Victoria, BC

Project Data & Floor Plan COPYRIGHT RESERVED. THESE PLANS AND DESIGNS ARE AND AT ALL TIMES REMAIN THE PROPERTY OF DE HOOG & HIERULF ARCHITECTS TO BE USED FOR THE PROJECT SHOWN AND MAY NOT. BE: REPRODUCED WITHOUT WRITTEN






BLDG.




0

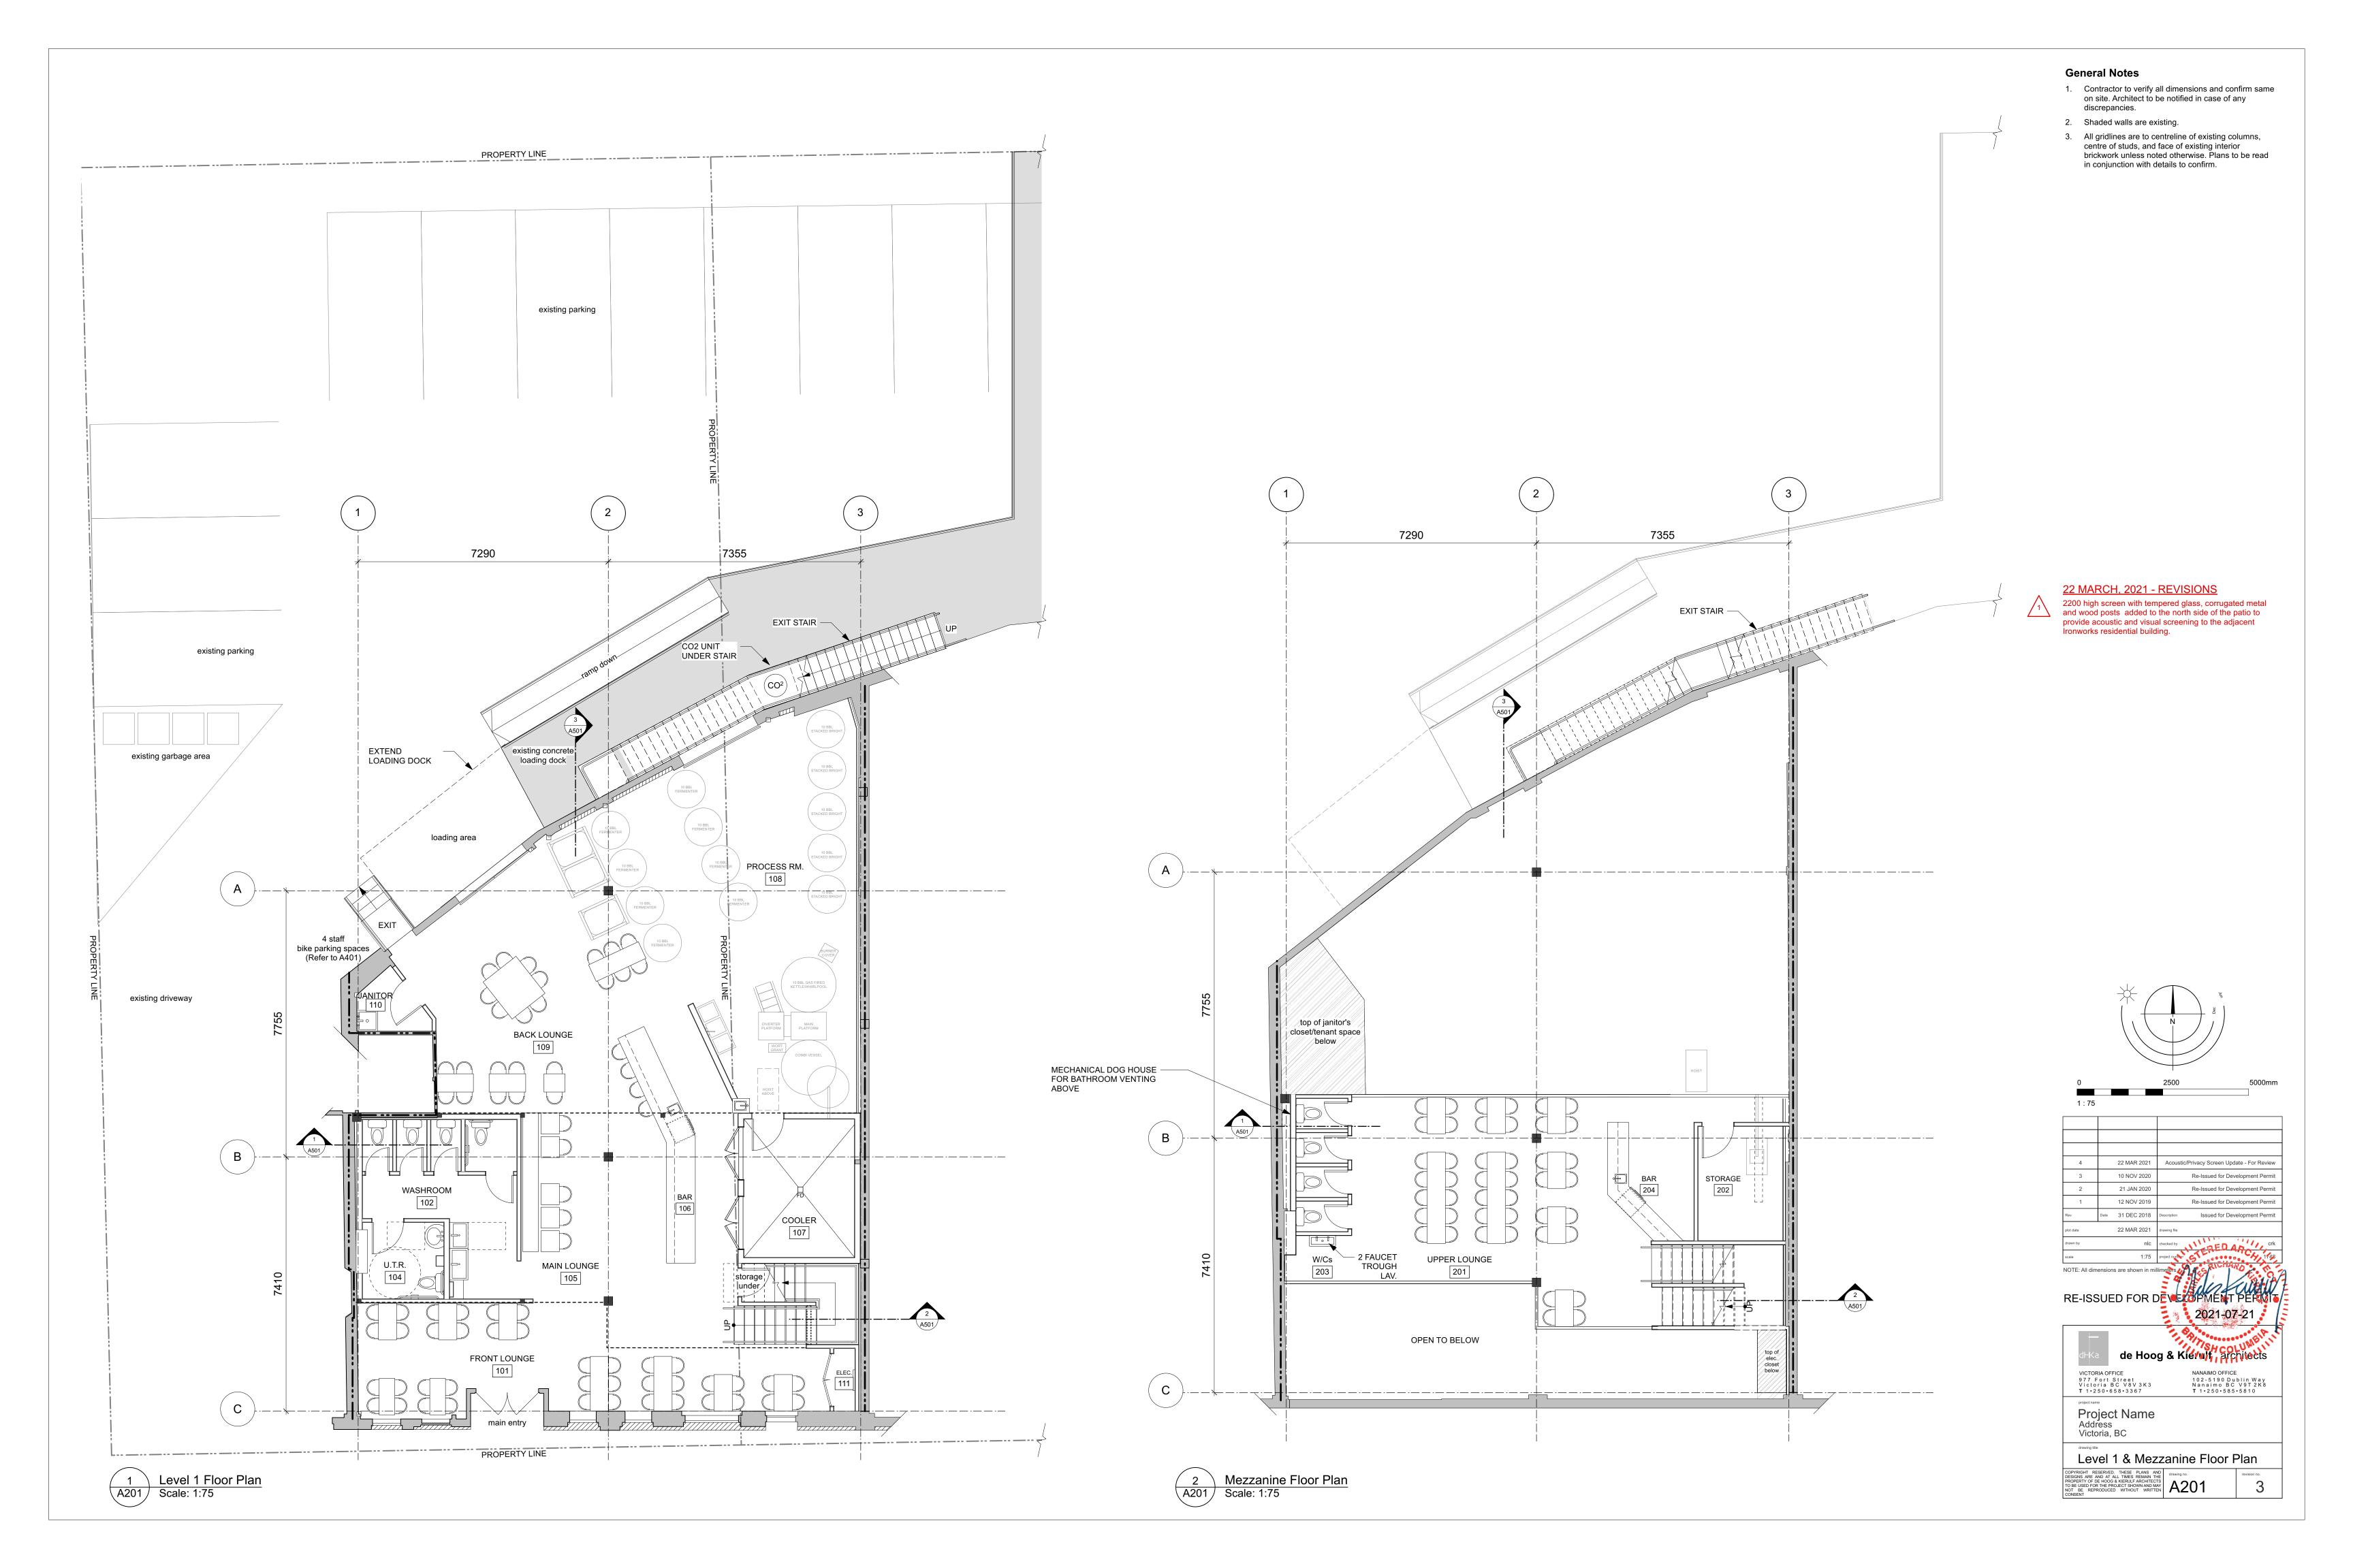

General Notes

- 1. Contractor to verify all dimensions and confirm same on site. Architect to be notified in case of any discrepancies.
- 2. Shaded walls are existing.
- All gridlines are to centreline of existing columns, centre of studs, and face of existing interior brickwork unless noted otherwise. Plans to be read in conjunction with details to confirm.

22 MARCH, 2021 - REVISIONS 2200 high screen with tempered glass, corrugated metal and wood posts added to the north side of the patio to provide acoustic and visual screening to the adjacent Ironworks residential building.

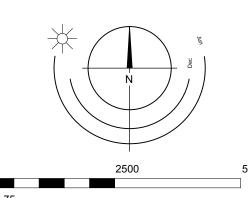

22 MAR 2021 Acoustic/Privacy Screen Update - For Review 21 JAN 2020 Re-Issued for Development Permit 12 NOV 2019 Re-Issued for Development Permit Date 31 DEC 2018 Descrip Issued for Development Permit 22 MAR 2021





NANAIMO OFFICE 102-5190 Dublin Way Nanaimo BC V9T 2K8 T 1•250•585•5810

VICTORIA OFFICE
977 Fort Street
Victoria BC V8V 3K3
T 1.250.658.3367

Project Name Address Victoria, BC


Roof Top Floor Plan

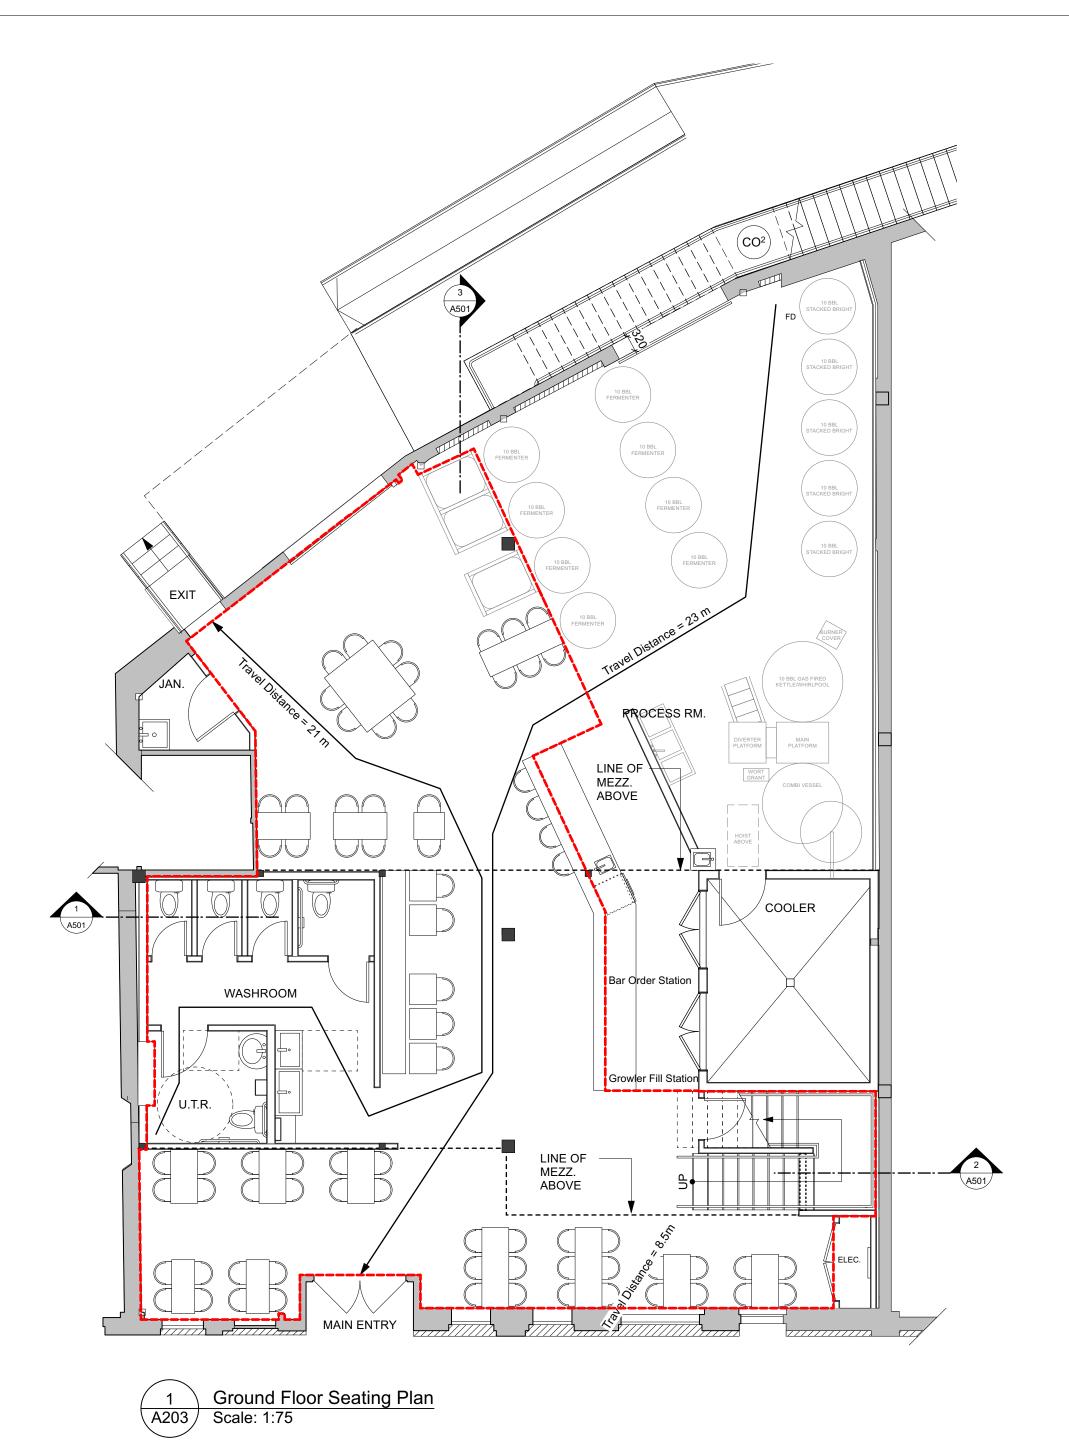


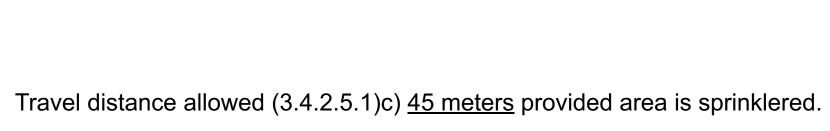




- Dashed red line indicates liquor service area.
 - 2. Total Occupant Load based on BCBC 2018

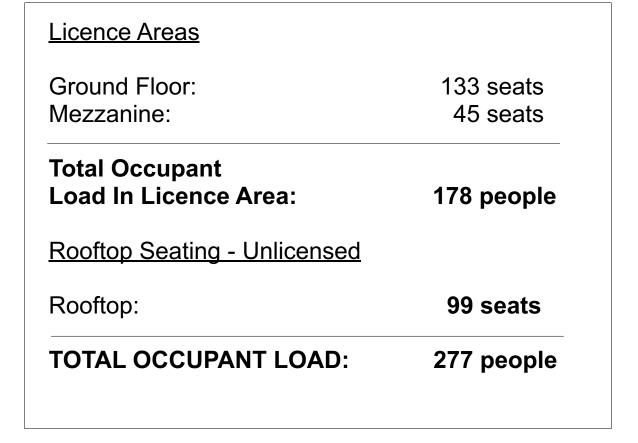

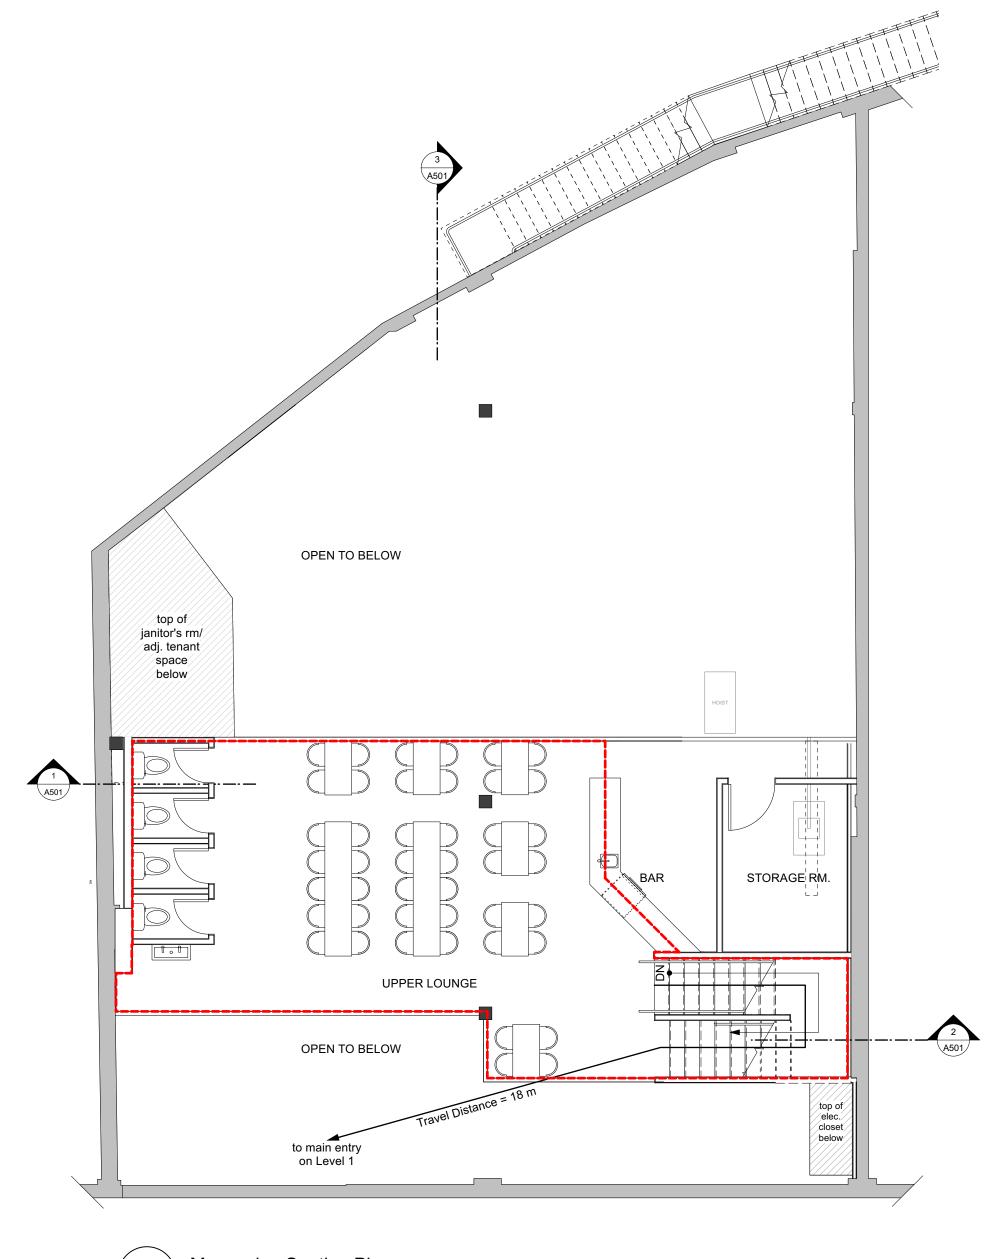


Mezzanine Seating Plan Scale: 1:75

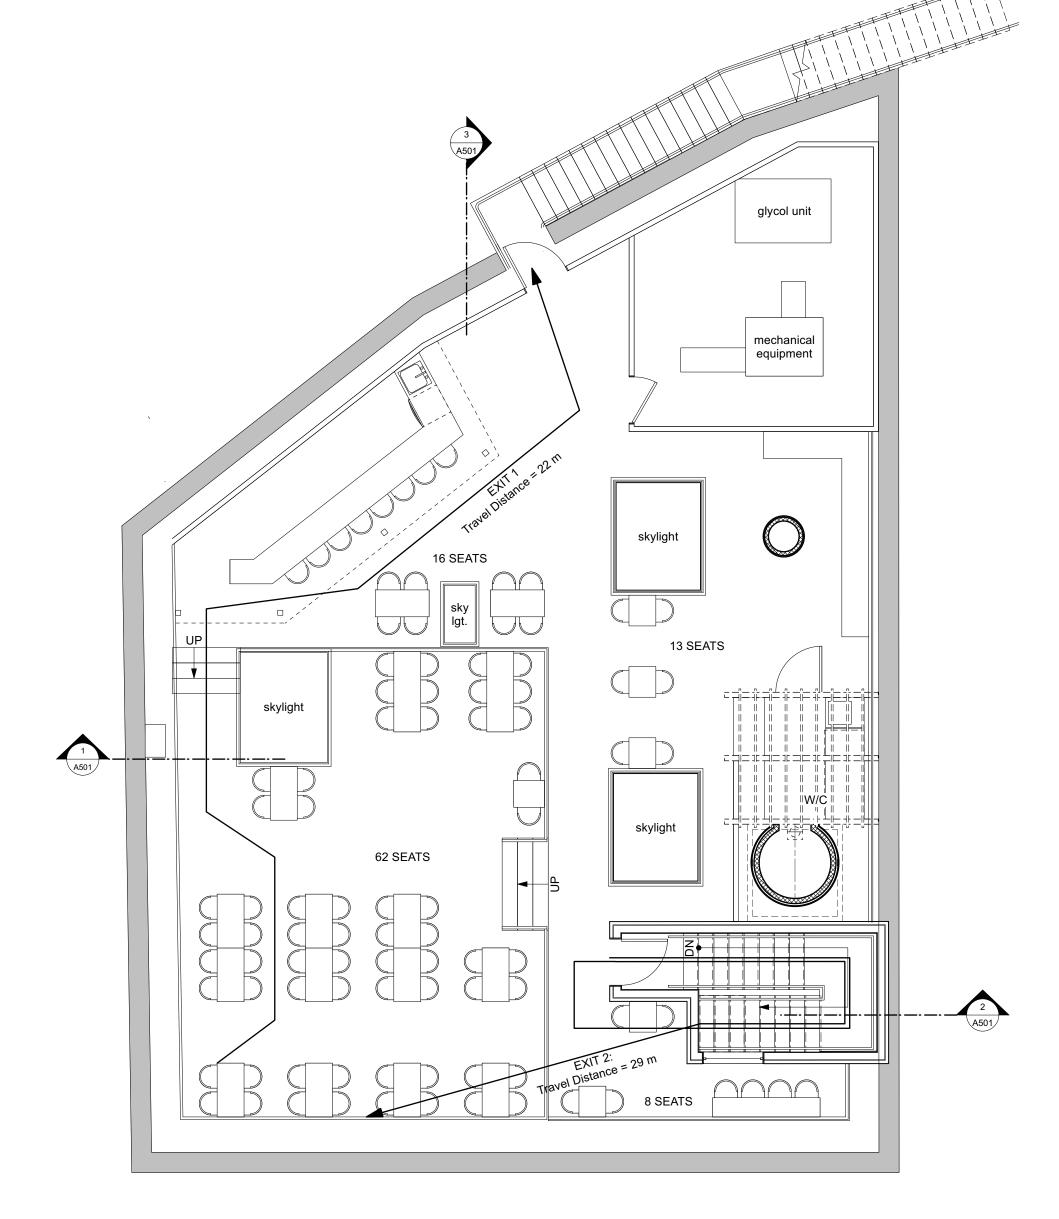

Roof Seating Plan
A203 Scale: 1:75

UNLICENSED

22 MARCH, 2021 - REVISIONS 2200 high screen with tempered glass, corrugated metal and wood posts added to the north side of the patio to provide acoustic and visual screening to the adjacent Ironworks residential building.

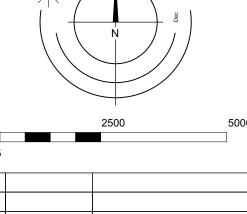


4		22 MAR 2021	Acoustic/Privacy Screen Update - For Review
3		10 NOV 2020	Re-Issued for Development Permi
2		21 JAN 2020	Re-Issued for Development Permi
1		12 NOV 2019	Re-Issued for Development Perm
Rev	Date	31 DEC 2018	Description Issued for Development Perm
plot date		22 MAR 2021	drawing file
drawn by		nlc	checked by Cr
scale		1:75	project number



Project Name Address Victoria, BC

Seating Plan COPYRIGHT RESERVED. THESE PLANS AND DESIGNS ARE AND AT ALL TIMES REMAIN THE PROPERTY OF DE HOOG & KIERULF ARCHITECTS TO BE USED FOR THE PROJECT SHOWN AND MAY NOT BE REPRODUCED WITHOUT WRITTEN CONSENT.

3

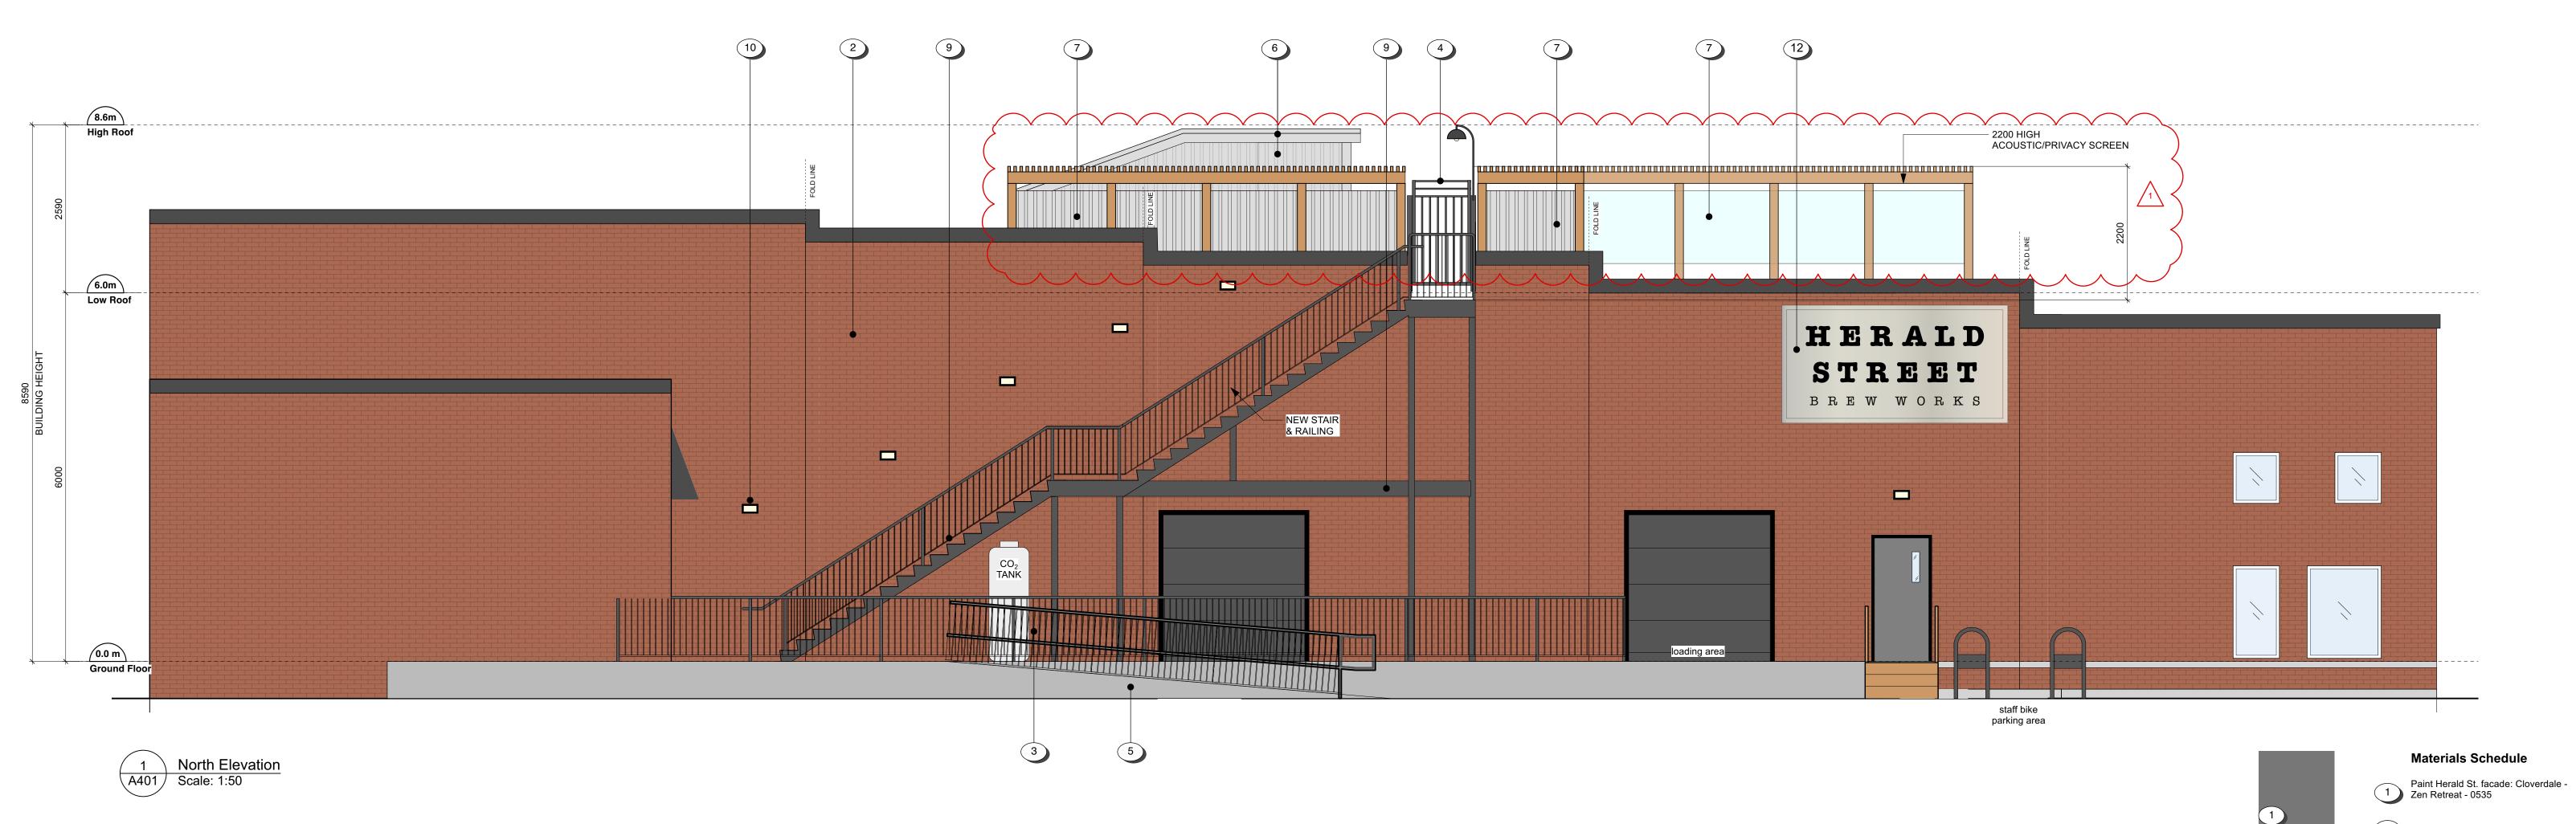



2 Retain existing brick (typ.)

Prefinished aluminum guardrail frame - Dark Grey. Climb-proof mesh inset - Anodized.

Prefinished aluminum gate - Dark Grey. Fir posts - Clear Stain.

5 Paint new concrete infill to match existing.

6 Anodized metal.

2200 mm high acoustic screen with translucent tempered glass and corregated metal. Fir posts and trellis - clear Stain.

Prefinished aluminum guardrail frame - Dark Grey Translucent tempered glass inset.

Prefinished aluminum stair, pickets and railing - Dark Grey.

New lighting to co-ordinate with existing (by others).

11 Paint all trim: Cloverdale - Subway - 0536

New mural-style painted sign (by others). Refer to Sign Bylaw Summary, A001.

2500mm

13 New wood decking.


	1	: 50		
4		22 MAR 2021	Acousti	c/Privacy Screen Update - For Revi
3		10 NOV 2020		Re-Issued for Development Per
2		21 JAN 2020		Re-Issued for Development Per
1		12 NOV 2019		Re-Issued for Development Per
Rev	Date	31 DEC 2018	Description	Issued for Development Per
plot date 22 MAR 2021			drawing file	
drawn by nlc			checked by	WINED AD !!
scale 1:75			project number	GTE C/Y 13


RE-ISSUED FOR DEVELOPMENT




Project Name Address Victoria, BC

Elevations & Materials COPYRIGHT RESERVED. THESE PLANS AND DESIGNS ARE AND AT ALL TIMES REMAIN THE PROPERTY OF DE HOOG & MIERULF ARCHITECTS TO BE USED FOR THE PROJECT SHOWN AND MAY NOT BE REPRODUCED WITHOUT WRITTEN CONSENT.

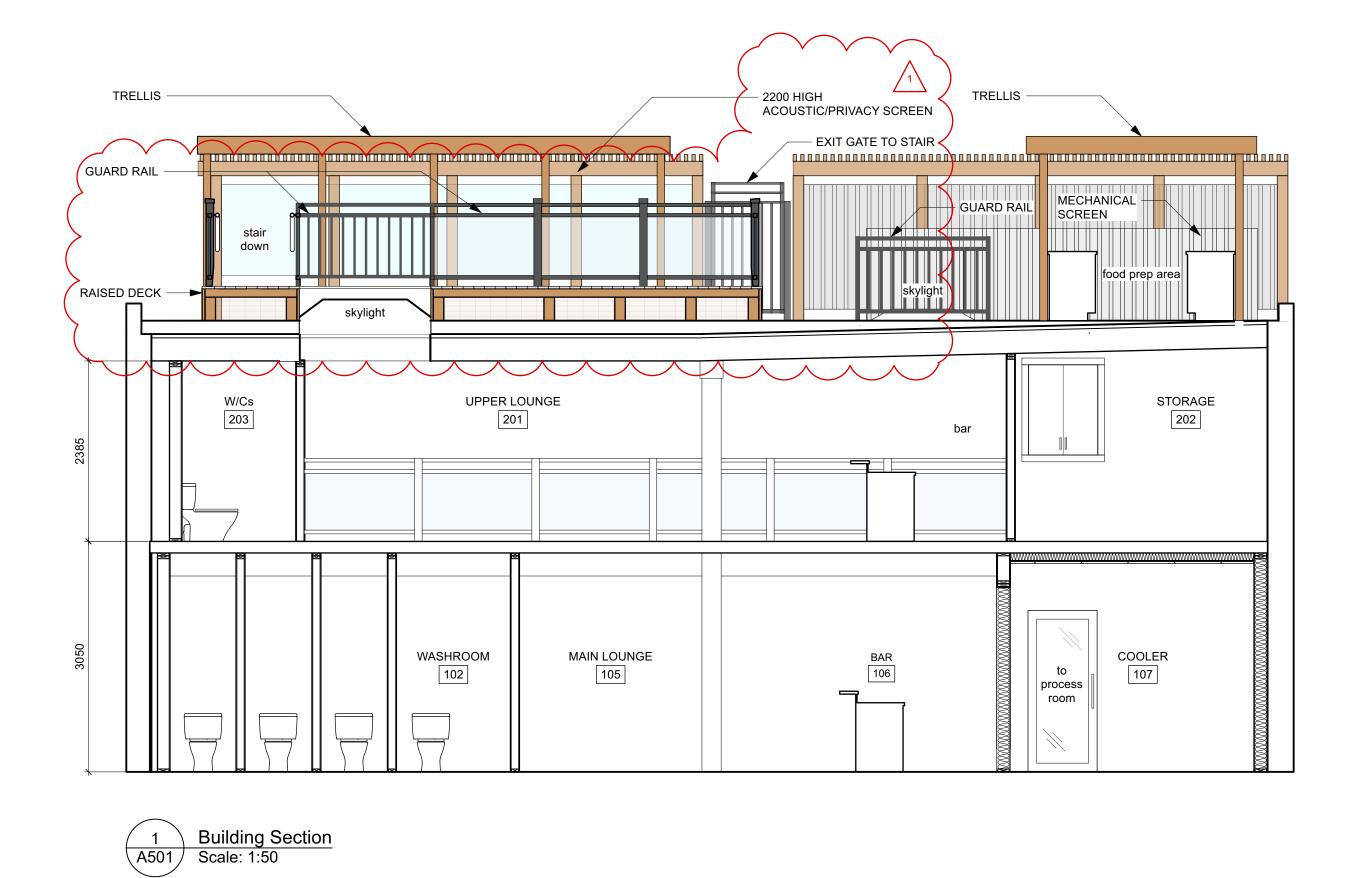

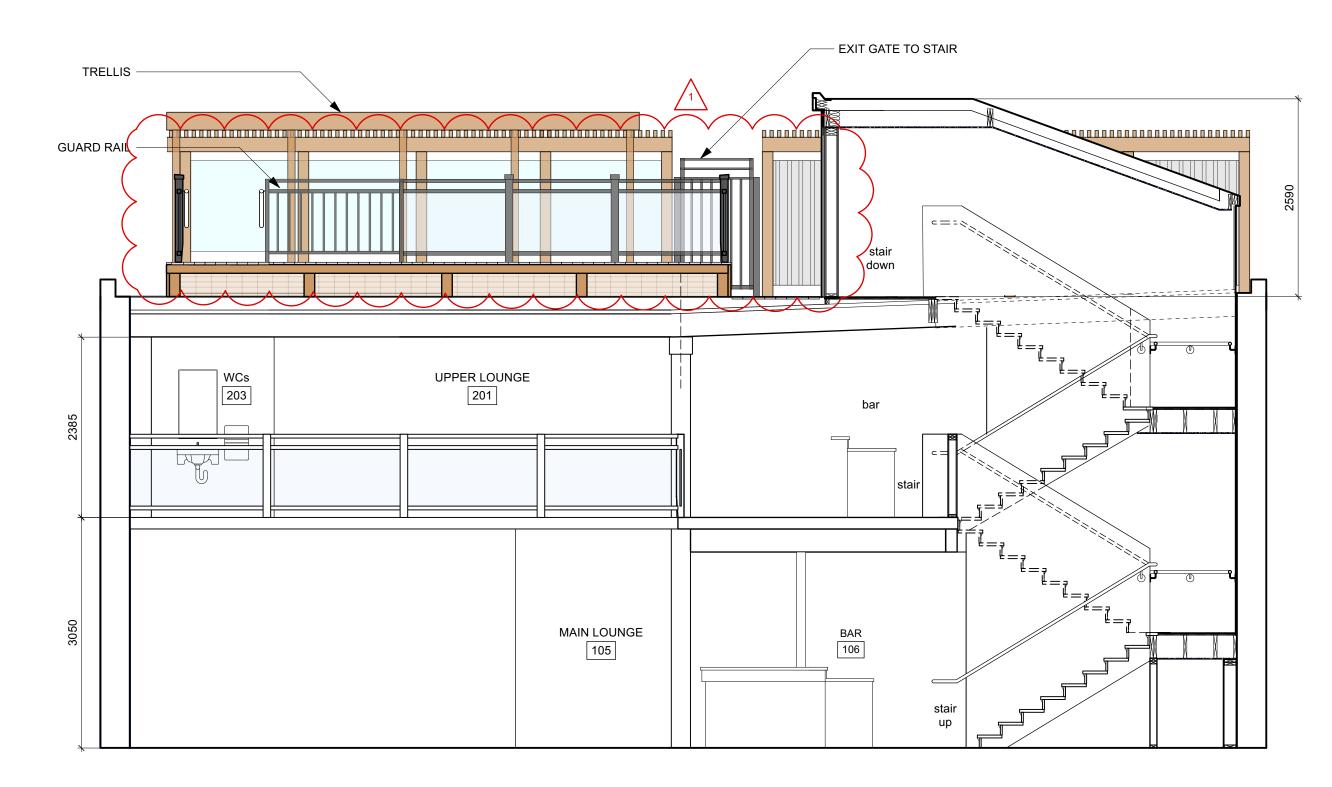

2 Building Section A501 Scale: 1:50

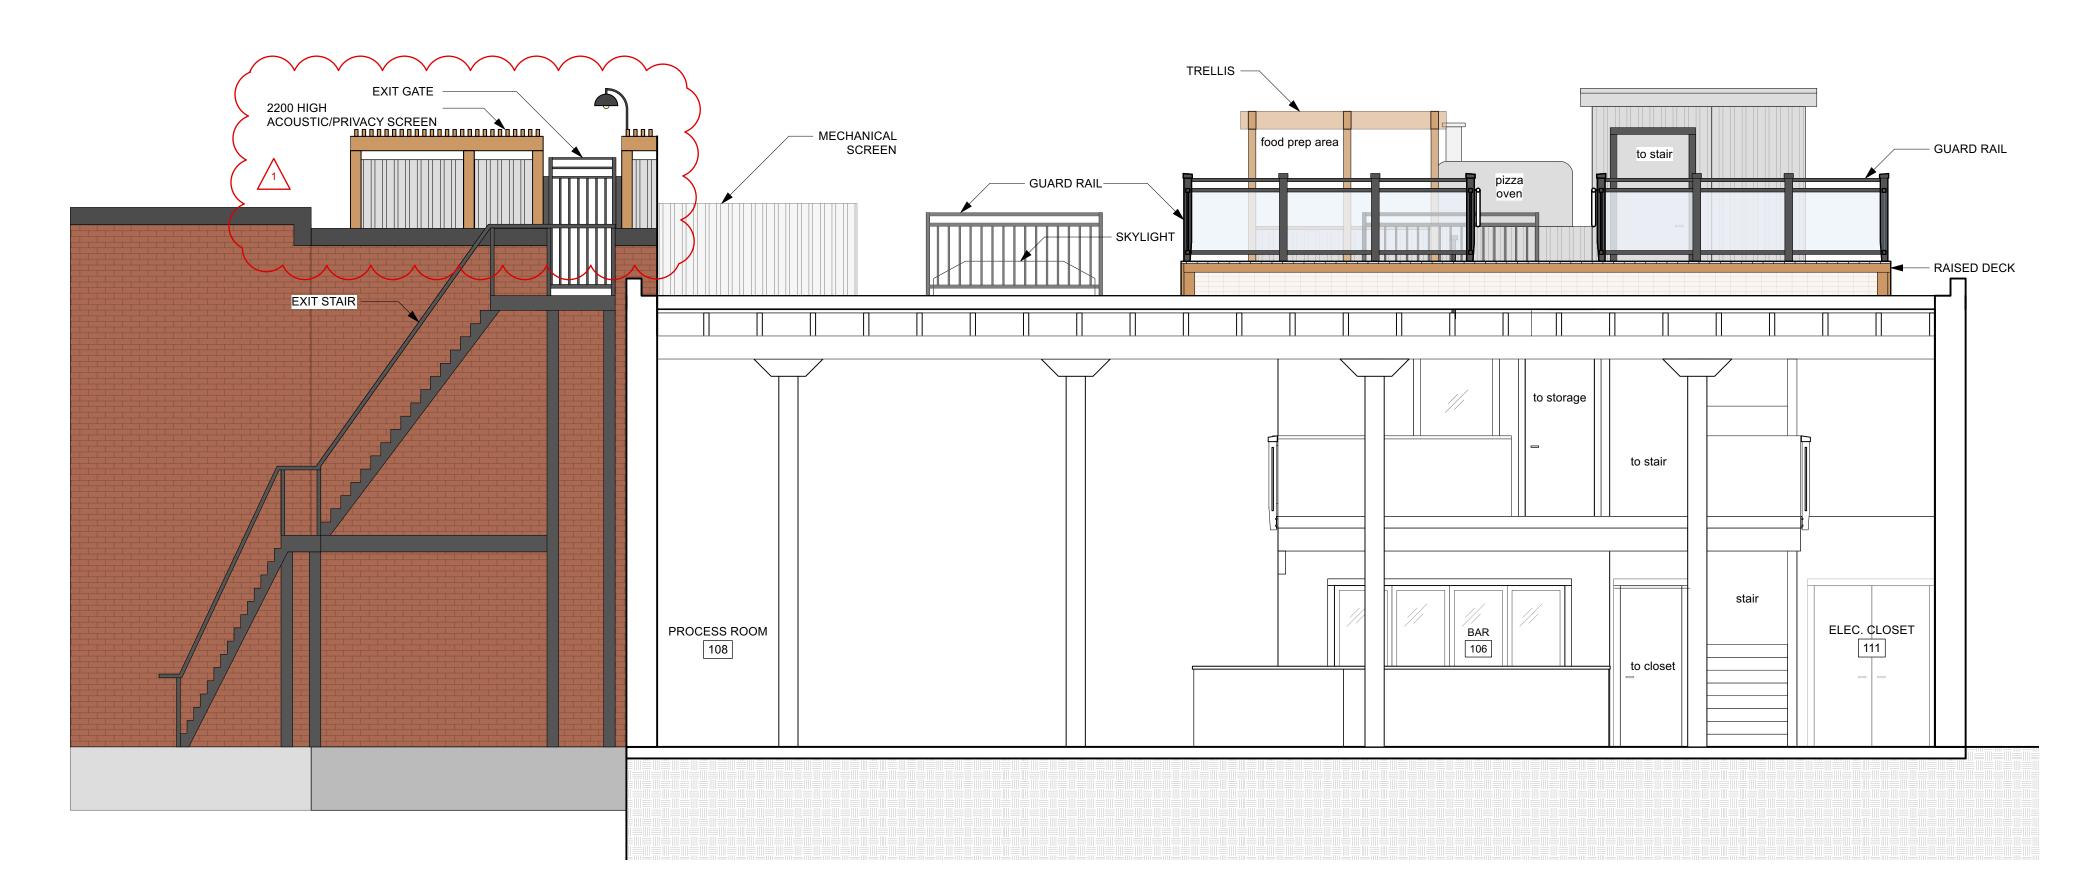



Sections

COPYRIGHT RESERVED. THESE PLANS AND DESIGNS ARE AND AT ALL TIMES REMAIN THE PROPERTY OF DE HOOG & KIERULF ARCHITECTS TO BE USED FOR THE PROJECT SHOWN AND MAY NOT BE REPRODUCED WITHOUT WRITTEN CONSENT

3

22 MARCH, 2021 - REVISIONS

Ironworks residential building.

2200 high screen with tempered glass, corrugated metal and wood posts added to the north side of the patio to provide acoustic and visual screening to the adjacent

3 Building Section A501 Scale: 1:50

