Contacts

#302 - 740 Hillside Ave. Victoria, BC V8T 1Z4

Registered Owner Jawl Development Corp. Robert K Jawl (as agent for Jawl YC Holdings) #200 - 1515 Douglas St. tel: 250-475-0338 Victoria, BC V8W 2G4 Architect DAU Studio Erica Sangster tel: 250-384-2400 2960 Jutland Rd. Victoria, BC V8T 5K2 Landscape Architect MDI Landscape Architecture Inc. Tamara Bonnemaison 3388A Tennyson Ave. tel: 250-384-2400 Victoria, BC V8Z 3P6 Civil Consultant Jeff Somerville #301 - 3600 Uptown Blvd. Victoria, BC V8Z 0B9 tel: 250-389-8068 Structural Reed Jones Christoffersen Ltd. Clint Plett #330 - 1515 Douglas St. tel: 778-746-1125 Victoria, BC V8W 2G4 Mechanical Erica Mak #210 - 1515 Douglas St. tel: 250-418-1288 Victoria, BC V8W 2G4 Electrical Introba Shayne Knox #210 - 1515 Douglas St. tel: 250-418-1288 Victoria, BC V8W 2G4 **Transportation Consultant**

tel: 250-388-9877

List of Drawings

Architectural

DAU Studio 2960 Jutland Rd. Victoria, BC V8T 5K2

A2.10 Level 6 Floor Plan

A2.12 Roof Plan

A2.10a Levels 7-19 Floor Plans

A3.1 West Building ElevationA3.2 West Building ElevationA3.3 West Building Elevation

A3.4 West Building Elevation

A3.5 East Building Elevations

A4.2 Building Sections

A4.1 Building Sections & Ramp Section

A2.11 Penthouse Floor Plan

A0.00 Cover Sheet A1.0 Project Data & Context Aerial Photo A1.1 Project Development & Alternative Massing A1.2 Rendered Views A1.3 Context Elevations A1.4 Solar Studies A1.5 Public Realm Shadow Impact Study A2.1 Site Plan and Project Data A2.2 Level P3 Plan A2.3 Level P2 Plan A2.4 Level P1 Plan A2.5 Level 1 Ground Floor Plan A2.6 Level 2 Floor Plan A2.7 Level 3 Floor Plan A2.8 Level 4 Floor Plan A2.9 Level 5 Floor Plan

Civil

Landscape

Victoria, BC V8Z 3P6

L0.00 Cover

MDI Landscape Architecture Inc. 3388A Tennyson Ave.

L0.01 General Information Sheet

L0.03 Stormwater Management

L1.01 Landscape Materials - L1

L1.03 Landscape Materials - L4

L1.02 Landscape Materials - L2 & L3

L2.01 Landscape Grading and Drainage

L0.02 Tree Replacement

L3.01 Planting - L1

L3.03 Planting - L4

L3.02 Planting - L2 & L3

WSP #301 - 3600 Uptown Blvd. Victoria, BC V8Z 0B9

C001	Site Plan & General Note
C002	Demolition Plan
C003	Surface Works
C004	Hydrant Locations



architecture + urbanism

2960 Jutland Road Victoria BC Canada V8T 5K2


250.384.2400 mail@daustudio.ca www.daustudio.ca

owned and operated by FM D'AMBROSIO architect Inc.



1101 Yates Mixed-Use Development

1101 Yates Street, Victoria BC

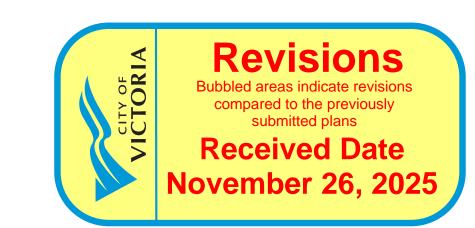

Resubmitted for Rezoning & Development Permit
November 20, 2025

Set with Revision Annotations

Project Information	n Summary	
	m2	sq.ft.
Site area	4,152	44,692
CRU / restaurant area (L1)	234	2,519
Residential Lobbies (L1)	117	1,259
Childcare floor area (L1)	400	4,306
Office Lobby (L1)	170	1,830
Meeting Facility (L1)	783	8,428
Circulation & service space (L1)	361	3,886
Office floor area (1/2-8)	3,100	~~~~~~~~~~~~~~~~~~~~~~~~~~~~~~~~~~~~~~
Residential floor area (L2-19)	11,887	127,951
Circulation & service space (L2-PH)	2,628	28,288
Total floor area	19,900	214,202
Floor Space Ratio	4.79	
Total number of residential units	175	
Number of storeys	19 & 5	
Total bylaw parking count	233	
Total parking provided*	192	
Proposed parking variance	41	
Total long term bicycle parking	261	
Total short term bicycle parking	52	

information on the parking variance rationale.

(m2) (m2) (m2) 1 1,273 - 289 1,5 Mezz - - 146 1 2 1,542 - 183 1,7 3 1,558 - 84 1,6 4 - 549 193 7 5 - 626 110 7 6 - 626 110 7 7 - 626 110 7 8 - 626 110 7 9 - 626 110 7 10 - 626 110 7 11 - 626 110 7 13 - 626 110 7 14 - 626 110 7 15 - 626 110 7 15 - 626 110 7 15 -	Floor Ar	ea - WEST BUILD	DING		
		-			736
	16 17	-	626	110	736 736

626 110 180 4,373 9,942 2,730

110

17,045

*Includes L1 Office/Meeting Facility Lobby & L2 Eleva	ator Lobby
**Includes L2 Elevator Lobby & L4 Amenity Space	


Penthouse


Subtotal

Total Floor Area

Level	Commercial	Residential	Serv./Circ.	Total Floor Area
	(m2)	(m2)	(m2)	(m2)
1	411	-	72	48
2	-	409	86	49
3	-	409	86	49
4	-	409	86	49
5	-	409	86	49
6	-	309	84	39
Subtotal	411	1,945	499	

Floor Space Ratio - EAST & WEST BUILDINGS	
Total Residential Area (m2)	11,887
Total Commercial Area (m2)	4,784
Total Serv./Circ. Area (m2)	3,229
Total Floor Area (m2)	19,900
Site Area (m2)	4,15
F.S.R.	4.7

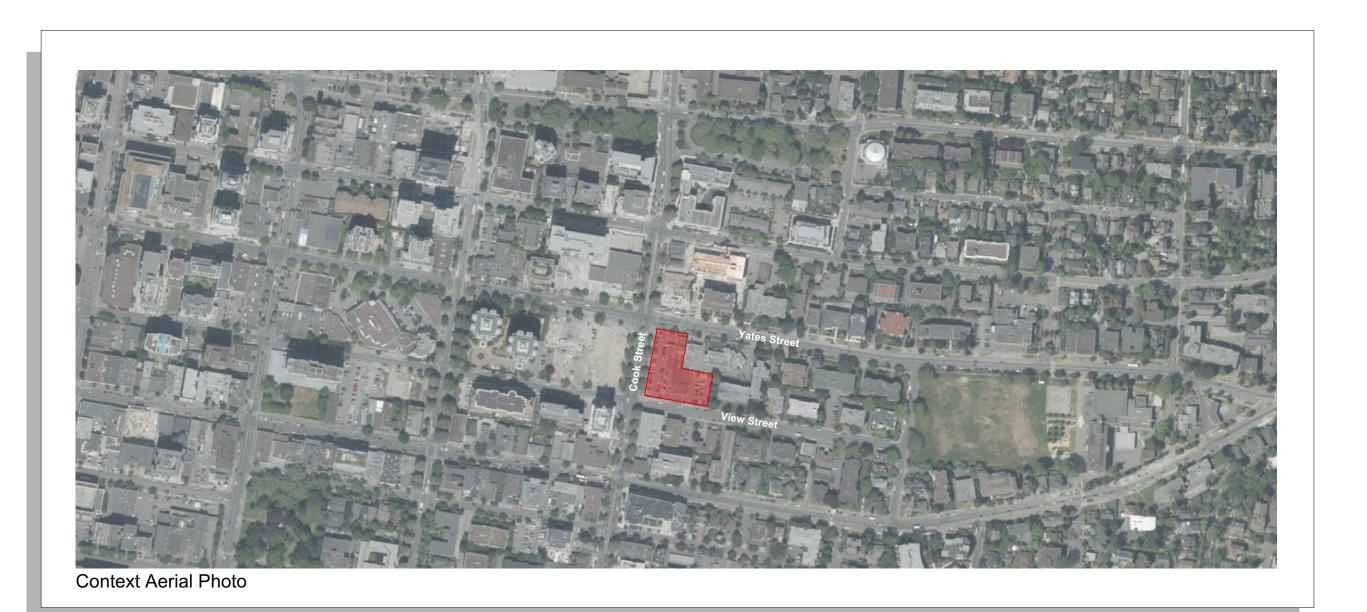

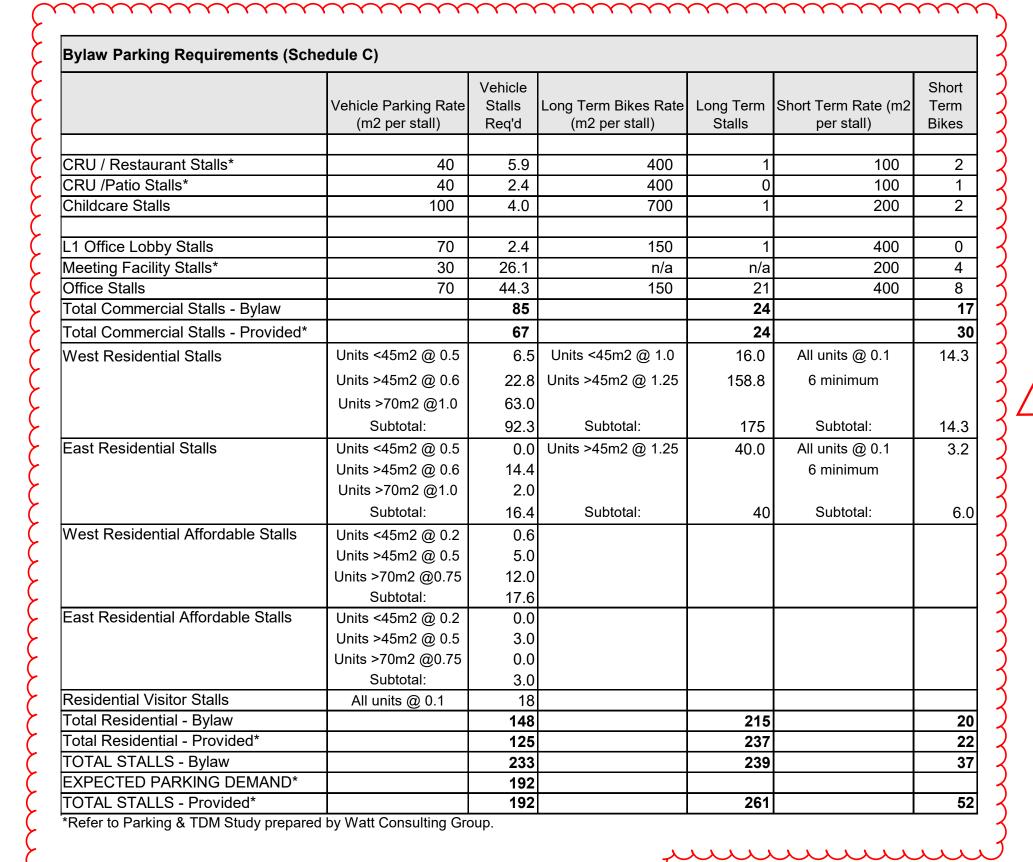

Accessible Parking Stalls (Schedule C)						
	Rate	Car Stalls	Van Stalls			
General Car Accessible Stalls	1 per 25 stalls	8.6				
Visitor Car Accessible Stalls	0 per 6-25 stalls	0.0				
General Van Accessible Stalls	2 of required		2*			
Visitor Van Accessible Stalls 1 per 6-25 stalls 1						
TOTAL ACCESSIBLE STALLS			10			

* Included in required accessible stalls.

Residential One 1BR an				cessible (20%)			EAST BUI 5 are acce	ssible (20%	5)
	STUDIO < 45m2	1BR > 45m2	1BR+DEN > 45m2	2BR > 70m2	3BR > 70m2		1BR > 45m2	2BR > 45m2	2BR > 70m2	3 > 7
Level						Level				
						2	6	1	0	
						3	6	1	0	
4	1	2	1	2	2	4	6	1	0	
5	1	2	1	3	2	5	6	1	0	
6	1	2	1	3	2	6	2	0	1	
7	1	2	1	3	2					
3	1	2	1	3	2					
9	1	2	1	3	2					
10	1	2	1	3	2					
11	1	2	1	3	2					
12	1	2	1	3	2					
13	1	2	1	3	2					
14	1	2	1	3	2					
15	1	2	1	3	2					
16	1	2	1	3	2					
17	1	2	1	3	2					
18	1	2	1	3	2					
19	1	2	1	3	2					
Subtotal	16	32	16	47	32	Subtotal	26	4	1	
2 2.310101	11%	22%	11%	33%	22%		81%	13%	3%	3
Total Units	1173		1170	0070	143	Total Unit				;

	U		U	U
3	6	1	0	0
4	6	1	0	0
5	6	1	0	0
6	2	0	1	1
Subtotal	26	4	1	1
	81%	13%	3%	3%
Total Unit	S			32

1	
·····	~~~
TOTAL UNITS:	175

-	STUDIO	1BR	1BR+DEN	2B
1	16	58	16	52
	9%	33%	9%	309
	Jun	س	س	V

3BR 33

19%

West Building Affordable Units Area (m2) No. Units

West Building Affordable Units: Studio: 506-W, 706-W, 1006-W, 1-BDR: 404-W*, 409-W, 609-W, 709-W, 809-W, 909-W, 1104-W*

1-BDR + Den: 501-W, 601-W, 701-W 2-BDR: 503-W, 603-W, 703-W, 805-W*, 808-W, 903-W, 905-W*, 1003-W, 1103-W 2-BDR + Den: 407-W, 507-W, 607-W

3-BDR: 402-W, 802-W, 902-W, 1002-W

East Building Affordable Units: 1-BDR: 207-E*, 301-E*, 303-E, 403-E, 405-E 2-BDR: 202-E

* Denotes accessible homes

East Building Affordable Units

rea (m2) No. Units



owned and operated by FM D'AMBROSIO architect Inc.

2025-11-21

THIS DOCUMENT HAS BEEN ELECTRONICALLY CERTIFIED WITH DIGITAL CERTIFICATE AND ENCRYPTION TECHNOLOGY AUTHORIZED BY THE AIBC. THE AUTHORITATIVE ORIGINAL IS IN ELECTRONIC FORM. ANY PRINTED VERSION CAN BE RELIED UPON AS A TRUE COPY OF THE ORIGINAL WHEN SUPPLIED BY DAUSTUDIO, BEARING IMAGES OF THE PROFESSIONAL SEAL AND DIGITAL CERTIFICATE OR WHEN PRINTED FROM THE DIGITALLY CERTIFIED ELECTRONIC FILE.

General Notes:

1. These preliminary plans are subject to refinement and confirmation of City policy and existing site conditions.

2. Refer to Landscape Architectural Plan for information on hardscaping, plantings and landscape site elements.

3. The proposed frontages within the public right-of-way are subject to coordination with the City of Victoria.

Revision Key:

1. Building height revisions (West Tower revised to 19 stories, East Tower revised to 6 stories) and associated project data updates. Note FSR is included to 2 decimal places per Zoning Plan Check comments.

2. Updates to bylaw parking counts for adjusted floor areas and to address Application Review Comments (Bike parking and accessible parking counts).

3. Affordable homes allocated to achieve proportional distribution between the two buildings and reflecting the overall unit

RZ/DP Resubmission velopment Permit - ADP Rezoning & 25.08.05 Development Permit Development Tracker 25.06.24

copyright reserved. these drawings and designs are and at all times remain the property of DAUSTUDIO to be used for the project shown and may not be reproduced without written consent.

description

project name

1101 Yates St.

Victoria, BC

sheet title

Project Data Aerial Context Photo

drawing file 2441 - 1101 Yates - 250923

scale drawn by

date issued November 20, 2025 A1.0

DAUSTUDIO





THIS DOCUMENT HAS BEEN ELECTRONICALLY CERTIFIED WITH DIGITAL CERTIFICATE AND ENCRYPTION TECHNOLOGY AUTHORIZED BY THE AIBC. THE AUTHORITATIVE ORIGINAL IS IN ELECTRONIC FORM. ANY PRINTED VERSION CAN BE RELIED UPON AS A TRUE COPY OF THE ORIGINAL WHEN SUPPLIED BY DAUSTUDIO, BEARING IMAGES OF THE PROFESSIONAL SEAL AND DIGITAL CERTIFICATE OR WHEN PRINTED FROM THE DIGITALLY CERTIFIED ELECTRONIC FILE.

General Notes:

 These preliminary plans are subject to refinement and confirmation of City policy and existing site conditions.


Refer to Landscape Architectural Plan for information on hardscaping, plantings and landscape site elements.


The proposed frontages within the public right-of-way are subject to coordination with the City of Victoria.

Revision Key:

1. Building height revisions (West Tower revised to 19 stories, East Tower revised to 6 stories).

 \sim

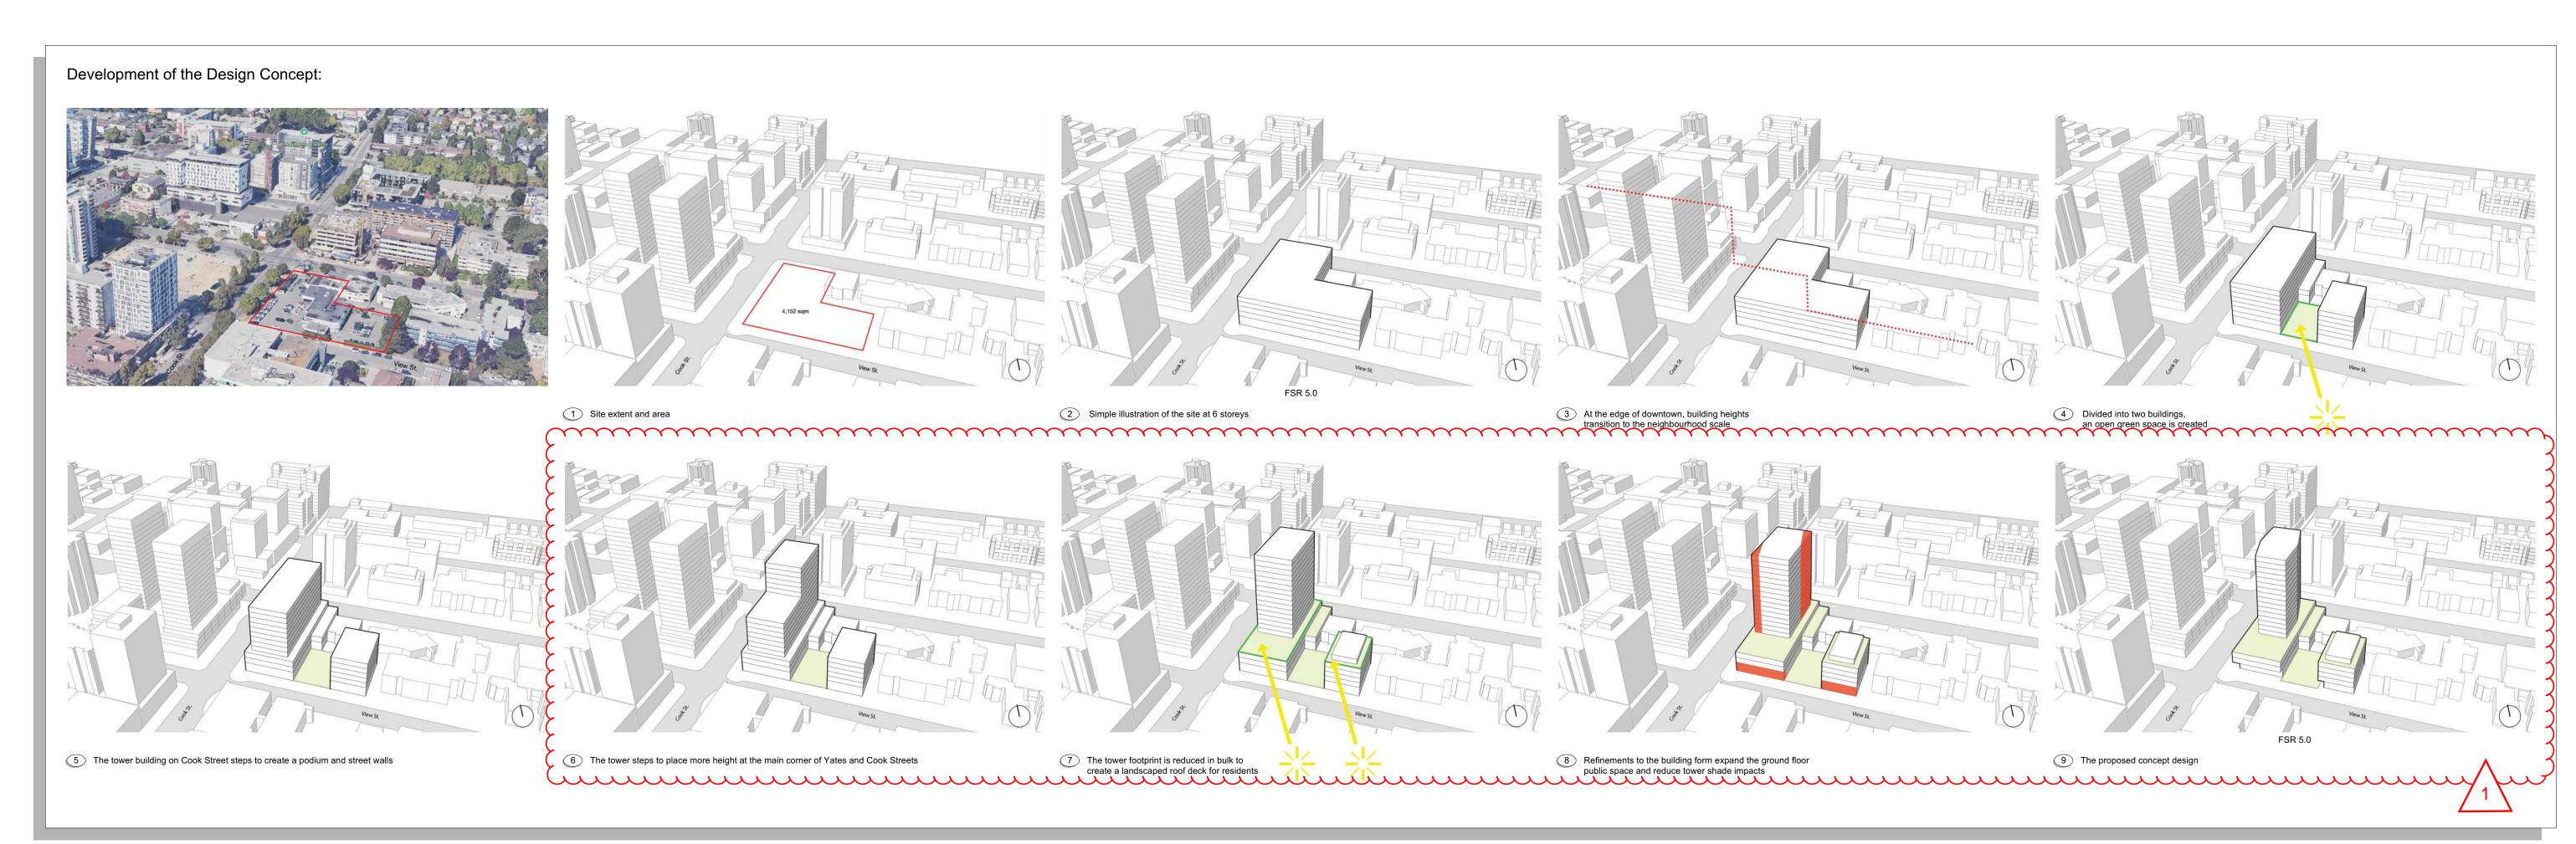

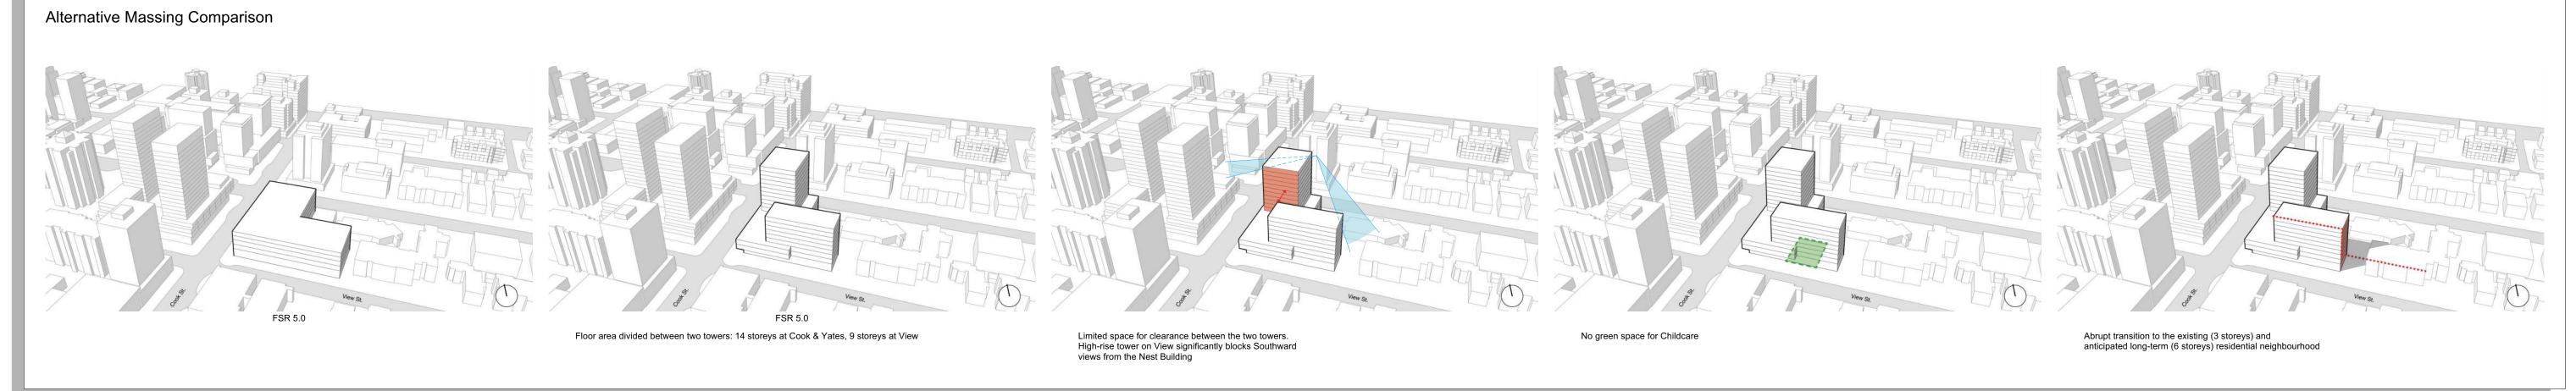

4	RZ/DP Resubmission	25.11.20
<u>/</u> 3\	Rezoning & Development Permit - ADP	25.10.02
2	Rezoning & Development Permit	25.08.05
1	Development Tracker	25.06.24
v no	description	date

copyright reserved. these drawings and designs are and at all times remain the property of DAUSTUDIO to be used for the project shown and may not be reproduced without written consent.

project name

1101 Yates St.

Victoria, BC

sheet title

Concept Development Massing Comparison

project no. 2441
drawing file 2441 - 1101 Yates - 250923
scale


drawn by

date issued sheet no.

November 20, 2025 **A1.1**




Rendered aerial from southeast

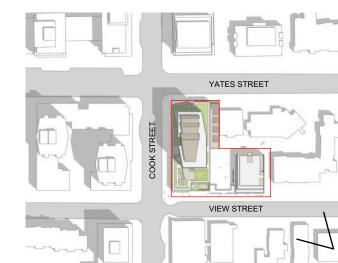



Rendered from corner of Yates and Cook

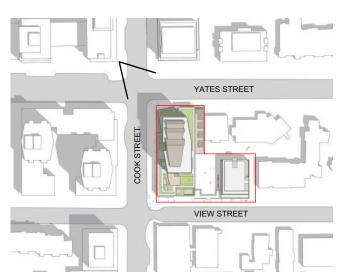




Rendered aerial from southeast



Rendered from corner of View and Cook

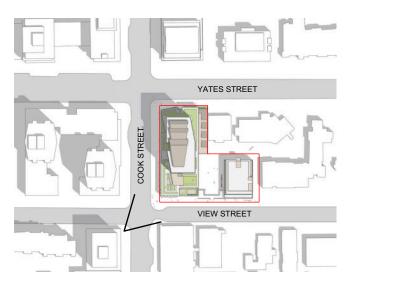

DAUSTUDIO

owned and operated by FM D'AMBROSIO architect Inc.


THIS DOCUMENT HAS BEEN ELECTRONICALLY CERTIFIED WITH DIGITAL CERTIFICATE AND ENCRYPTION TECHNOLOGY AUTHORIZED BY THE AIBC. THE AUTHORITATIVE ORIGINAL IS IN ELECTRONIC FORM. ANY PRINTED VERSION CAN BE RELIED UPON AS A TRUE COPY OF THE ORIGINAL WHEN SUPPLIED BY DAUSTUDIO, BEARING IMAGES OF THE PROFESSIONAL SEAL AND DIGITAL CERTIFICATE OR WHEN PRINTED FROM THE DIGITALLY CERTIFIED ELECTRONIC FILE.

General Notes:

 These preliminary plans are subject to refinement and confirmation of City policy and existing site conditions.


Refer to Landscape Architectural Plan for information on hardscaping, plantings and landscape site elements.

 The proposed frontages within the public right-of-way are subject to coordination with the City of Victoria.

Revision Key:

 1. Building height revisions (West Tower revised to 19 stories, East Tower revised to 6 stories).

mmmm

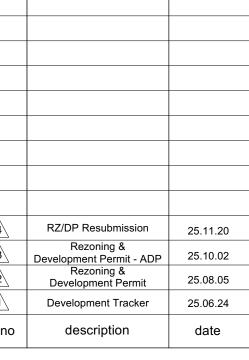

copyright reserved. these drawings and designs are and at all times remain the property of DAUSTUDIO to be used for the project shown and may not be reproduced without written consent.

project name

1101 Yates St.

Victoria, BC

viotoria,

Rendered Context Views


project no. 2441


drawing file 2441 - 1101 Yates - 250923


le wn by

date issued sheet no.

November 20, 2025 A1.2

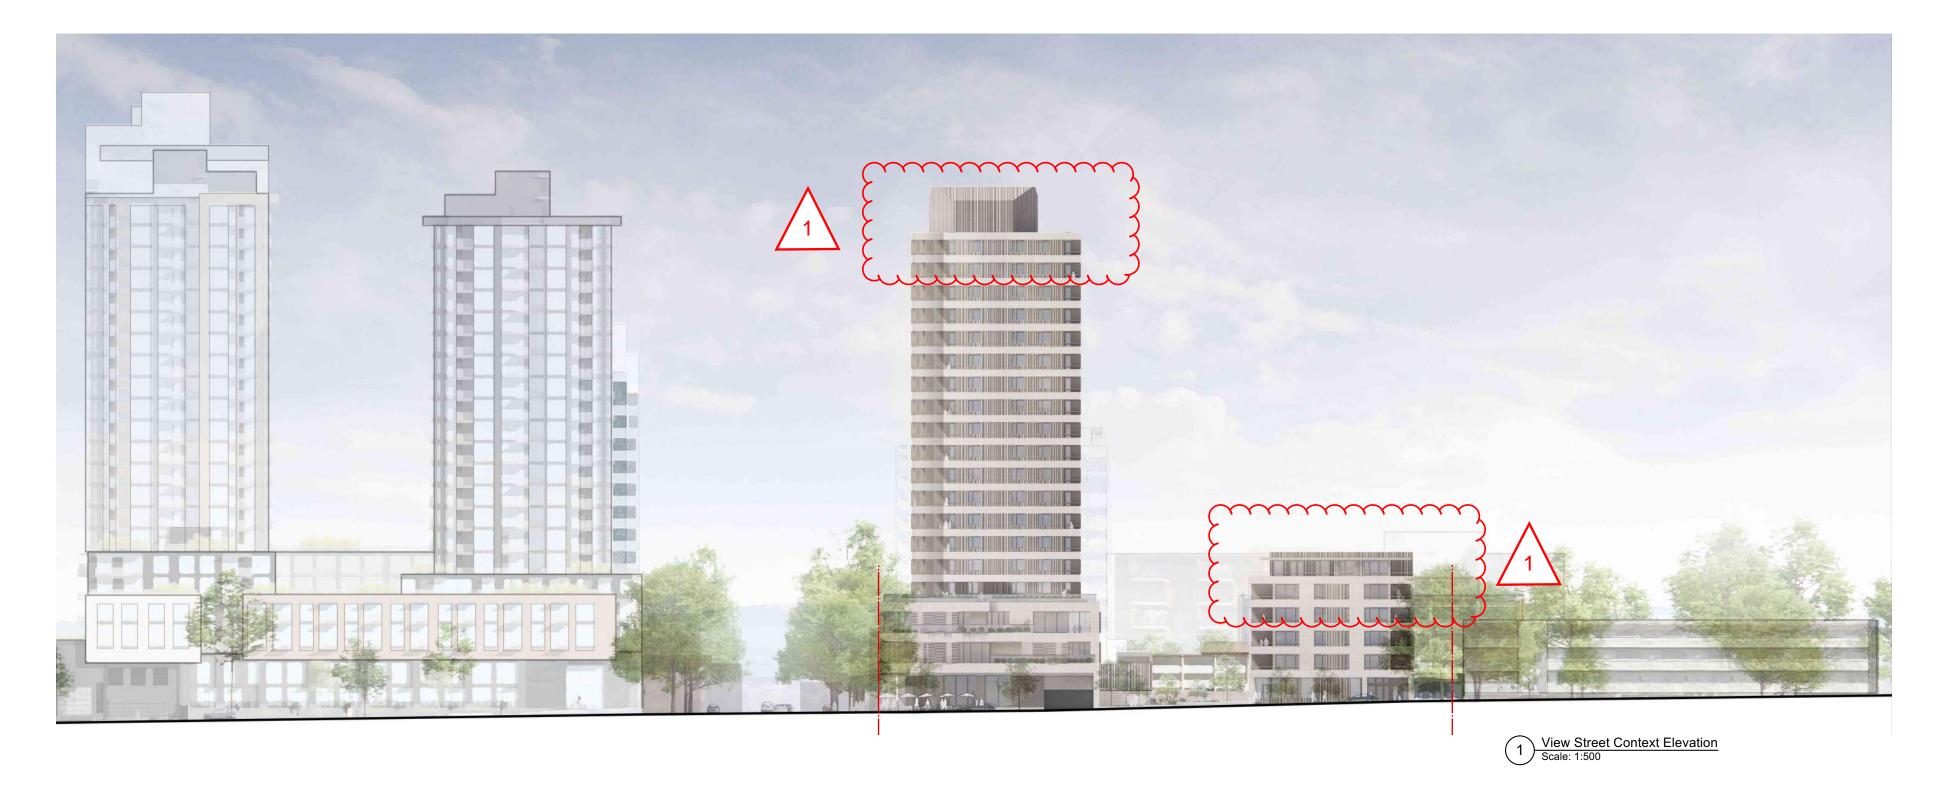

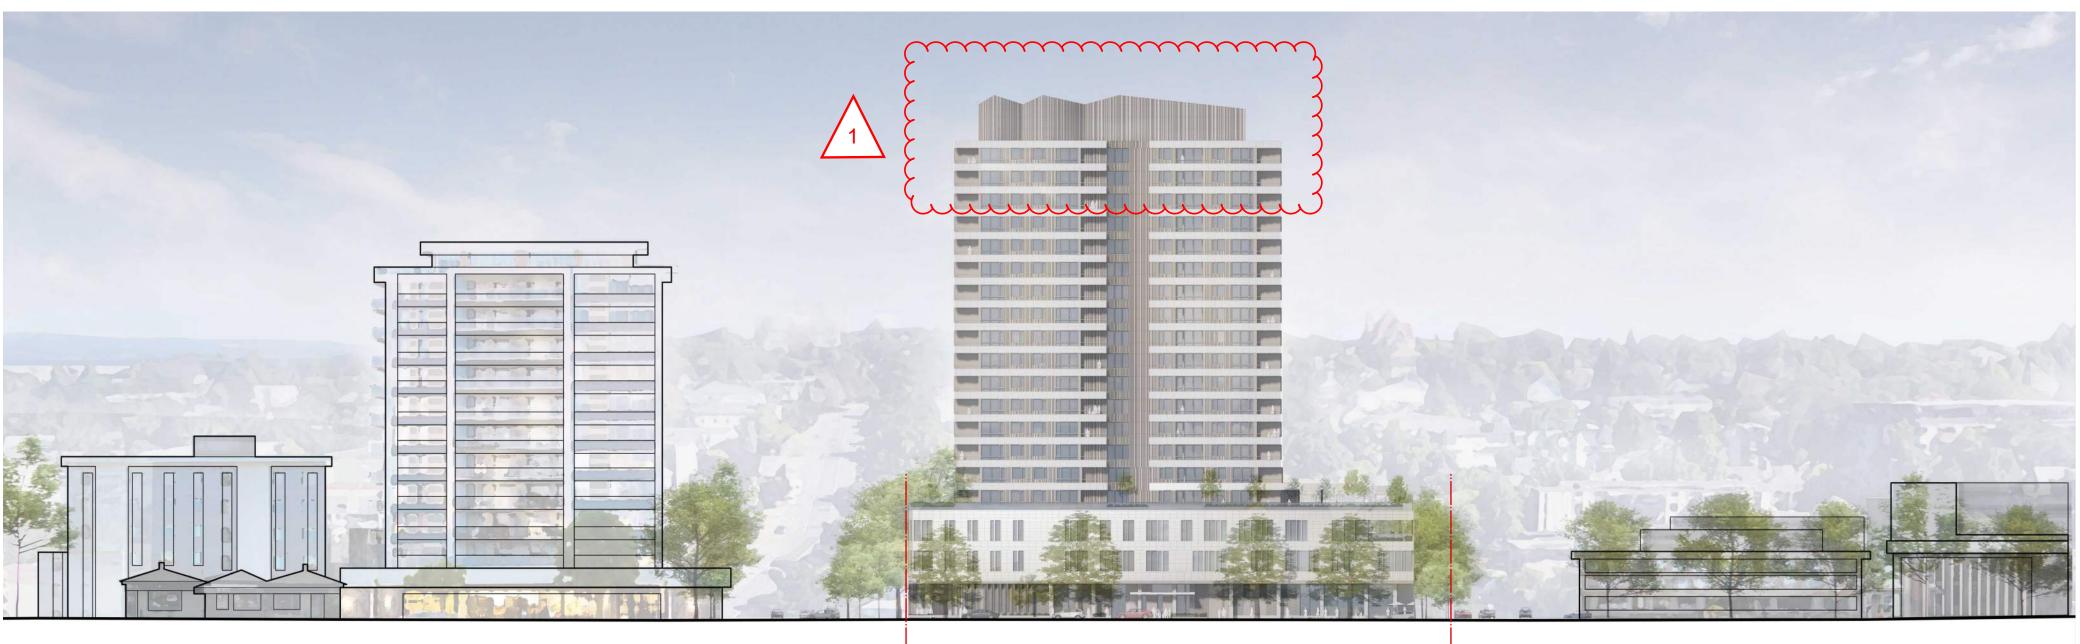

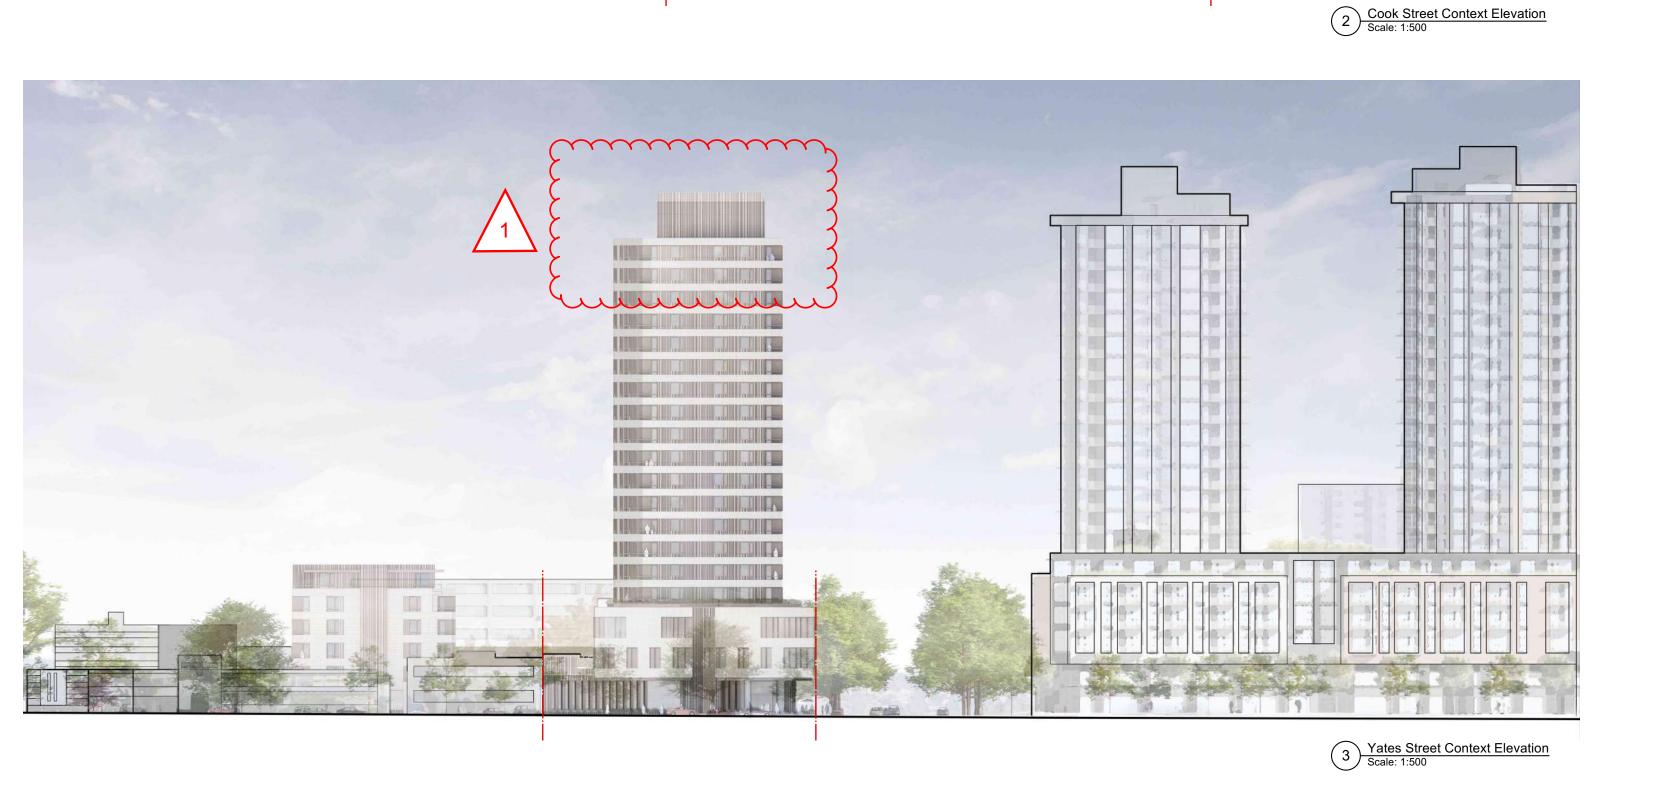

DAUSTUDIO

owned and operated by FM D'AMBROSIO architect Inc.

A SANGO ON THE SAN

THIS DOCUMENT HAS BEEN ELECTRONICALLY CERTIFIED WITH DIGITAL CERTIFICATE AND ENCRYPTION TECHNOLOGY AUTHORIZED BY THE AIBC. THE AUTHORITATIVE ORIGINAL IS IN ELECTRONIC FORM. ANY PRINTED VERSION CAN BE RELIED UPON AS A TRUE COPY OF THE ORIGINAL WHEN SUPPLIED BY DAUSTUDIO, BEARING IMAGES OF THE PROFESSIONAL SEAL AND DIGITAL CERTIFICATE OR WHEN PRINTED FROM THE DIGITALLY CERTIFIED ELECTRONIC FILE.

2025-11-21

General Notes:

These preliminary plans are subject to refinement and confirmation of City policy and existing site conditions.

Refer to Landscape Architectural Plan for information on hardscaping, plantings and landscape site elements.

3. The proposed frontages within the public right-of-way are subject to coordination with the City of Victoria.

Illustrations of anticipated building forms for developments at 1045 and 1050 Yates Street are based upon available information.

Revision Key:

1. Building height revisions (West Tower revised to 19 stories, East Tower revised to 6 stories).

 \sim

Cumming

4	RZ/DP Resubmission	25.11.20
<u>3</u>	Rezoning & Development Permit - ADP	25.10.02
2	Rezoning & Development Permit	25.08.05
1	Development Tracker	25.06.24
ev no	description	date
	1	1

copyright reserved. these drawings and designs are and at all times remain the property of DAUSTUDIO to be used for the project shown and may not be reproduced without written consent.

project name

1101 Yates St.

Victoria, BC

sheet title

Context Street Elevations

project no.	2441
drawing file 2441 - 1	101 Yates - 250923
scale	1:500
drawn by	JH
date issued	sheet no.
November 20, 2025	A1.3

Winter Solstice (December 21)







DAUSTUDIO

owned and operated by FM D'AMBROSIO architect Inc.



THIS DOCUMENT HAS BEEN ELECTRONICALLY CERTIFIED WITH DIGITAL CERTIFICATE AND ENCRYPTION TECHNOLOGY AUTHORIZED BY THE AIBC. THE AUTHORITATIVE ORIGINAL IS IN ELECTRONIC FORM. ANY PRINTED VERSION CAN BE RELIED UPON AS A TRUE COPY OF THE ORIGINAL WHEN SUPPLIED BY DAUSTUDIO, BEARING IMAGES OF THE PROFESSIONAL SEAL AND DIGITAL CERTIFICATE OR WHEN PRINTED FROM THE DIGITALLY CERTIFIED ELECTRONIC FILE.

General Notes

These preliminary plans are subject to refinement and confirmation of City policy and existing site conditions.

Refer to Landscape Architectural Plan for information on hardscaping, plantings and landscape site elements.

3. The proposed frontages within the public right-of-way are subject to coordination with the City of Victoria.

Povision Kov:

1. Building height revisions (West Tower revised to 19 stories, East Tower revised to 6 stories).


mmmm

Equinox (March / September 20)







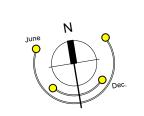

Summer Solstice (June 20)







ノ			
7			
3			
3	4	RZ/DP Resubmission	25.11.20
\mathcal{L}	<u></u>	Rezoning & Development Permit - ADP	25.10.02
7	2	Rezoning & Development Permit	25.08.05
3	<u> 1</u>	Development Tracker	25.06.24
3	rev no	description	date

main the property of DAUSTUDIO to be used for the project shown id may not be reproduced without written consent.

oroject name

1101 Yates St.

Victoria, BC

sheet title
Solar Studies


))						
\rangle)	project no.				24	41
$\left. \right\rangle$)	drawing file	2441 -	1101	Yates	- 2509	23
١	١	anala					

drawn by

date issued sheet no.

November 20, 2025 A1.4

Spring Equinox (March 20)

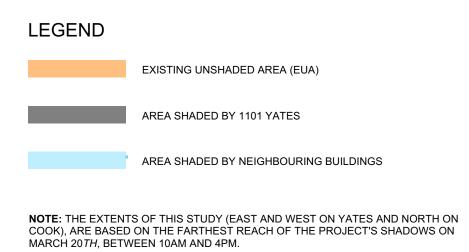



EUA on Yates St. = 1,734.7 sq m (100%)
Shadow Impact = 365.4 sq m (21%)
EUA on Cook St. = 666.1 sq m (100%)
Shadow Impact = 169.5 sq m (25%)



EUA on Yates St. = 1,735.9 sq m (100%) Shadow Impact = 164.3 sq m (9.5%)

EUA on Cook St. = 666.1 sq m (100%) Shadow Impact = 212.5 sq m (32%)





EUA on Yates St. = 1,735.9 sq m (100%) Shadow Impact = 370.9 sq m (21%)

EUA on Cook St. = 666.1 sq m (100%) Shadow Impact = 0.0 sq m (0%)




EUA on Yates St. = 1,735.9 sq m (100%) Shadow Impact = 498.4 sq m (29%)

EUA on Cook St. = 336.3 sq m (100%) Shadow Impact = 0.0 sq m (0%)



EUA on Yates St. = 1,735.9 sq m (100%) Shadow Impact = 498.6 sq m (29%)

EUA on Cook St. = 521.3 sq m (100%) Shadow Impact = 0.0 sq m (0%)

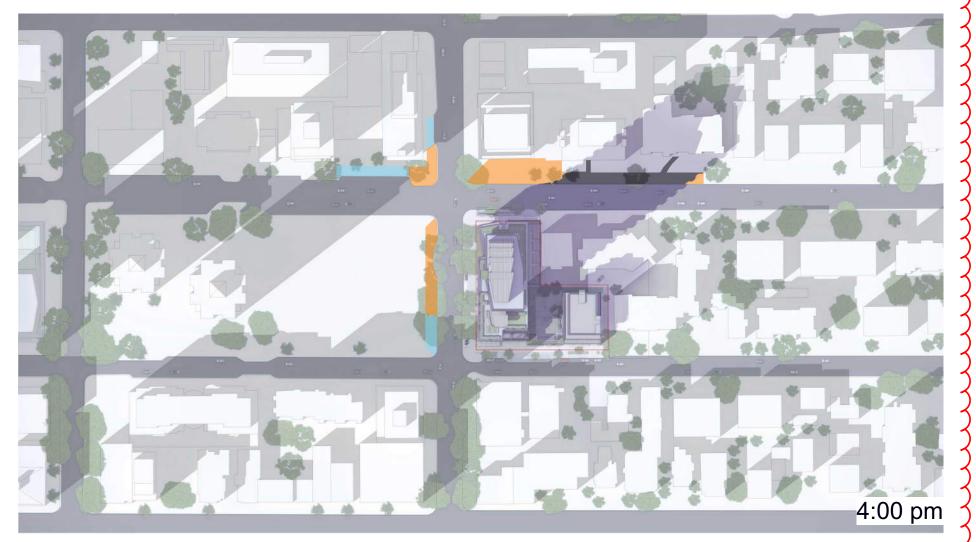

EUA on Yates St. = 1477.7 sq m (100%) Shadow Impact = 595.2 sq m (40%)

EUA on Cook St. = 458.0 sq m (100%) Shadow Impact = 0.0 sq m (0%)



DAUSTUDIO

owned and operated by FM D'AMBROSIO architect Inc.

THIS DOCUMENT HAS BEEN ELECTRONICALLY CERTIFIED WITH DIGITAL CERTIFICATE AND ENCRYPTION TECHNOLOGY AUTHORIZED BY THE AIBC. THE AUTHORITATIVE ORIGINAL IS IN ELECTRONIC FORM. ANY PRINTED VERSION CAN BE RELIED UPON AS A TRUE COPY OF THE ORIGINAL WHEN SUPPLIED BY DAUSTUDIO, BEARING IMAGES OF THE PROFESSIONAL SEAL AND DIGITAL CERTIFICATE OR WHEN PRINTED FROM THE DIGITALLY CERTIFIED ELECTRONIC FILE.

General Notes:

These preliminary plans are subject to refinement and confirmation of City policy and existing site conditions.


Refer to Landscape Architectural Plan for information on hardscaping, plantings and landscape site elements.

 The proposed frontages within the public right-of-way are subject to coordination with the City of Victoria.

Revision Key:

 1. Building height revisions (West Tower revised to 19 stories, East Tower revised to 6 stories).



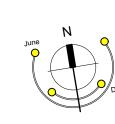

4	RZ/DP Resubmission	25.11.20
<u> </u>	Rezoning & Development Permit - ADP	25.10.02
2	Rezoning & Development Permit	25.08.05
1	Development Tracker	25.06.24
rev no	description	date
	served, these drawings and designs are a	

copyright reserved. these drawings and designs are and at all times remain the property of DAUSTUDIO to be used for the project shown and may not be reproduced without written consent.

1101 Yates St.


Victoria, BC

sheet title

Public Realm Shadow Impact Study

project no.				2441	
drawing file	2441 - 1	101 Y	'ates -	250923	
scale					
drawn by				JH	

November 20, 2025 A1.5

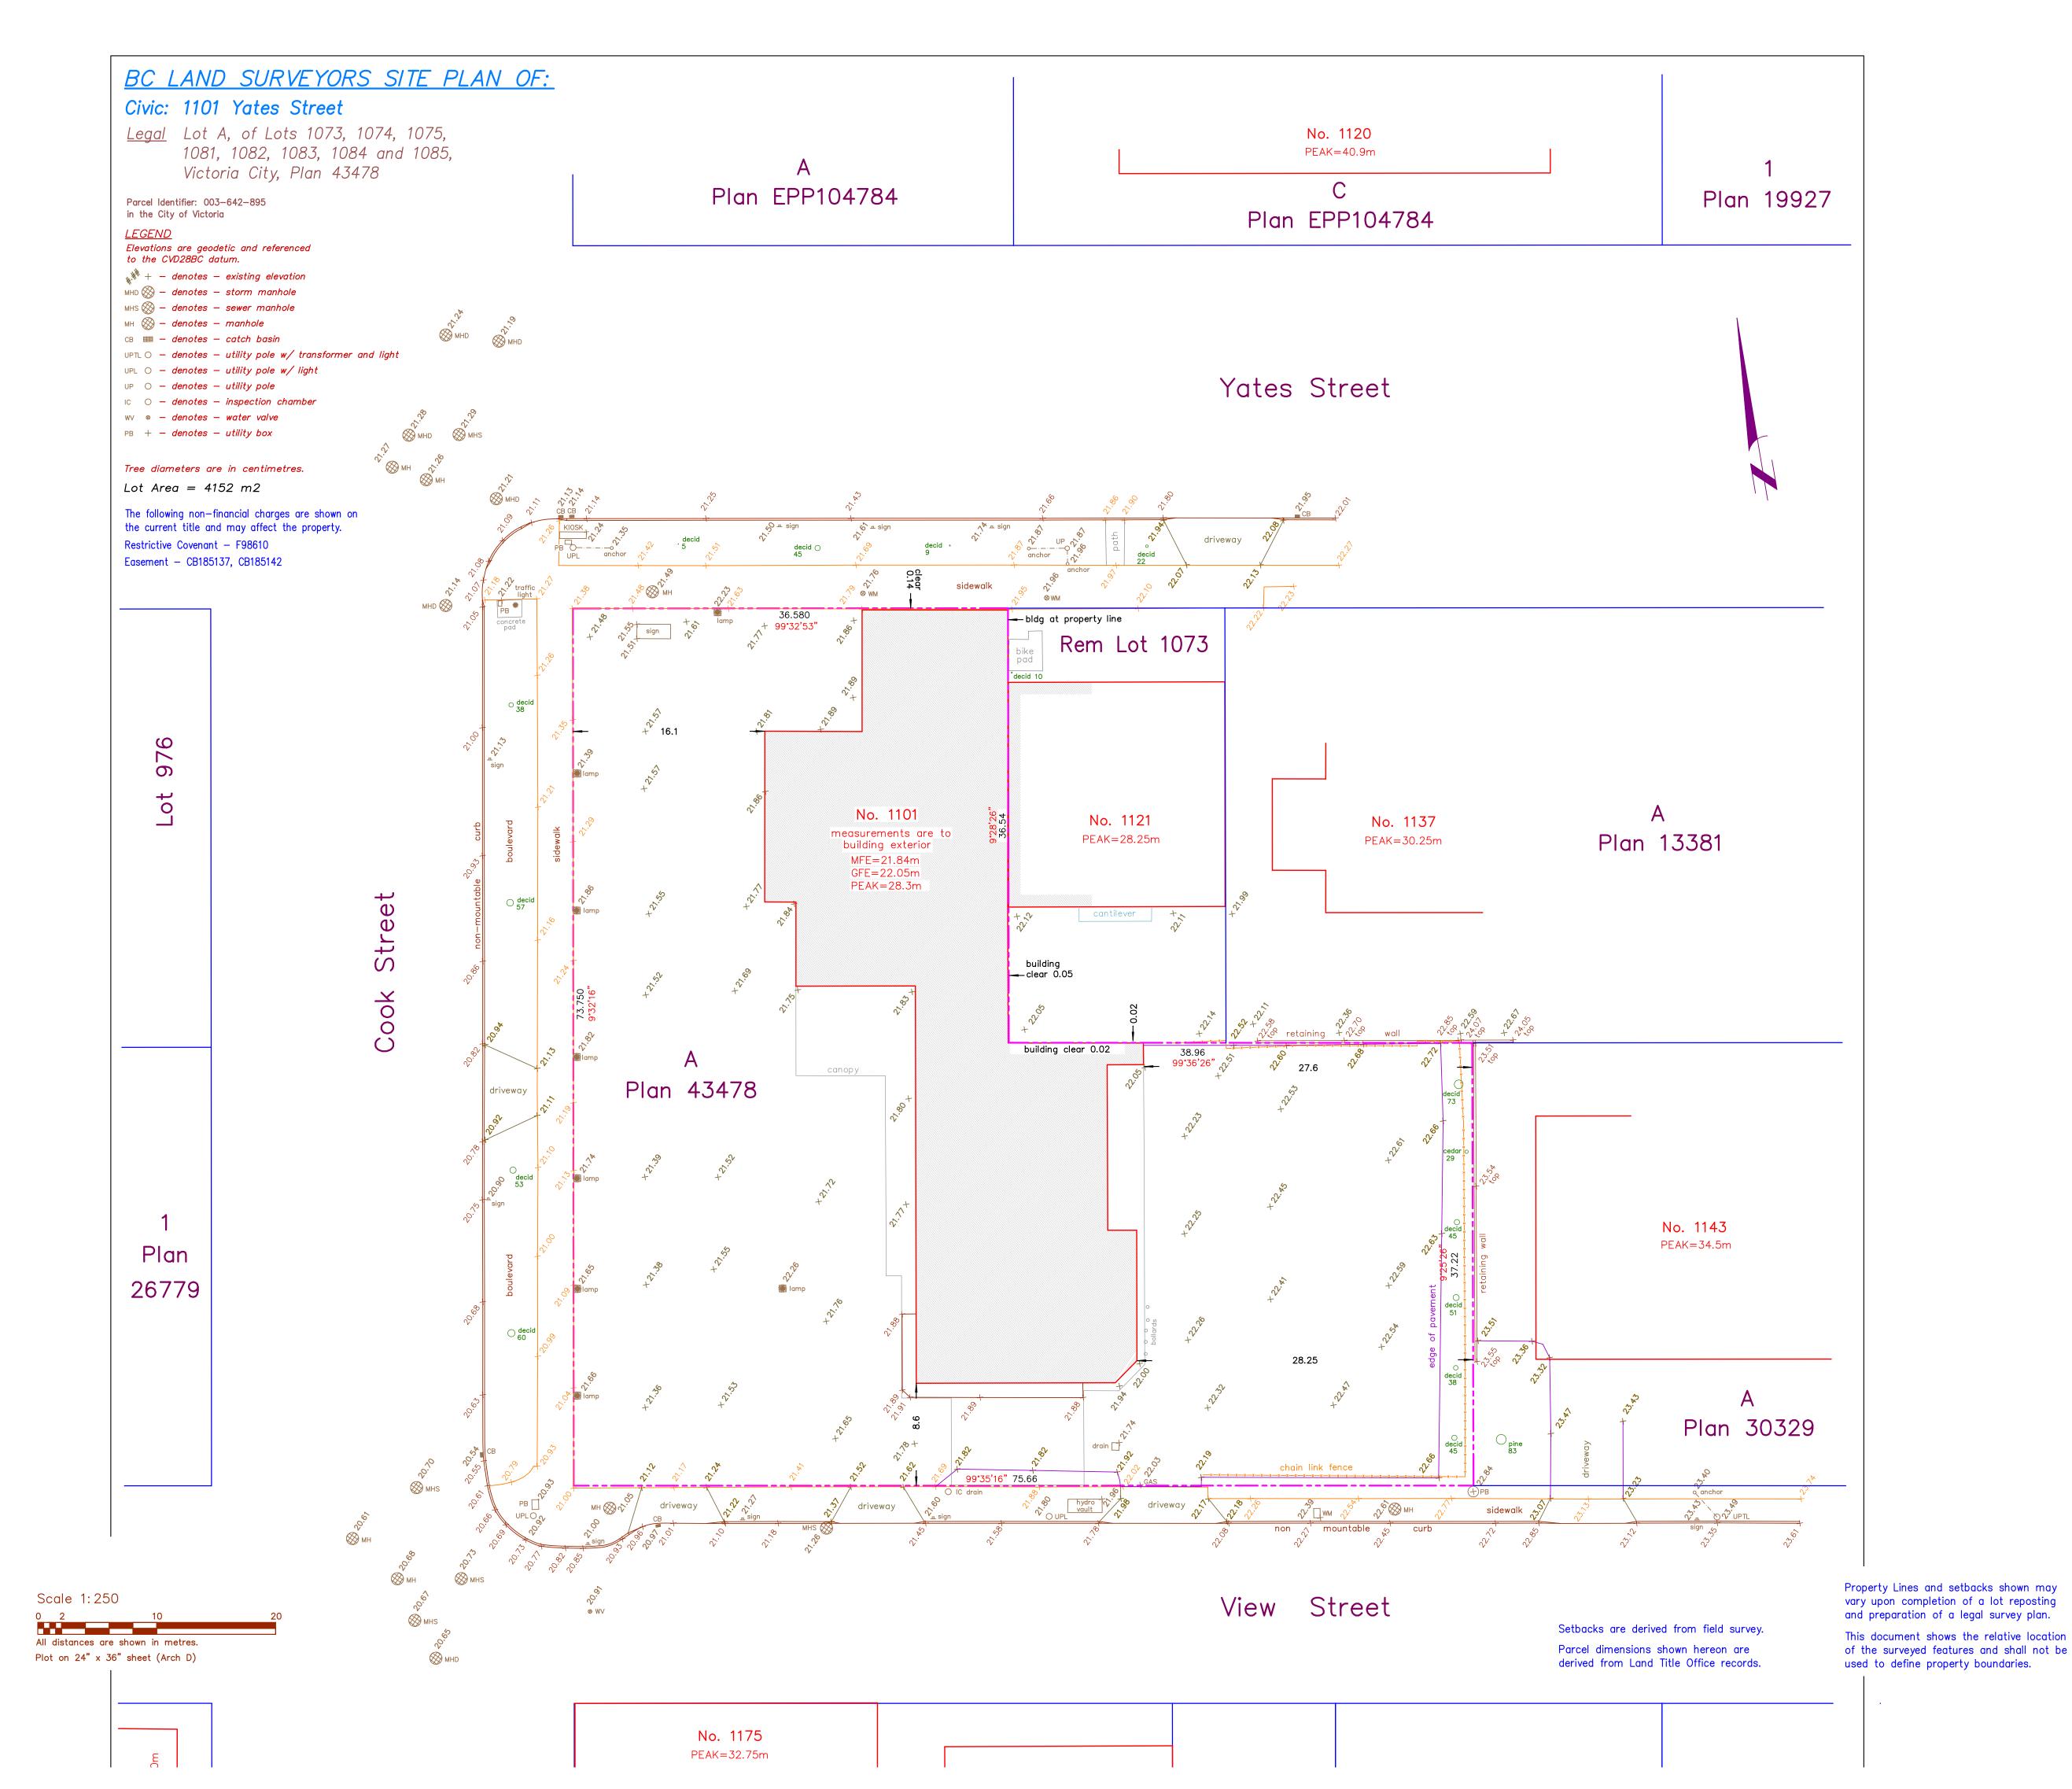

Date March 28, 2023

13959-16

POWELL & ASSOCIATES

BC Land Surveyors 250—2950 Douglas Street

Victoria, BC V8T 4N4

phone (250) 382-8855

DAUSTUDIO

owned and operated by FM D'AMBROSIO architect Inc.


THIS DOCUMENT HAS BEEN ELECTRONICALLY CERTIFIED WITH DIGITAL CERTIFICATE AND ENCRYPTION TECHNOLOGY AUTHORIZED BY THE AIBC. THE AUTHORITATIVE ORIGINAL IS IN ELECTRONIC FORM. ANY PRINTED VERSION CAN BE RELIED UPON AS A TRUE COPY OF THE ORIGINAL WHEN SUPPLIED BY DAUSTUDIO, BEARING IMAGES OF THE PROFESSIONAL SEAL AND DIGITAL CERTIFICATE OR WHEN PRINTED FROM THE DIGITALLY CERTIFIED ELECTRONIC FILE.

General Notes:

 These preliminary plans are subject to refinement and confirmation of City policy and existing site conditions.

Refer to Landscape Architectural Plan for information on hardscaping, plantings and landscape site elements.

The proposed frontages within the public right-of-way are subject to coordination with the City of Victoria.

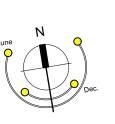

4	RZ/DP Resubmission	25.11.20
<u>/3\</u>	Rezoning & Development Permit - ADP	25.10.02
2	Rezoning & Development Permit	25.08.05
1	Development Tracker	25.06.24
ev no	description	date

copyright reserved. these drawings and designs are and at all times remain the property of DAUSTUDIO to be used for the project shown and may not be reproduced without written consent.

project name


1101 Yates St.

Victoria, BC

sheet title

Site Survey (Existing Site Plan)

	,
project no.	2441
drawing file 2441 - 1101 Yates - 250923	
scale 1:200	
drawn by	JH
date issued	sheet no.
November 20, 2025	A2.0

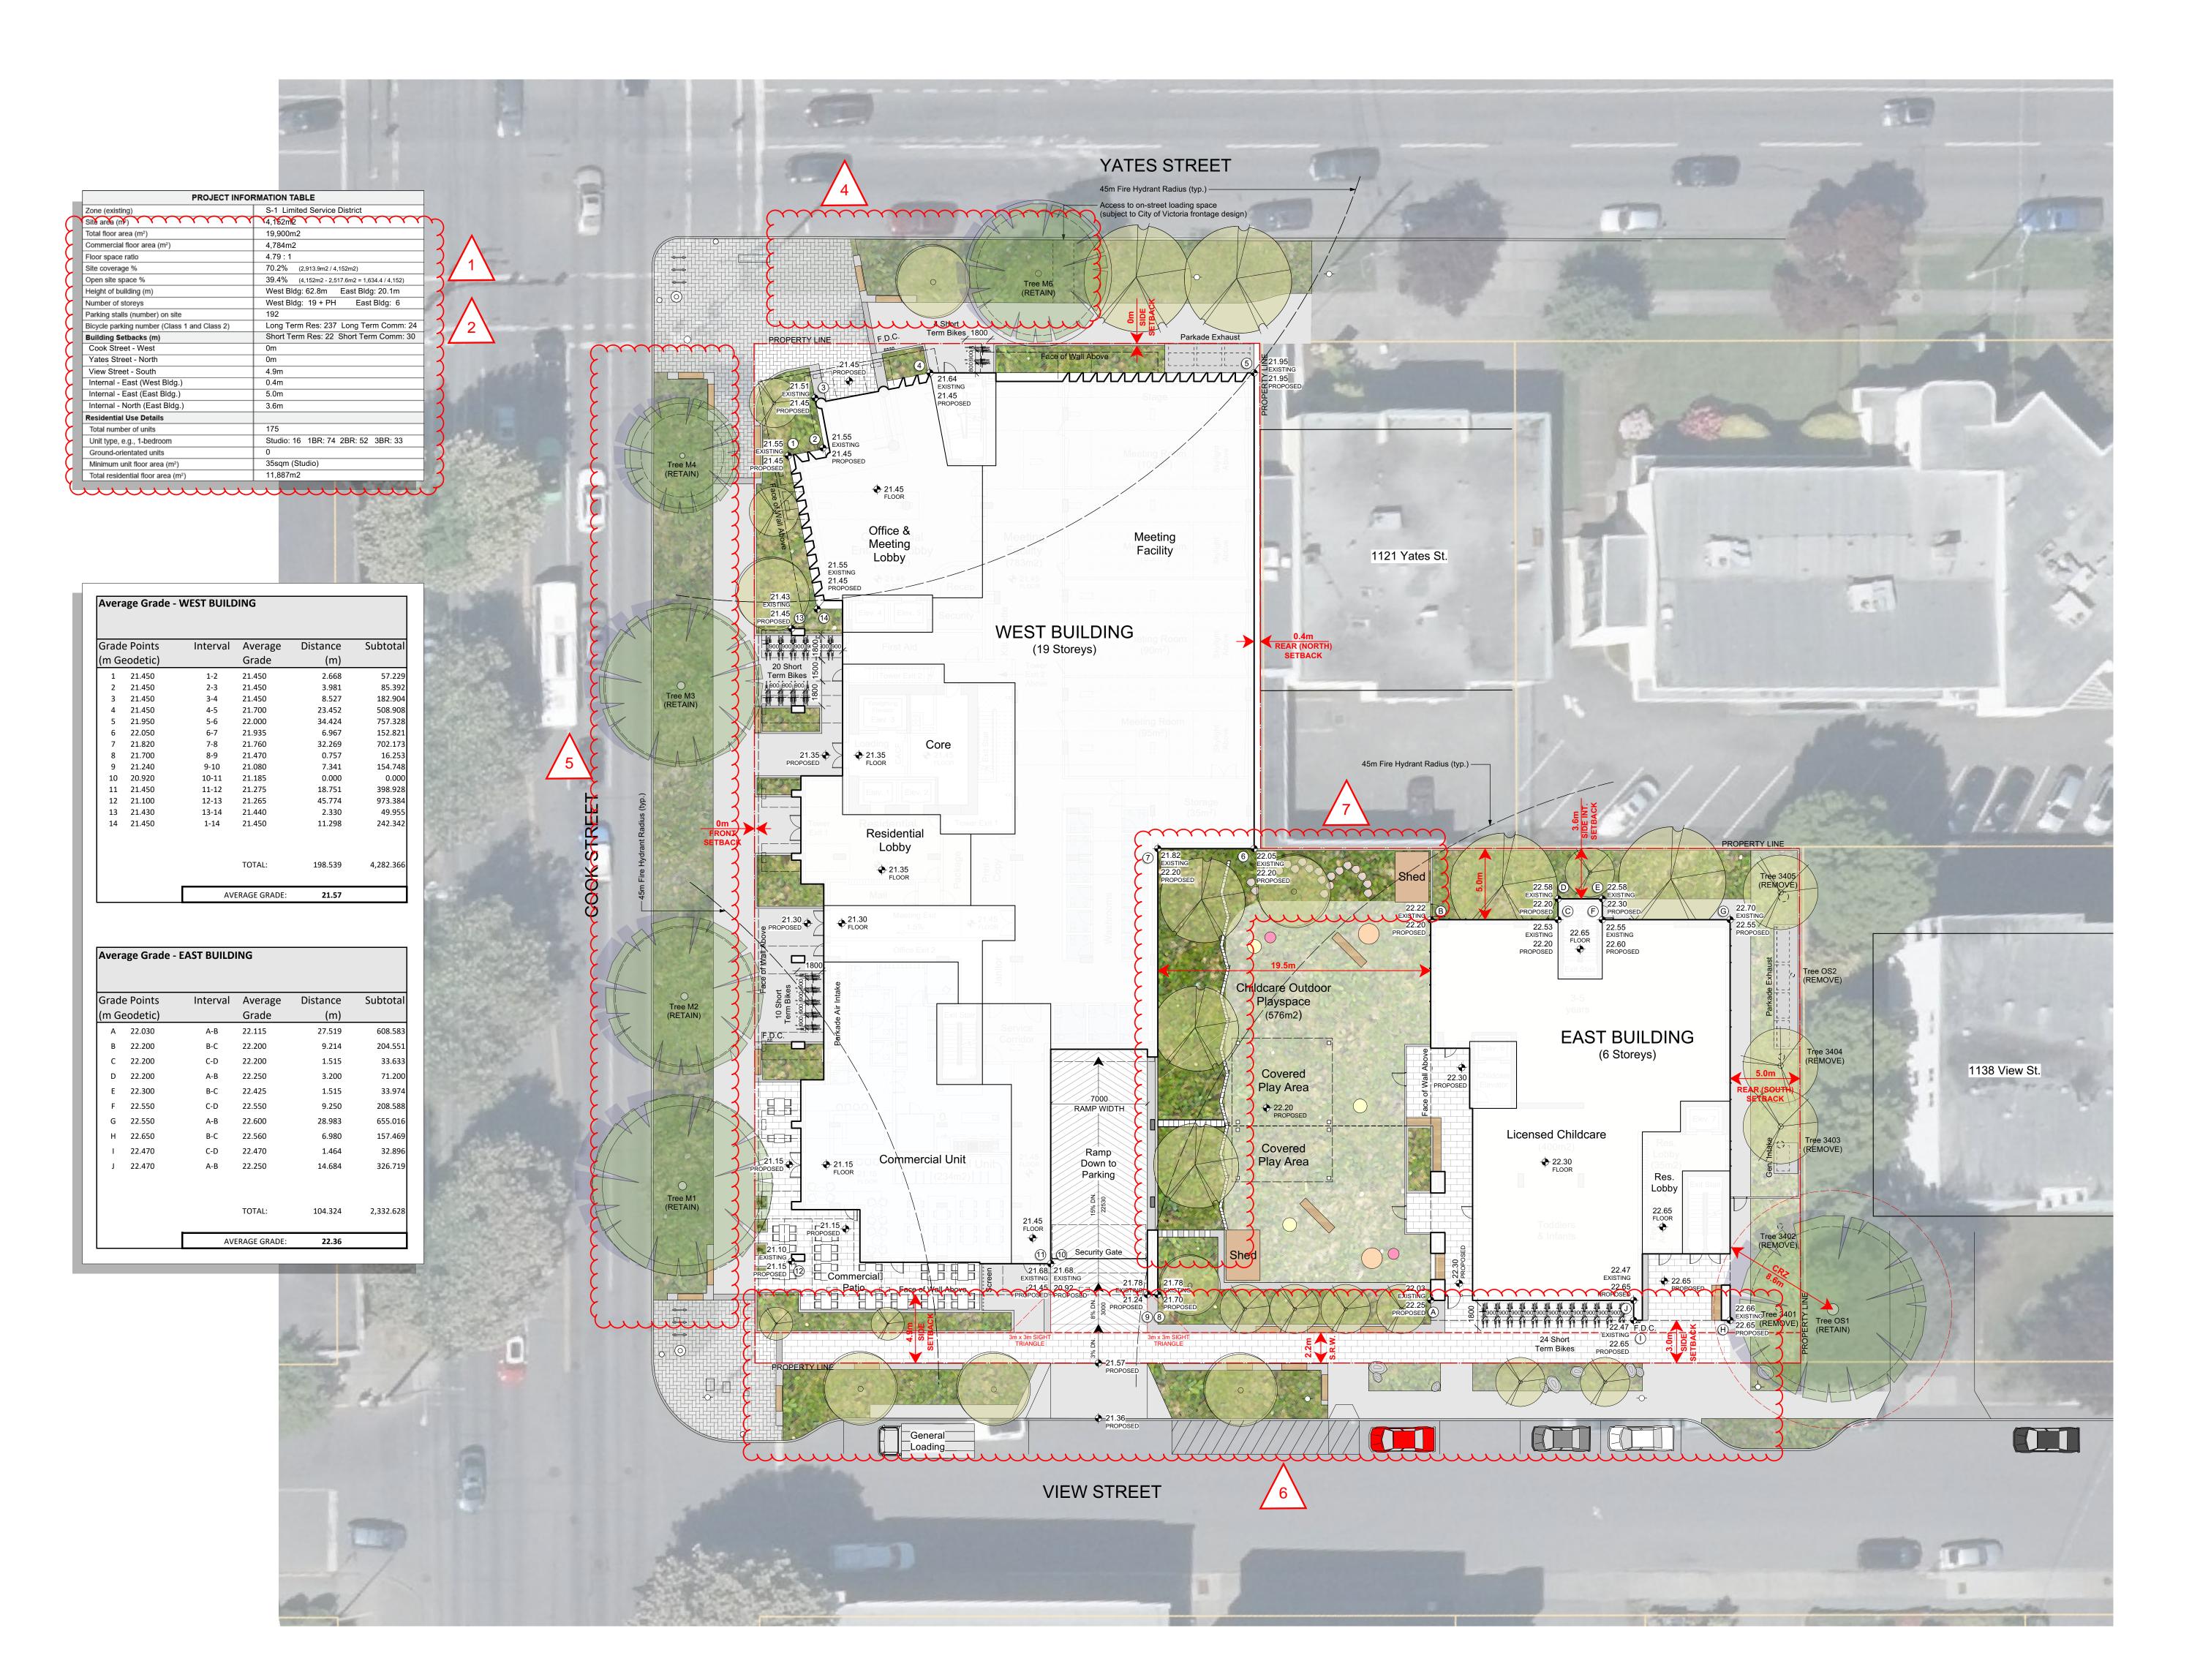




owned and operated by FM D'AMBROSIO architect Inc.

THIS DOCUMENT HAS BEEN ELECTRONICALLY CERTIFIED WITH DIGITAL CERTIFICATE AND ENCRYPTION TECHNOLOGY AUTHORIZED BY THE AIBC. THE AUTHORITATIVE ORIGINAL IS IN ELECTRONIC FORM. ANY PRINTED VERSION CAN BE RELIED UPON AS A TRUE COPY OF THE ORIGINAL WHEN SUPPLIED BY DAUSTUDIO, BEARING IMAGES OF THE PROFESSIONAL SEAL AND DIGITAL CERTIFICATE OR WHEN PRINTED FROM THE DIGITALLY CERTIFIED ELECTRONIC FILE.

General Notes:

These preliminary plans are subject to refinement and confirmation of City policy and existing site conditions.

Refer to Landscape Architectural Plan for information on hardscaping, plantings and landscape site elements.

The proposed frontages within the public right-of-way are subject to coordination with the City of Victoria.


Revision Key:

4. Yates Street frontage updates: corner plaza adjustment to the extent of paving and boulevard tree; boulevard seating edges added; tree tags added; hydro poles updated; access path indicated for on-street loading space (to be coordinated with the City of Victoria frontage design). Refer also to Civil and Landscape Architectural bubbled drawings.

5. Cook Street frontage updates:
boulevard seating edges added; tree
tags added; mid-block short-term parking
bay removed. Refer also to Civil and
Landscape Architectural bubbled
drawings.

6. View Street frontage updates:
sidewalk adjusted to align with 2.2m wide
volumetric SRW; boulevard seating
edges added; tree tags added; curbside
access walkway added at loading space;
fire hydrant location revised. Refer also
to Civil and Landscape Architectural
bubbled drawings.

7. Childcare play area updated in coordination with Landscape Architectural plans. Refer to Landscape Architectural drawings.

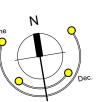

._	RZ/DP Resubmission	25.11.20
	Rezoning & Development Permit - ADP	25.10.02
	Rezoning & Development Permit	25.08.05
7	Development Tracker	25.06.24
nο	description	date

copyright reserved. these drawings and designs are and at all times remain the property of DAUSTUDIO to be used for the project shown and may not be reproduced without written consent.

project name

1101 Yates St.


Victoria, BC

sheet title

Site Plan

project no.		2441
drawing file	2441 - 1	101 Yates - 250923
scale		1:200
drawn by		JH
date issued		sheet no.

November 20, 2025 **A2.1**

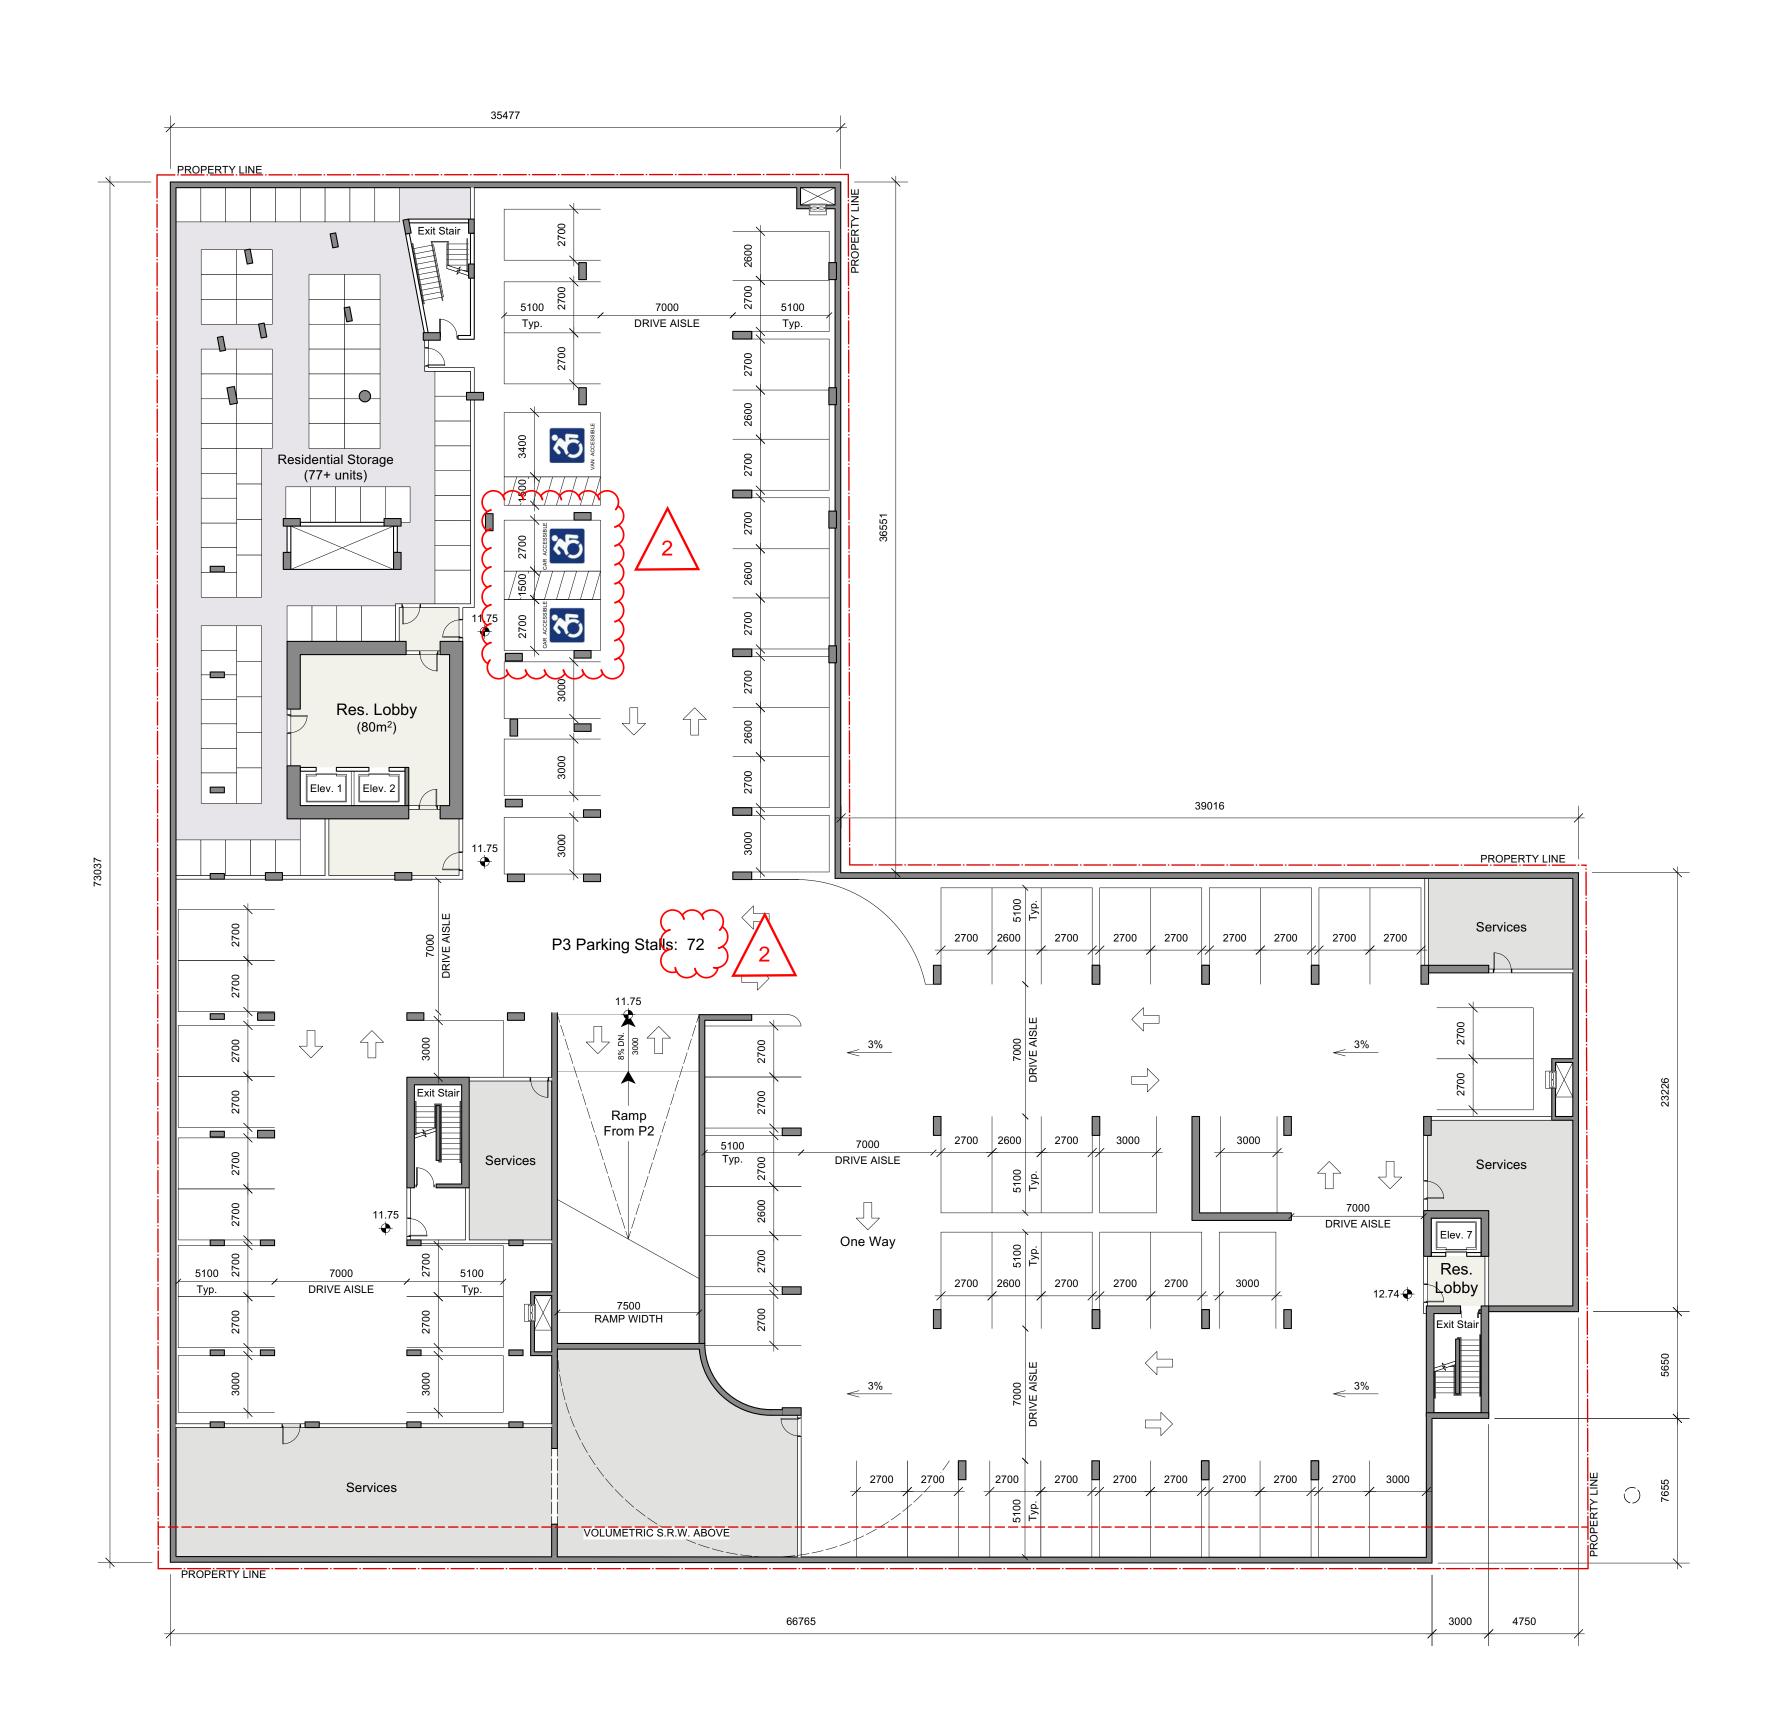




THIS DOCUMENT HAS BEEN ELECTRONICALLY CERTIFIED WITH DIGITAL CERTIFICATE AND ENCRYPTION TECHNOLOGY AUTHORIZED BY THE AIBC. THE AUTHORITATIVE ORIGINAL IS IN ELECTRONIC FORM. ANY PRINTED VERSION CAN BE RELIED UPON AS A TRUE COPY OF THE ORIGINAL WHEN SUPPLIED BY DAUSTUDIO, BEARING IMAGES OF THE PROFESSIONAL SEAL AND DIGITAL CERTIFICATE OR WHEN PRINTED FROM THE DIGITALLY CERTIFIED ELECTRONIC FILE.

General Notes:

These preliminary plans are subject to refinement and confirmation of City policy and existing site conditions.


Refer to Landscape Architectural Plan for information on hardscaping, plantings and landscape site elements.

 The proposed frontages within the public right-of-way are subject to coordination with the City of Victoria.

Revision Key:

2. Parking revisions: one accessible vehicle stall added per bylaw requirements.

 $\sim\sim\sim\sim$

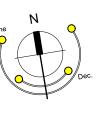

4	RZ/DP Resubmission	25.11.20
<u>/</u> 3\	Rezoning & Development Permit - ADP	25.10.02
2	Rezoning & Development Permit	25.08.05
1	Development Tracker	25.06.24
rev no	description	date

copyright reserved. these drawings and designs are and at all times remain the property of DAUSTUDIO to be used for the project shown and may not be reproduced without written consent.

project name


1101 Yates St.

Victoria, BC

sheet title

Level P3 Plan

project no.	2441
drawing file 2441 - 1	101 Yates - 250923
scale	1:200
drawn by	JH
date issued	sheet no.
November 20, 2025	A2.2

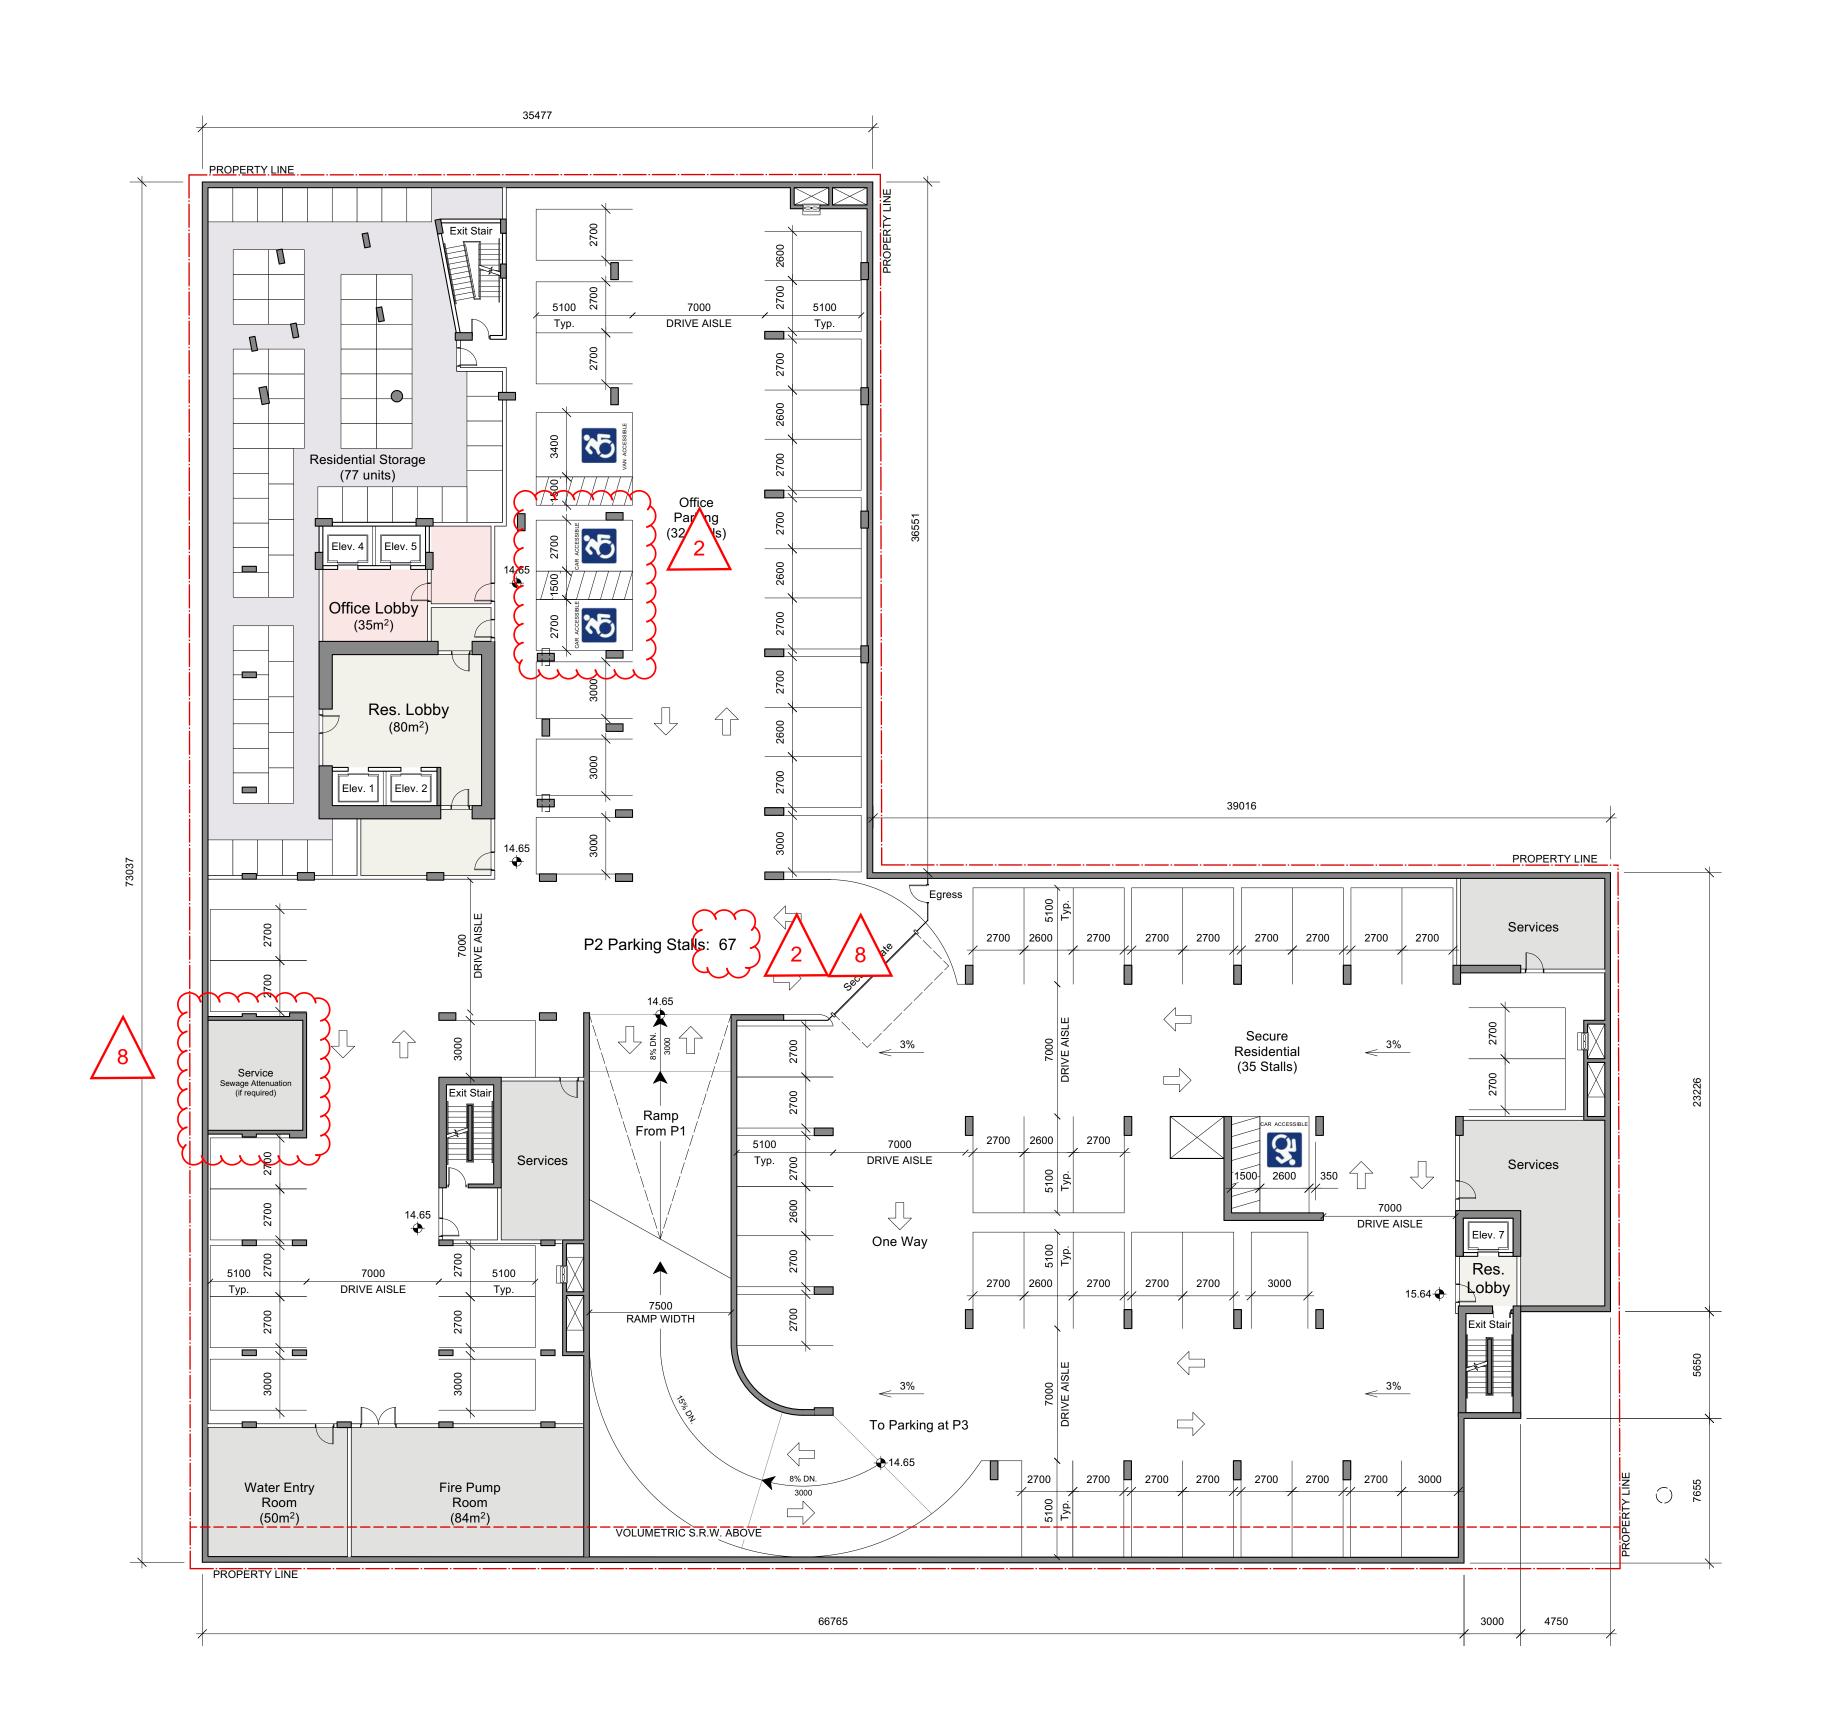



2025-11-21

THIS DOCUMENT HAS BEEN ELECTRONICALLY CERTIFIED WITH DIGITAL CERTIFICATE AND ENCRYPTION TECHNOLOGY AUTHORIZED BY THE AIBC. THE AUTHORITATIVE ORIGINAL IS IN ELECTRONIC FORM. ANY PRINTED VERSION CAN BE RELIED UPON AS A TRUE COPY OF THE ORIGINAL WHEN SUPPLIED BY DAUSTUDIO, BEARING IMAGES OF THE PROFESSIONAL SEAL AND DIGITAL
CERTIFICATE OR WHEN PRINTED FROM THE
DIGITALLY CERTIFIED ELECTRONIC FILE.

General Notes:

These preliminary plans are subject to refinement and confirmation of City policy and existing site conditions.

Refer to Landscape Architectural Plan for information on hardscaping, plantings and landscape site elements.


 The proposed frontages within the public right-of-way are subject to coordination with the City of Victoria.

Revision Key:

2. Parking revisions: one accessiblevehicle stall added per bylaw requirements.

 \sim

8. Potential sewage attenuation tank: two parking spaces removed to accommodate a tank should attenuation be required.

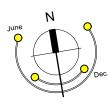

<u> </u>	RZ/DP Resubmission	25.11.20
<u>3</u>	Rezoning & Development Permit - ADP	25.10.02
2	Rezoning & Development Permit	25.08.05
1	Development Tracker	25.06.24
rev no	description	date

copyright reserved. these drawings and designs are and at all times remain the property of DAUSTUDIO to be used for the project shown and may not be reproduced without written consent.

project name


1101 Yates St.

Victoria, BC

sheet title

Level P2 Plan

project no.	2441
drawing file 2441 - 1	101 Yates - 250923
scale	1:200
drawn by	JH
date issued	sheet no.
November 20, 2025	A2.3

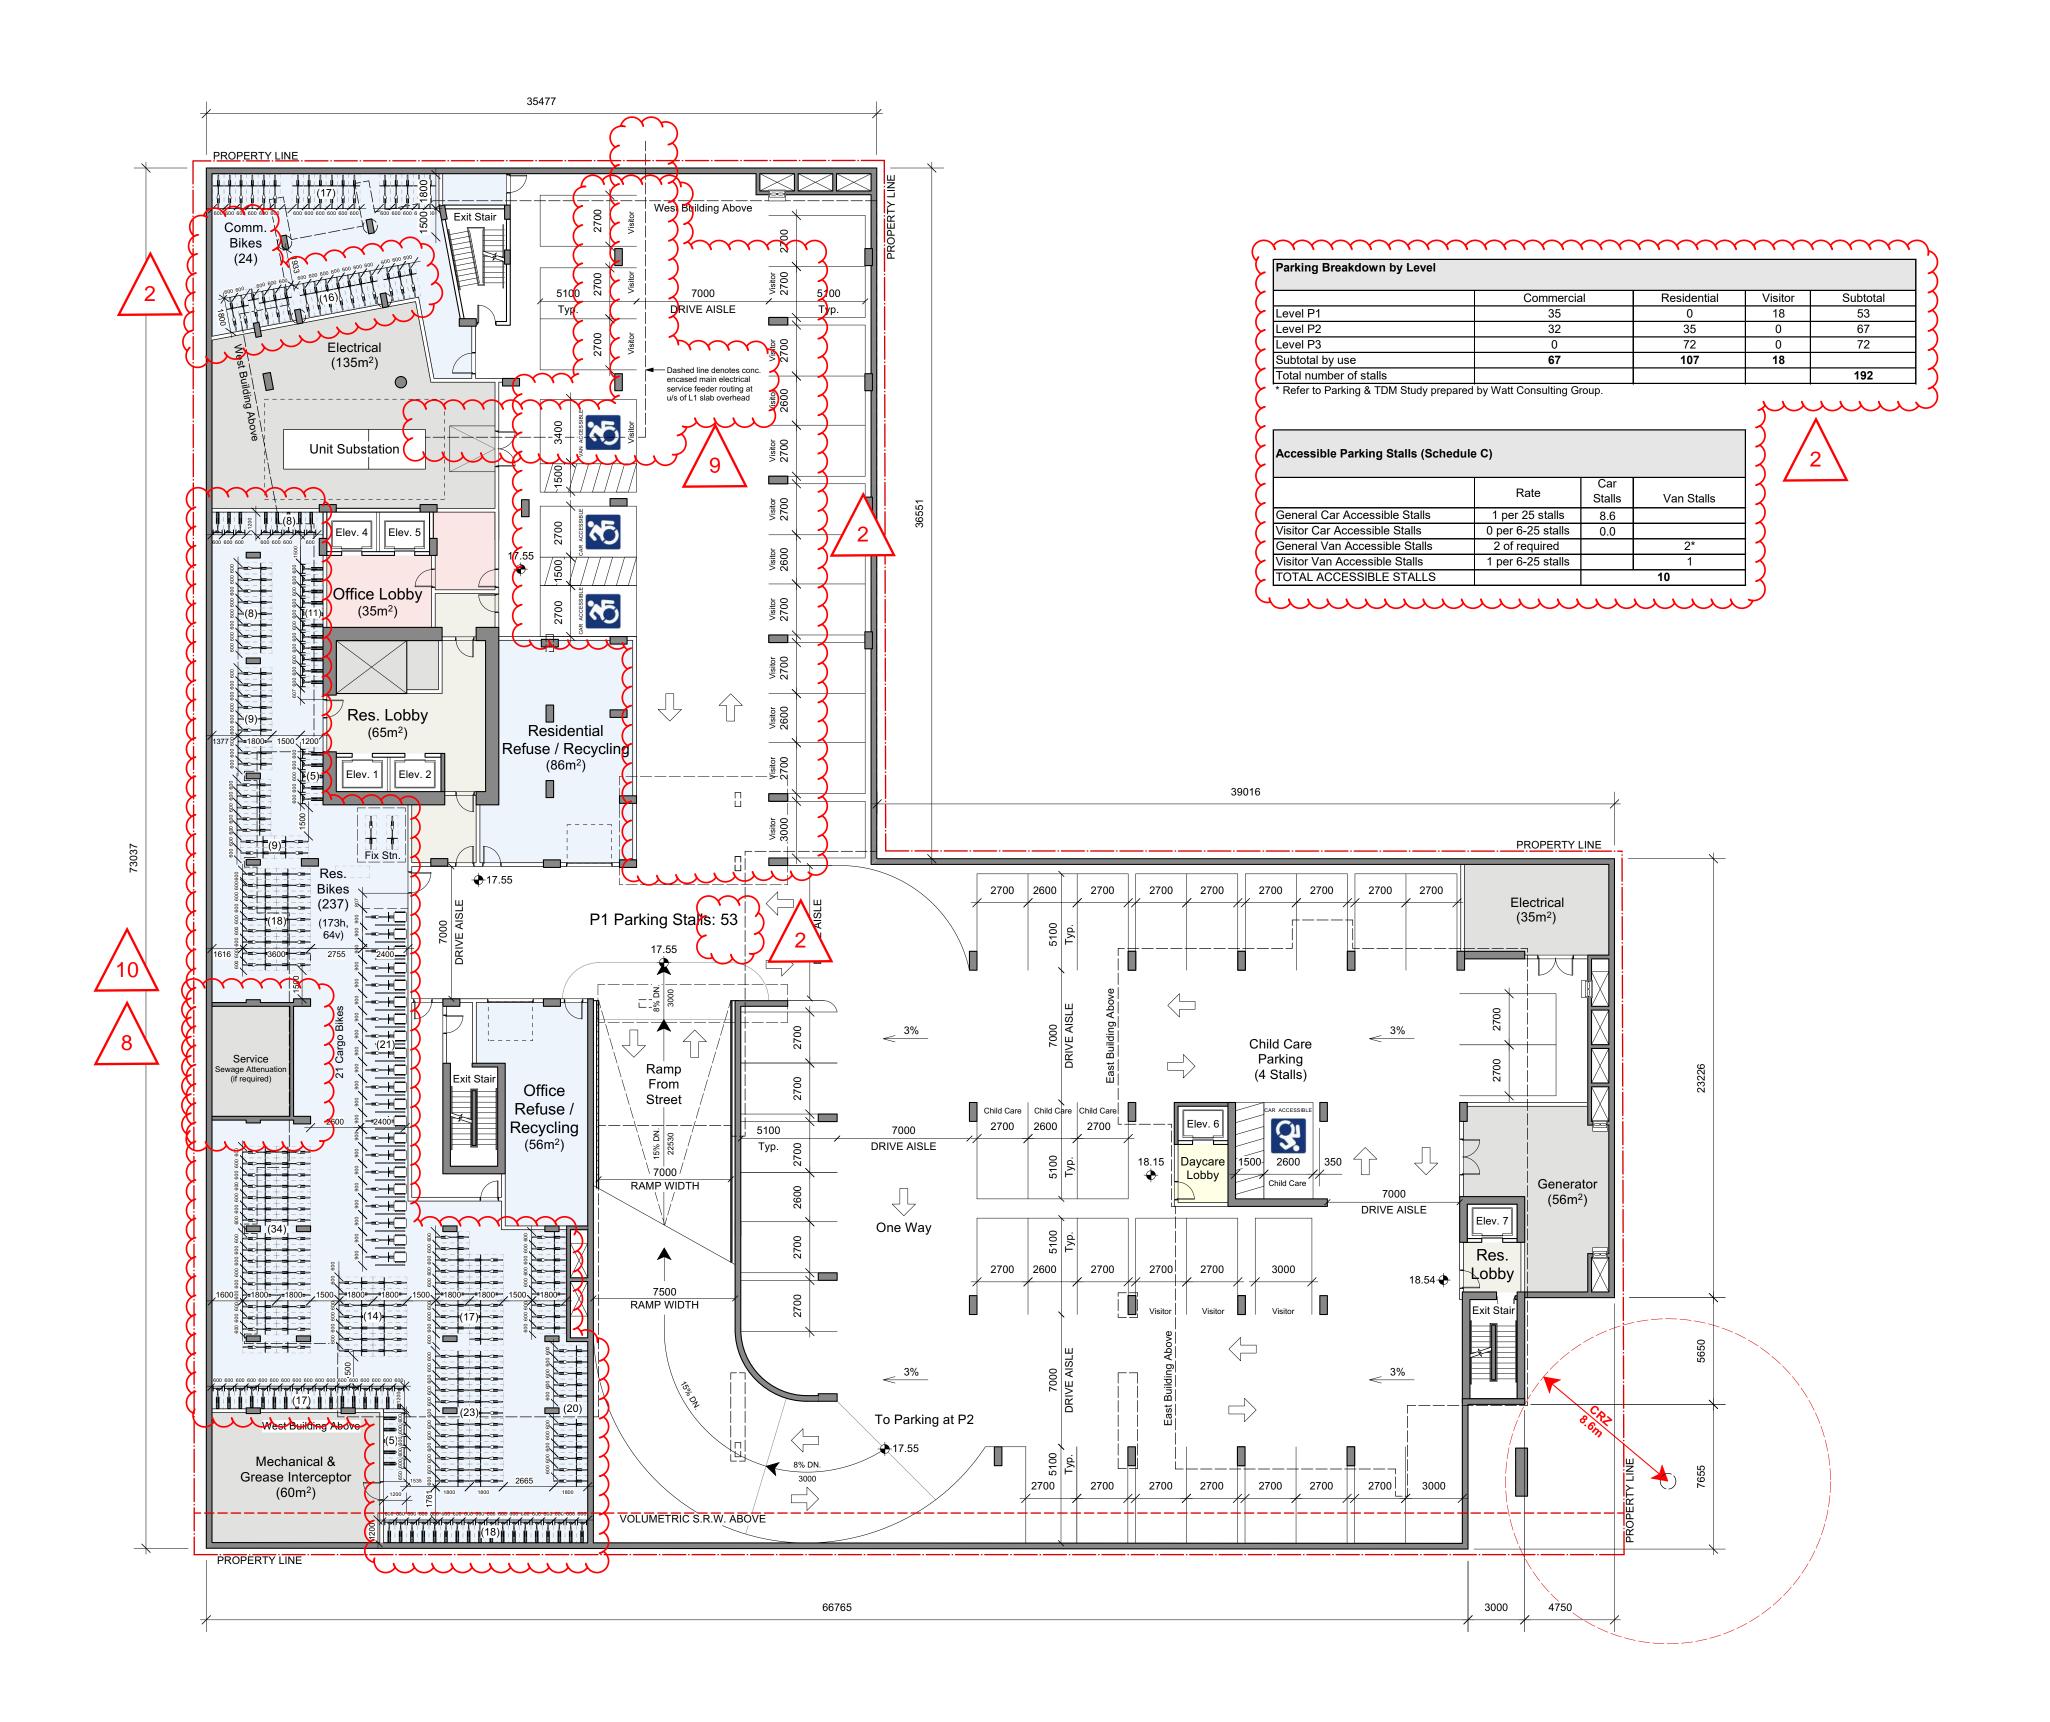




2025-11-21

THIS DOCUMENT HAS BEEN ELECTRONICALLY CERTIFIED WITH DIGITAL CERTIFICATE AND ENCRYPTION TECHNOLOGY AUTHORIZED BY THE AIBC. THE AUTHORITATIVE ORIGINAL IS IN ELECTRONIC FORM. ANY PRINTED VERSION CAN BE RELIED UPON AS A TRUE COPY OF THE ORIGINAL WHEN SUPPLIED BY DAUSTUDIO, BEARING IMAGES OF THE PROFESSIONAL SEAL AND DIGITAL CERTIFICATE OR WHEN PRINTED FROM THE DIGITALLY CERTIFIED ELECTRONIC FILE.

General Notes:

 These preliminary plans are subject to refinement and confirmation of City policy and existing site conditions.

Refer to Landscape Architectural Plan for information on hardscaping, plantings and landscape site elements.

 The proposed frontages within the public right-of-way are subject to coordination with the City of Victoria.

Revision Key:

2. Parking revisions: Parking counts updated to reflect floor area changes and accessible parking requirements; accessible vehicle stall added; Class 1 Office Bike Parking revised per bylaw requirements.

8. Potential sewage attenuation tank


accommodated should attenuation be

required.

9. Schematic hydro ducting route to

underground unit substation added.

10. Class 1 Residential Bike Parking revised to increase bike parking supply, in coordination with project TDM commitments.

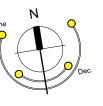

4	RZ/DP Resubmission	25.11.20
<u>3</u>	Rezoning & Development Permit - ADP	25.10.02
2	Rezoning & Development Permit	25.08.05
1	Development Tracker	25.06.24
ev no	description	date

copyright reserved. these drawings and designs are and at all times remain the property of DAUSTUDIO to be used for the project shown and may not be reproduced without written consent.

project name


1101 Yates St.

Victoria, BC

sheet title

Level P1 Plan

project no.	2441
drawing file 2441 - 1	101 Yates - 250923
scale	1:200
drawn by	JH
date issued	sheet no.
November 20, 2025	A2.4

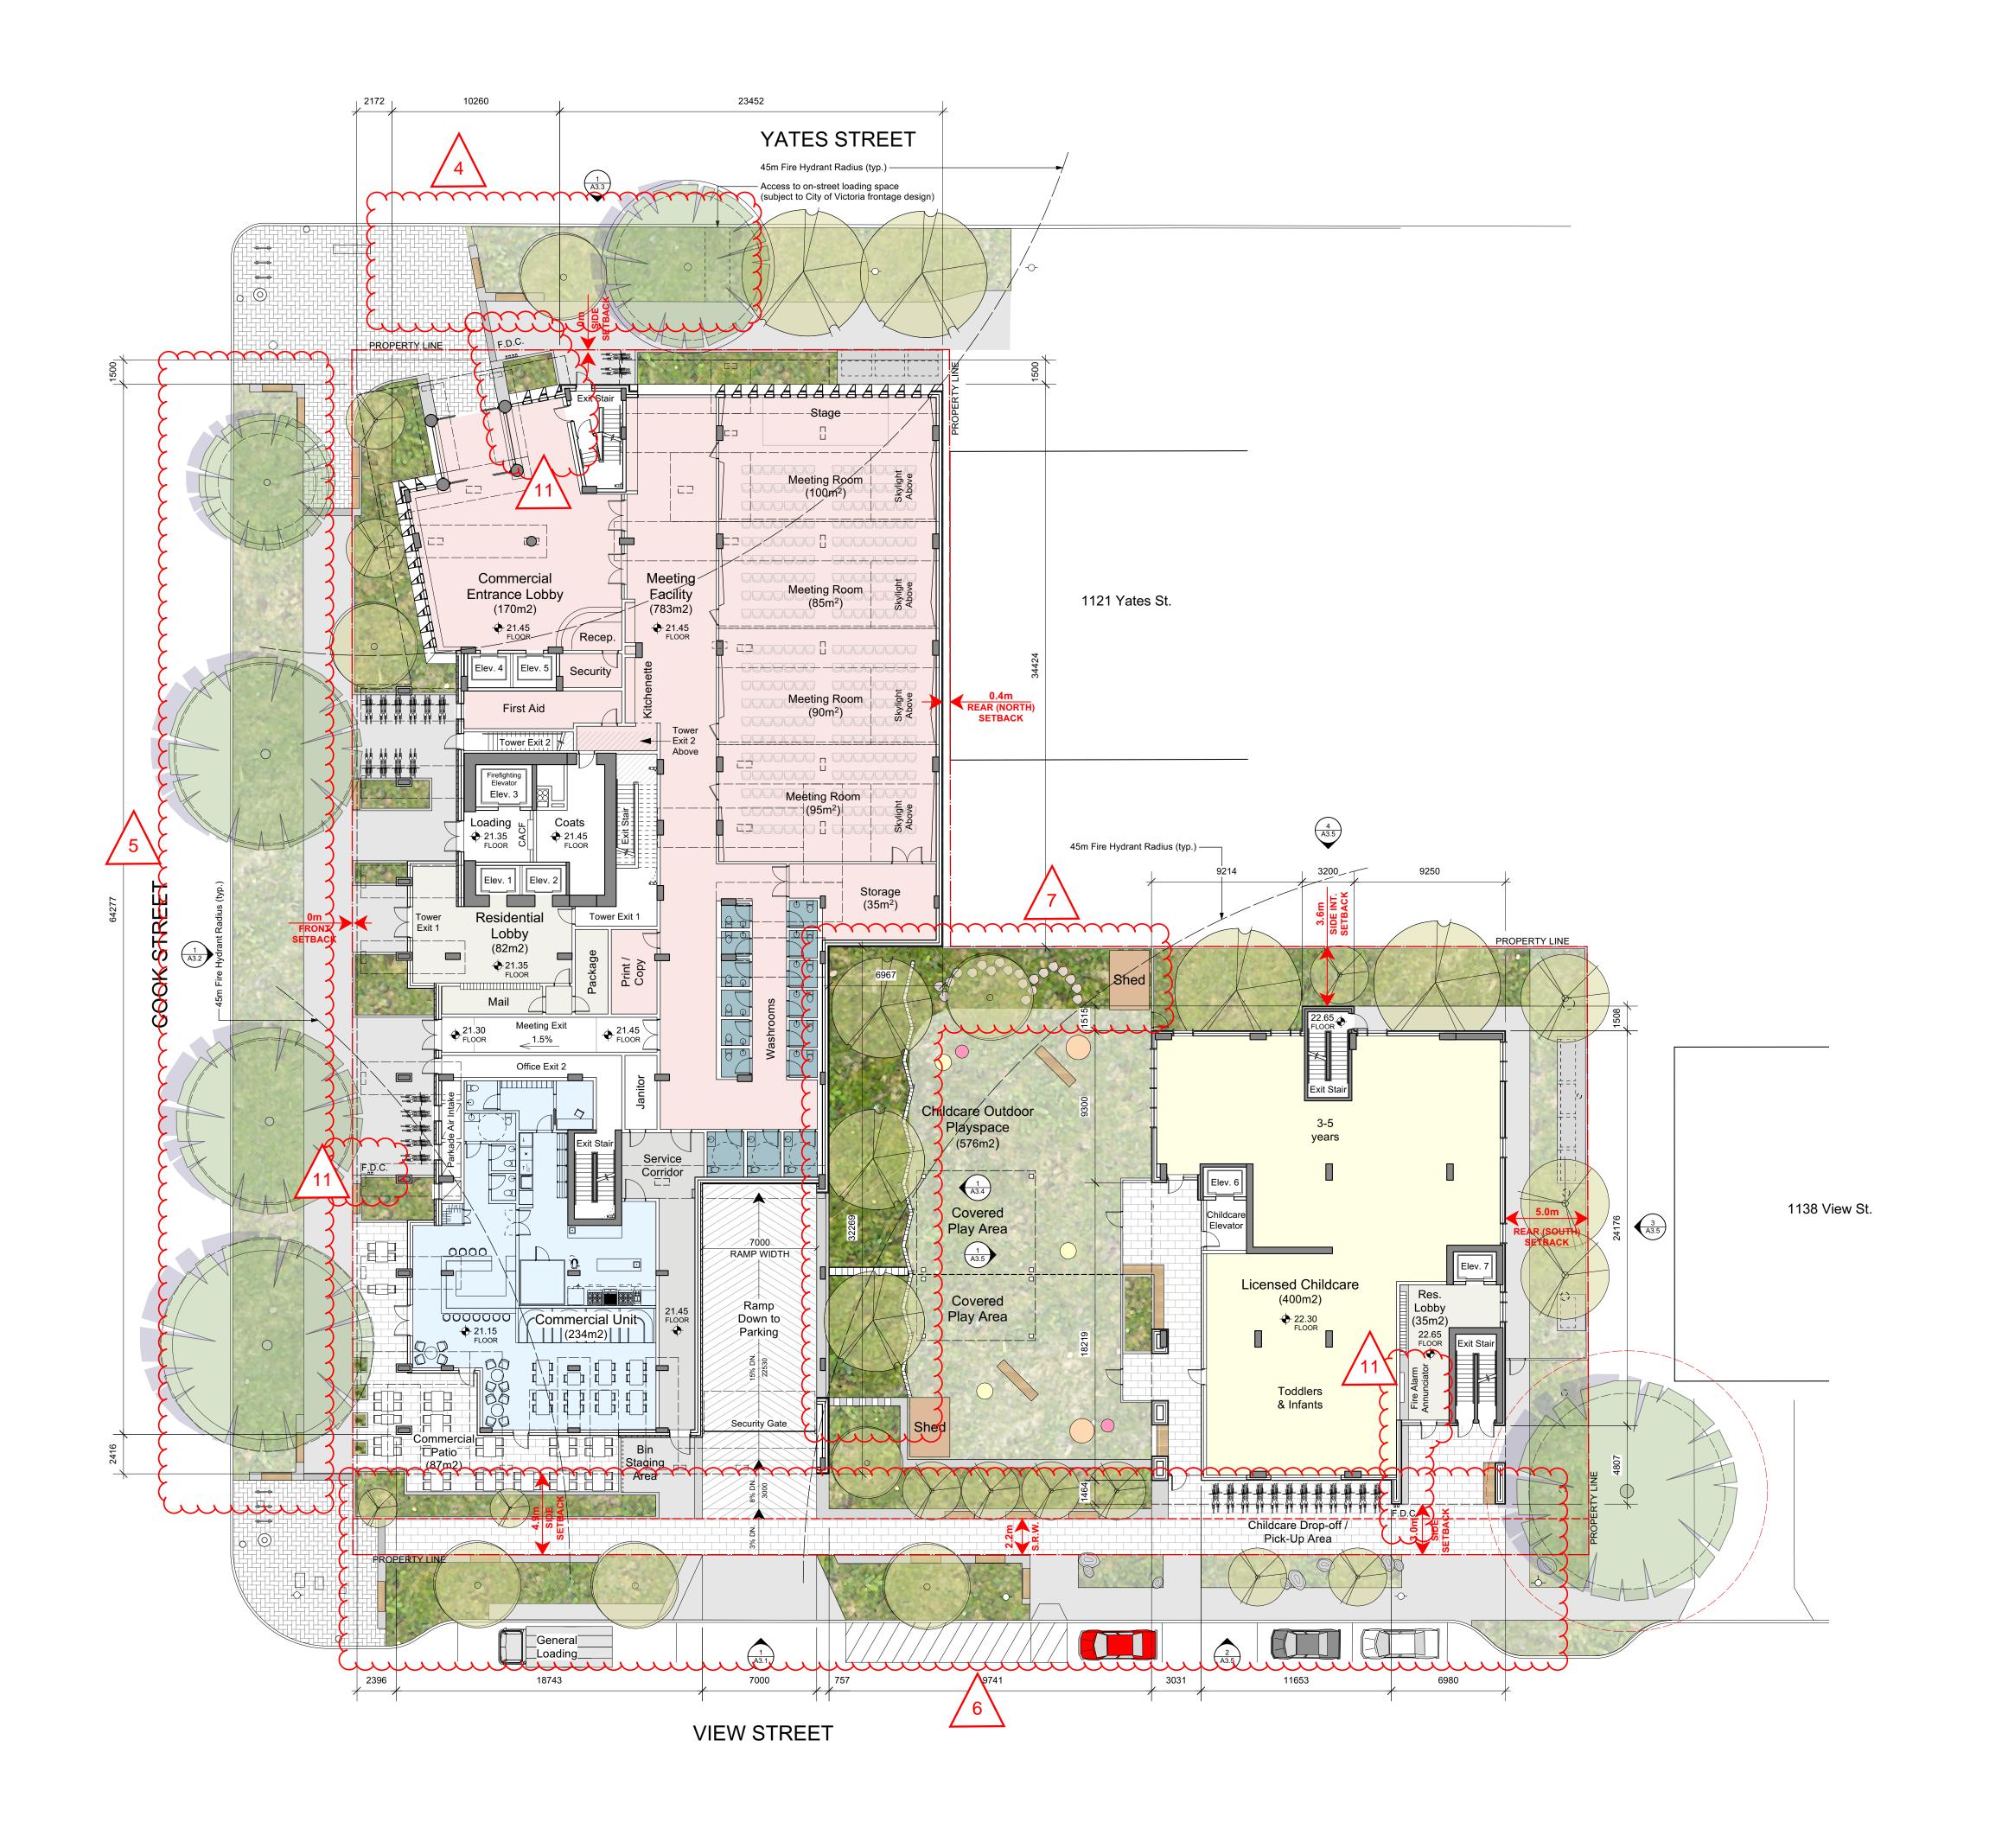



2025-11-21

THIS DOCUMENT HAS BEEN ELECTRONICALLY CERTIFIED WITH DIGITAL CERTIFICATE AND ENCRYPTION TECHNOLOGY AUTHORIZED BY THE AIBC. THE AUTHORITATIVE ORIGINAL IS IN ELECTRONIC FORM. ANY PRINTED VERSION CAN BE RELIED UPON AS A TRUE COPY OF THE ORIGINAL WHEN SUPPLIED BY **DAUSTUDIO**, BEARING IMAGES OF THE PROFESSIONAL SEAL AND DIGITAL CERTIFICATE OR WHEN PRINTED FROM THE DIGITALLY CERTIFIED ELECTRONIC FILE.

General Notes:

These preliminary plans are subject to refinement and confirmation of City policy and existing site conditions.

Refer to Landscape Architectural Plan for information on hardscaping, plantings and landscape site elements.

3. The proposed frontages within the public right-of-way are subject to coordination with the City of Victoria.

Revision Key:

4. Yates Street frontage updates: refer to comments on A2.1 Site Plan.

5. Cook Street frontage updates: refer to

 \sim

comments on A2.1 Site Plan.

6. View Street frontage updates: refer to comments on A2.1 Site Plan.


7. Childcare play area updated in coordination with Landscape Architectural plans. Refer to Landscape Architectural drawings.

11. Revisions related to Inspections

- Detail added to show Fire Department Connection heads; locations revised as needed to ensure hoses do not conflict

with egress paths; - Clarification on locations for the CACF and Fire Alarm Panels: there will be one CACF at the West Tower loading elevator lobby and one Annunciator in the East Building Residential Entrance Lobby (refer also to the updated GHL

outline code report).

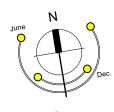

4	RZ/DP Resubmission	25.11.
<u>/</u> 3\	Rezoning & Development Permit - ADP	25.10.
2	Rezoning & Development Permit	25.08.
1	Development Tracker	25.06.
rev no	description	date

copyright reserved. these drawings and designs are and at all times remain the property of DAUSTUDIO to be used for the project shown and may not be reproduced without written consent.

project name


1101 Yates St.

Victoria, BC

sheet title Level 1 Plan


project no.	2441
drawing file 2441 - 1	101 Yates - 250923
scale	1:200
drawn by	JH
date issued	sheet no.
November 20, 2025	A2.5

YATES STREET

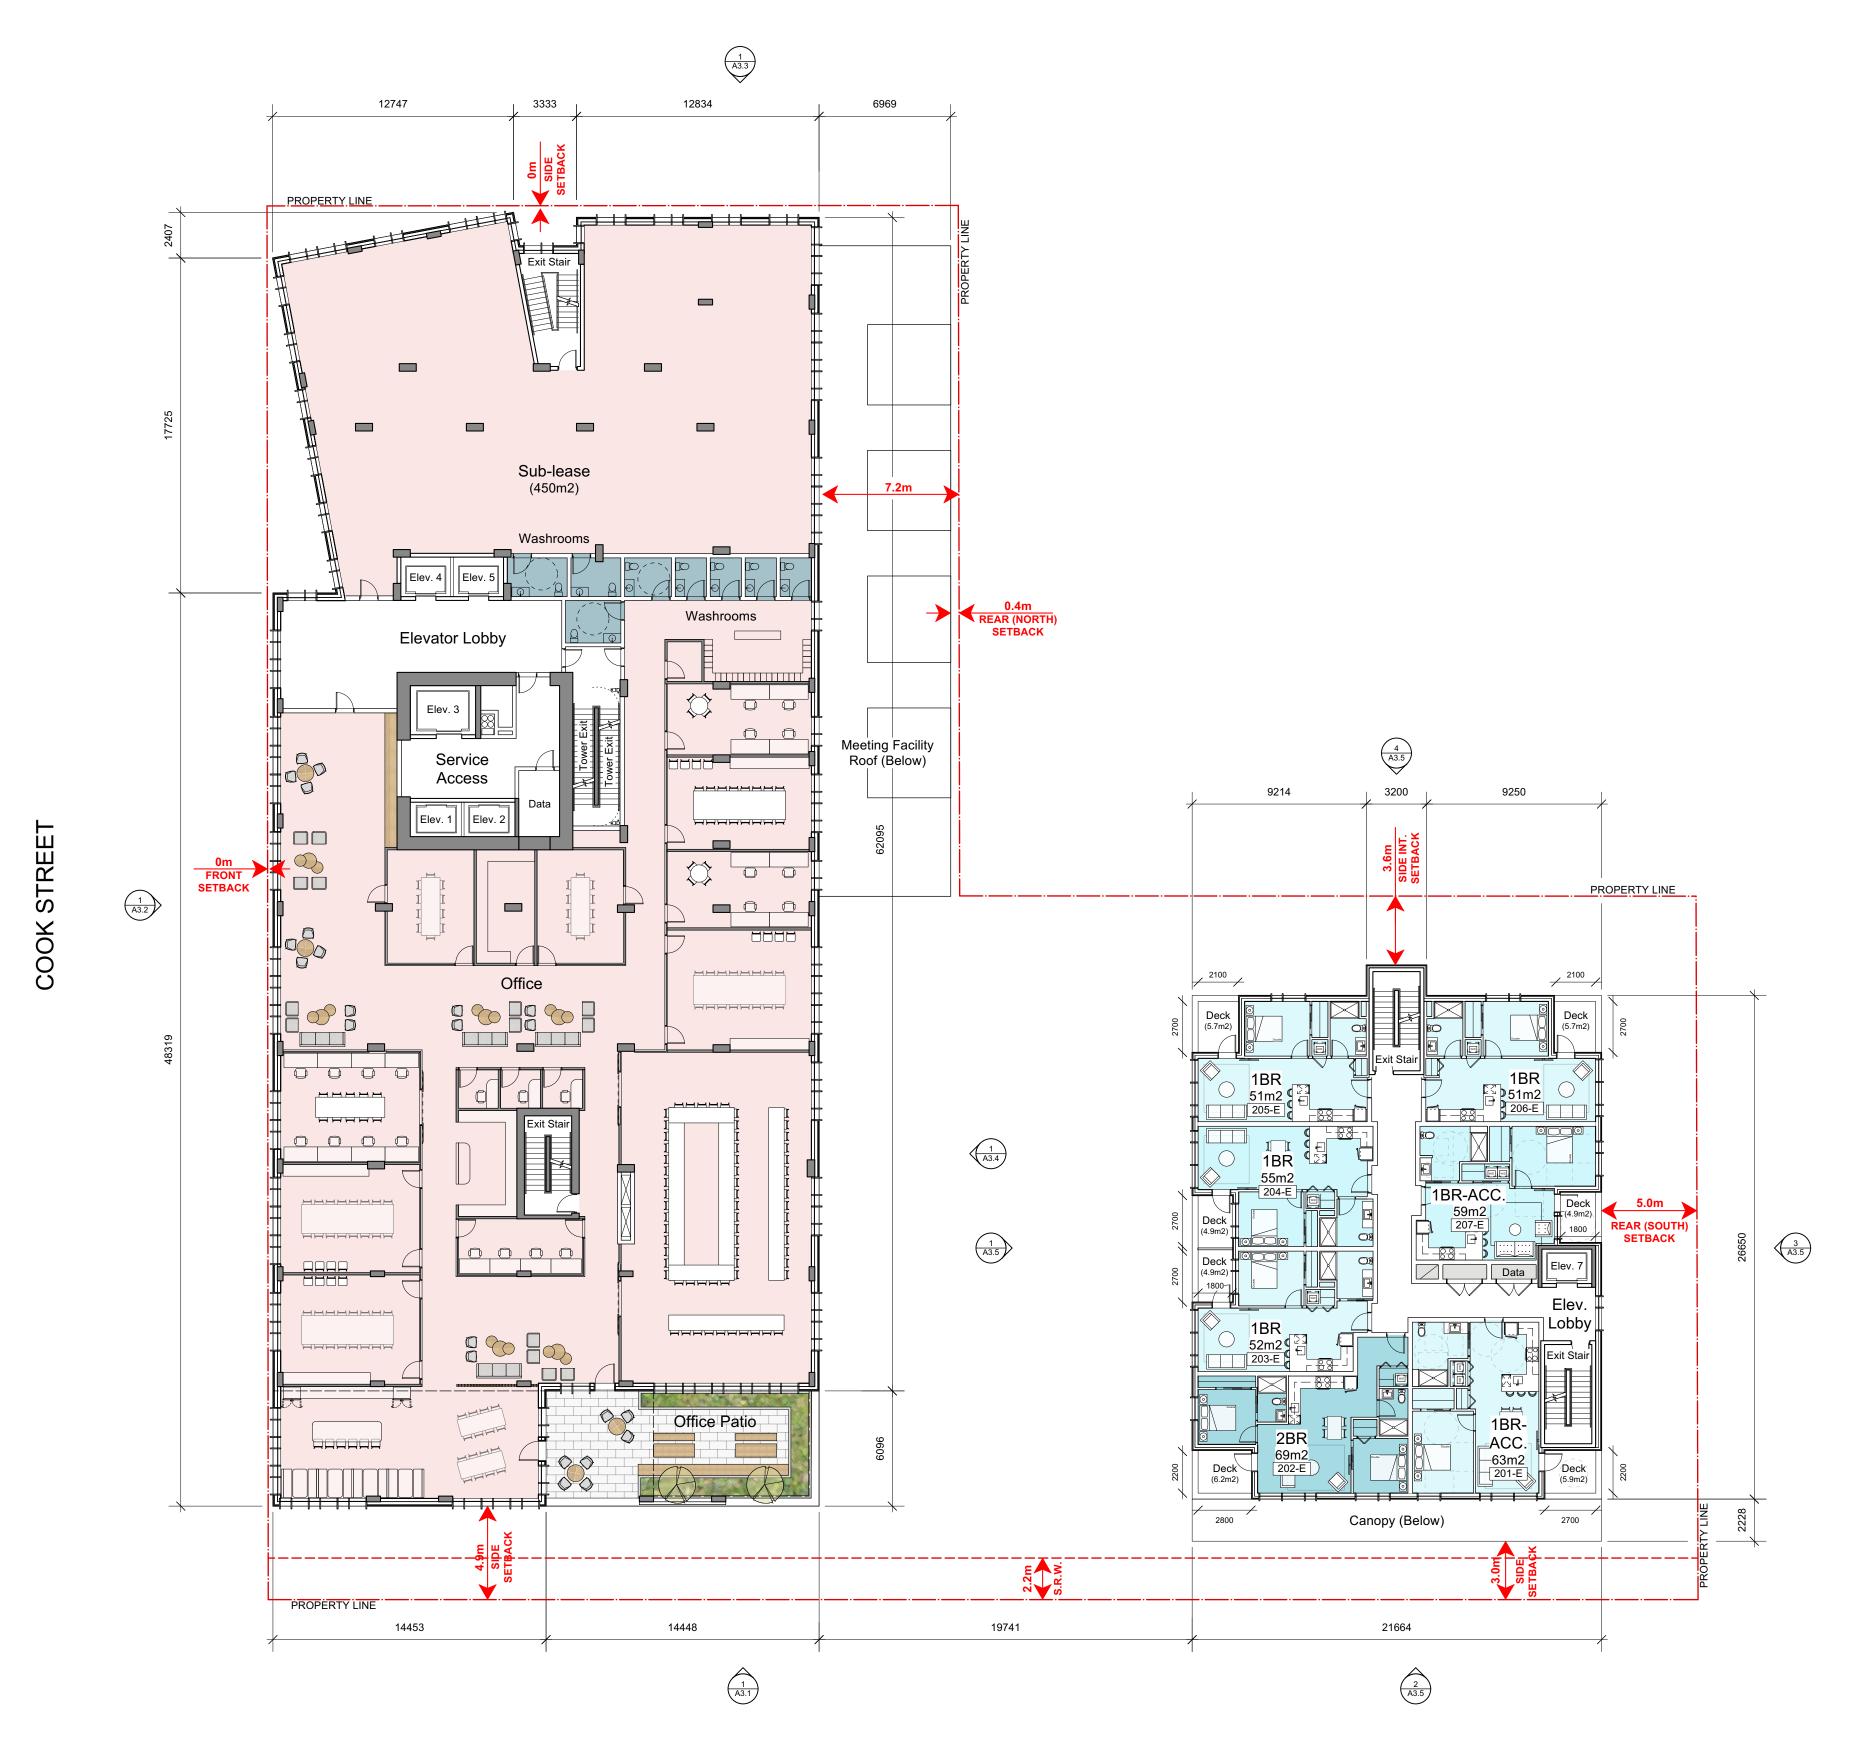

VIEW STREET



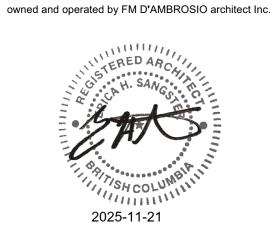


THIS DOCUMENT HAS BEEN ELECTRONICALLY CERTIFIED WITH DIGITAL CERTIFICATE AND ENCRYPTION TECHNOLOGY AUTHORIZED BY THE AIBC. THE AUTHORITATIVE ORIGINAL IS IN ELECTRONIC FORM. ANY PRINTED VERSION CAN BE RELIED UPON AS A TRUE COPY OF THE ORIGINAL WHEN SUPPLIED BY DAUSTUDIO, BEARING IMAGES OF THE PROFESSIONAL SEAL AND DIGITAL CERTIFICATE OR WHEN PRINTED FROM THE DIGITALLY CERTIFIED ELECTRONIC FILE.

General Notes:

These preliminary plans are subject to refinement and confirmation of City policy and existing site conditions.

Refer to Landscape Architectural Plan for information on hardscaping, plantings and landscape site elements.

The proposed frontages within the public right-of-way are subject to coordination with the City of Victoria.

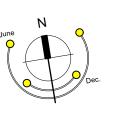

4	RZ/DP Resubmission	25.11.20
<u>/3\</u>	Rezoning & Development Permit - ADP	25.10.02
2	Rezoning & Development Permit	25.08.05
1	Development Tracker	25.06.24
ev no	description	date

copyright reserved. these drawings and designs are and at all times remain the property of DAUSTUDIO to be used for the project shown and may not be reproduced without written consent.

project name

1101 Yates St.

Victoria, BC

Level 2 Plan

project no.

drawing file 2441 - 1101 Yates - 250923 scale 1:200

drawn by ...
date issued sheet no.

November 20, 2025 **A2.6**







THIS DOCUMENT HAS BEEN ELECTRONICALLY CERTIFIED WITH DIGITAL CERTIFICATE AND ENCRYPTION TECHNOLOGY AUTHORIZED BY THE AIBC. THE AUTHORITATIVE ORIGINAL IS IN ELECTRONIC FORM. ANY PRINTED VERSION CAN BE RELIED UPON AS A TRUE COPY OF THE ORIGINAL WHEN SUPPLIED BY DAUSTUDIO, BEARING IMAGES OF THE PROFESSIONAL SEAL AND DIGITAL CERTIFICATE OR WHEN PRINTED FROM THE DIGITALLY CERTIFIED ELECTRONIC FILE.

General Notes:

These preliminary plans are subject to refinement and confirmation of City policy and existing site conditions.

Refer to Landscape Architectural Plan for information on hardscaping, plantings and landscape site elements.

The proposed frontages within the public right-of-way are subject to coordination with the City of Victoria.

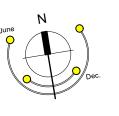

4	RZ/DP Resubmission	25.11.20
<u>3</u>	Rezoning & Development Permit - ADP	25.10.02
2	Rezoning & Development Permit	25.08.05
1	Development Tracker	25.06.24
ev no	description	date

copyright reserved. these drawings and designs are and at all times remain the property of DAUSTUDIO to be used for the project shown and may not be reproduced without written consent.

project name

1101 Yates St.

Victoria, BC

sheet title

Level 3 Plan

project no.	2441
drawing file 2441 - 1	101 Yates - 250923
scale	1:200
drawn by	JH
date issued	sheet no.
November 20, 2025	A2.7






THIS DOCUMENT HAS BEEN ELECTRONICALLY CERTIFIED WITH DIGITAL CERTIFICATE AND ENCRYPTION TECHNOLOGY AUTHORIZED BY THE AIBC. THE AUTHORITATIVE ORIGINAL IS IN ELECTRONIC FORM. ANY PRINTED VERSION CAN BE RELIED UPON AS A TRUE COPY OF THE ORIGINAL WHEN SUPPLIED BY DAUSTUDIO, BEARING IMAGES OF THE PROFESSIONAL SEAL AND DIGITAL CERTIFICATE OR WHEN PRINTED FROM THE DIGITALLY CERTIFIED ELECTRONIC FILE.

General Notes:


These preliminary plans are subject to refinement and confirmation of City policy and existing site conditions.

Refer to Landscape Architectural Plan for information on hardscaping, plantings and landscape site elements.

The proposed frontages within the public right-of-way are subject to coordination with the City of Victoria.

Revision Key:

12. Southeast corner units (_07-W)
revised from 2-BDR+Den to 3-BDR
homes. Note these layouts meet overall
area guidelines however the third
bedroom area is below guideline
standards.

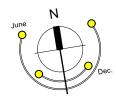

4	RZ/DP Resubmission	25.11.20
<u>/</u> 3\	Rezoning & Development Permit - ADP	25.10.02
2	Rezoning & Development Permit	25.08.05
\triangle	Development Tracker	25.06.24
rev no	description	date
	1	

copyright reserved. these drawings and designs are and at all times remain the property of DAUSTUDIO to be used for the project shown and may not be reproduced without written consent.

project name


1101 Yates St.

Victoria, BC

sheet title

Level 4 Plan

project no.	2441
drawing file 2441 - 1	101 Yates - 250923
scale	1:200
drawn by	JH
date issued	sheet no.
November 20, 2025	A2.8

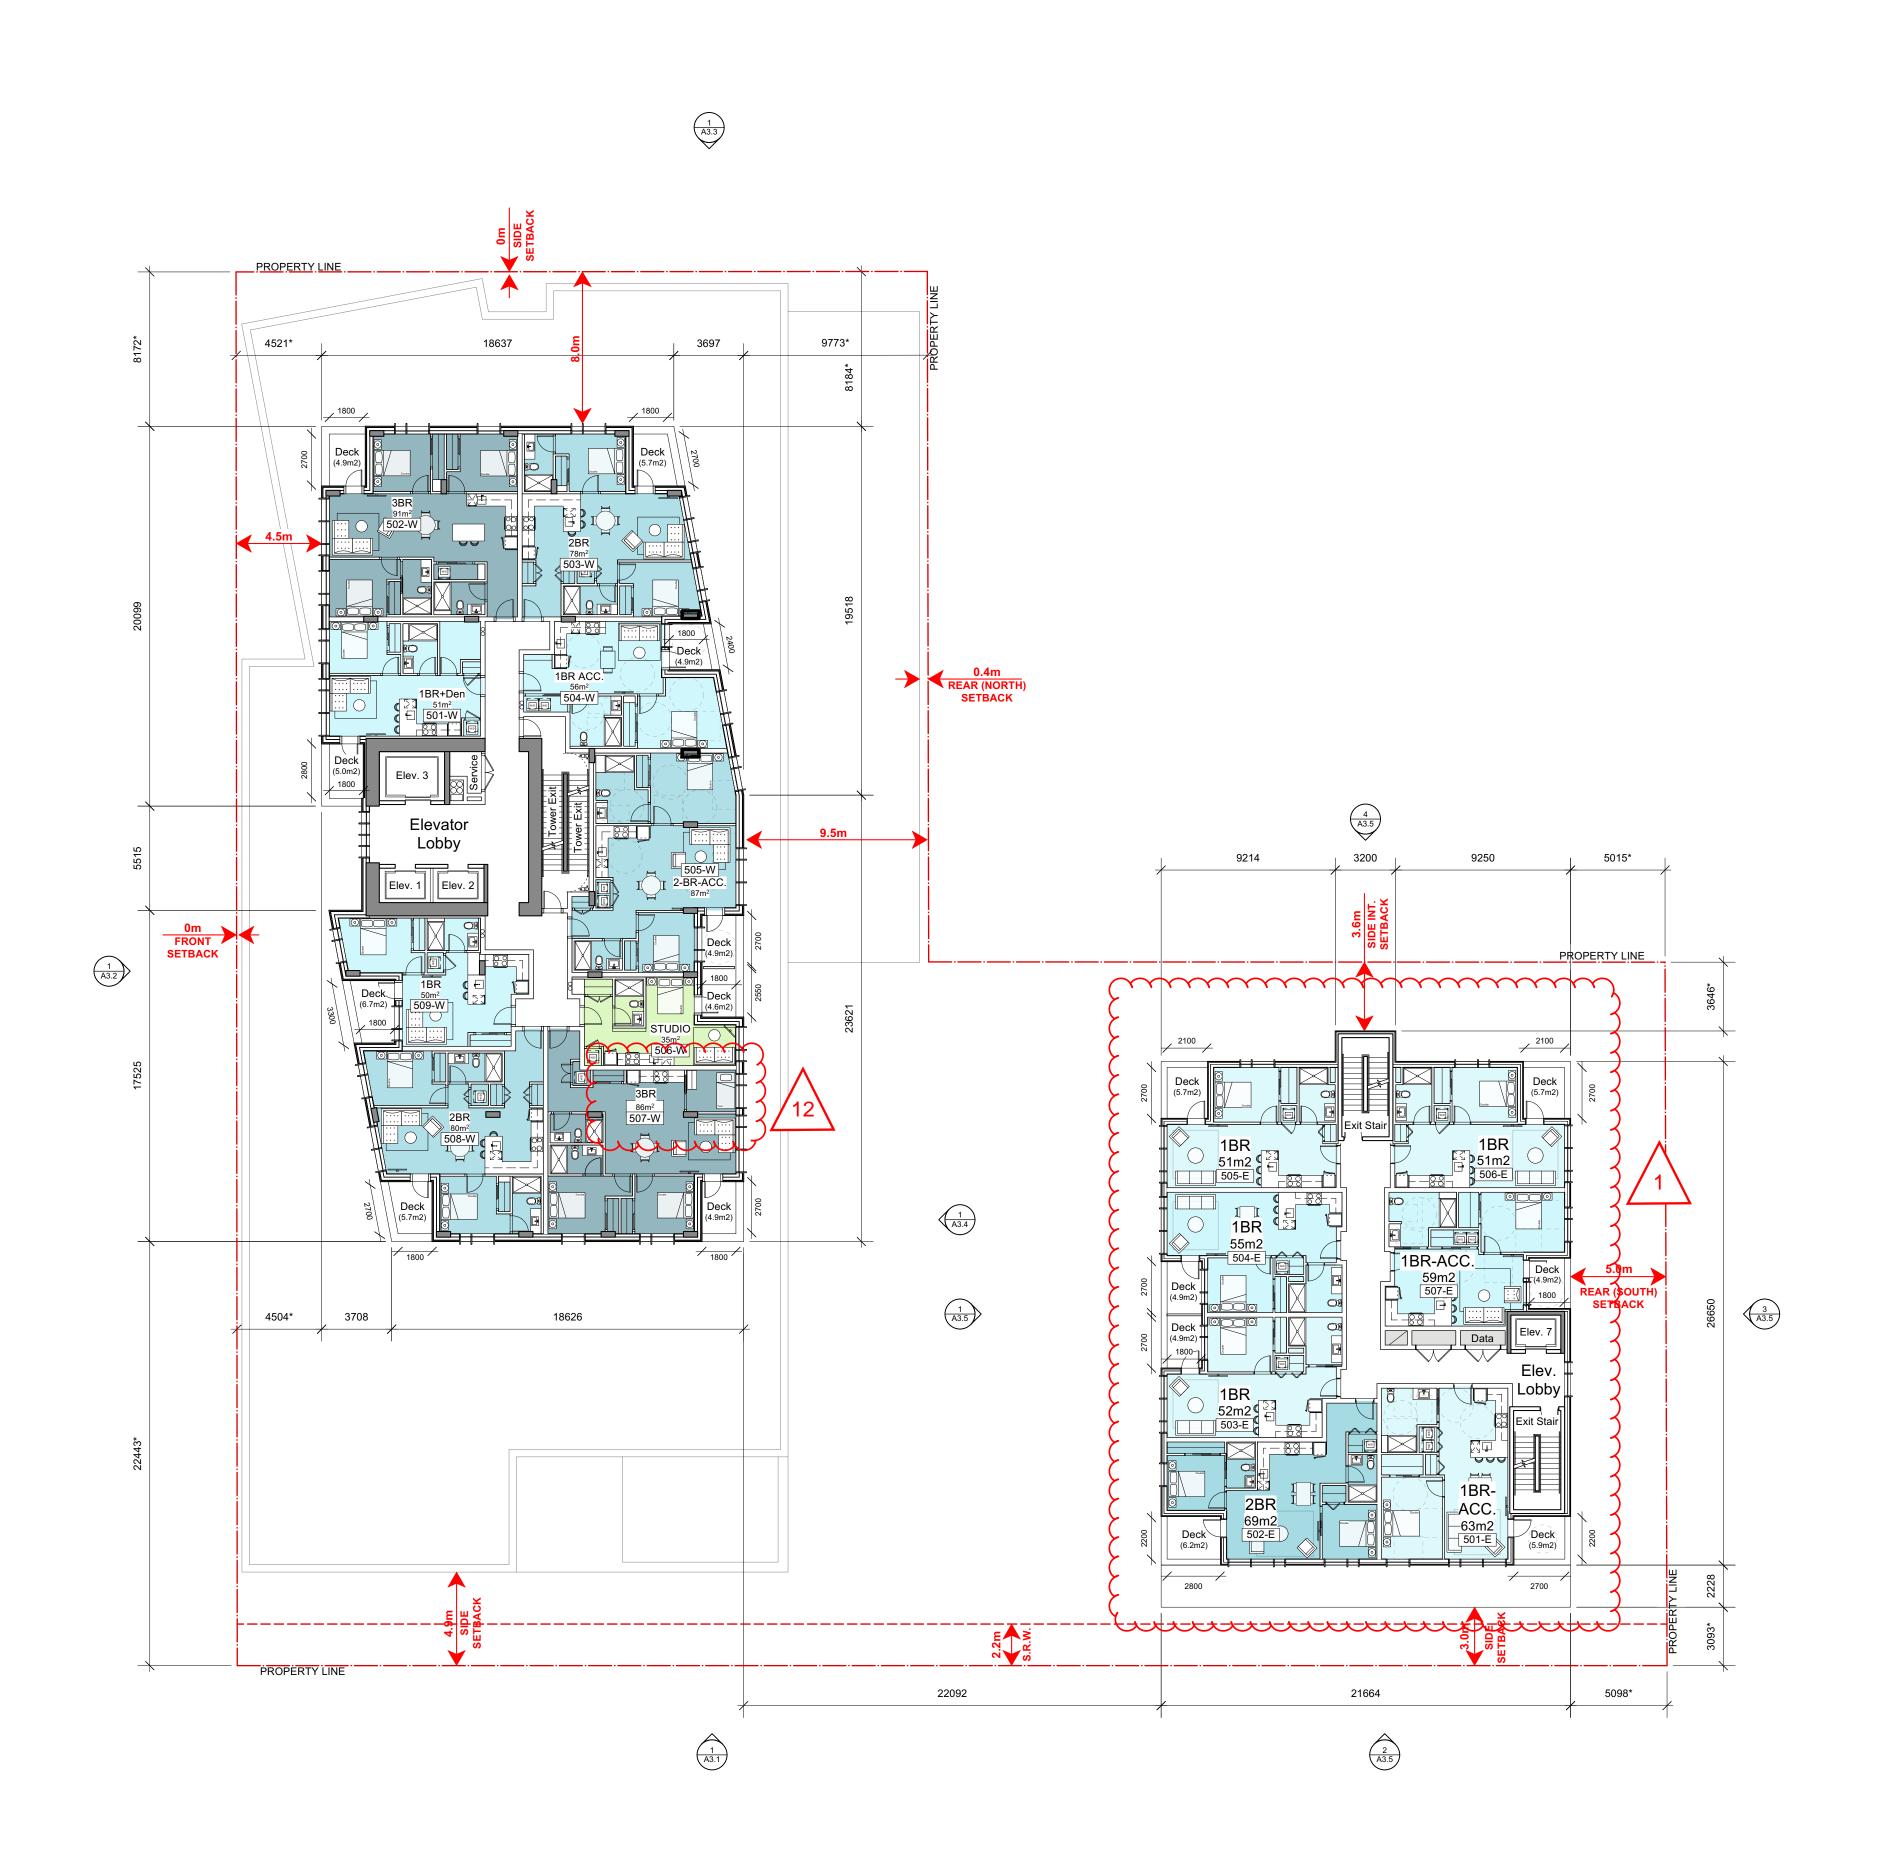




THIS DOCUMENT HAS BEEN ELECTRONICALLY CERTIFIED WITH DIGITAL CERTIFICATE AND ENCRYPTION TECHNOLOGY AUTHORIZED BY THE AIBC. THE AUTHORITATIVE ORIGINAL IS IN ELECTRONIC FORM. ANY PRINTED VERSION CAN BE RELIED UPON AS A TRUE COPY OF THE ORIGINAL WHEN SUPPLIED BY DAUSTUDIO, BEARING IMAGES OF THE PROFESSIONAL SEAL AND DIGITAL CERTIFICATE OR WHEN PRINTED FROM THE DIGITALLY CERTIFIED ELECTRONIC FILE.

General Notes:

These preliminary plans are subject to refinement and confirmation of City policy and existing site conditions.

Refer to Landscape Architectural Plan for information on hardscaping, plantings and landscape site elements.


The proposed frontages within the public right-of-way are subject to coordination with the City of Victoria.

Revision Key:

1. Building height revisions (West Tower revised to 19 stories, East Tower revised to 6 stories).


12. Southeast corner units (_07-W) revised from 2-BDR+Den to 3-BDR homes. Note these layouts meet overall area guidelines however the third bedroom area is below guideline standards.

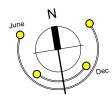

4	RZ/DP Resubmission	25.11.20
3	Rezoning & Development Permit - ADP	25.10.02
<u></u>	Rezoning & Development Permit	25.08.05
1	Development Tracker	25.06.24
rev no	description	date

copyright reserved. these drawings and designs are and at all times remain the property of DAUSTUDIO to be used for the project shown and may not be reproduced without written consent.

project name


1101 Yates St.

Victoria, BC

sheet title

Level 5 Plan

project no. 2441 drawing file 2441 - 1101 Yates - 250923
drawing file 2441 - 1101 Yates - 250923
scale 1:200
drawn by JH
date issued sheet no.
November 20, 2025 A2.9

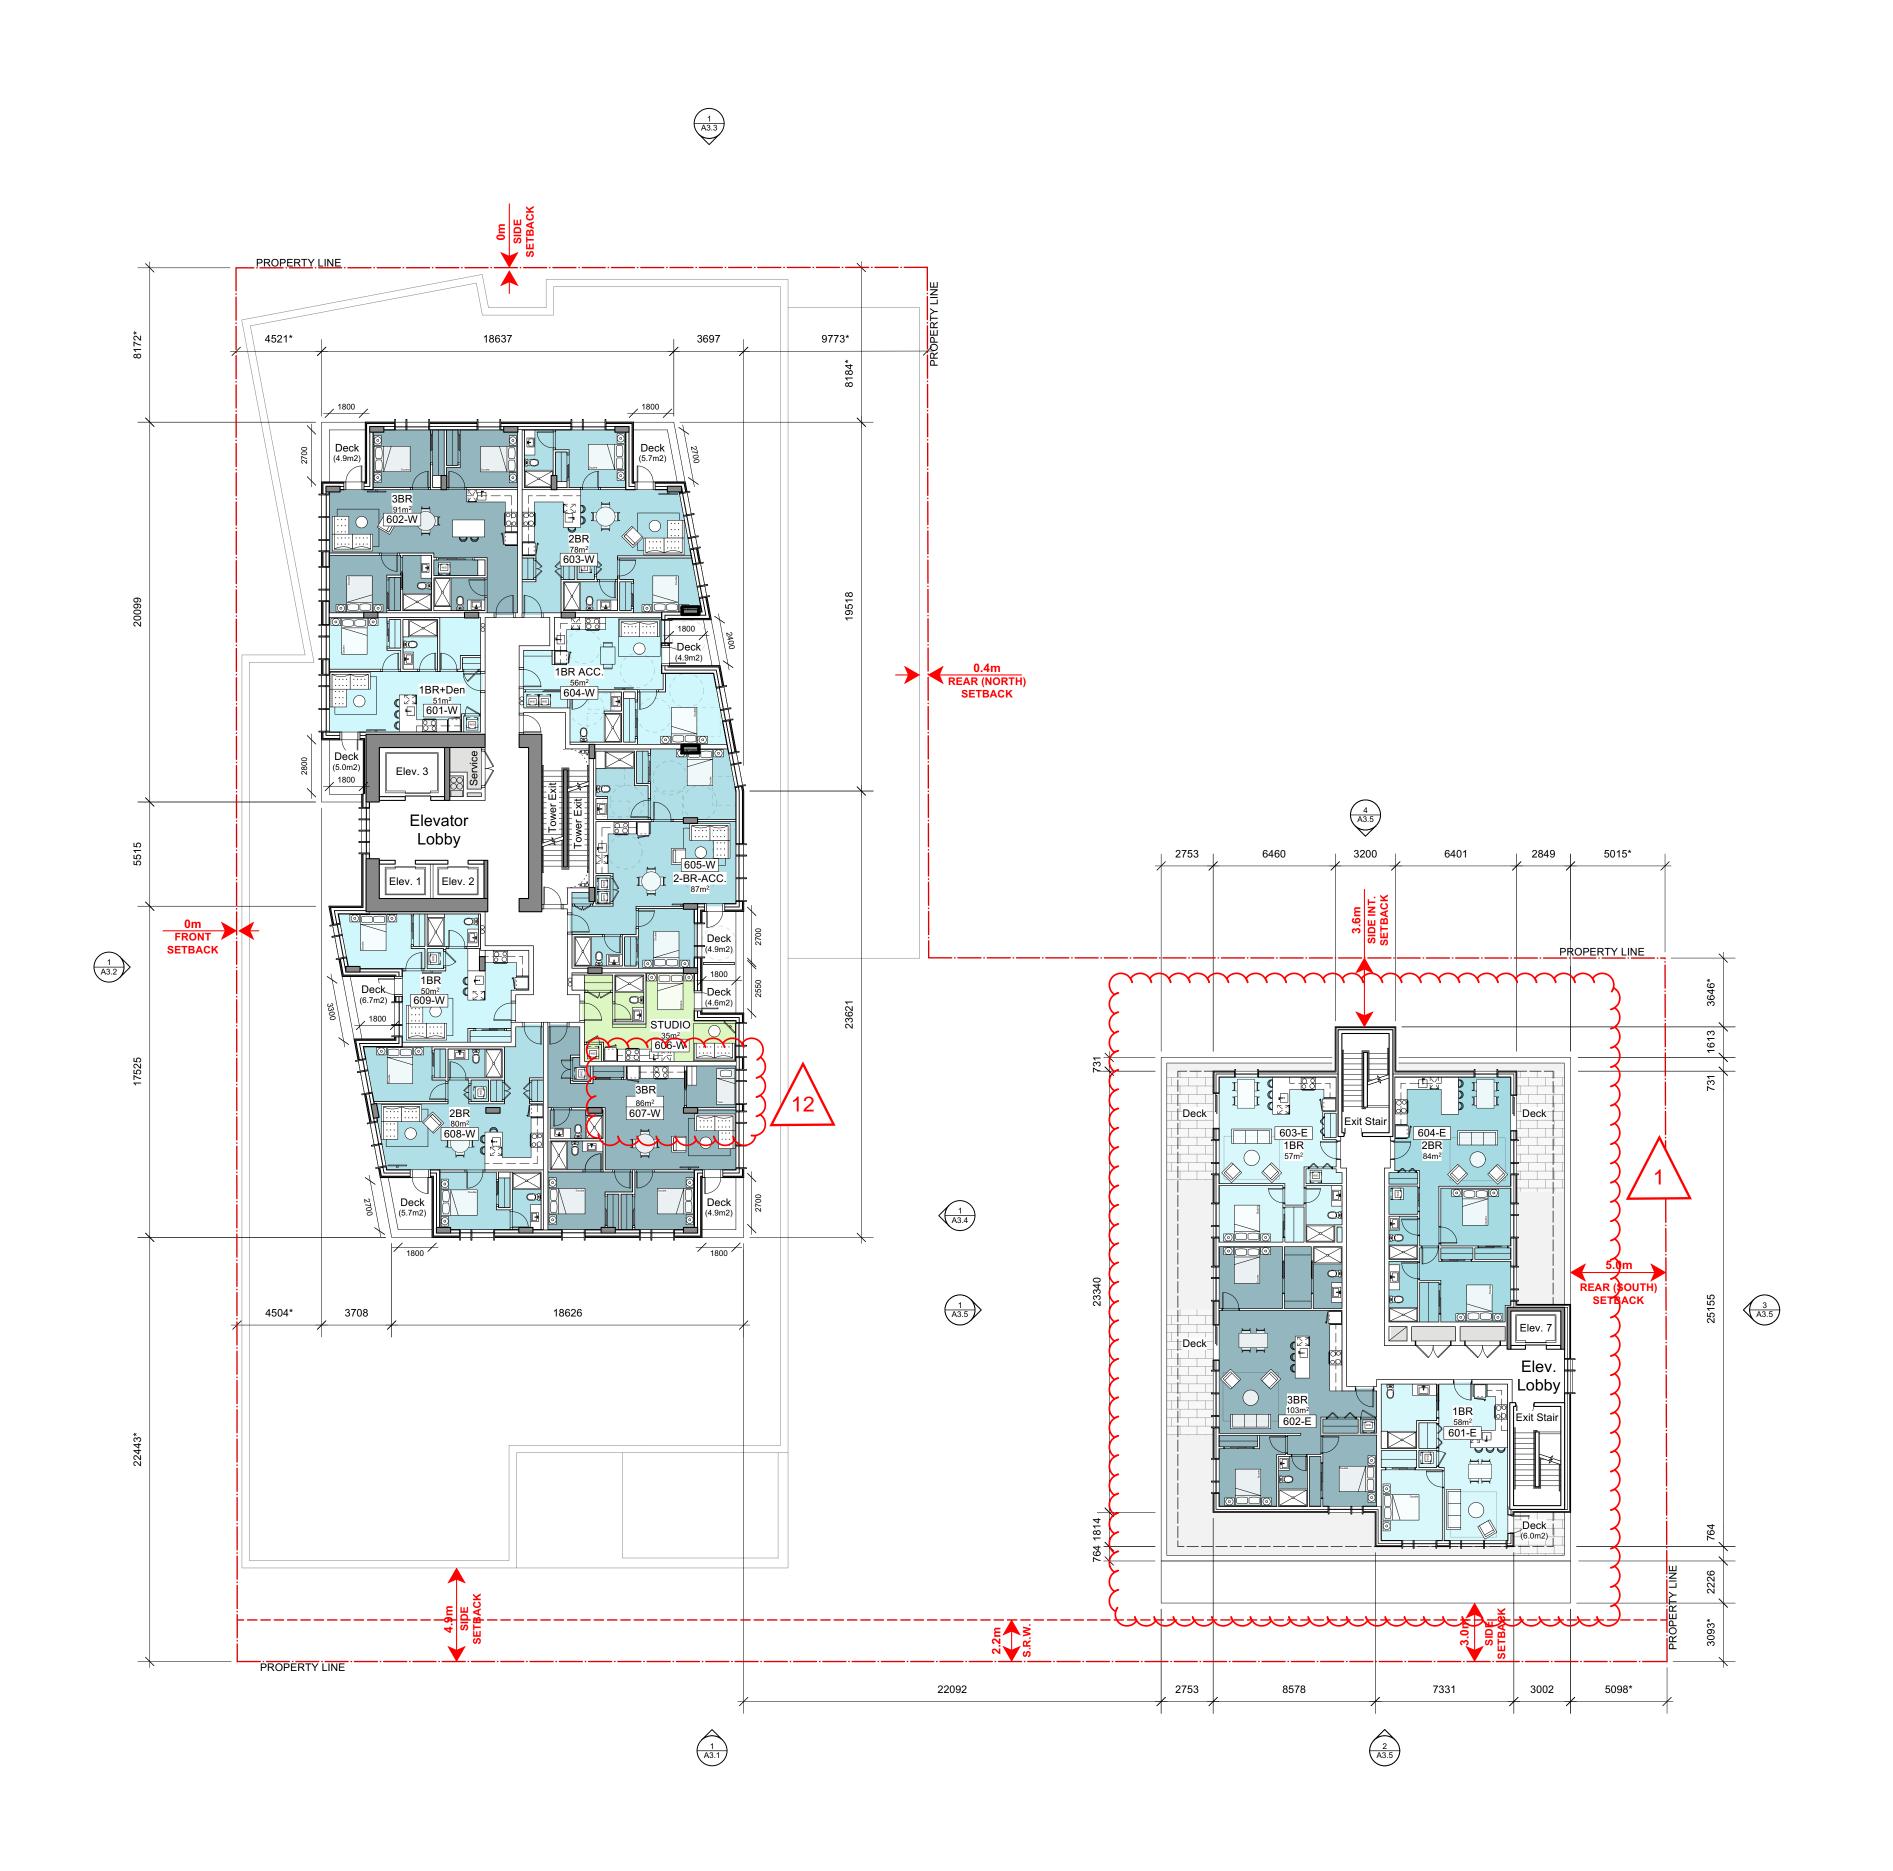



ANG TO LINE TO

THIS DOCUMENT HAS BEEN ELECTRONICALLY CERTIFIED WITH DIGITAL CERTIFICATE AND ENCRYPTION TECHNOLOGY AUTHORIZED BY THE AIBC. THE AUTHORITATIVE ORIGINAL IS IN ELECTRONIC FORM. ANY PRINTED VERSION CAN BE RELIED UPON AS A TRUE COPY OF THE ORIGINAL WHEN SUPPLIED BY DAUSTUDIO, BEARING IMAGES OF THE PROFESSIONAL SEAL AND DIGITAL CERTIFICATE OR WHEN PRINTED FROM THE DIGITALLY CERTIFIED ELECTRONIC FILE.

General Notes:

These preliminary plans are subject to refinement and confirmation of City policy and existing site conditions.

Refer to Landscape Architectural Plan for information on hardscaping, plantings and landscape site elements.

The proposed frontages within the public right-of-way are subject to coordination with the City of Victoria.


Revision Key:

1. Building height revisions (West Tower revised to 19 stories, East Tower revised to 6 stories).

mmmmm

12. Southeast corner units (_07-W) revised from 2-BDR+Den to 3-BDR homes. Note these layouts meet overall area guidelines however the third bedroom area is below guideline standards.

TULLING

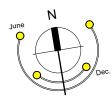

4	RZ/DP Resubmission	25.11.20
<u>/3</u>	Rezoning & Development Permit - ADP	25.10.02
<u>/2</u>	Rezoning & Development Permit	25.08.05
1	Development Tracker	25.06.24
rev no	description	date

copyright reserved. these drawings and designs are and at all times remain the property of DAUSTUDIO to be used for the project shown and may not be reproduced without written consent.

project name


1101 Yates St.

Victoria, BC

sheet title

Level 6 Plan

project no.	2441
drawing file 2441 - 1	101 Yates - 250923
scale	1:200
drawn by	JH
date issued	sheet no.
November 20, 2025	A2.10

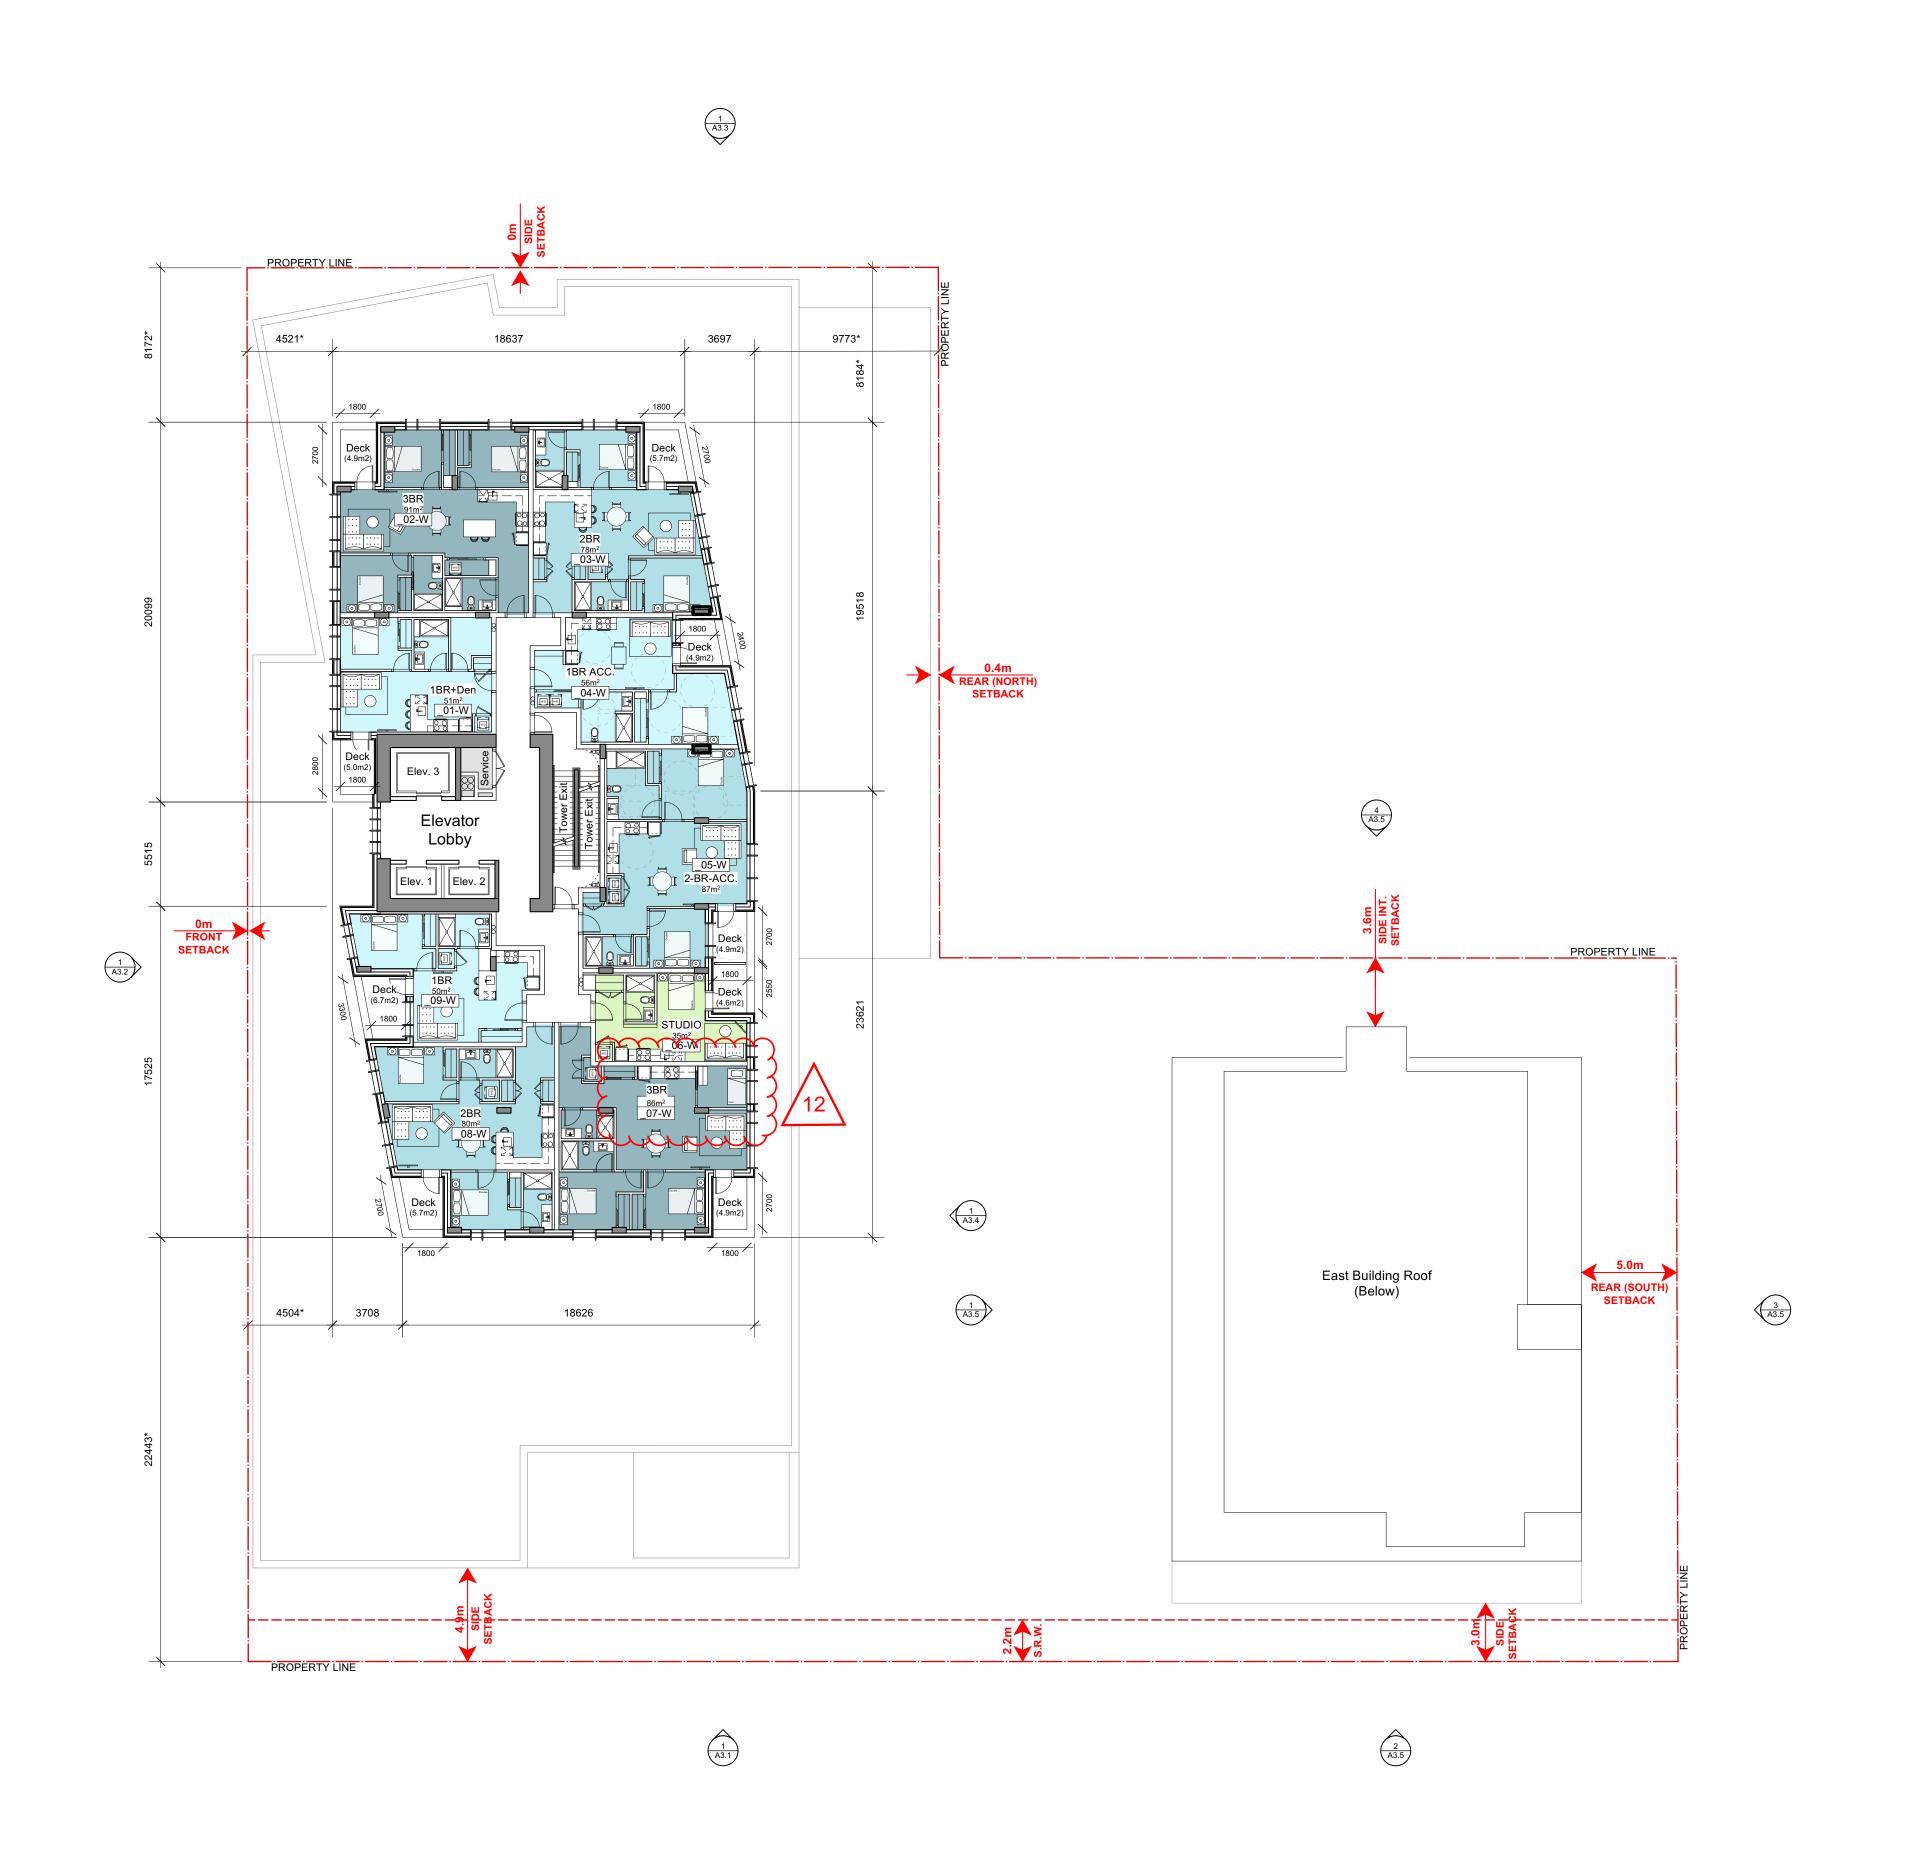



THIS DOCUMENT HAS BEEN ELECTRONICALLY CERTIFIED WITH DIGITAL CERTIFICATE AND ENCRYPTION TECHNOLOGY AUTHORIZED BY THE AIBC. THE AUTHORITATIVE ORIGINAL IS IN ELECTRONIC FORM. ANY PRINTED VERSION CAN BE RELIED UPON AS A TRUE COPY OF THE ORIGINAL WHEN SUPPLIED BY DAUSTUDIO, BEARING IMAGES OF THE PROFESSIONAL SEAL AND DIGITAL CERTIFICATE OR WHEN PRINTED FROM THE DIGITALLY CERTIFIED ELECTRONIC FILE.

General Notes:

These preliminary plans are subject to refinement and confirmation of City policy and existing site conditions.

Refer to Landscape Architectural Plan for information on hardscaping, plantings and landscape site elements.


The proposed frontages within the public right-of-way are subject to coordination with the City of Victoria.

Revision Key:

12. Southeast corner units (_07-W) revised from 2-BDR+Den to 3-BDR homes. Note these layouts meet overall area guidelines however the third bedroom area is below guideline standards.

mmmm

 $\sim\sim\sim\sim$

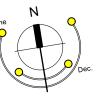

<u>/</u> 4\	RZ/DP Resubmission	25.11.20
<u>3</u>	Rezoning & Development Permit - ADP	25.10.02
2	Rezoning & Development Permit	25.08.05
1	Development Tracker	25.06.24
rev no	description	date

copyright reserved. these drawings and designs are and at all times remain the property of DAUSTUDIO to be used for the project shown and may not be reproduced without written consent.

project name


1101 Yates St.

Victoria, BC

sheet title

Level 7 - 19 Plan

project no. 244
project no. 244
drawing file 2441 - 1101 Yates - 25092
scale 1:20
drawn by J
date issued sheet no.
November 20, 2025 A2.10a

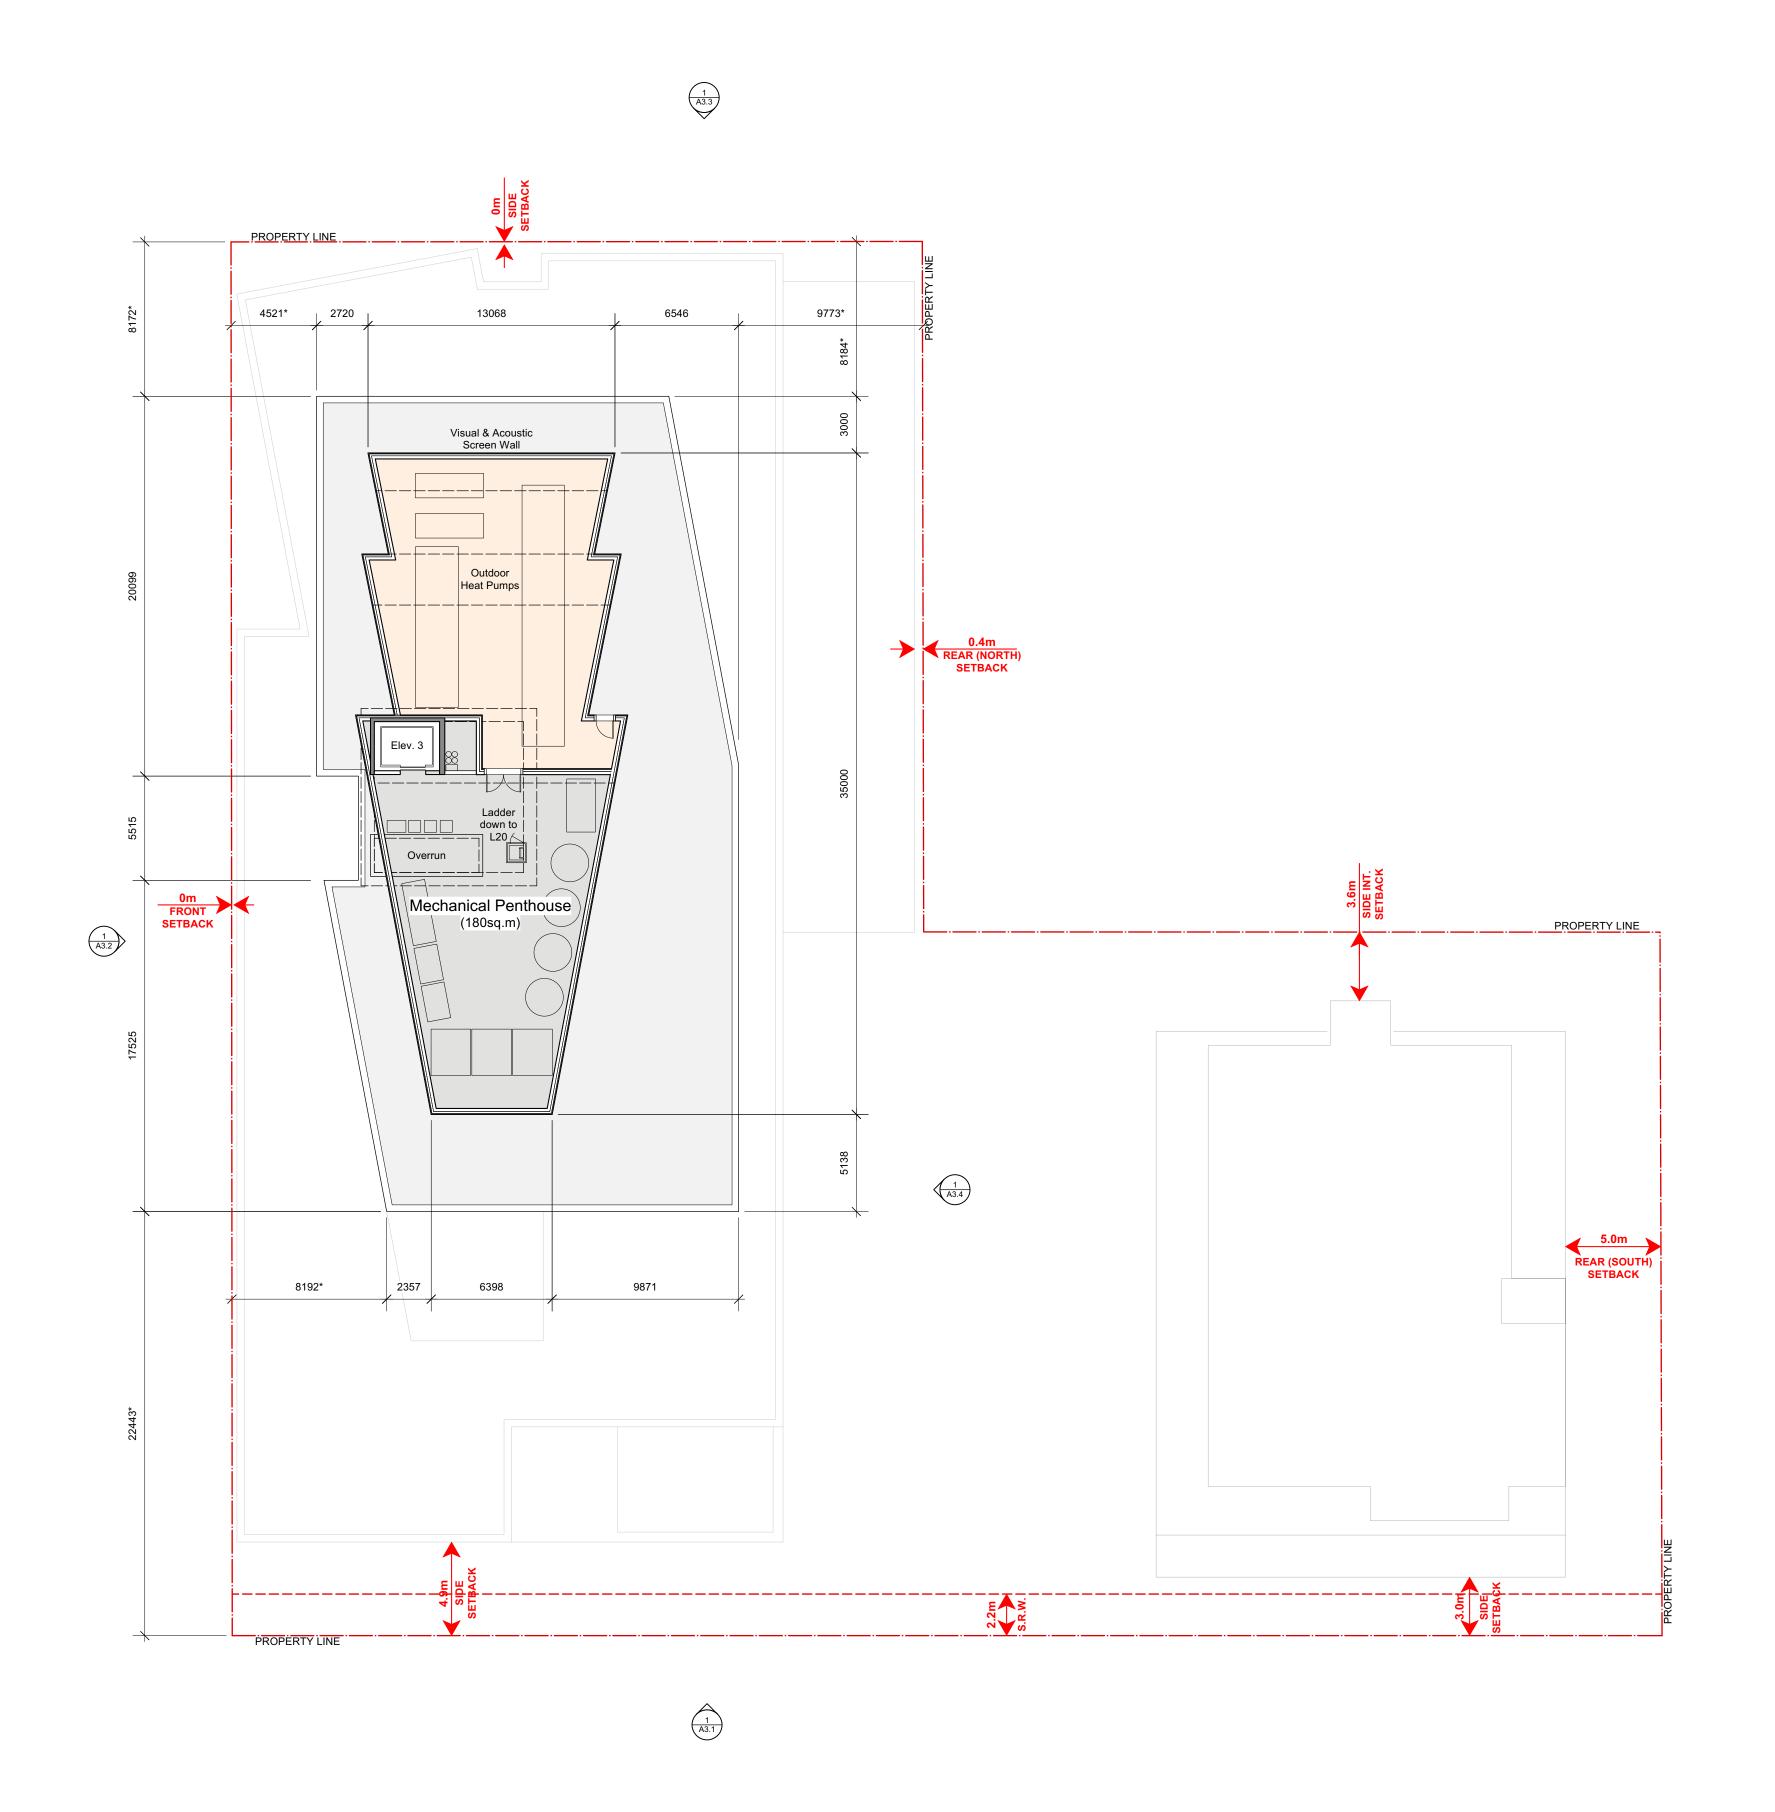



A SANGO MONTH SANG


THIS DOCUMENT HAS BEEN ELECTRONICALLY CERTIFIED WITH DIGITAL CERTIFICATE AND ENCRYPTION TECHNOLOGY AUTHORIZED BY THE AIBC. THE AUTHORITATIVE ORIGINAL IS IN ELECTRONIC FORM. ANY PRINTED VERSION CAN BE RELIED UPON AS A TRUE COPY OF THE ORIGINAL WHEN SUPPLIED BY DAUSTUDIO, BEARING IMAGES OF THE PROFESSIONAL SEAL AND DIGITAL CERTIFICATE OR WHEN PRINTED FROM THE DIGITALLY CERTIFIED ELECTRONIC FILE.

General Notes:

These preliminary plans are subject to refinement and confirmation of City policy and existing site conditions.

Refer to Landscape Architectural Plan for information on hardscaping, plantings and landscape site elements.

The proposed frontages within the public right-of-way are subject to coordination with the City of Victoria.

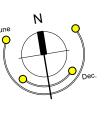

4	RZ/DP Resubmission	25.11.20
<u>/</u> 3\	Rezoning & Development Permit - ADP	25.10.02
2	Rezoning & Development Permit	25.08.05
1	Development Tracker	25.06.24
rev no	description	date

copyright reserved. these drawings and designs are and at all times remain the property of DAUSTUDIO to be used for the project shown and may not be reproduced without written consent.

project name

1101 Yates St.


Victoria, BC

sheet title

Penthouse Plan

project no. 2441	
drawing file 2441 - 1101 Yates - 250923	
scale	1:200
drawn by	JH
date issued	sheet no.
November 20, 2025	A2.11



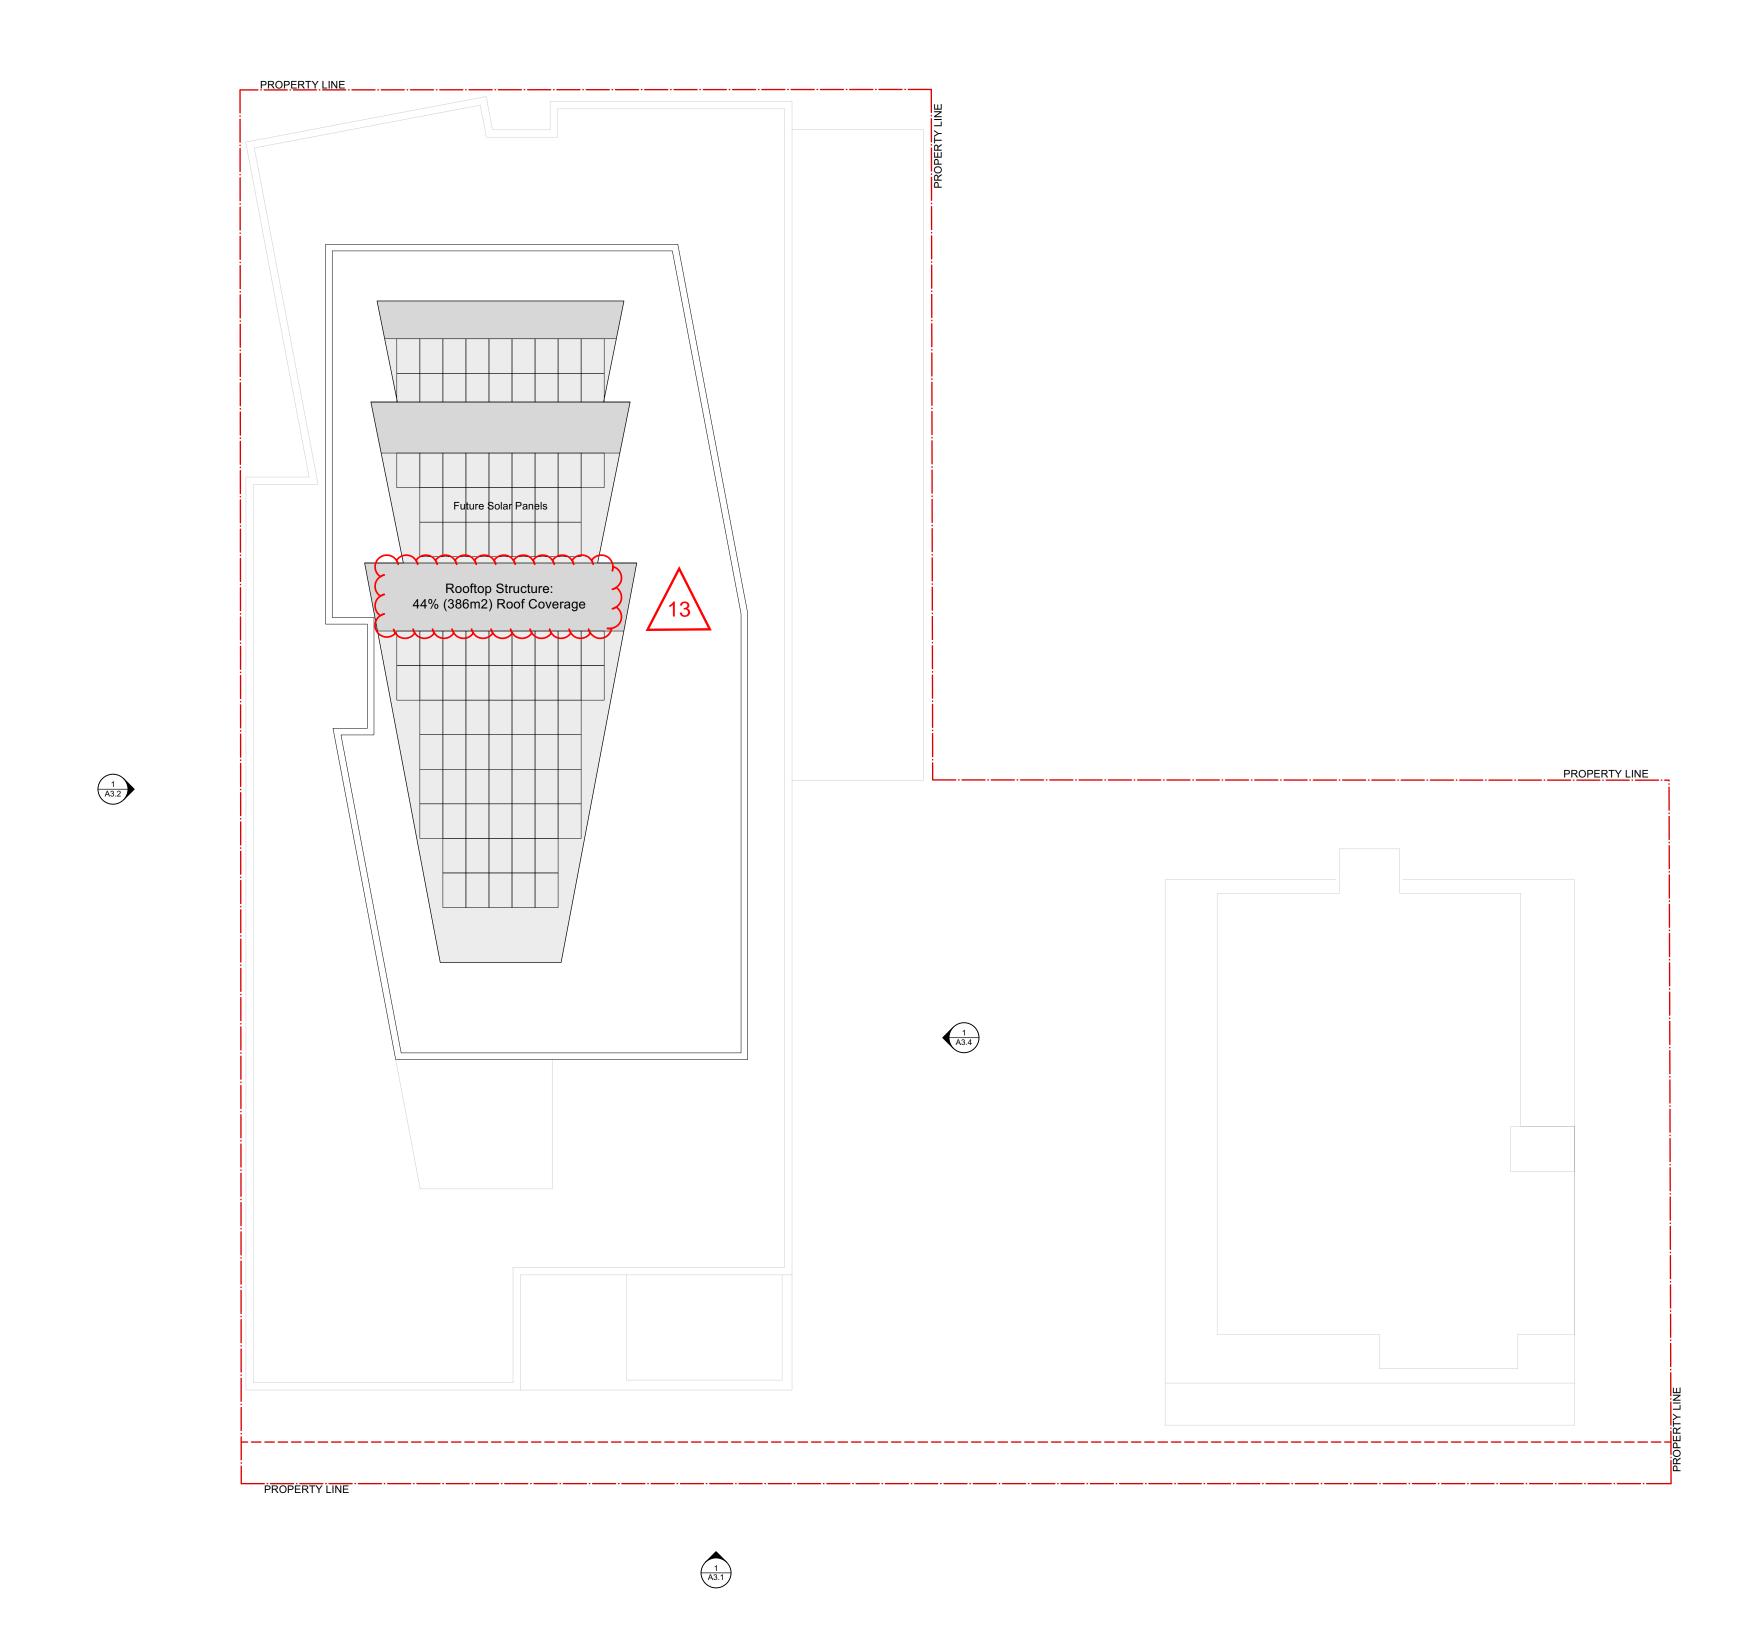




THIS DOCUMENT HAS BEEN ELECTRONICALLY CERTIFIED WITH DIGITAL CERTIFICATE AND ENCRYPTION TECHNOLOGY AUTHORIZED BY THE AIBC. THE AUTHORITATIVE ORIGINAL IS IN ELECTRONIC FORM. ANY PRINTED VERSION CAN BE RELIED UPON AS A TRUE COPY OF THE ORIGINAL WHEN SUPPLIED BY DAUSTUDIO, BEARING IMAGES OF THE PROFESSIONAL SEAL AND DIGITAL CERTIFICATE OR WHEN PRINTED FROM THE DIGITALLY CERTIFIED ELECTRONIC FILE.

General Notes:

These preliminary plans are subject to refinement and confirmation of City policy and existing site conditions.

Refer to Landscape Architectural Plan for information on hardscaping, plantings and landscape site elements.


The proposed frontages within the public right-of-way are subject to coordination with the City of Victoria.

Revision Key:

13. Roof coverage noted for mechanical penthouse and structure for future PV panel arrays.

minimi

 \sim

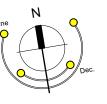

4	RZ/DP Resubmission	25.11.20
3	Rezoning & Development Permit - ADP	25.10.02
2	Rezoning & Development Permit	25.08.05
1	Development Tracker	25.06.24
rev no	description	date
	1	•

copyright reserved. these drawings and designs are and at all times remain the property of DAUSTUDIO to be used for the project shown and may not be reproduced without written consent.

project name

1101 Yates St.

Victoria, BC

sheet title
Roof Plan

project no.			2441
drawing file	2441 - 1 ⁻	101	Yates - 250923
scale			1:200
drawn by			JH

ovember 20, 2025 A2 12



South Elevation (View Street) - West & East Buildings
Scale: 1:200



owned and operated by FM D'AMBROSIO architect Inc.


THIS DOCUMENT HAS BEEN ELECTRONICALLY CERTIFIED WITH DIGITAL CERTIFICATE AND ENCRYPTION TECHNOLOGY AUTHORIZED BY THE AIBC. THE AUTHORITATIVE ORIGINAL IS IN ELECTRONIC FORM. ANY PRINTED VERSION CAN BE RELIED UPON AS A TRUE COPY OF THE ORIGINAL WHEN SUPPLIED BY DAUSTUDIO, BEARING IMAGES OF THE PROFESSIONAL SEAL AND DIGITAL CERTIFICATE OR WHEN PRINTED FROM THE DIGITALLY CERTIFIED ELECTRONIC FILE.

General Notes:

 These preliminary plans are subject to refinement and confirmation of City policy and existing site conditions.

 \sim

Refer to Landscape Architectural Plan for information on hardscaping, plantings and landscape site elements.

 The proposed frontages within the public

3. The proposed frontages within the public right-of-way are subject to coordination with the City of Victoria.

Revision Key:

1. Building height revisions (West Tower revised to 19 stories, East Tower revised to 6 stories).

<u>4</u>	RZ/DP Resubmission	25.11.20
<u></u>	Rezoning & Development Permit - ADP	25.10.02
2	Rezoning & Development Permit	25.08.05
<u>1</u>	Development Tracker	25.06.24
rev no	description	date

copyright reserved. these drawings and designs are and at all times remain the property of DAUSTUDIO to be used for the project shown and may not be reproduced without written consent.

project name

1101 Yates St.

Victoria, BC

sheet title

Elevations

project no.	2441
drawing file 2441 - 1	101 Yates - 250923
scale	1:200
drawn by	JH
date issued	sheet no.
November 20, 2025	A3.1








THIS DOCUMENT HAS BEEN ELECTRONICALLY CERTIFIED WITH DIGITAL CERTIFICATE AND ENCRYPTION TECHNOLOGY AUTHORIZED BY THE AIBC. THE AUTHORITATIVE ORIGINAL IS IN ELECTRONIC FORM. ANY PRINTED VERSION CAN BE RELIED UPON AS A TRUE COPY OF THE ORIGINAL WHEN SUPPLIED BY DAUSTUDIO, BEARING IMAGES OF THE PROFESSIONAL SEAL AND DIGITAL CERTIFICATE OR WHEN PRINTED FROM THE DIGITALLY CERTIFIED ELECTRONIC FILE.

General Notes:

Materials Key

Aluminum Curtain Wall with High-Performance Glazing: Light Bronze Anodized

3 Pre-finished Metal Panels: Champagne Finish, Flat

Cement Panels: Sandstone Finish

6 Architectural Concrete

7 Ground-Face Concrete Block

8 Stucco Soffit: Warm White

9 Fiberglass or vinyl Windows. Charcoal

Pre-finished Metal Panels: Champagne Finish, Custom Corrugated Profile

5 Clear Glazed, Metal Framed Guards: Light Bronze Finish

These preliminary plans are subject to refinement and confirmation of City policy and existing site conditions.


 \sim

Refer to Landscape Architectural Plan for information on hardscaping, plantings and landscape site elements.

3. The proposed frontages within the public right-of-way are subject to coordination with the City of Victoria.

Revision Key:

1. Building height revisions (West Tower revised to 19 stories, East Tower revised to 6 stories).

7	RZ/DP Resubmission	25.11.20
7	Rezoning & Development Permit - ADP	25.10.02
7	Rezoning & Development Permit	25.08.05
7	Development Tracker	25.06.24
10	description	date

copyright reserved. these drawings and designs are and at all times remain the property of DAUSTUDIO to be used for the project shown and may not be reproduced without written consent.

project name


1101 Yates St.

Victoria, BC

sheet title

Elevations

project no.	2441
drawing file 2441 - 1	101 Yates - 250923
scale	1:200
drawn by	JH
date issued	sheet no.
November 20, 2025	A3.2

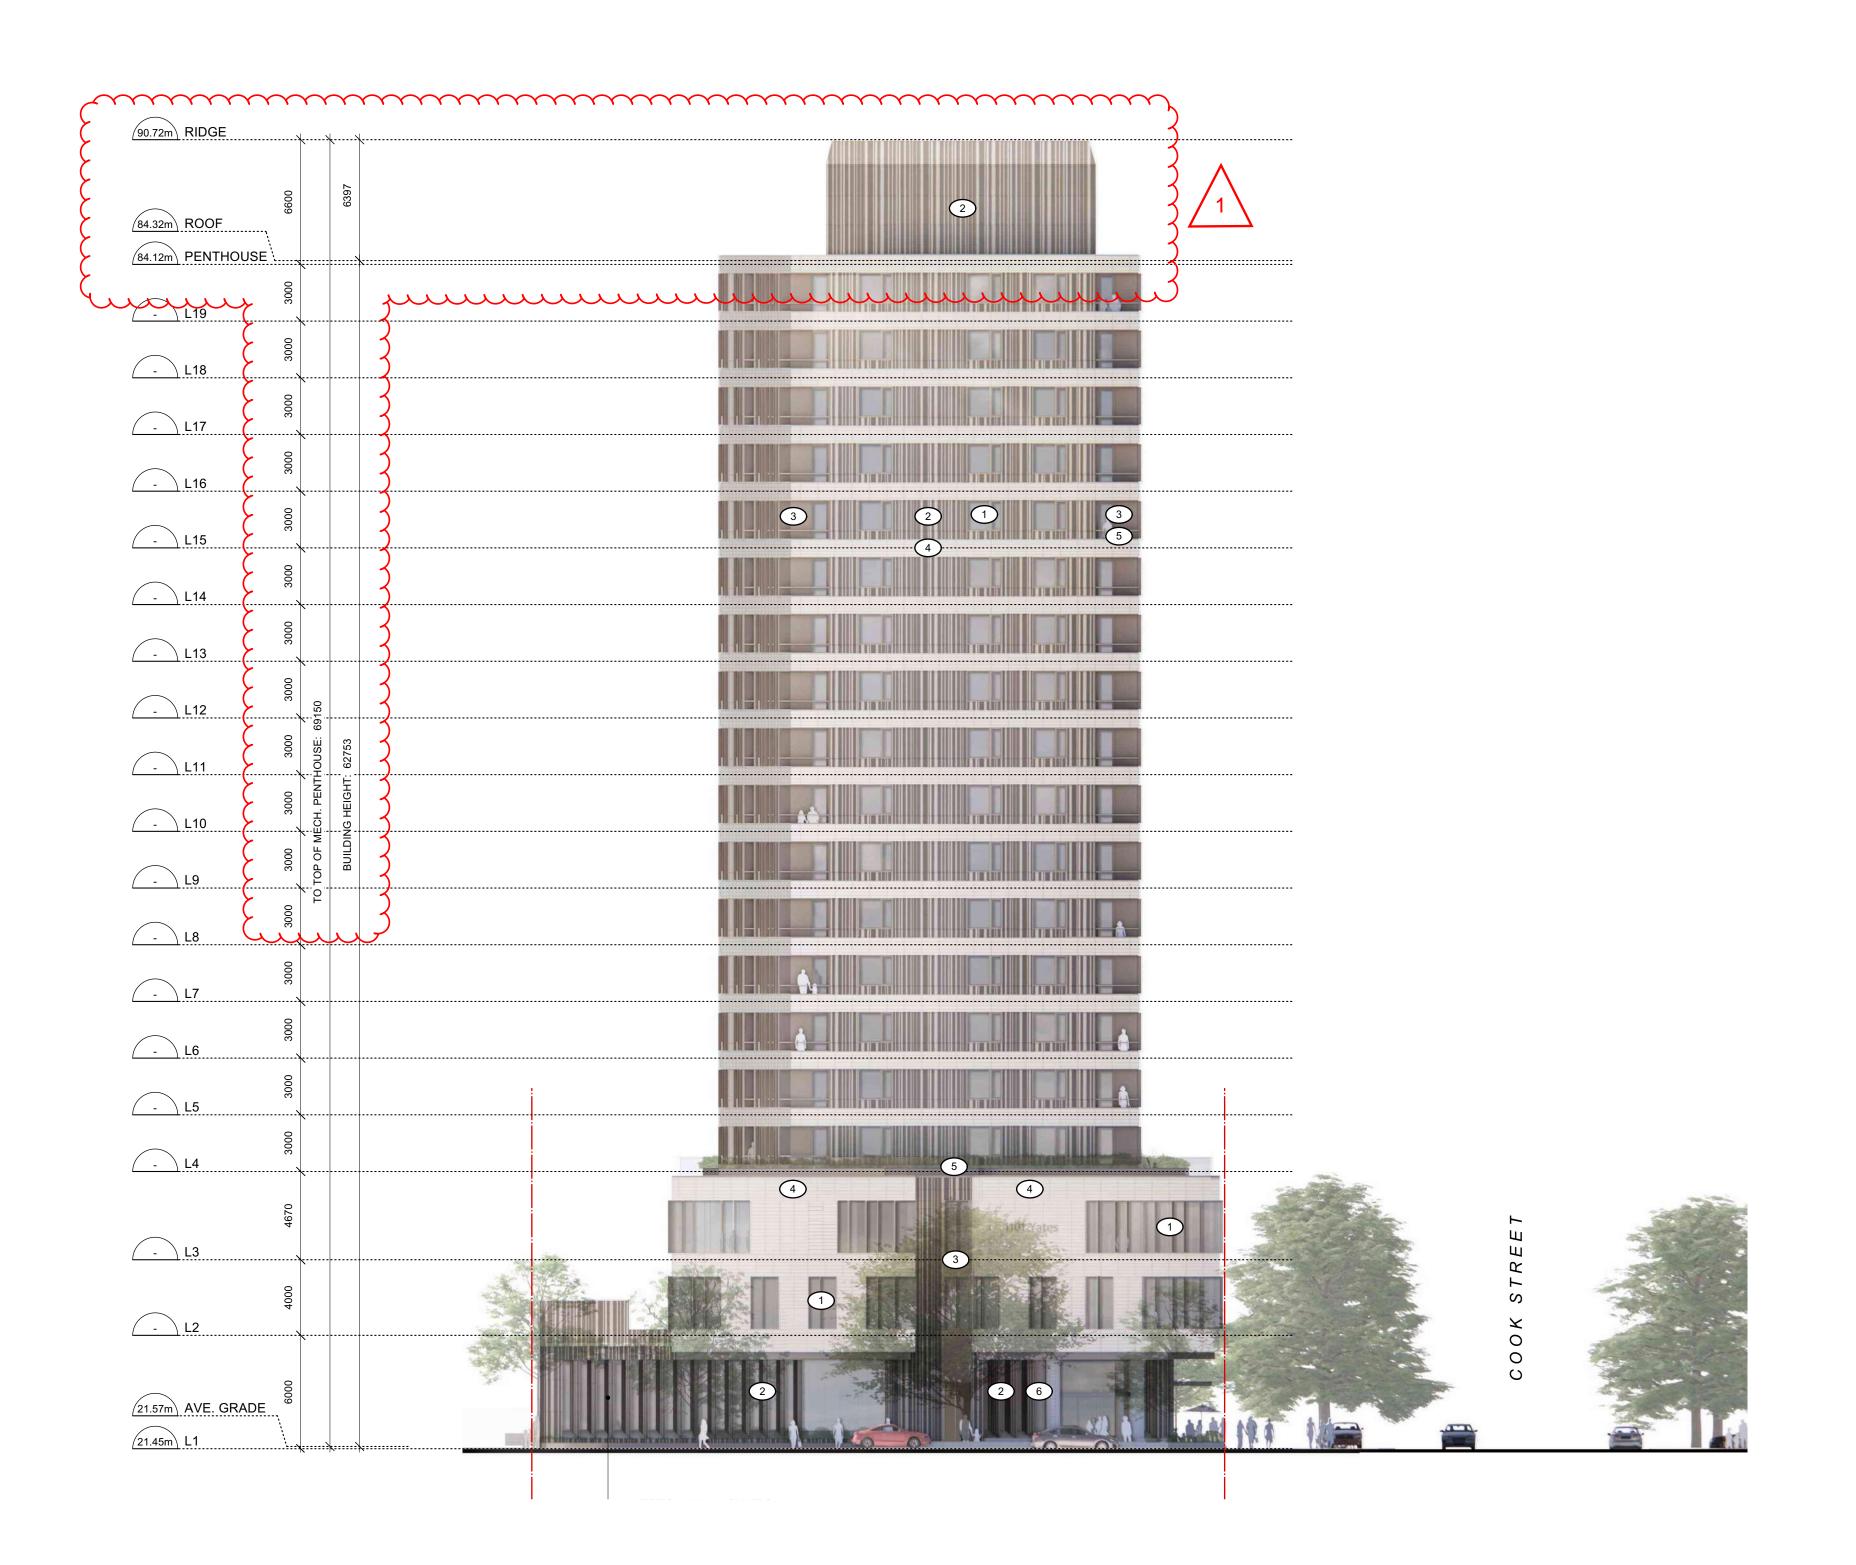

North Elevation (Yates Street) - West Building
Scale: 1:200



owned and operated by FM D'AMBROSIO architect Inc.



Pre-finished Metal Panels: Champagne Finish, Custom Corrugated Profile	2025-11-21
Pre-finished Metal Panels: Champagne Finish, Flat	THIS DOCUMENT HAS BEEN ELECTRONICALLY CERTIFIED WITH DIGITAL CERTIFICATE AND ENCRYPTION TECHNOLOGY AUTHORIZED BY THE AIBC. THE AUTHORITATIVE ORIGINAL IS IN ELECTRONIC FORM. ANY PRINTED VERSION
4 Cement Panels: Sandstone Finish	CAN BE RELIED UPON AS A TRUE COPY OF THE ORIGINAL WHEN SUPPLIED BY DAUSTUDIO, BEARING IMAGES OF THE PROFESSIONAL SEAL AND DIGITAL CERTIFICATE OR WHEN PRINTED FROM THE DIGITALLY CERTIFIED ELECTRONIC FILE.
Clear Glazed, Metal Framed Guards: Light Bronze Finish	General Notes: 1. These preliminary plans are subject to refinement and confirmation of City policy and
6 Architectural Concrete	existing site conditions. 2. Refer to Landscape Architectural Plan for information on hardscaping, plantings and landscape site elements.
7 Ground-Face Concrete Block	The proposed frontages within the public right-of-way are subject to coordination with the City of Victoria.
8 Stucco Soffit: Warm White	Revision Key: 1. Building height revisions (West Tower revised to 19 stories, East Tower revised to 6 stories).
9 Fiberglass or vinyl Windows. Charcoal	(minimizer

Materials Key

Aluminum Curtain Wall with High-Performance Glazing: Light Bronze Anodized

4	RZ/DP Resubmission	25.11.20
3	Rezoning & Development Permit - ADP	25.10.02
2	Rezoning & Development Permit	25.08.05
1\	Development Tracker	25.06.24
no	description	date

copyright reserved. these drawings and designs are and at all times remain the property of DAUSTUDIO to be used for the project shown and may not be reproduced without written consent.

project name

1101 Yates St.

Victoria, BC

sheet title

Elevations

project no.	2441
drawing file 2441 - 1	101 Yates - 250923
scale	1:200
drawn by	JH
date issued	sheet no.
November 20, 2025	A3.3






Materials Key

- Aluminum Curtain Wall with High-Performance Glazing: Light Bronze Anodized
- Pre-finished Metal Panels: Champagne Finish, Custom Corrugated Profile
- 3 Pre-finished Metal Panels: Champagne Finish, Flat
- 4 Cement Panels: Sandstone Finish
- 5 Clear Glazed, Metal Framed Guards: Light Bronze Finish
- 6 Architectural Concrete
- 7 Ground-Face Concrete Block
- 8 Stucco Soffit: Warm White
- 9 Fiberglass or vinyl Windows. Charcoal



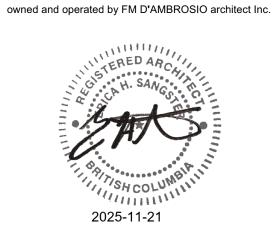

DAUSTUDIO

THIS DOCUMENT HAS BEEN ELECTRONICALLY CERTIFIED WITH DIGITAL CERTIFICATE AND ENCRYPTION TECHNOLOGY AUTHORIZED BY THE AIBC. THE AUTHORITATIVE ORIGINAL IS IN ELECTRONIC FORM. ANY PRINTED VERSION CAN BE RELIED UPON AS A TRUE COPY OF THE ORIGINAL WHEN SUPPLIED BY DAUSTUDIO, BEARING IMAGES OF THE PROFESSIONAL SEAL AND DIGITAL CERTIFICATE OR WHEN PRINTED FROM THE DIGITALLY CERTIFIED ELECTRONIC FILE.

General Notes:

 These preliminary plans are subject to refinement and confirmation of City policy and existing site conditions.

Refer to Landscape Architectural Plan for information on hardscaping, plantings and landscape site elements.

The proposed frontages within the public right-of-way are subject to coordination with the City of Victoria.

Revision Key:

1. Building height revisions (West Tower revised to 19 stories, East Tower revised to 6 stories).

mmmm

RZ/DP Resubmission 25.11.20
Rezoning & 25.10.02
Rezoning & 25.10.02
Rezoning & 25.08.05
Development Permit 25.06.24
Development Tracker 25.06.24
Development date

copyright reserved. these drawings and designs are and at all times remain the property of DAUSTUDIO to be used for the project shown and may not be reproduced without written consent.

project name

1101 Yates St.

Victoria, BC

sheet title

Elevations

project no. 2441

drawing file 2441 - 1101 Yates - 250923


scale 1:200

drawn by JH

date issued sheet no.


November 20, 2025 A3.4

East Elevation - West Building
Scale: 1:200

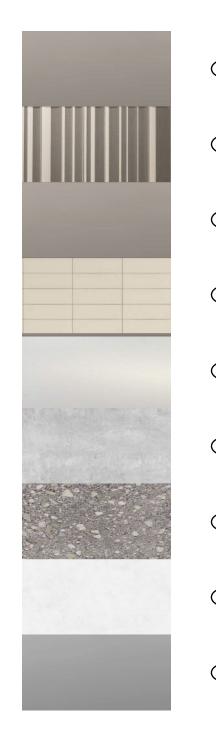


Materials Key

- Aluminum Curtain Wall with High-Performance Glazing: Light Bronze Anodized
- Pre-finished Metal Panels: Champagne Finish, Custom Corrugated Profile
- 3 Pre-finished Metal Panels: Champagne Finish, Flat
- 4 Cement Panels: Sandstone Finish
- 5 Clear Glazed, Metal Framed Guards: Light Bronze Finish
- 6 Architectural Concrete
- 7 Ground-Face Concrete Block
- 8 Stucco Soffit: Warm White
- 9 Fiberglass or vinyl Windows. Charcoal

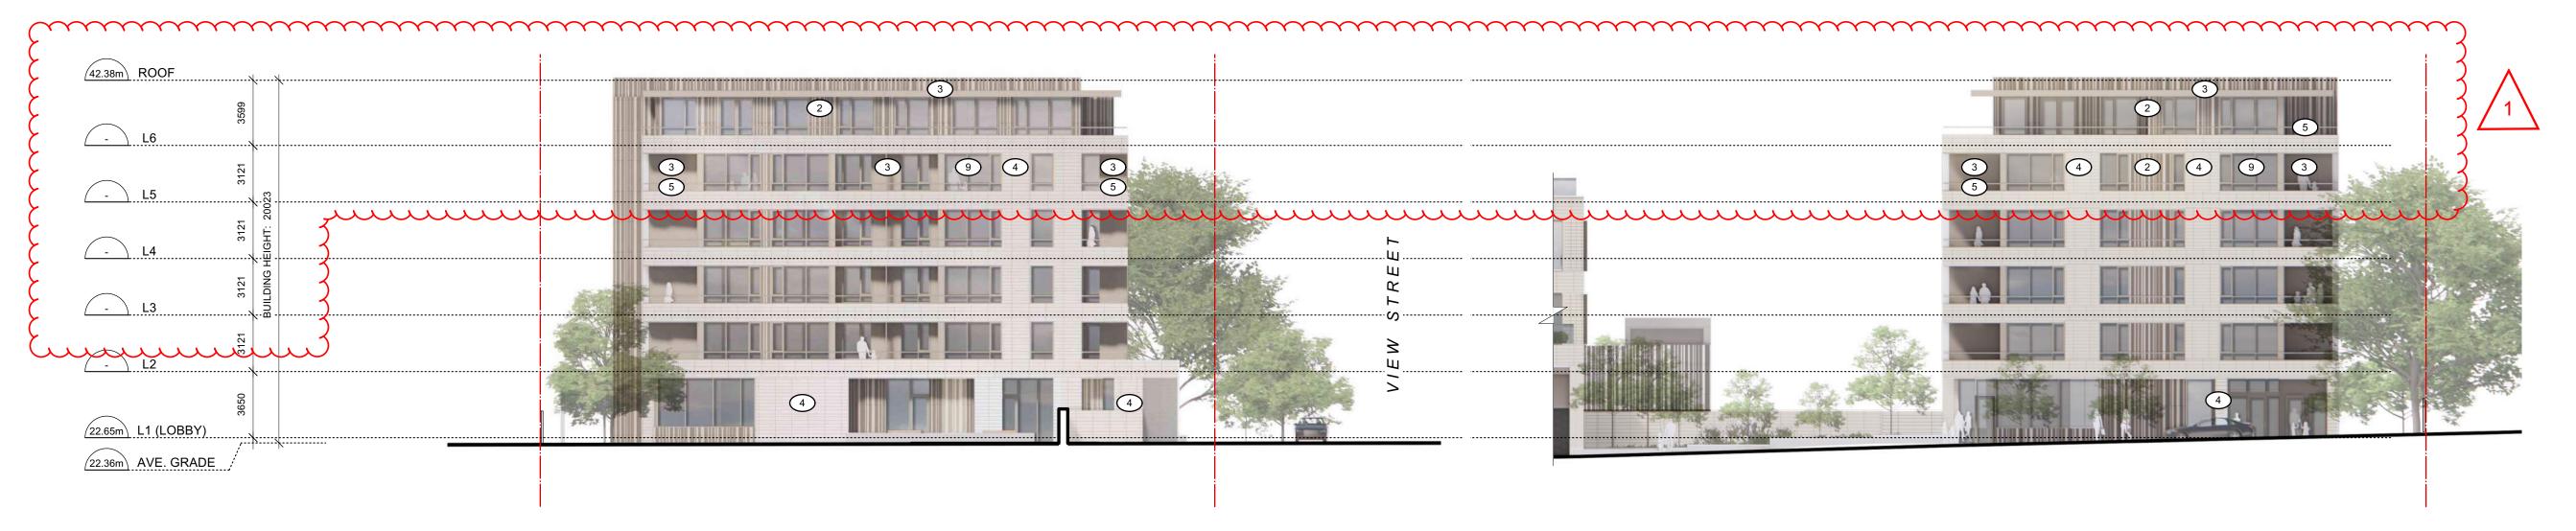

West Elevation - East Building
Scale: 1:200

South Elevation (Yates Street) - East Building
Scale: 1:200

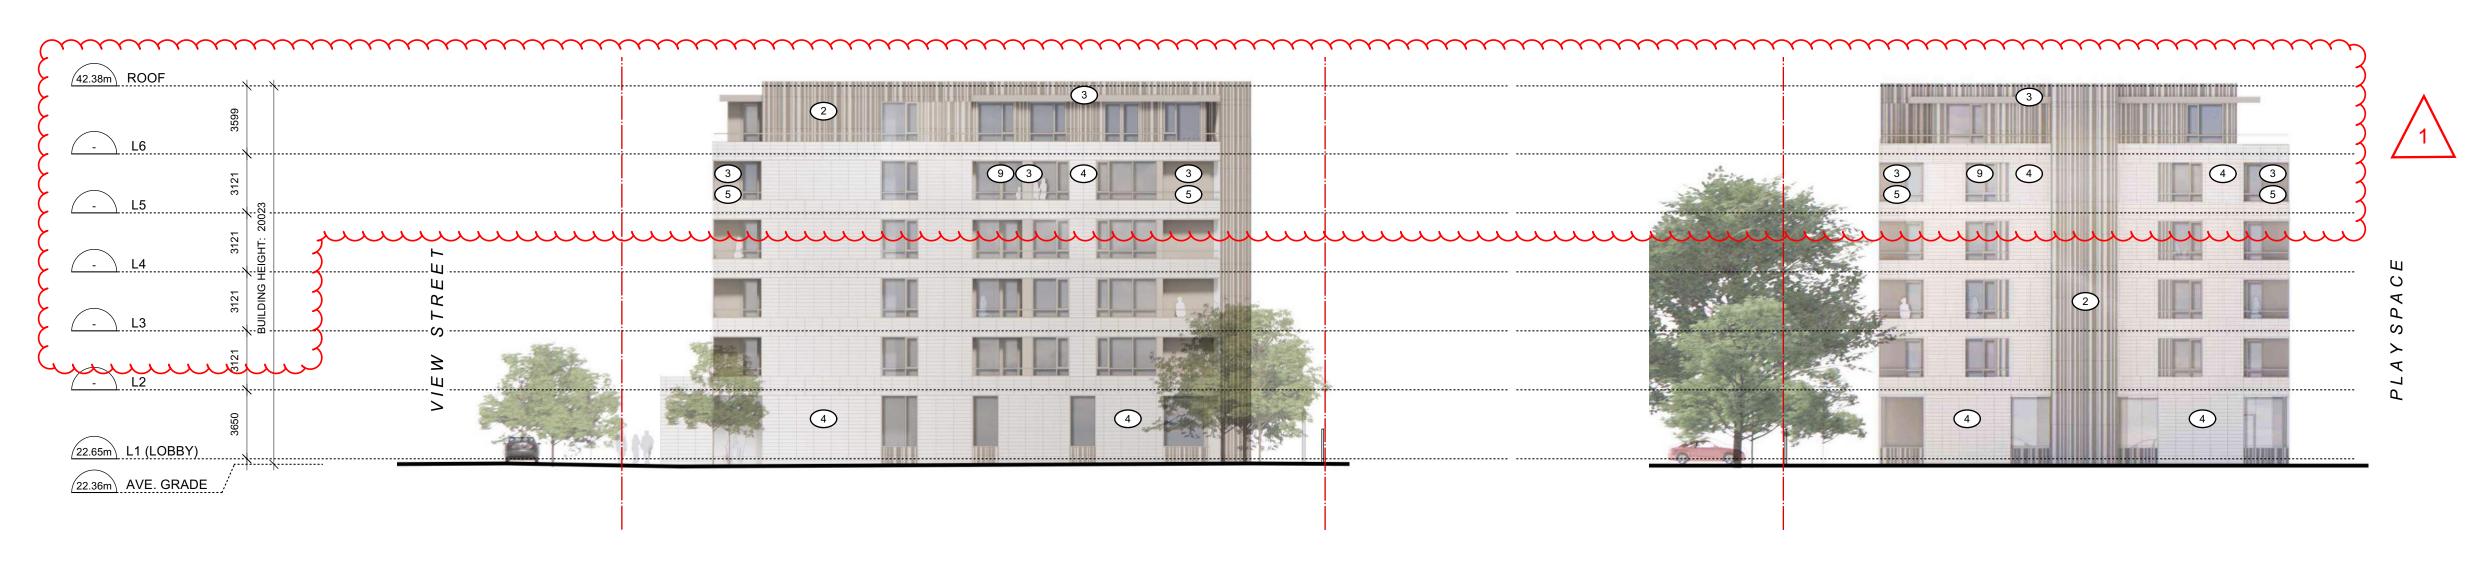


North Elevation - East Building
Scale: 1:200



owned and operated by FM D'AMBROSIO architect Inc.


THIS DOCUMENT HAS BEEN ELECTRONICALLY CERTIFIED WITH DIGITAL CERTIFICATE AND ENCRYPTION TECHNOLOGY AUTHORIZED BY THE AIBC. THE AUTHORITATIVE ORIGINAL IS IN ELECTRONIC FORM. ANY PRINTED VERSION CAN BE RELIED UPON AS A TRUE COPY OF THE ORIGINAL WHEN SUPPLIED BY DAUSTUDIO, BEARING IMAGES OF THE PROFESSIONAL SEAL AND DIGITAL CERTIFICATE OR WHEN PRINTED FROM THE DIGITALLY CERTIFIED ELECTRONIC FILE.

General Notes:

 These preliminary plans are subject to refinement and confirmation of City policy and existing site conditions.

Refer to Landscape Architectural Plan for information on hardscaping, plantings and landscape site elements.

The proposed frontages within the public right-of-way are subject to coordination with the City of Victoria.

Revision Key:

1. Building height revisions (West Tower revised to 19 stories, East Tower revised to 6 stories).

RZ/DP Resubmission 25.11.20
Rezoning & 25.10.02
Rezoning & 25.10.02
Rezoning & 25.08.05
Development Permit 25.06.24
Development Tracker 25.06.24

description date

copyright reserved. these drawings and designs are and at all times remain the property of DAUSTUDIO to be used for the project shown and may not be reproduced without written consent.

project name

1101 Yates St.

Victoria, BC

sheet title

Elevations

project no. 2441


drawing file 2441 - 1101 Yates - 250923

scale 1:200


drawn by JH

date issued sheet no.

November 20, 2025 A3.5

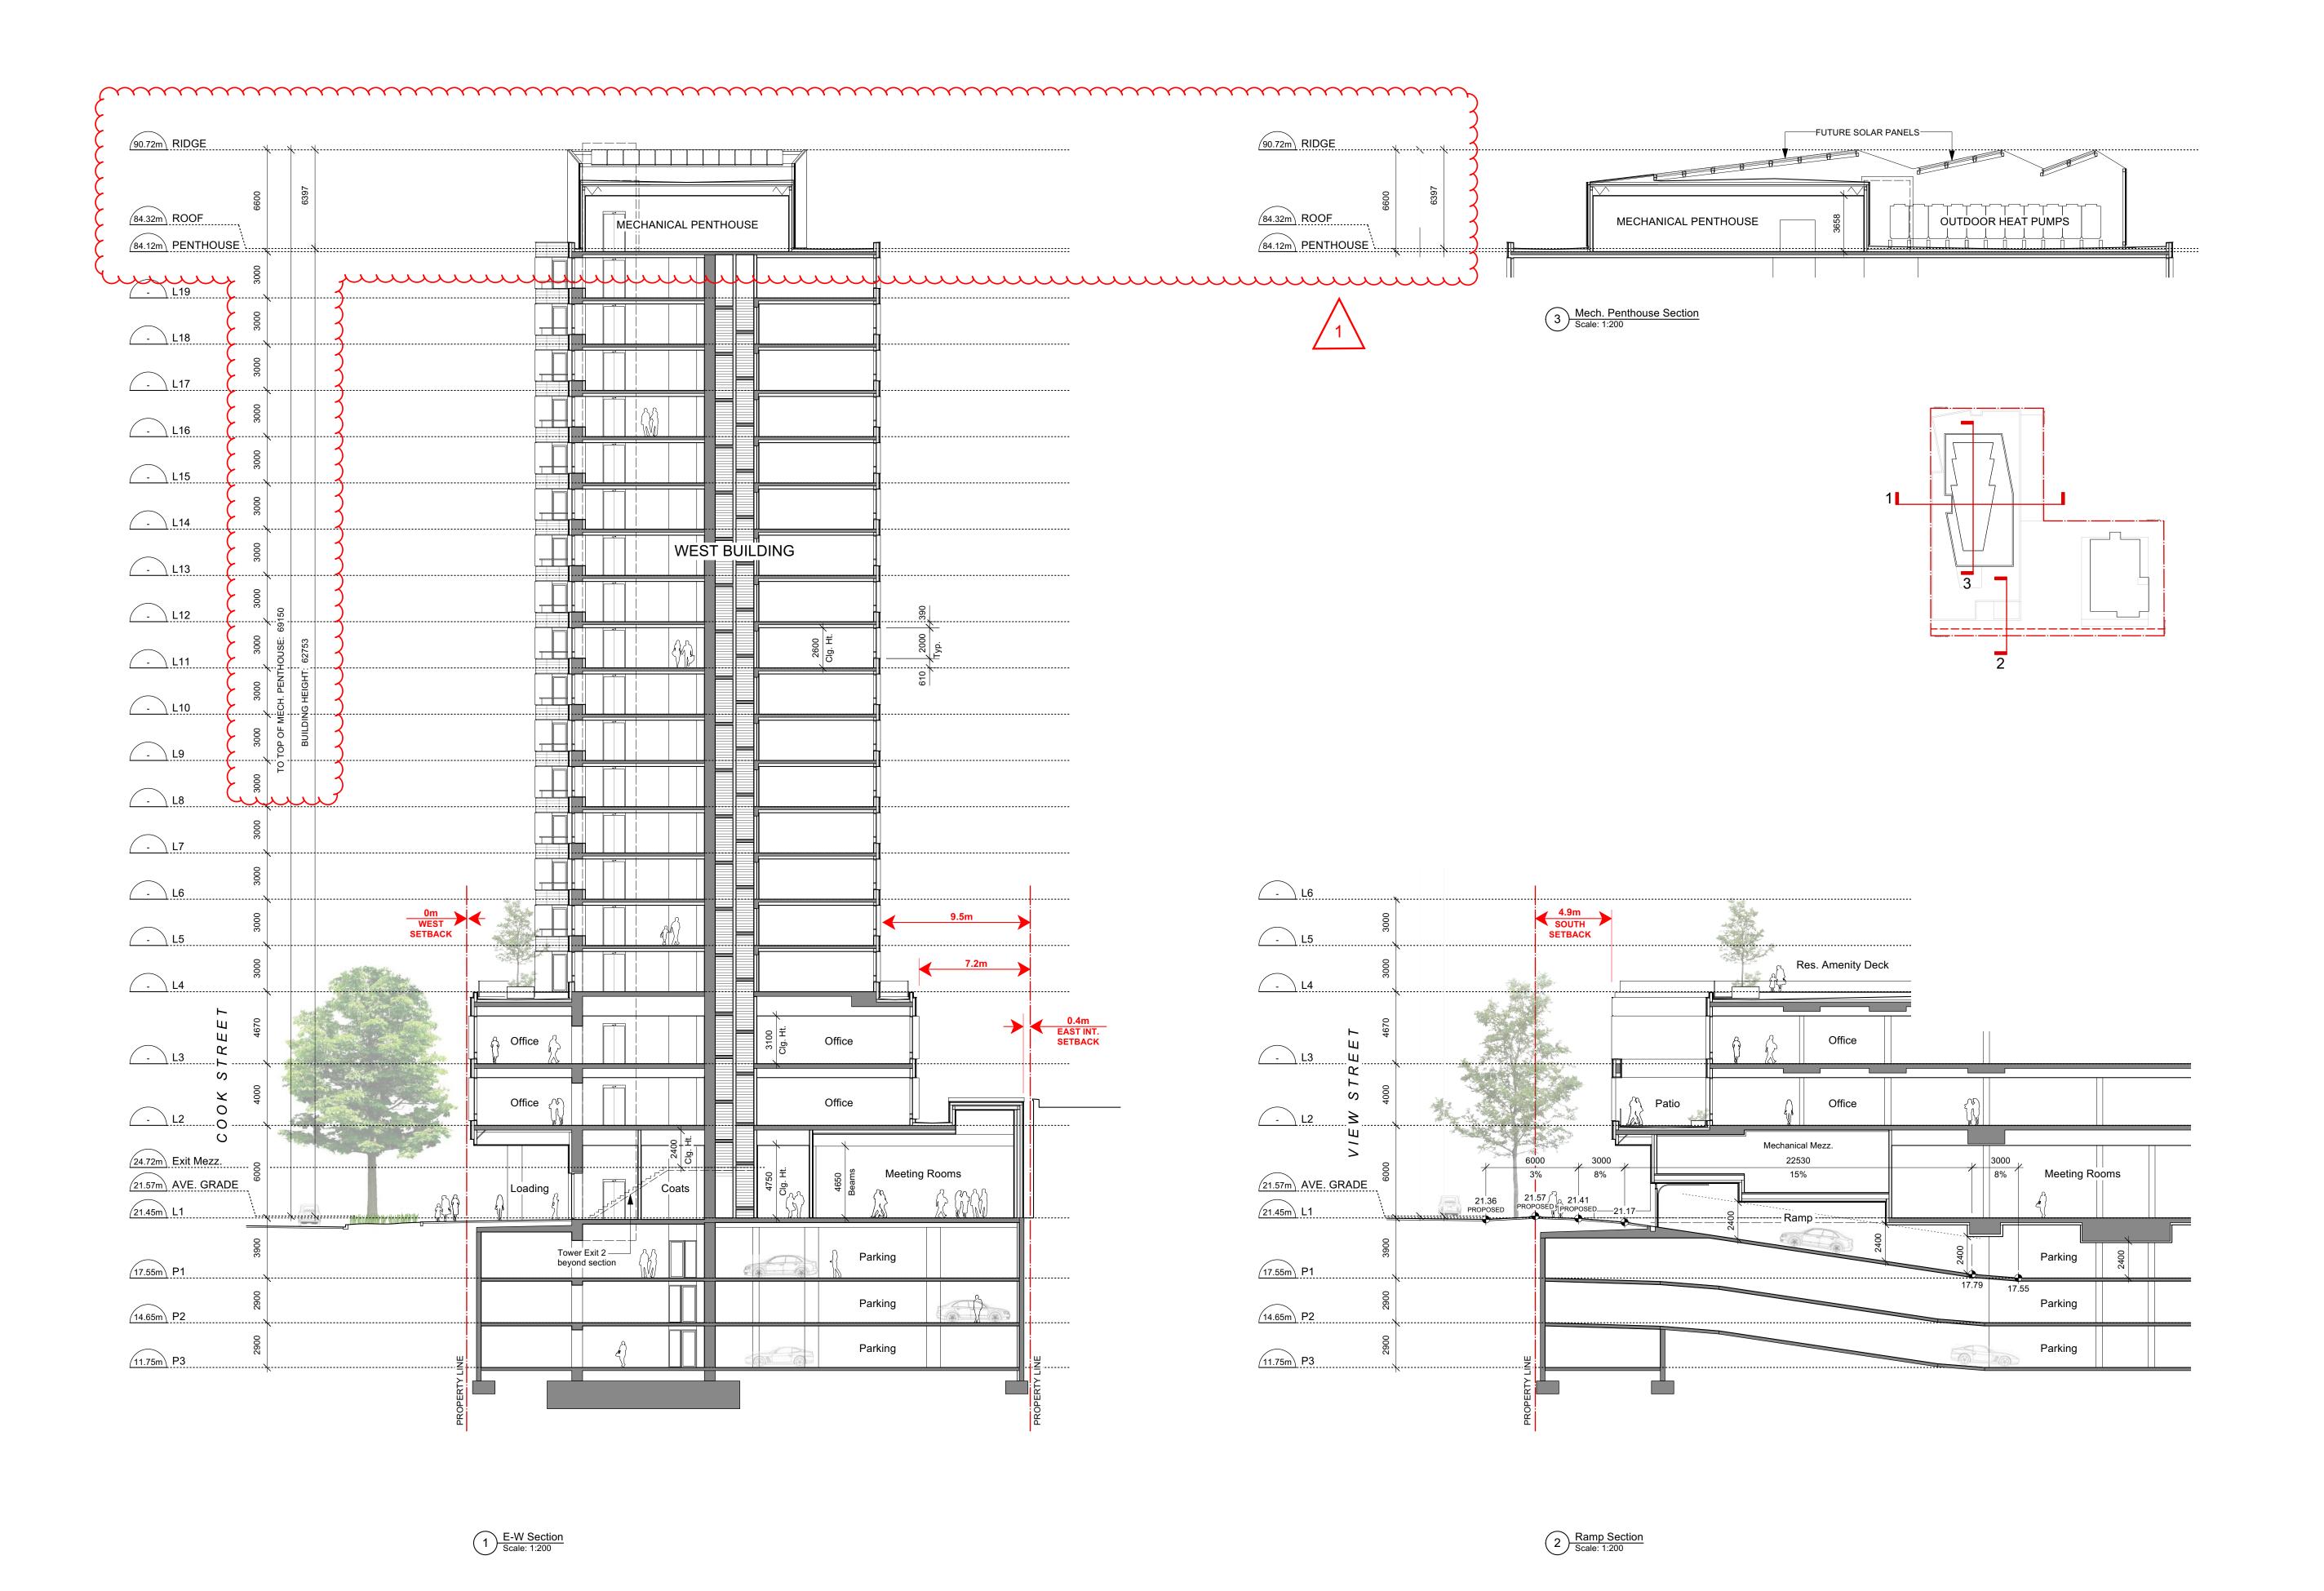



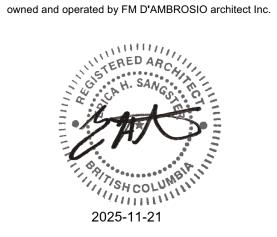

THIS DOCUMENT HAS BEEN ELECTRONICALLY CERTIFIED WITH DIGITAL CERTIFICATE AND ENCRYPTION TECHNOLOGY AUTHORIZED BY THE AIBC. THE AUTHORITATIVE ORIGINAL IS IN ELECTRONIC FORM. ANY PRINTED VERSION CAN BE RELIED UPON AS A TRUE COPY OF THE ORIGINAL WHEN SUPPLIED BY DAUSTUDIO, BEARING IMAGES OF THE PROFESSIONAL SEAL AND DIGITAL CERTIFICATE OR WHEN PRINTED FROM THE DIGITALLY CERTIFIED ELECTRONIC FILE.

General Notes:


 These preliminary plans are subject to refinement and confirmation of City policy and existing site conditions.

Refer to Landscape Architectural Plan for information on hardscaping, plantings and landscape site elements.

The proposed frontages within the public right-of-way are subject to coordination with the City of Victoria.

Revision Key:

1. Building height revisions (West Tower revised to 19 stories, East Tower revised to 6 stories).

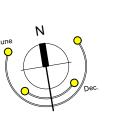

4	RZ/DP Resubmission	25.11.20
<u>/</u> 3\	Rezoning & Development Permit - ADP	25.10.02
2	Rezoning & Development Permit	25.08.05
1	Development Tracker	25.06.24
ev no	description	date
	•	

copyright reserved. these drawings and designs are and at all times remain the property of DAUSTUDIO to be used for the project shown and may not be reproduced without written consent.

project name


1101 Yates St.

Victoria, BC

sheet title

Building Sections

project no.	2441
drawing file 2441 - 1	101 Yates - 250923
scale	1:200
drawn by	JH
date issued	sheet no.
November 20, 2025	A4.1

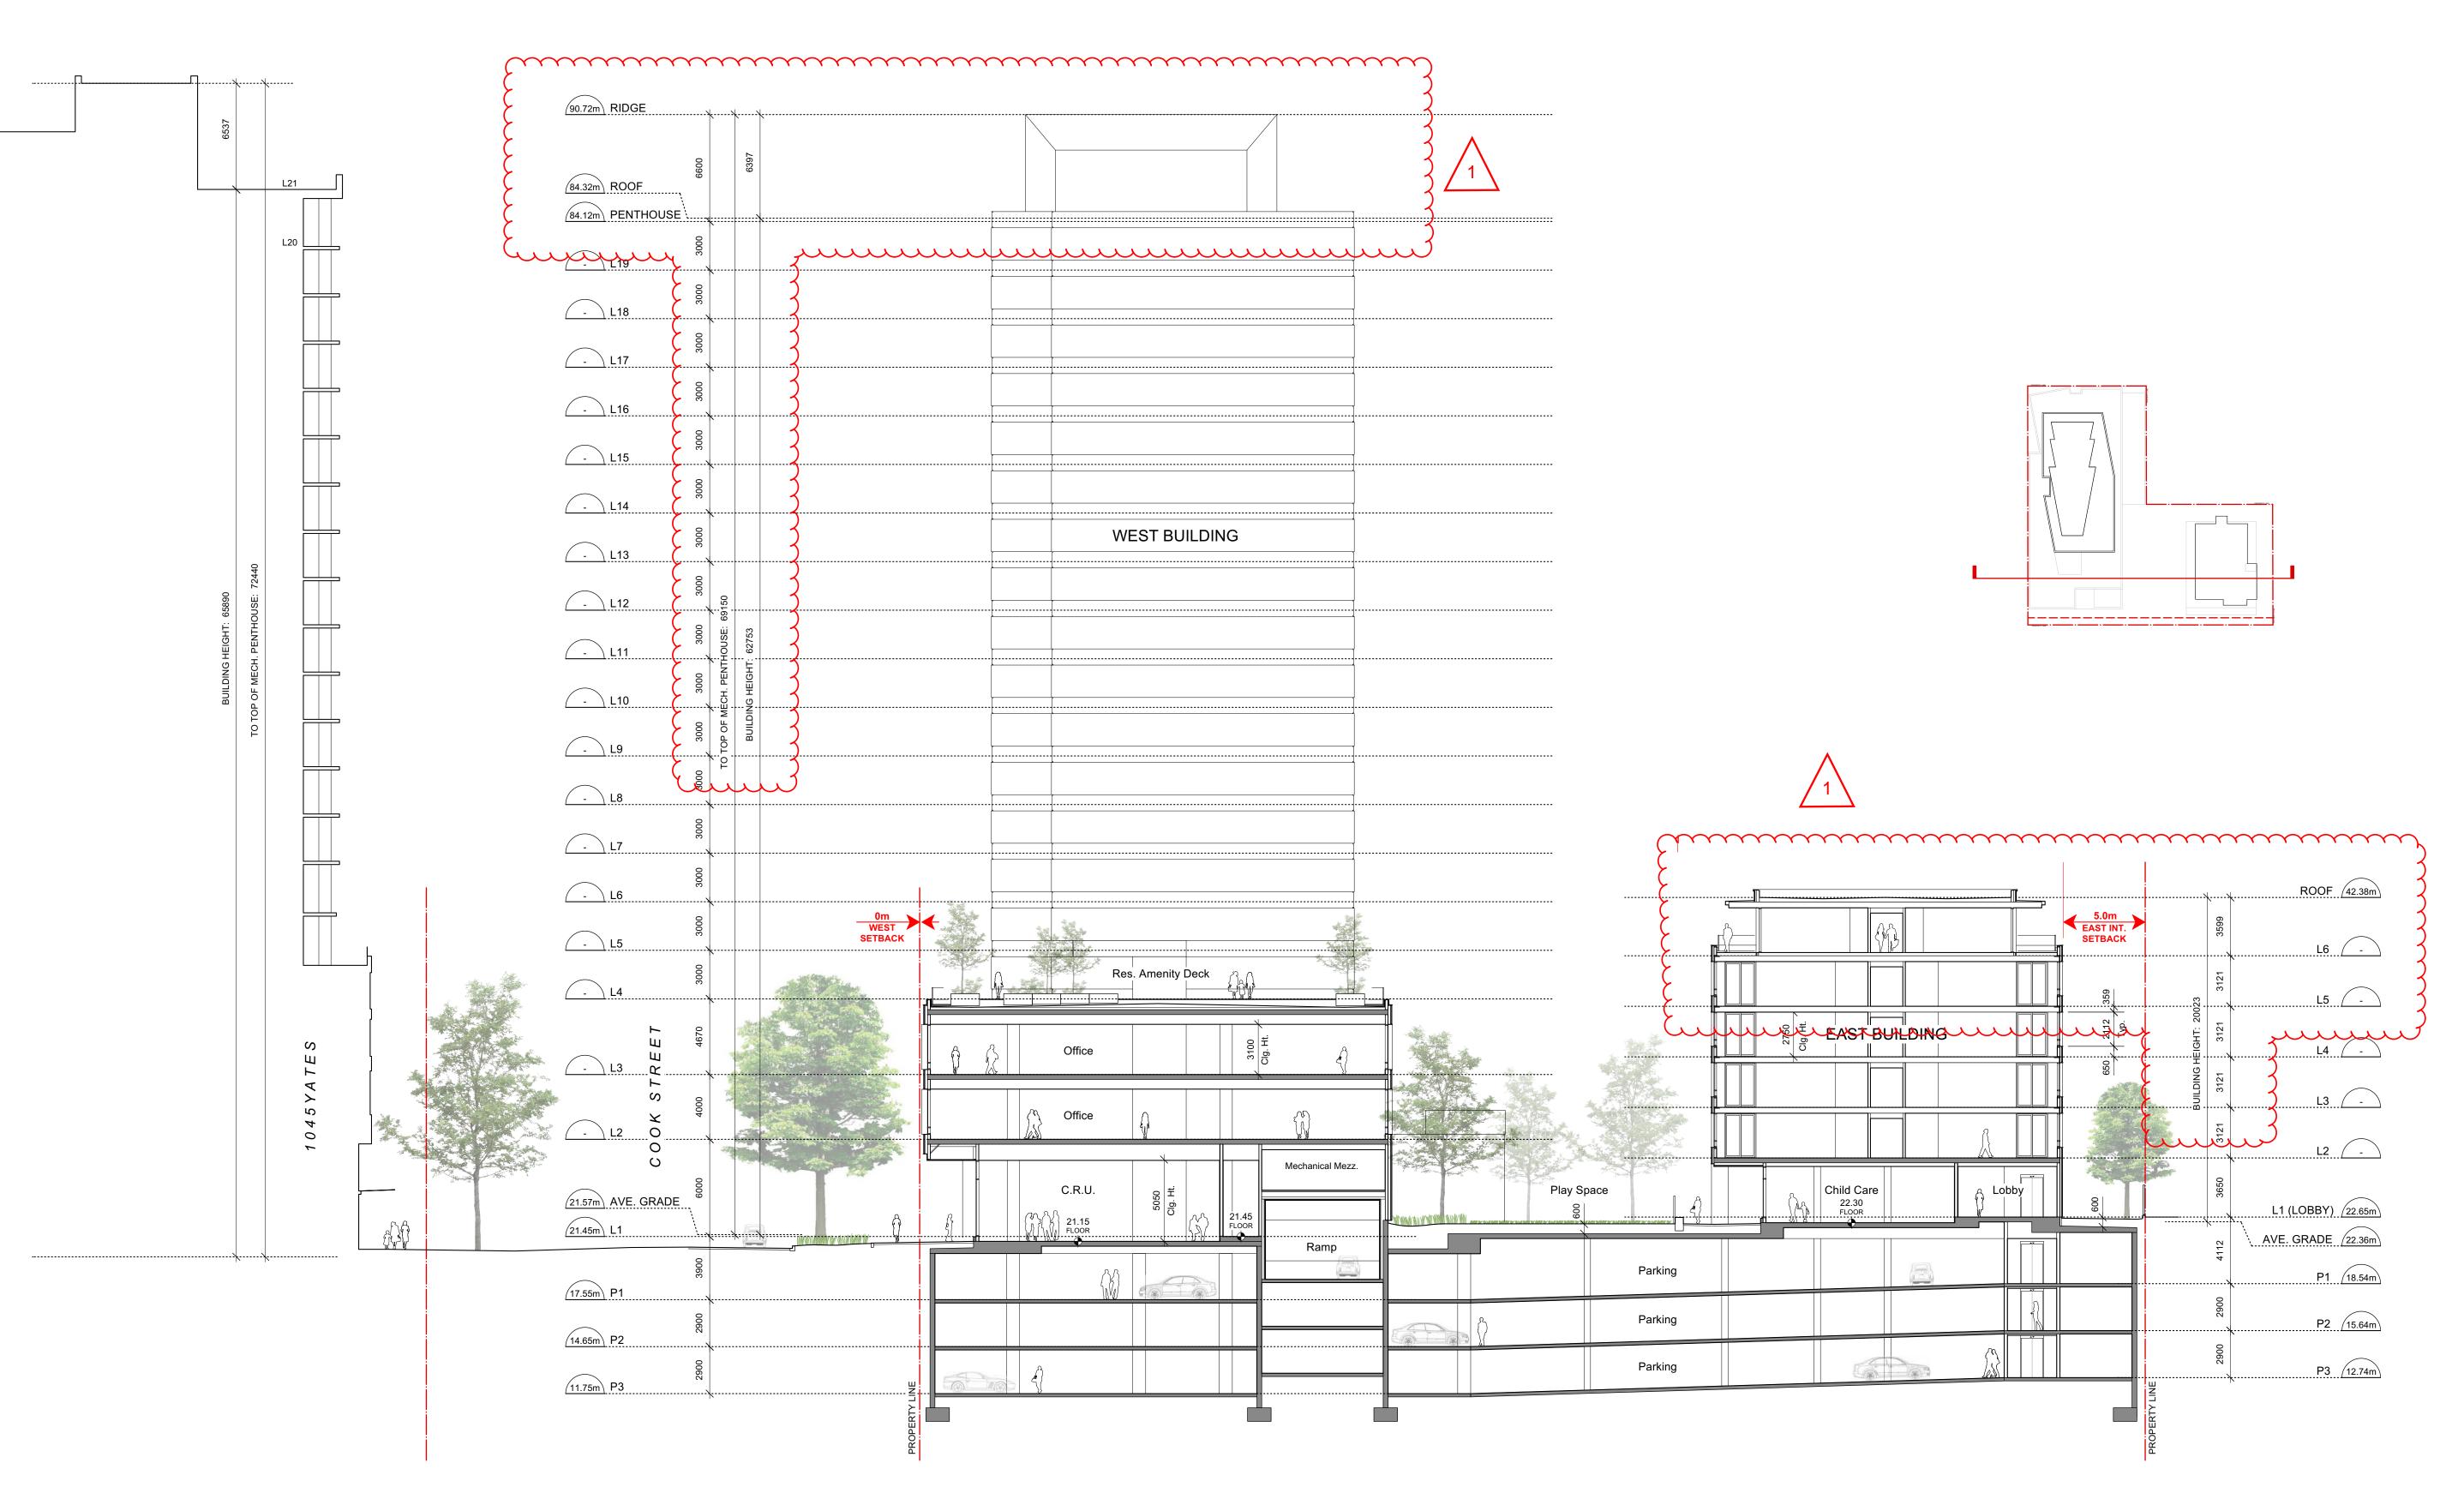




THIS DOCUMENT HAS BEEN ELECTRONICALLY CERTIFIED WITH DIGITAL CERTIFICATE AND ENCRYPTION TECHNOLOGY AUTHORIZED BY THE AIBC. THE AUTHORITATIVE ORIGINAL IS IN ELECTRONIC FORM. ANY PRINTED VERSION CAN BE RELIED UPON AS A TRUE COPY OF THE ORIGINAL WHEN SUPPLIED BY DAUSTUDIO, BEARING IMAGES OF THE PROFESSIONAL SEAL AND DIGITAL CERTIFICATE OR WHEN PRINTED FROM THE DIGITALLY CERTIFIED ELECTRONIC FILE.

General Notes:


These preliminary plans are subject to refinement and confirmation of City policy and existing site conditions.

Refer to Landscape Architectural Plan for information on hardscaping, plantings and landscape site elements.

The proposed frontages within the public right-of-way are subject to coordination with the City of Victoria.

Revision Key:

1. Building height revisions (West Tower revised to 19 stories, East Tower revised to 6 stories).

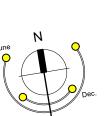

4	RZ/DP Resubmission	25.11.20
<u>/</u> 3\	Rezoning & Development Permit - ADP	25.10.02
2	Rezoning & Development Permit	25.08.05
1	Development Tracker	25.06.24
ev no	description	date

copyright reserved, these drawings and designs are and at all times remain the property of DAUSTUDIO to be used for the project shown and may not be reproduced without written consent.

project name

1101 Yates St.

Victoria, BC

sheet title

Building Section


JH sheet no.
JH
1:200
01 Yates - 250923
2441
-

Jawl Properties Ltd.

1101 Yates

Victoria, BC

KEY PLAN

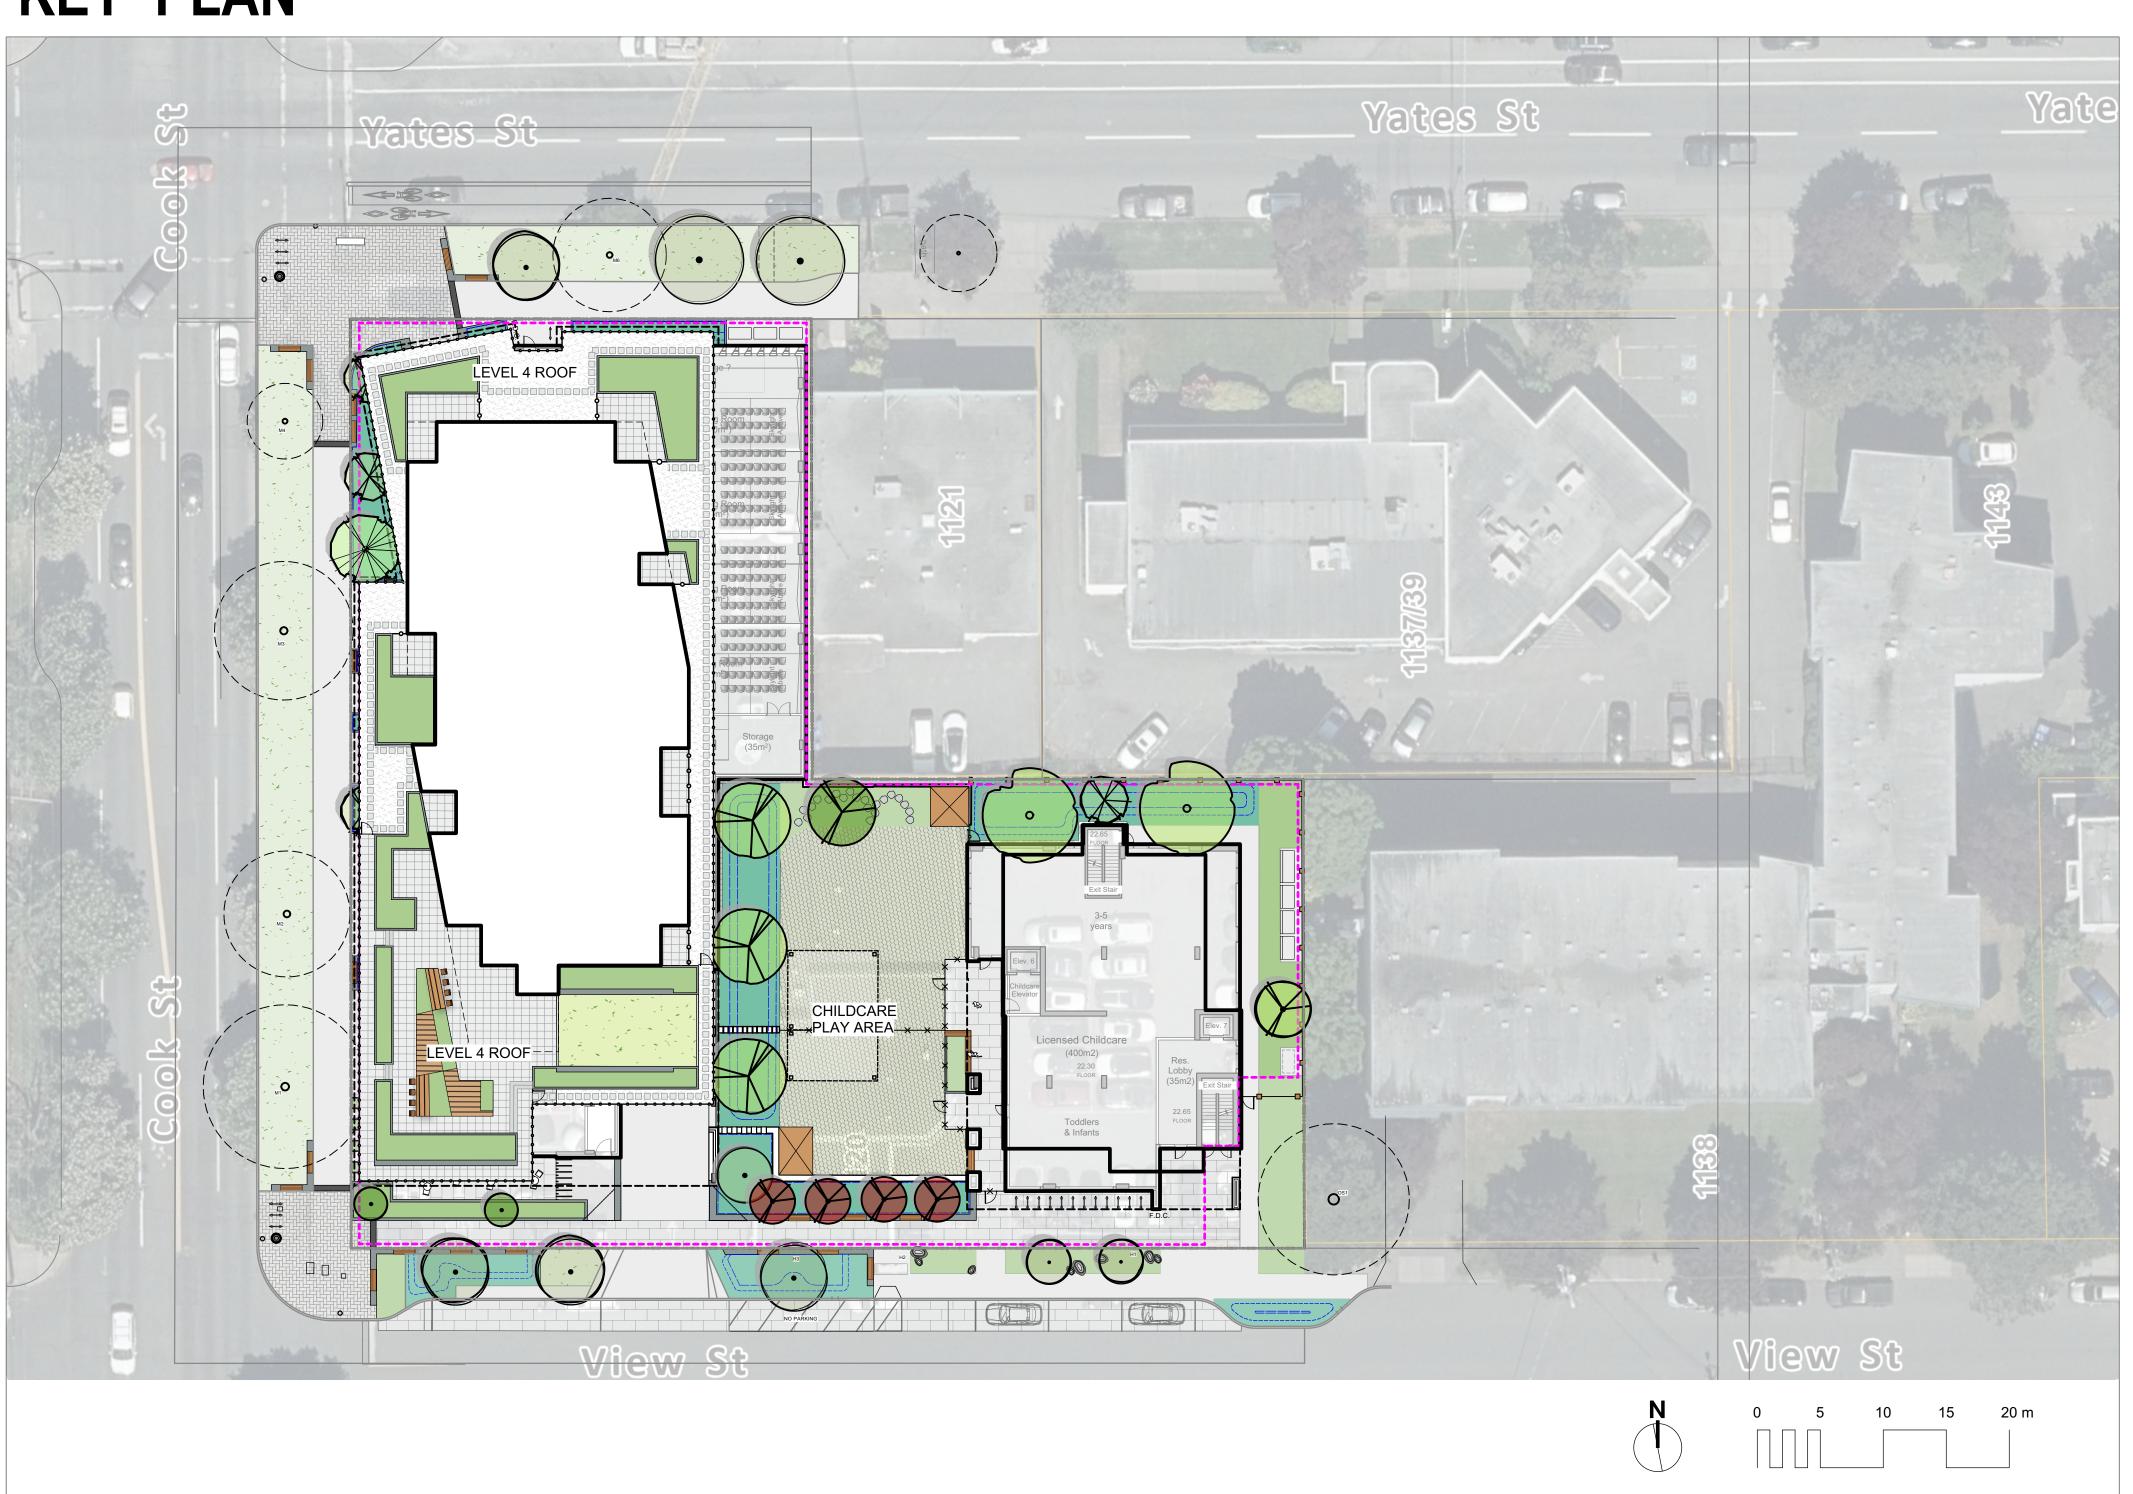

Landscape Sheets		
Sheet No.	Sheet Title	
L0.00	Cover	
L0.01	General Information Sheet	
L0.02	Tree Replacement	
L0.03	Stormwater Management	
L1.01	Landscape Materials - L1	
L1.02	Landscape Materials -L2 & L3	
L1.03	Landscape Materials - L4	
L2.01	Landscape Grading & Drainage	
L2.02	Landscape Sections	
L3.01	Planting - L1	
L3.02	Planting - L2 & L3	
L3.03	Planting - L4	
L4.01	Landscape Details: Rain Garden	
L4.02	cape Details: Boulevard Rain Garden and I	

Sheets added.

NOT FOR CONSTRUCTION

3 RZ/DP Resubmission 2025-11-20
2 Development Permit 2025-08-05
1 For Dev Tracker 2025-06-20
No. Issued For Issue Date



Jawl Properties Ltd.
1515 Douglas St. Suite 200
Victoria, BC

project 1101 Yates Street 1101 Yates St

Victoria, BC

Cover

project no.		124.36
scale	1:300	@ 24"x36"
drawn by		SC
checked by		ТВ

L0.00

GENERAL NOTES

- 1. Work performed shall comply with the following: a) These General Notes, and Construction Documents and Specifications; b) Canadian Landscape Standards, Current Edition (CLS-CE); and c) All applicable local, provincial, and federal codes, ordinances, and regulations.
- 2. Contractor shall be responsible for verifying all existing site conditions including location of all property lines, existing structures, utilities, and buried infrastructure. Verify all field conditions prior to commencing work.
- 3. Contractor is responsible for determining means and methods for construction. These drawings may indicate a limit of proposed improvements or limit of work for the delineation of expected extents of disturbance. Should limits of disturbance exceed boundaries defined in drawings, contractor shall contact Landscape Architect for resolution.
- 4. Contractor is responsible for repairing all work disturbed by construction outside of limit lines defined on drawings or through their means and methods to a condition better than or equal to the existing conditions prior to commencement of construction at no additional cost to the owner.
- 5. Contractor is responsible for maintaining a complete up-to-date set of drawings and specifications at the construction site and ensuring the documents are readily available for review by the Landscape Architect and governing agency.
- 6. Contractor is responsible for coordination of all designs, drawings, specifications and other documents or publications upon which construction is based. Any discrepencies with the drawings and/or specifications and site conditions shall be brought to the attention of the Landscape Architect, prior to proceeding with construction.
- 7. The drawings and specifications are complementary to one another and implied to correspond with one another. Any discrepencies should be brought to the attention of the Landscape Architect for resolution immediately.
- 8. General Contractor and/or sub-contractors are responsible for all costs related to production and submission to consultant of all landscape as-built information including irrigation.

TREE RETENTION AND REMOVAL NOTES

- 1. Tree protection fencing, for existing trees, to be installed prior to commencement of all site work. Refer to Arborist's plans for location of tree protection fencing, and protection fencing detail.
- Refer to arborist's report for detailed information for existing tree resources.

SITE GRADING AND DRAINAGE NOTES

- . All elevations are in meters.
- 2. Refer to Architectural plans, sections and elevations for top of slab elevations. Slab elevations indicated on Landscape drawings are for reference only. Report any discrepancies to consultant for review and response
- 3. All road, public walkway and vehicular drive aisles and parking area elevations indicated on the Landscape drawings are for reference only. Refer to Civil Engineering drawings. Report any discrepancies to consultant for review and response.
- 4. Confirm all existing grades prior to contruction. Report any discrepancies to consultant for review and response.
- Unless otherwise noted provide a minimum slope of 2% on all hard and soft Landscape areas to ensure positive drainage away from buildings, to rain gardens, or to drainage devices.
- 6. All landscape areas shall not exceed a maximum slope of 3:1 in all instances.
- 7. Upon discovery, contractor to refrain from blasting rock to meet landscape subgrades. Contractor to contact Landscape Architect on how to proceed in each instance.

IRRIGATION NOTES

- 1. Contractor to provide irrigation system for all planters to current IIABC Standards and Contract Specifications.
- 2. All specified work to meet the project specifications, and all standards or specifications established in the lastest edition of the Canadian Landscape Standard and IIABC standards.
- 3. Design/build drawings for detailed irrigation plan to be submitted to Contract Administrator in PDF and .dwg formats at least two weeks prior to commencement of irrigation installation
- 4. Utilties Contractor to verify location of all on-site utilities, prior to construction. Restoration of damaged utilities shall be made at the contractor's expense, to the satisfaction of the owner's representatives.

Refer to electrical drawings for electrical service.

- 6. Controller and backflow prevention device to be located in Mechanical Room, unless otherwise noted. Refer to Mechanical drawings for size and location of irrigation service.
- Contractor to verify pressure and flow prior to installation of irrigation and notify owner's representative in writing if such data adversely affects the operation of the system.
- 8. Sleeves shall be installed at the necessary depths, prior to pavement construction. Sleeving shall extend 300 mm from edge of paving into planting area, and shall have ends marked above grade unless otherwise shown.
- Contractor to field fit irrigation system around existing trees, to limit disturbance to root systems. 10. At various milestones during construction, inspection and testing of components will be required to ensure that the performance of irrigation system meets standards and specifications. Contractor to provide equipment and personnel necessary for performance of inspections and tests. Conduct all inspections and tests in the presence of the contract administrator. Keep work uncovered and accessible until successful completeition of inspection or test.
- 11. Over spray onto hardscape areas to be minimized. Use drip irrigation within small planting areas to avoid overspray.
- 12. Trees within shrub or rain garden areas to be irrigated with spray heads.
- 13. Trees in Plaza in hard pavement (soil cells below) to recieve temporary irrigation system around root collar and permanent drip irrigation system

GROWING MEDIUM NOTES

- Refer to Landscape Specifications for growing medium properties by soil type.
- Advise Contract Administrator of sources of growing medium to be utilized 14 days in advance of
- Growing medium properties and handling shall meet CLS-CE (see Section 6 CLS-CE).
- 4. Contractor is responsible for soil analysis and amendment requirements to supply suitable growing medium, as specified by testing agency. Soil analysis and amendment costs shall be included in the price for the work.
- Submit to the Landscape Architect a copy of the soil analysis report from Pacific Soil Analysis Inc. 5-11720 Voyageur Way, Richmond, BC, V6X 3G9. p. 604- 273-8226. The analysis shall be of tests done on the proposed growing medium from stratified samples taken from the supply source. Costs of the initial and all subsequent tests to ensure compliance with the specifications shall be borne by the Contractor.
- 6. Contract Administrator will collect sample of growing medium in place and determine acceptance of material, depth of growing medium and finish grading. Approval of growing medium material subject to soil testing and analysis. Planting is not to occur until finished grades have been approved by Contract Administrator.

SITE LAYOUT NOTES

- 1. Provide layout of all work for approval by Contract Administrator prior to proceeding with work. Requests for site review as required 48 hours in advance of performing any work, unless otherwise
- 2. Layout and verify dimensions prior to construction. Bring discrepancies to the attention of the Contract
- Administrator. 3. Written dimensions take precedence over scale. Do not scale drawings.
- 4. All plan dimensions in metres and all detail dimensions in millimetres, unless otherwise noted.
- 5. Where dimensions are called as 'equal' or 'eq', space referenced items equally, measured to centre

GENERAL PLANTING NOTES

- 1. Plant quantities on Plans shall take precedence over plant list quantities.
- 2. Provide layout of all work for approval by Contract Administrator prior to proceeding with work.
- 3. Plant material, installation and maintenance to conform to the current edition of the Canadian Landscape Standard.
- 4. Plant quantities and species may change between issuance of DP and Construction due to plant availability and design changes. Substitutions to be approved by Landscape Architect.

ON-SLAB TREE PLANTING NOTES

- 1. For on-slab landscape, a root barrier will be installed to protect exposed water proof membranes. A dimple board (drain mat) will be installed over the root barrier.
- 2. Parkade walls and foundation walls will be protected with a dimple board (drain mat) to convey water to the perimeter drain and protect wall from roots.
- 3. A root barrier will be installed between the tree roots and perimeter drain, to minimize tree root interference with the drain, where the follow conditions exist in on-grade planting areas: a)where trees less than 8m tall are located closer than 2m from a parkade or foundation wall; b) where trees more than 8m tall are located closer than 3m from a parkade or foundation wall; and c) where perimeter drains are less than 2m deep.

BOULEVARD PLANTING NOTES

- 1. Boulevard trees have been placed to avoid existing and proposed infrastructure. Trees planted within 1m of an existing underground municipal service will have a root barrier installed between the root ball and the existing infrastructure.
- 2. Boulevard trees will be place a minimum of 1.5m from an above ground municipal service such as fire hydrant, streetlight or driveway
- . Boulevard tree species have been picked from the municipality's list of recommended boulevard trees or have been selected due their site-adapted qualities. Final selection of boulevard trees to be
- determined through consultation with municipal parks staff. 4. Irrigation to be installed as per Municipal Specifications, for all boulevard planting areas (unless otherwise indicated).
- 5. Design/build drawings for boulevard irrigation to be submitted to Contract Administrator in PDF and .dwg formats, at least two weeks prior to commencement of irrigation installation and will be reviewed by municipal staff.
- 6. Refer to Civil drawings for location of boulevard irrigation point of connection. Separate water meter and timer/controller, to be provided at point of connection. Timer/controller for boulevard areas must be readily accessible to municipal staff.
- . Boulevard irrigation to be inspected as per municipal specification by municipal staff. Boulevard tree irrigation system will be maintained and operated by municipality, after it is inspected and approved by
- 8. Soil volume for boulevard trees to be as follows: 8 cu. m. for small trees, 12 cu. m. for medium trees,
- 9. Municipal Parks staff to inspect soil and planting area of boulevard rain gardens prior to planting. 10. Street trees must have one dominant central leader or single straight trunk, 6-8 cm diameter caliper measured 15 cm above ground, and a well-balanced crown with branching starting at 1.8 m - 2.5 m above ground. Trees must be planted per the City of Victoria Supplemental Drawing SD P4 (Tree Planting in Boulevard) and SD P5 (Tree Planting in Sidewalk with Tree Guard) and the Canadian
- Landscape Standard. l. Please contact Rob Hughes, rhughes@victoria.ca and also copy treepermits@victoria.ca 48 hours prior to the required inspection time to schedule an inspection.
- 12. Required Parks inspections for street tree planting:
 - Inspection of excavated tree pits, soil cells, root barriers. Inspection of soil and planting area prior to 🔼
 - Inspection of tree stock prior to planting.
- Inspection of installed tree tree planting, grate/guard, stakes, etc. Trees must be in good health and condition with no visible signs of disease, insect pests, or damage, and comply with the latest version of the Canadian Landscape Standard.
- 3. Plant material and installation must meet or exceed the current edition of the Canadian Landscape Standard and specifications for planted landscapes as required in the MMCD. To schedule an inspection please contact Tom Sherbo, tsherbo@victoria.ca and also copy treepermits@victoria.ca 48 hours prior to the required inspection time.
- Required Parks inspections for landscaped/planted areas:
- Inspection of excavated and scarified subgrade prior placement of the growing media.
- Inspection of installed and prepared growing medium prior to planting.
- Inspection of plant material on-site prior to planting.
- Inspection of planted landscape prior to the installation of mulch.
- Inspection when the planted and mulched landscaping meets the conditions for total performance as required in the MMCD.

14. A soil test for the growing media, for each landscape application on City Property must 1 be submitted to the City Parks treepermits@victoria.ca for review at least one week prior to soil placement. Growing media must meet the standards for each specific landscape application as required in the current edition of the Canadian Landscape Standard.

PAVING NOTES

- 1. Final concrete control joint layout to be confirmed by Landscape Architect prior to installation. Control joints to logically align with edges, corners, and intersections of Landscape and Architectural elements and/or as indicated on plan. Contractor to obtain layout approval by Landscape Architect prior to installation. Contractor to pour concrete pavement in alternating panels as required to achieve control
- 2. Cast in place concrete areas that are subject to vechicular loading shall be structurally reinforced for applicable vehicular loading requirements. See Structural Engineering drawings.

WARRANTY AND MAINTENANCE NOTES

- Contractor is responsible for Maintenance from installation to Acceptance of the work by the Contract
- Refer to Landscape Specifications for Maintenance Period following Acceptance.
- adequate maintenance by the Owner after Acceptance, as determined by the Landscape Architect. The Contractor will not be responsible for plant loss or damage to other products by causes out of the
- 4. Contractor is responsible for plant damage, failure and death due to poor delivery, storage and handling, and all other installation related aspects up until the End of Warranty period.

- joint design and to prevent cracking.


- Administrator
- Landscape installation to carry a 1-year warranty from date of acceptance. This warranty is based on
- Contractor's control, such as vandalism, "acts of God", "excessive wear and tear", or abuse.
- 5. Plant material, installation and maintenance to conform with the current edition of the Canadian Landscape Standards, and the Contract Specifications

LINE TYPE LEGEND

	Description in the second seco
— …— …	Property line
	Building Footprint
	Extent of Roof / Canopy, above
	Extent of Parkade, below
	Rain garden - TOP OF POOL
	Rain garden - BOTTOM OF POOL

EXISTING TREE LEGEND

(Refer to Arborist Report and Tree Management Plan for full details and management strategies).

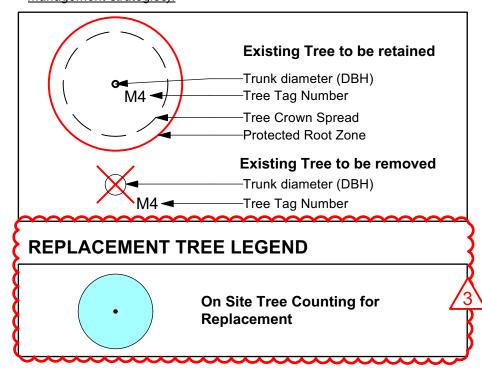

LANDSCAPE INFRASTRUCTURE LEGEND


	Perforated Underdrain
°C/O	Clean Out
L-AD	Landscape Area Drain 8" Square Drain with ADA Steel Lockable Grate.
	Rain Garden Curb Inlet Sediment Trap Concrete pad to capture sediment at curb cuts.

GRADING LEGEND

25.25	Proposed Landscape Grade		
25.25 36.7% 24.25	TOW Top of Wall BP Bottom of Pool BW Bottom of Wall TS Top of Stairs TOC Top of Curb BS Bottom of Stairs BC Bottom of Curb HP High Point TP Top of Pool LP Low Point		
25.25	Existing Grade		
← 25.25	Architectural grade, for reference only		
- (+) - 25.25	Civil Grade, for reference only		

LIST OF ABBREVIATIONS

APPROX	APPROXIMATE	M MAX	METRE MAXIMUM
ARCH	ARCHITECT	MFR	MANUFACTURER
AVG	AVERAGE	MH	MANHOLE
B&B	BALLED AND BURLAPPED		
ВС	BOTTOM OF CURB	MIN	MINIMUM
BLDG	BUILDING	MISC	MISCELLANEOUS
BM	BENCHMARK	MM	MILLIMETRE
BC	BOTTOM OF CURB	N	NORTH
BR	BOTTOM OF RAMP	NIC	NOT IN CONTRACT
BS	BOTTOM OF STEP	NO	NUMBER
BW	BOTTOM OF WALL	NOM	NOMINAL
CAL	CALIPER	NTS	NOT TO SCALE
CB	CATCH BASIN	OC	ON CENTER
CF	CUBIC FEET	OD	OUTSIDE DIAMETER
CIP	CAST IN PLACE	PC	POINT OF CURVATURE
CL	CENTER LINE	PE	POLYURETHANE
CLR	CLEARANCE	PI	POINT OF INTERSECTION
CM	CENTIMETER	PL	PROPERTY LINE
CO	CLEAN OUT	PT	POINT, POINT OF TANGENCY
CONT	CONTINUOUS	PVC	POLYVINYL CHLORIDE
CU M	CUBIC METRE	QTY	QUANTITY
DEG	DEGREE	R	RADIUS
DEMO		REF	REFERENCE
	DEMOLISH, DEMOLITION	REINF	REINFORCE(D)
DIA DIM	DIAMETER DIMENSION	REQ'D	REQUIRE(D)
DTL		REV	REVISION
DWG	DETAIL DRAWING	ROW	RIGHT OF WAY
		S	SOUTH
E	EAST	SAN	SANITARY
EA Ei	EACH	SD	STORM DRAIN
EL	ELEVATION	SF	SQUARE FOOT (FEET)
ENG	ENGINEER	SHT	SHEET
EQ EST	EQUAL	SIM	SIMILAR
	ESTIMATE	SPECS	SPECIFICATIONS
E.W.	EACH WAY	SQ M	SQUARE METRE
EXIST	EXISTING	ST	STORM SEWER
EXP FFE	EXPANSION, EXPOSED	STA	STATION
	FINISHED FLOOR ELEVATION	STD	STANDARD
FG FL	FINISHED GRADE FLOW LINE	SYM	SYMMETRICAL
FL FOC	FACE OF CURB	T&B	TOP AND BOTTOM
		TC	TOP OF CURB
FT FTG	FOOT (FEET) FOOTING	TF	TOP OF FOOTING
	GAUGE	TH	THICK
GA	GENERAL	TOPO	TOPOGRAPHY
GEN	GRADE ELEVATION	TR	TOP OF RAMP
GR HORIZ		TS	TOP OF STEP
HP	HORIZONTAL HIGH POINT	TW	TOP OF WALL
		TYP	TYPICAL
HT	HEIGHT	VAR	VARIES
ID INIV	INSIDE DIAMETER	VOL	VOLUME
INV	INVERT ELEVATION	W	WITH
IN INCL	INCH(ES)	W/O	WITHOUT
INCL	INCLUDE(D)	WT	WEIGHT
JT LE	JOINT LINEAR EEET	WL	WATER LEVEL
LF	LINEAR FEET	WWF	WELDED WIRE FRAME
LP	LOW POINT	YD	YARD
		@	AT
		=	

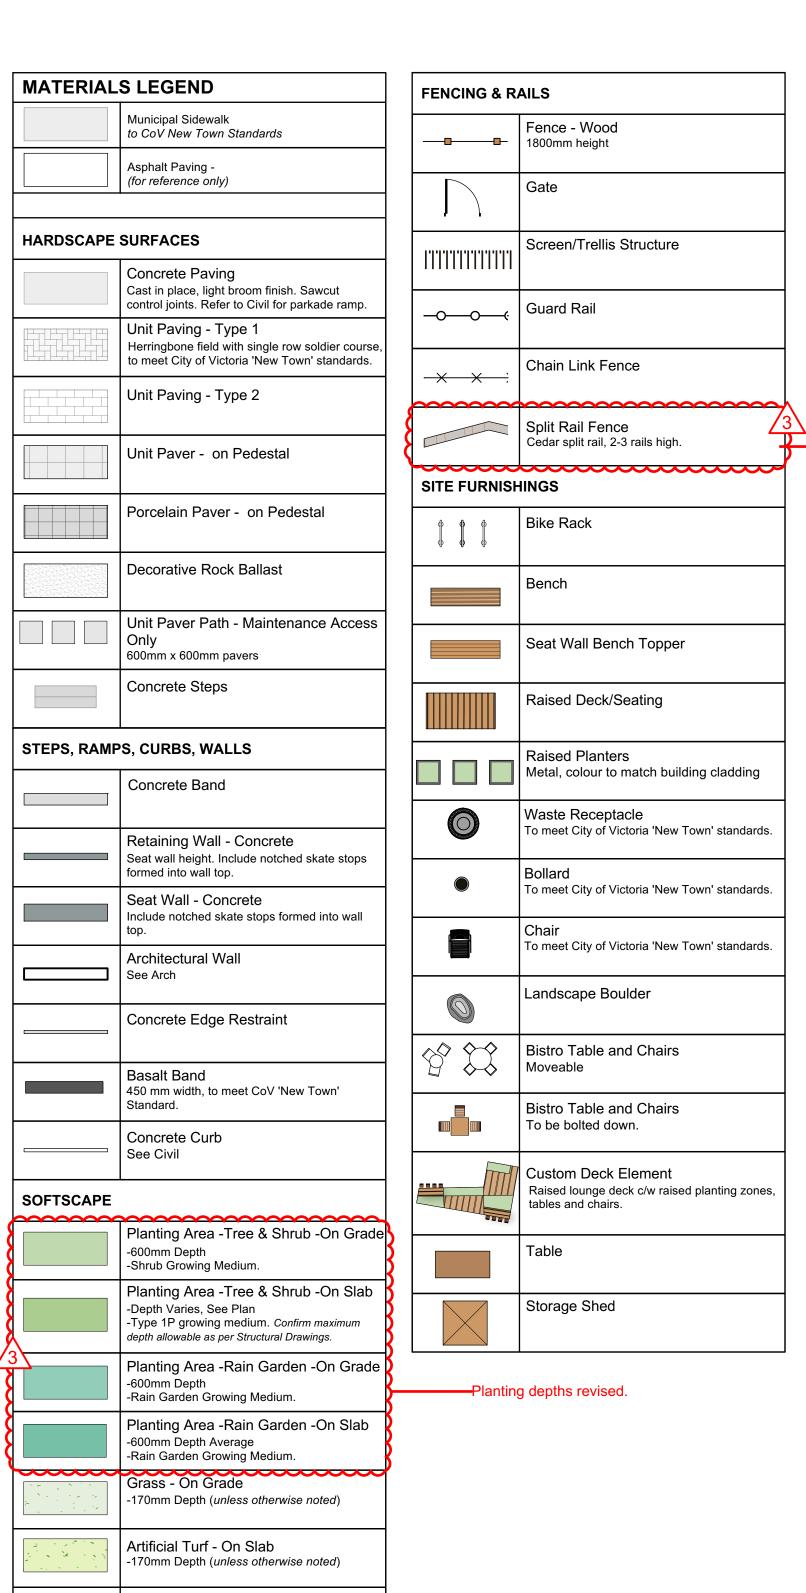



NOT FOR CONSTRUCTION

RZ/DP Resubmission | 2025-11-20 Development Permit | 2025-08-05 For Dev Tracker 2025-06-20 No. Issued For Issue Date



Jawl Properties Ltd. 1515 Douglas St. Suite 200 Victoria, BC

1101 Yates Street 1101 Yates St Victoria, BC

project

sheet title


General Information Sheet

124.36 project no 1: ### @ 24"x36" scale drawn by checked by sheet no.

L0.01

ALL DRAWINGS TO BE READ IN ASSOCIATION WITH CONTRACT SPECIFICATIONS.

Gravel Maintenance Edge

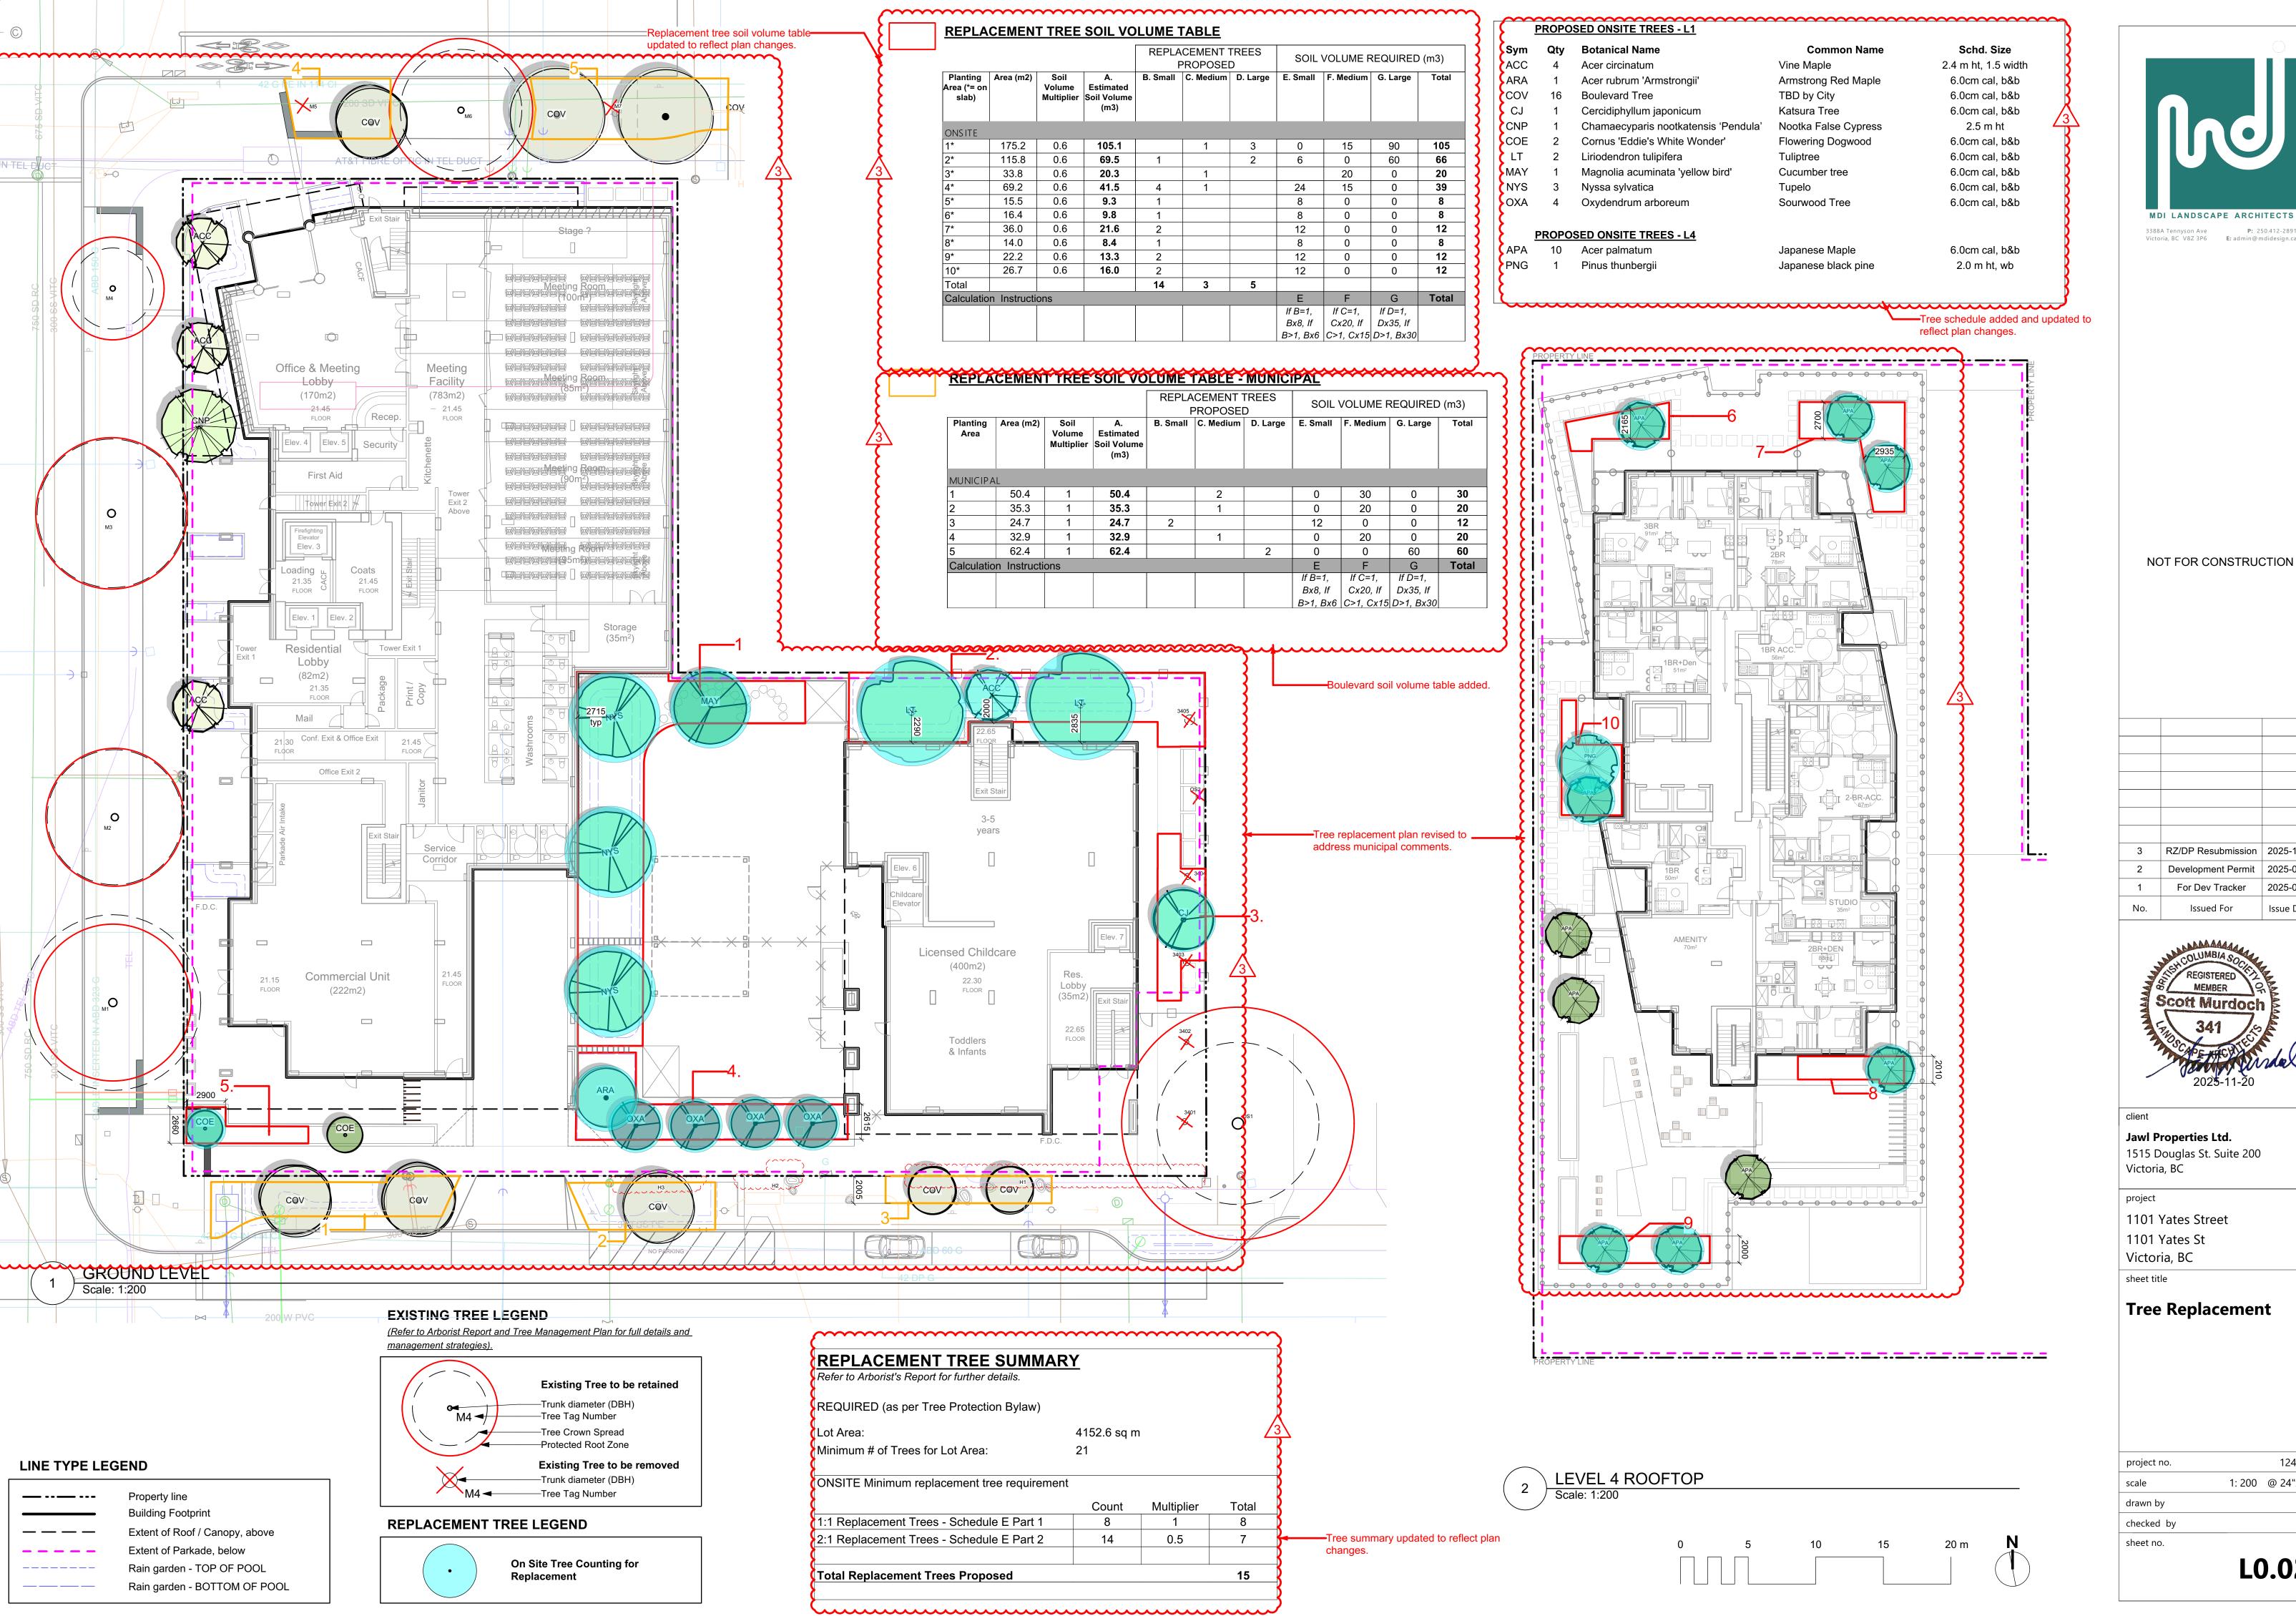

MDI LANDSCAPE ARCHITECTS

NOT FOR CONSTRUCTION

RZ/DP Resubmission | 2025-11-20 Development Permit 2025-08-05 For Dev Tracker Issue Date Issued For



Jawl Properties Ltd.

1515 Douglas St. Suite 200 Victoria, BC


1101 Yates Street 1101 Yates St

sheet title

Tree Replacement

roject no.		124.36
cale	1: 200	@ 24"x36"
rawn by		SC
hecked by		ТВ
heet no.		


L0.02

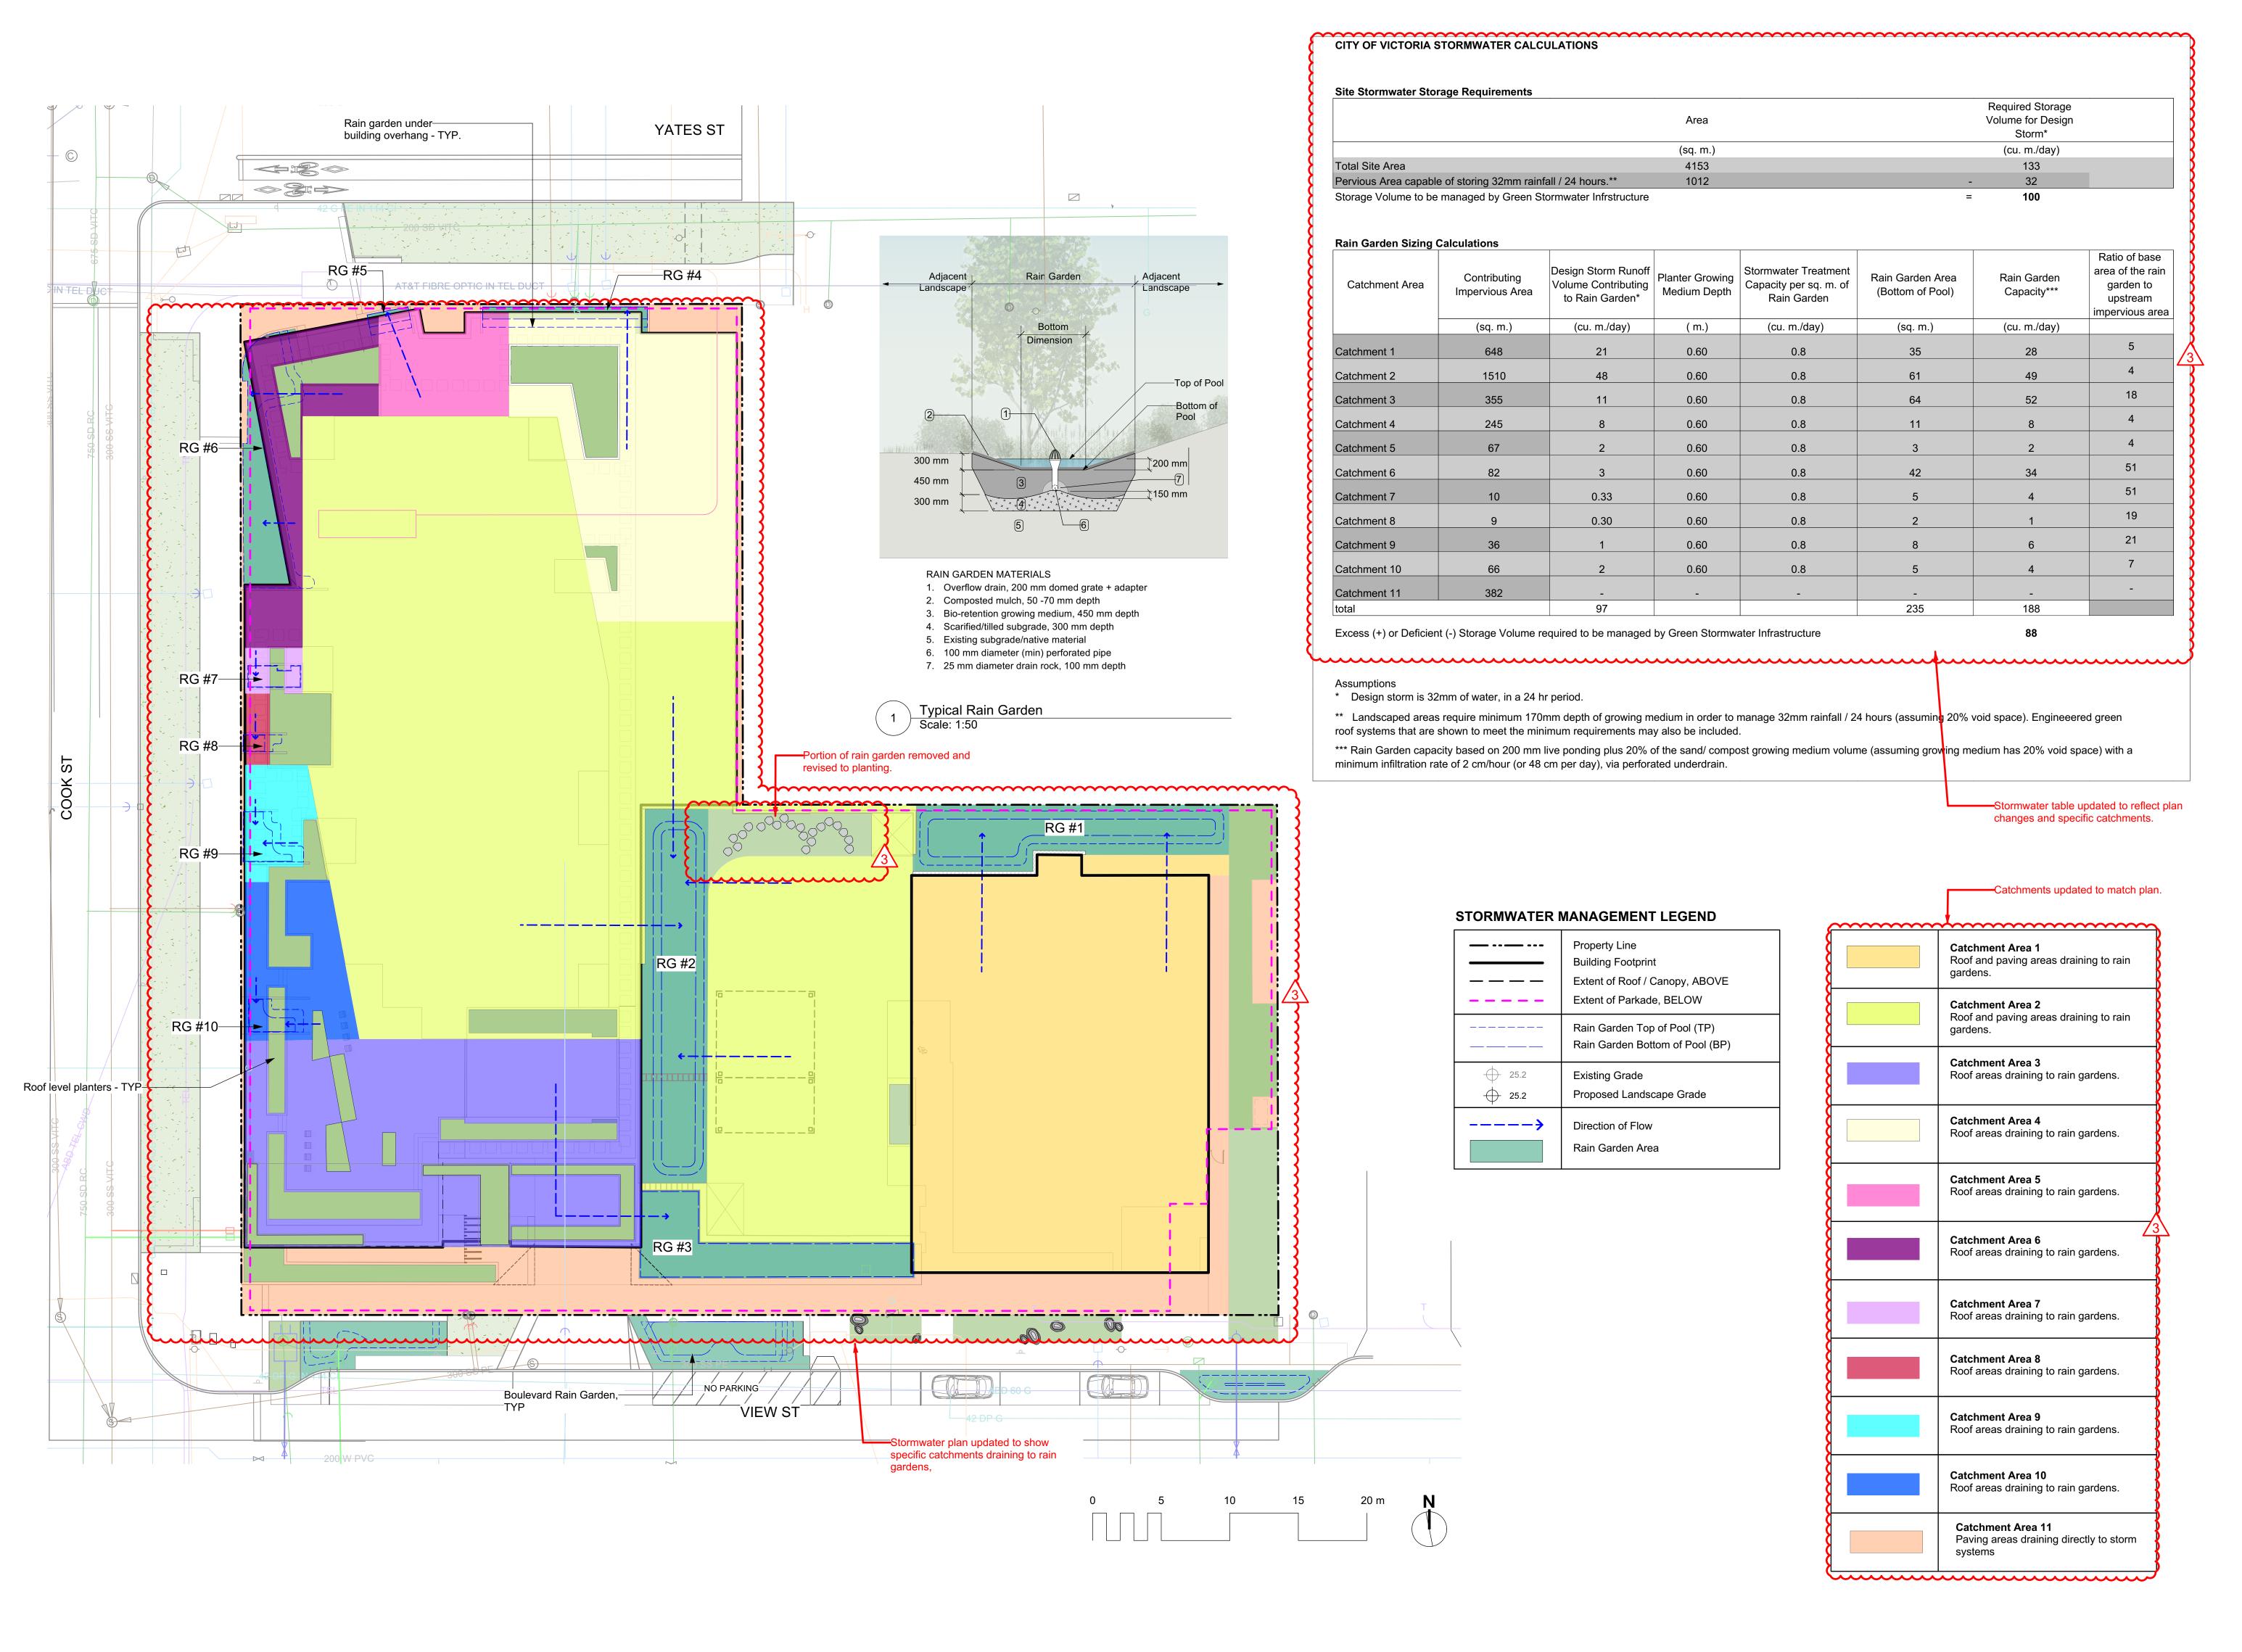



NOT FOR CONSTRUCTION

3 RZ/DP Resubmission 2025-11-20
2 Development Permit 2025-08-05
1 For Dev Tracker 2025-06-20
No. Issued For Issue Date

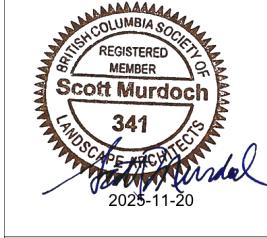

Jawl Properties Ltd.
1515 Douglas St. Suite 200
Victoria, BC

1101 Yates Street 1101 Yates St Victoria, BC


sheet title

Stormwater


Management

project no. 124.36
scale 1: 200 @ 24"x36"
drawn by SC
checked by TB
sheet no.

L0.03

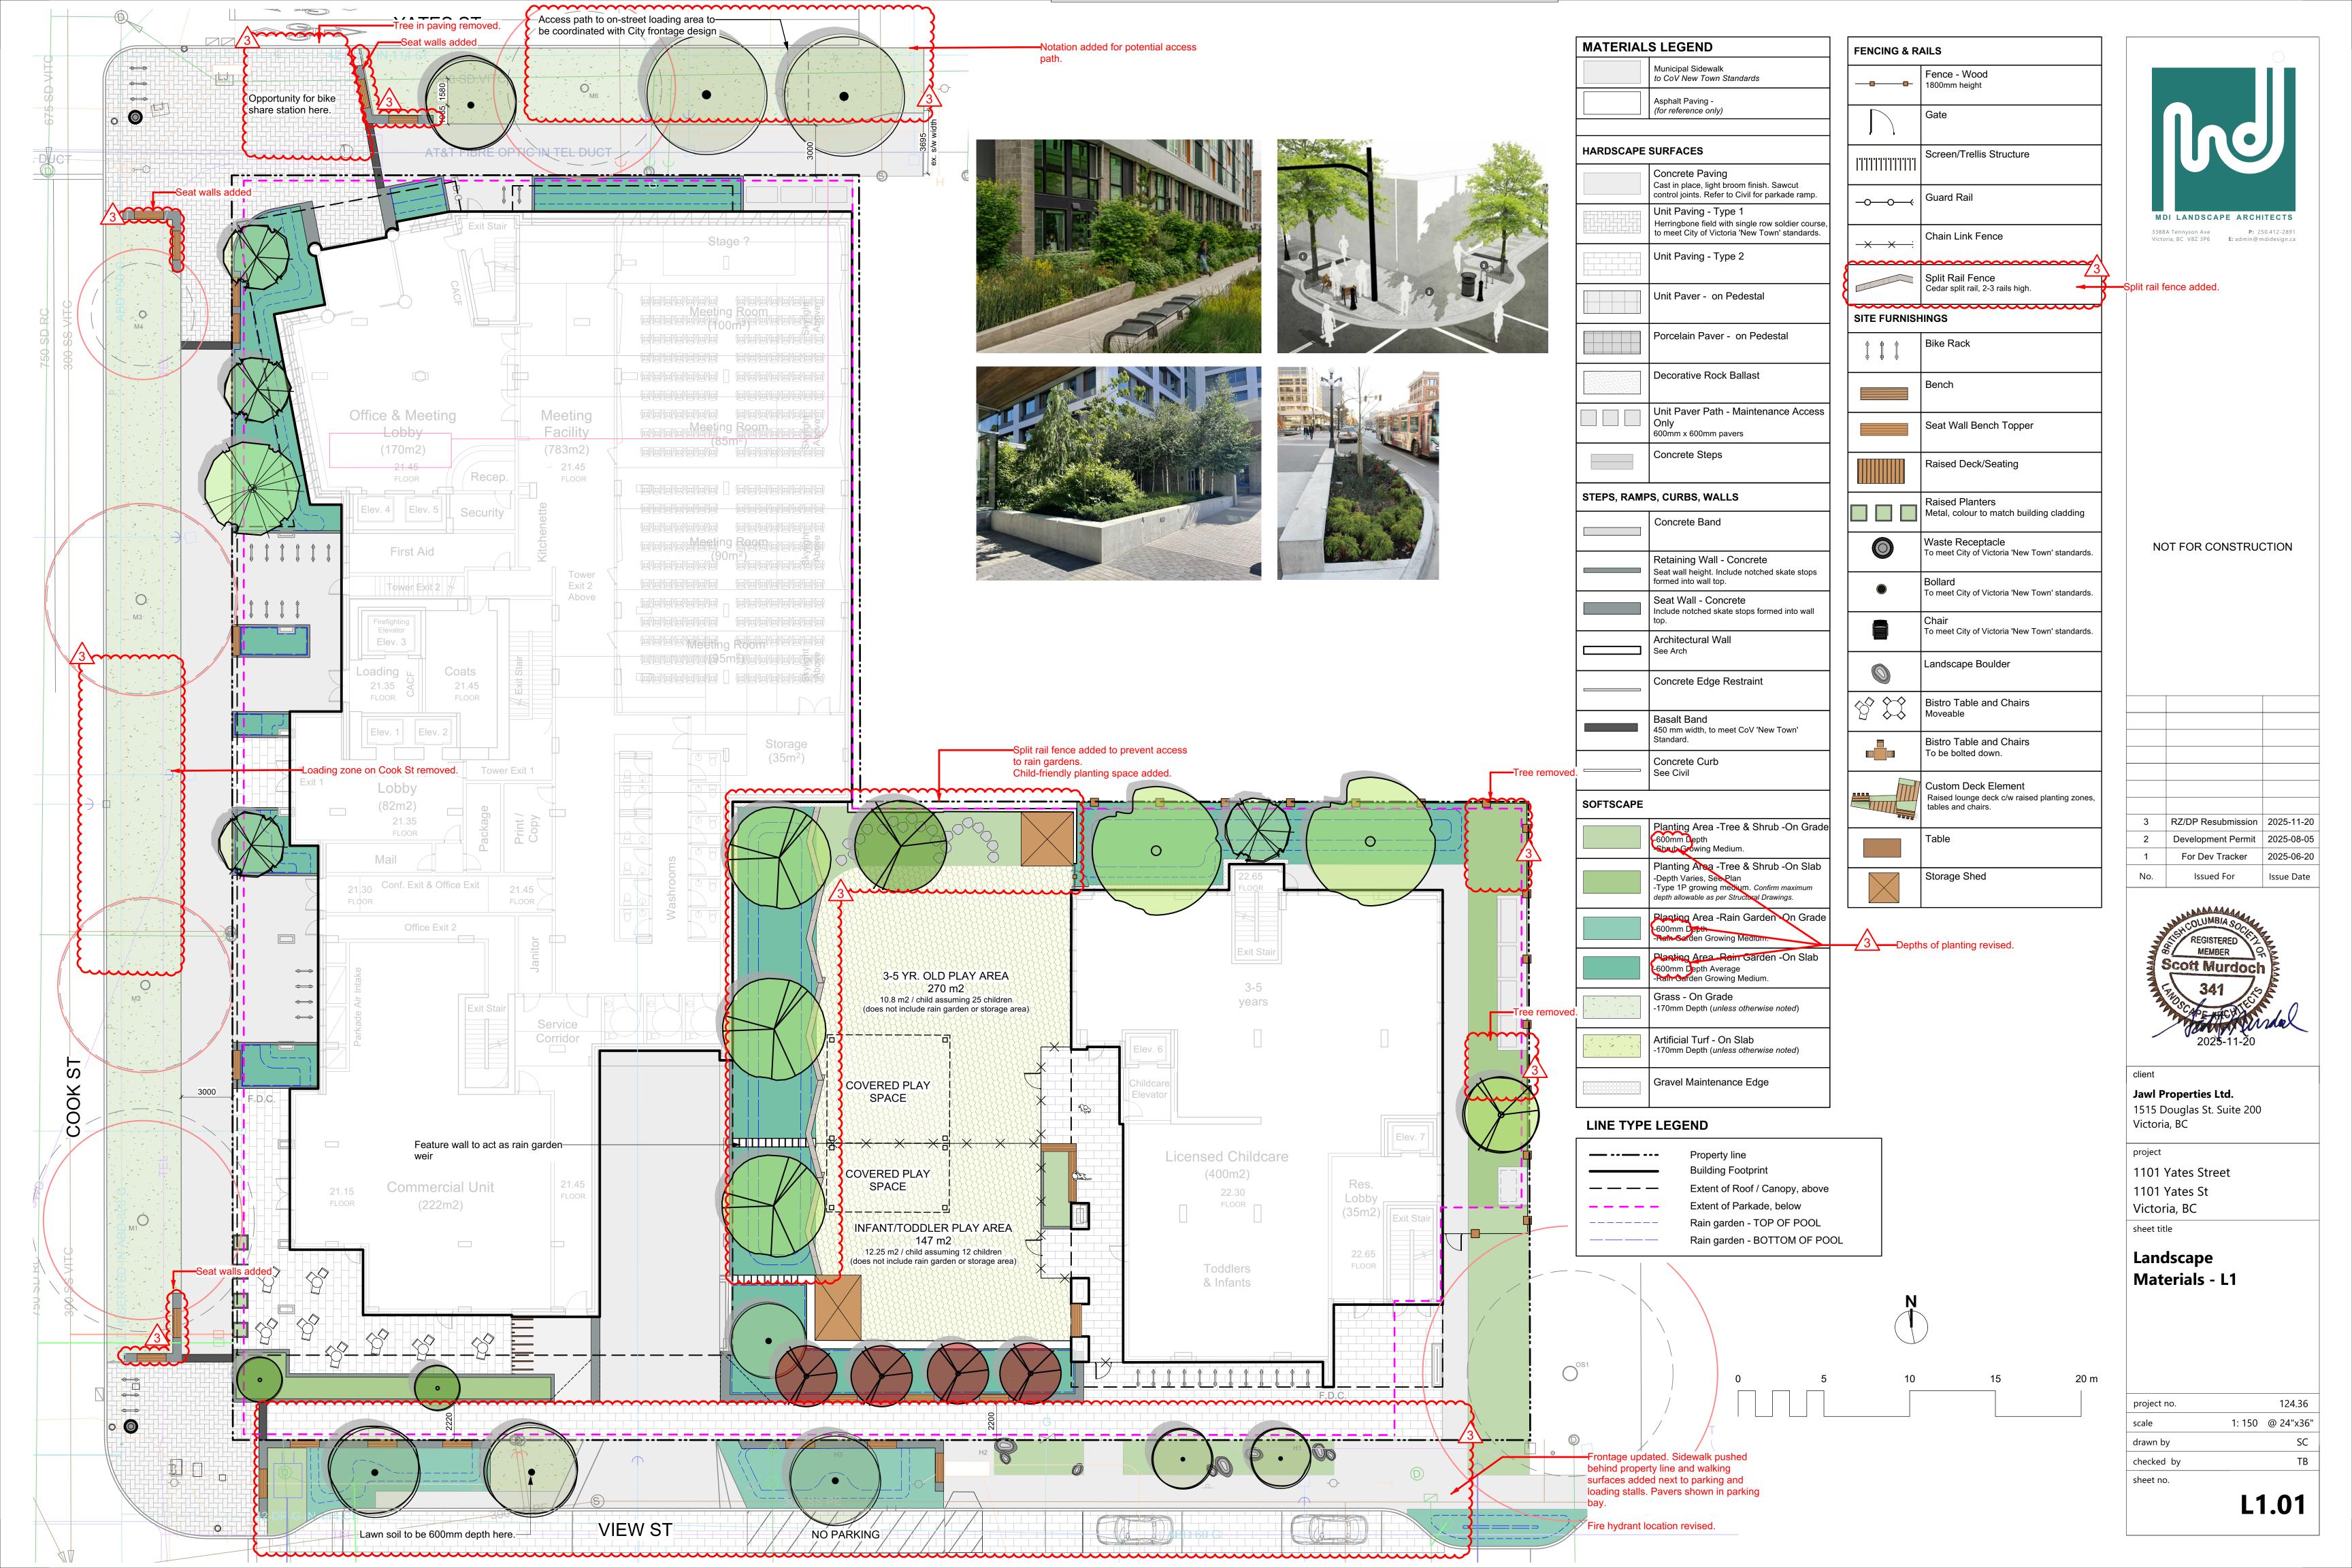




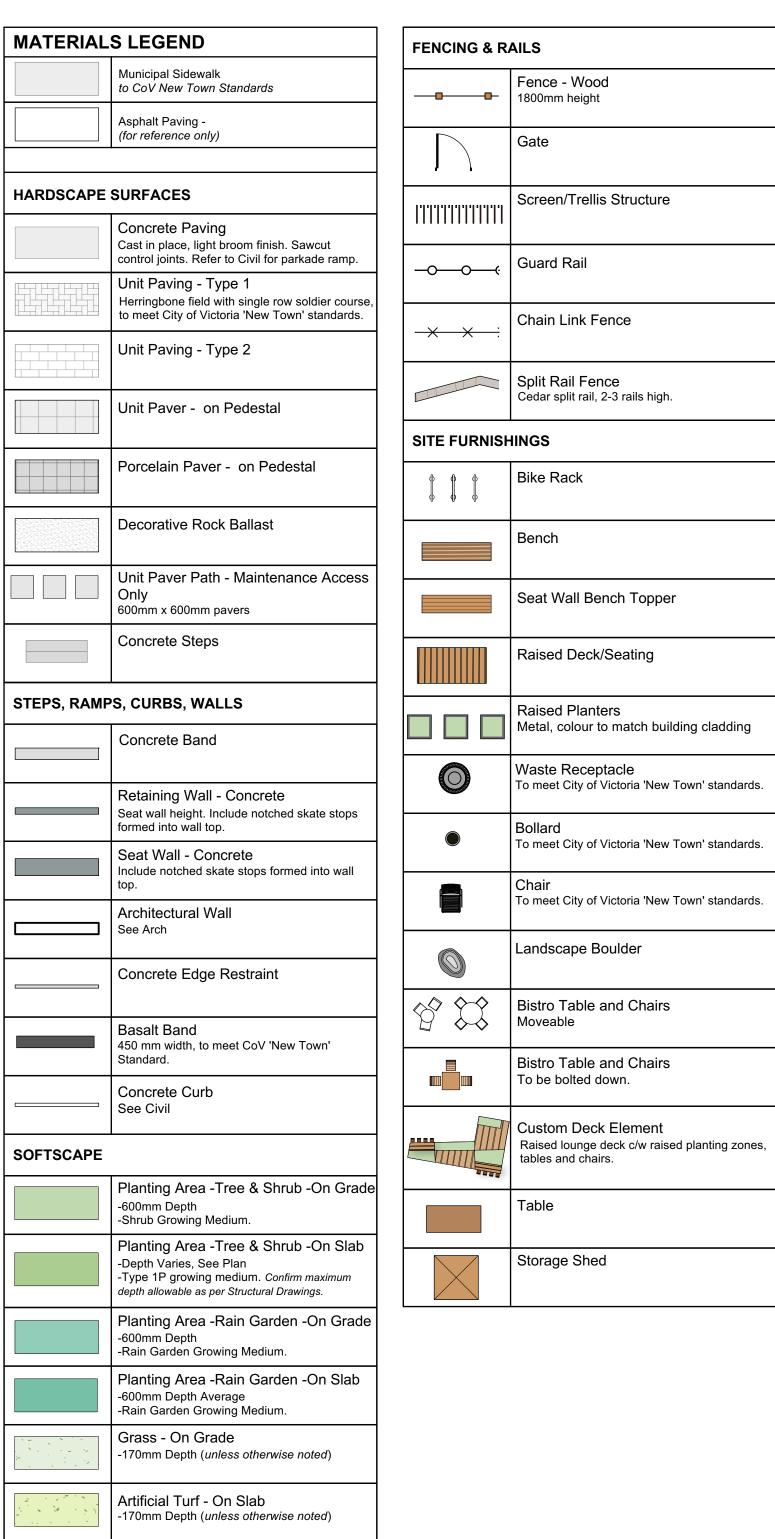

20 m

Gravel Maintenance Edge

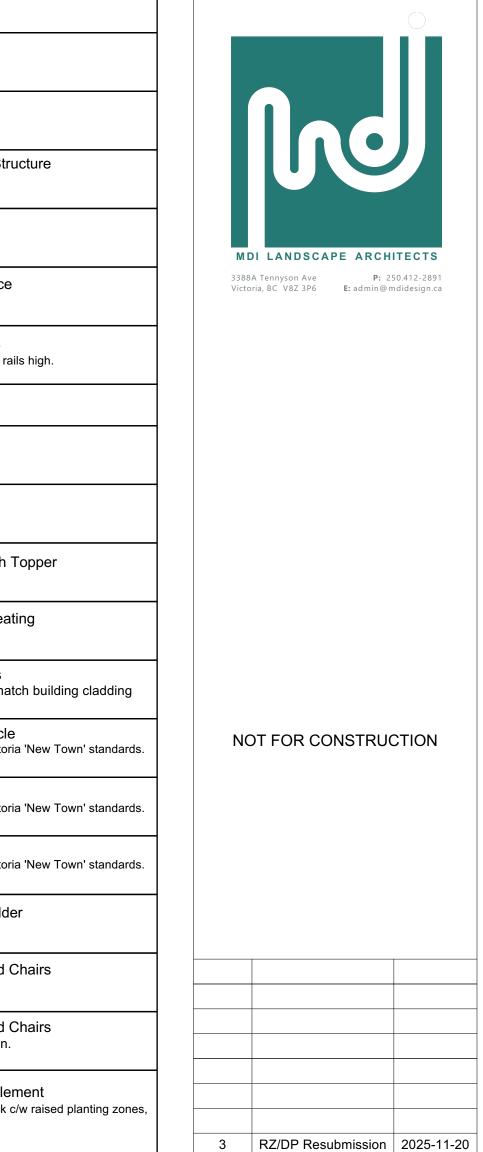



2 Development Permit 2025-08-05

2025-06-20

Issue Date

For Dev Tracker

Issued For

No.

Jawl Properties Ltd.
1515 Douglas St. Suite 200

Victoria, BC


project
1101 Yates Street
1101 Yates St

Victoria, BC

Landscape
Materials -L2 & L3

project no.		124.36
scale	1: 150	@ 24"x36"
drawn by		SC
checked by		ТВ
sheet no.		
	1 4	1 02

L1.02

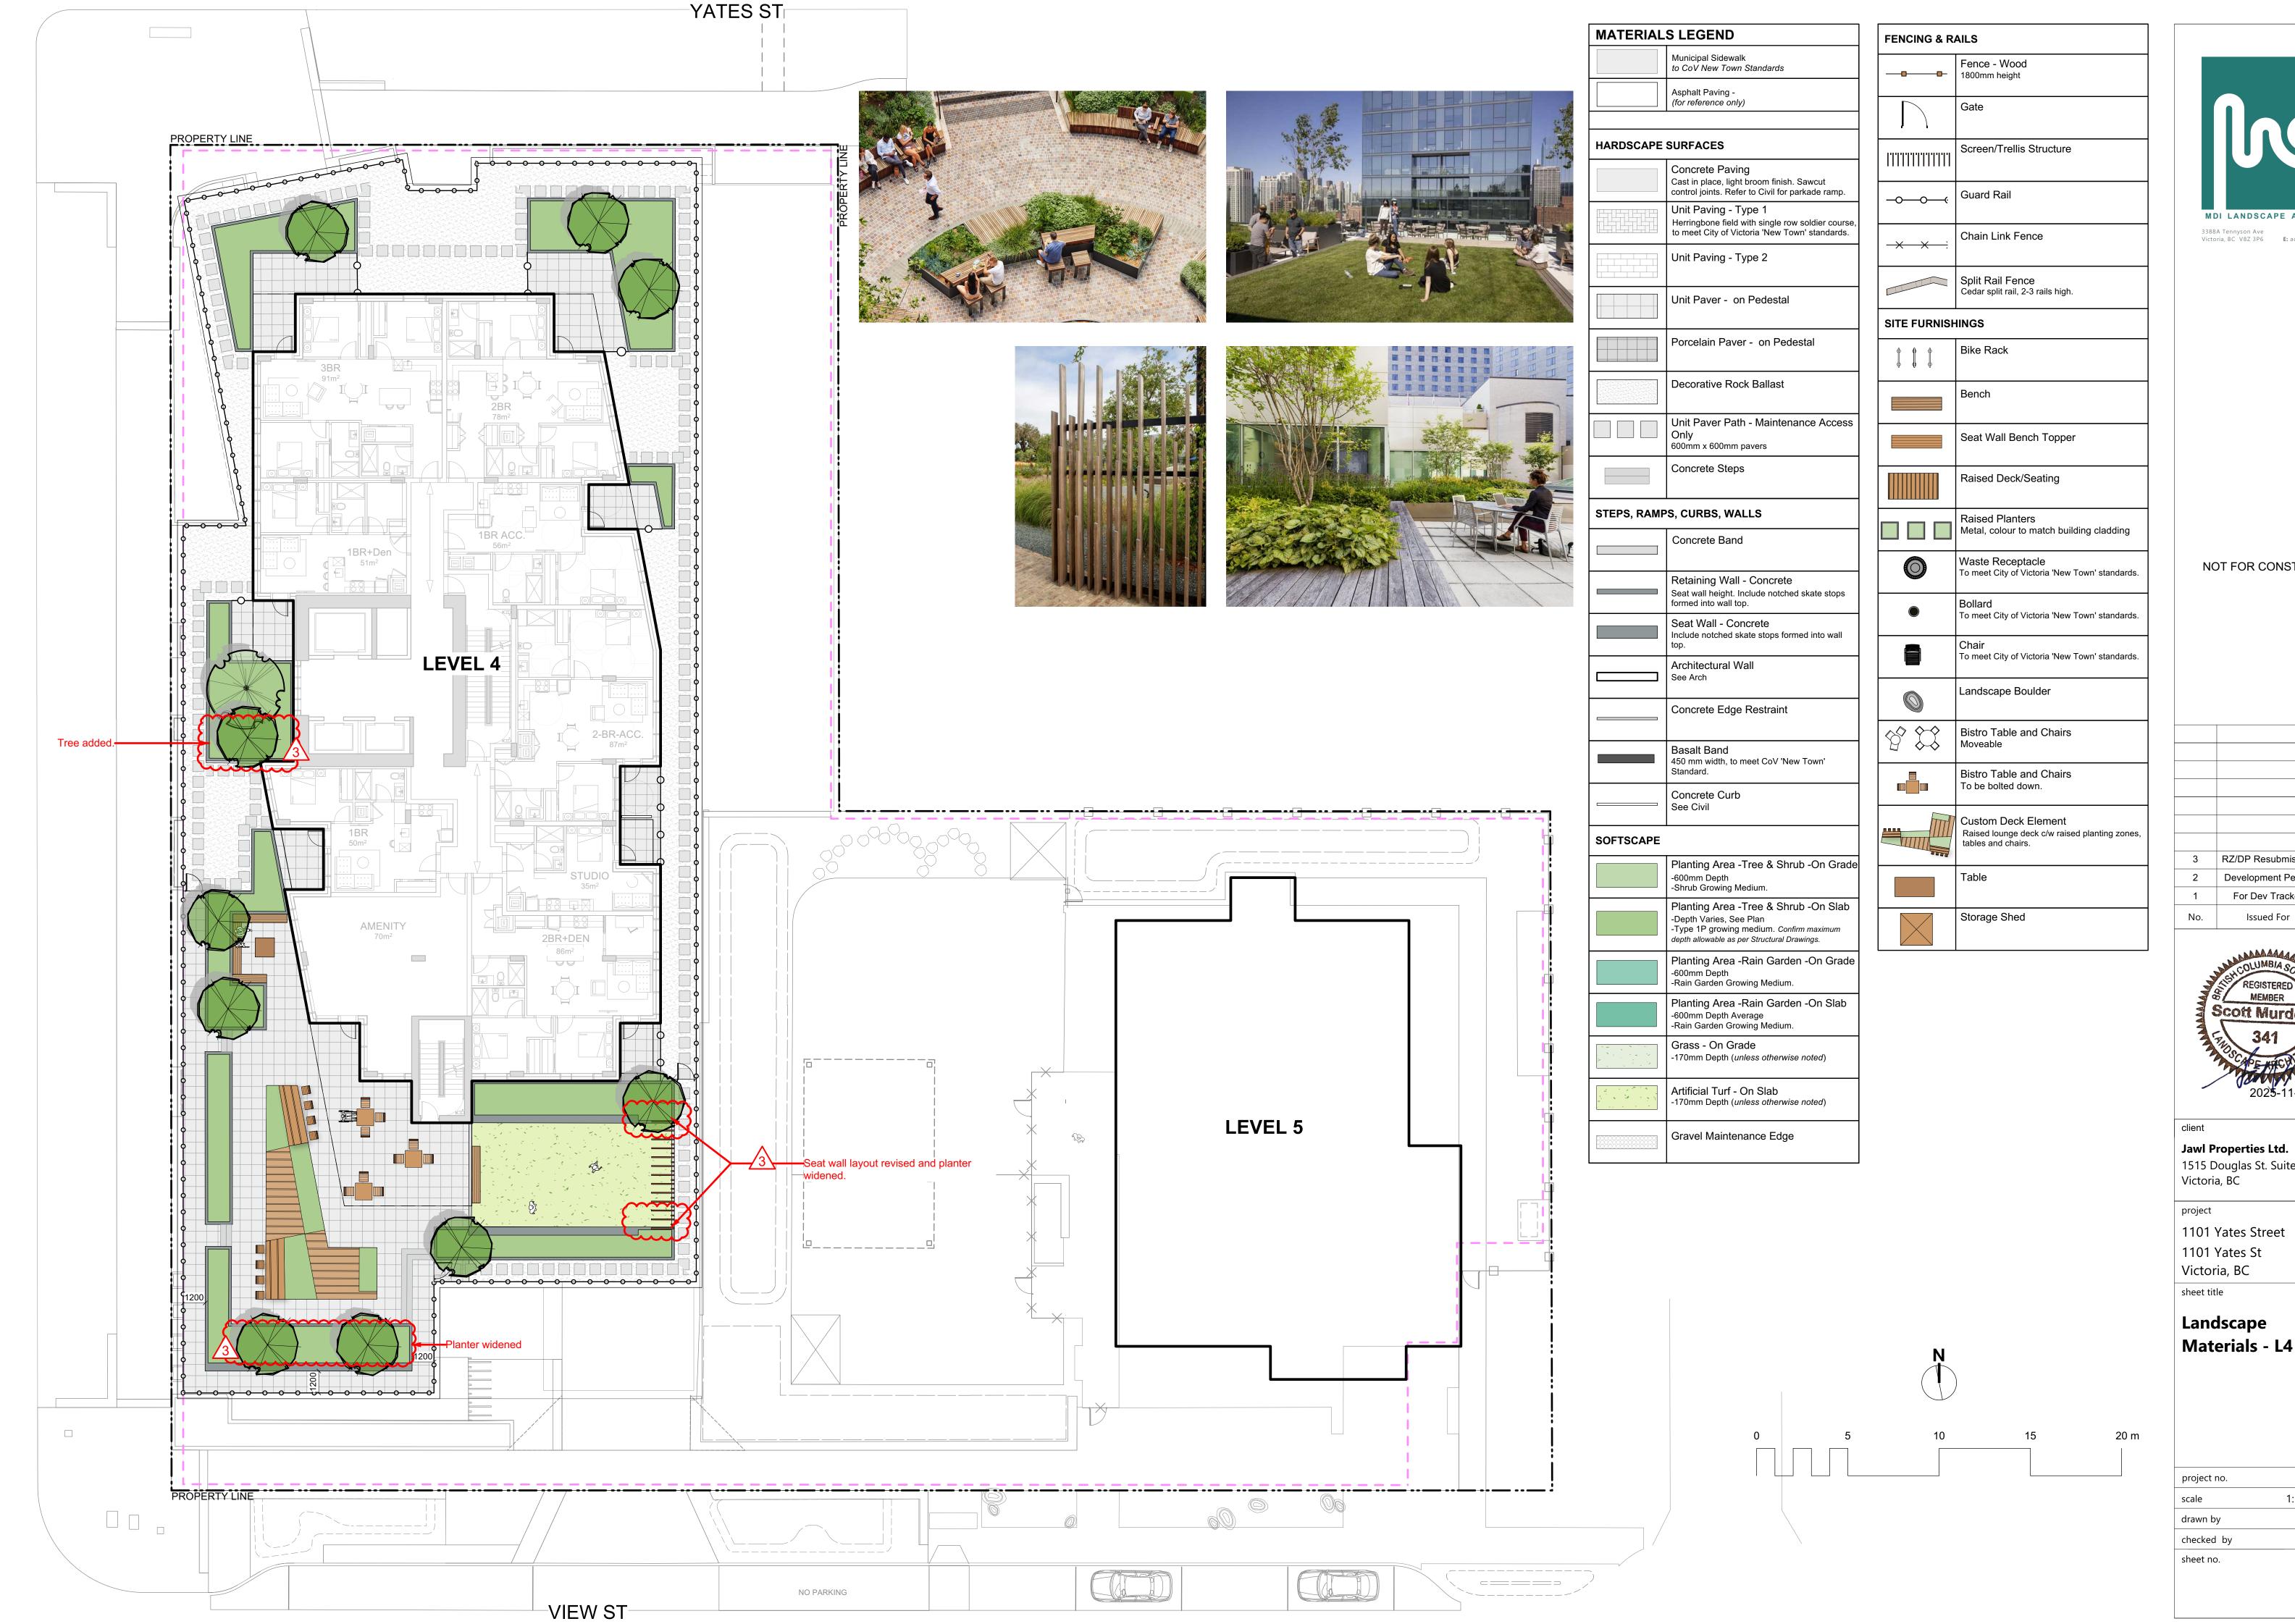



NOT FOR CONSTRUCTION

RZ/DP Resubmission 2025-11-20 2 Development Permit 2025-08-05 For Dev Tracker Issued For Issue Date MEMBER Scott Murdock


Jawl Properties Ltd. 1515 Douglas St. Suite 200

1101 Yates Street 1101 Yates St

Landscape

124.36 1: 150 @ 24"x36"

L1.03

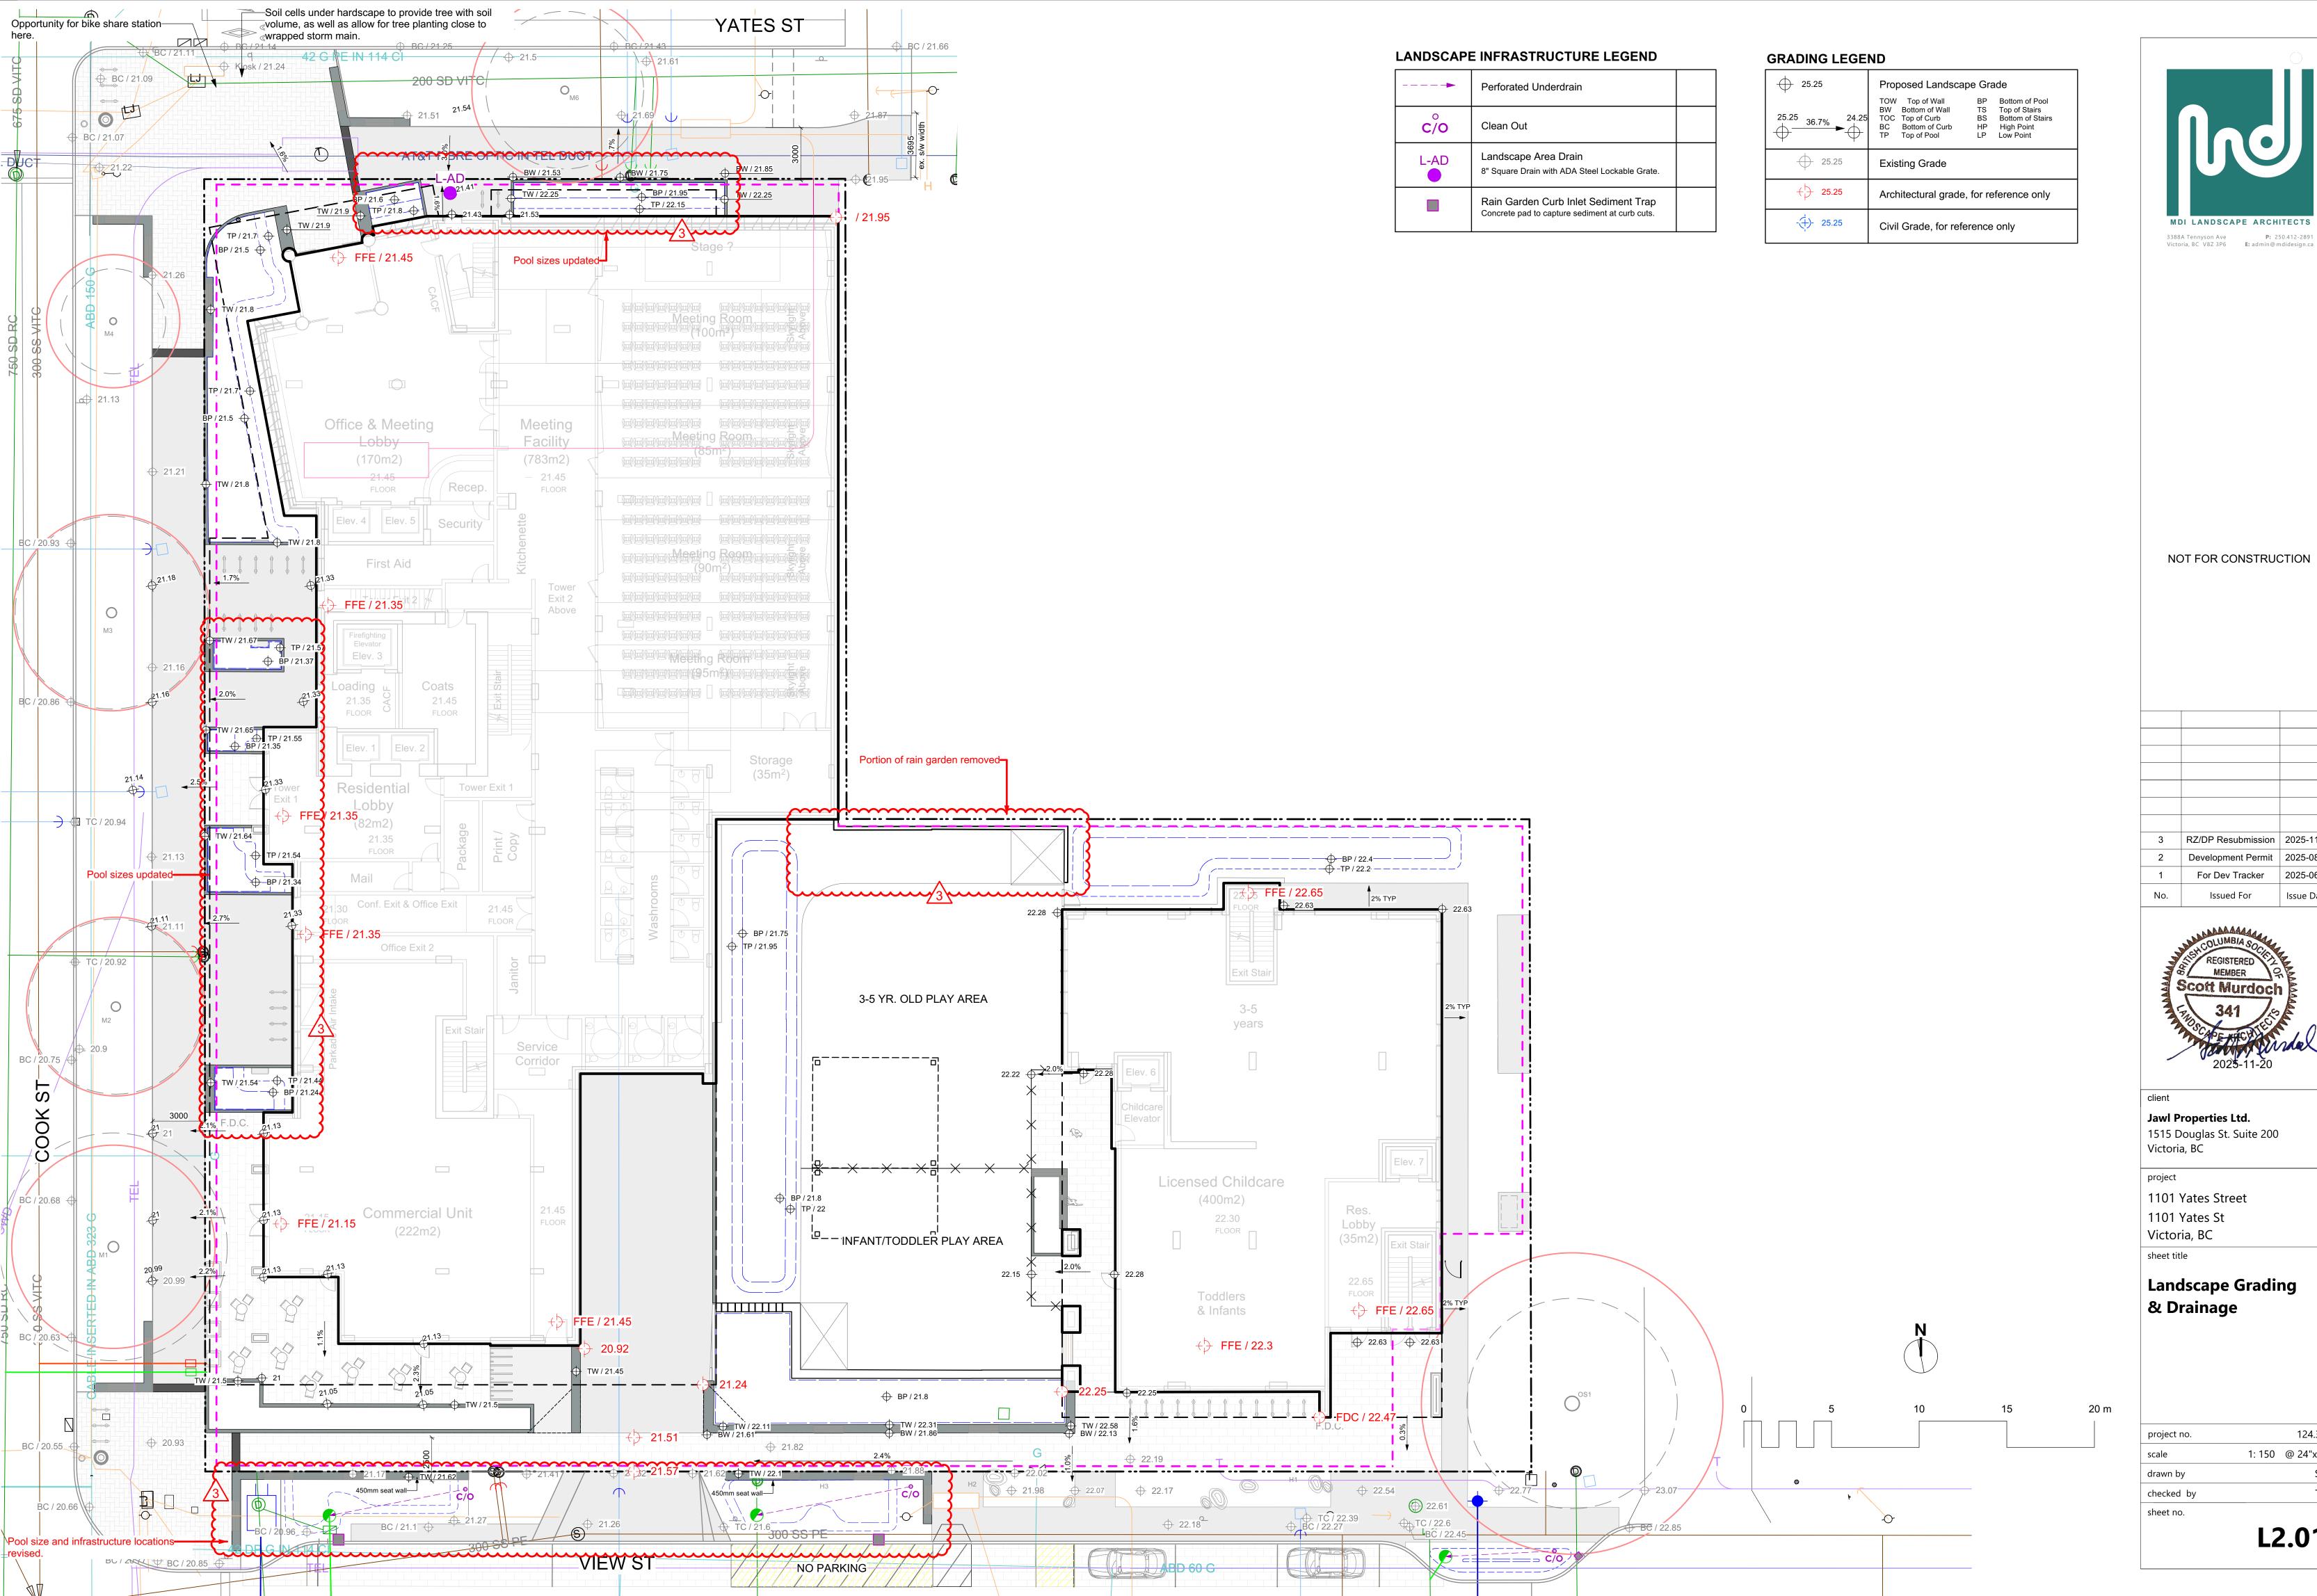



NOT FOR CONSTRUCTION

3	RZ/DP Resubmission	2025-11-20			
2	Development Permit	2025-08-05			
	For Dev Tracker	2025-06-20			
0.	Issued For	Issue Date			
REGISTERED CHARLES MEMBER					


Jawl Properties Ltd. 1515 Douglas St. Suite 200


1101 Yates Street 1101 Yates St


Landscape Grading

& Drainage


	L2.01
sheet no.	
checked by	ТВ
drawn by	SC
scale	1: 150 @ 24"x36"
project no.	124.36

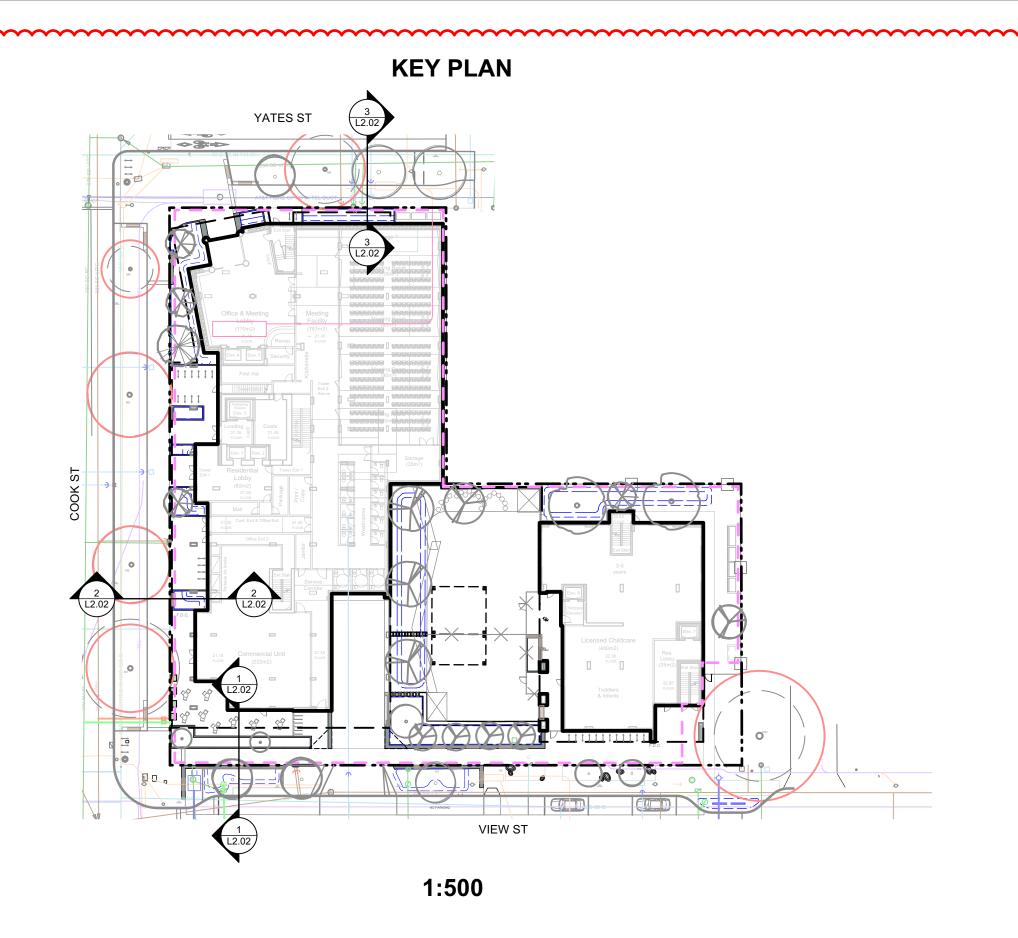

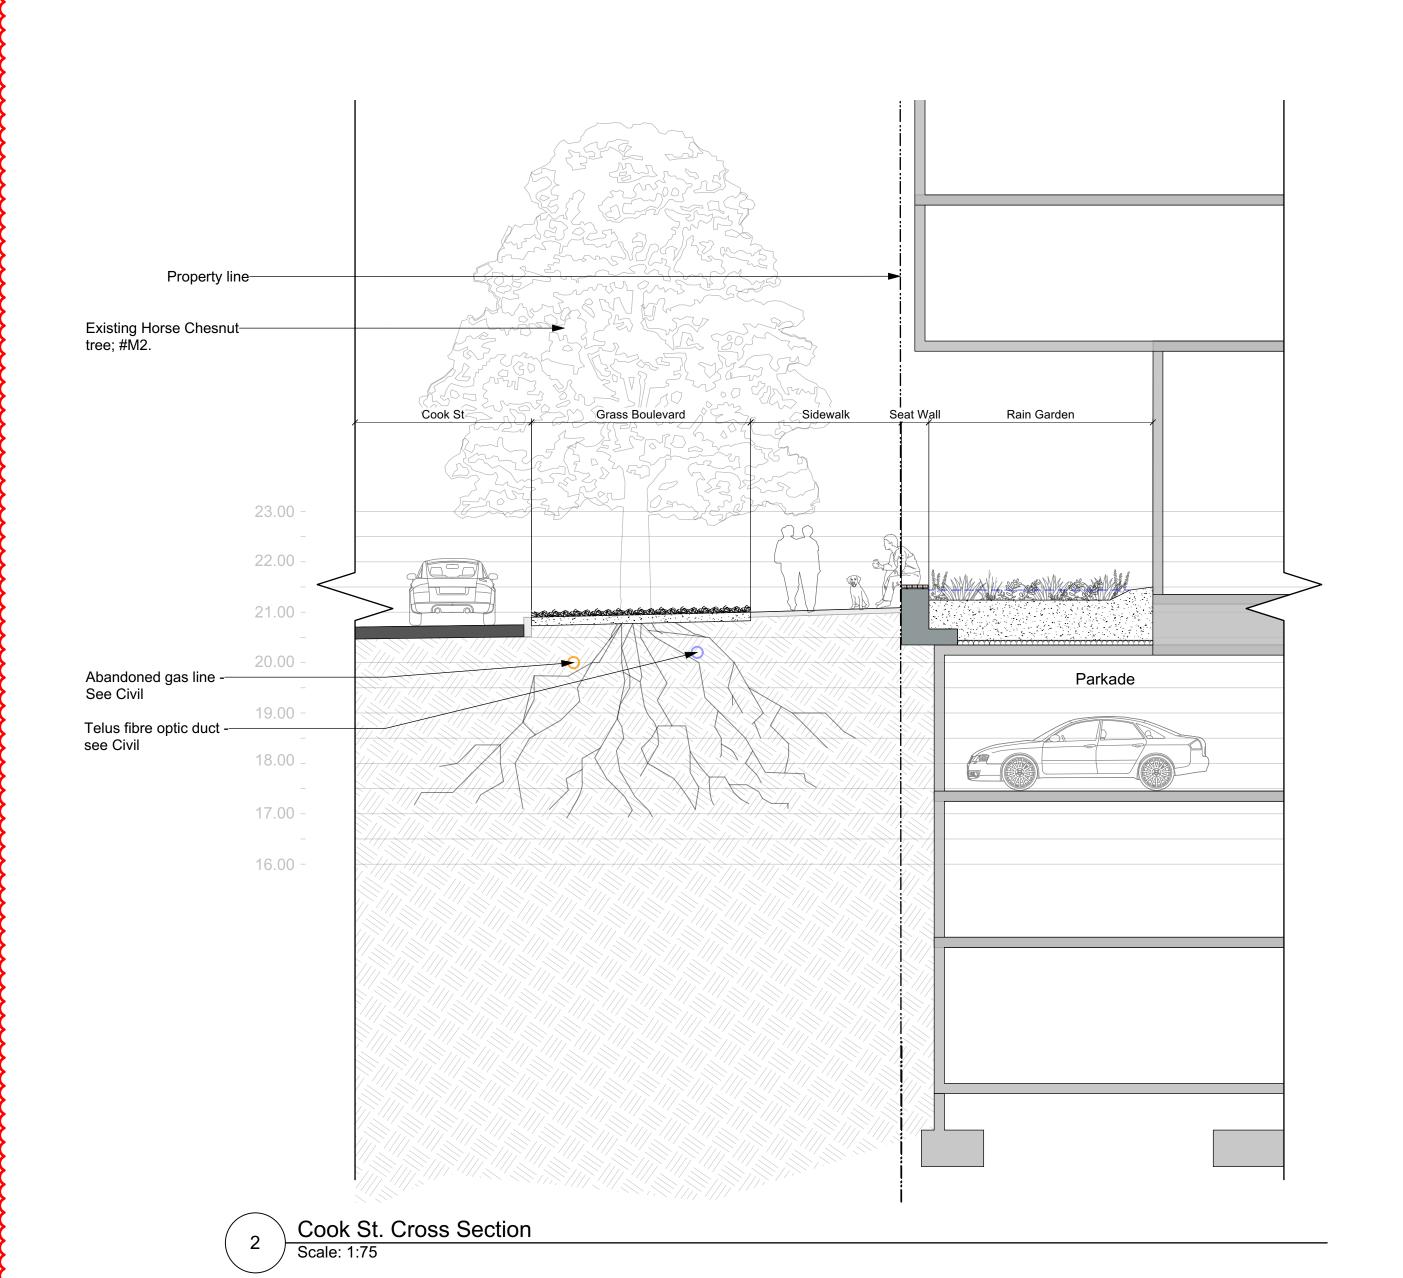

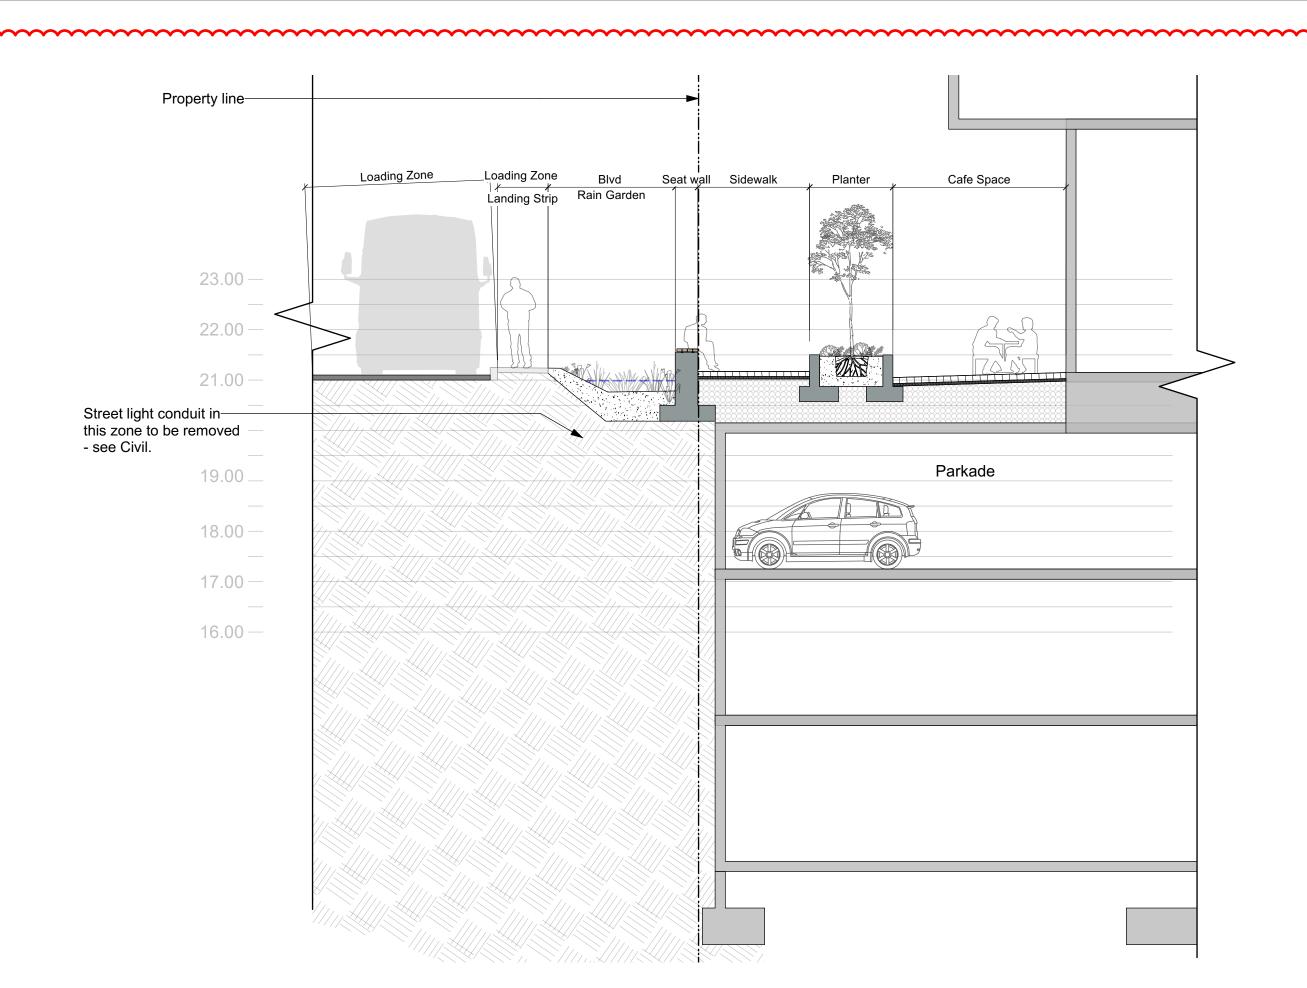

1 View St Cross Section
Scale: 1:75

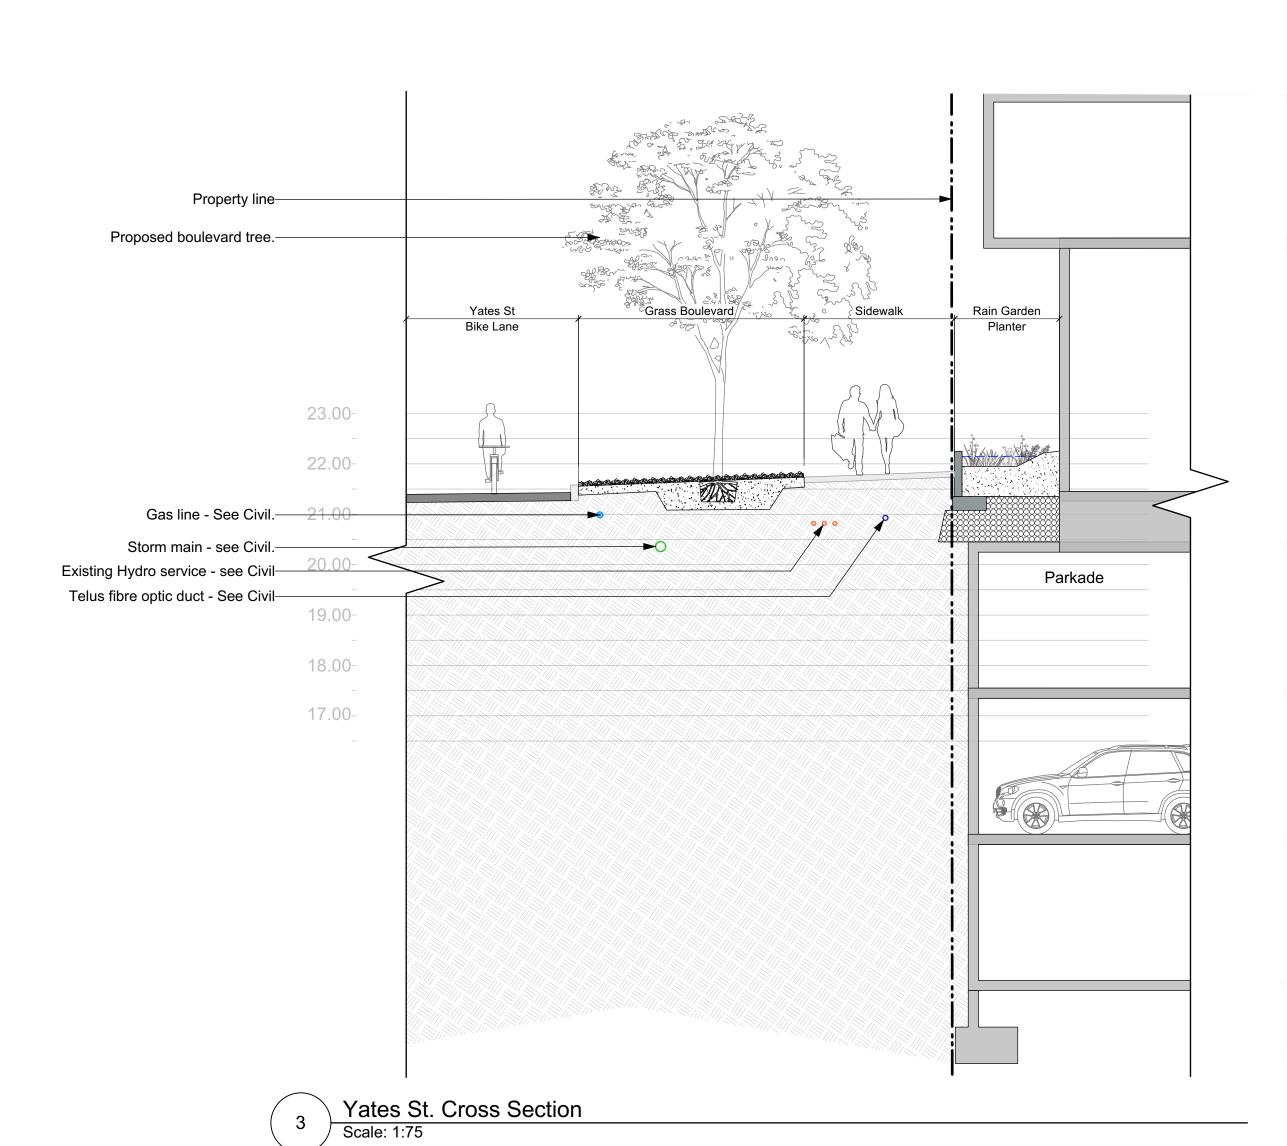



NOT FOR CONSTRUCTION

3	RZ/DP Resubmission	2025-11-20
2	Development Permit	2025-08-05
1	For Dev Tracker	2025-06-20
No.	Issued For	Issue Date



Jawl Properties Ltd.
1515 Douglas St. Suite 200
Victoria, BC

project

1101 Yates Street

1101 Yates St


Victoria, BC

sheet title


Landscape Sections

project no.		124.36
scale	AS NOTED	@ 24"x36"
drawn by		SC
checked by		ТВ
sheet no.		
	L2	2.02

Sections added.

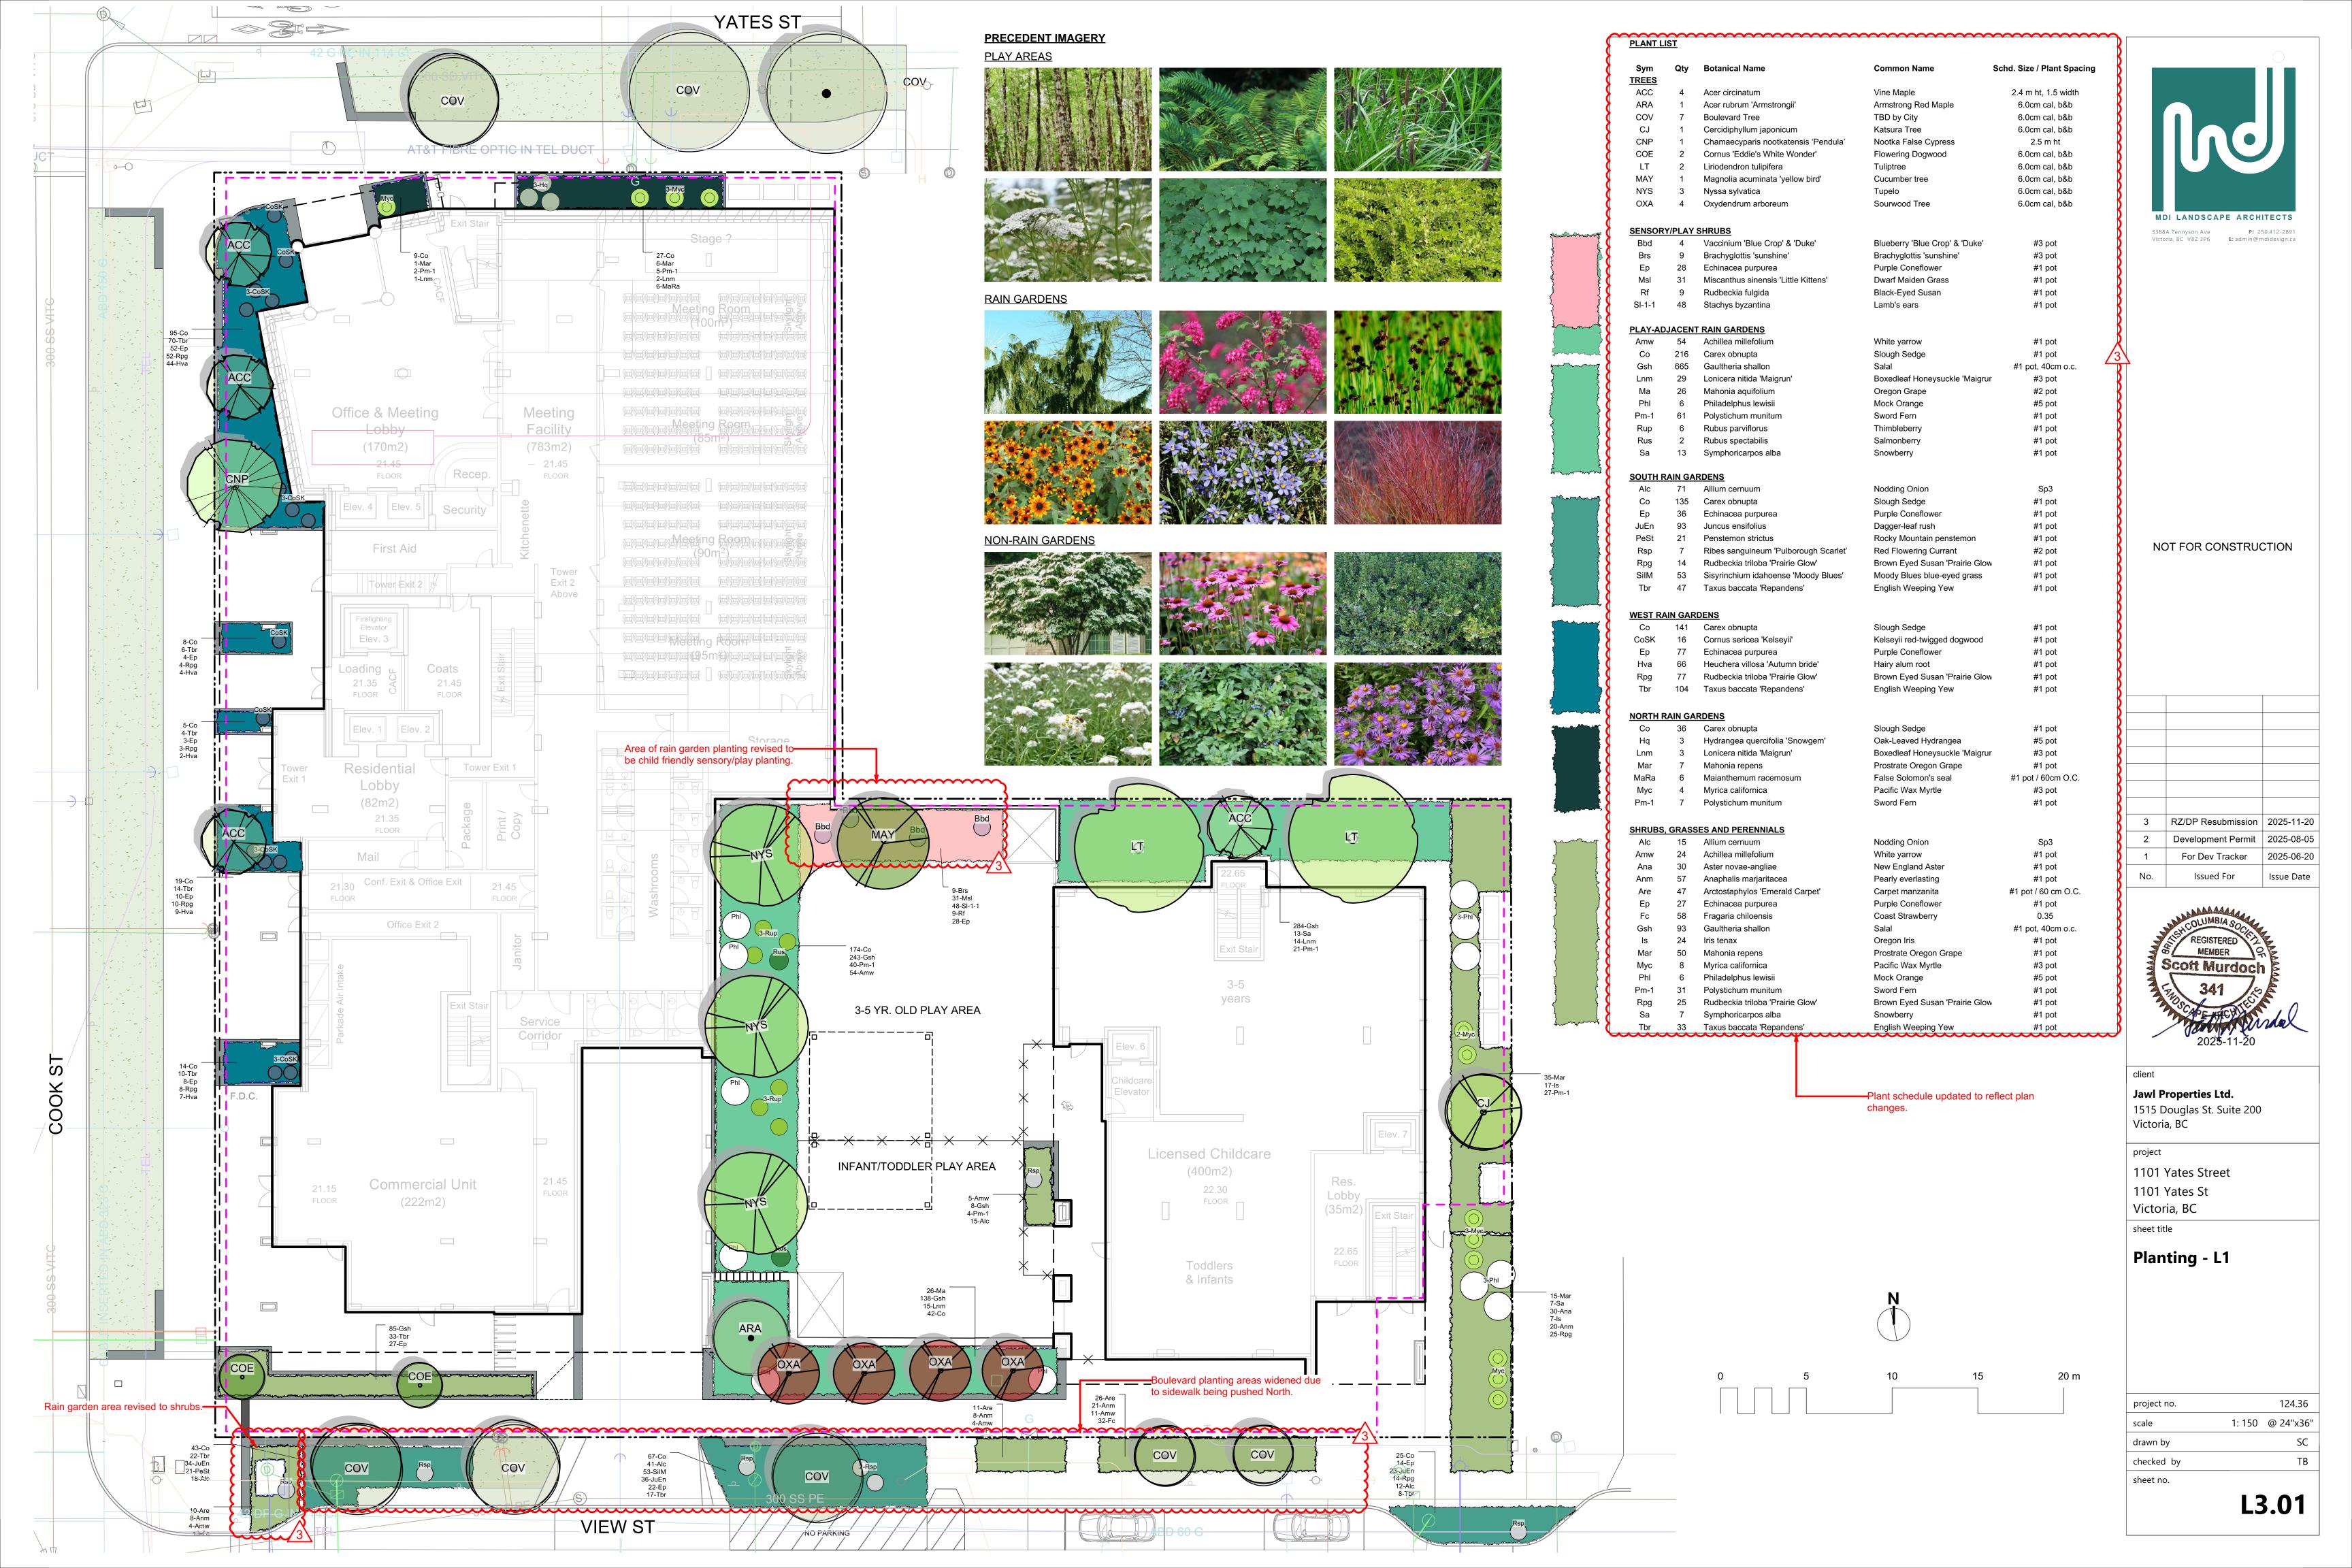



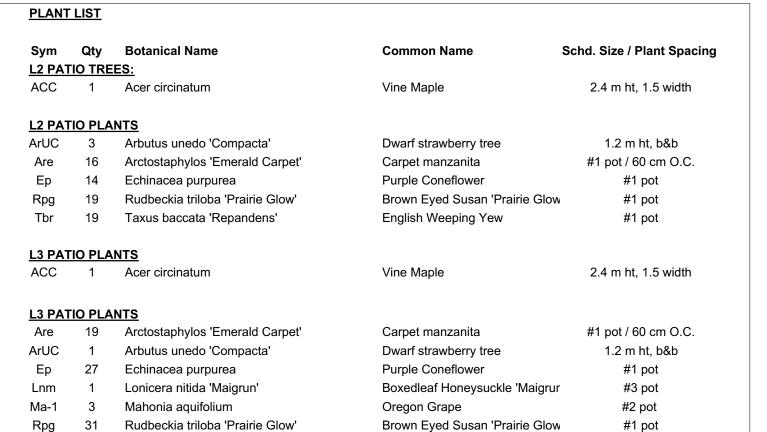

English Weeping Yew

#1 pot

MDI LANDSCAPE ARCHITECTS 3388A Tennyson Ave P: 250.412-2891 Victoria, BC V8Z 3P6 E: admin@mdidesign.ca


PRECEDENT IMAGERY

Tbr 9 Taxus baccata 'Repandens'

L2 & L3



NOT FOR CONSTRUCTION

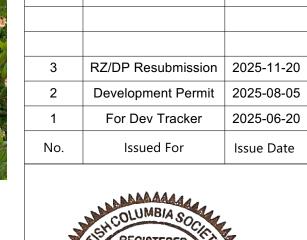

MEMBER Scott Murdoc


Jawl Properties Ltd. 1515 Douglas St. Suite 200 Victoria, BC

1101 Yates Street 1101 Yates St Victoria, BC

sheet title

Planting - L2 & L3

				L3	3.02
10	15	20 m	she	eet no.	
40 45 00	che	ecked by	ТВ		
			drav	wn by	SC
			scal	le 1: 150	@ 24"x36"
N			pro	oject no.	124.36
N.I.					

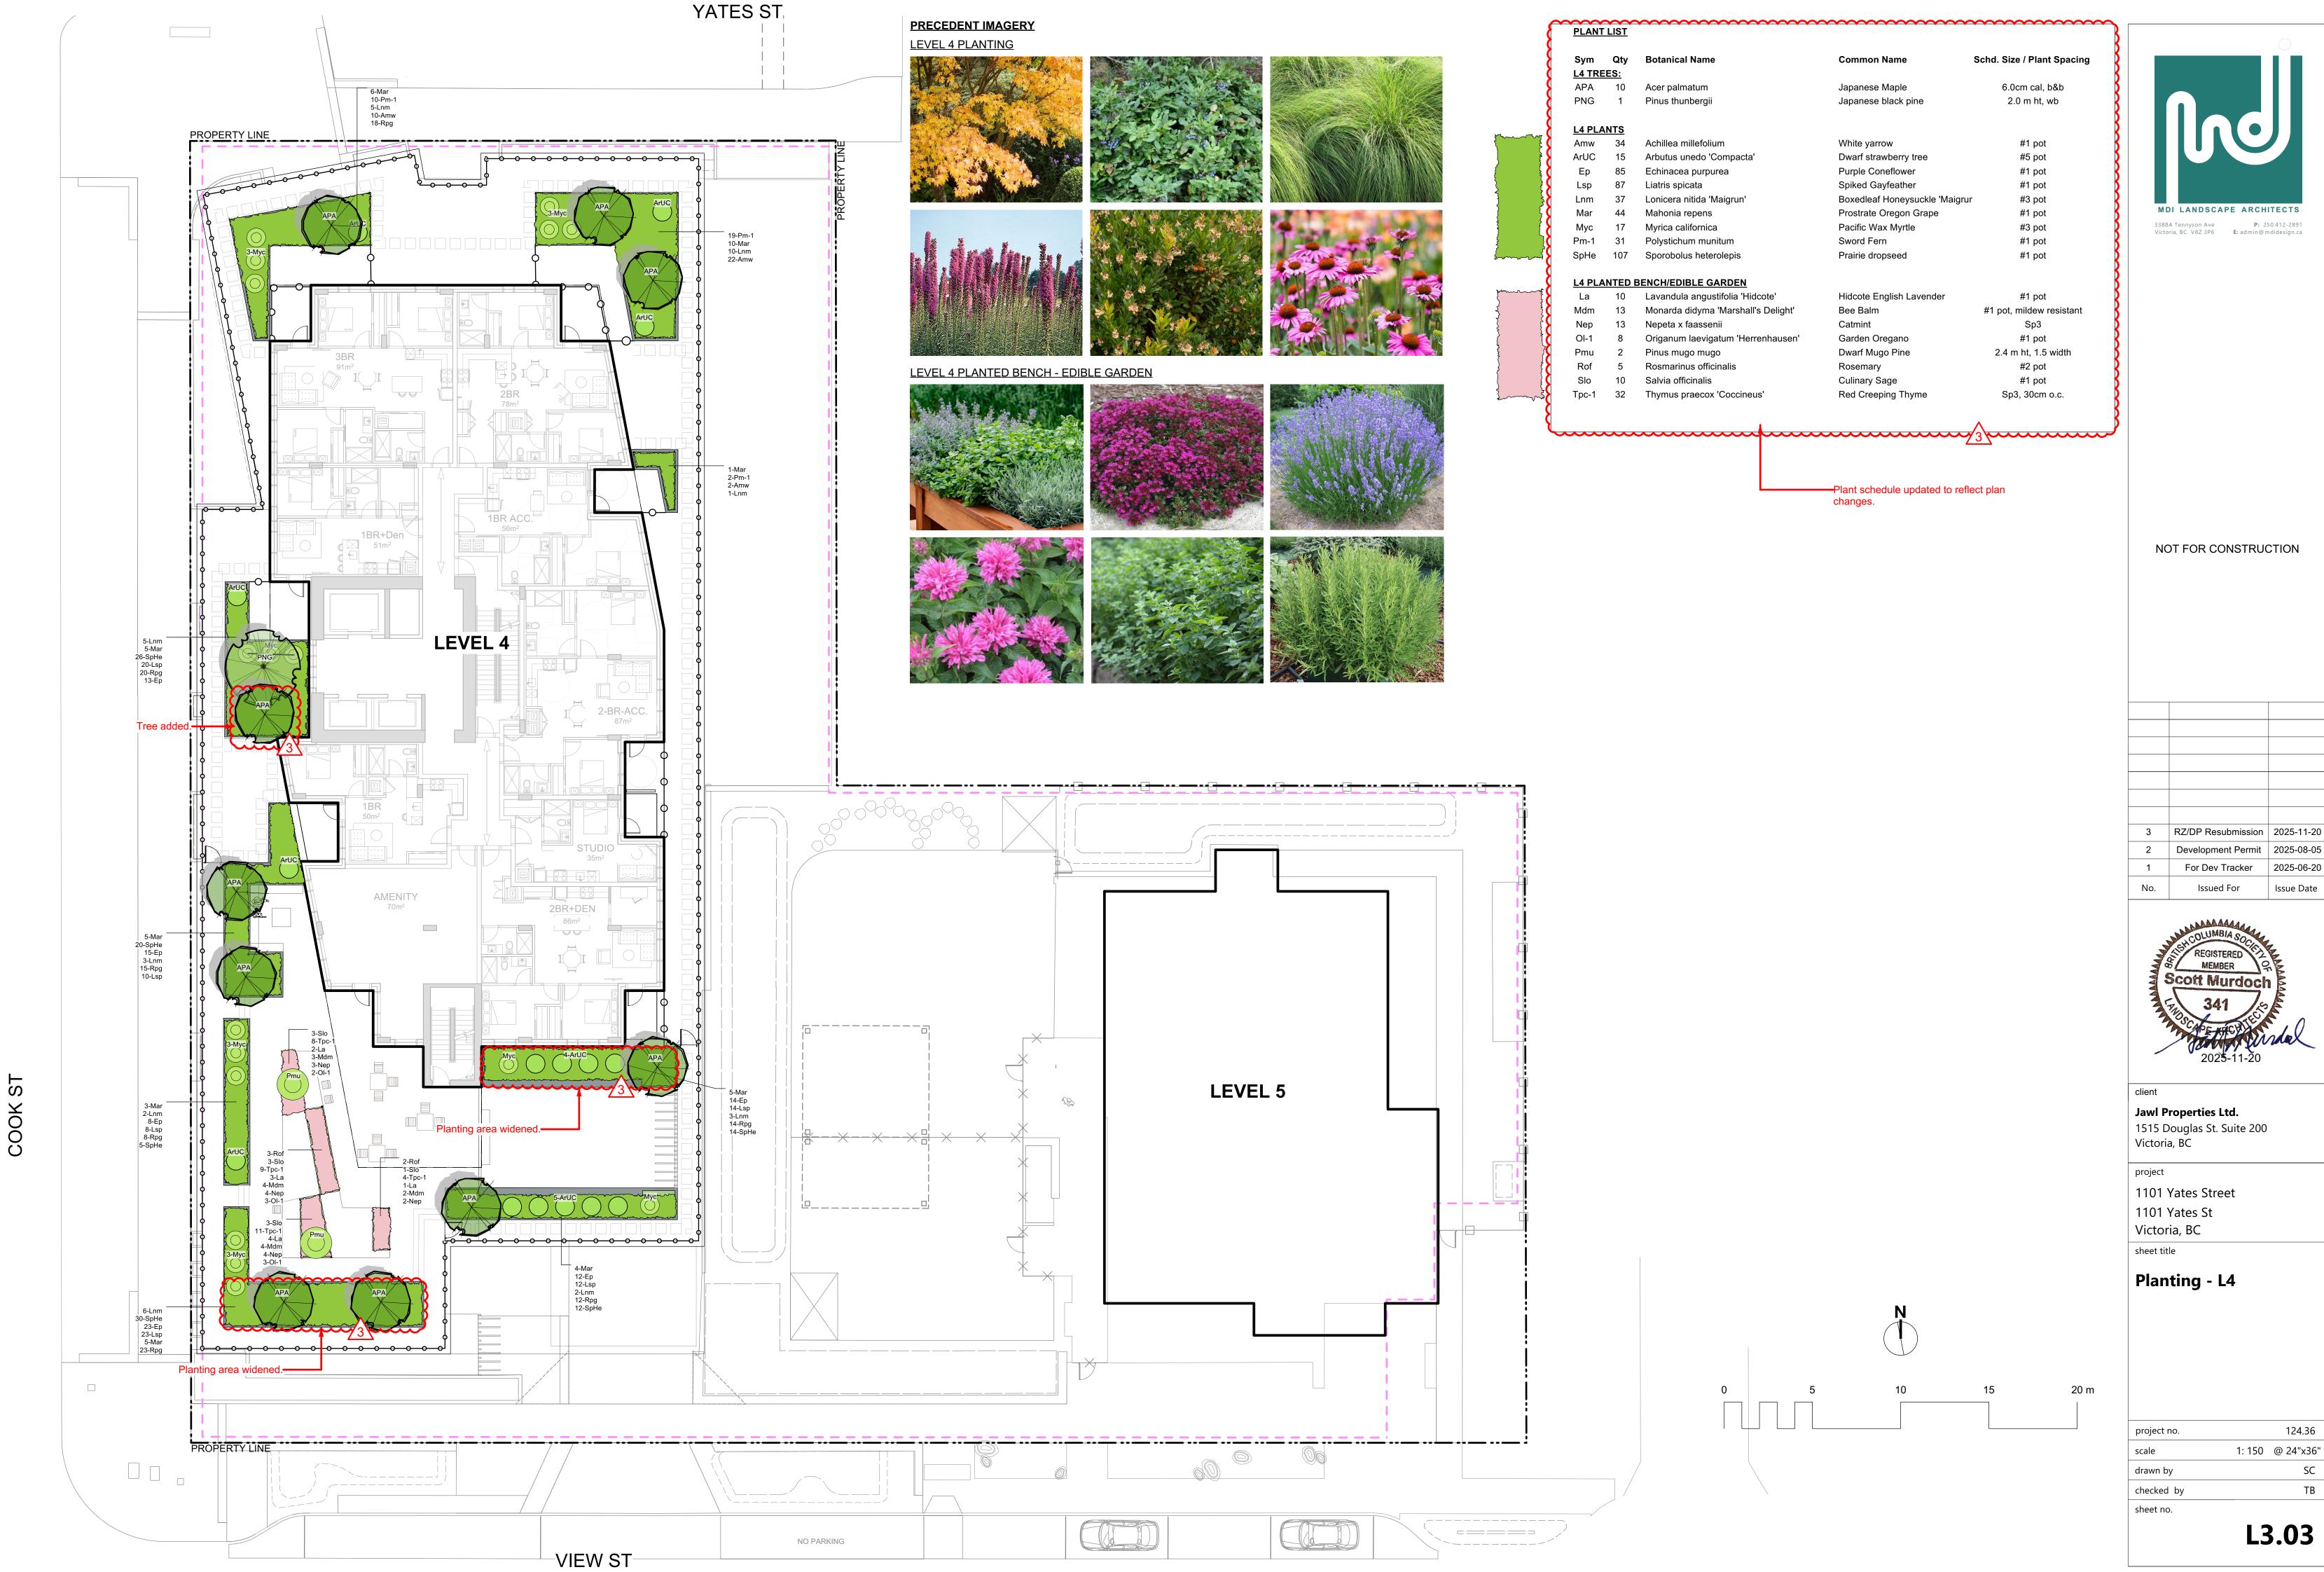





NOT FOR CONSTRUCTION


Scott Murdoc

project no.			124.36
scale	1:	150	@ 24"x36"
drawn by			SC
checked by			ТВ
sheet no.			
		L 3	3.03

LJ.UJ

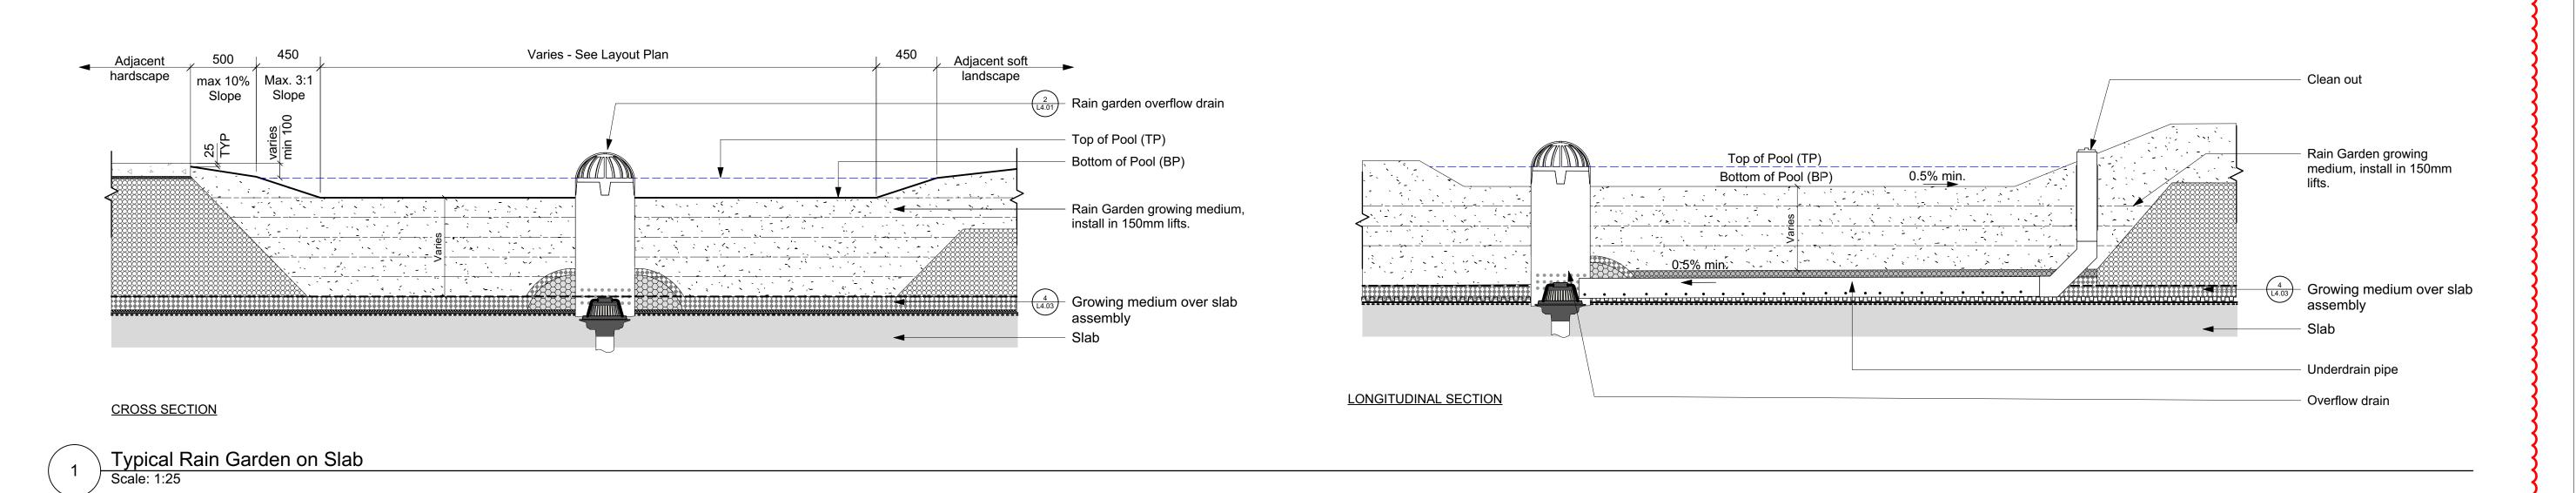

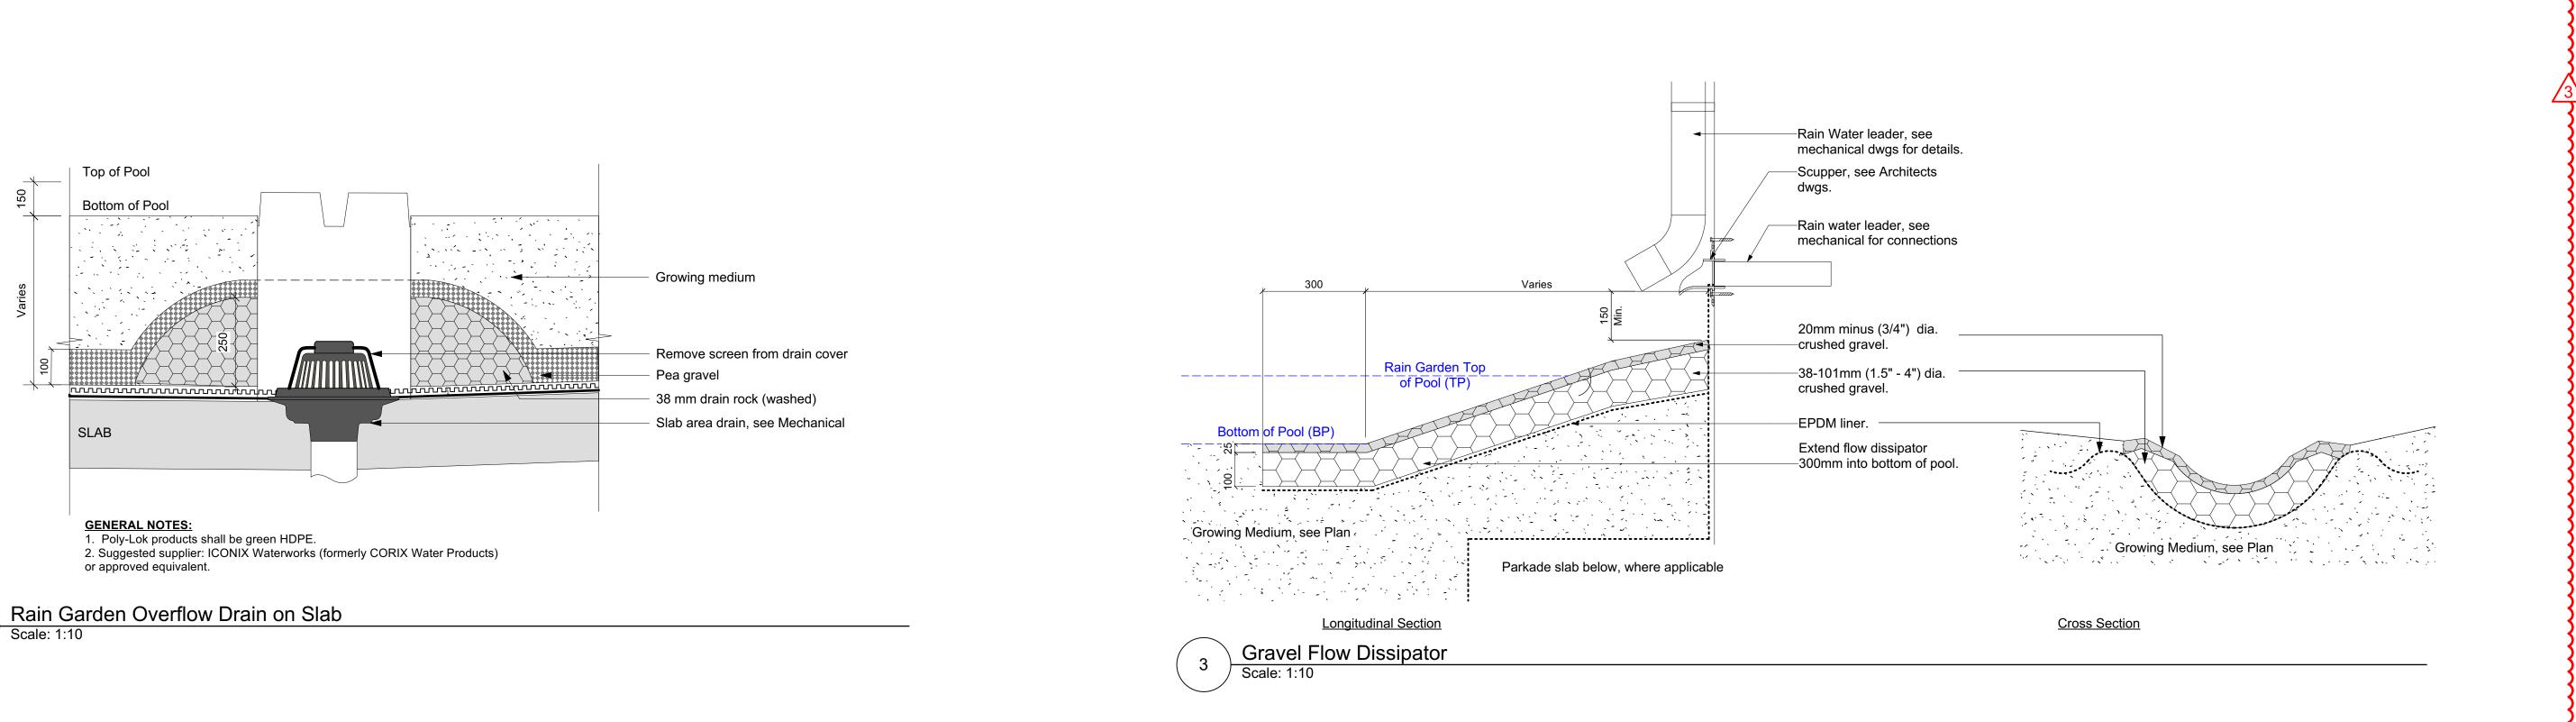

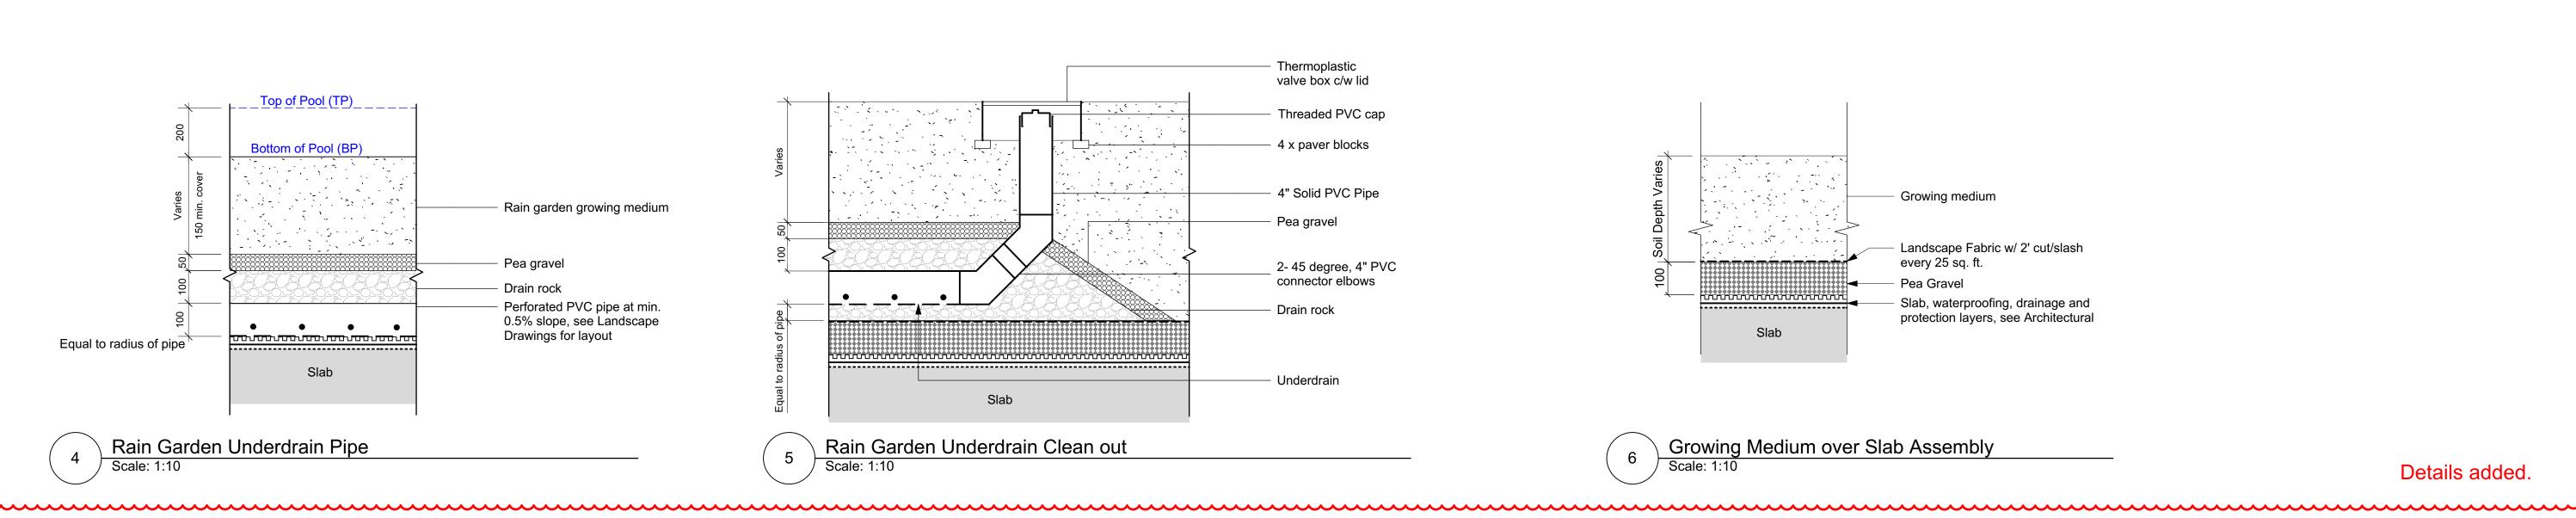



NOT FOR CONSTRUCTION

3 RZ/DP Resubmission 2025-11-20
2 Development Permit 2025-08-05
1 For Dev Tracker 2025-06-20
No. Issued For Issue Date



Jawl Properties Ltd.
1515 Douglas St. Suite 200
Victoria, BC

project

1101 Yates Street

1101 Yates St

Victoria, BC


sheet title


Landscape Details: Rain Garden

project no. 124.36

scale AS NOTED @ 24"x36"
drawn by SC
checked by TB
sheet no.

L4.01

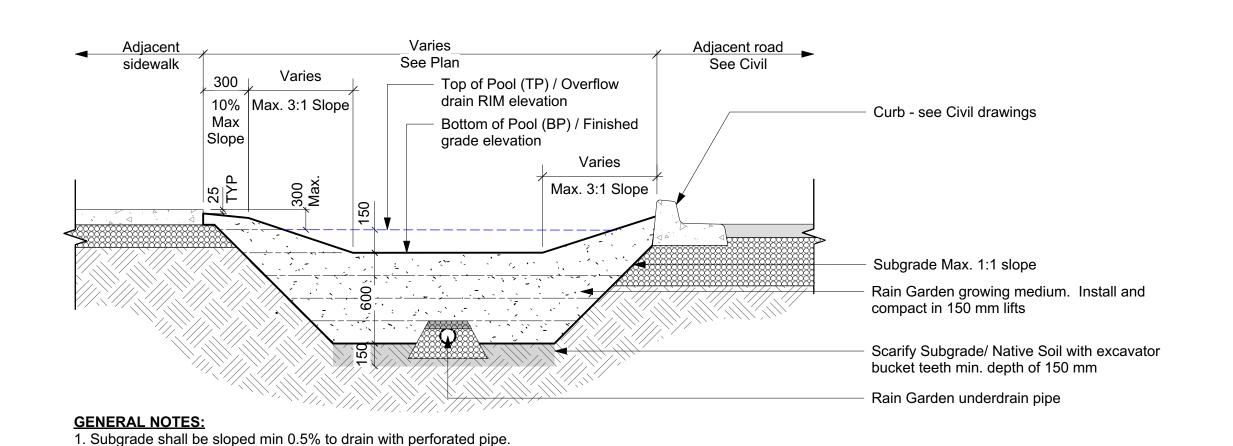

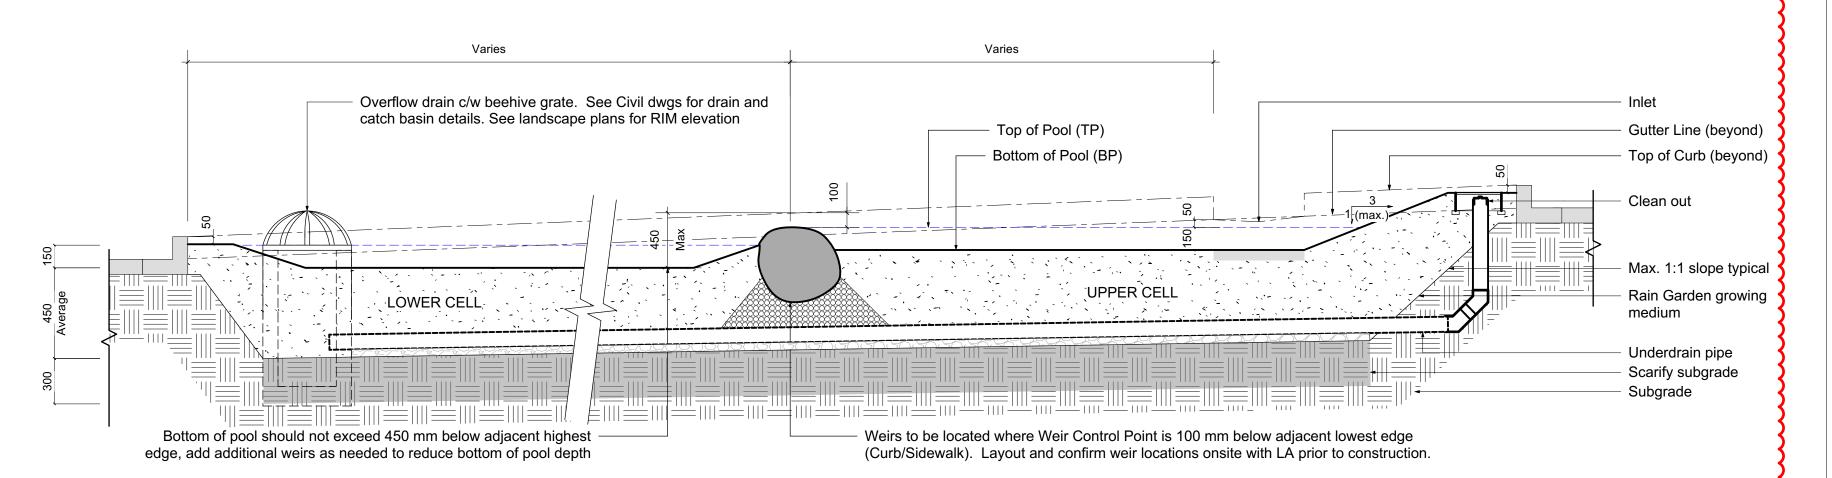

VICTORIA

REMOVE COMPLETELY FROM CONTAINER

REMOVE TOP ½ OF WIRE, ROPE AND BURLAP COVERING WITHOUT

DAMAGING ROOTBALL. REMOVE ALL

40mm NYLON WEBBING

GROWING MEDIA SHALL MEET B.C. LANDSCAPE

STANDARD TABLES 6-3 (SECTION 32 91 21-

MMCD 2009) ALL SOIL PROPERTIES MUST MEET THIS STANDARD. DEPTH GROWING MEDIA TO BE

ASPHALT ...

COMPACTED SUBGRADE - TO 98% S.P.D.

VICTORIA TREE SPECIFICATIONS

AND/OR BLVD WIDTH.

ALL TREES SHALL MEET OR EXCEED THE CITY OF

ROOT BARRIER REQUIRED ON BLVD 2.0m OR LESS

ROOT BARRIER REQUIRED PENDING TREE SPECIES

TREE PLANTING IN BOULEVARD

WIDE OR AS SPECIFIED BY THE DIRECTOR OF PARKS.

PLACED AND TRAMPED IN 100 mm LIFTS \ OR rain garden growing medium spec. See plan fo

ROADWAY

REFER TO

450 mm x 4.0M LENGTH

ROOT BARRIER

CIVIL DWGS

150mm DEPTH -

1.0m DIAMETER BARK MULCH

RING SAUCER OVER ROOTBALL

REMOVE TOP 1/3 OF COVERING

PREPARATION NOTES:

1. CONTAINER GROWN:

2. BURLAP AND ROPE:

3. WIRE AND BURLAP:



NOT FOR CONSTRUCTION

RZ/DP Resubmission | 2025-11-20 Development Permit 2025-08-05 For Dev Tracker

Jawl Properties Ltd. 1515 Douglas St. Suite 200

project 1101 Yates Street 1101 Yates St Victoria, BC

Landscape Details: Boulevard Rain

scale draw chec shee

No. Issue Date



Victoria, BC

sheet title

Garden and Planting

	L	1.02
et no.		
cked by		ТВ
wn by		SC
e	AS NOTED	@ 24"x36"
ect no.		124.50

Scale: 1:25 -Cast in place concrete curb inlet. See Civil dwg: -Curb. See Civil dwgs. Civil Contract Landscape Contract gutter Top of Pool —Bottom of pool. -2'x2' concrete paver

Growing Medium

--2'x2' concrete paver **PLAN VIEW**


SECTION A-A' Rain Garden Curb Inlet Scale: 1:10

2. Side slopes of rain garden shall be mulched 50 mm depth.

Boulevard Rain Garden Cross Section

Δ Δ Δ Δ

3. Finish grade of mulch to be 25 mm below sidewalk.

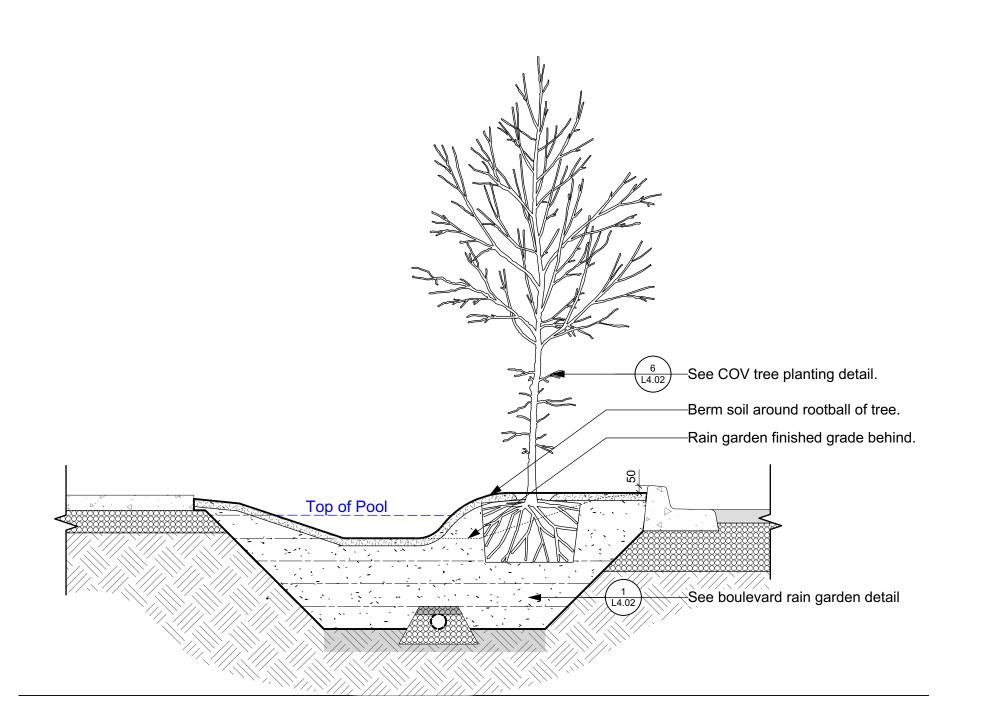

Tree Planting in Boulevard Rain Garden

LSCARIFY BOTTOM OF PIT

SUPPLEMENTARY STANDARD

DETAIL DRAWINGS

DO NOT PRUNE LEADER PRUNE ONLY DEAD OR

 $_{-}$ 2-2 1/2" (64mm) ROUND PRESSURE

LENGTH. STAKE AT EDGES OF THE

ROOTBALL IN LINE WITH ROADWAY.

ON EXPOSED SITES STAKE IN LINE

VERTICAL STAKES TO BE DRIVEN

TREES MUST BE PLANTED WITH NO MORE THAN A 50 mm DEPTH

450 mm x 4.0M LENGTH

For tree planting in boulevard rain garden, see $\frac{5}{(L4.02)}$

BROOM FINISH CONCRETE SIDEWALK

_ 700 mm COMPACTED STRUCTURAL SOIL TO THE APPROVAL OF THE GEOTECHNICAL ENGINEER

REVISIONS DRAWING NUMBER:

SD P4

GRASS BOULEVARD, shrub planting or rain garden, see plan for condition.

FROM FINISHED GRADE TO THE

WITH PREVAILING WIND.

600 mm INTO GROUND.

TOP OF THE ROOT BALL

TREATED STAKES @ 8' 0" (2440mm)

DAMAGED BRANCHES