



Contacts + Drawing List

Owner **Architectural** One Pointe Property Team c/o Mke Geric Construction 4520 West Saanich Road Saanich, BC V8Z 3G4 Niall Paltiel, niall@gericconstruction.com A0.4 Height & View Analysis **Architect** A0.09 Massing, Sun and Shade Study A0.10 Massing, Sun and Shade Study
A0.11 Sun and Shade Study D'Ambrosio architecture + urbanism 2960 Jutland Road Victoria, BC V8T 5K2 250.384.2400 x 103 Erica Sangster - esangster@daustudio.ca A1.0 Existing Site Survey A1.2 Average Grade Calculations A1.3 Level 1 Phasing Plan A1.4 P1 Phasing Plan A2.0 P2 Parking Plan A2.1 P1 Parking Plan Landscape Architect A2.3 Level 2 Plan A2.4 Level 3 Plan Murdoch de Greeff Inc. 200 - 524 Oulduthel Road Victoria, BC V8Z 1G1 250.412.2891 Soott Murdoch - soott@maldesign.ca A2.7 Penthouse + Roof Plan A3.0 North Elevation Civil Consultant A4.2 Building Section / Elevations WSP 301 - 3600 Uptown Blvd. Victoria, BC V8Z 0B9 250.389.8068 Jeff Sumerville - Jeff.Somerville@wsp.com


Lo.0 Cover
C1.0 Conceptual Site Demolition
C2.0 Conceptual Site Servicing Plant
C3.0 Conceptual Site Surface Works
C4.0 Conceptual Site Surface Works
C5.0 Conceptual Site Surface Works
C6.0 C

Revisions

Bubbled areas indicate revisions compared to the previously submitted plans

Received Date:

May 6, 2022

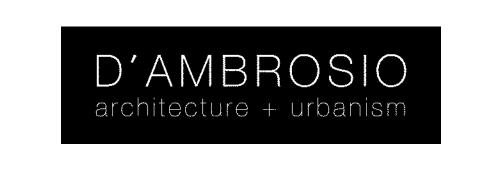

2960 Jutland Road Victoria BC Canada V8T5K2

el 250.384.2400 eml mail@daustudio.ca web www.daustudio.ca



#21-18

Montreal and Quebec

205 Quebec Street
Victoria, BC

Rezoning/Development Resubmission

(SET WITH REVISION BUBBLES) 22.04.14

Electrical Consultant

AES Engineering 500 - 3795 Carey Road, Victoria, BC V8Z 618 778-746-2003 Bal Klear - bal klear@æsengr.com

Transportation Consultant

Watt Consulting Group 302 - 740 Hillside Avenue Victoria, BC V8T 124 250.388.9877 x 423 Nadine King - nking@vattconsultinggroup.com

22.04.14




THIS DOOLMENT HAS BEEN ELECTRONICALLY CERTIFIED WITH DIGITAL CERTIFICATE AND ENCRYPTION TECHNOLOGY AUTHORIZED BY THE AIBC. THE AUTHORITATIVE ORIGINAL IS IN ELECTRONIC FORM ANY PRINTED VERSION CAN BE RELIED UPON AS A TRUE COPY OF THE ORIGINAL WHEN SUPPLIED BY DAMBROSIO architecture + urbanism, BEARING IMAGES OF THE PROPESSIONAL SEAL AND DIGITAL CERTIFICATE OR WHEN PRINTED FROM THE DIGITALLY CERTIFIED ELECTRONIC FILE.





Pendered Context View NTS




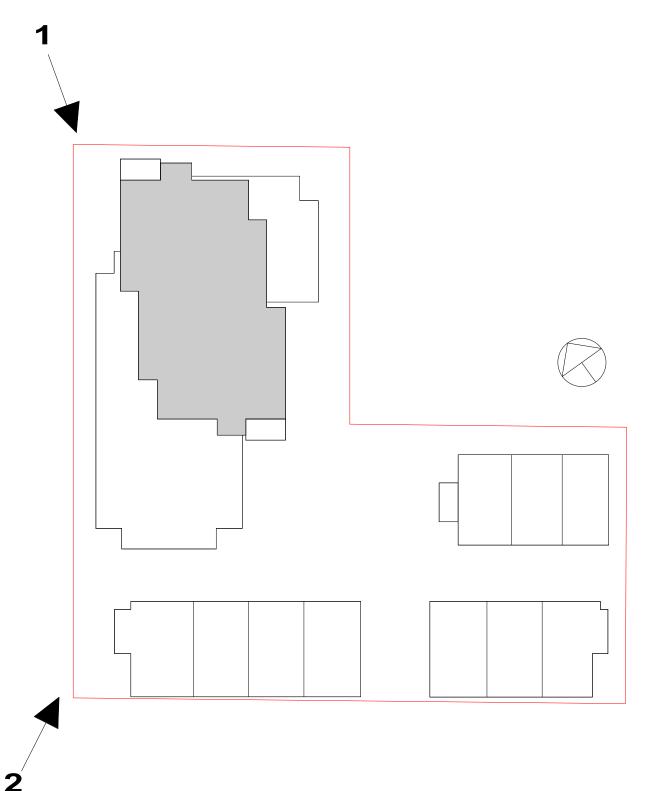

	Rezoning/DP Resubmission	
2	Issued for Rezoning / DP	21.12.15
1	Issued for Dev. Tracker	21.10.19
rev no	description	date
times rer	t reserved, these drawings and designs an main the property of d'ambrosio architectur the project shown and may not be reprodi onsent.	e to be
M c 205 (ot name Intreal and Que Quebec Street ria, BC	ebec
shee	t title ntext Views	

project no.	#21-18
scale	As indicated
drawn by	Œ
date issued	sheet no.
12/04/22	A0.1



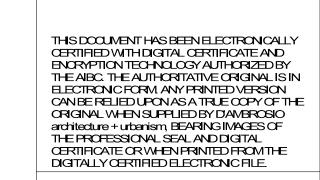




Rendered Context View


NTS




Mandalla de la constanta de la

Montreal Entry Render

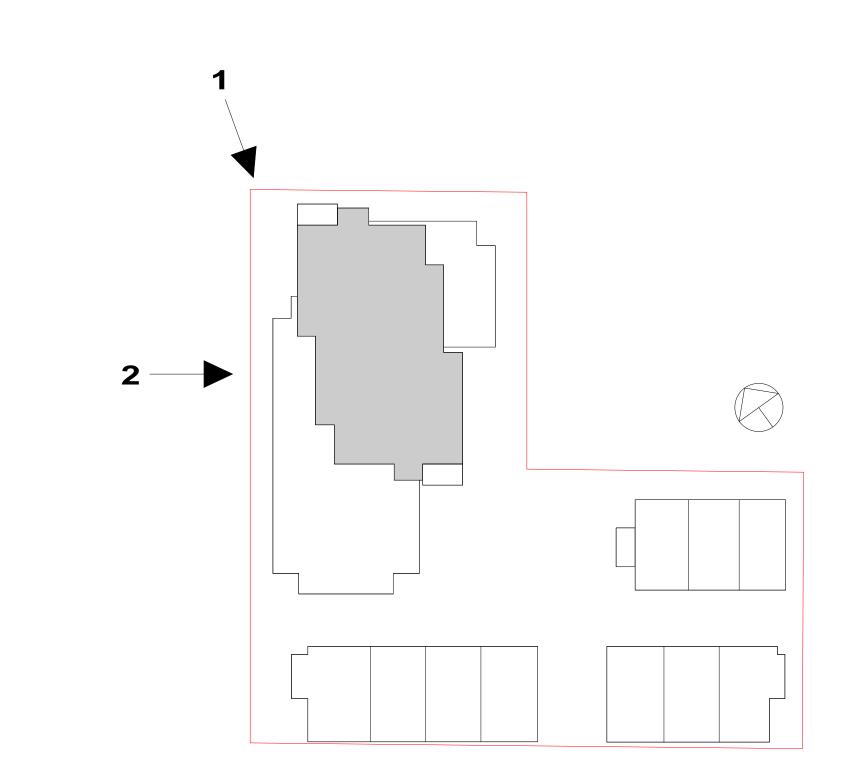

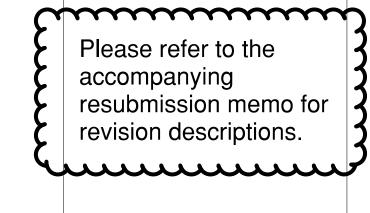

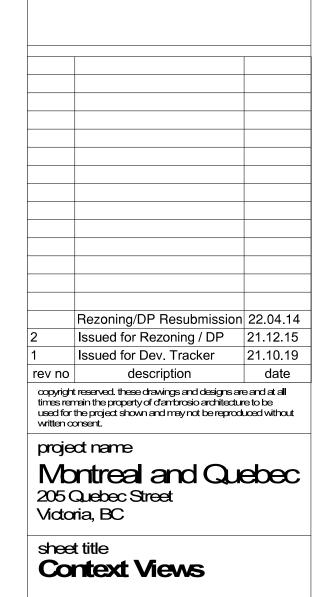

project no.

scale

drawn by

date issued

12/04/22


#21-18

Œ

As indicated

A0.2

sheet no.

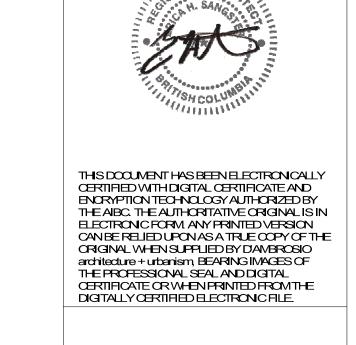






Commender of the commendation of the commendati

1 Rendered Context View

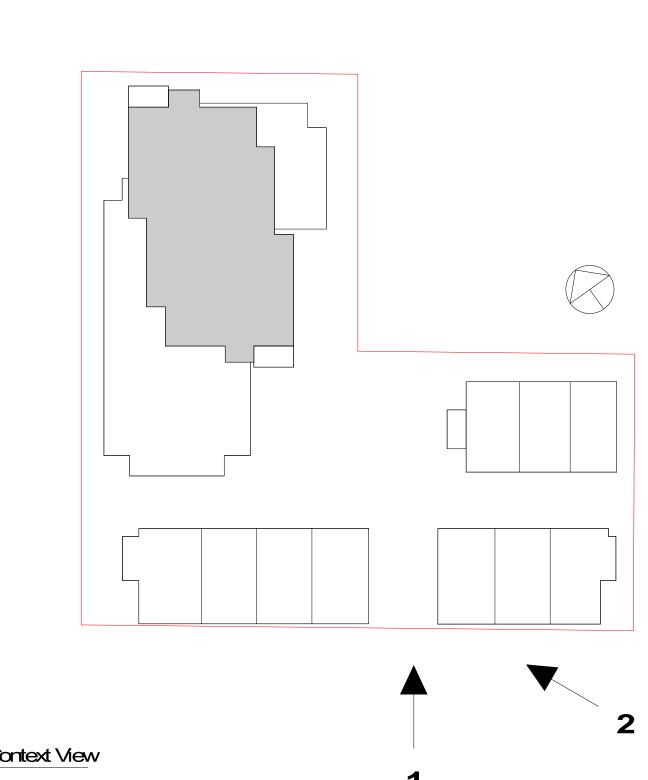

drawn by date issued 12/04/22

sheet title
Context Views

Comment of the state of the sta

resubmission memo for

mmmmy

Rezoning/DP Resubmission 22.04.14 rev no description date

copyright reserved, these drawings and designs are and at all times remain the property of d'ambrosio architecture to be used for the project shown and may not be reproduced without written consent.

Montreal and Quebec 205 Quebec Street Victoria, BC


project name


revision descriptions.

Please refer to the

accompanying

Policy Context

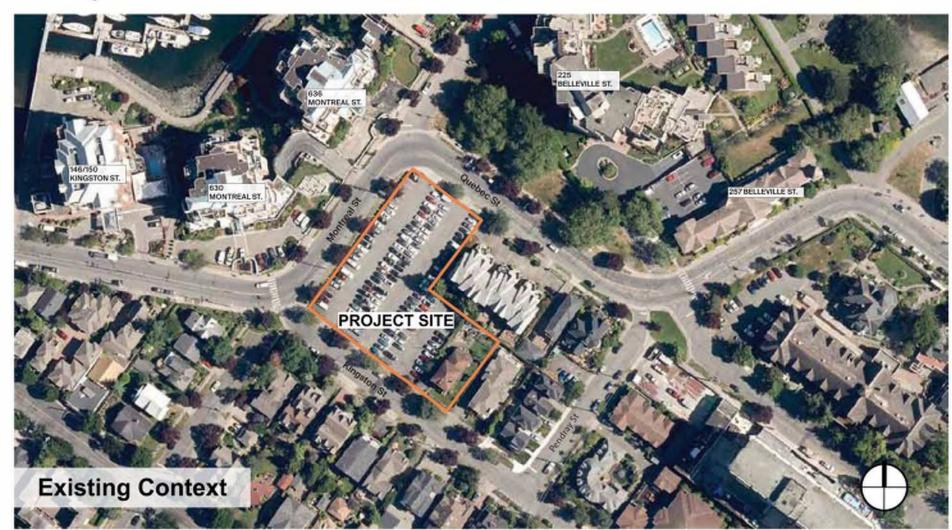

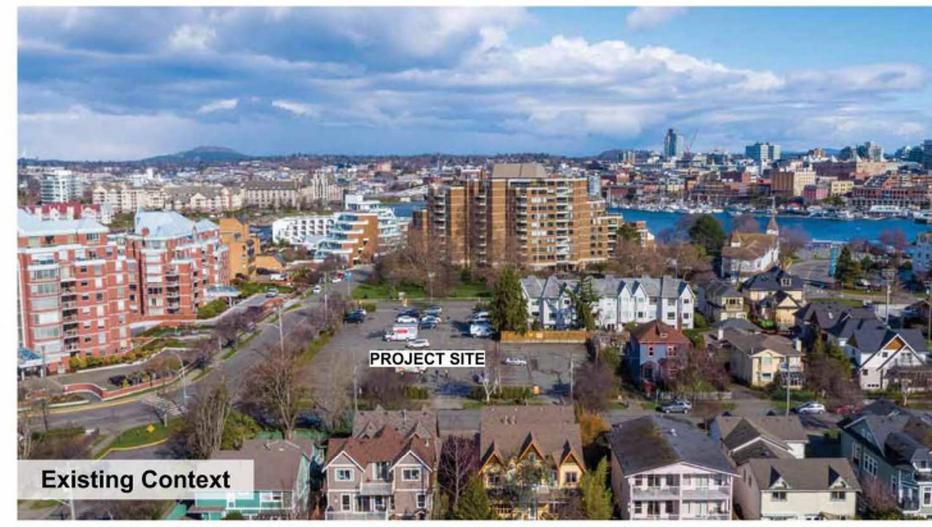










Height Analysis









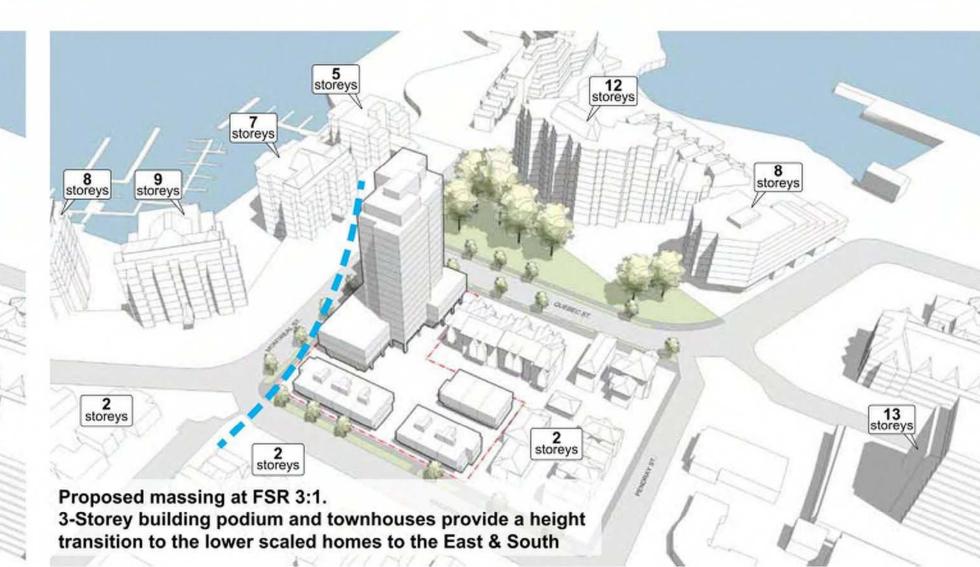



View Impact Analysis




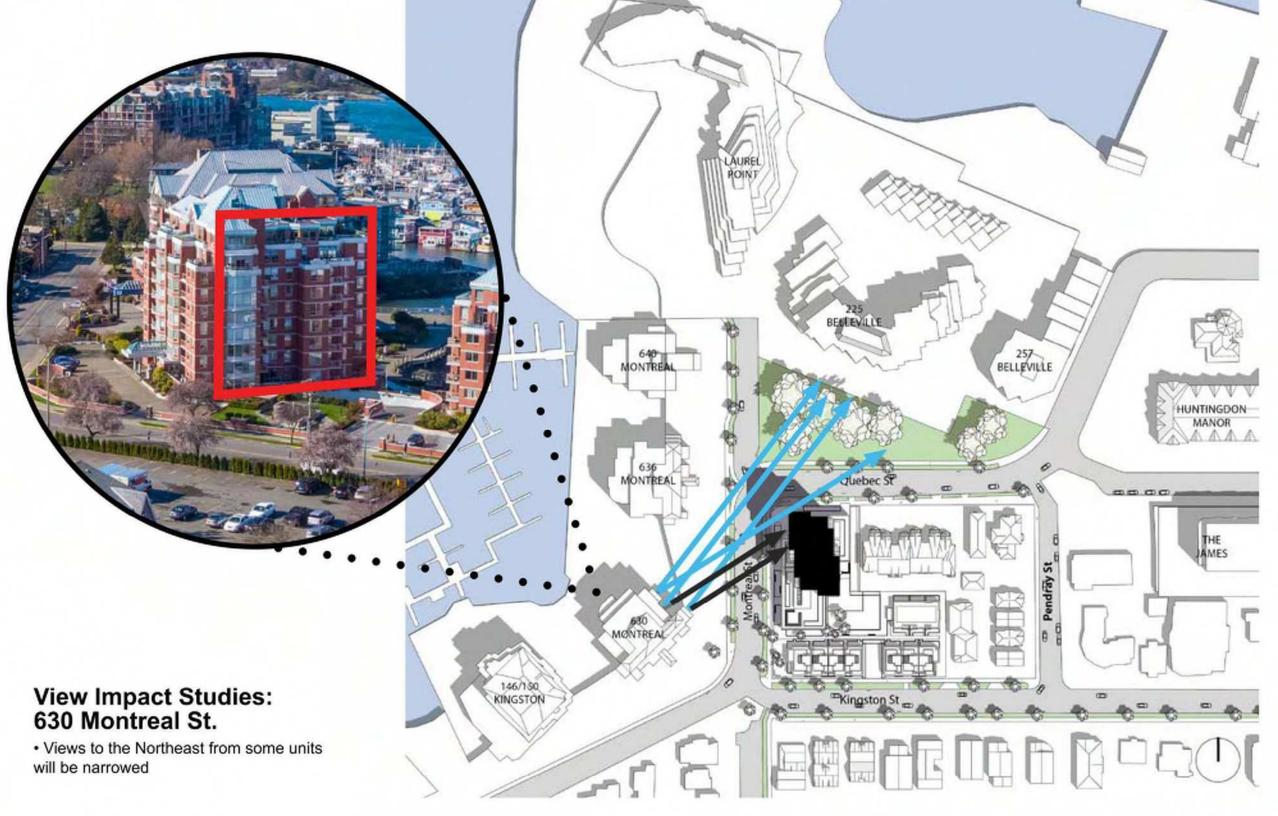

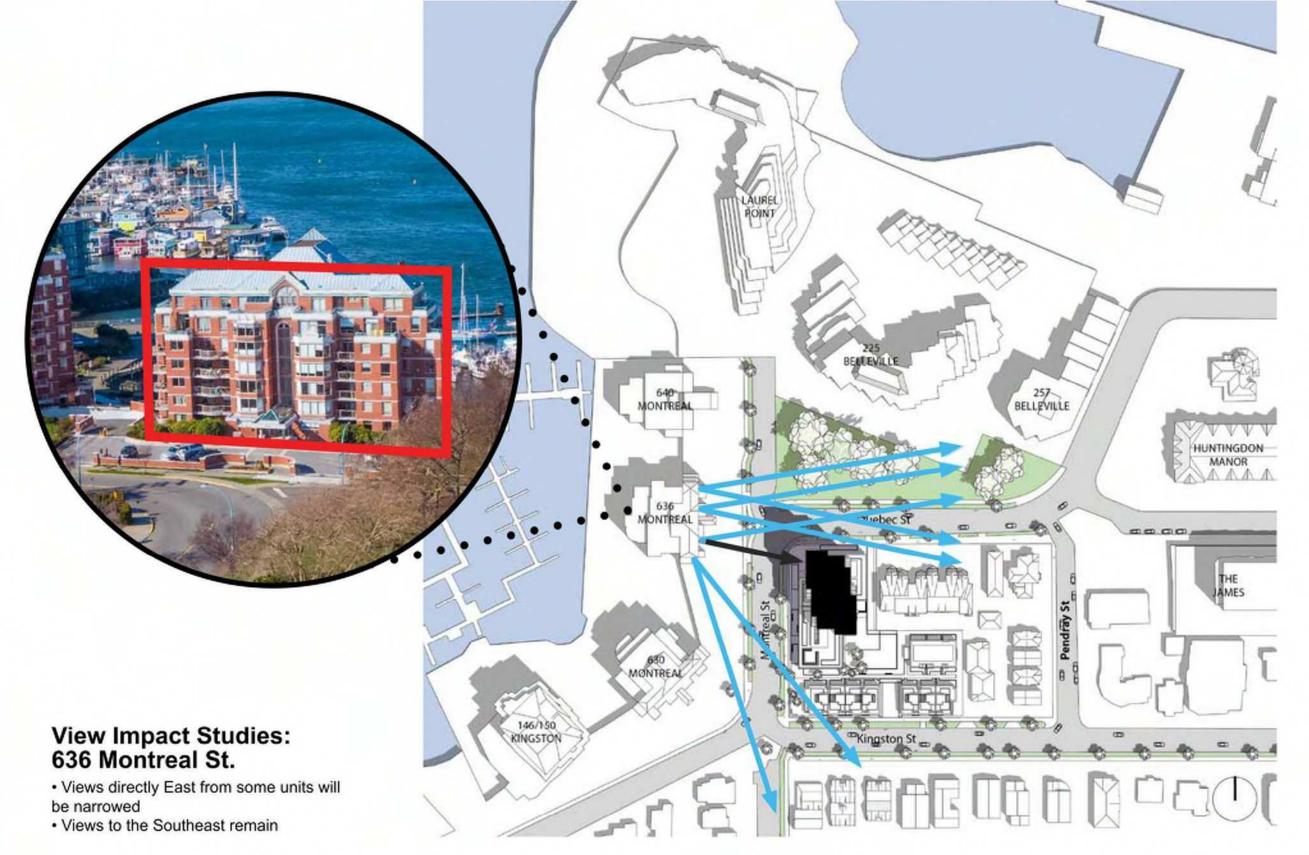

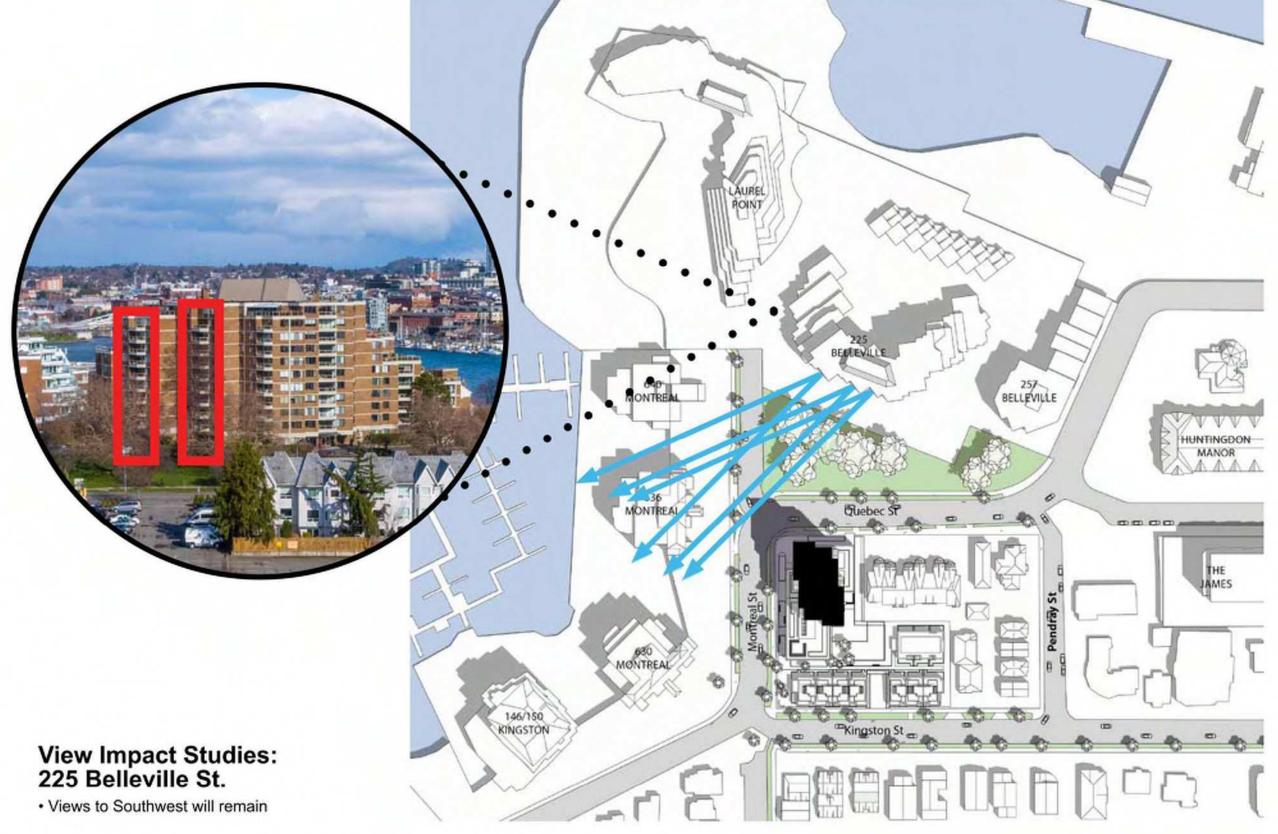

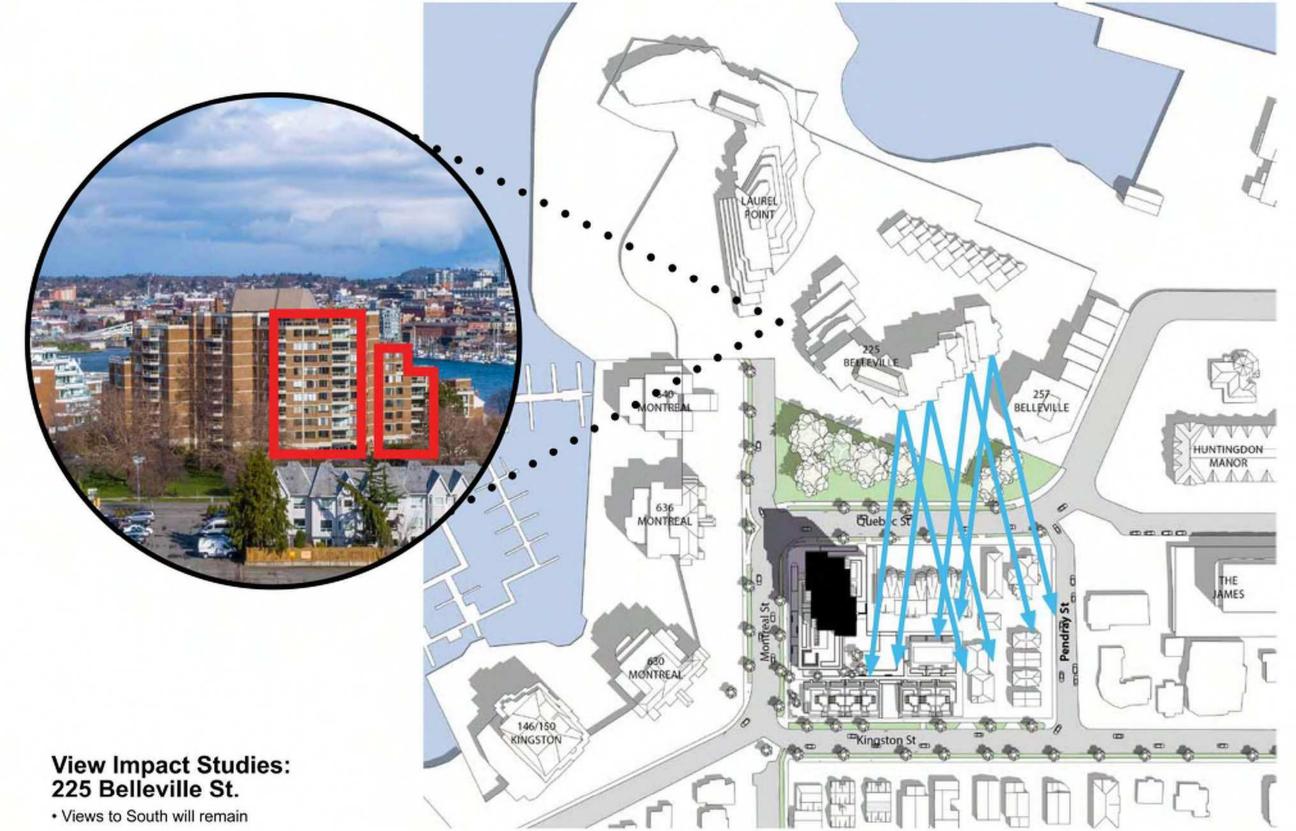

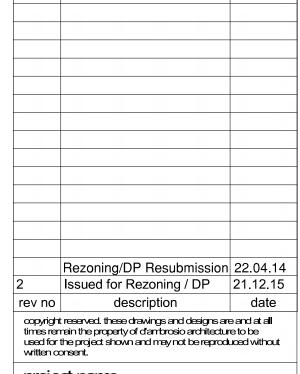

project name

Montreal and Quebec

205 Quebec Street

Victoria, BC

sheet title
Height & View Analysis

project no.	#21-18	20
scale	NTS	E:14:30 DM
drawn by	DZ	7.7
date issued	sheet no.	1 1 2
12/04/22	A0.4	70 00







Section C - Montreal St. 1:300


225 BELLEVILLE ST.

QUEBEC ST.

630 MONTREAL ST.

Section B - Kingston St. 1:300 146/150 KINGSTON ST.



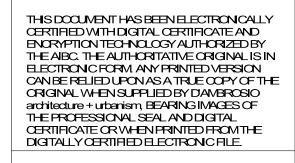



Rezoning/DP Resubmission 22.04.14

2 Issued for Rezoning / DP 21.12.15

1 Issued for Dev. Tracker 21.10.19

rev no description date

copyright reserved, these drawings and designs are and at all times remain the property of dambrosio architecture to be used for the project shown and may not be reproduced without written consent.

project name


Nontreal and Quebec

205 Quebec Street

Victoria, BC

sheet title
Context Elevations


project no. #21-18
scale 1:300
drawn by CF
date issued sheet no.

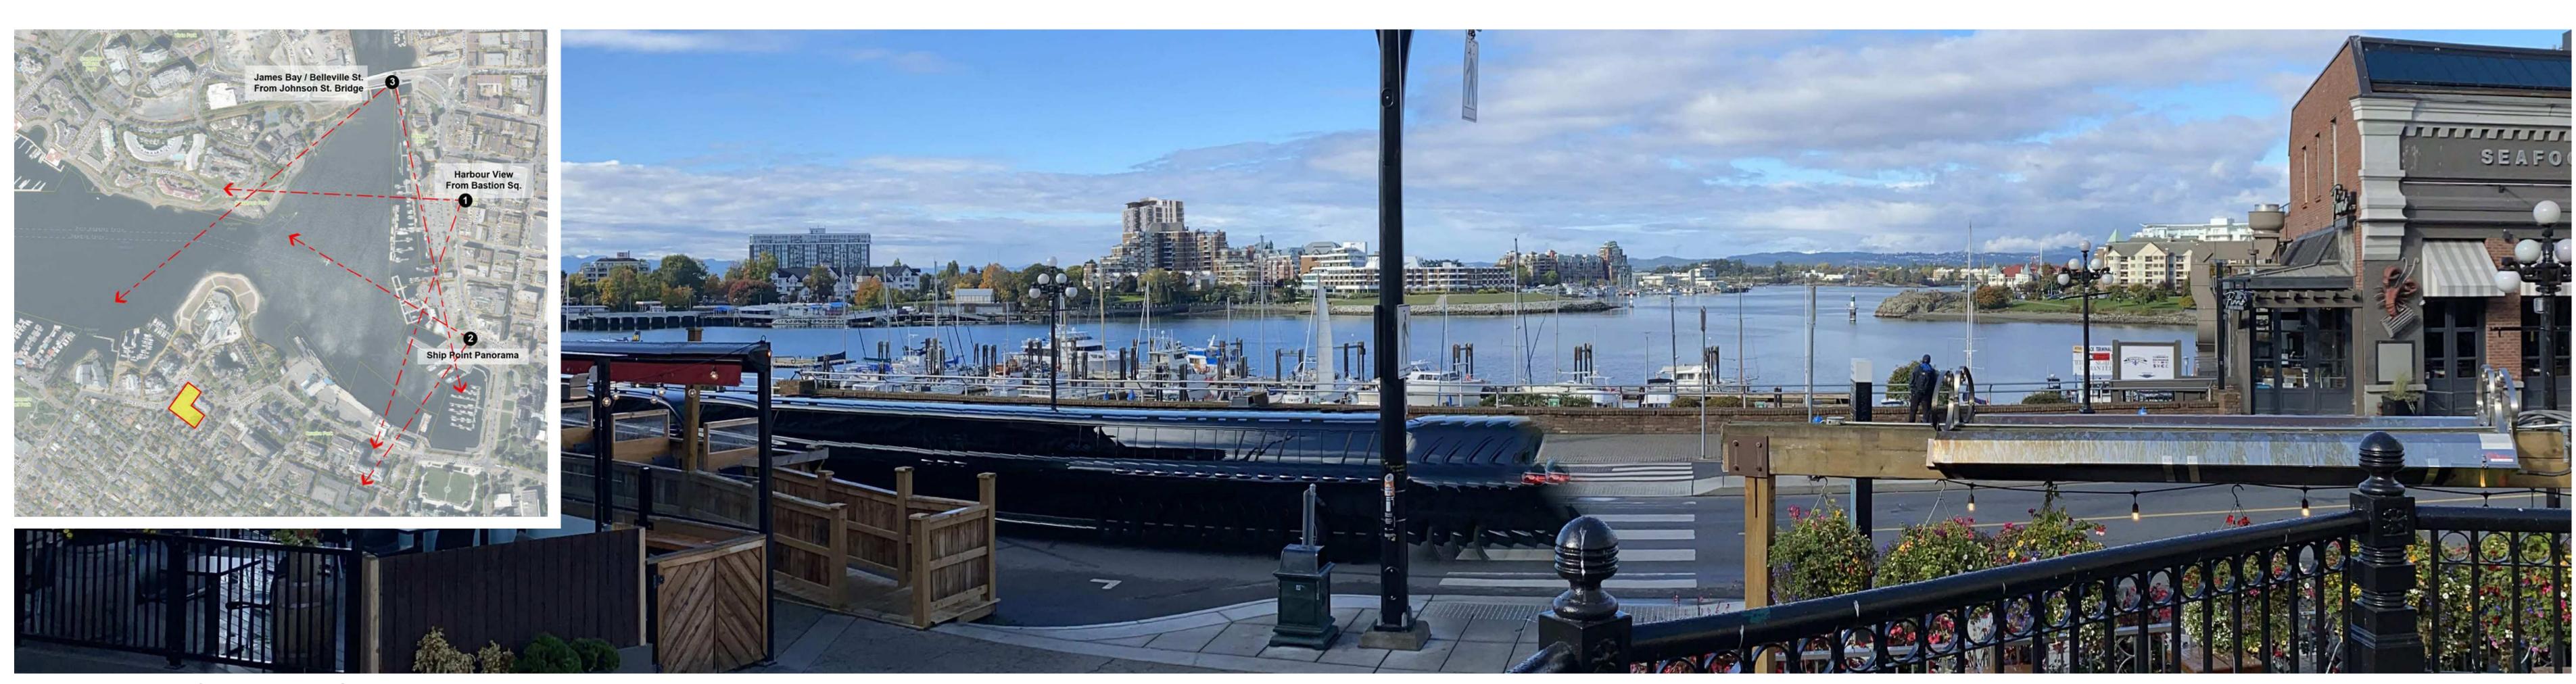

1. Harbour View from Bastion Square



2. Ship Point Panoroma

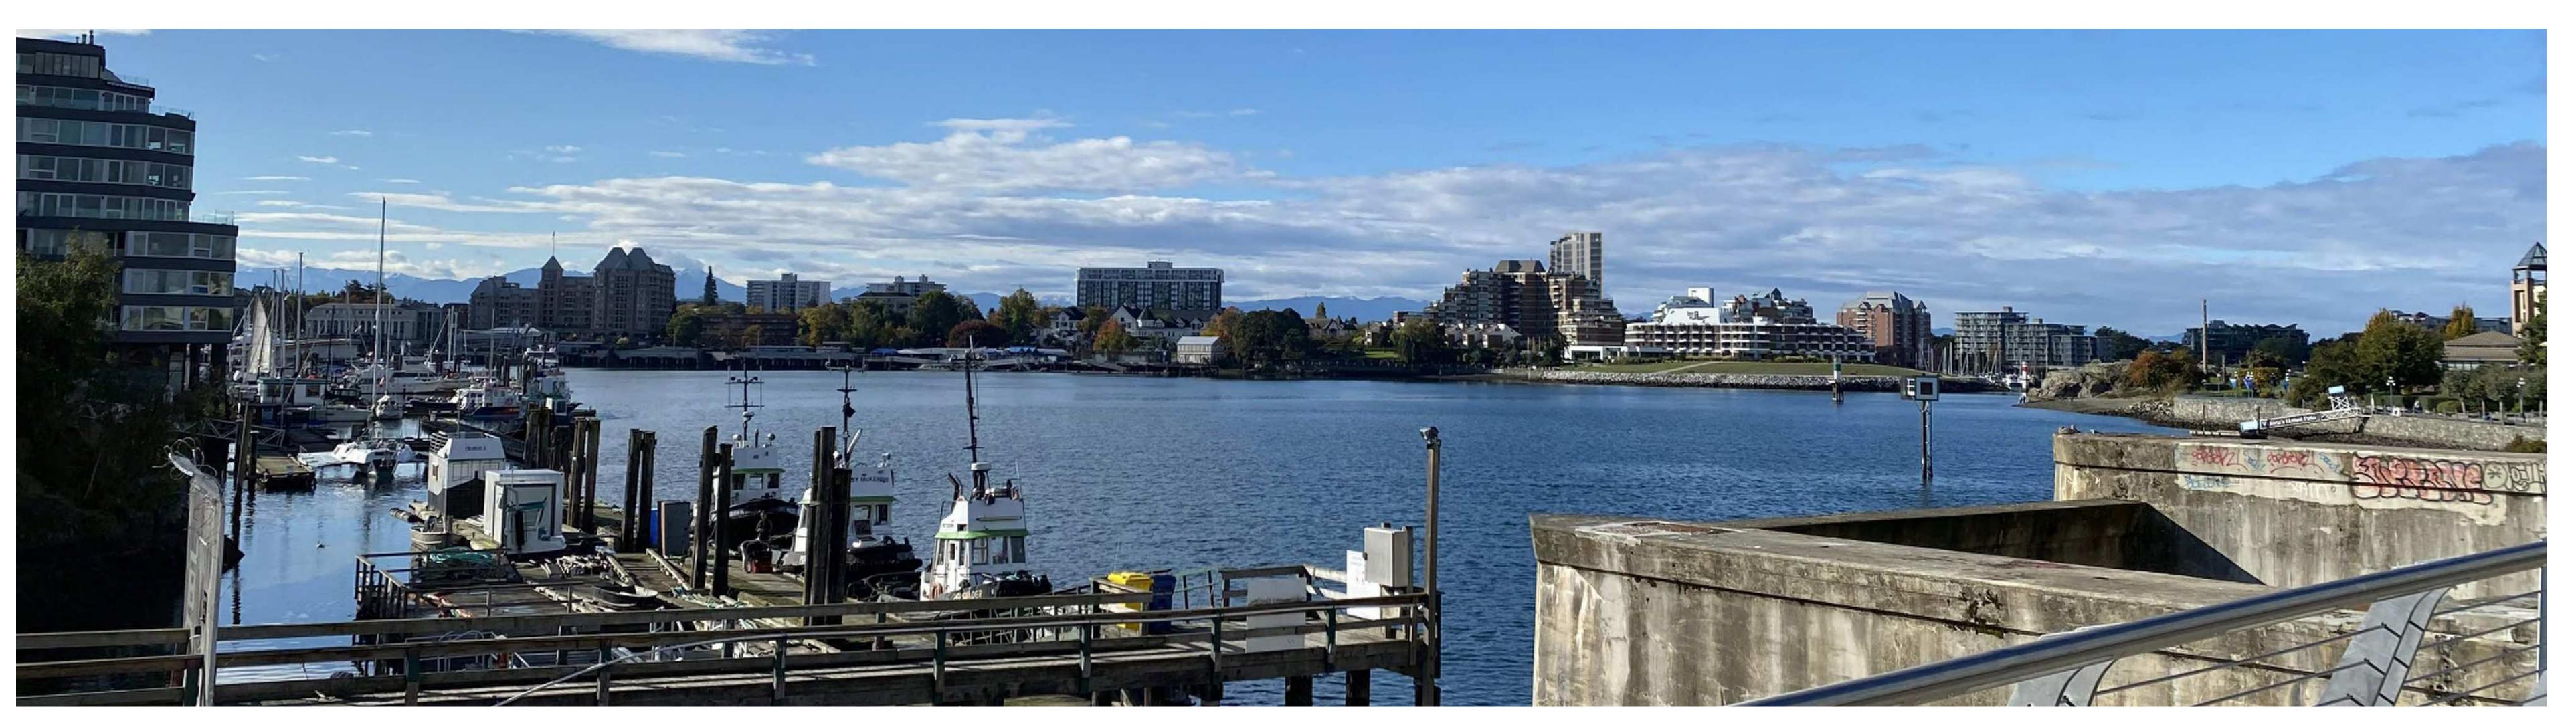

3. James Bay / Belleville Street from Johnson Street Bridge



THIS DOCUMENT HAS BEEN ELECTRONICALLY CERTIFIED WITH DIGITAL CERTIFICATE AND ENCRYPTION TECHNOLOGY AUTHORIZED BY THE AIBC. THE AUTHORITATIVE ORIGINAL IS IN ELECTRONIC FORM ANY PRINTED VERSION CAN BE RELIED UPON AS A TRUE COPY OF THE ORIGINAL WHEN SUPPLIED BY DAMBROSIO architecture + urbanism, BEARING IMAGES OF THE PROFESSIONAL SEAL AND DIGITAL CERTIFICATE OR WHEN PRINTED FROM THE DIGITALLY OERTIFIED ELECTRONIC FILE.

Rezoning/DP Resubmission 22.0
2 Issued for Rezoning / DP 21.1
rev no description d

Rezoning/DP Resubmission 22.04.14

2 Issued for Rezoning / DP 21.12.15

rev no description date

copyright reserved, these drawings and designs are and at all times remain the property of drambrosio architecture to be used for the project shown and may not be reproduced without written consent.

project name

Montreal and Quebec 205 Quebec Street

Victoria, BC

sheet title Skyline Analysis

12/04/22

project no. #21-18
scale NTS
drawn by CF

A0.6


THIS DOCUMENT HAS BEEN ELECTRONICALLY CERTIFIED WITH DIGITAL CERTIFICATE AND ENCRYPTION TECHNOLOGY AUTHORIZED BY THE AIBC. THE AUTHORITATIVE ORIGINALIS IN ELECTRONIC FORM ANY PRINTED VERSION
CAN BE RELIED UPON AS A TRUE COPY OF THE
ORIGINAL WHEN SUPPLIED BY DAMBROSIO
and iterative + urbanism, SEALAND DIGITAL THE PROFESSIONAL SEAL AND DIGITAL CERTIFICATE OR WHEN PRINTED FROM THE DIGITALLY CERTIFIED ELECTRONIC FILE.




Legend

Shadows from Proposed Building

Shadows from Existing Buildings

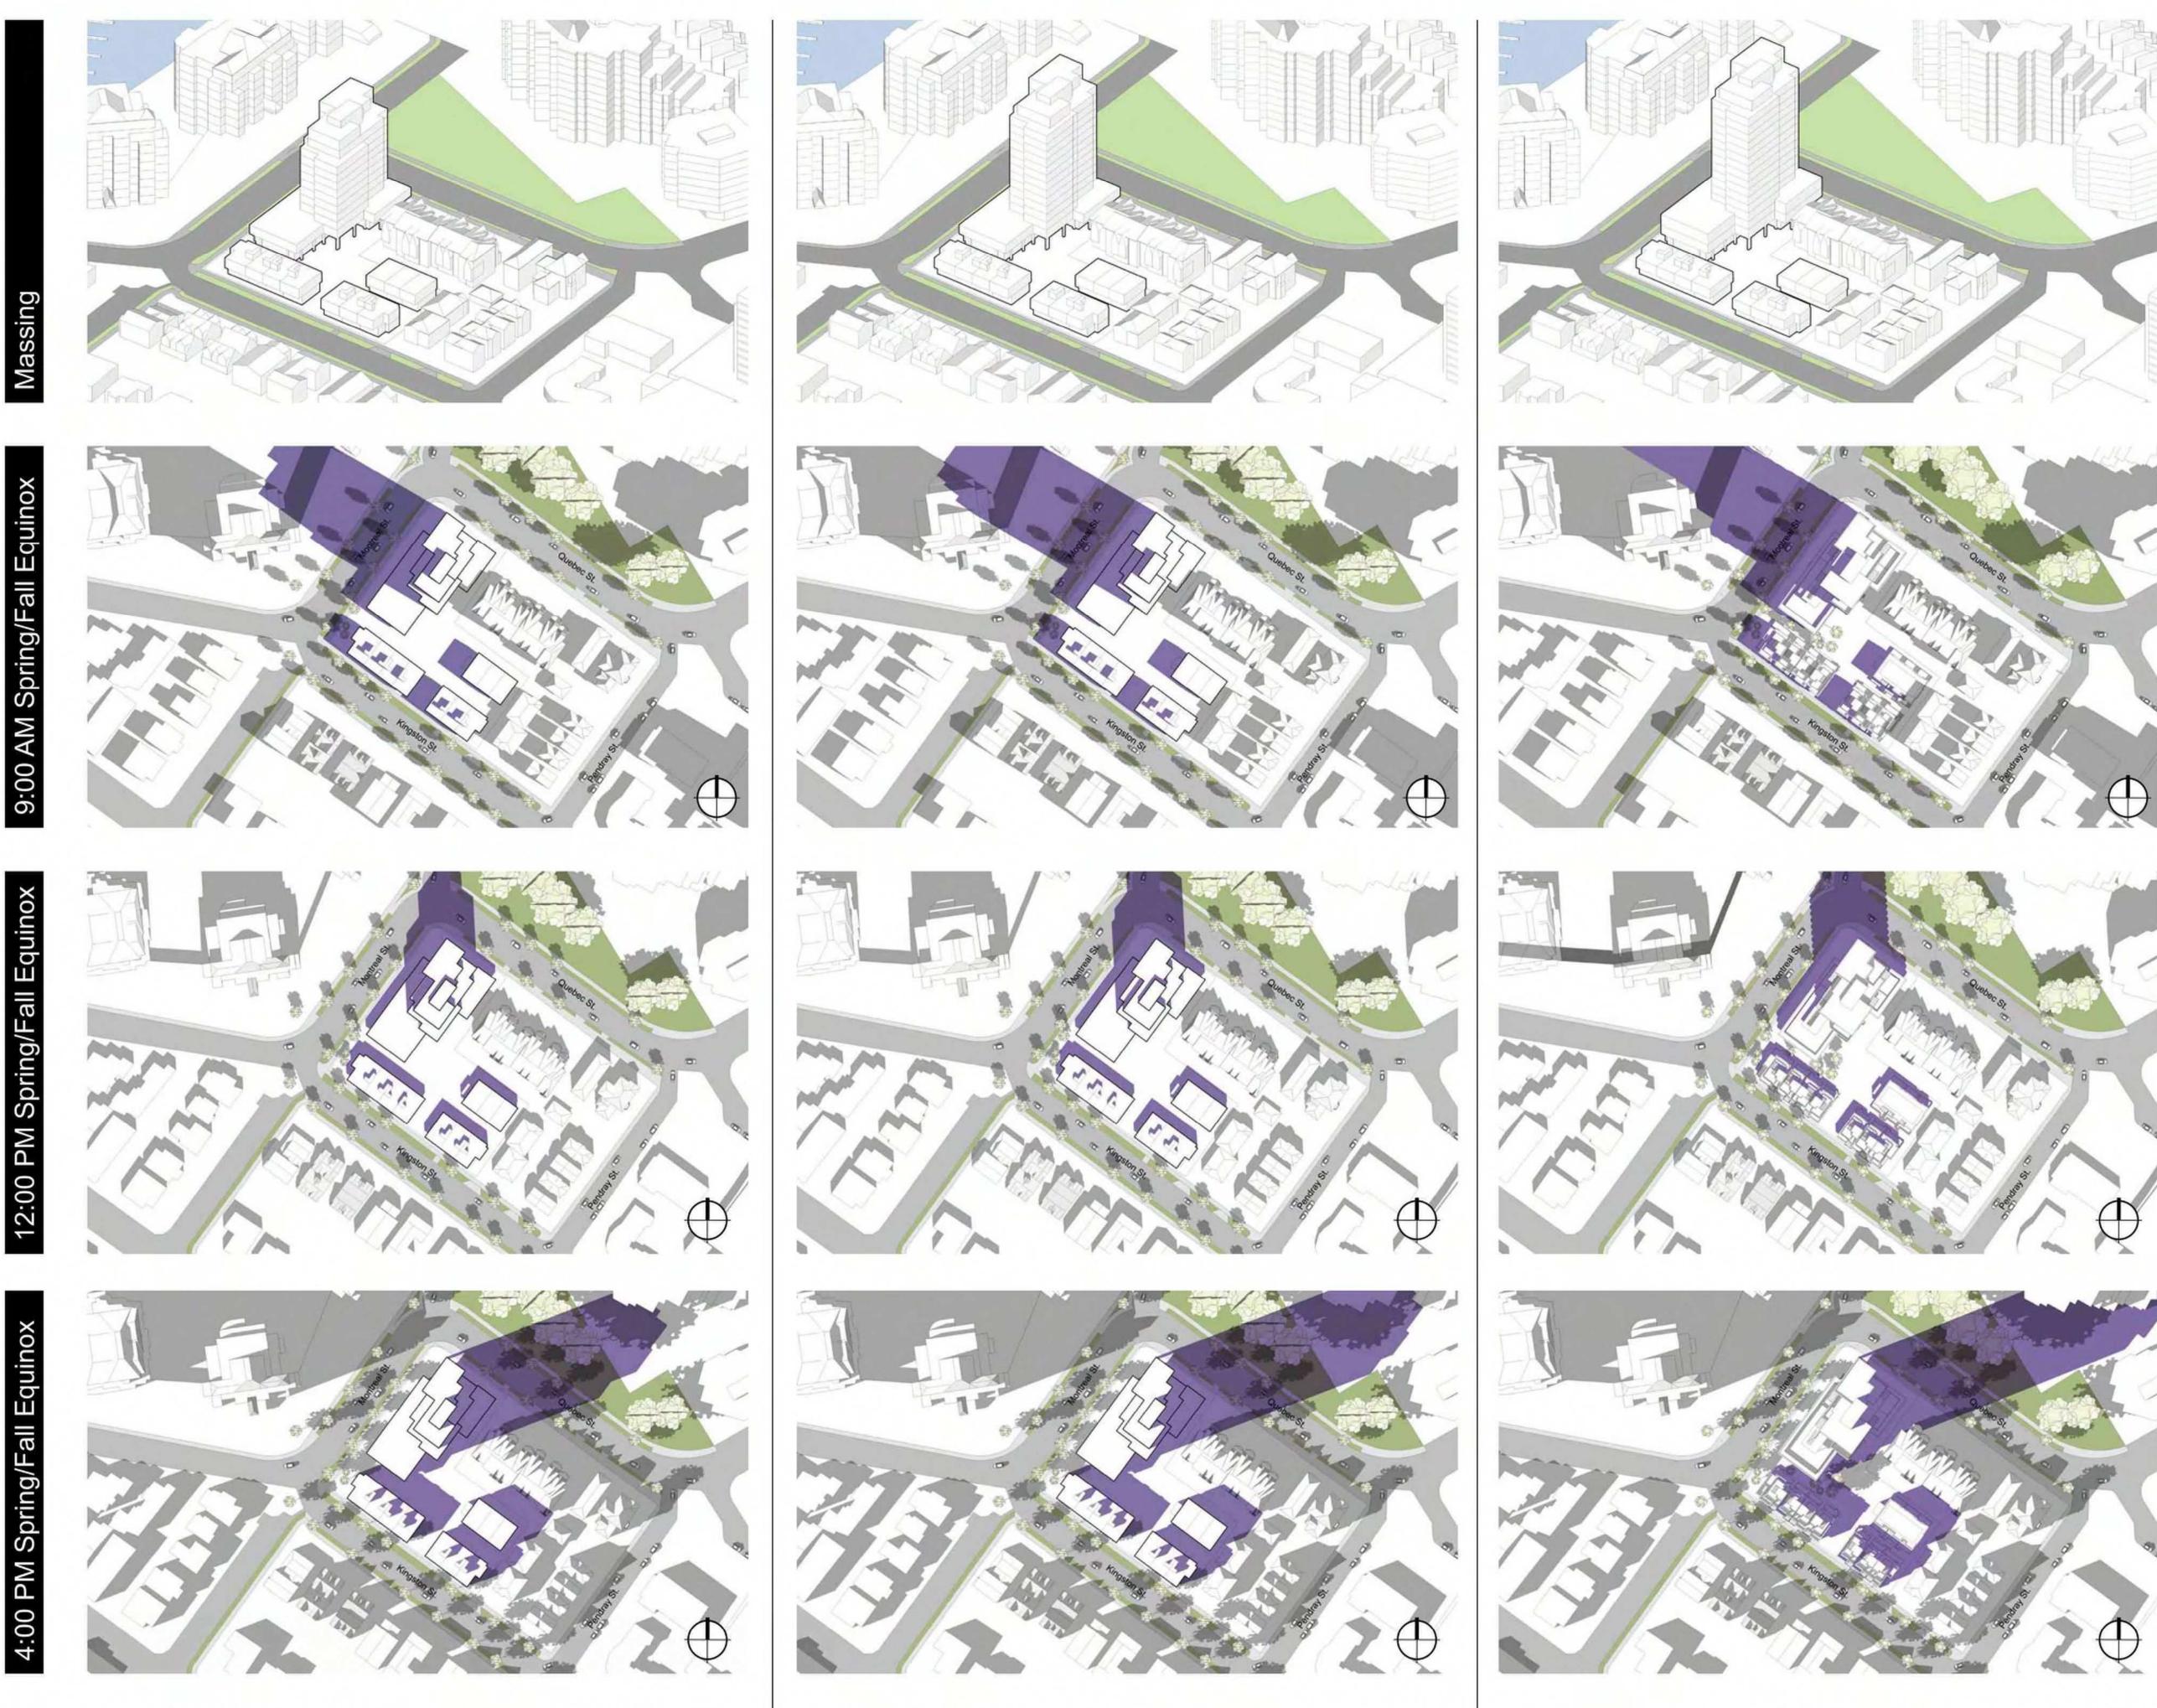

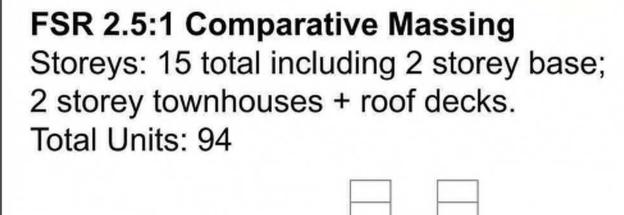


FSR 2:1 Comparative Massing

2 storey townhouses + roof decks.

Total Units: 76

Storeys: 12 total including 2 storey base;

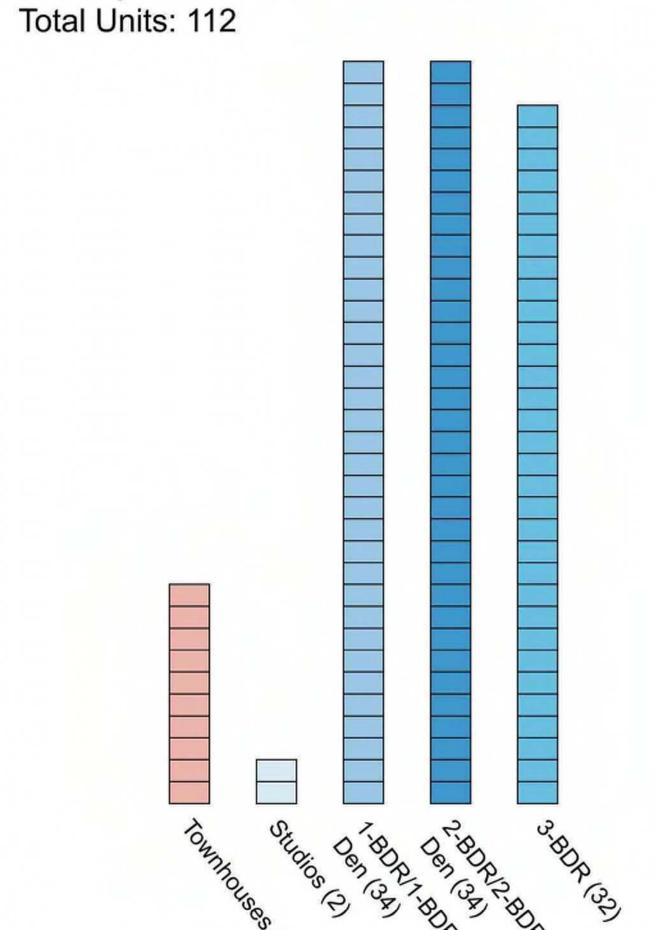



FSR 3:1 Proposed Massing Storeys: 17 total including 3 storey base; 2 storey townhouses + roof decks



Comment of the state of the sta Please refer to the accompanying resubmission memo for revision descriptions.

minimum s

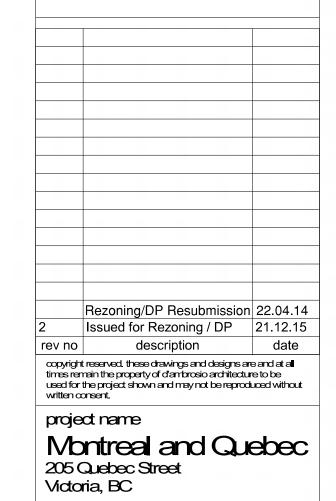

sheet title Massing, Sun and Shade Study

drawn by date issued 12/04/22




D'AMBROSIO architecture + urbanism



THIS DOCUMENT HAS BEEN ELECTRONICALLY CERTIFIED WITH DIGITAL CERTIFICATE AND ENCRYPTION TECHNOLOGY AUTHORIZED BY THE AIBC. THE AUTHORITATIVE ORIGINAL IS IN ELECTRONIC FORM ANY PRINTED VERSION CAN BE RELIED UPON AS A TRUE COPY OF THE ORIGINAL WHEN SUPPLIED BY DAMBROSIO architecture + urbanism, BEARING IMAGES OF THE PROFESSIONAL SEAL AND DIGITAL CERTIFICATE OR WHEN PRINTED FROM THE DIGITALLY CERTIFIED ELECTRONIC FILE

Please refer to the accompanying resubmission memo for revision descriptions.

Rezoning/DP Resubmission 22.04.14

rev no description date

copyright reserved, these drawings and designs are and at all times remain the property of dambrosio architecture to be used for the project shown and may not be reproduced without written consent.

project name

Montreal and Quebec
205 Quebec Street
Victoria, BC

sheet title
Massing, Sun and
Shade Study


project no. #21scale

scale

drawn by

DZ

date issued sheet no.

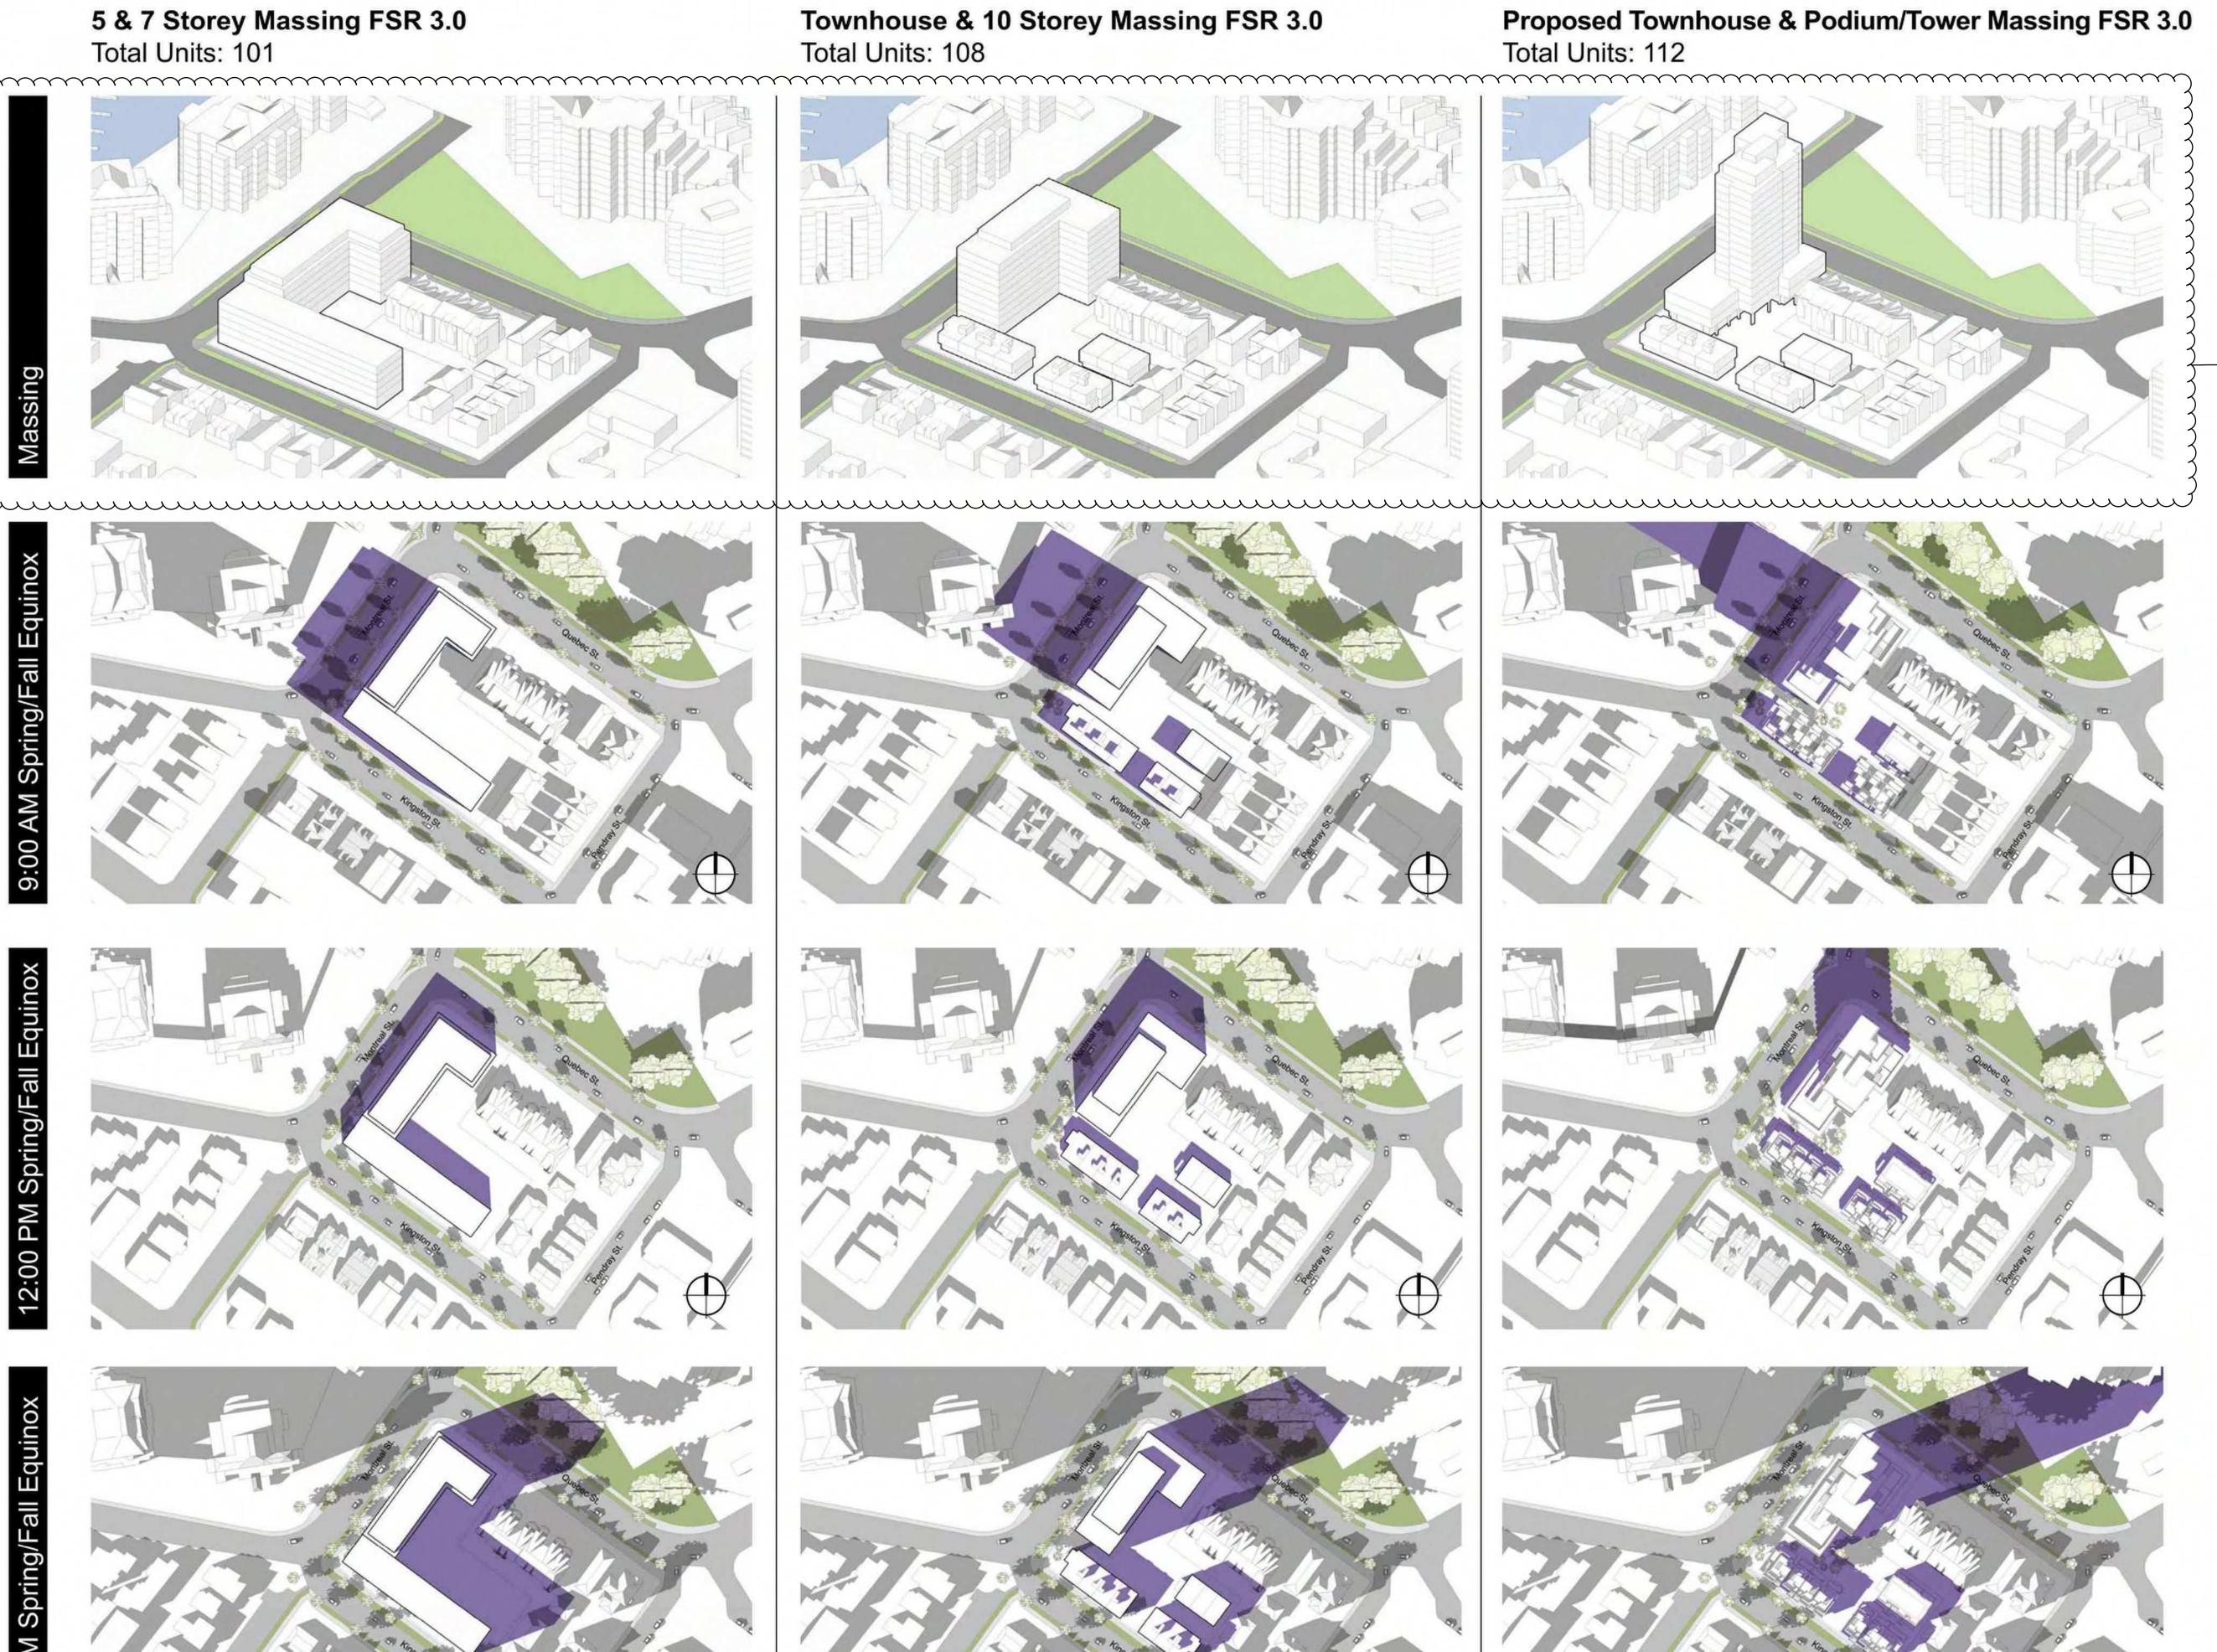


SPRING/FALL EQUINOX

Legend

Shadows from Proposed Building


Shadows from Existing Buildings

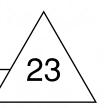



mmmmm. Please refer to the resubmission memo for revision descriptions.

munimer of the second

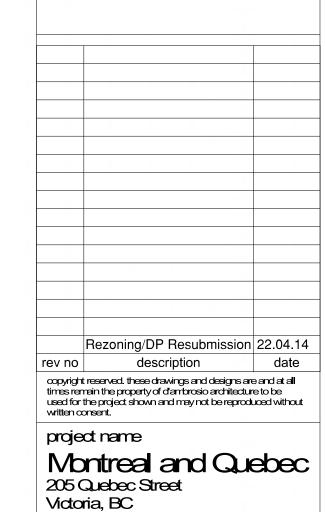

sheet title
Massing, Sun and
Shade Study


project no.	#21-18
scale	
drawn by	DZ
date issued	sheet no.
04/08/22	A0.09


COMPARATIVE MASSING ANALYSIS SUMMER SOLSTICE

Legend

Shadows from Proposed Building

Shadows from Existing Buildings

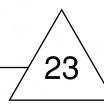

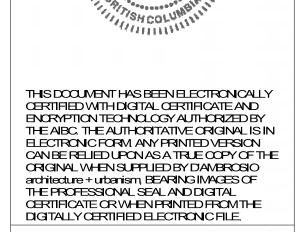

D'AMBROSIO

Please refer to the accompanying resubmission memo for revision descriptions.

mmmmmy


66		
11		
ii ii		
12		
H		
i.i.		
10		
11	Rezoning/DP Resubmission	22.04.1
rev no	description	date
times re	it reserved. these drawings and designs are main the property of d'ambrosio architecture the project shown and may not be reprodu onsent.	e to be
proje	ect name	
M	ontreal and Que	ebec
	Quebec Street	
	oria, BC	

sheet title
Massing, Sun and
Shade Study

project no. #21-18
scale
drawn by
DZ
date issued sheet no.





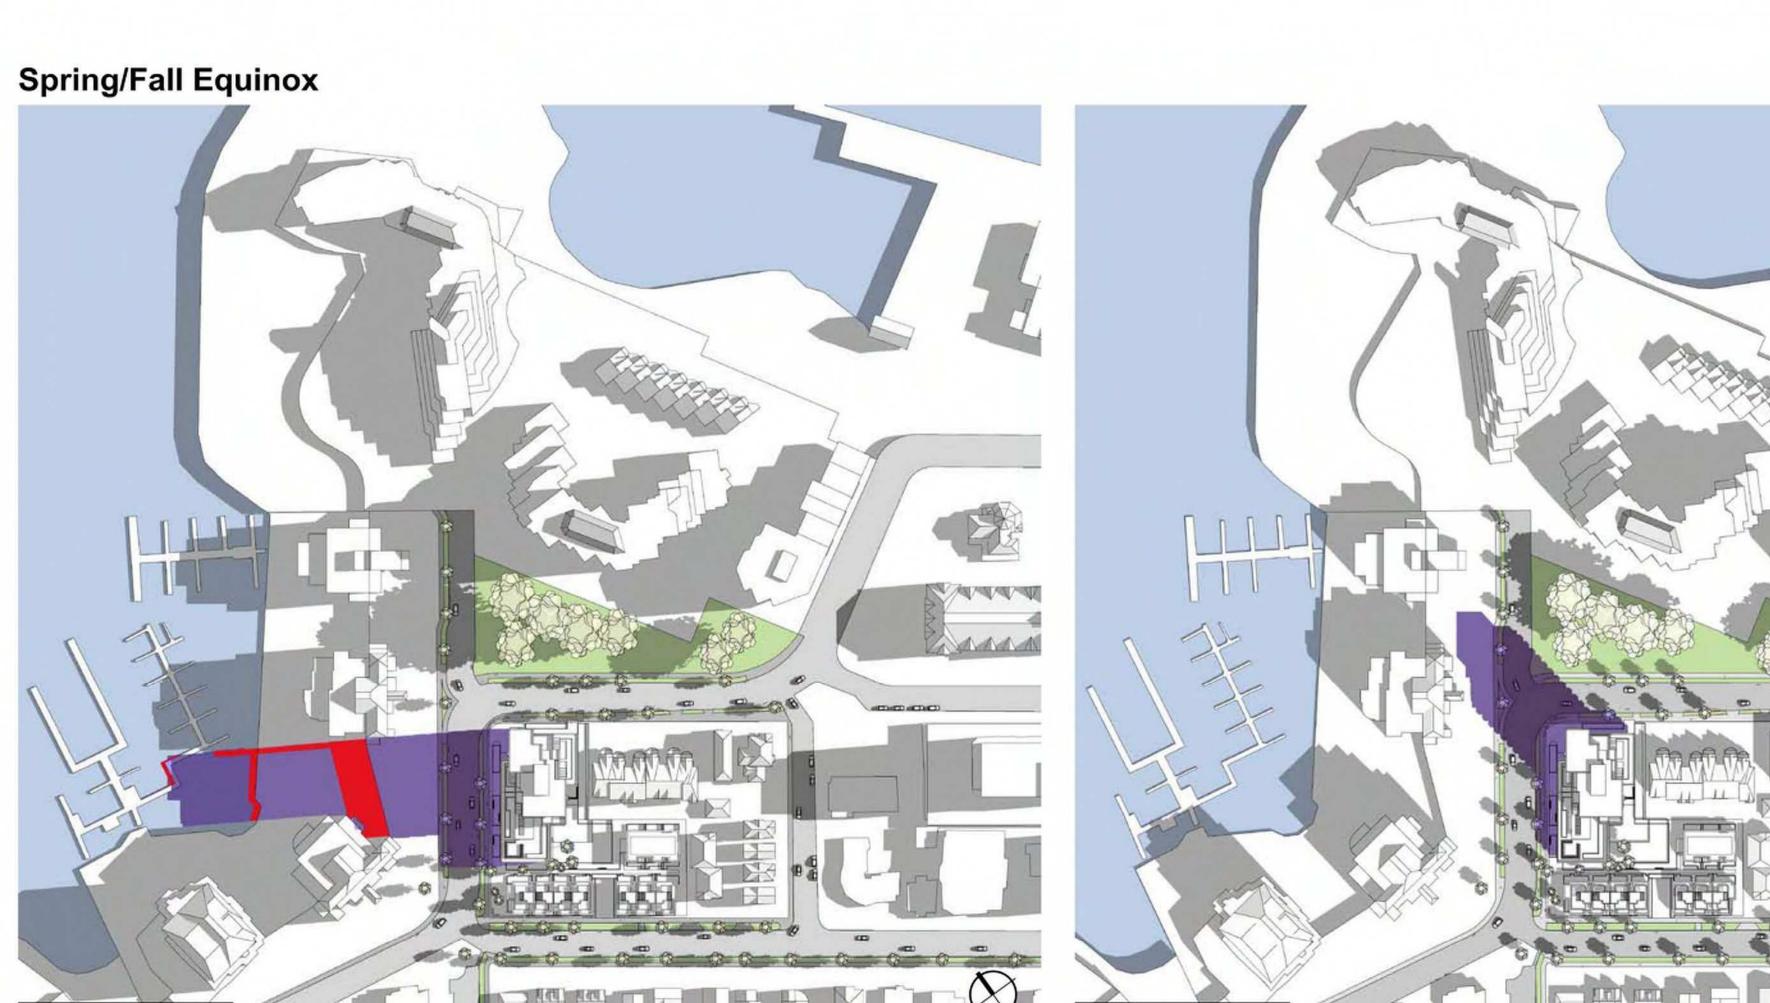




Summer Solstice






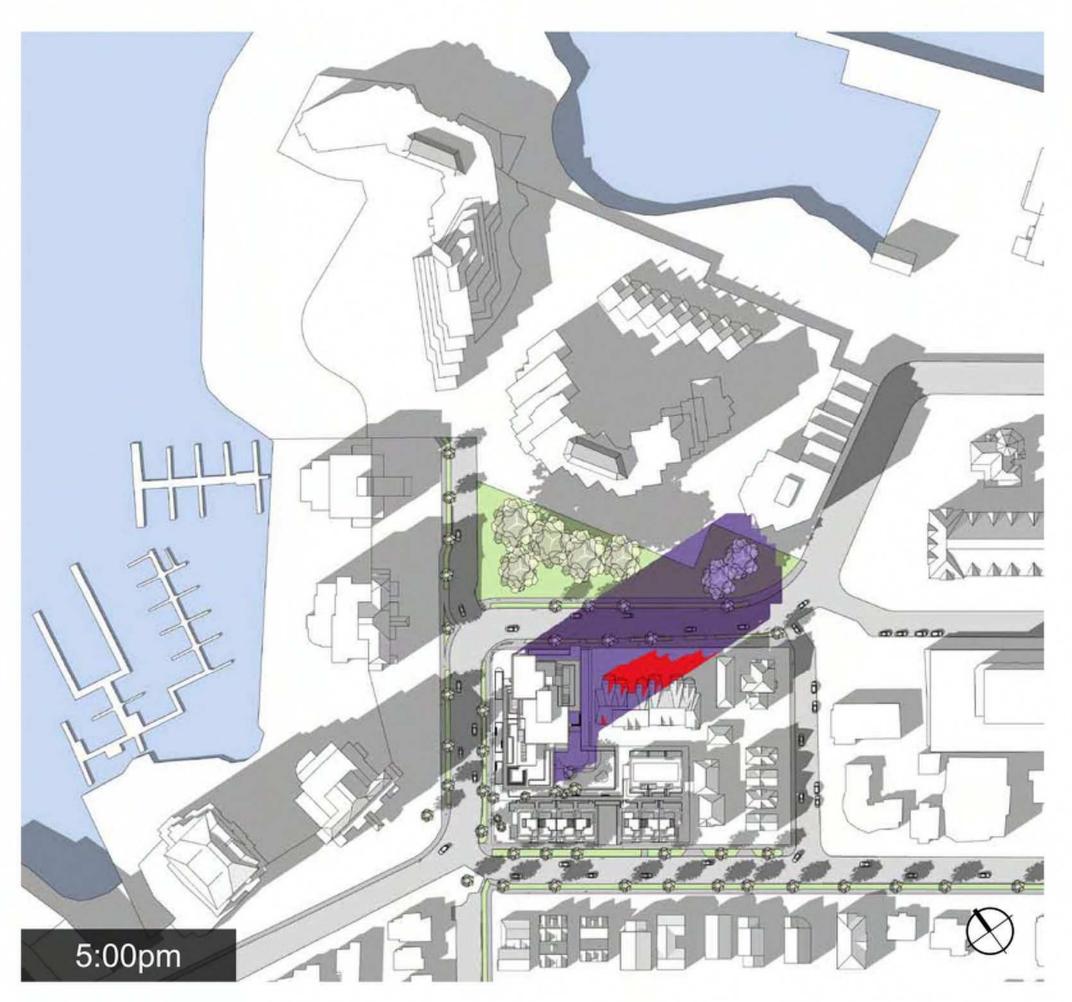


Winter Solstice





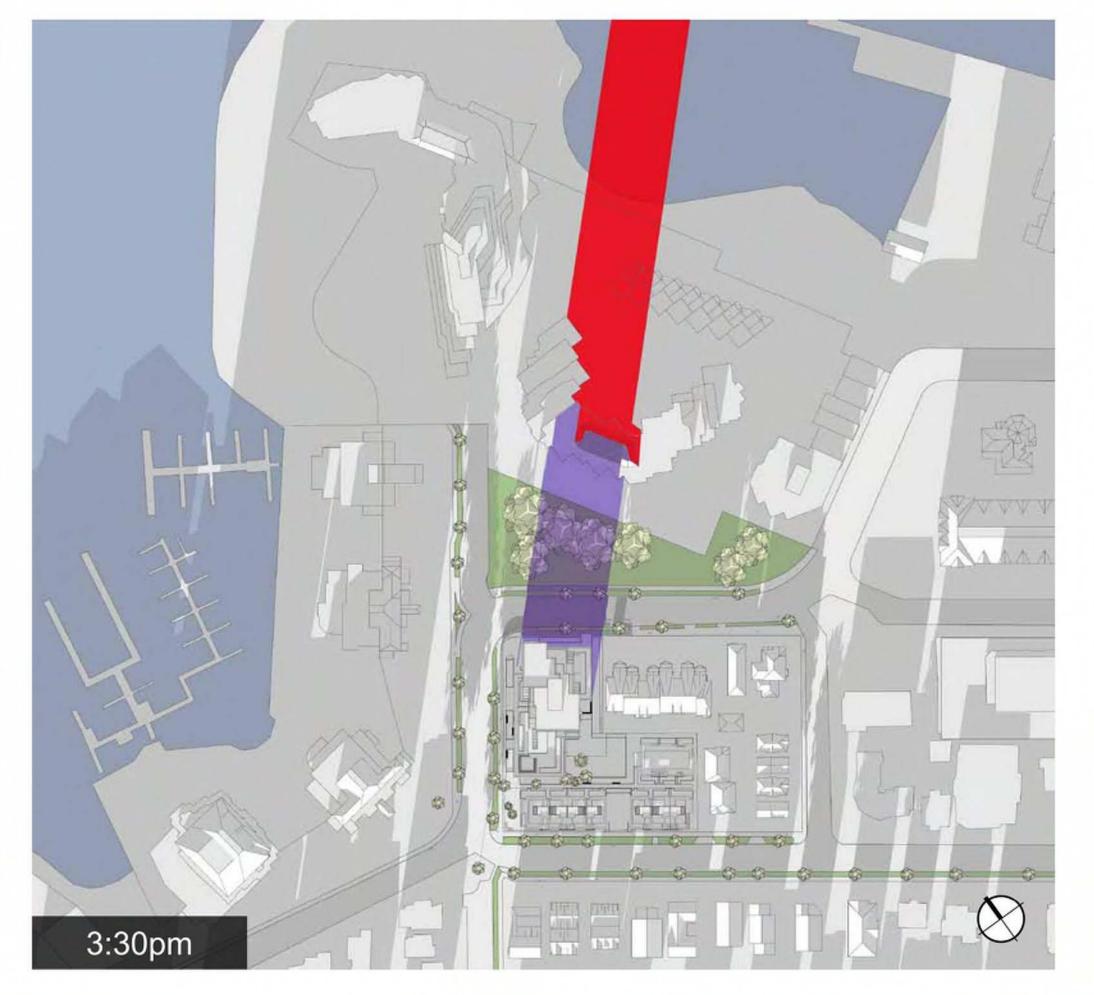

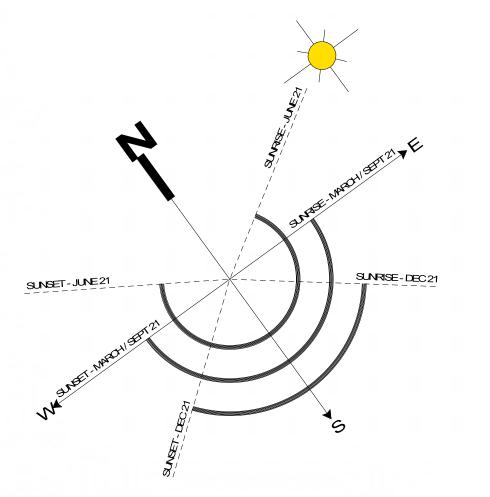

Legend

Shadows from Proposed Building

Shadow overlay of Proposed & Existing Buildings

Shadows from Existing Buildings

project no.	#21-18
scale	
drawn by	DZ, GK
date issued	sheet no.
12/04/22	A0.11

Rezoning/DP Resubmission 22.04.14

2 Issued for Rezoning / DP 21.12.15

rev no description date

copyright reserved, these drawings and designs are and at all times remain the property of dambrosio architecture to be used for the project shown and may not be reproduced without written consent.

project name

Montreal and Quebec

205 Quebec Street


Victoria, BC

sheet title
Sun and Shade Study



THIS DOCUMENT HAS BEEN ELECTRONICALLY CERTIFIED WITH DIGITAL CERTIFICATE AND ENCRYPTION TECHNOLOGY AUTHORIZED BY THE AIBC. THE AUTHORITATIVE ORIGINAL IS IN ELECTRONIC FORM ANY PRINTED VERSION CAN BE RELIED UPON AS A TRUE COPY OF THE ORIGINAL WHEN SUPPLIED BY DAMBROSIO architecture + urbanism, BEARING IMAGES OF THE PROFESSIONAL SEAL AND DIGITAL CERTIFICATE OR WHEN PRINTED FROM THE DIGITALLY OERTIFIED ELECTRONIC FILE.

Please refer to the accompanying resubmission memo for revision descriptions.

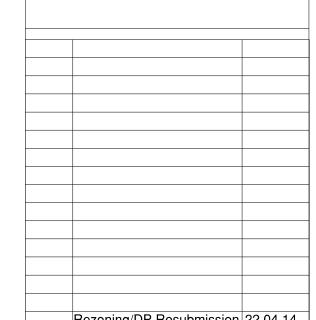

Rezoning/DP Resubmission 22.04.14

2 Issued for Rezoning / DP 21.12.15

rev no description date

copyright reserved, these drawings and designs are and at all times remain the property of d'ambrosio architecture to be used for the project shown and may not be reproduced without written consent.

project name


Nontreal and Quebec

205 Quebec Street

Victoria, BC

sheet title
Existing Site Survey

project no. #21-18
scale
drawn by Author
date issued sheet no.
12/04/22 A1.0

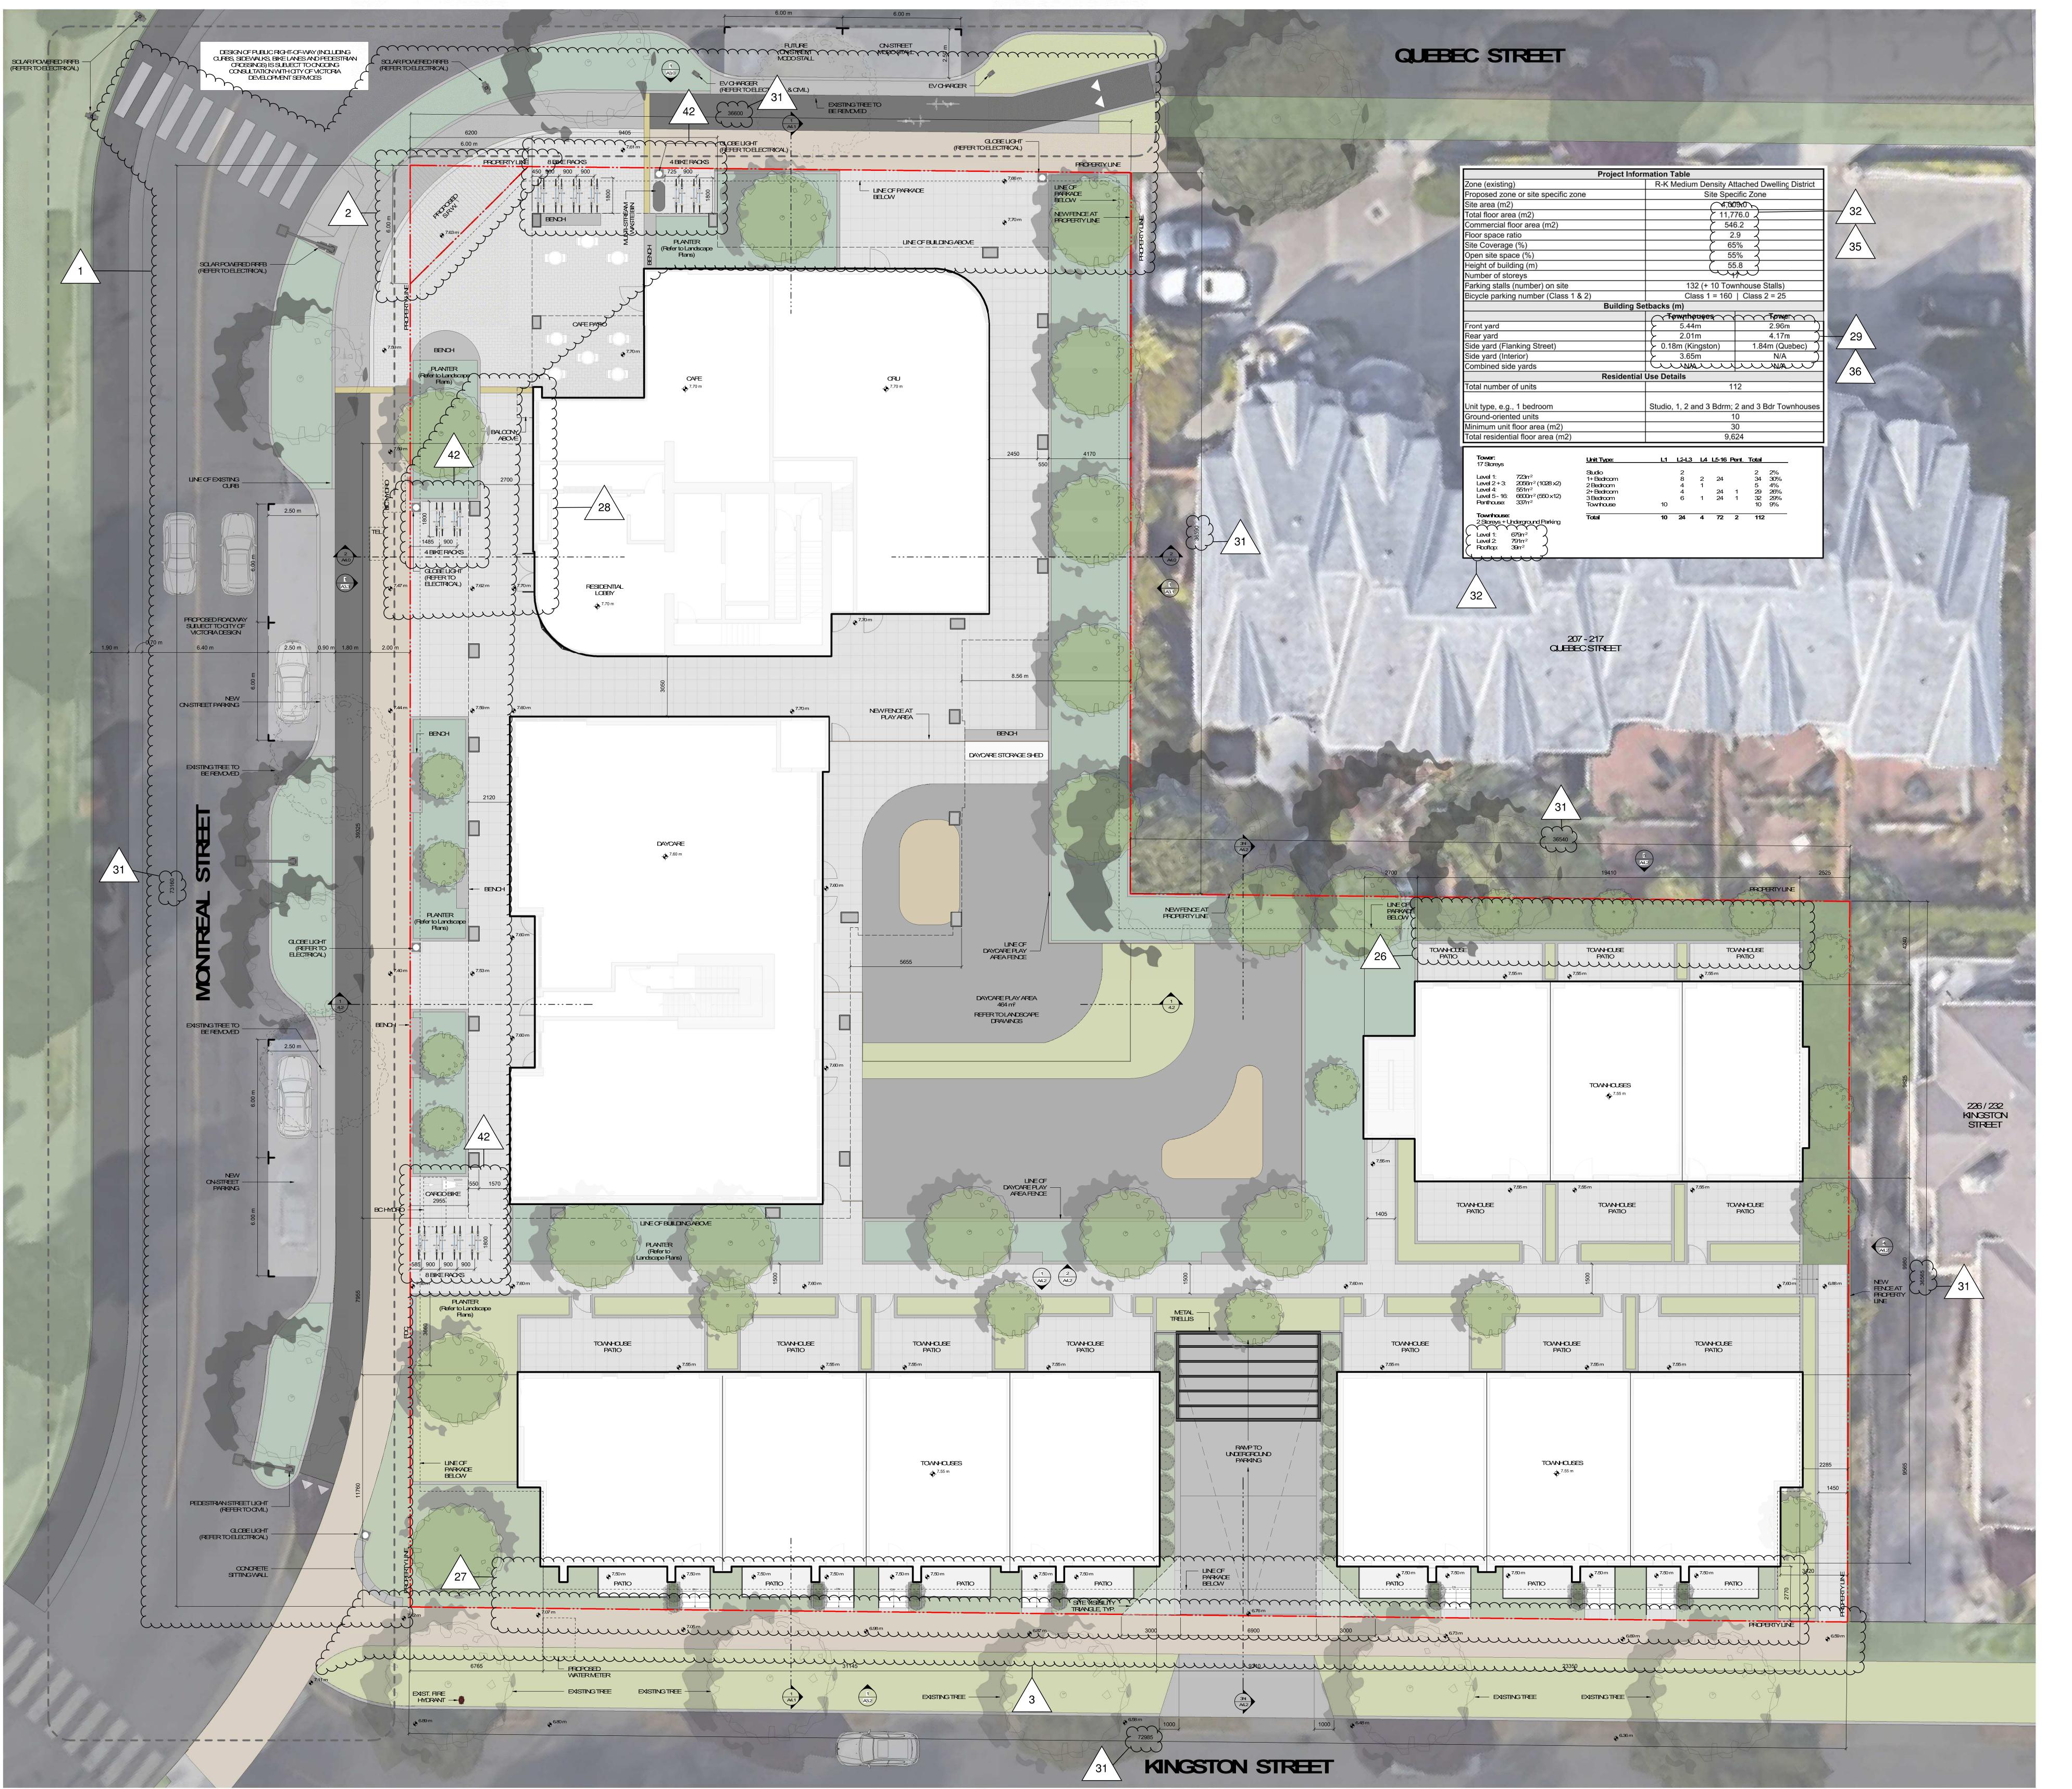

D'AMBROSIO architecture + urbanism




THIS DOCUMENT HAS BEEN ELECTRONICALLY CERTIFIED WITH DIGITAL CERTIFICATE AND ENCRYPTION TECHNOLOGY AUTHORIZED BY THE AIBC. THE AUTHORITATIVE ORIGINAL IS IN ELECTRONIC FORM ANY PRINTED VERSION CANBE RELIED UPON AS A TRUE COPY OF THE ORIGINAL WHEN SUPPLIED BY DIAMBROSIO architecture + urbanism, BEARING IMAGES OF THE PROFESSIONAL SEAL AND DIGITAL CERTIFICATE OR WHEN PRINTED FROM THE DIGITALLY CERTIFIED ELECTRONIC FILE.

NOTES:

REFER TO LANDSCAPE PLANS FOR INFORMATION ON PAMING ON PAMING, FENCING, PLANTING AND TREES.

Please refer to the accompanying resubmission memo for revision descriptions.


minume.

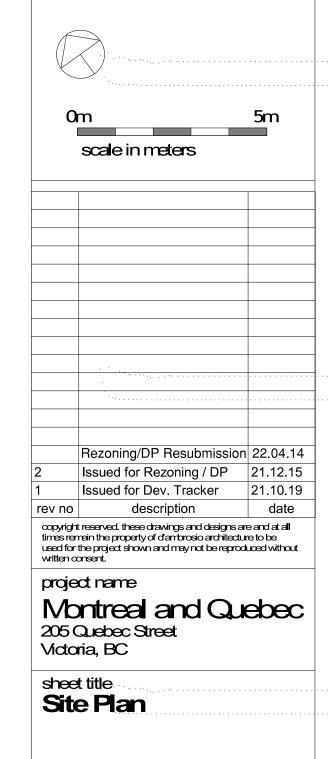

project no. #21-18
scale 1:100
drawn by RP, GK
date issued sheet no.
12/04/22 A1.1


D'AMBROSIO architecture + urbanism



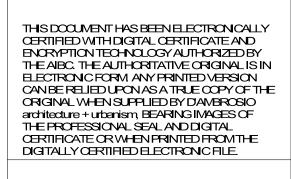

Please refer to the accompanying resubmission memo for revision descriptions.

Yuuuuuu

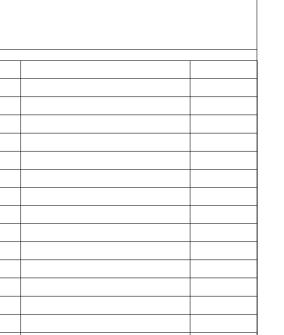

Rezoning/DP Resubmission 22.04.14

2 Issued for Rezoning / DP 21.12.15

rev no description date

copyright reserved, these drawings and designs are and at all times remain the property of drambrosio architecture to be used for the project shown and may not be reproduced without written consent.

project name


Nontreal and Quebec

205 Quebec Street

Victoria, BC


sheet title
Average Grade
Calculations

project no.	#21-18	2
scale	1 : 100	E-1E-0E DIV
drawn by	RP, GK	7.15
date issued	sheet no.	7
12/04/22	A1.2	2022 04

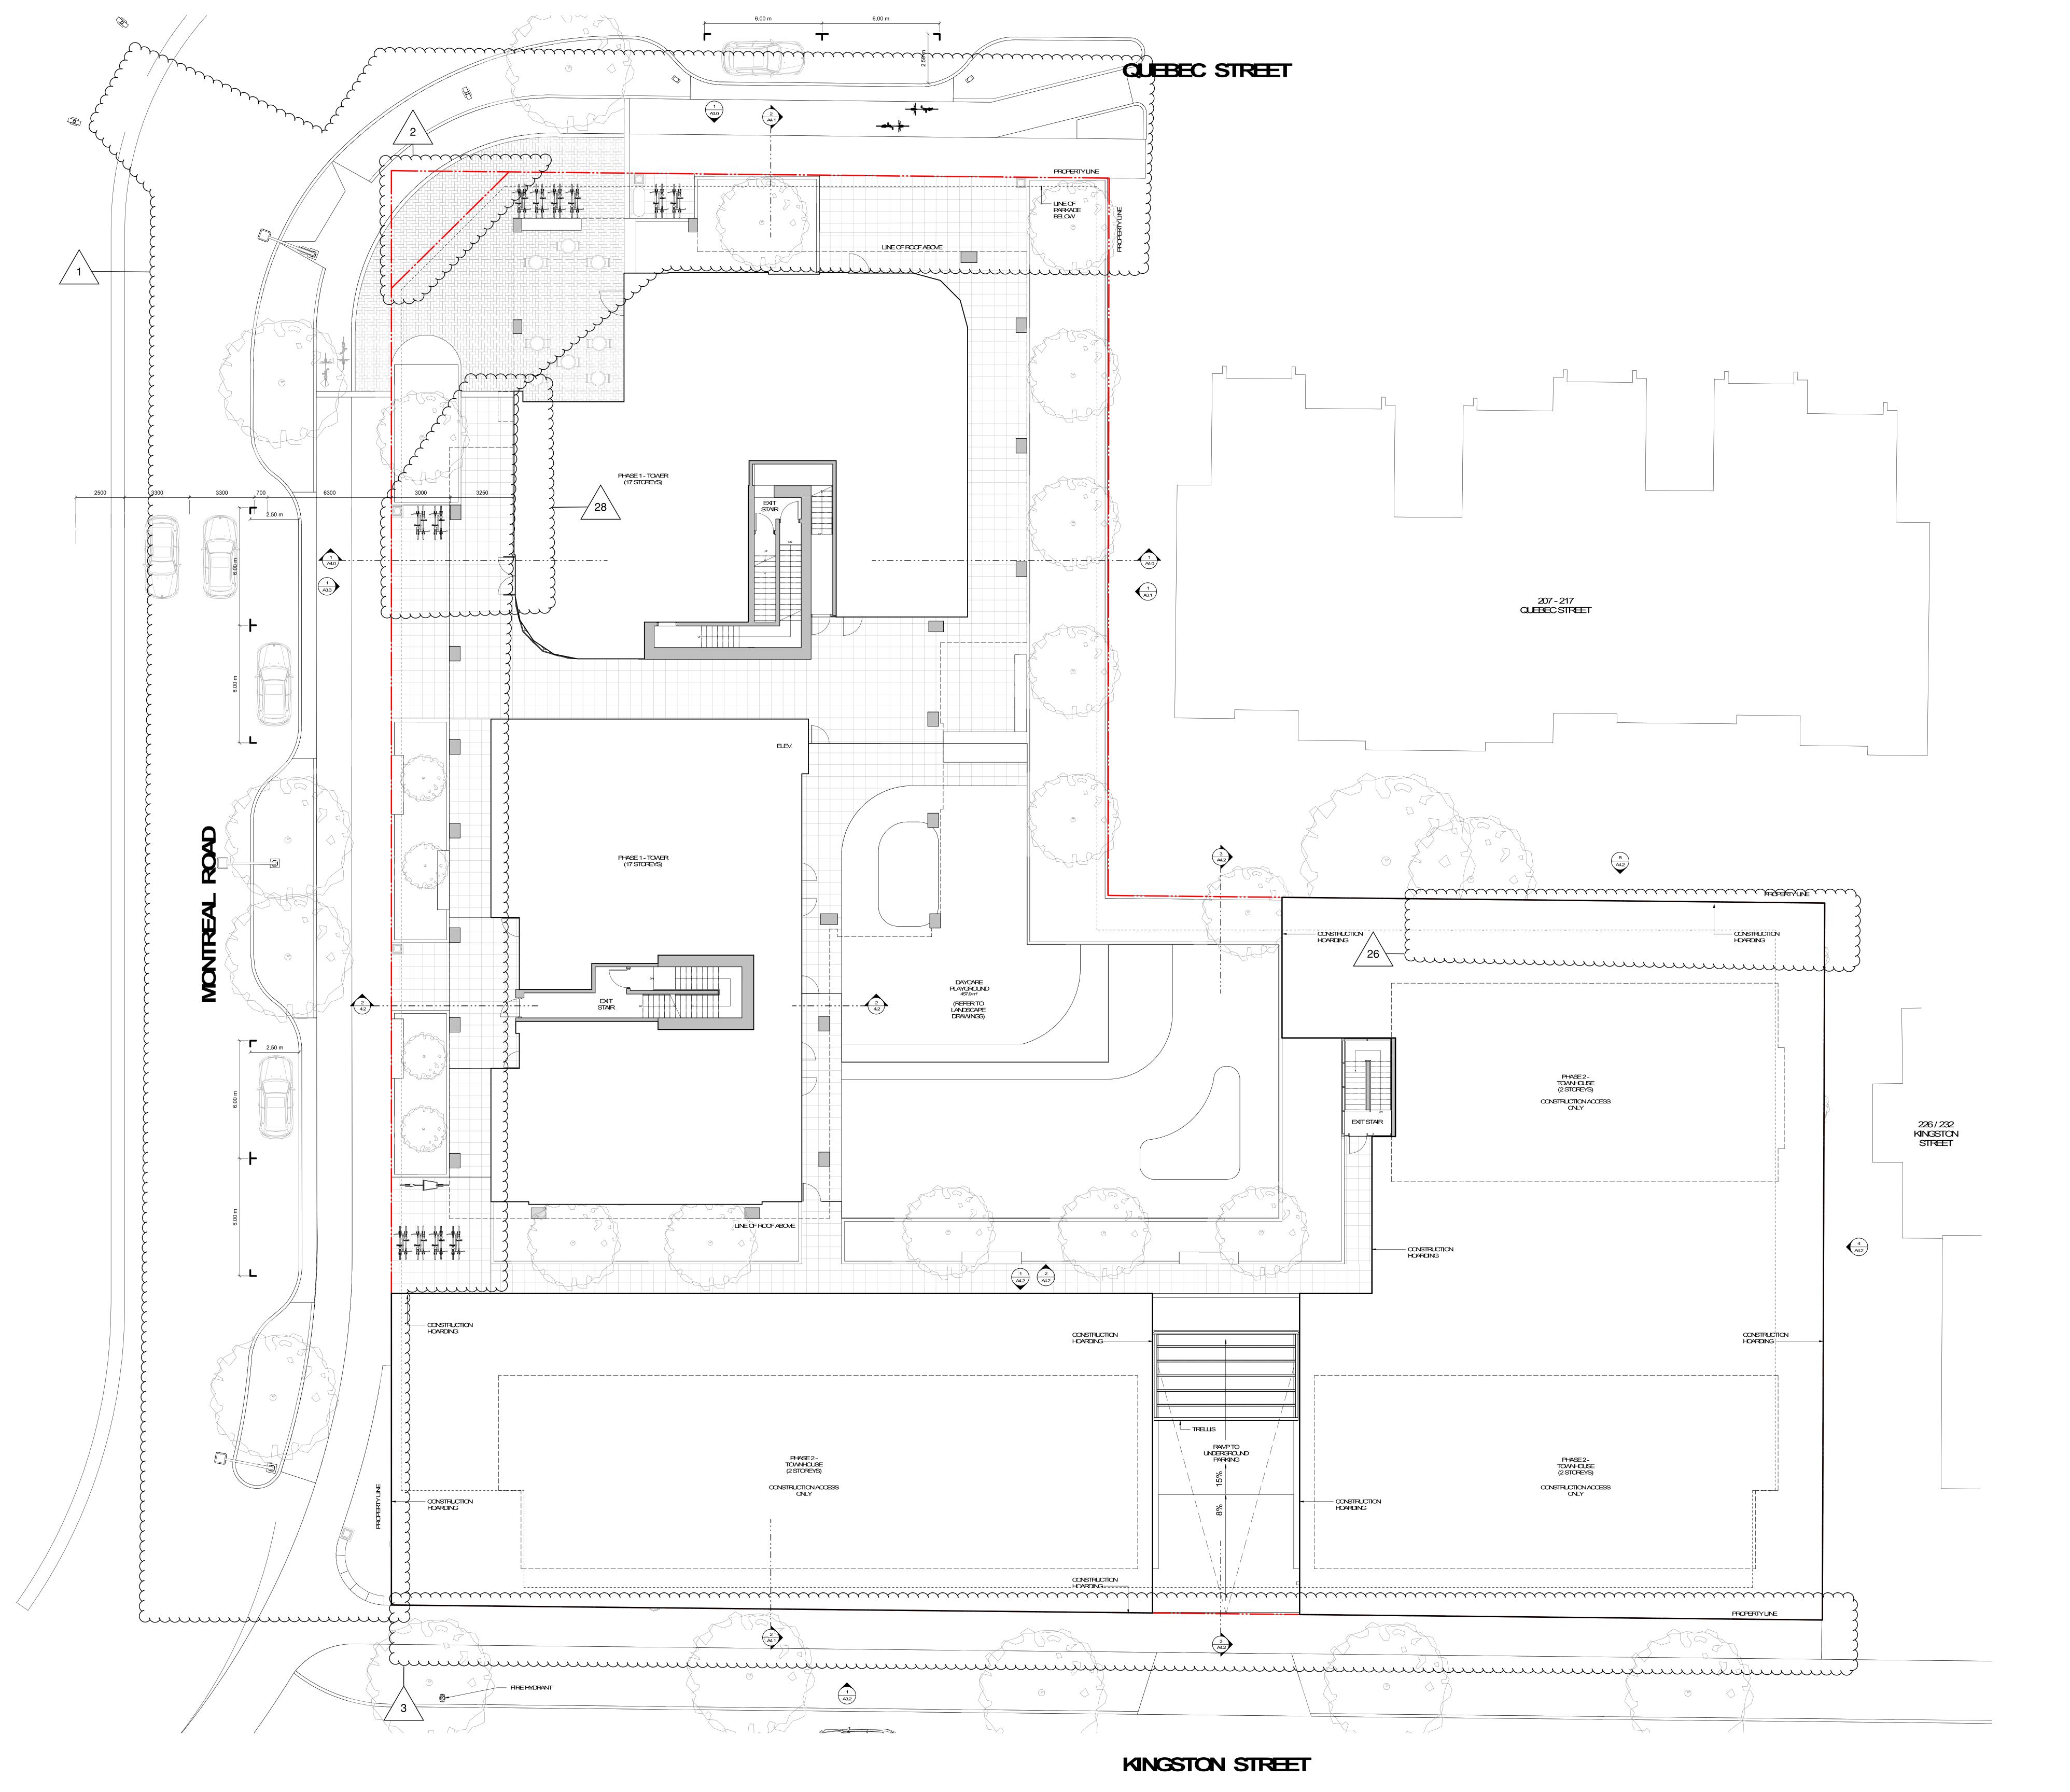


D'AMBROSIO architecture + urbanism



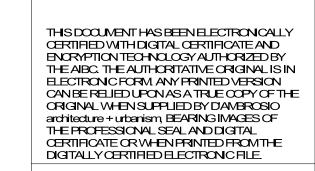


Please refer to the accompanying resubmission memo for revision descriptions.

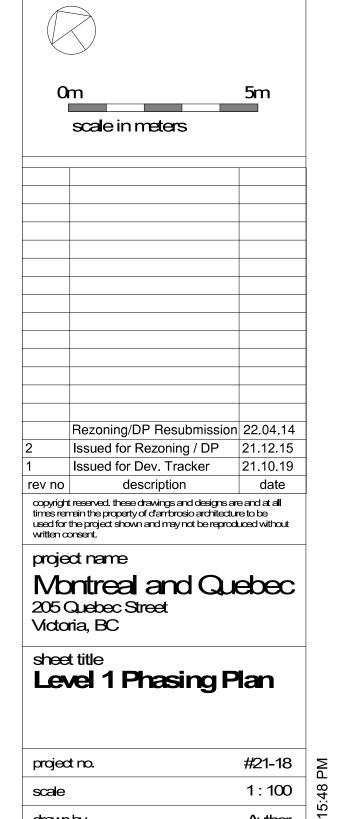


date issued





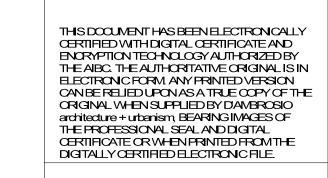


Please refer to the accompanying resubmission memo for revision descriptions.

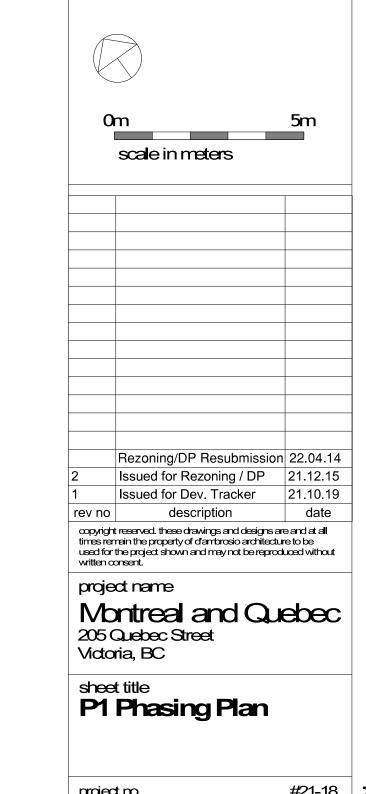


date issued





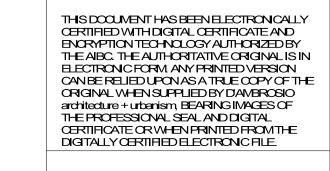

Comment of the same of the sam Please refer to the accompanying resubmission memo for revision descriptions. Yuuuuuu

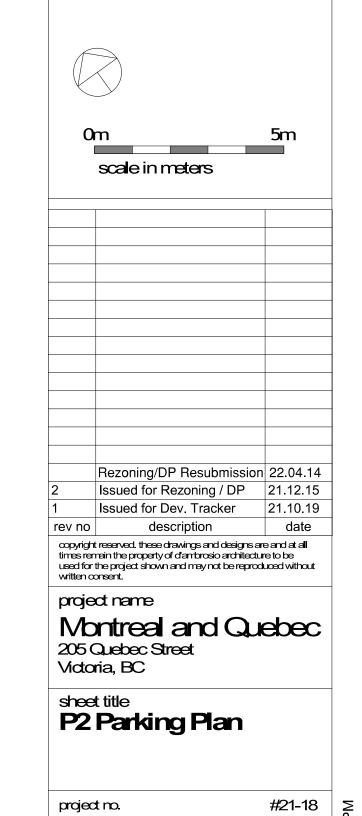


1 : 100

A2.0

project no.


drawn by

date issued

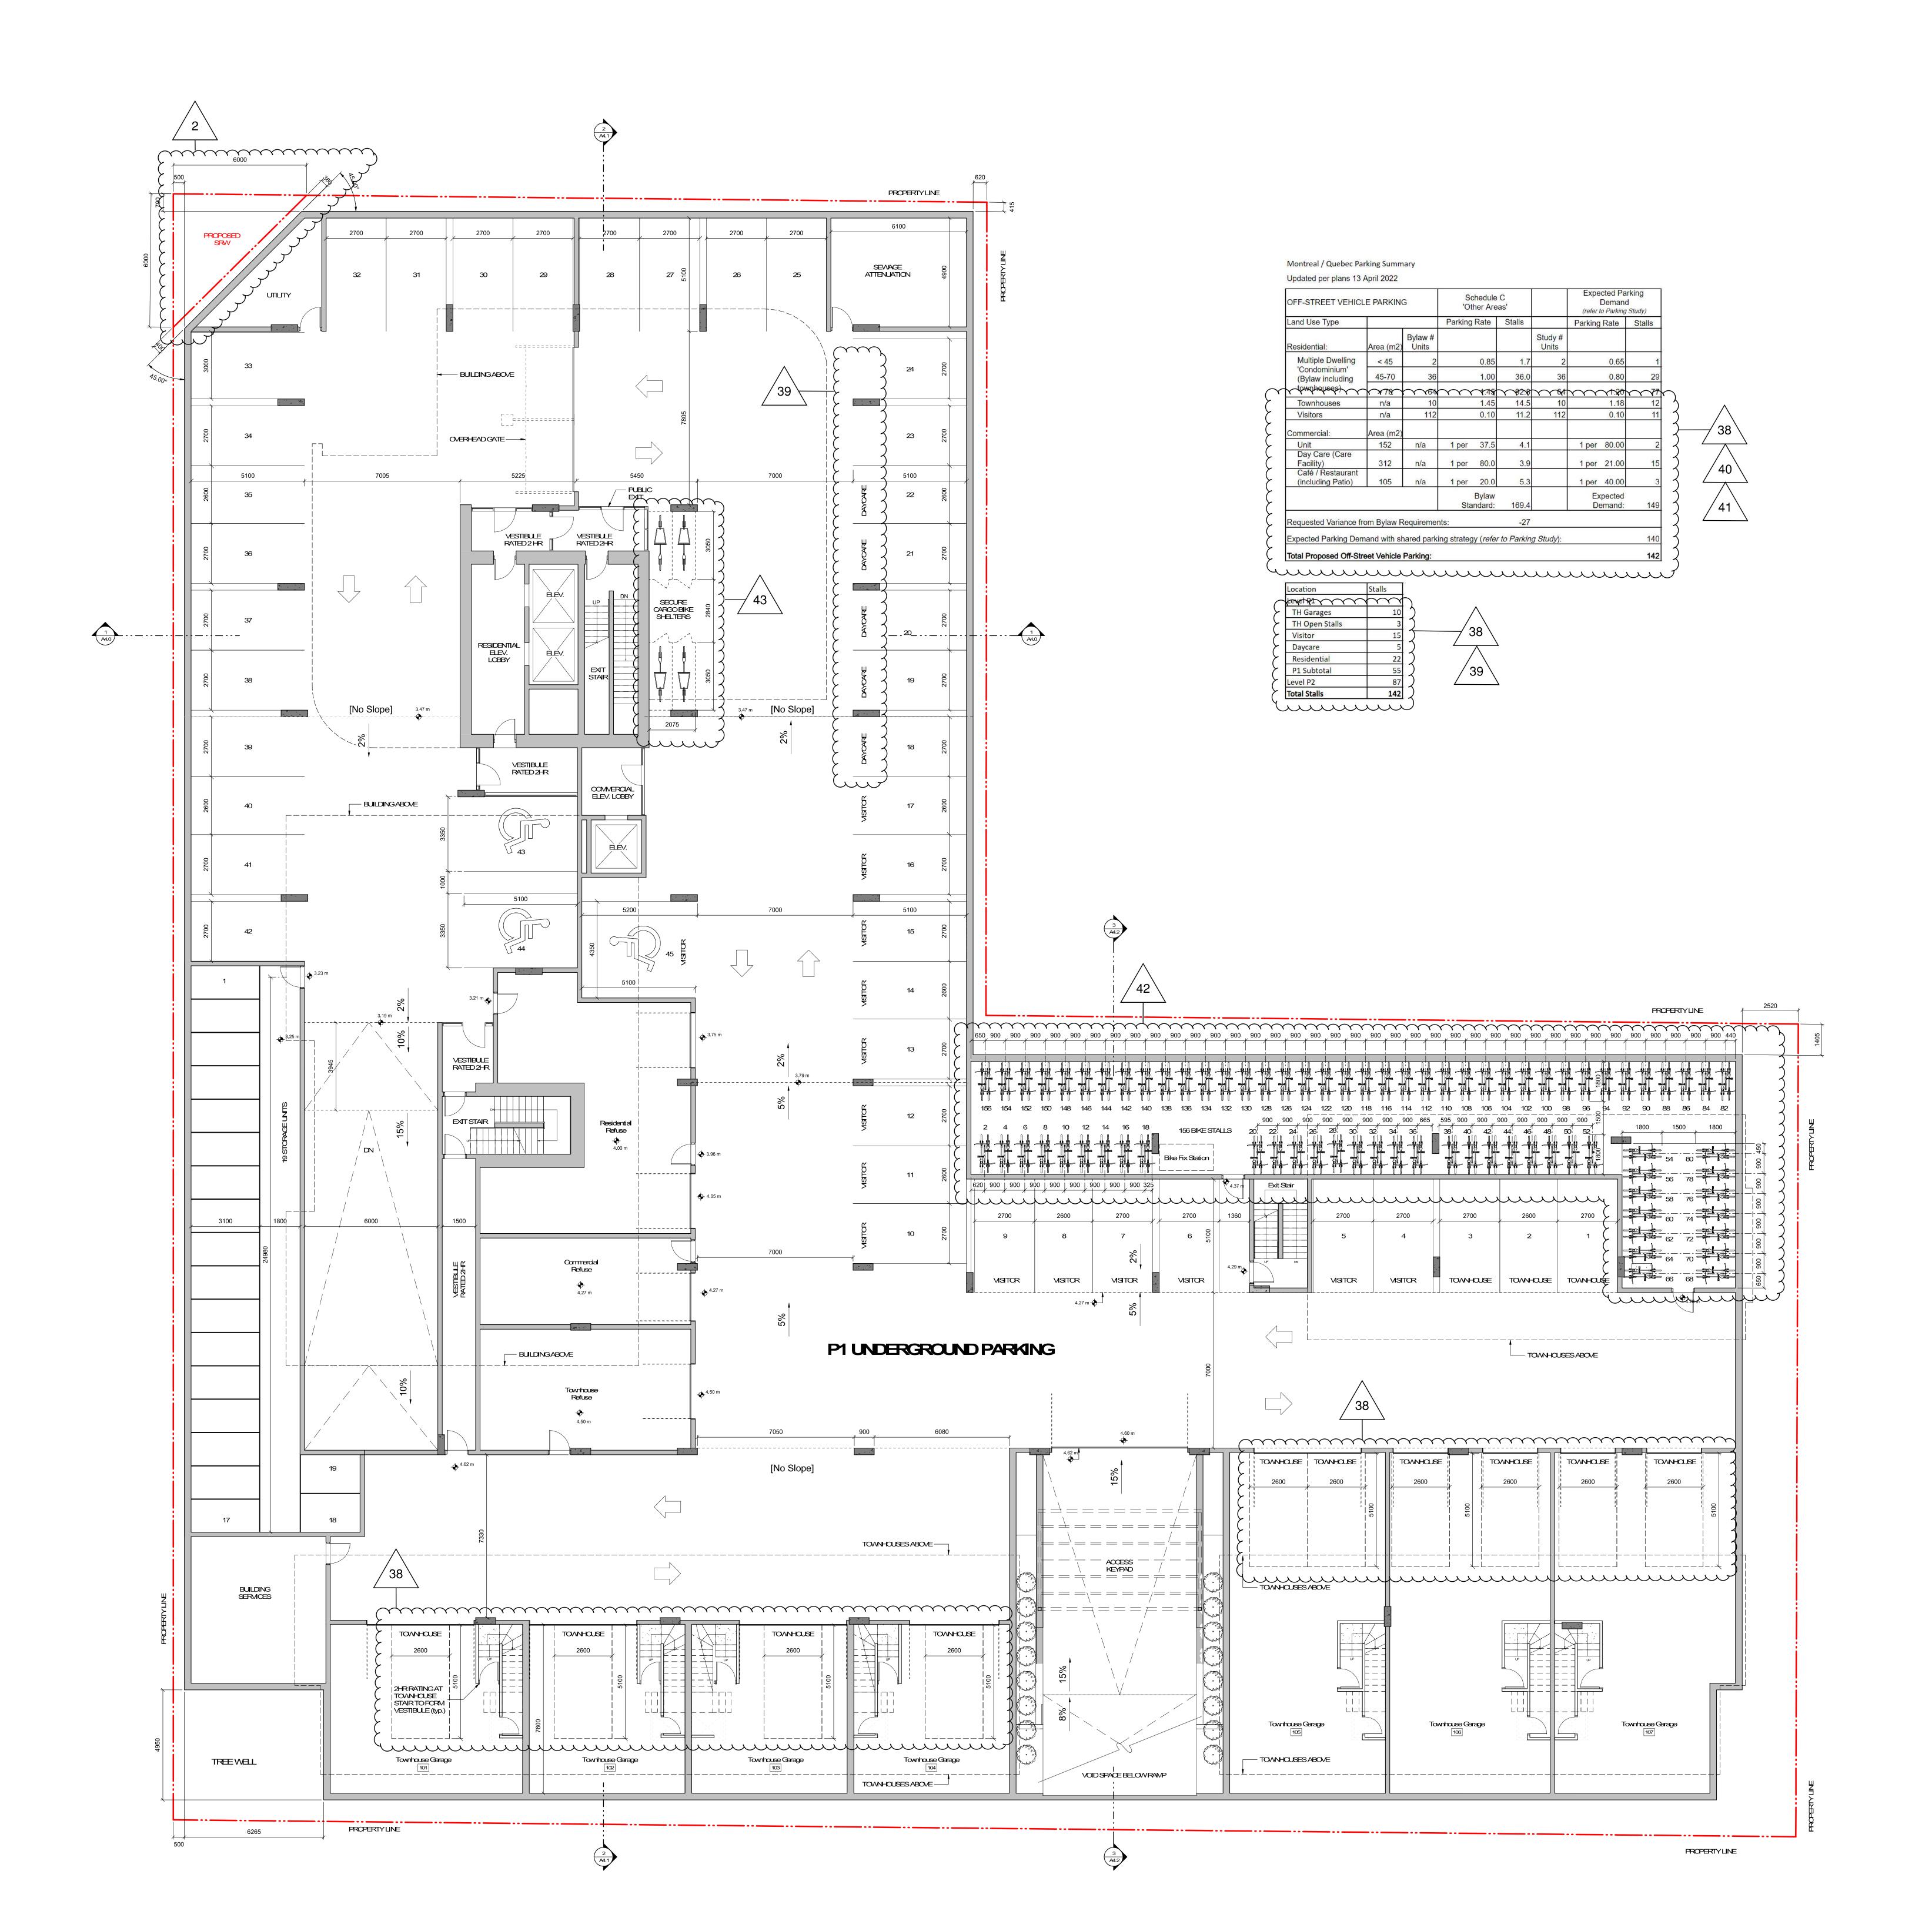






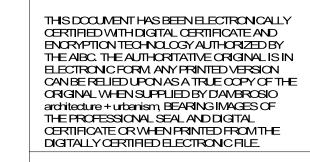

Please refer to the accompanying resubmission memo for revision descriptions.

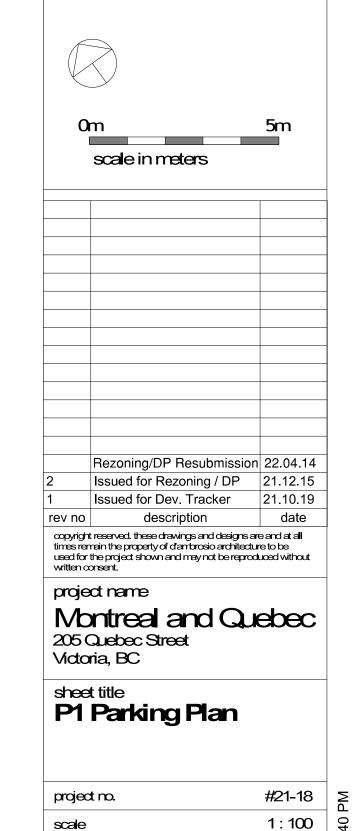


drawnby

date issued

D'AMBROSIO



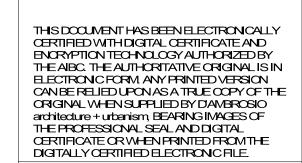


NOTES:

1. REFER TO LANDSCAPE PLANS FOR INFORMATION ON PAMING, FENCING, PLANTINGS, AND TREES.

Please refer to the accompanying resubmission memo for revision descriptions.



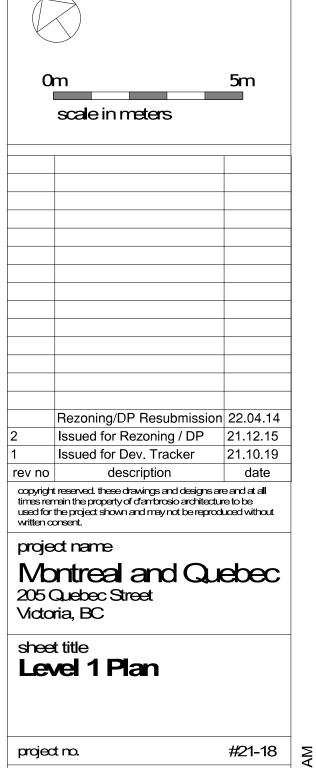


drawn by

date issued



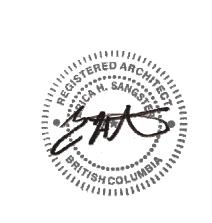

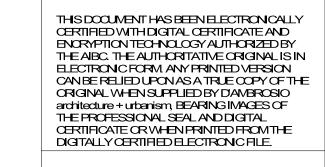


Please refer to the accompanying resubmission memo for revision descriptions.

2	Issued for Rezoning / DP	21.12.15
1	Issued for Dev. Tracker	21.10.19
rev no	description	date
times ren used for written o		e to be
M c 205 (ct name I ntreal and Qu i Quebec Street ria, BC	ebec

date issued






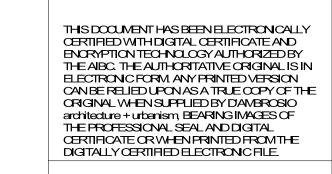

NOTES:

1. REFER TO LANDSCAPE PLANS FOR INFORMATION ON PAVING, FENCING, PLANTINGS, AND TREES.

Please refer to the accompanying resubmission memo for revision descriptions.

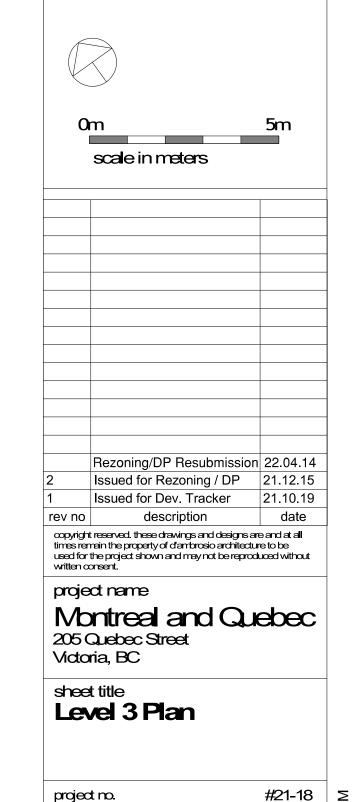


drawn by

date issued






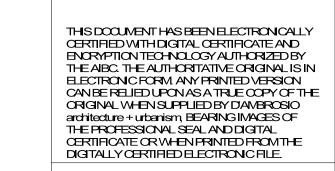

NOTES:

1. REFER TO LANDSCAPE PLANS FOR INFORMATION ON PAMING, FENCING, PLANTINGS, AND TREES.

Please refer to the accompanying resubmission memo for revision descriptions.

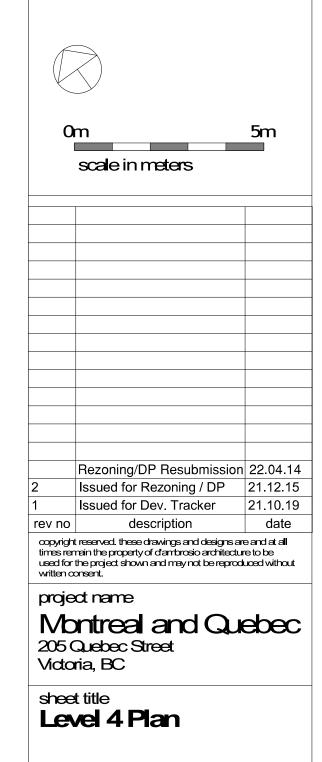

1 : 100

RP/GK

sheet no.

project no.

drawn by


date issued

12/04/22


PROPERTYLINE





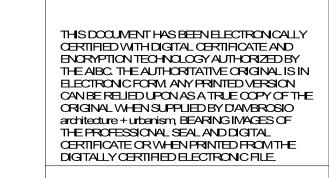

Please refer to the accompanying resubmission memo for revision descriptions.

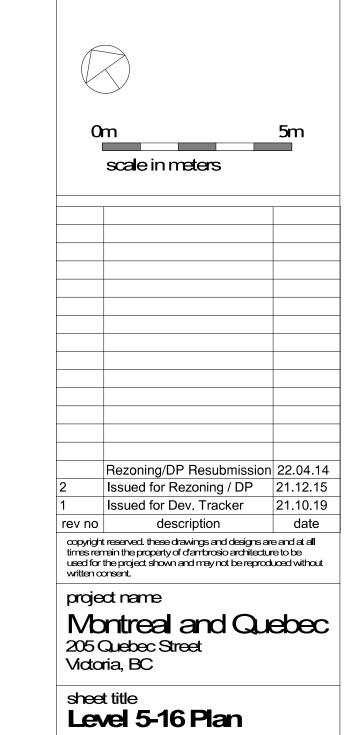

project no.

drawn by


date issued


12/04/22

1 : 100


PROPERTYLINE



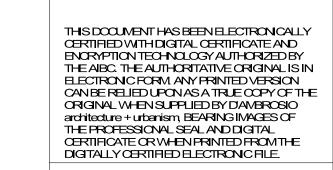

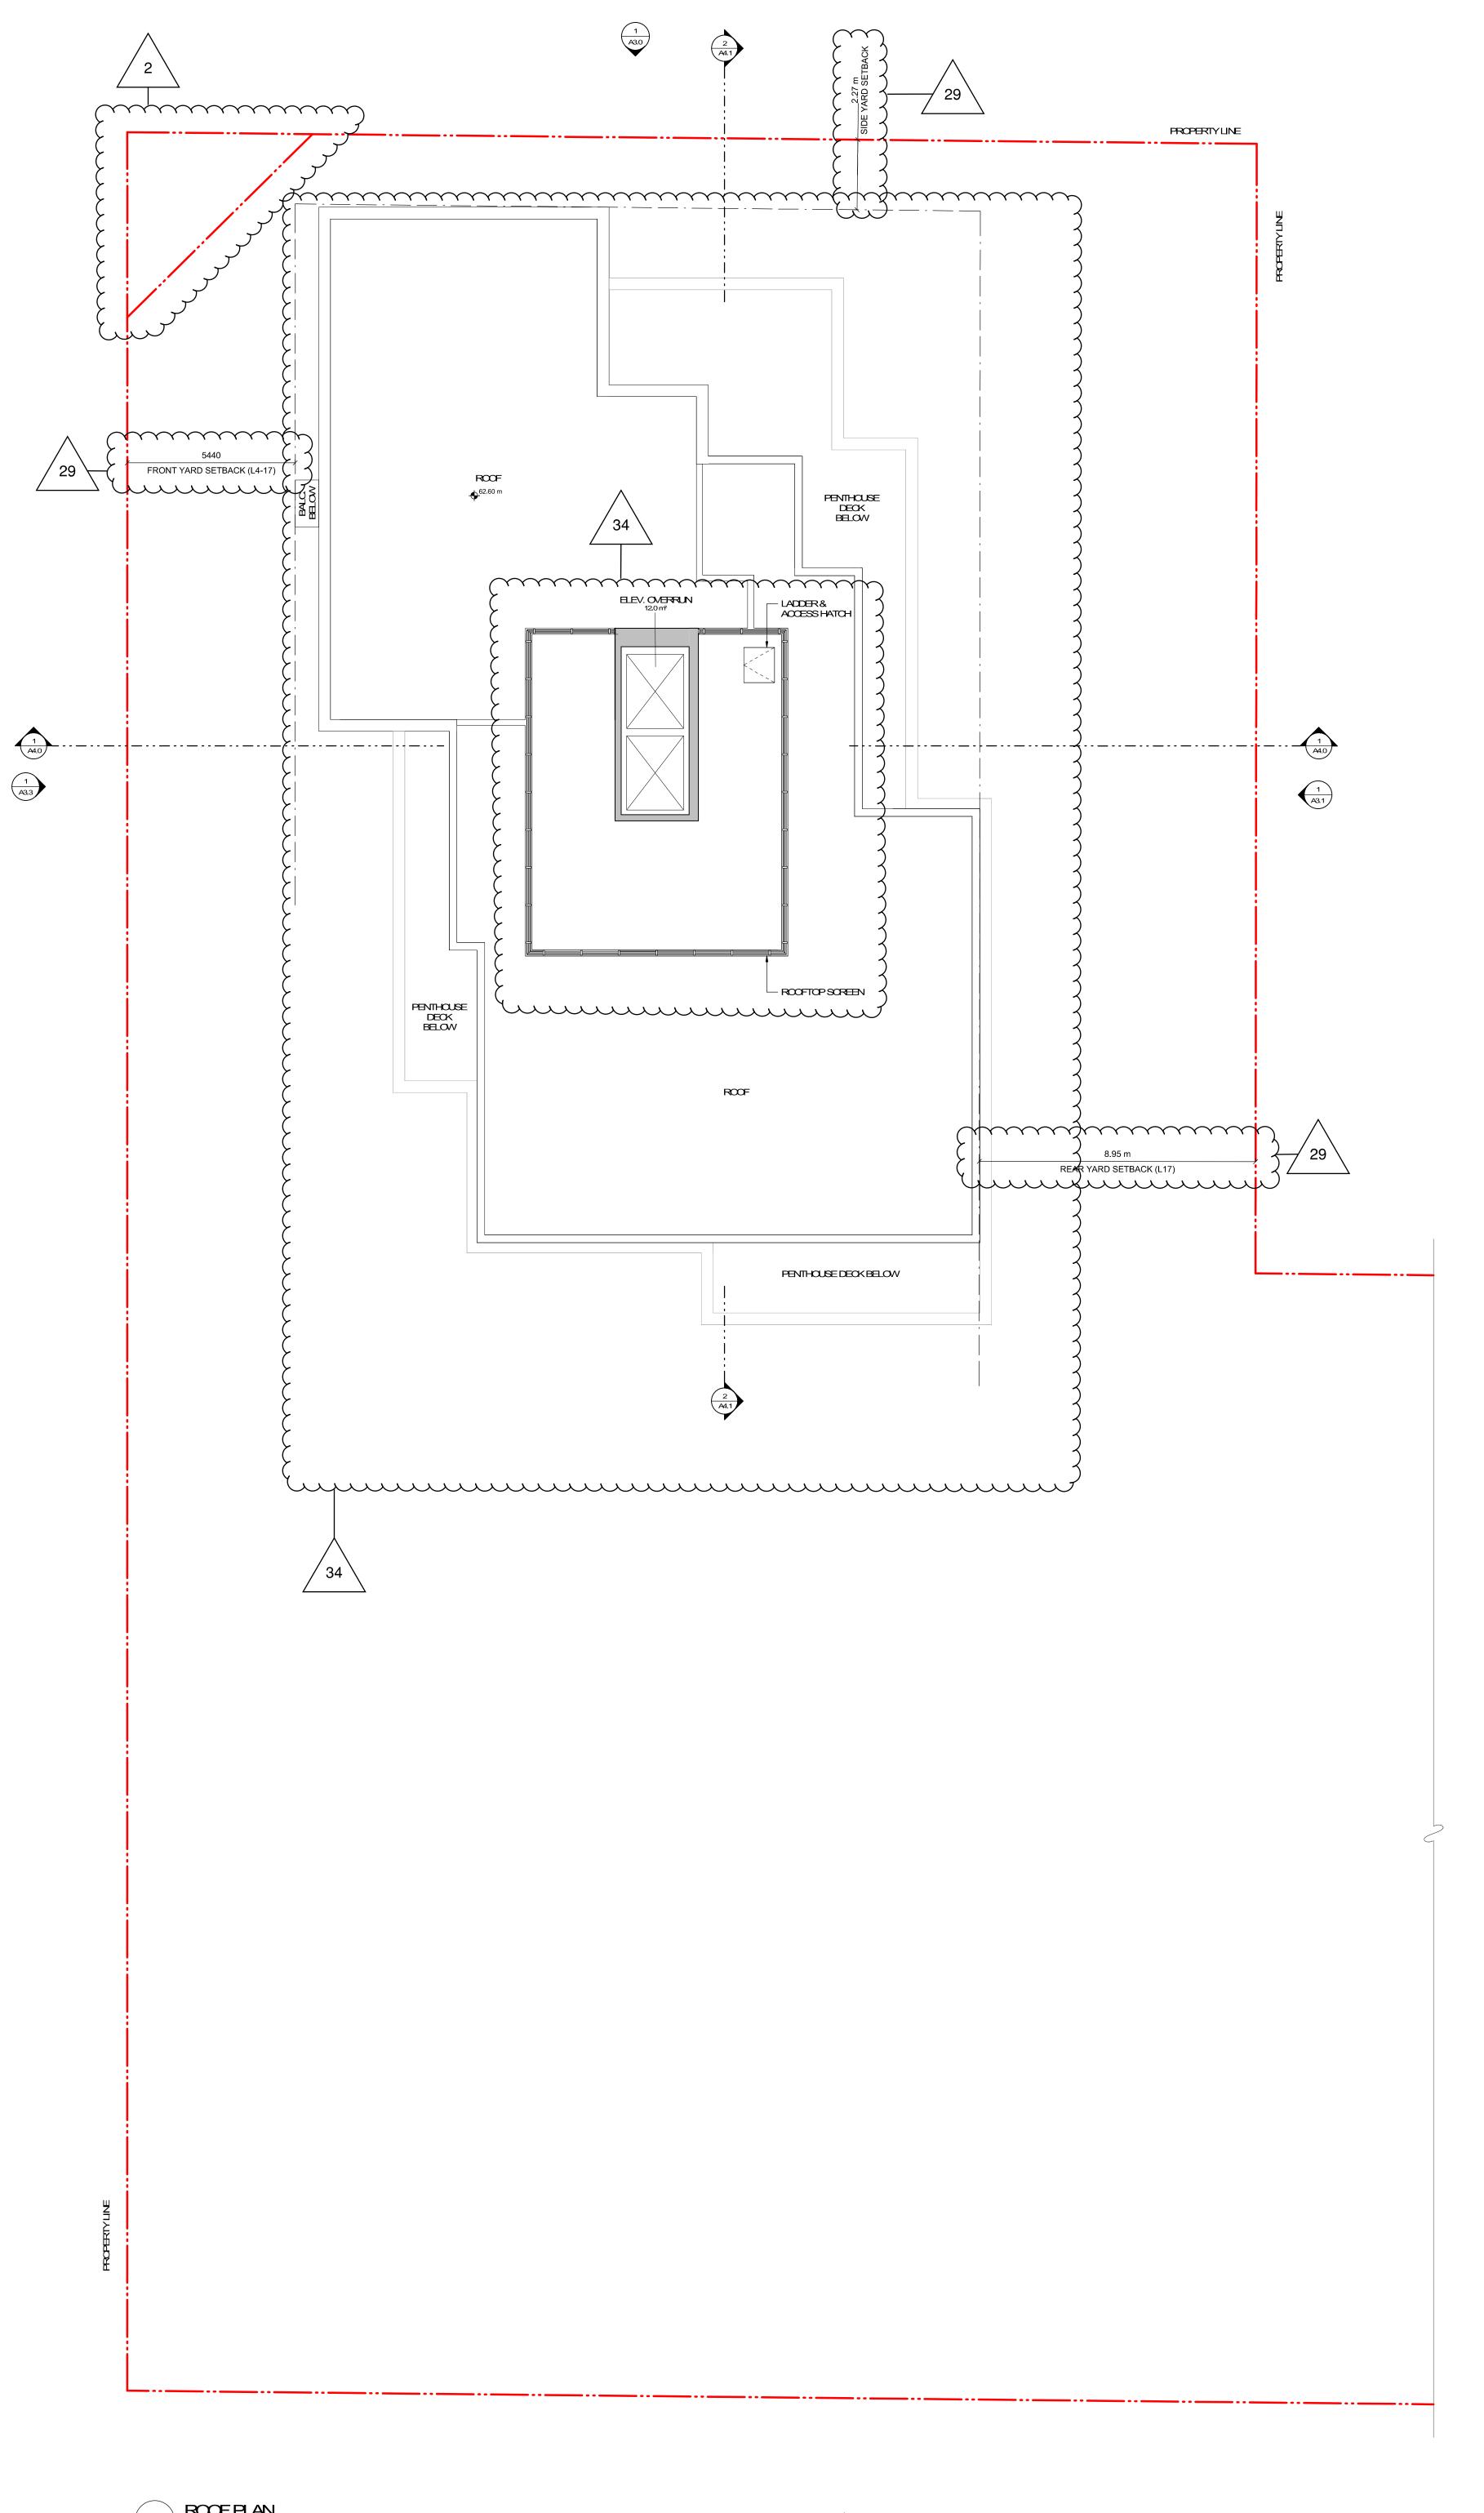


Comment of the same of the sam Please refer to the accompanying resubmission memo for revision descriptions.

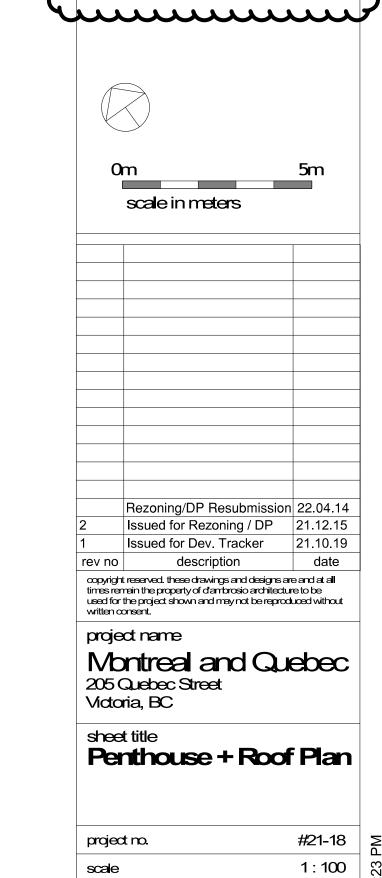

drawn by

date issued

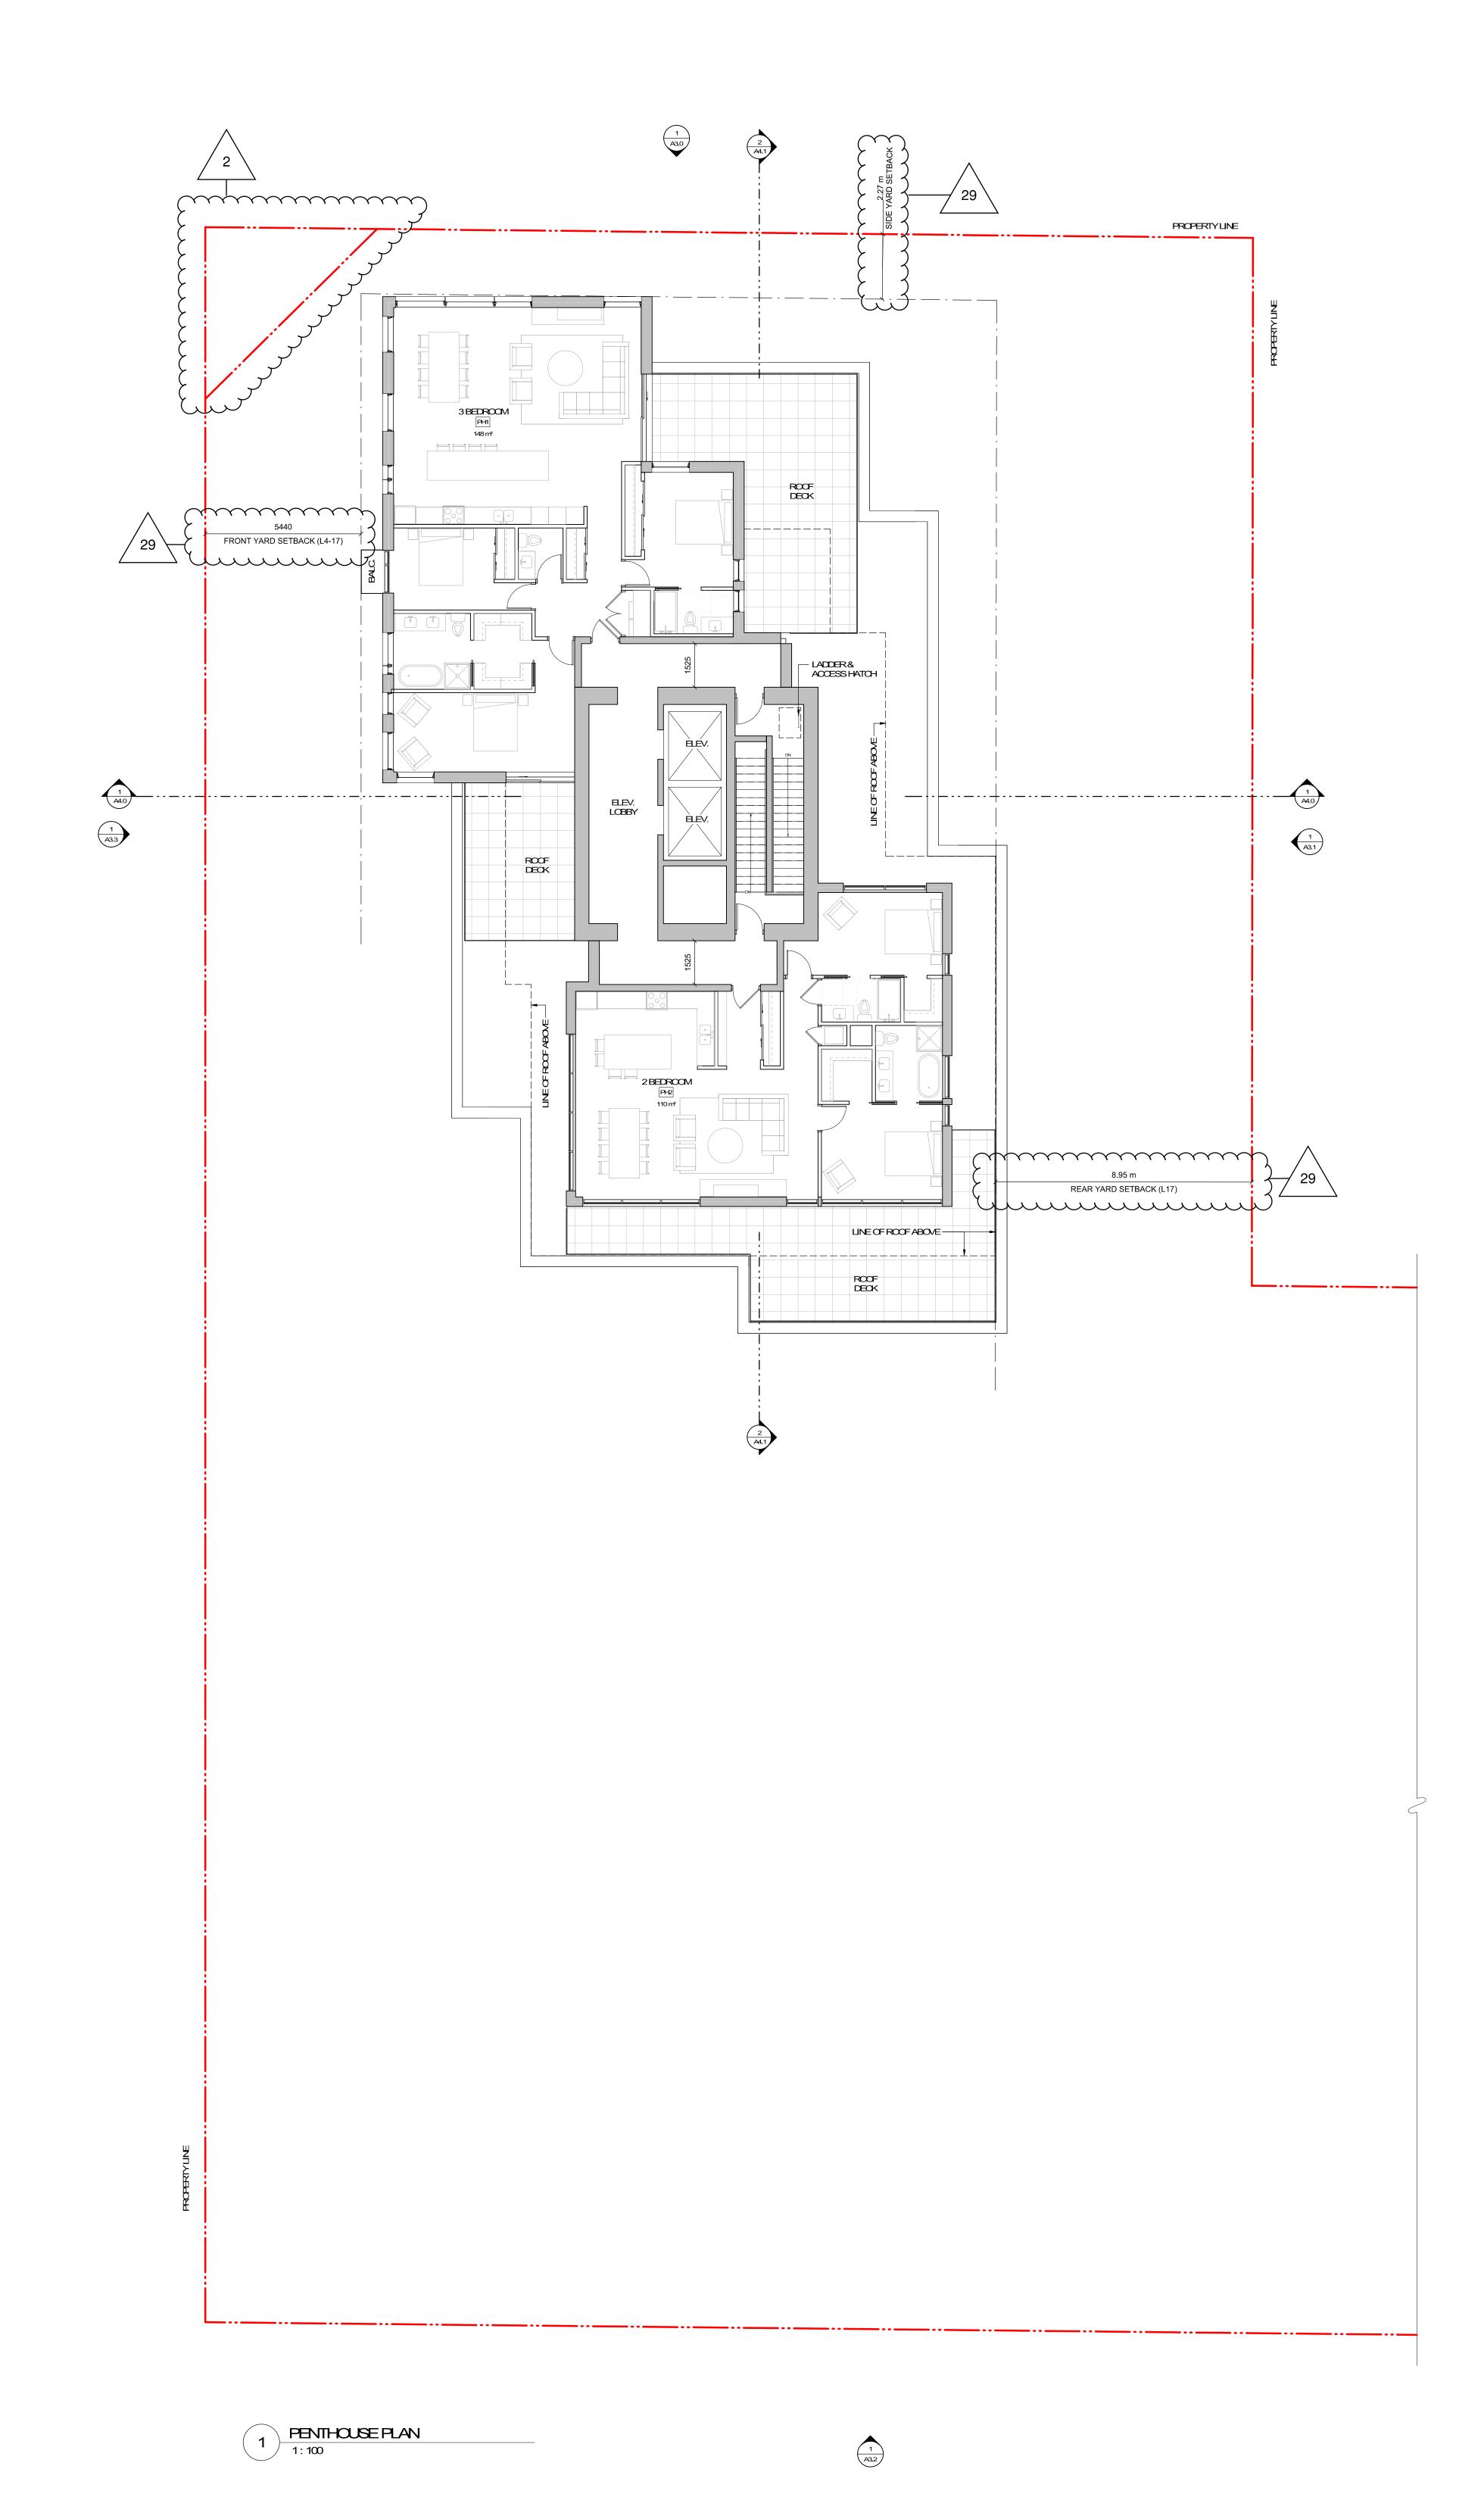



THIS DOOUMENT HAS BEEN ELECTRONICALLY CERTIFIED WITH DIGITAL CERTIFICATE AND ENCRYPTION TECHNOLOGY AUTHORIZED BY THE AIBC. THE AUTHORITATIVE ORIGINAL IS IN ELECTRONIC FORM ANY PRINTED VERSION CAN BE RELIED UPON AS A TRUE COPY OF THE ORIGINAL WHEN SUPPLIED BY DIAMBROSIO architecture + urbanism, BEARING IIMAGES OF THE PROFESSIONAL SEAL AND DIGITAL CERTIFICATE OR WHEN PRINTED FROM THE DIGITALLY CERTIFIED BLECTRONIC FILE.

Cement Panel System
Colour: Sandstone

Running Bond Brick
Colour: Wheat

3 Fibre Cement Panel
Colour: Dark Grey

4 Pre-finished Vertical Wood Siding

5 Soffits: T&GWbcd
6 Glass Quards in Pre-finished Aluminum Frames

7 Gazed Canopies: Laminated Gazing on Painted Steel Structure Colour: Iron / Ore

8 Prefinished Metal Parapet Flashing Colour: Iron / Ore

Prefinished Metal Fascia
Cdour: Iron/Ore

Perforated Metal Balcony Quard
Cdour: Iron/Ore

Painted Metal Pergolas and Gates
Colour: Iron/ Ore

Windowand Doors: Gear Glazing in Dark
Anodized Aluminum Frames
Colour: Iron/ Ore

Glass Walls and Quards w Aluminum Frame
Colour: Iron / Ore

14) Exposed Architectural Concrete


Prefinished Metal Louvers

Prefinished Metal Louvers
Colour: Iron/Ore

Prefinished Metal Panel
Colour: Iron/Ore



Please refer to the accompanying resubmission memo for revision descriptions.

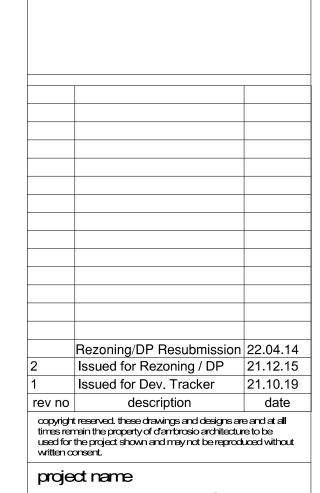

Montreal and Quebec 205 Quebec Street Victoria, BC sheet title North Elevation

xx/11/21

project no. #21-18
scale 1:100
drawn by Author
date issued sheet no.

A3.0.



THIS DOCUMENT HAS BEEN ELECTRONICALLY CERTIFIED WITH DIGITAL CERTIFICATE AND ENCRYPTION TECHNOLOGY AUTHORIZED BY THE AIBC. THE AUTHORITATIVE ORIGINAL IS IN ELECTRONIC FORM ANY PRINTED VERSION CANBE RELIED UPON AS A TRUE COPY OF THE ORIGINAL WHEN SUPPLIED BY DAMBROSIO architecture + urbanism, BEARING IMAGES OF THE PROFESSIONAL SEAL AND DIGITAL CERTIFICATE OR WHEN PRINTED FROM THE DIGITALLY CERTIFIED ELECTRONIC FILE.

Cement Panel System
Colour: Sandstone

Running Bond Brick
Colour: Wheat

3 Fibre Cement Panel Colour: Dark Grey

Pre-finished Vertical Wood Siding
 Soffits: T&GWood
 Gass Quards in Pre-finished Auminum Frames

Glazed Canopies: Laminated Glazing on Painted Steel Structure Colour: Iron / Ore

8 Prefinished Metal Parapet Flashing Colour: Iron / Ore

9 Prefinished Metal Fascia
Colour: Iron / Ore

10 Perforated Metal Balcony Guard
Colour: Iron / Ore

Painted Metal Pergolas and Gates
Colour: Iron / Ore

Windowand Doors: Clear Glazing in Dark
Anodized Aluminum Frames
Colour: Iron / Ore

Glass Walls and Quards w Aluminum Frame
Colour: Iron / Ore

Exposed Architectural Concrete
 Prefinished Metal Louvers
 Calour: Iron / Ore

15 Calcur: Iron / Ore

16 Prefinished Metal Panel
Calcur: Iron / Ore

Please refer to the accompanying resubmission memo for revision descriptions.

33



Rezoning/DP Resubmission 22.04.14
2 Issued for Rezoning / DP 21.12.15
1 Issued for Dev. Tracker 21.10.19
rev no description date

copyright reserved, these drawings and designs are and at all times remain the property of dambrosio architecture to be used for the project shown and may not be reproduced without written consent.

project name

Montreal and Quebec

205 Quebec Street

Victoria, BC

sheet title **East Elevation**

project no.	#21-18	2
scale	1 : 100	MA 70.40.0
drawn by	Author	5.5
date issued	sheet no.	7
xx/11/21	A3.1.	77 70 000



THIS DOCUMENT HAS BEEN ELECTRONICALLY CERTIFIED WITH DIGITAL CERTIFICATE AND ENCRYPTION TECHNOLOGY AUTHORIZED BY THE AIBC. THE AUTHORITATIVE ORIGINAL IS IN ELECTRONIC FORM ANY PRINTED VERSION CAN BE RELIED UPON AS A TRUE COPY OF THE ORIGINAL WHEN SUPPLIED BY DAVABROSIO architecture + urbanism, BEARING IMAGES OF THE PROFESSIONAL SEAL AND DIGITAL CERTIFICATE OR WHEN PRINTED FROM THE DIGITALLY CERTIFIED ELECTRONIC FILE.

1 Cement Panel System
Colour: Sandstone
Running Bond Brick
Colour: Wheat

2 Colour: Wheat

3 Fibre Cement Panel
Colour: Dark Grey

Colour: Dark Grey

4 Pre-finished Vertical Wood Siding

5 Soffits: T&GWood
6 Glass Quards in Pre-finished Aluminum Frames

Gazed Canopies: Laminated Gazing on Painted Steel Structure Colour: Iron / Ore

8 Prefinished Metal Parapet Flashing Colour: Iron / Ore

Prefinished Metal Fascia
Colour: Iron / Ore
 Perforated Metal Balcony Quard
Colour: Iron / Ore

Calour: Iron / Gre

Painted Metal Pergalas and Gates
Calour: Iron / Gre

Windowand Doors: Clear Glazing in Dark Anodized Aluminum Frames Colour: Iron / Ore

Glass Walls and Quards w Aluminum Frame Colour: Iron / Ore


(14) Exposed Architectural Concrete

Prefinished Metal Louvers Colour: Iron/Ore

Prefinished Metal Panel Colour: Iron / Ore



Please refer to the accompanying resubmission memo for revision descriptions.

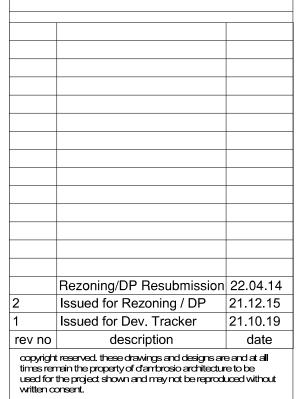

used for the project shown and may not be reproduced without written consent.

project name

Montreal and Quebec

205 Quebec Street
Victoria, BC

Victoria, BC
sheet title
South Elevation

xx/11/21

project no. #21-18
scale 1:100
drawn by Author
date issued sheet no.

A3.2.



THIS DOCUMENT HAS BEEN ELECTRONICALLY CERTIFIED WITH DIGITAL CERTIFICATE AND ENCRYPTION TECHNOLOGY AUTHORIZED BY THE AIBC. THE AUTHORITATIVE ORIGINAL IS IN ELECTRONIC FORM ANY PRINTED VERSION CAN BE RELIED UPON AS A TRUE COPY OF THE ORIGINAL WHEN SUPPLIED BY DAVBROSIO architecture + urbanism, BEARING IMAGES OF THE PROFESSIONAL SEAL AND DIGITAL CERTIFICATE OR WHEN PRINTED FROM THE DIGITALLY CERTIFIED ELECTRONIC FILE. ELEVATION MATERIALS KEY:

1 Cement Panel System Colour: Sandstone

2 Running Bond Brick Colour: Wheat

3 Fibre Cement Panel Colour: Dark Grey 4) Pre-finished Vertical Wood Siding

(5) Soffits: T&GWood 6 Glass Guards in Pre-finished Aluminum Frames

Gazed Canopies: Laminated Gazing on Painted Steel Structure Colour: Iron / Ore 8 Prefinished Metal Parapet Flashing Colour: Iron / Ore

9 Prefinished Metal Fascia Calour: Iron / Ore

Perforated Metal Balcony Quard Colour: Iron / Ore Painted Metal Pergolas and Gates Colour: Iron / Ore

Windowand Doors: Clear Glazing in Dark Anodized Aluminum Frames Colour: Iron / Ore

Glass Walls and Guards w Aluminum Frame Colour: Iron / Ore


(14) Exposed Architectural Concrete

Prefinished Metal Louvers
Colour: Iron / Ore

16) Prefinished Metal Panel Colour: Iron/Ore



mmmmm Please refer to the accompanying resubmission memo for revision descriptions. mummer

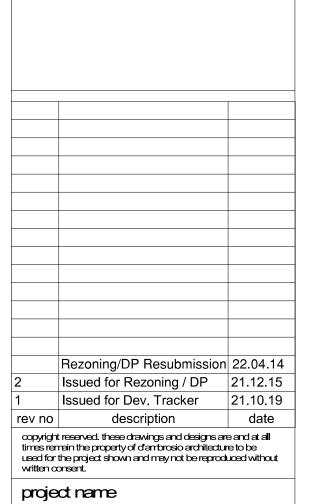


Montreal and Quebec 205 Quebec Street Victoria, BC

sheet title


West Bevation

project no. 1:100 drawn by date issued A3.3. **xx/11/21**



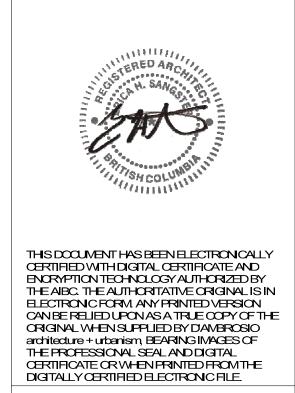

Please refer to the accompanying resubmission memo for revision descriptions.

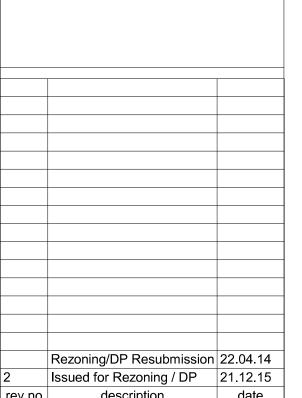

Rezoning/DP Resubmission 22.04.14

2 Issued for Rezoning / DP 21.12.15

rev no description date


copyright reserved, these drawings and designs are and at all times remain the property of dambrosio architecture to be used for the project shown and may not be reproduced without written consent.

project name

Montreal and Quebec 205 Quebec Street Victoria, BC

sheet title Building Sections

project no.	#21-18	Σ
scale	1 : 100	2:33:02 PM
drawn by	RP	2:33
date issued	sheet no.	1-14
12/04/22	A4.0	2022-04-14

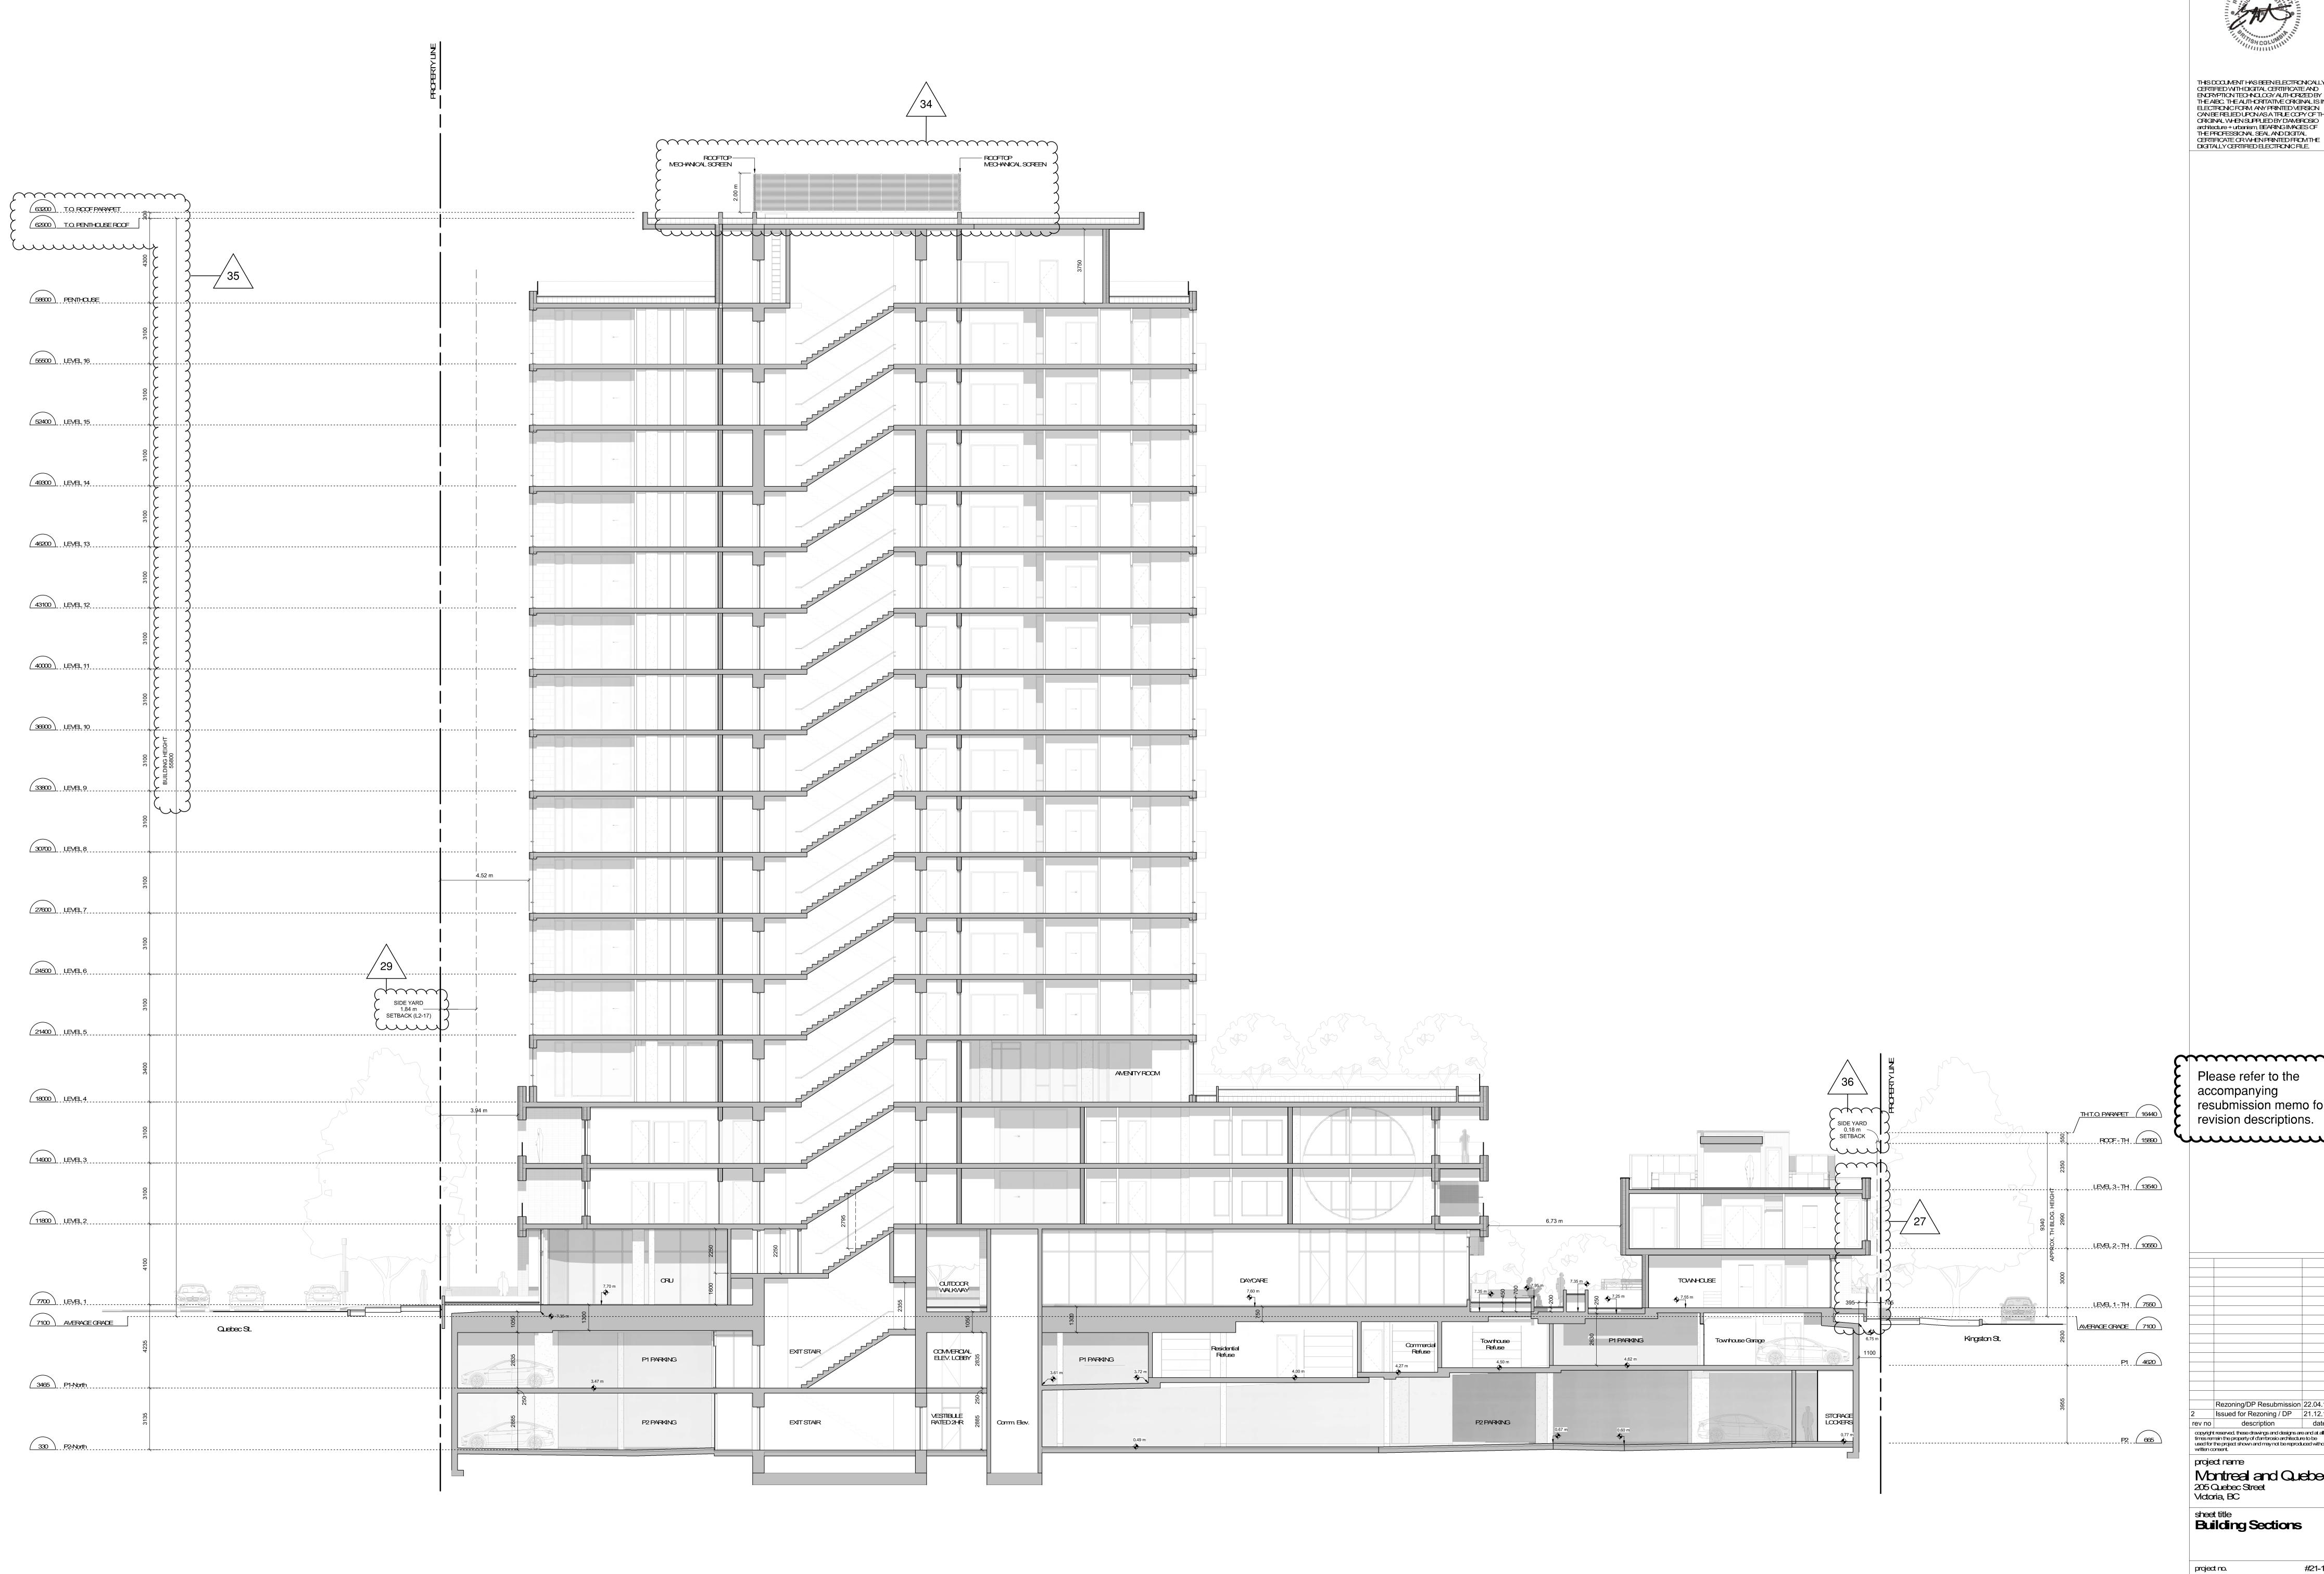


FRONT YARD 2.96 m 1800 LEVEL 3 1900 URARI 2

2 South Bevation - Townhouse 1:100


1 North Bevation - Townhouse



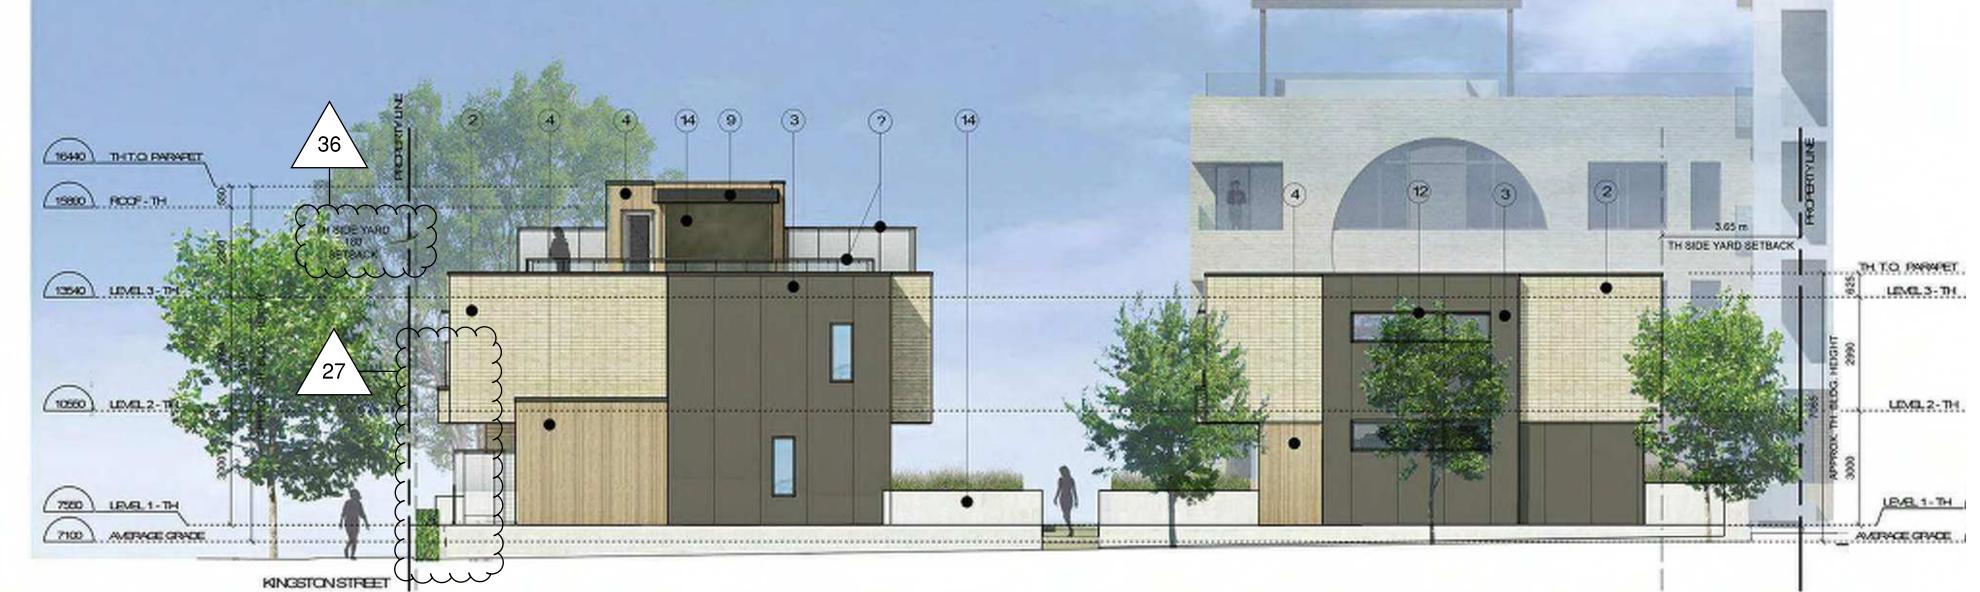

4 East Blevation - Townhouse



5 North Bevetion - Townhouse 1:100

D'AMBROSIO architecture + urbanism




THIS DOCUMENT HAS BEEN ELECTRONICALLY CERTIFIED WITH DIGITAL CERTIFICATE AND ENCRYPTION TECHNOLOGY AUTHORIZED BY THE AIBC. THE AUTHORITATIVE ORIGINAL IS IN ELECTRONIC FORM ANY PRINTED VERSION CAN BE RELIED UPON AS A TRUE COPY OF THE ORIGINAL WHEN SUPPLIED BY DAMBROSIO architecture + urbanism, BEARING IMAGES OF THE PROFESSIONAL SEAL AND DIGITAL CERTIFICATE OR WHEN PRINTED FROM THE DIGITALLY OERTIFIED ELECTRONIC FILE.

- ELEVATION MATERIALS KEY: 1 Cement Panel System Colour: Sandstone
- Running Bond Brick 2 Colour: Wheat
- Fibre Cement Panel Colour: Dark Grey 4 Pre-finished Vertical Wood Siding
- 5 Soffits: T&GWood
- 6 Class Quards in Pre-finished Aluminum Frames 7 Gazed Canopies: Laminated Gazing on Painted Steel Structure
- Calaur: Iran / Ore 8 Prefinished Metal Parapet Flashing Colour: Iron / Ore
- g Prefinished Metal Fascia Colour: Iron / Ore
- 10 Perforated Metal Balcony Quard Colour: Iron / Ore
- 11 Painted Metal Pergolas and Gates Colour: Iron / Ore
- Windoward Doors: Clear Glazing in Dark Anodized Aluminum Frames Colour: Iron / Ore
- 13 Gass Walls and Quards w Aluminum Frame Colour: Iron / Ore
- 14 Exposed Architectural Concrete
- 15 Prefinished Metal Louvers Colour: Iron / Ore

16 Prefinished Metal Panel Colour: Iron / Ore

resubmission memo for revision descriptions. 4 June 1

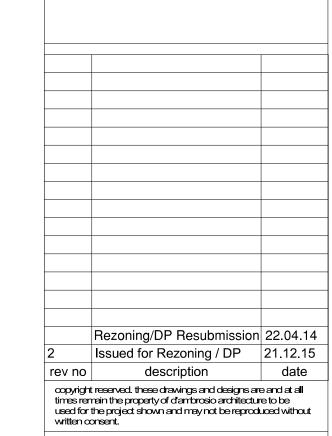

project name Montreal and Quebec 205 Quebec Street Victoria, BC


sheet title
Building Section / **Bevations**

#21-18 project no. 1:100 Author drawn by sheet no. date issued A4.2. **xx/11/21**


Mike Geric Construction

Quebec & Montreal


Victoria, BC

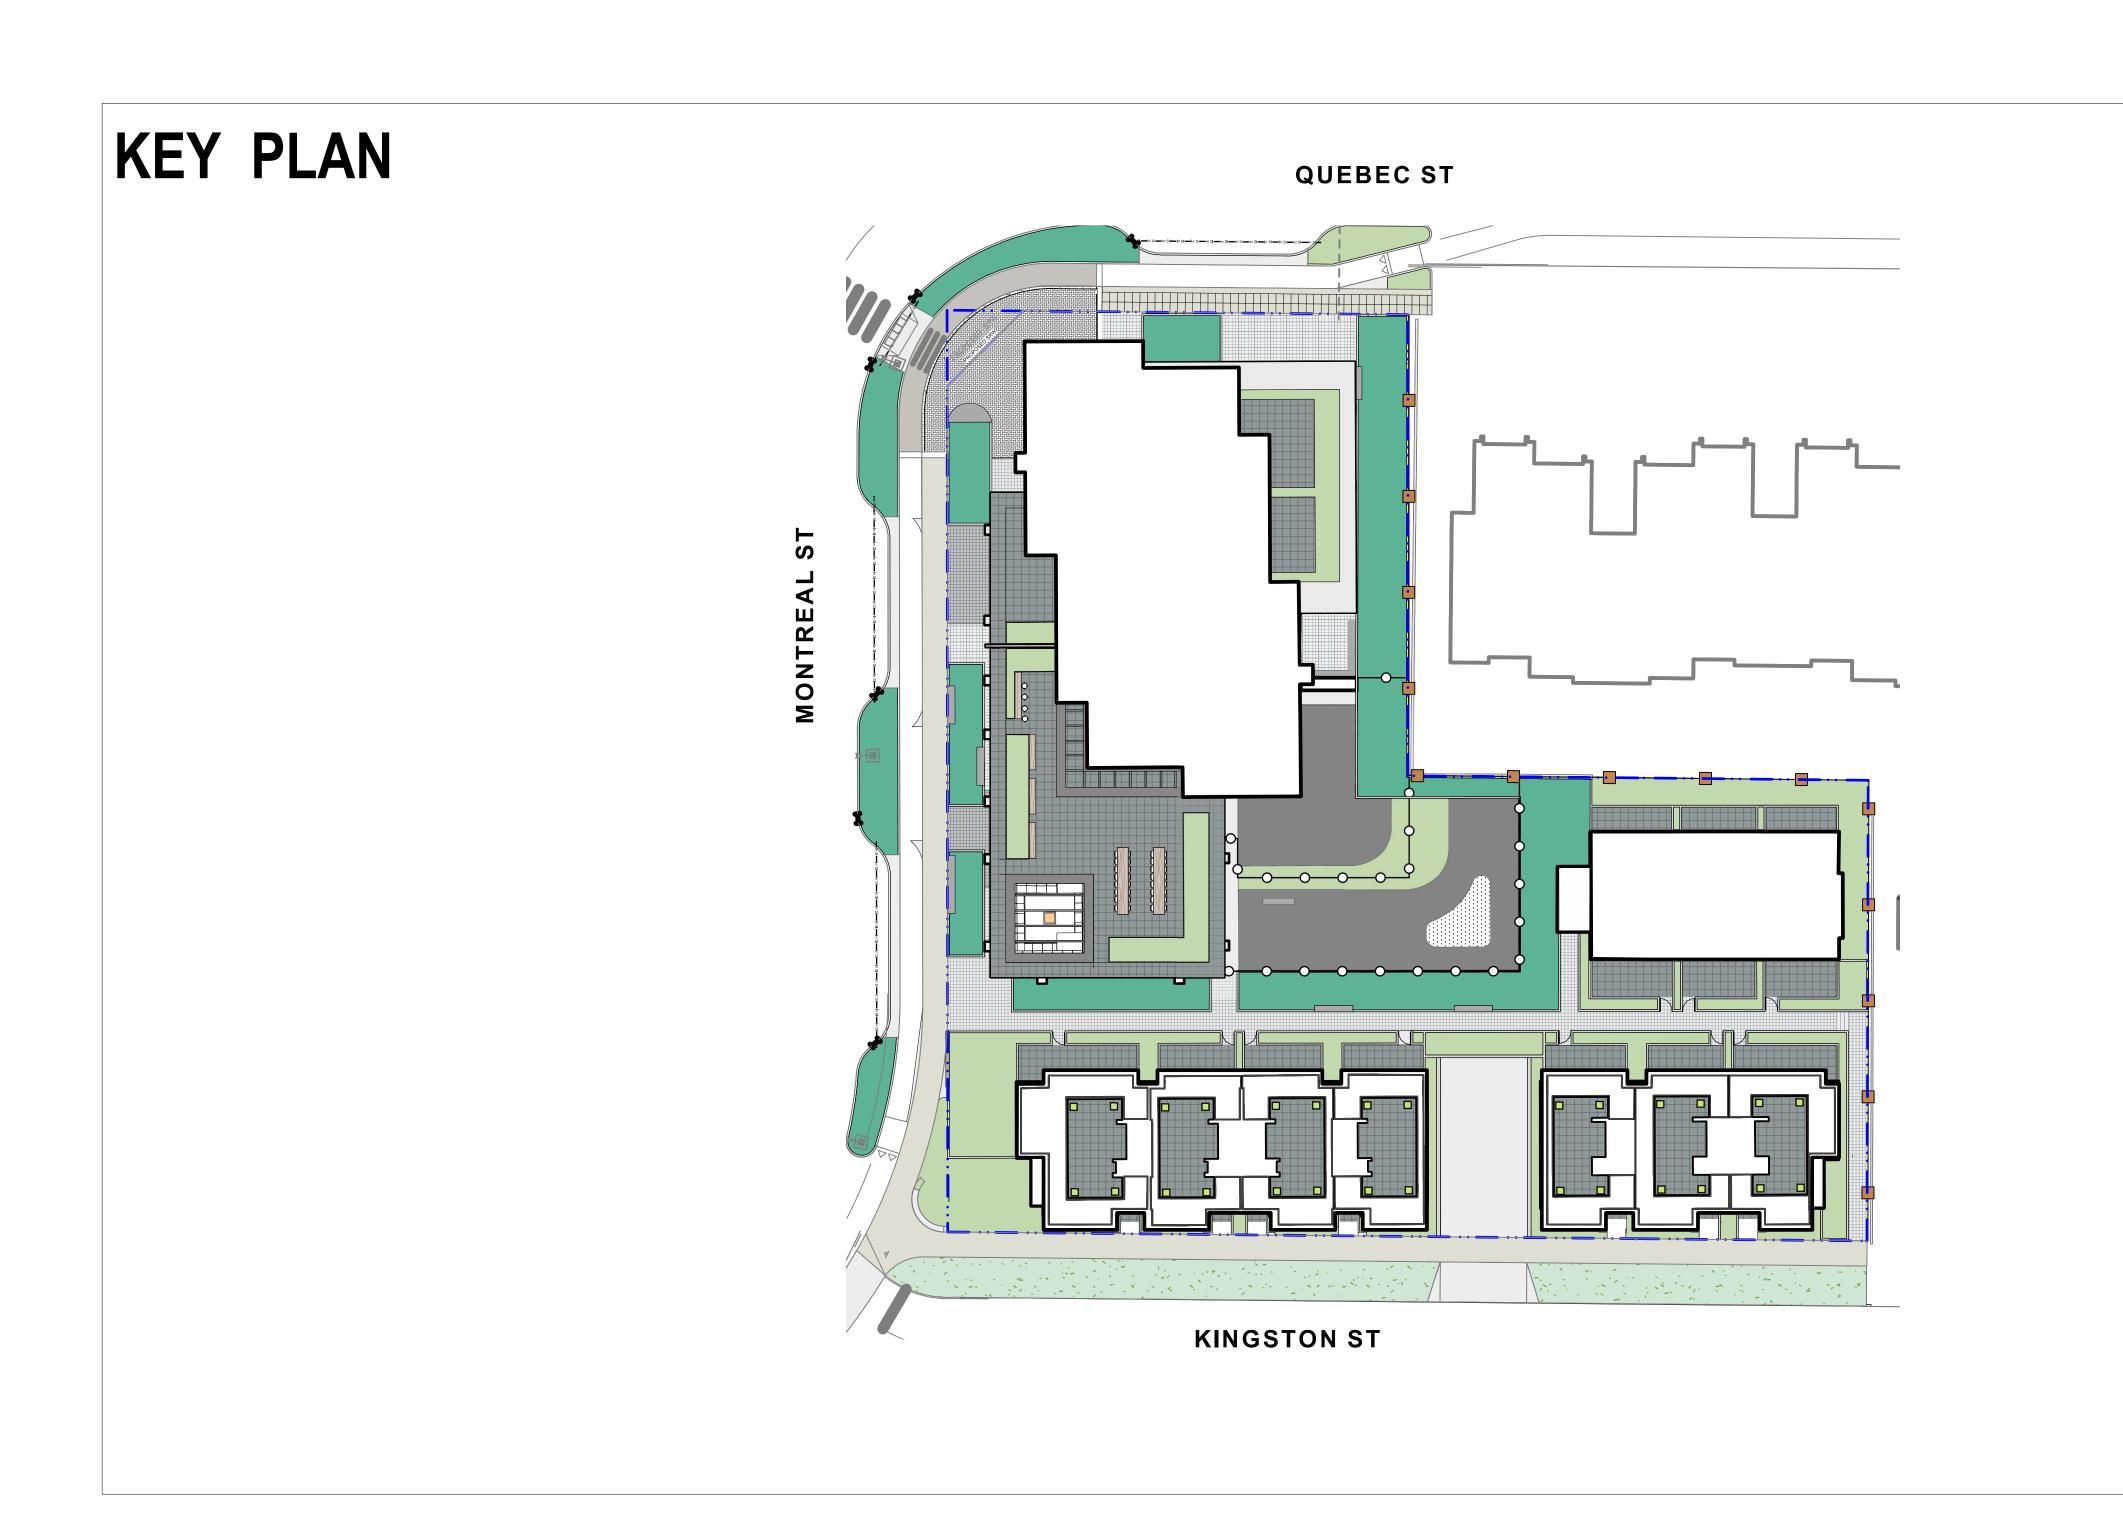

_andscape Sheets		
Sheet No.	Sheet Title	
L0.00	Cover	
L0.01	General Information Sheet	
L1.01	Landscape Materials - Ground	
L1.02	Landscape Materials - Roof	
L1.04	Landscape Precedents	
L1.05	Landscape Materials - Sections	
L1.06	Landscape Materials - Sections	
L1.03	Stormwater Management & Grading	
L1.07	Soil Volumes	
L3.01	Planting Plan	
L3.02	Planting Plan	
L0.02	Tree Survey Plan	
L0.03	Tree Management Plan	
L4.01	Landscape Details	

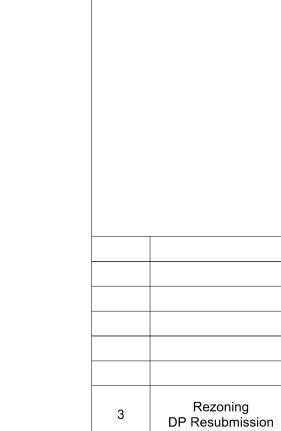



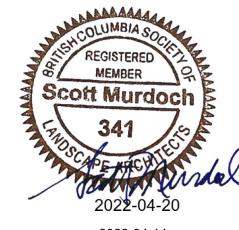

Mike Geric Construction 4520 West Saanich Rd Saanich, BC

QUEBEC & MONTREAL DEV. 501-502 MONTREAL ST. VICTORIA, BC

sheet title

Cover

project no.		121.23
scale	1: ###	@ 24"x36"
drawn by		MDI
checked by		SM
revison no.	sheet no.	
3	L	.0.00

GENERAL NOTES

- 1. Work performed shall comply with the following: a) These General Notes, and Construction Documents and Specifications; b) Canadian Landscape Standards, Current Edition (CLS-CE); and c) All applicable local, provincial, and federal codes, ordinances, and regulations.
- 2. Contractor shall be responsible for verifying all existing site conditions including location of all property lines, existing structures, utilities, and buried infrastructure. Verify all field conditions prior to commencing work.
- 3. Contractor is responsible for determining means and methods for construction. These drawings may indicate a limit of proposed improvements or limit of work for the delineation of expected extents of disturbance. Should limits of disturbance exceed boundaries defined in drawings, contractor shall contact Landscape Architect for resolution.
- 4. Contractor is responsible for repairing all work disturbed by construction outside of limit lines defined on drawings or through their means and methods to a condition better than or equal to the existing conditions prior to commencement of construction at no additional cost to the owner.
- 5. Contractor is responsible for maintaining a complete up-to-date set of drawings and specifications at the construction site and ensuring the documents are readily available for review by the Landscape Architect and governing agency. 6. Contractor is responsible for coordination of all designs, drawings, specifications and other documents
- or publications upon which construction is based. Any discrepencies with the drawings and/or specifications and site conditions shall be brought to the attention of the Landscape Architect, prior to
- 7. The drawings and specifications are complementary to one another and implied to correspond with one another. Any discrepencies should be brought to the attention of the Landscape Architect for resolution immediately.
- 8. General Contractor and/or sub-contractors are responsible for all costs related to production and submission to consultant of all landscape as-built information including irrigation.

TREE RETENTION AND REMOVAL NOTES

- 1. Tree protection fencing, for existing trees, to be installed prior to commencement of all site work. Refer to Arborist's plans for location of tree protection fencing, and protection fencing detail.
- Refer to arborist's report for detailed information for existing tree resources.

SITE GRADING AND DRAINAGE NOTES

- . All elevations are in meters.
- 2. Refer to Architectural plans, sections and elevations for top of slab elevations. Slab elevations indicated on Landscape drawings are for reference only. Report any discrepancies to consultant for
- 3. All road, public walkway and vehicular drive aisles and parking area elevations indicated on the Landscape drawings are for reference only. Refer to Civil Engineering drawings. Report any discrepancies to consultant for review and response.
- 4. Confirm all existing grades prior to contruction. Report any discrepancies to consultant for review and
- Unless otherwise noted provide a minimum slope of 2% on all hard and soft Landscape areas to ensure positive drainage away from buildings, to rain gardens, or to drainage devices.
- 6. All landscape areas shall not exceed a maximum slope of 3:1 in all instances.
- 7. Upon discovery, contractor to refrain from blasting rock to meet landscape subgrades. Contractor to contact Landscape Architect on how to proceed in each instance.

- Contractor to provide irrigation system for all planters to current IIABC Standards and Contract
- All specified work to meet the project specifications, and all standards or specifications established in the lastest edition of the Canadian Landscape Standard and IIABC standards.
- Design/build drawings for detailed irrigation plan to be submitted to Contract Administrator in PDF and ' .dwg formats at least two weeks prior to commencement of irrigation installation
- Utilties Contractor to verify location of all on-site utilities, prior to construction. Restoration of damaged utilities shall be made at the contractor's expense, to the satisfaction of the owner's representatives.

Refer to electrical drawings for electrical service.

- 6. Controller and backflow prevention device to be located in Mechanical Room, unless otherwise noted. Refer to Mechanical drawings for size and location of irrigation service.
- Contractor to verify pressure and flow prior to installation of irrigation and notify owner's representative in writing if such data adversely affects the operation of the system.
- Sleeves shall be installed at the necessary depths, prior to pavement construction. Sleeving shall extend 300 mm from edge of paving into planting area, and shall have ends marked above grade unless otherwise shown.
- Contractor to field fit irrigation system around existing trees, to limit disturbance to root systems. 10. At various milestones during construction, inspection and testing of components will be required to ensure that the performance of irrigation system meets standards and specifications. Contractor to provide equipment and personnel necessary for performance of inspections and tests. Conduct all inspections and tests in the presence of the contract administrator. Keep work uncovered and
- accessible until successful completeition of inspection or test. 11. Over spray onto hardscape areas to be minimized. Use drip irrigation within small planting areas to
- 12. Trees within shrub or rain garden areas to be irrigated with spray heads.
- 13. Trees in Plaza in hard pavement (soil cells below) to recieve temporary irrigation system around root collar and permanent drip irrigation system

GROWING MEDIUM NOTES

- 1. Refer to Landscape Specifications for growing medium properties by soil type.
- Advise Contract Administrator of sources of growing medium to be utilized 14 days in advance of
- 3. Growing medium properties and handling shall meet CLS-CE (see Section 6 CLS-CE).
- 4. Contractor is responsible for soil analysis and amendment requirements to supply suitable growing medium, as specified by testing agency. Soil analysis and amendment costs shall be included in the
- 5. Submit to the Landscape Architect a copy of the soil analysis report from Pacific Soil Analysis Inc. 5-11720 Voyageur Way, Richmond, BC, V6X 3G9. p. 604- 273-8226. The analysis shall be of tests done on the proposed growing medium from stratified samples taken from the supply source. Costs of the initial and all subsequent tests to ensure compliance with the specifications shall be borne by the Contractor.
- 6. Contract Administrator will collect sample of growing medium in place and determine acceptance of material, depth of growing medium and finish grading. Approval of growing medium material subject to soil testing and analysis. Planting is not to occur until finished grades have been approved by Contract Administrator.

SITE LAYOUT NOTES

- 1. Provide layout of all work for approval by Contract Administrator prior to proceeding with work. Requests for site review as required 48 hours in advance of performing any work, unless otherwise
- 2. Layout and verify dimensions prior to construction. Bring discrepancies to the attention of the Contract
- Administrator.
- 3. Written dimensions take precedence over scale. Do not scale drawings.
- 4. All plan dimensions in metres and all detail dimensions in millimetres, unless otherwise noted. 5. Where dimensions are called as 'equal' or 'eq', space referenced items equally, measured to centre

- **GENERAL PLANTING NOTES** 1. Plant quantities on Plans shall take precedence over plant list quantities.
- 2. Provide layout of all work for approval by Contract Administrator prior to proceeding with work. 3. Plant material, installation and maintenance to conform to the current edition of the Canadian
- Landscape Standard
- 4. Plant quantities and species may change between issuance of DP and Construction due to plant
- availability and design changes. 5. Landscape installation to carry a 1 year warranty from date of acceptance. This warranty is based on adequate maintenance by the Owner after Acceptance. The Contractor will not be responsible for plant loss due to extreme climatic conditions such as abnormal freezing temperatures or hail which occur after Acceptance. The Contractor shall be responsible for plant loss due to inadequate acclimatization of plants for their planted location.

ON-SLAB TREE PLANTING NOTES

- 1. For on-slab landscape, a root barrier will be installed to protect exposed water proof membranes. A dimple board (drain mat) will be installed over the root barrier.
- 2. Parkade walls and foundation walls will be protected with a dimple board (drain mat) to convey water
- to the perimeter drain and protect wall from roots.
- 3. A root barrier will be installed between the tree roots and perimeter drain, to minimize tree root interference with the drain, where the follow conditions exist in on-grade planting areas: a)where trees less than 8m tall are located closer than 2m from a parkade or foundation wall; b) where trees more than 8m tall are located closer than 3m from a parkade or foundation wall; and c) where perimeter drains are less than 2m deep.

BOULEVARD PLANTING NOTES

- 1. Boulevard trees have been placed to avoid existing and proposed infrastructure. Trees planted within 1m of an existing underground municipal service will have a root barrier installed between the root ball and the existing infrastructure.
- 2. Boulevard trees will be place a minimum of 1.5m from an above ground municipal service such as fire hydrant, streetlight or driveway.
- 3. Boulevard tree species have been picked from the municipality's list of recommended boulevard trees or have been selected due their site-adapted qualities. Final selection of boulevard trees to be determined through consultation with municipal parks staff.
- 4. Irrigation to be installed as per Municipal Specifications, for all boulevard planting areas (unless otherwise indicated).
- 5. Design/build drawings for boulevard irrigation to be submitted to Contract Administrator in PDF and .dwg formats, at least two weeks prior to commencement of irrigation installation and will be reviewed
- 6. Refer to Civil drawings for location of boulevard irrigation point of connection. Separate water meter and timer/controller, to be provided at point of connection. Timer/controller for boulevard areas must be readily accessible to municipal staff.
- Boulevard irrigation to be inspected as per municipal specification by municipal staff. Boulevard tree irrigation system will be maintained and operated by municipality, after it is inspected and approved by
- 8. Soil volume for boulevard trees to be as follows: 8 cu. m. for small trees, 12 cu. m. for medium trees, and 16 cu. m. for large trees.

LIST OF ABBREVIATIONS

	<u></u>	M	METRE
ADDDOV	ADDDOVIMATE	MAX	MAXIMUM
APPROX	APPROXIMATE	MH	MANHOLE
ARCH	ARCHITECT	MIN	MINIMUM
AVG	AVERAGE	MISC	MISCELLANEOUS
B&B	BALLED AND BURLAPPED	MM	MILLIMETRE
BC	BOTTOM OF CURB	N	NORTH
BLDG	BUILDING	NIC	NOT IN CONTRACT
BM	BENCHMARK	NO	NUMBER
BC	BOTTOM OF CURB	NOM	NOMINAL
BR	BOTTOM OF RAMP	NTS	
BS	BOTTOM OF STEP		NOT TO SCALE
BW	BOTTOM OF WALL	OC	ON CENTER
CAL	CALIPER	OD	OUTSIDE DIAMETER
CB	CATCH BASIN	PC	POINT OF CURVATURE
CF	CUBIC FEET	PE	POLYURETHANE
CIP	CAST IN PLACE	PI	POINT OF INTERSECTION
		PL	PROPERTY LINE
CL	CENTER LINE	PT	POINT, POINT OF TANGENCY
CLR	CLEARANCE	PVC	POLYVINYL CHLORIDE
CM	CENTIMETER	QTY	QUANTITY
CO	CLEAN OUT	R	RADIUS
CONT	CONTINUOUS	REF	REFERENCE
CU M	CUBIC METRE	REINF	REINFORCE(D)
DEG	DEGREE	REQ'D	REQUIRE(D)
DEMO	DEMOLISH, DEMOLITION		
DIA	DIAMETER	REV	REVISION
DIM	DIMENSION	ROW	RIGHT OF WAY
DTL	DETAIL	S	SOUTH
DWG	DRAWING	SAN	SANITARY
E	EAST	SD	STORM DRAIN
EA	EACH	SF	SQUARE FOOT (FEET)
EL	ELEVATION	SHT	SHEET
		SIM	SIMILAR
ENG	ENGINEER	SPECS	SPECIFICATIONS
EQ	EQUAL	SQ M	SQUARE METRE
EST	ESTIMATE	ST	STORM SEWER
E.W.	EACH WAY	STA	STATION
EXIST	EXISTING	STD	STANDARD
EXP	EXPANSION, EXPOSED	SYM	SYMMETRICAL
FFE	FINISHED FLOOR ELEVATION	T&B	TOP AND BOTTOM
FG	FINISHED GRADE	TC	TOP OF CURB
FL	FLOW LINE	TF	TOP OF FOOTING
FOC	FACE OF CURB	TH	THICK
FT	FOOT (FEET)		
FTG	FOOTING	TOPO	TOPOGRAPHY
GA	GAUGE	TR	TOP OF RAMP
GEN	GENERAL	TS	TOP OF STEP
GR	GRADE ELEVATION	TW	TOP OF WALL
HORIZ	HORIZONTAL	TYP	TYPICAL
		VAR	VARIES
HP	HIGH POINT	VOL	VOLUME
HT	HEIGHT	W	WITH
ID	INSIDE DIAMETER	W/O	WITHOUT
INV	INVERT ELEVATION	WT	WEIGHT
IN	INCH(ES)	WL	WATER LEVEL
INIOI	INICI LIDE(D)	* * -	**/ \ L \ L L V L L

DRAWING NOTES

INCLÙDÉ(D)

LINEAR FEET

LOW POINT

1. DO NOT SCALE DRAWING: Verify all property lines and existing structures/vegetation to remain, prior to commencing work.

WWF

YD

YARD

WELDED WIRE FRAME

- 2. All plan dimensions in metres and all detail dimensions in millimetres. 3. Plant quantities on Plans shall take precedence over plant list
- 4. Contractor to confirm location and elevation of all existing services and utilities prior to start of construction.
- 5. Provide layout of all work for approval by Landscape Architect prior to proceeding with work.
- 6. Contractor to provide irrigation system for all planters to current IIABC Standards and Contract Specifications. Boulevard irrigation system to meet City of Victoria Supplementary Specification for Street Trees and Irrigation Bylaw.
- 7. Landscape installation to carry a 1 year warranty from date of
- 8. Plant material, installation and maintenance to conform to the current edition of the Canadian Landscape Standard.
- 9. General Contractor and/or sub-contractors are responsible for all costs related to production and submission to consultant of all landscape as-built information including irrigation.

10. Tree protection fencing, for existing trees, to be installed prior to commencement of all site work

MATERIALS LEGEND

HARDSCAPE



CIP Concrete Light Broom finish with tooled control joints.

CIP Concrete Light Broom Radial Concrete Control Joints

Standard Paver 8x8 tile pattern, colour Charcoal

8x8 tile pattern, colour Natural

Standard Paver

'Texada' Hydrapressed Slabs. 457 mm x 457 mm x40 mm. Charcoal colour. Square Grid. Supplier: Abbotsford Concrete. Nonpermeable.

HARDSCAPE: CITY STANDARDS

See 'Downtown Public Realm Plan & StreetScape Standards', Section 5.1.1 Inner Harbour, for details.

Trowel Joint Concrete. See L4.01 For Pattern Details

1.9

Granite Pavers @ 300mm x 100mm x 80mm. Mortar set. Paving field. Grey granite.

Flamed Finish. Nonpermeable.

Grey Basalt Entry Band Sandblasted Street name insert 450mm width, Font Tisa Bro Bold -

All caps, Finish Flamed

Granite Pavers Solider Course Border 200mm

DAYCARE

Design TBD by imput from Daycare provider

2.2

Safety Surfacing

Granite Pavers


 $\langle 3.0 \rangle$ WALLS

Concrete Retaining Wall - On Grade

Concrete Bench

Concrete Flush Curb - See Civil.

FURNISHINGS

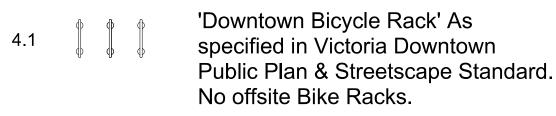

4.2

4.3

Fire pit

Trash Bin

Benches

Shed. See Architecture.

FENCES AND BARRIERS 1800mm Wood Fence Picket Fence See Arch and Electrical LANDSCAPE MATERIAL Shrub Area Rain Garden (See Dwg 1 L1.03 & 4.01)

LINE TYPE LEGEND

Property line Extent of Parkade, below Pedestrian Sightline

UNDERGROUND UTILITIES

(Shown for reference only - refer to Civil Engineer's drawings).

Civil Typical Inlet Drain

TOC Top of Curb

TP Top of Pool

BC Bottom of Curb

GRADING LEGEND

Existing Landscape Grade Civil Grade, provided for reference only

Architectural grade, provided for reference Proposed Landscape Grade TOW Top of Wall BW Bottom of Wall TS Top of Stairs

IRRIGATION LEGEND



Irrigation Point of Connection Proposed Irrigation Point of Connection. Provide water service and electrical service from irrigation controller to valves.

BS Bottom of Stairs

HP High Point

LP Low Point

— Irr SI — Irr SI —

Irrigation Sleeve Schedule 40 PVC, dia. shall be min 3x main line diameter, or 2x lateral line diameter. Install irrigation wiring in separate 2" electrical conduit. Extend sleeve 300 mm past edge of hard surface or walls.

LANDSCAPE DRAINAGE LEGEND




DRAINS BY OTHERS







Mechanical Drains (For reference only)

Aco K100 Trench Drain, Load Class 'A'.

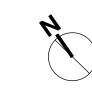

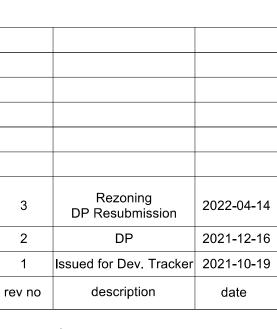



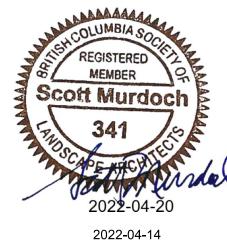


Mike Geric Construction 4520 West Saanich Rd Saanich, BC


QUEBEC & MONTREAL DEV. 501-502 MONTREAL ST. VICTORIA, BC

General Information Sheet

sheet title

121.23 project no. 1: ### @ 24"x36" scale MDI drawn by checked by revison no. sheet no. L0.01 /3

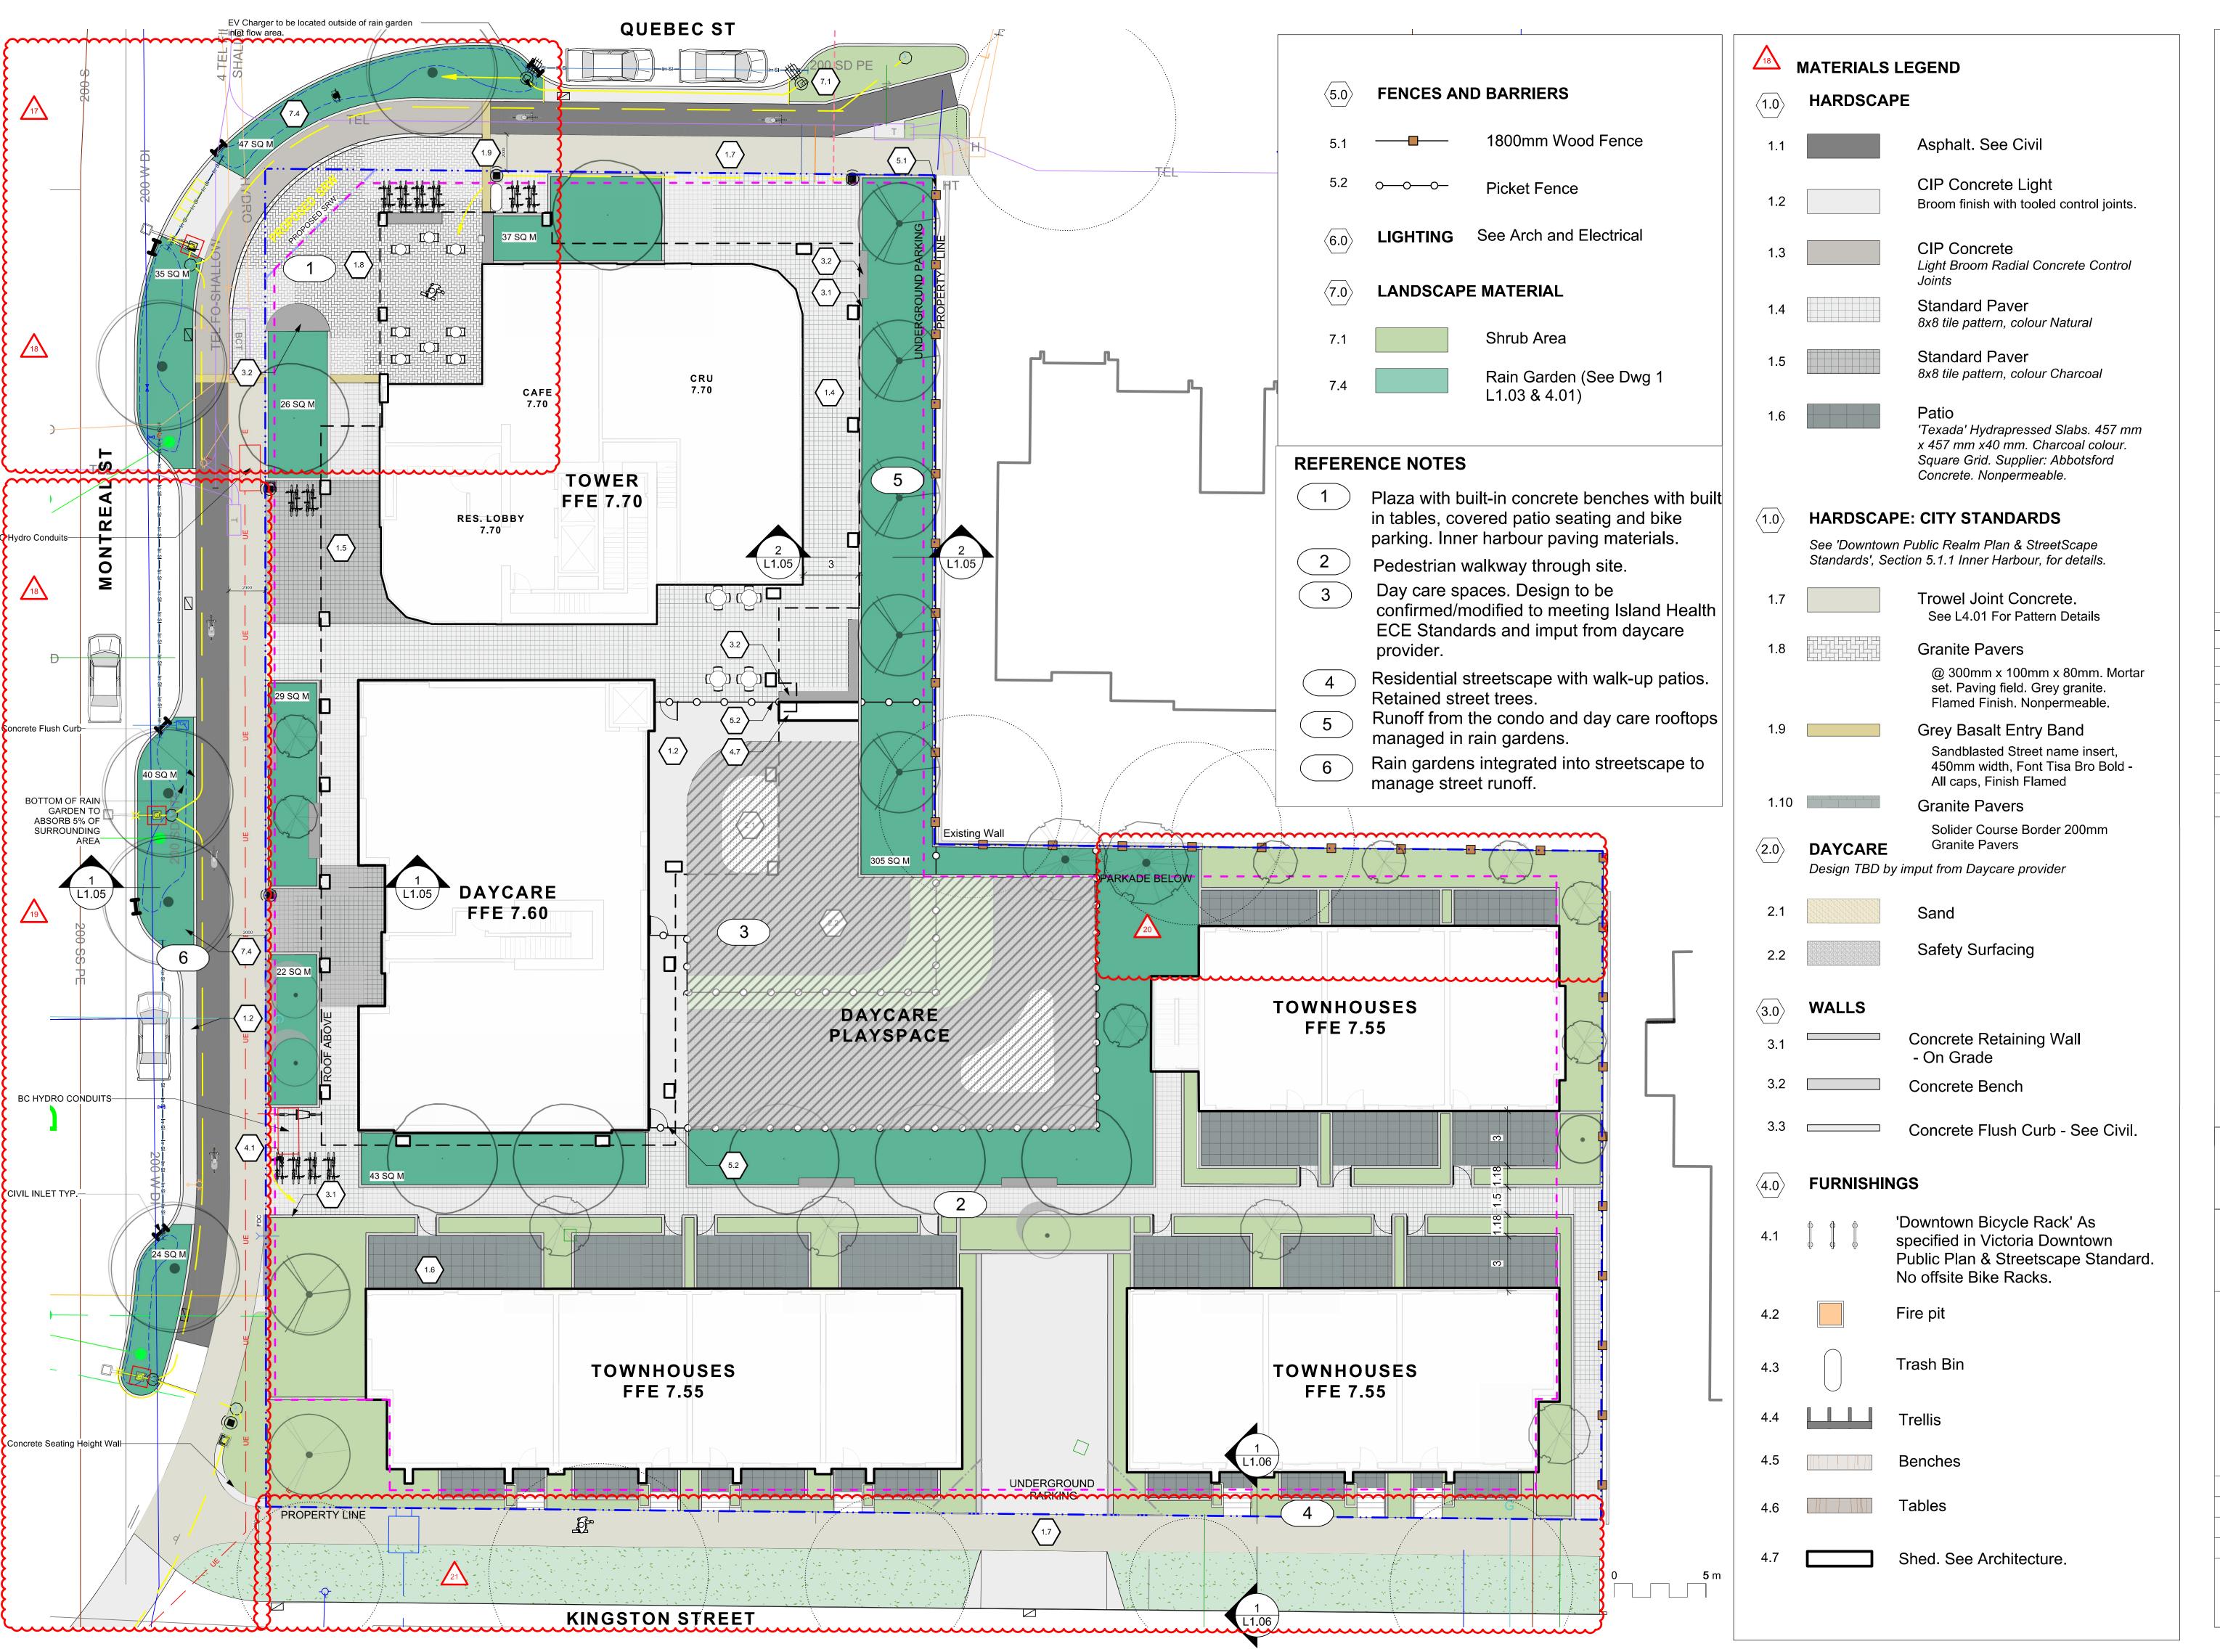

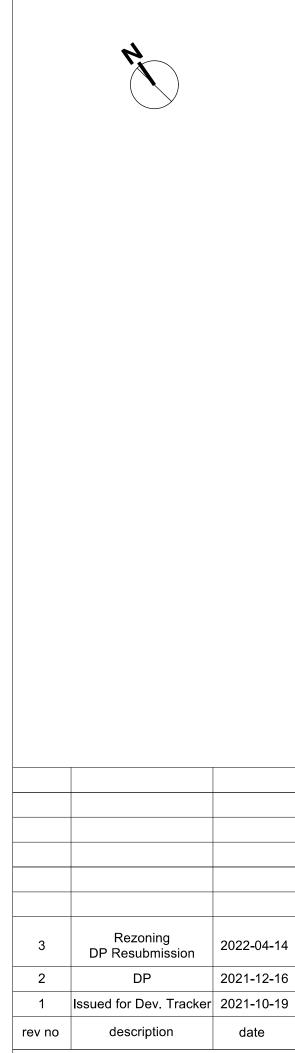



Murdoch

de Greeff INC

2022-04-20 2022-04-14


Mike Geric Construction 4520 West Saanich Rd Saanich, BC


QUEBEC & MONTREAL DEV. 501-502 MONTREAL ST. VICTORIA, BC

sheet title

Landscape Materials - Ground

project no.		121.23
scale	1:150	@ 24"x36"
drawn by		MDI
checked by		SM
revison no.	sheet no.	
3	L	1.01

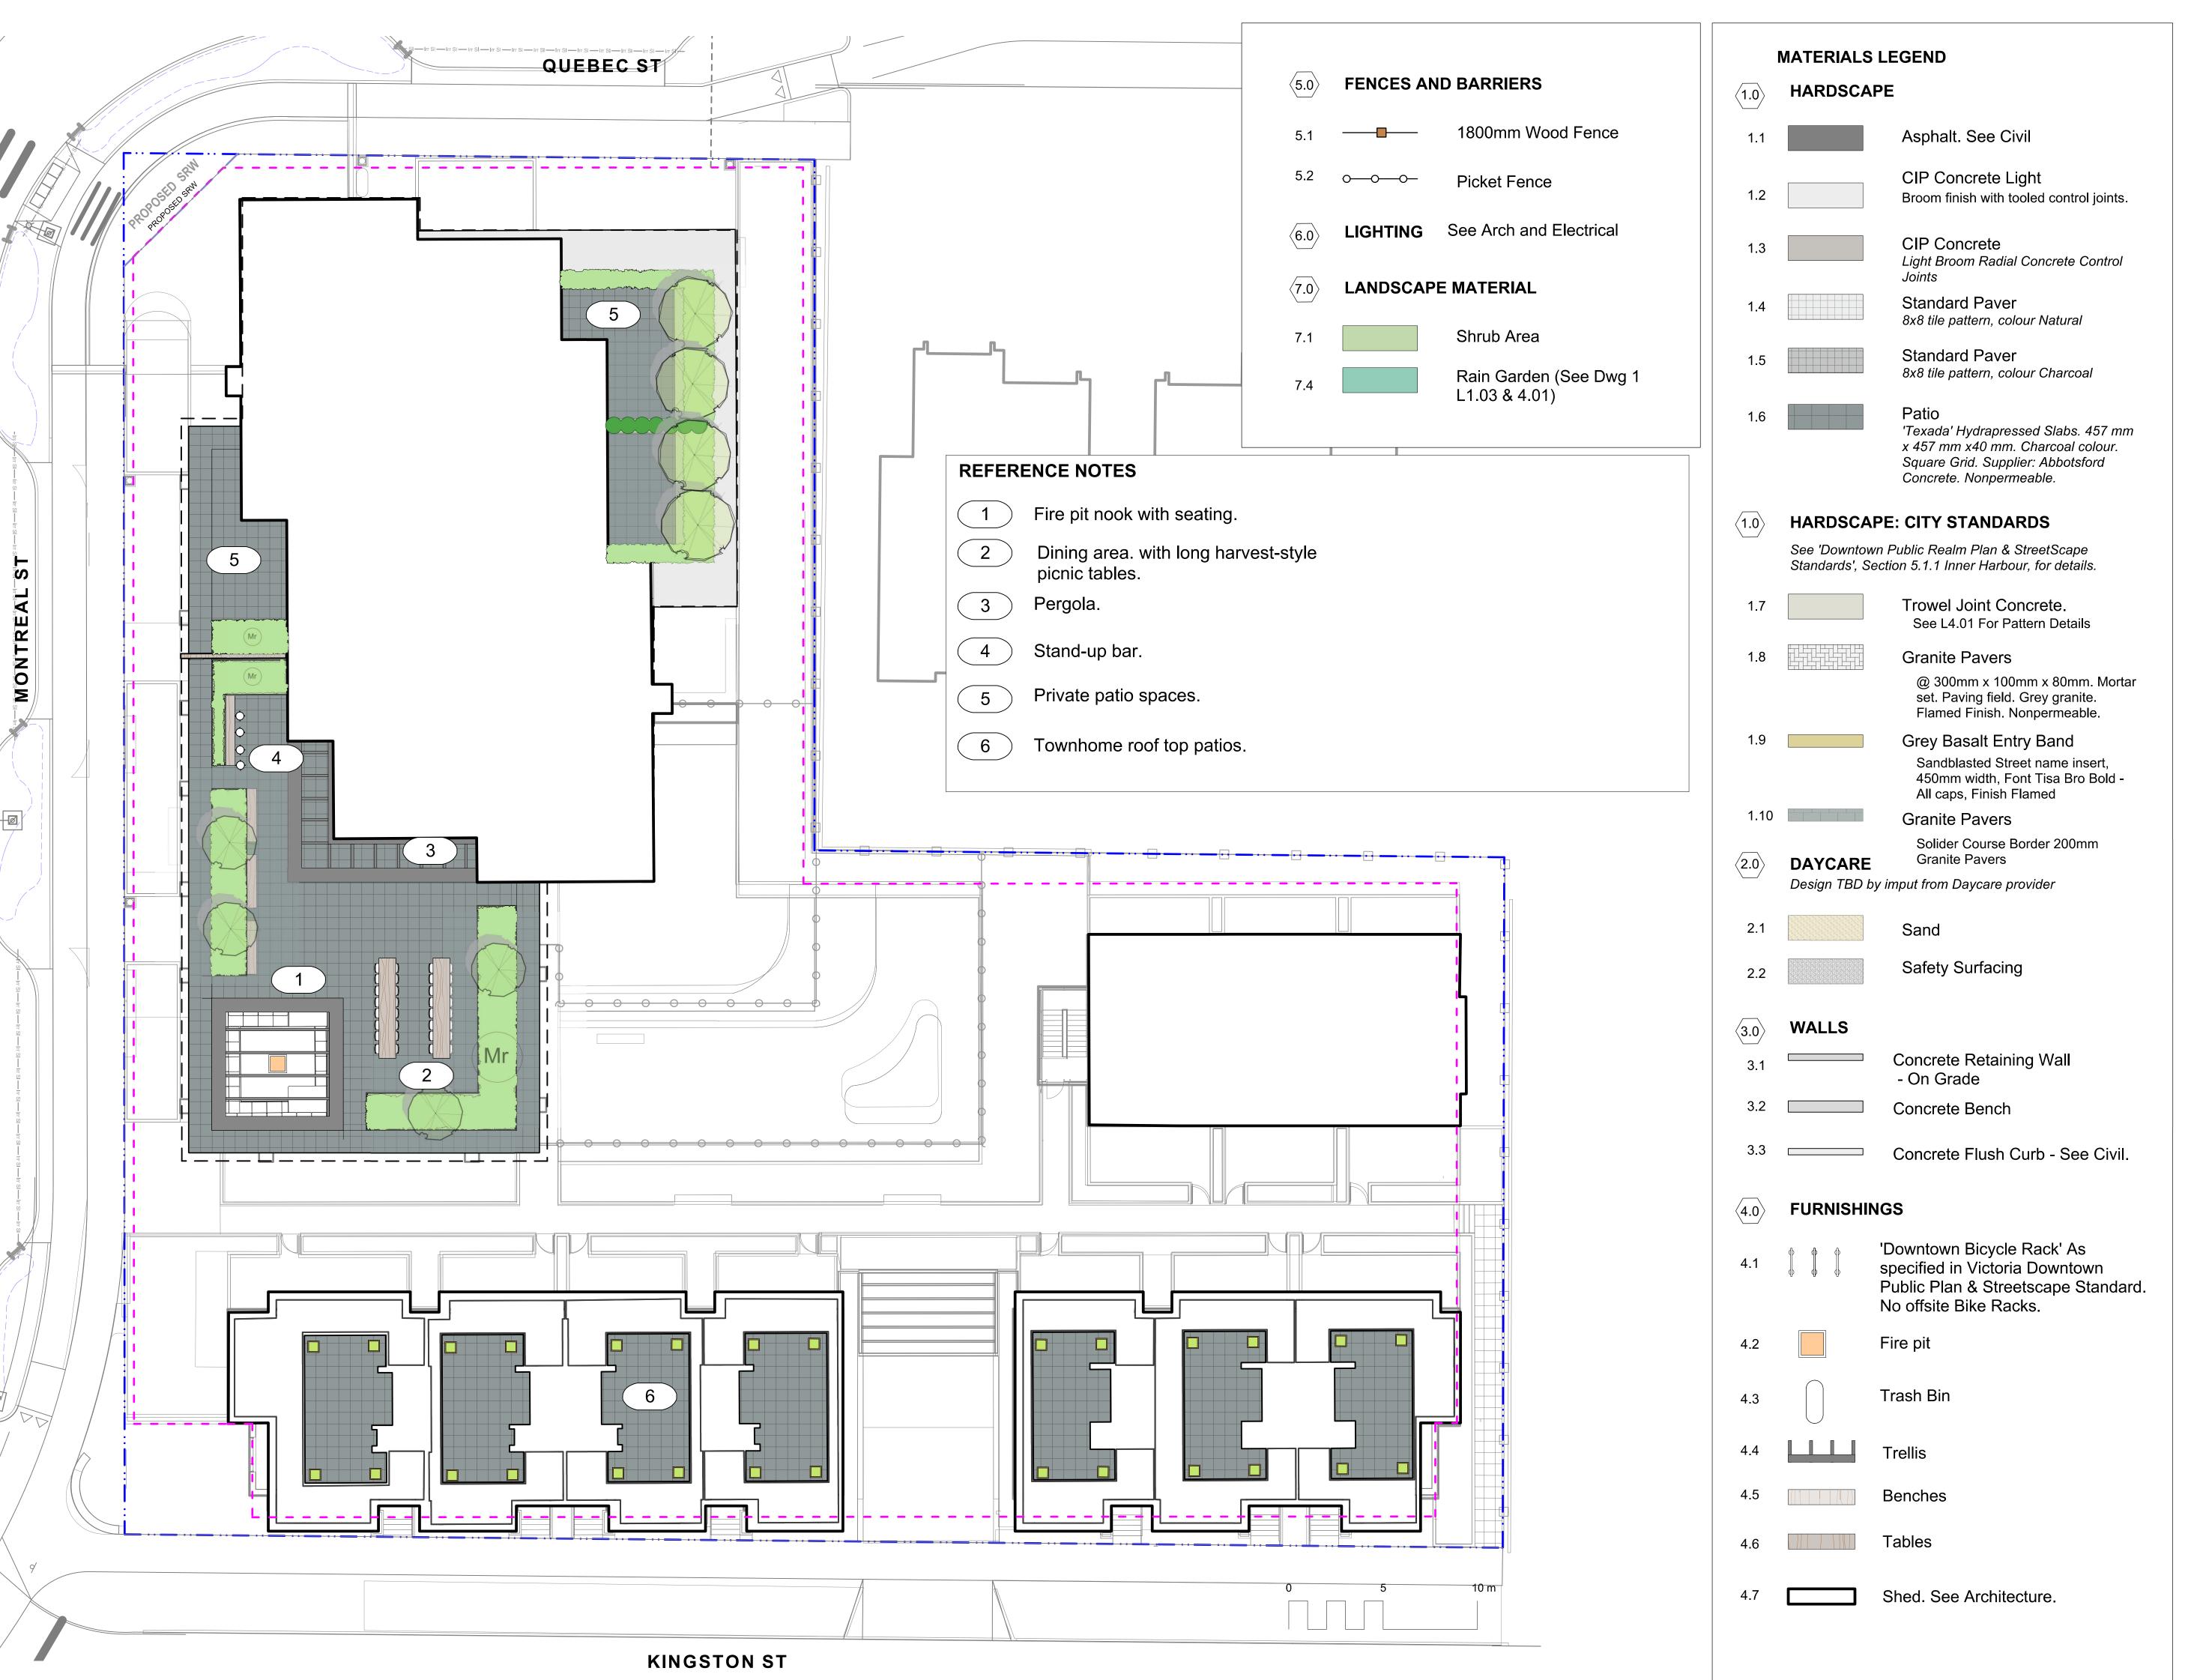

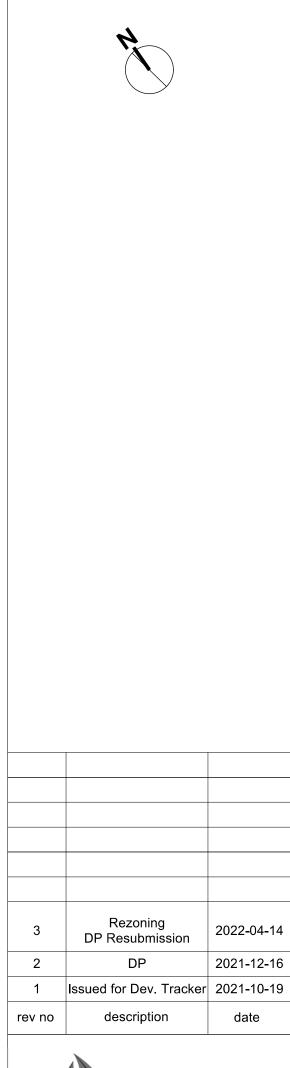





2022-04-14


Mike Geric Construction 4520 West Saanich Rd Saanich, BC

QUEBEC & MONTREAL DEV. 501-502 MONTREAL ST. VICTORIA, BC

sheet title

Landscape Materials - Roof

project no.		121.23
scale	1:150	@ 24"x36
drawn by		MDI
checked by		SM
revison no.	sheet no.	
3	L	_1.02

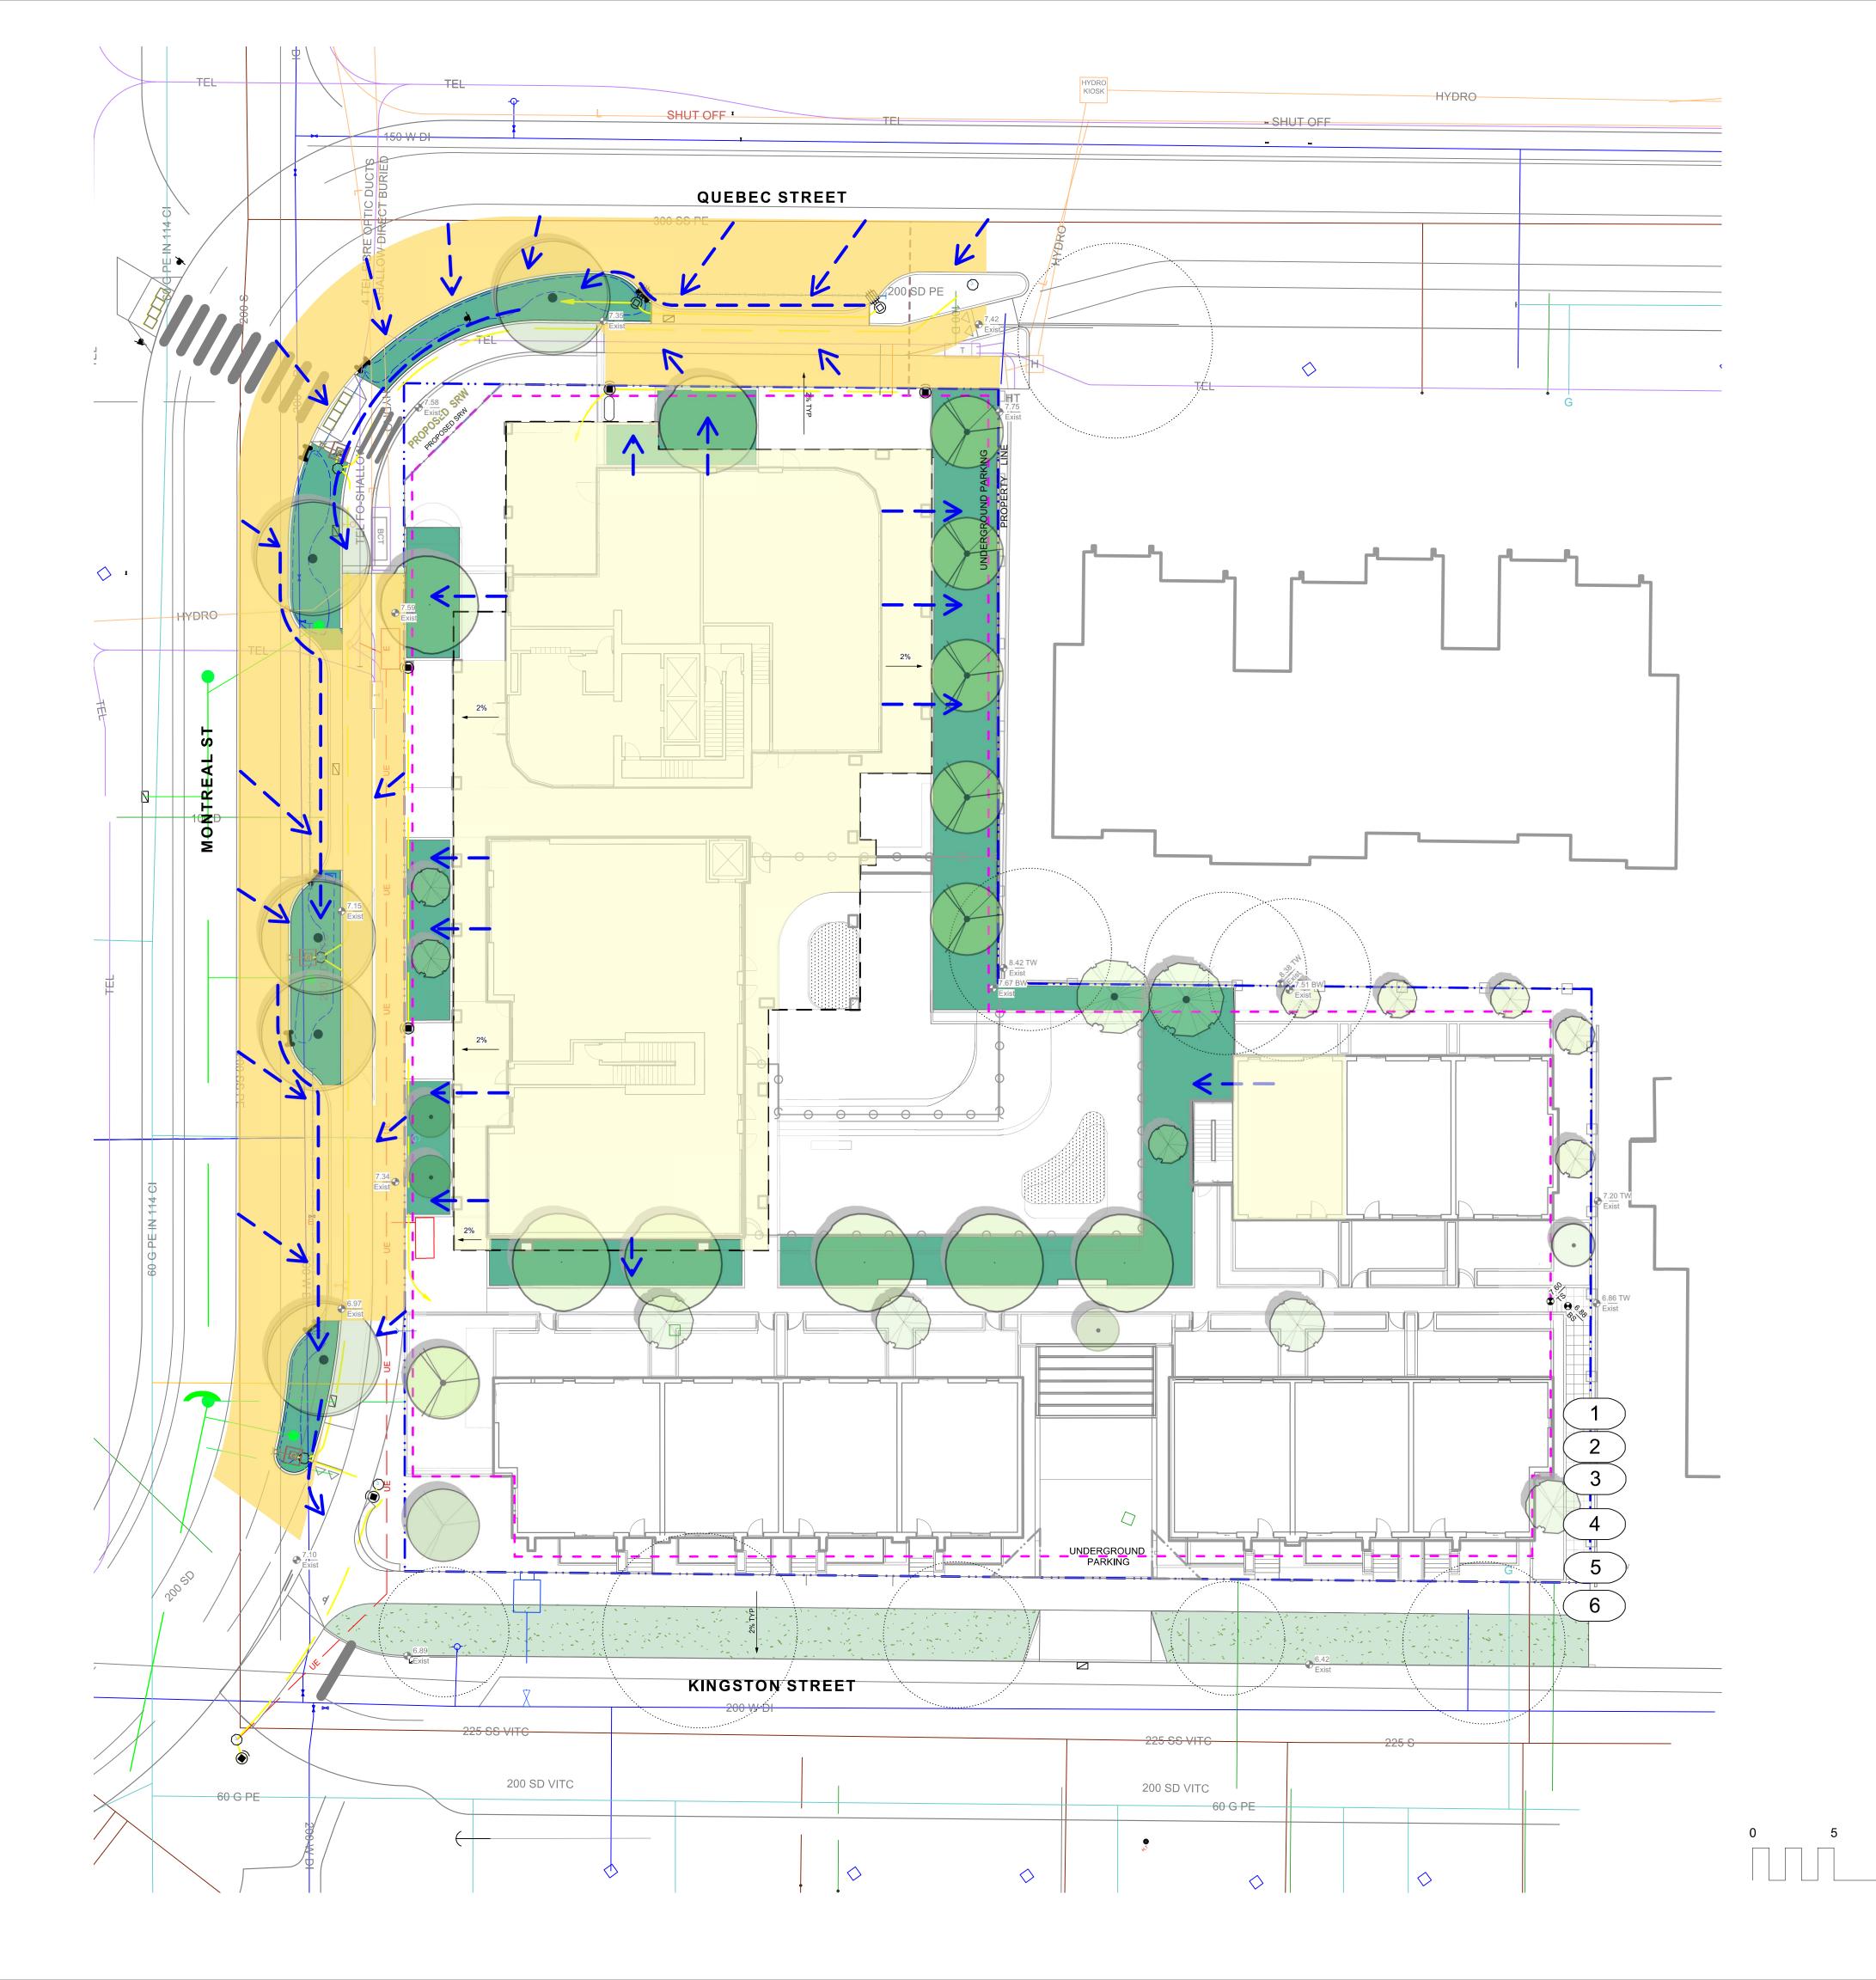



LEGEND PROPERTY LINE EXTENT OF UNDERGROUND PARKING (INDICATIVE) EXTENT OF ROOF / CANOPY LINE (INDICATIVE) RAIN GARDEN - TOP OF POOL _____ RAIN GARDEN - BOTTOM OF POOL EXISTING GRADE (APPROXIMATE) PROPOSED ARCH GRADE PROPOSED LANDSCAPE GRADE TP TOP OF POOL BP BOTTOM OF POOL DIRECTION OF FLOW RAIN GARDEN ON GRADE IMPERVIOUS AREAS ROOF DRAINS TO RAIN GARDEN ROAD / HARDSCAPE DRAINS TO RAIN GARDEN

RAIN WATER MANAGEMENT NOTES

Water collected from road areas, building roofs, flow to the rain gardens located throughout the site.

Rain gardens are integrated building landscapes and landscape bulges within streetscape areas and are designed to capture, slow flows, and treat runoff from roadways.

Rain gardens will be designed with underdrains and a high-capacity overflow drain that will be connected to the onsite piped drainage system.

The rain gardens are sized such that the bottom of the rain garden is 5% of the impervious area to meet or exceed City of Victoria Green Stormwater Infrastructure Guidelines.


Boulevard rain gardens to be designed to City of Victoria Standards





GRADING NOTES

- 1. All grades slope 2% from the building to back of curb.
- 2. Slab grade varies
- 3. All landscape walls are an average of 500mm height.
- 4. Kingston St Townhouses require 3-4 risers to meet grade.
- 5. Proposed curb grades to be determined by Civil (proposed grades will be similar to existing grades. See Civil for details)
- 6. All sidewalk slope 2% to back of curb.

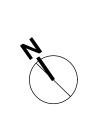

3	Rezoning DP Resubmission	2022-04-14
2	DP	2021-12-16
1	Issued for Dev. Tracker	2021-10-19
no	description	date



Murdoch

de Greeff INC


Mike Geric Construction 4520 West Saanich Rd Saanich, BC


QUEBEC & MONTREAL DEV. 501-502 MONTREAL ST.

VICTORIA, BC sheet title

Stormwater Management & Grading

revison no.	sheet no.	.1.03
checked by		SM
drawn by		MDI
scale	1: ###	@ 24"x36"
project no.		121.23

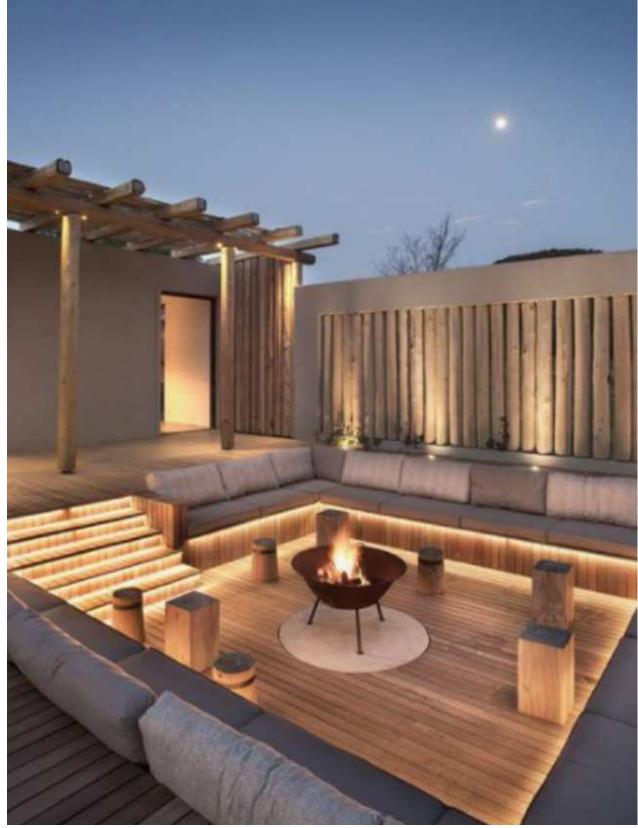

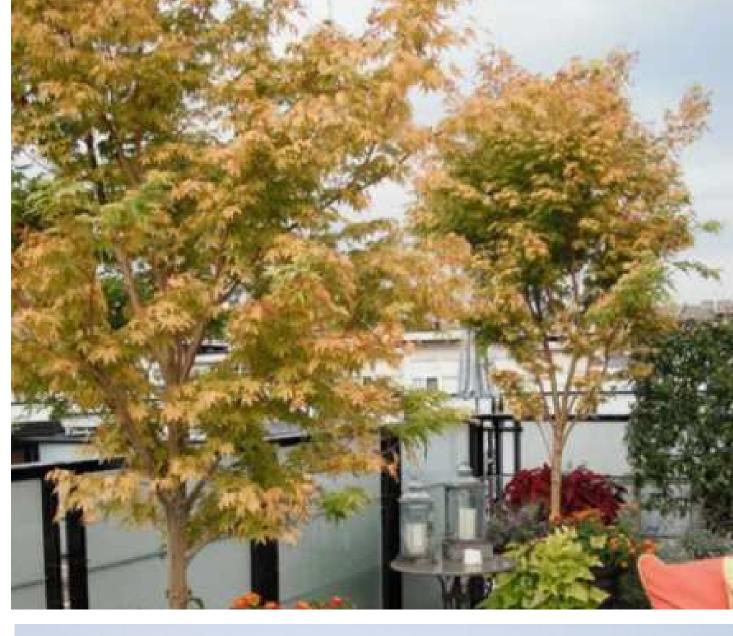











ROOFTOP COMMON SPACE













3	Rezoning DP Resubmission	2022-04-14
2	DP	2021-12-16
1	Issued for Dev. Tracker	2021-10-19
rev no	description	date






Mike Geric Construction 4520 West Saanich Rd Saanich, BC

QUEBEC & MONTREAL DEV. 501-502 MONTREAL ST. VICTORIA, BC

Landscape Precedents

oject no.		121.23
ale	N/A	@ 24"x36"
awn by		MDI
ecked by		SM
vison no.	sheet no.	
3		1.04



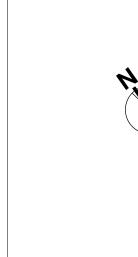

3	Rezonin DP Resubmi		2022-04-14
2	DP		2021-12-16
1	Issued for Dev.	Tracker	2021-10-19
rev no	descriptio	n	date



2022-04-20 2022-04-14


Mike Geric Construction 4520 West Saanich Rd Saanich, BC


project
QUEBEC & MONTREAL DEV.
501-502 MONTREAL ST.
VICTORIA, BC


neet title

Landscape Materials - Sections

project no.		121.23
scale	1:50	@ 24"x36"
drawn by		MDI
checked by		SM
revison no.	sheet no.	
3		1.05

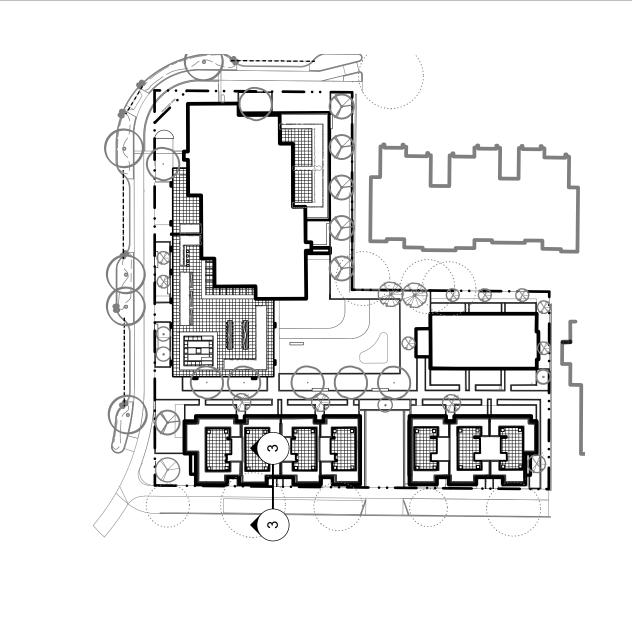

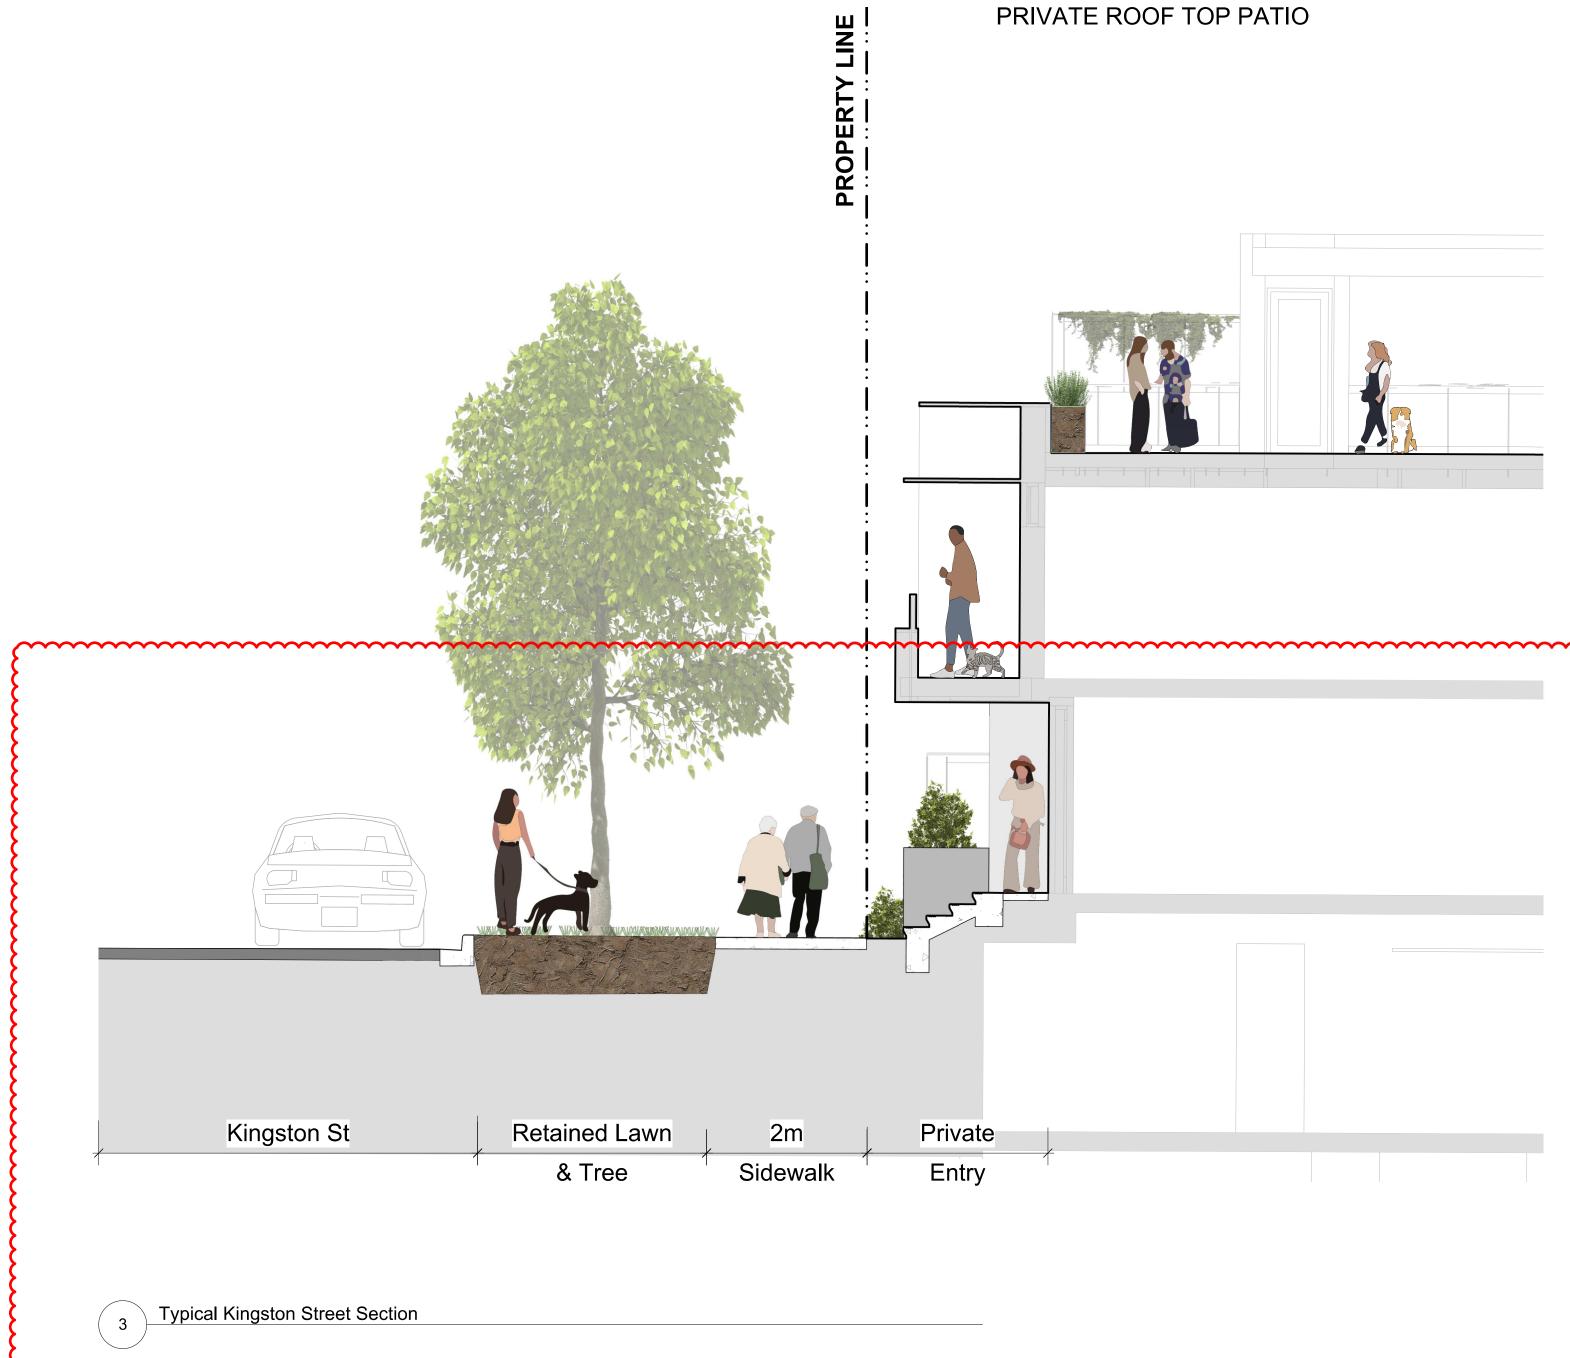

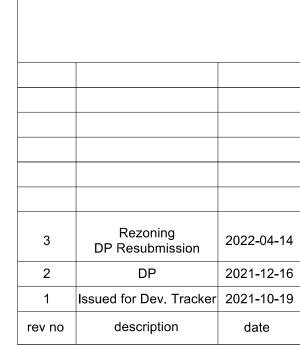





2022-04-14

Mike Geric Construction
4520 West Saanich Rd
Saanich, BC


ect EBEC & MC

QUEBEC & MONTREAL DEV. 501-502 MONTREAL ST. VICTORIA, BC


sheet title


Landscape Materials - Sections

	2		
	project no.		121.23
	scale	1:50	@ 24"x36"
	drawn by		MDI
رر	checked by		SM
	revison no.	sheet no.	
	3		1.06

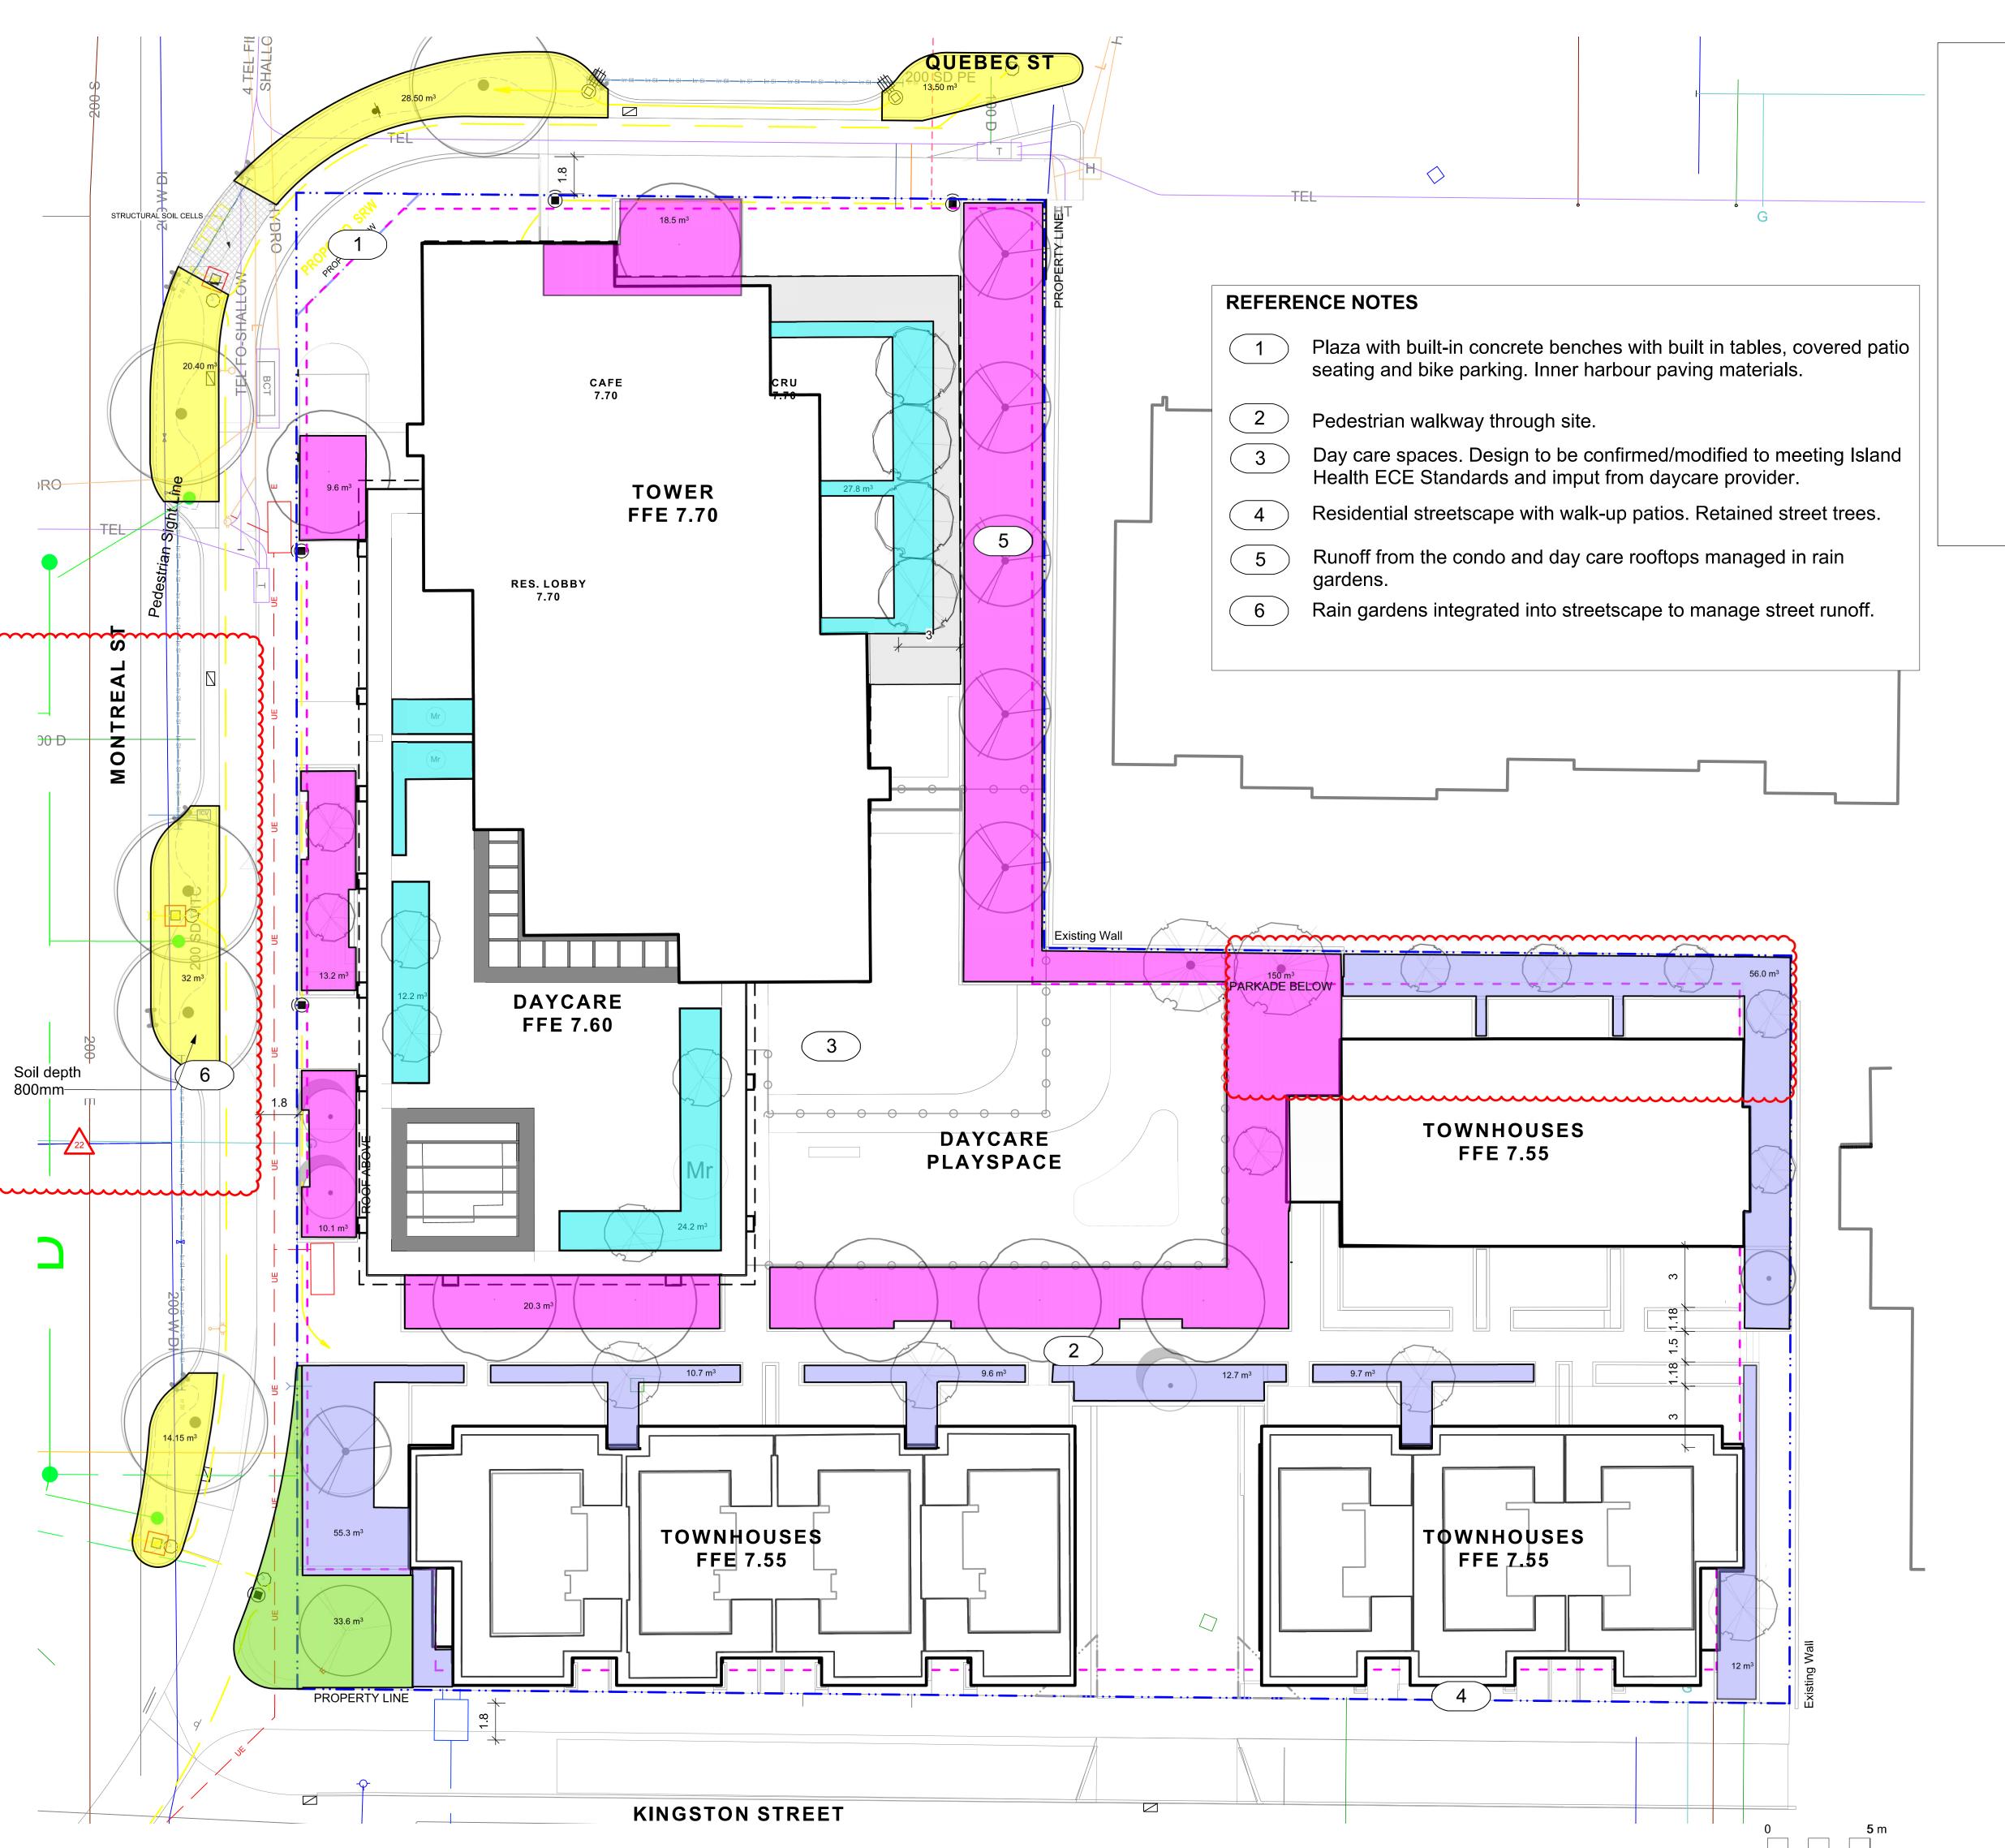



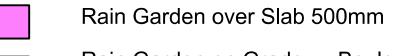

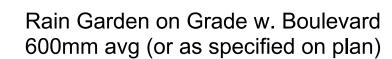

Planter over Slab or Raised Planter - 700mm

Planter over Slab or Raised
Planter - 500-600mm


Tree soil on Grade - 600m

NOTES

- 1. Small Tree: min 6-8 cubic metres of soil
- 2. Medium Tree: min 15-20 cubic metres of soil
- . Large Tree: 30-35 cubic metres of



3	Rezoning DP Resubmission	2022-04-14
2	DP	2021-12-16
1	Issued for Dev. Tracker	2021-10-19
ev no	description	date

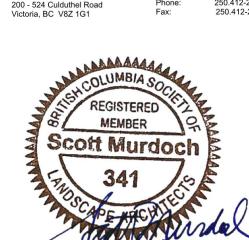

Murdoch

de Greeff INC

2022-04-14

Mike Geric Construction 4520 West Saanich Rd Saanich, BC


roject

QUEBEC & MONTREAL DEV. 501-502 MONTREAL ST. VICTORIA, BC

sheet title

Soil Volumes

sheet no.	SM
	IVIDI
	MDI
1:150	@ 24"x36"
	121.23
	1:150

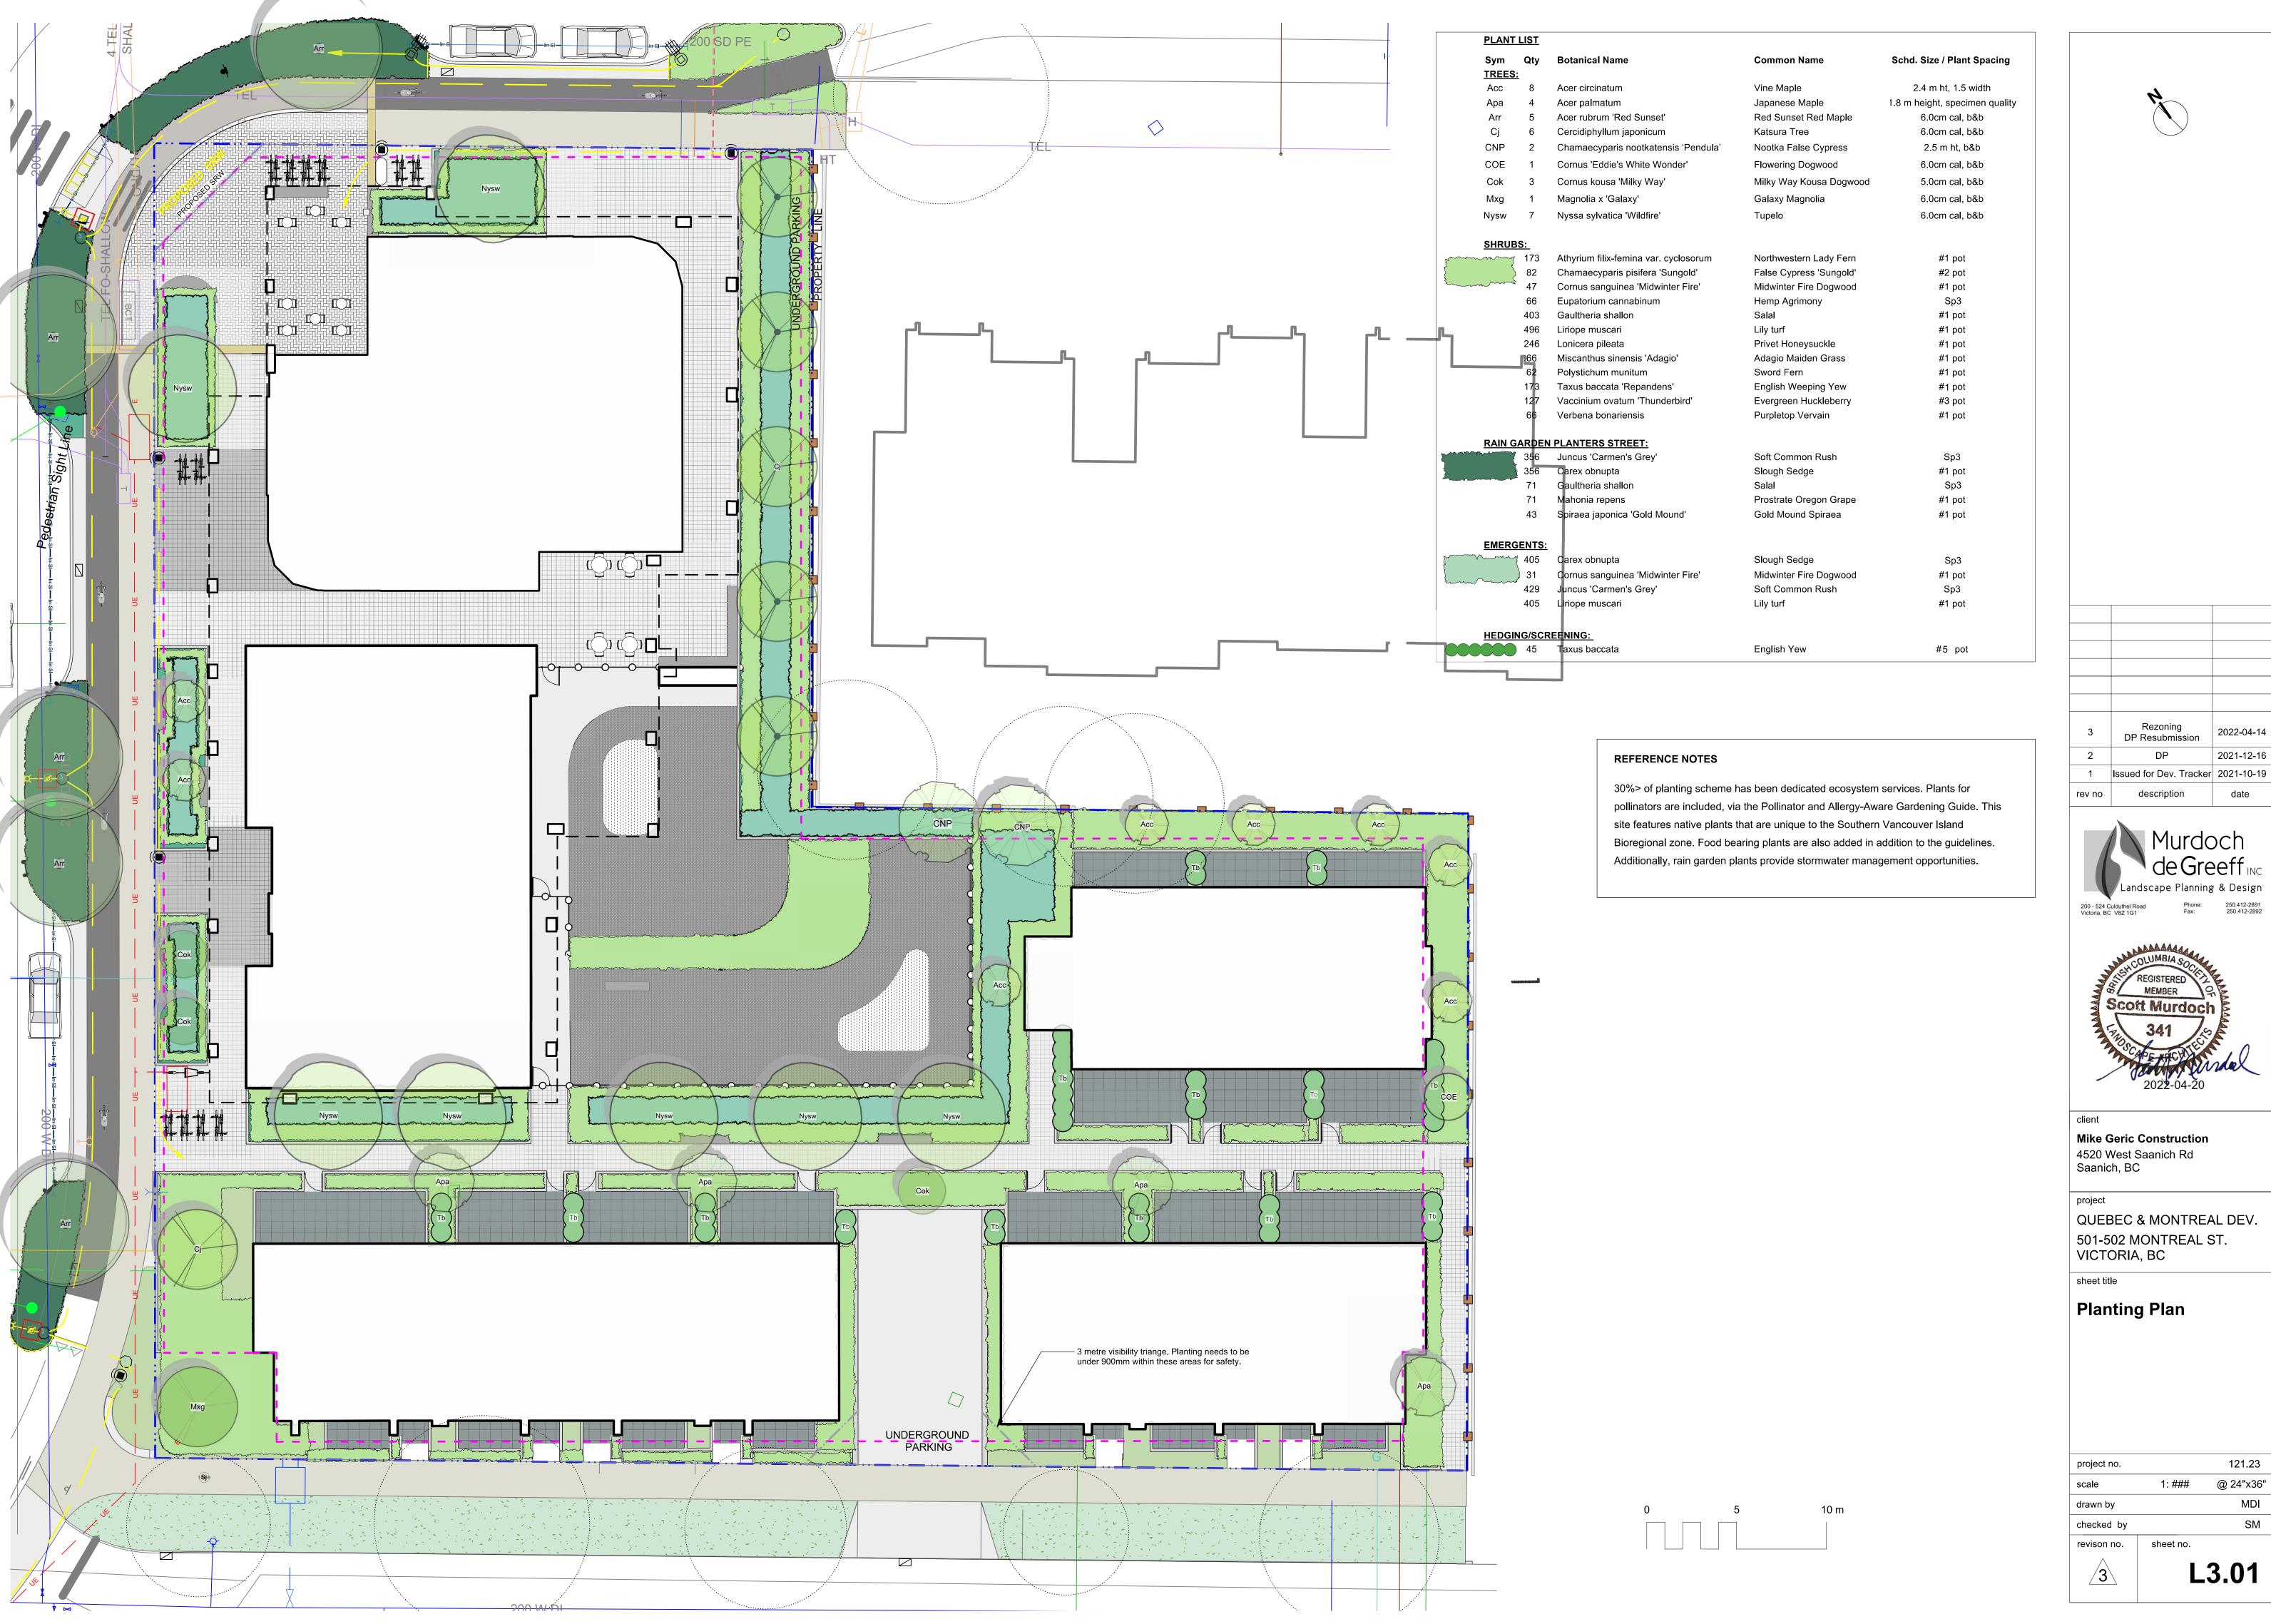





Rezoning DP Resubmission

description

2022-04-14



Mike Geric Construction 4520 West Saanich Rd Saanich, BC

QUEBEC & MONTREAL DEV. 501-502 MONTREAL ST. VICTORIA, BC

Planting Plan

project no.		121.23
scale	1: ###	@ 24"x36"
drawn by		MDI
checked by		SM
revison no.	sheet no.	
3	L	.3.01




PLAN ⁻	Γ LIST			
Sym	Qty	Botanical Name	Common Name	Schd. Size / Plant Spacing
TREES	<u> </u>			
Acc	4	Acer circinatum	Vine Maple	2.4 m ht, 1.5 width
Apa	4	Acer palmatum	Japanese Maple	1.8 m height, specimen quality
Mr	3	Magnolia stellata 'Royal Star'	Royal Star Magnolia	1.2m b&b
SHRU	BS:			
Cummuna.	~ 24	Abelia x grandiflora 'Prostrata'	Prostrate White Abelia	#2 pot
{	32	Cistus x corbariensis	Rock Rose	#1 pot
Z	^{_≒} 35	Eriophyllum lanatum	Wooly Sunflower	#1 pot
	106	Hebe topiaria	Topiarist's hebe	#1 pot
	63	Lavandula angustifolia 'Hidcote'	Hidcote English Lavender	#1 pot
	106	Mahonia repens	Prostrate Oregon Grape	#1 pot
	16	Nepeta x faassenii	Catmint	Sp3
	16	Rosmarinus officinalis	Rosemary	0.6
	16	Salvia officinalis	Culinary Sage	#1 pot
	24	Vaccinium ovatum 'Thunderbird'	Evergreen Huckleberry	#3 pot
	0			
PEREI	NIALS:			
	7	Taxus baccata 'Repandens'	English Weeping Yew	#3 pot


REFERENCE NOTES

30%> of planting scheme has been dedicated ecosystem services. Plants for pollinators are included, via the Pollinator and Allergy-Aware Gardening Guide. This site features native plants that are unique to the Southern Vancouver Island Bioregional zone. Food bearing plants are also added in addition to the guidelines. Additionally, rain garden plants provide stormwater management opportunities.

Residential planters. Planters to be planted and maintained by residents.

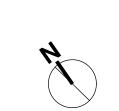

3	Rezoning DP Resubmission	2022-04-14
2	DP	2021-12-16
1	Issued for Dev. Tracker	2021-10-19
rev no	description	date

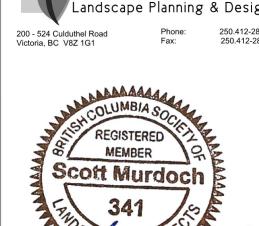

de Greeff INC


Mike Geric Construction 4520 West Saanich Rd Saanich, BC


QUEBEC & MONTREAL DEV. 501-502 MONTREAL ST. VICTORIA, BC

sheet title

Planting Plan


project no.		121.23
scale	1: ###	@ 24"x36"
drawn by		MDI
checked by		SM
revison no.	sheet no.	
3	L	.3.02

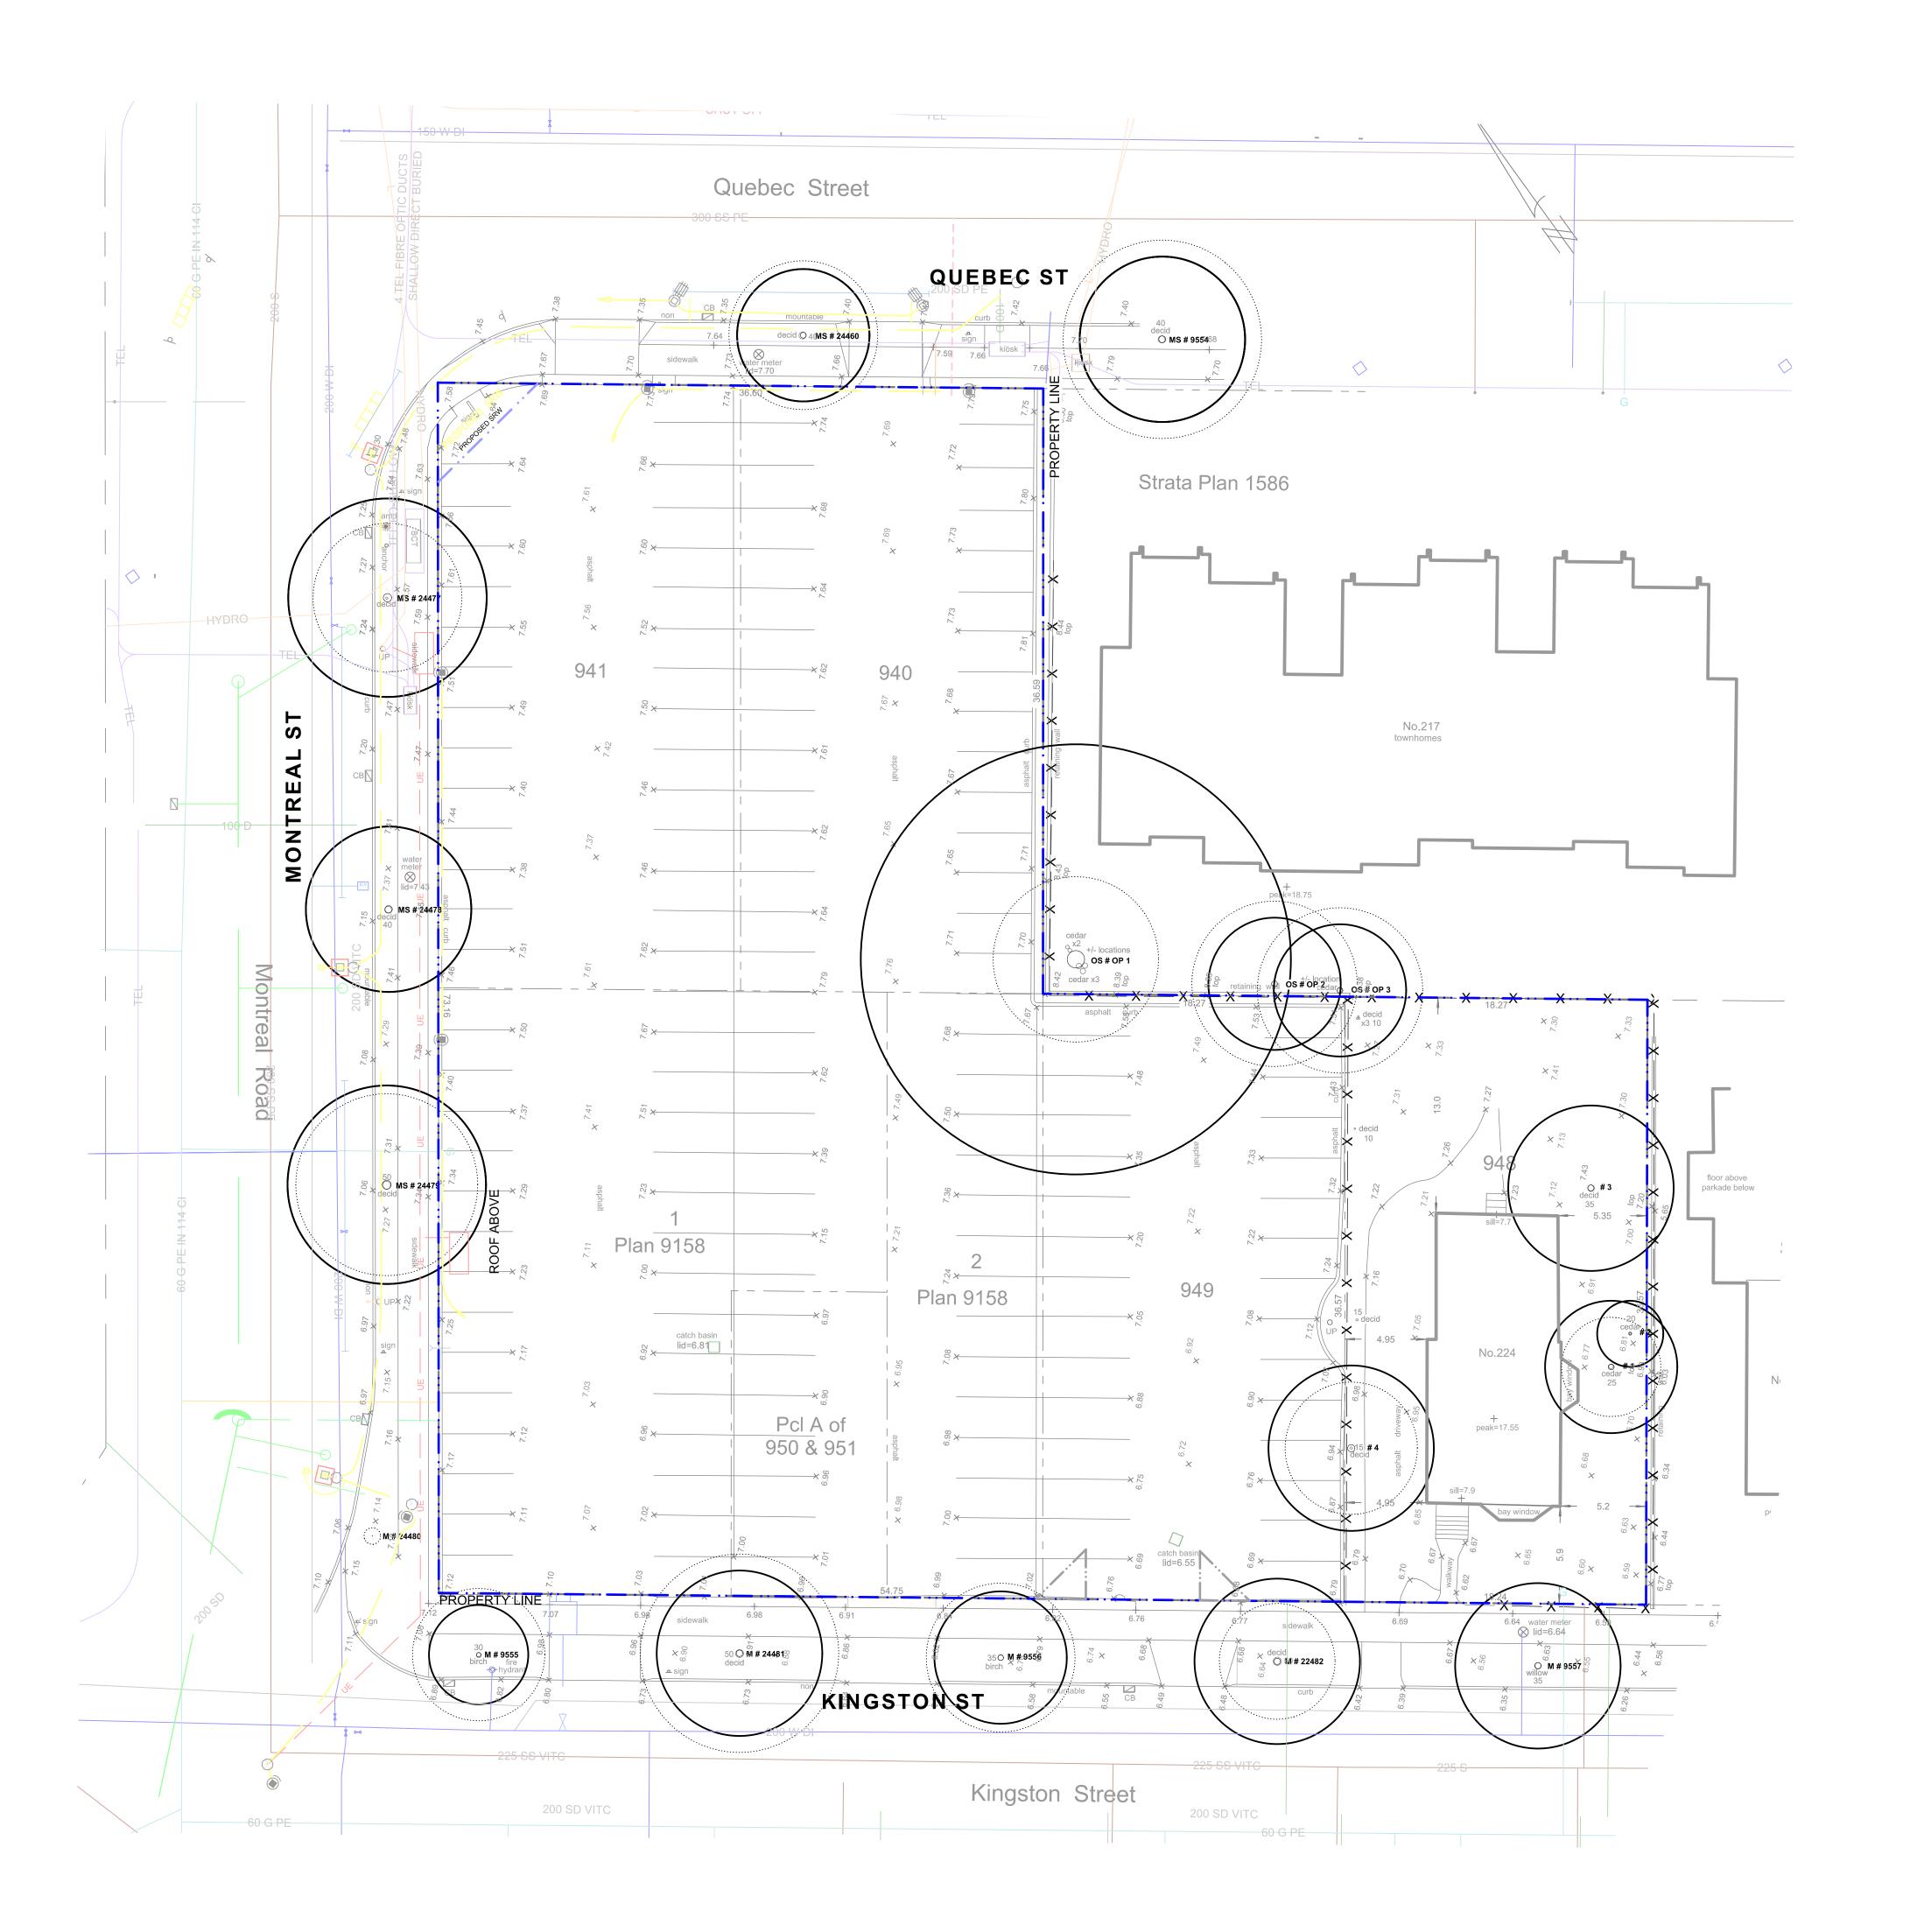

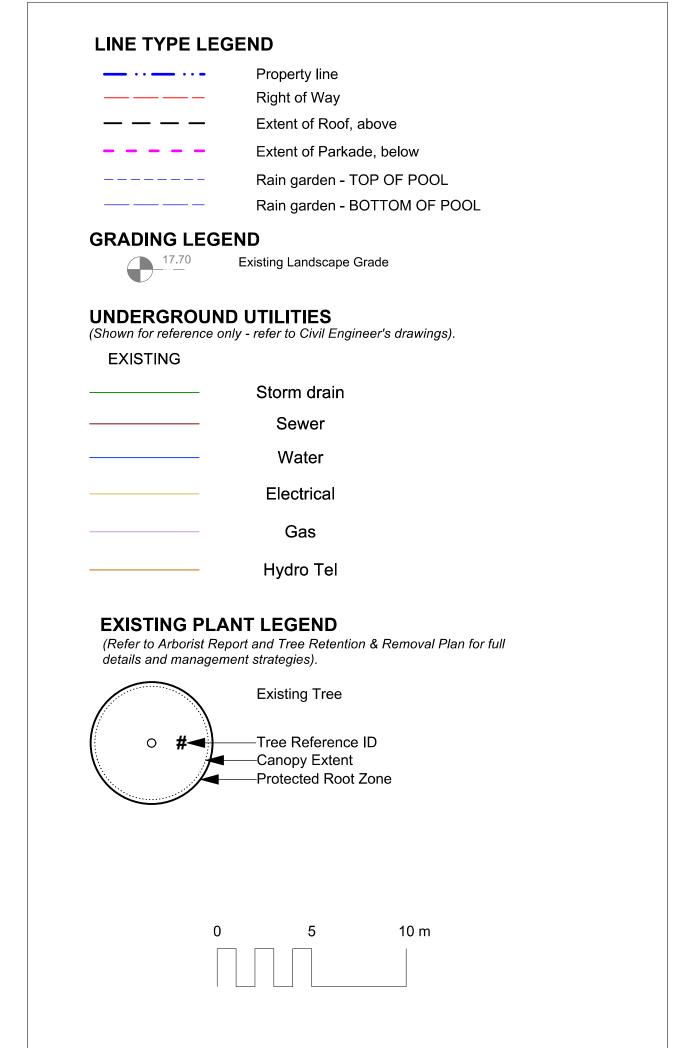


TREE TAG#	DBH (cm)	CRZ	Species	Crown Spread (m)	Height (m)
9555	27	3	Betula papyrifera	8	9
24481	39	5	Prunus cerasifera	12	9
24482	38	5	Prunus cerasifera	7	9
9557	39	4	Betula pendula	10	11
9554	42	5	Aesculus carnea	12	9
Op1	105	12	Thuja plicata	10	14
Op2	35	4	Cedrus dreadar	9	18
Op3	35	4	Sequoiadendron giganteum	9	10
2556	34	4	Betula papyrifera	9	10
OTAL TREES	_	AINED	: 9		
EMOVED TR	EES			Crown	Height
TREE TAG#	DBH (cm)		Species	Spread (m)	(m)
24460	35		Sorbus intermedia	9	0
24480	3		Prunus sargentii	1	3
24479	53		Prunus cerasifera	11	8
24478	44		Prunus cerasifera	10	8
24477	50		Prunus cerasifera	9	8
	35		Thuja plicata smaragd	3	6
1	4.4		Thuja plicata smaragd	2	6
1 2	14		D	5	4
	14 39		Pyrus sp.	•	
2			llex aquifolium	4	6
2 3	39 44	OVED:	llex aquifolium		6

EXISTING TREE INVENTORY*

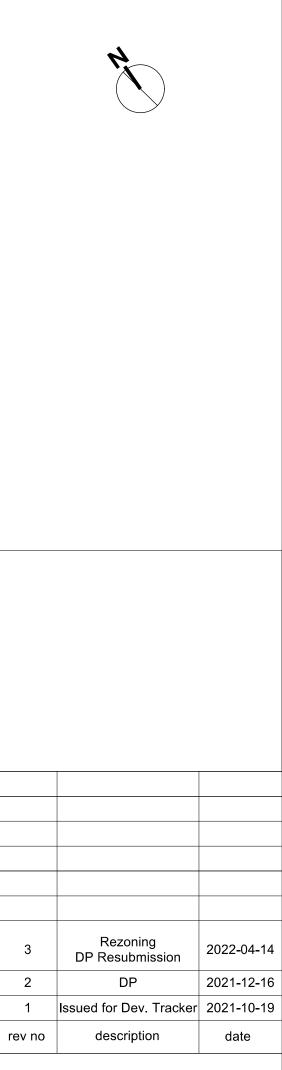



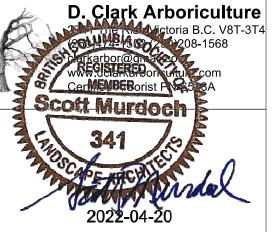

2022-04-14


Mike Geric Construction 4520 West Saanich Rd Saanich, BC


project
QUEBEC & MONTREAL DEV.
501-502 MONTREAL ST.
VICTORIA, BC

sheet title

Tree Survey Plan

project no.		121.23
scale	1: 200	@ 24"x36"
drawn by		MDI
checked by		SM
revison no.	sheet no.	
3		0.02

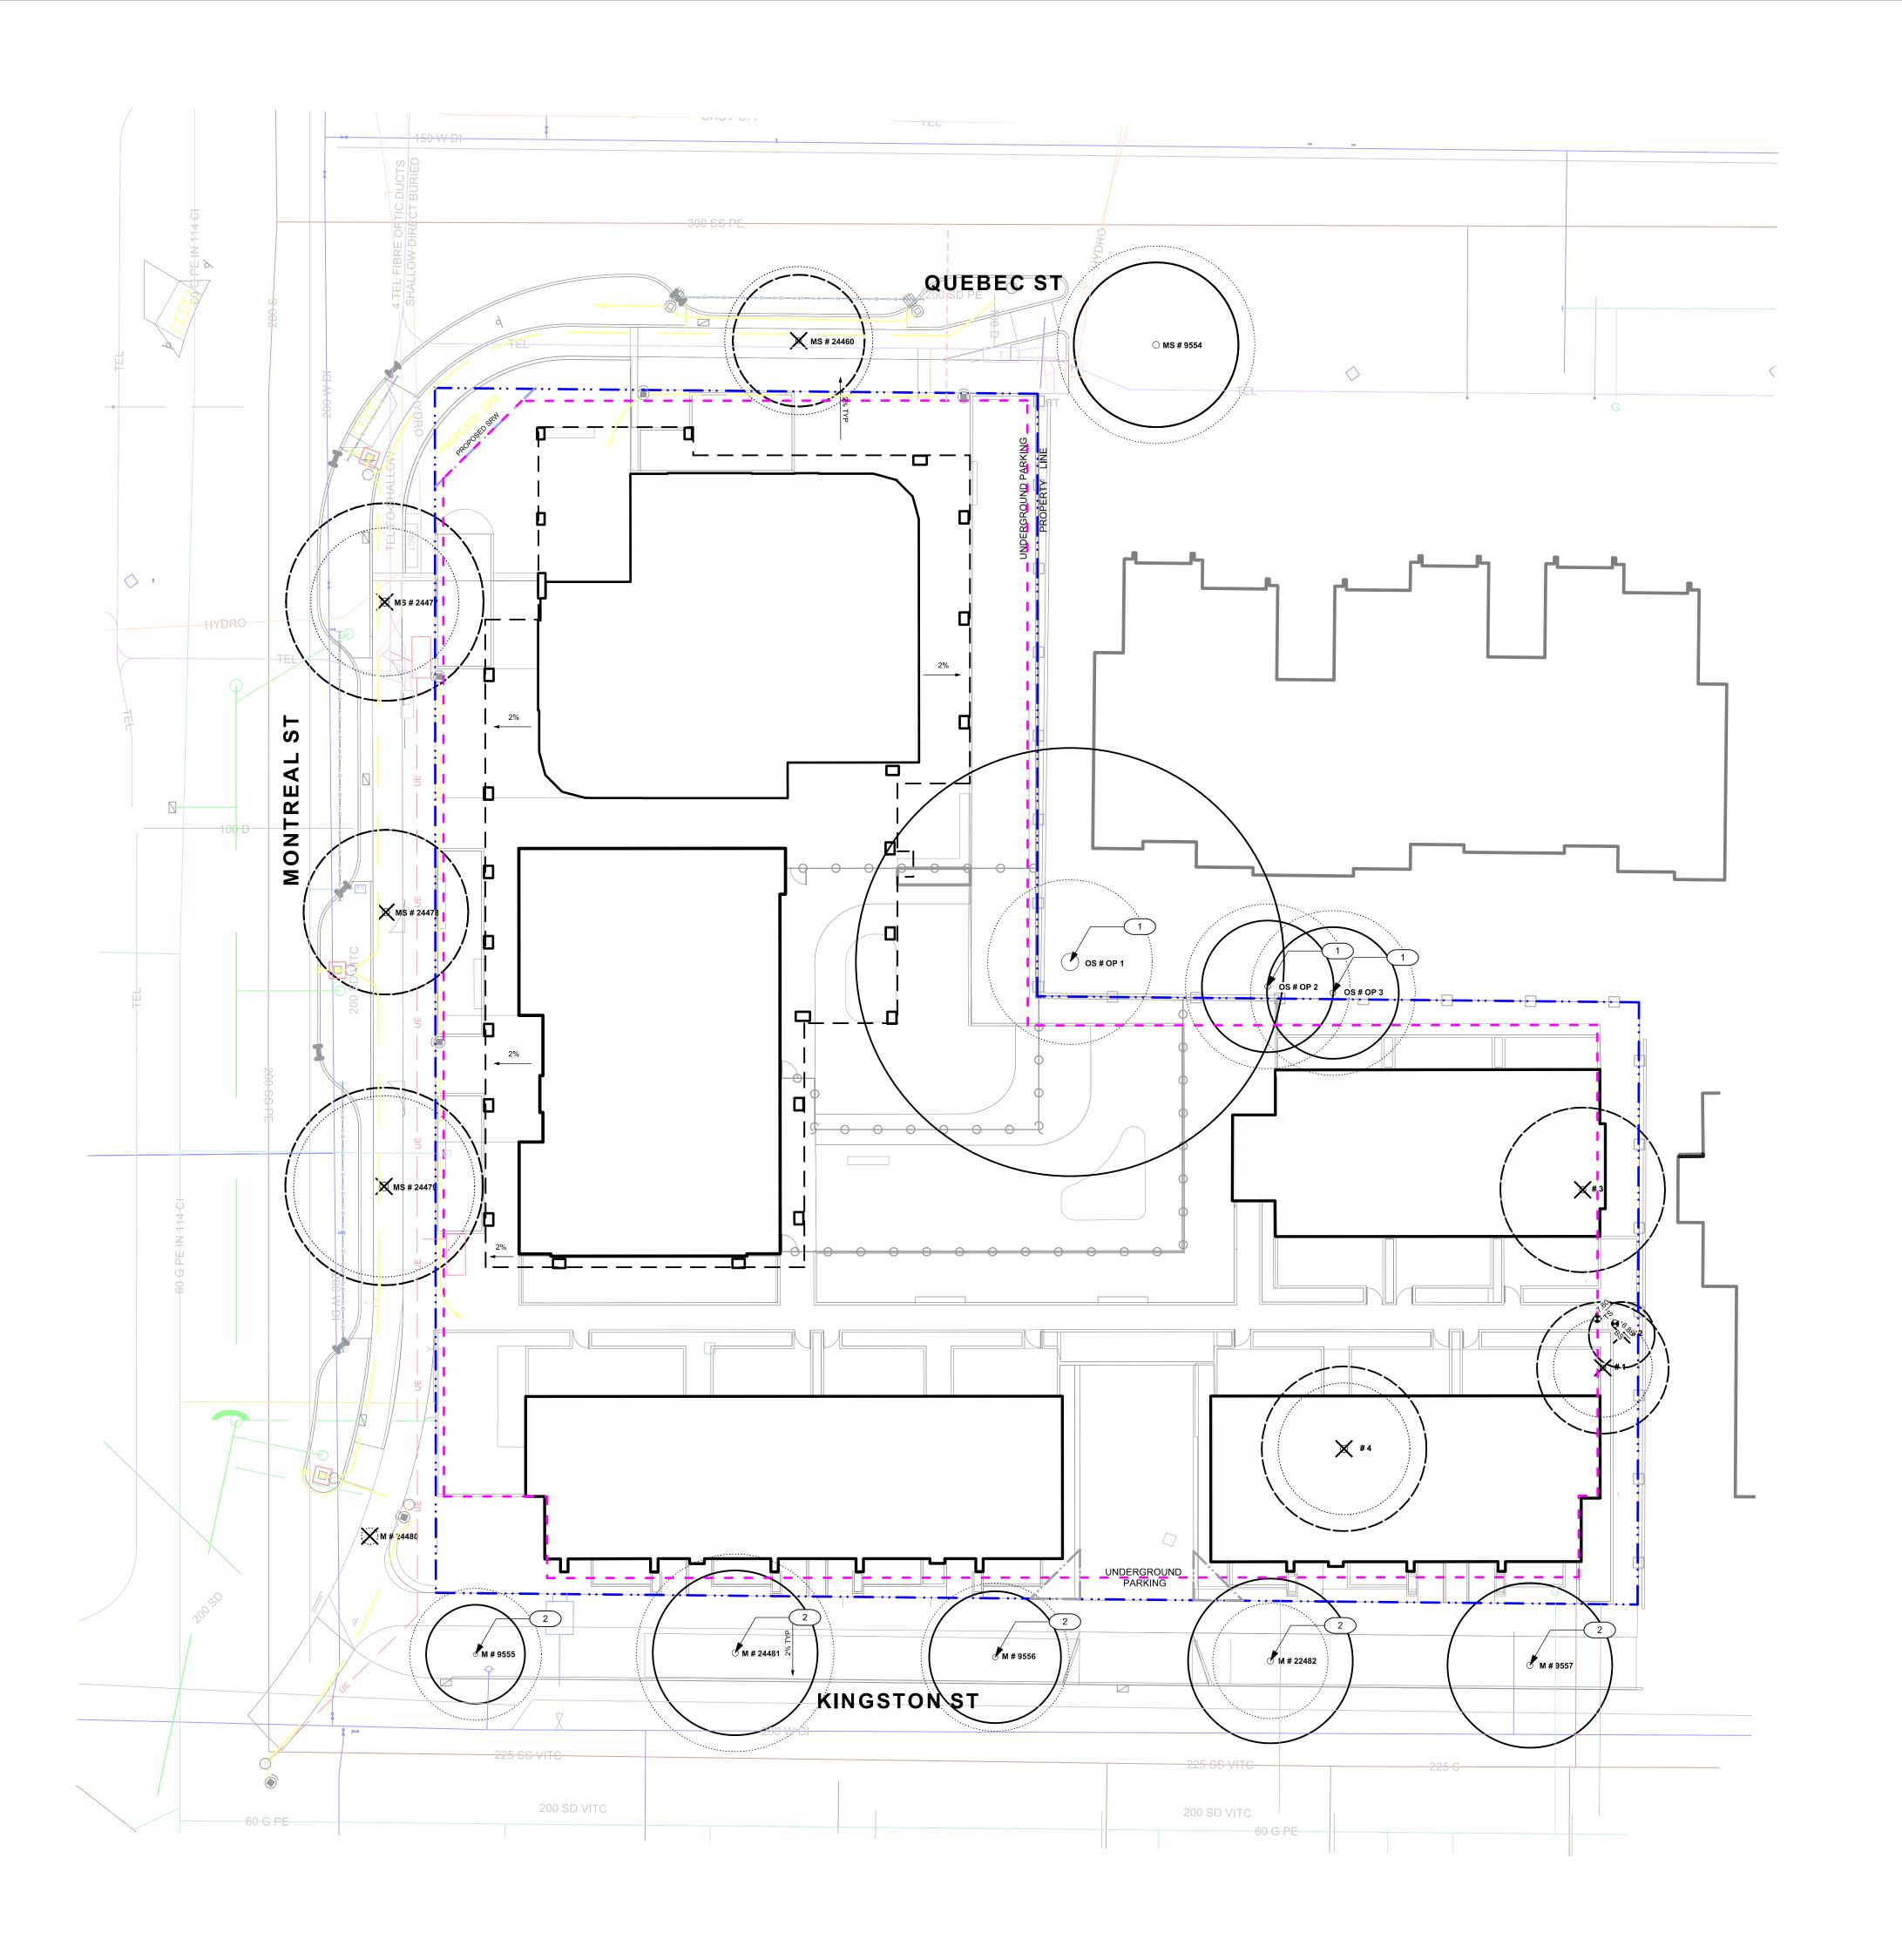

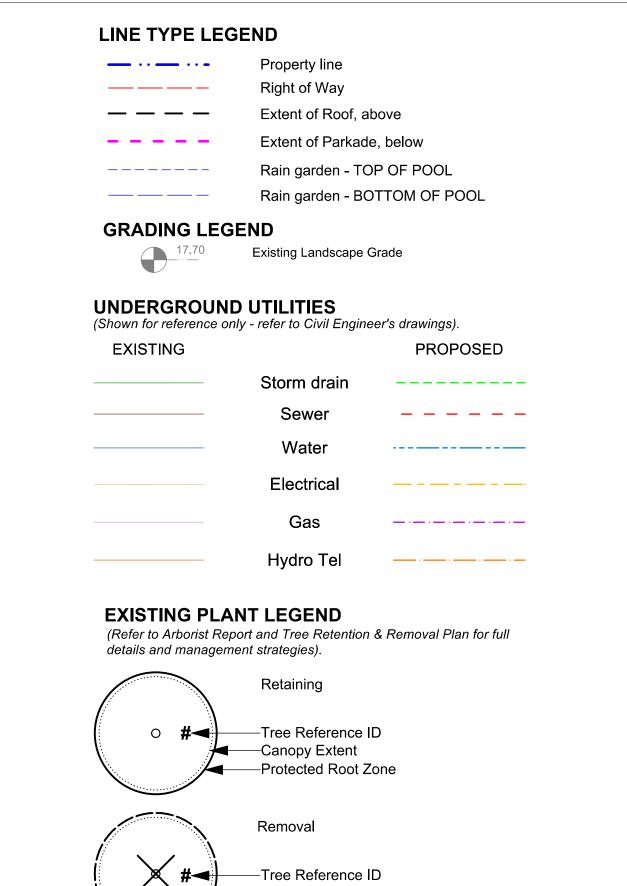


REE TAG #	DBH (cm)	DBH (cm) CRZ Species		Crown Spread (m)	Height (m)	
9555	27	3	Betula papyrifera	8	9	
24481	39	5	Prunus cerasifera	12	9	
24482	38	5	Prunus cerasifera	7	9	
9557	39	4	Betula pendula	10	11	
9554	42	5	Aesculus carnea	12	9	
Op1	105	12	Thuja plicata	10	14	
Op2	35	4	Cedrus dreadar	9	18	
Op3	35	4	Sequoiadendron giganteum	9	10	
2556	34	4	Betula papyrifera	9	10	
OTAL TREES	TO BE RET	AINED:	: 9			
EMOVED TR	EES			0	11-1-1-1	
REE TAG#	DBH (cm)		Species	Crown Spread (m)	Height (m)	
24460	35		Sorbus intermedia	9	0	
24480	3		Prunus sargentii	1	3	
24479	53		Prunus cerasifera	11	8	
24478	44		Prunus cerasifera	10	8	
24477	50		Prunus cerasifera	9	8	
1	35		Thuja plicata smaragd	3	6	
2	14		Thuja plicata smaragd	2	6	
3	39		Pyrus sp.	5	4	
4	44		llex aquifolium	4	6	
OTAL TREES	TO BE REM	IOVED:	9			

Requires onsite supervision of trees during excavation


Potentially impacted by site serving and grading

EXISTING TREE INVENTORY*

REFERENCE NOTES

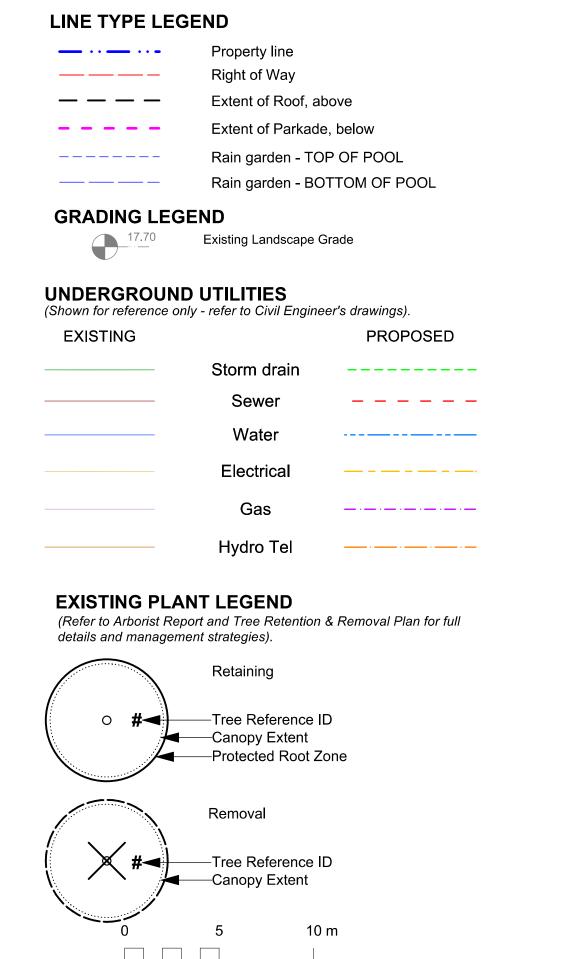



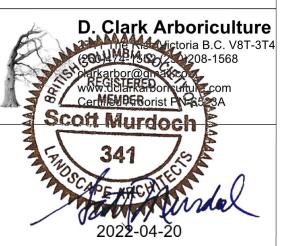

2022-04-14


Mike Geric Construction 4520 West Saanich Rd Saanich, BC


QUEBEC & MONTREAL DEV. 501-502 MONTREAL ST.

VICTORIA, BC sheet title


Tree Management Plan

project no.		121.23			
scale	1: 200	@ 24"x36"			
drawn by		MDI			
checked by		SM			
revison no.	sheet no.				
3	L0.03				

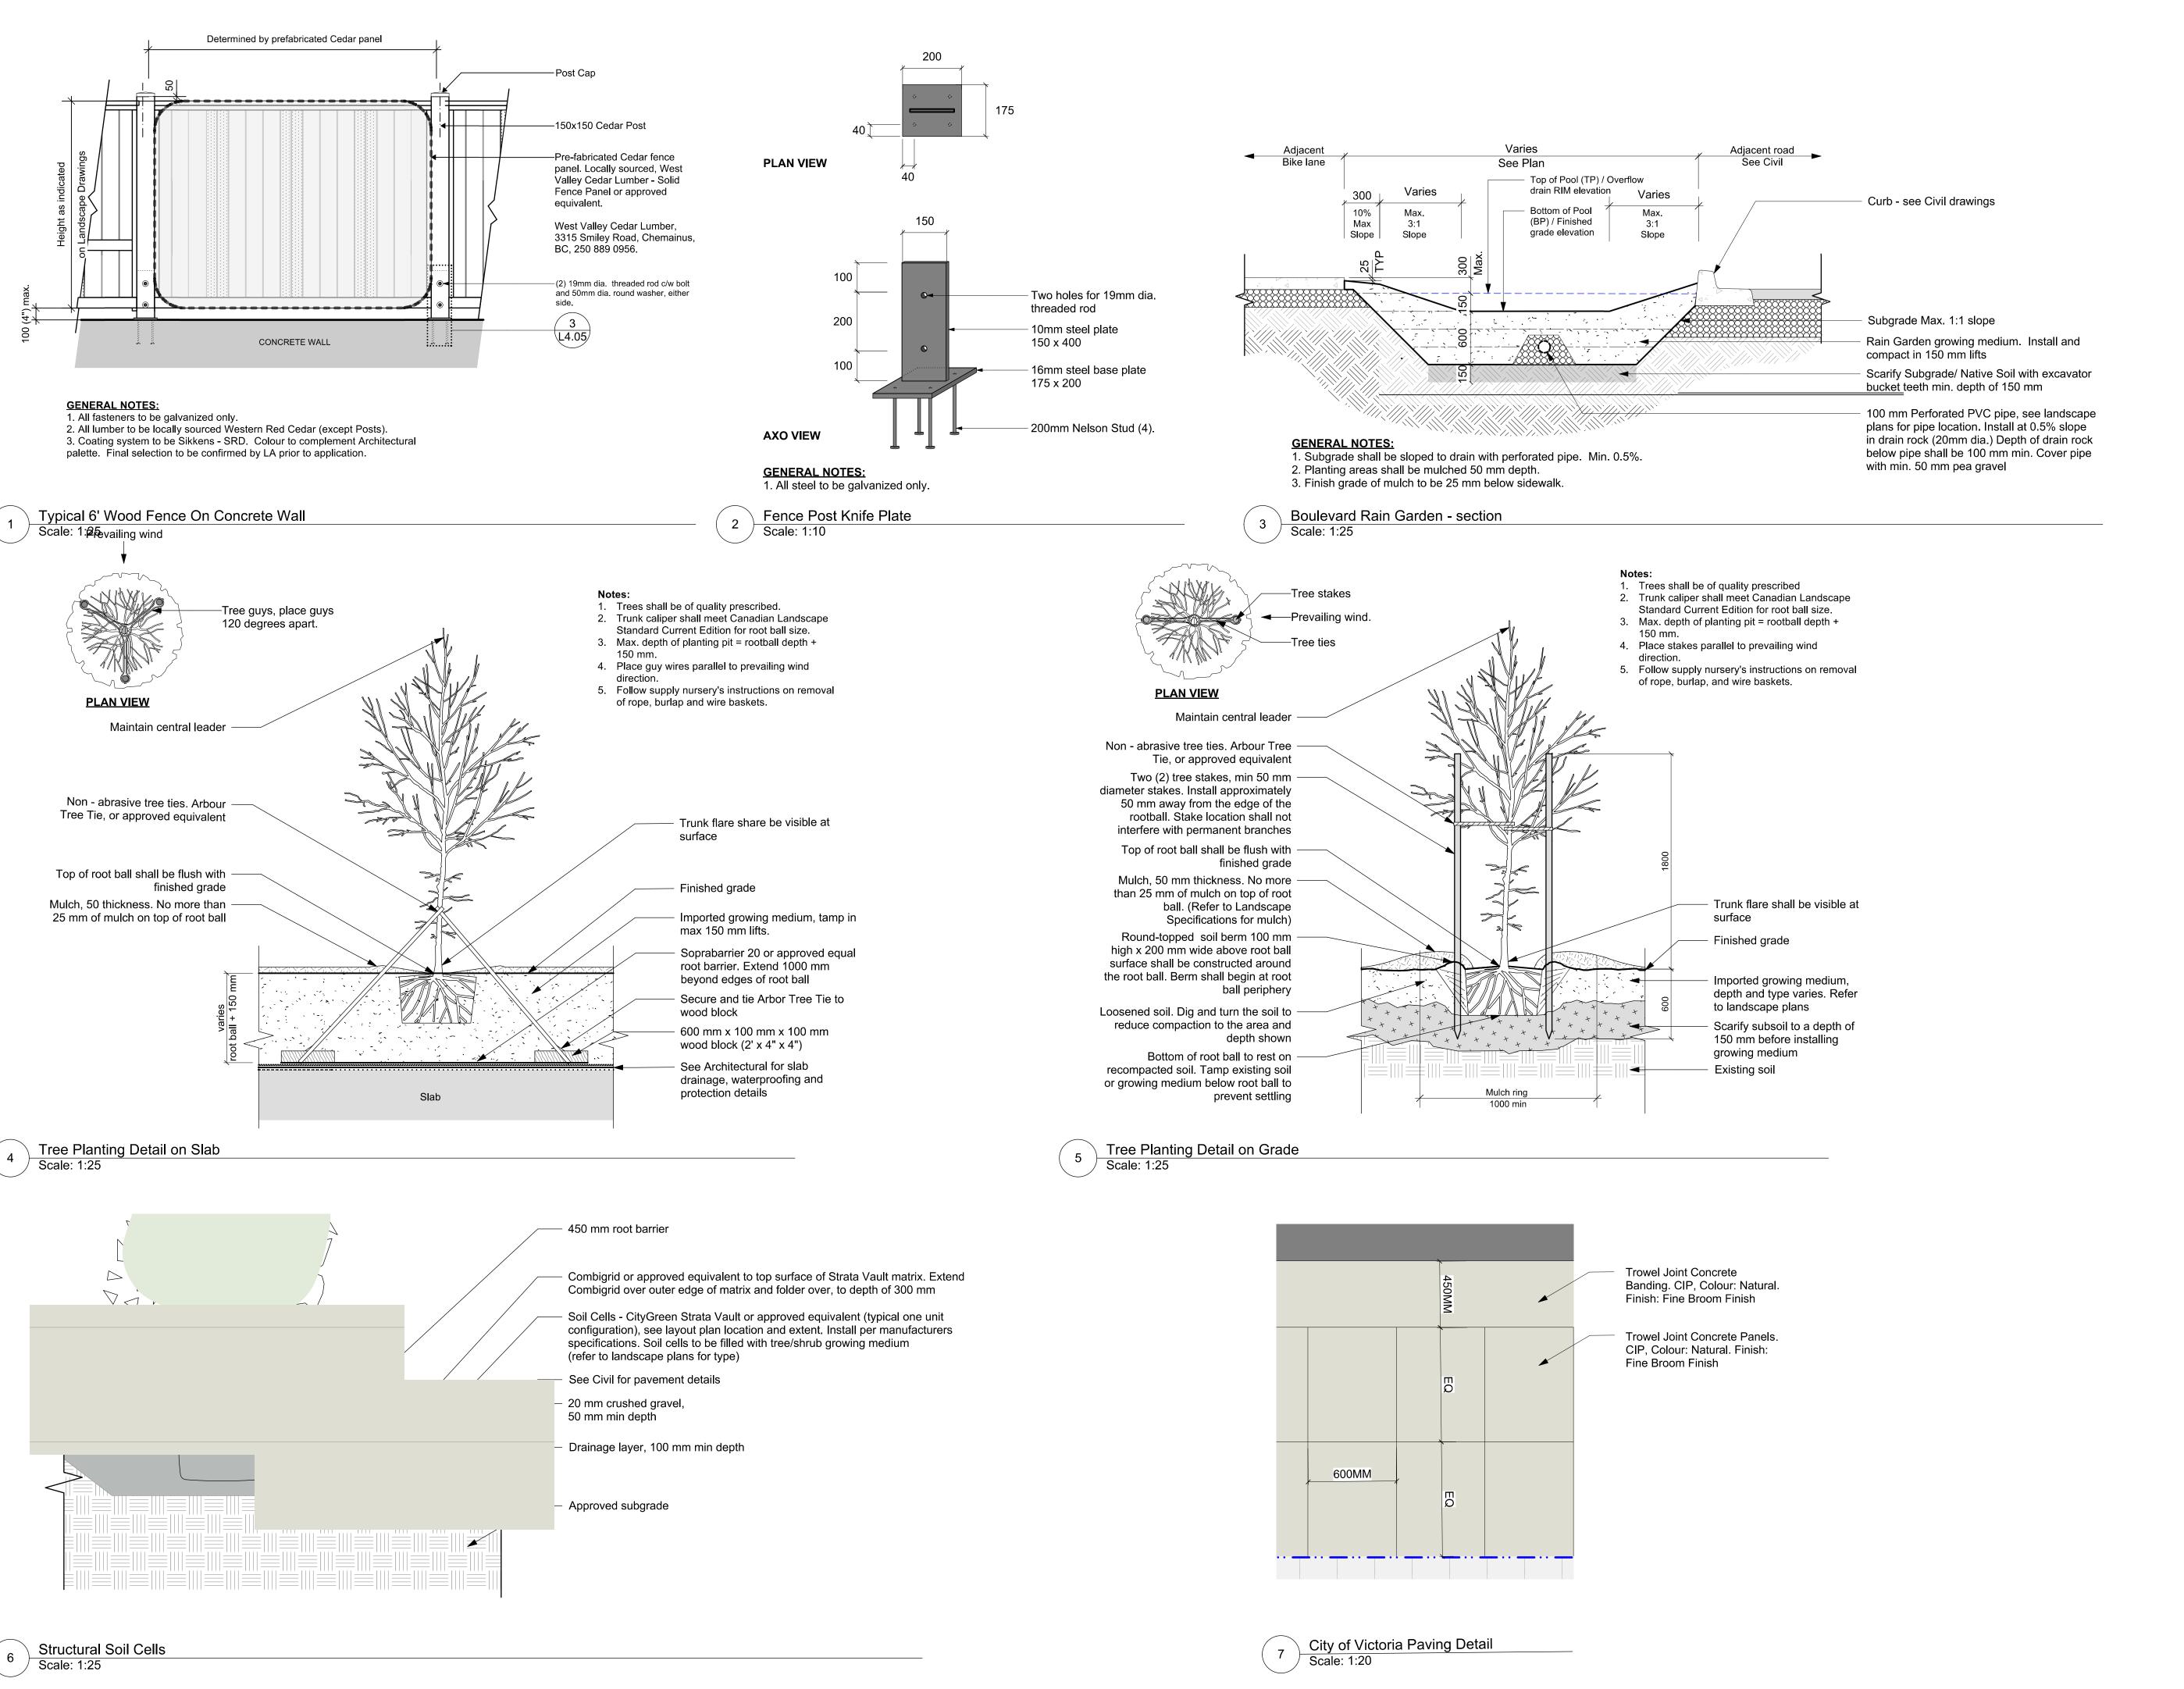

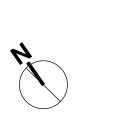

3 Rezoning 2022-04-14
2 DP 2021-12-16
1 Issued for Dev. Tracker 2021-10-19
rev no description date

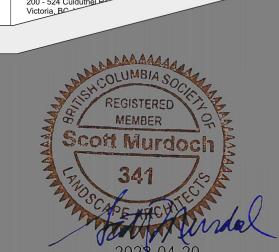

Murdoch

de Greeff


Mike Geric Construction 4520 West Saanich Rd Saanich, BC


QUEBEC & MONTREAL DEV. 501-502 MONTREAL ST. VICTORIA, BC


sheet title


Landscape Details


project no.		121.23
scale <i>F</i>	AS SHOWN	@ 24"x36"
drawn by		MDI
checked by		SM
revison no.	sheet no.	
3	L	4.01

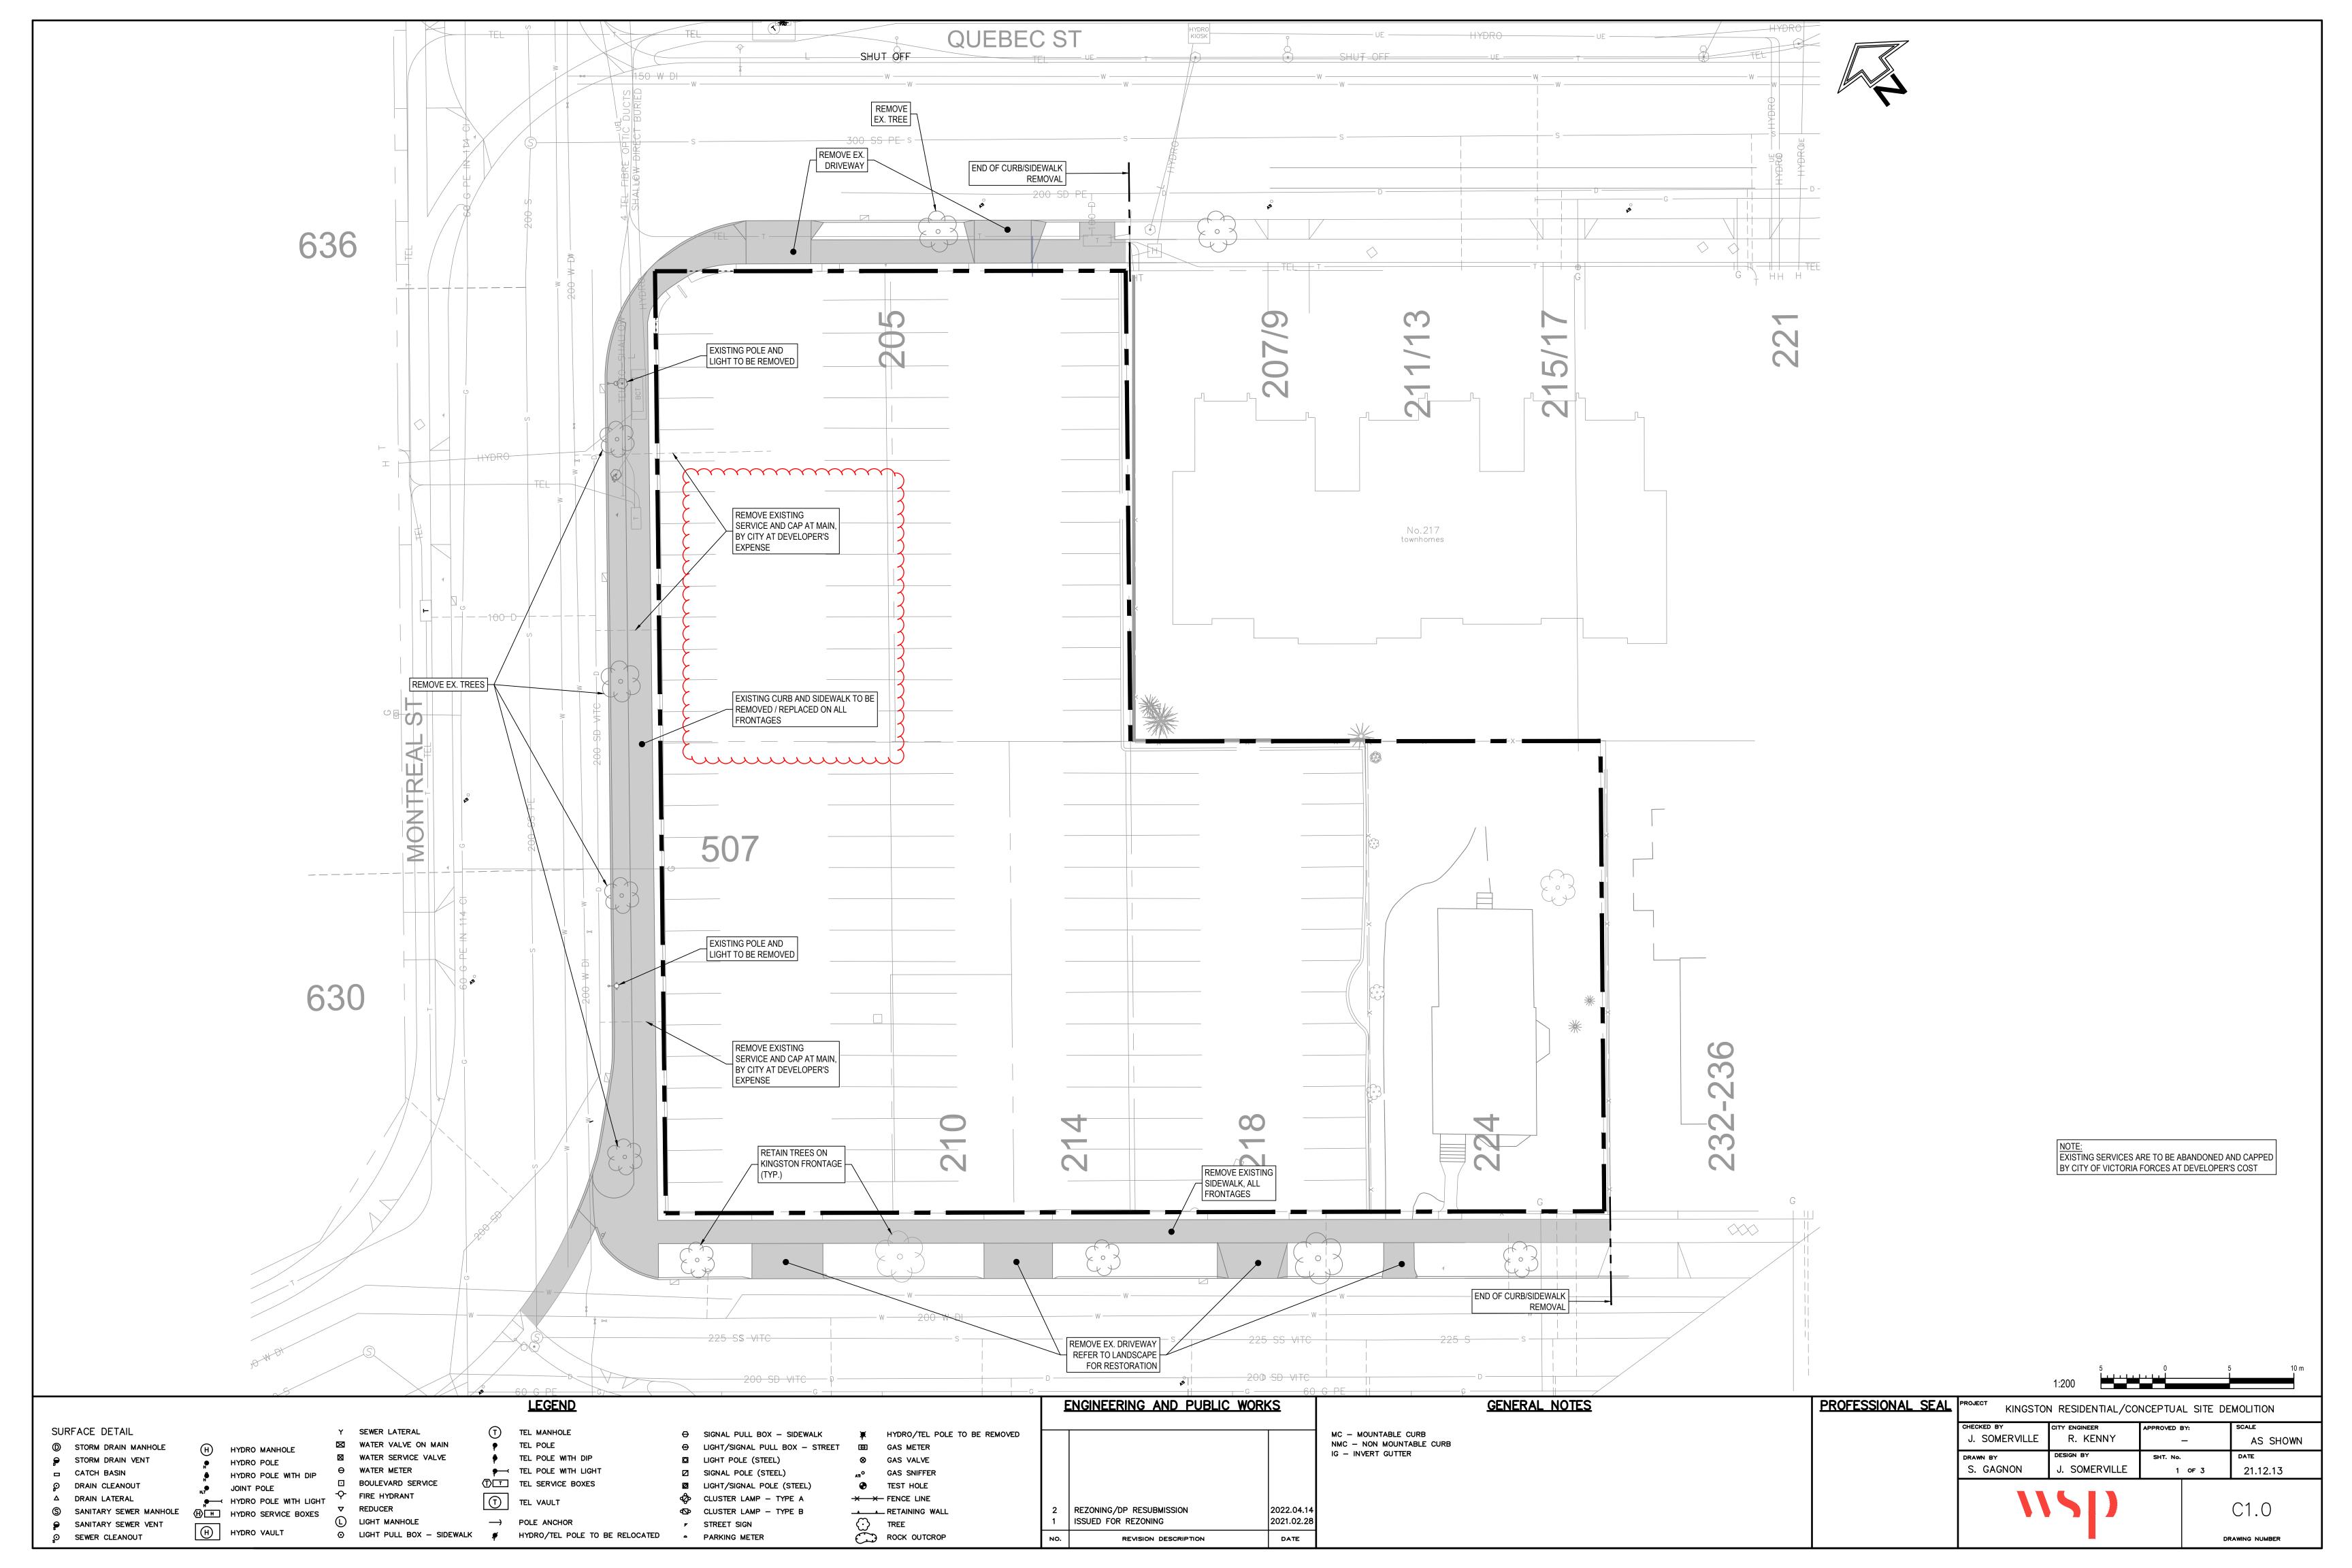

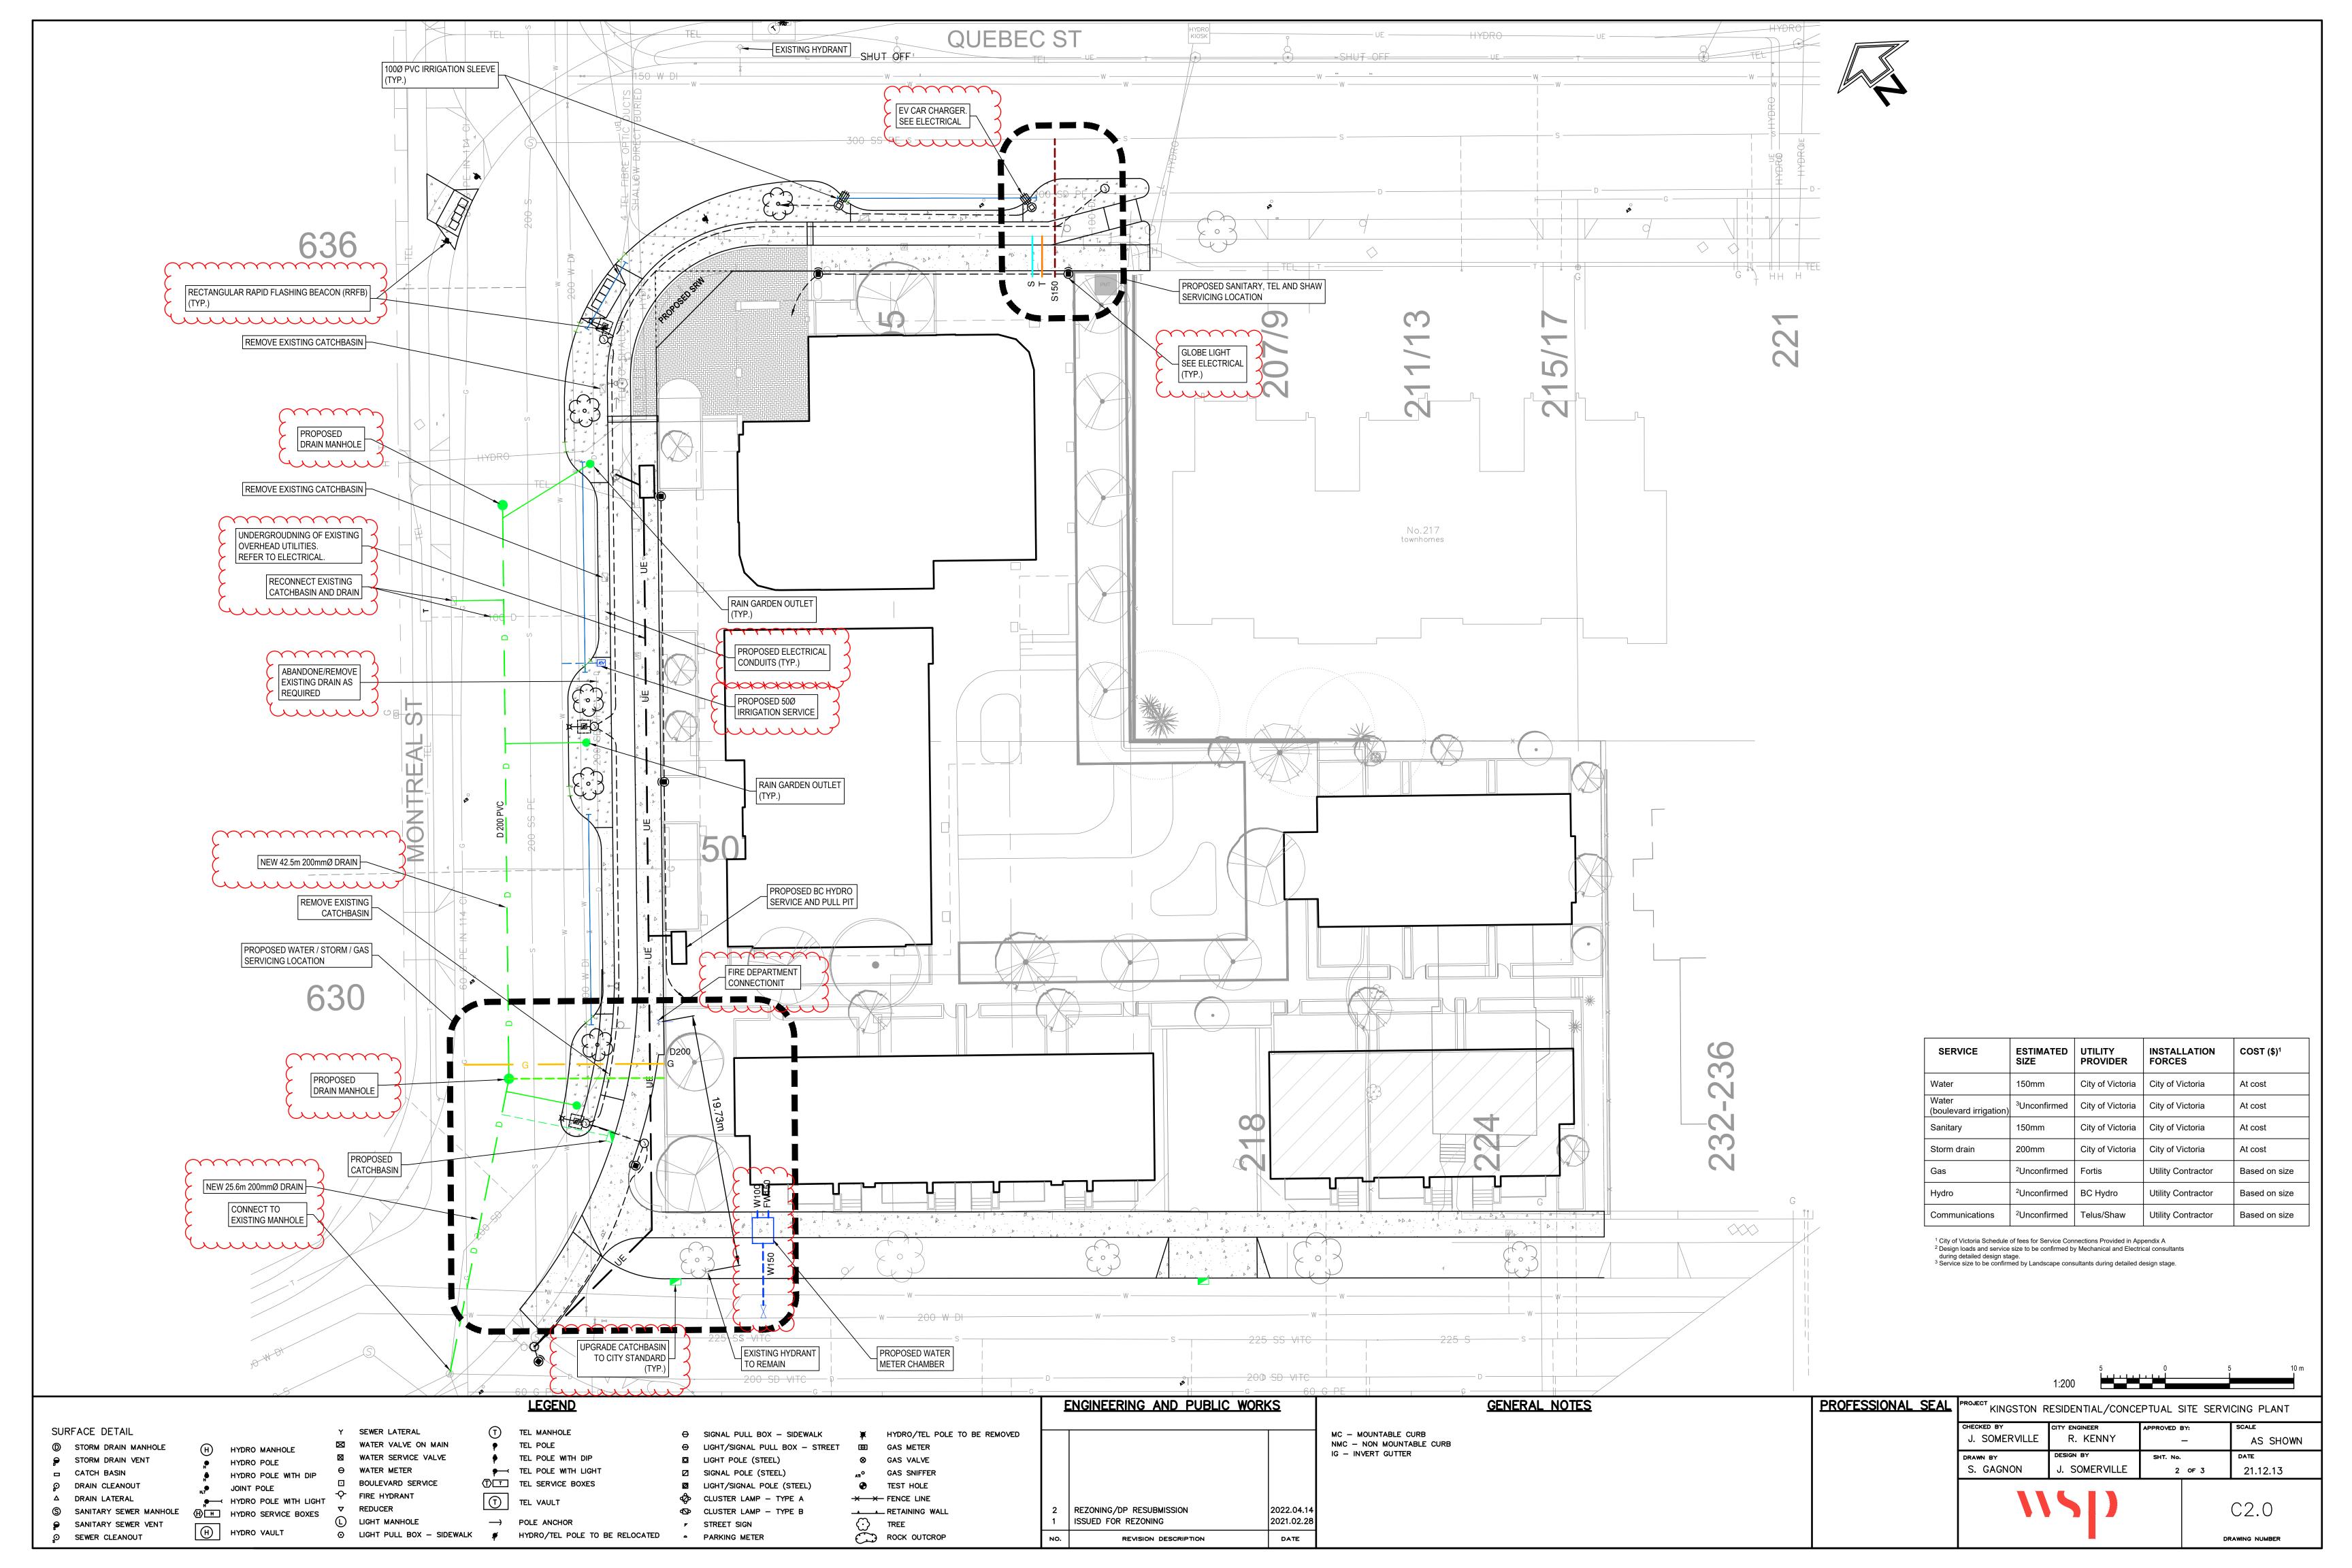

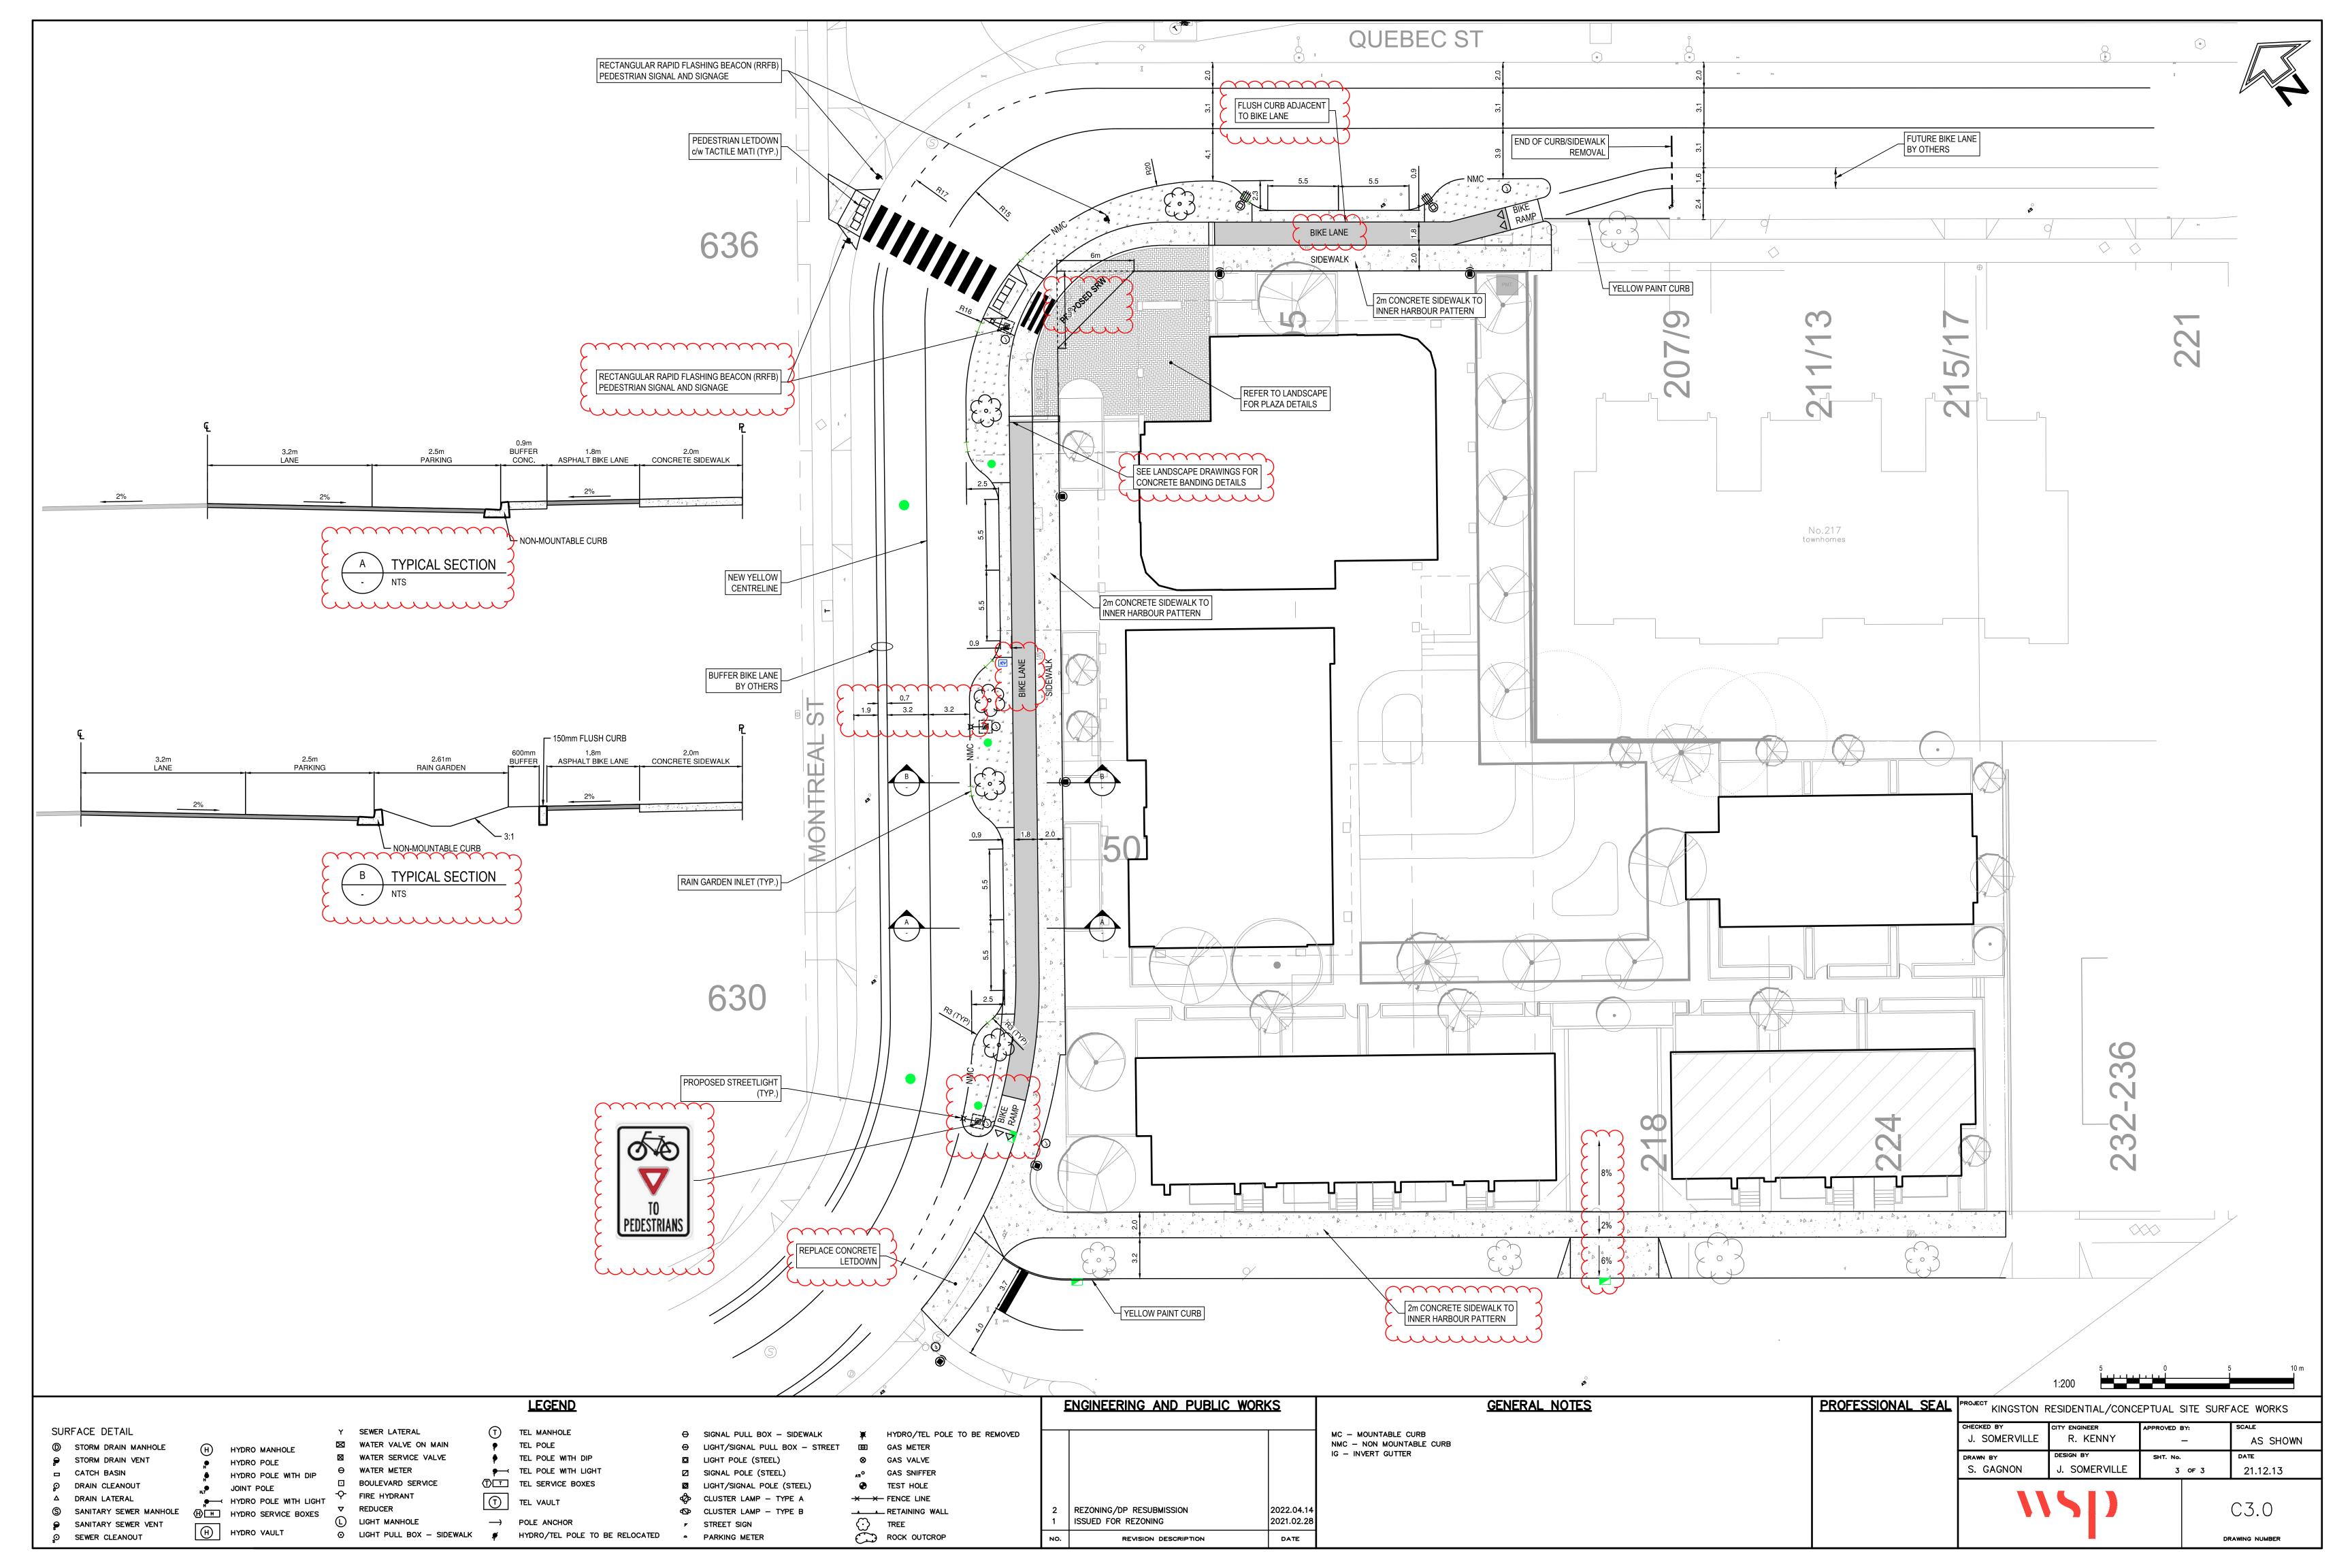

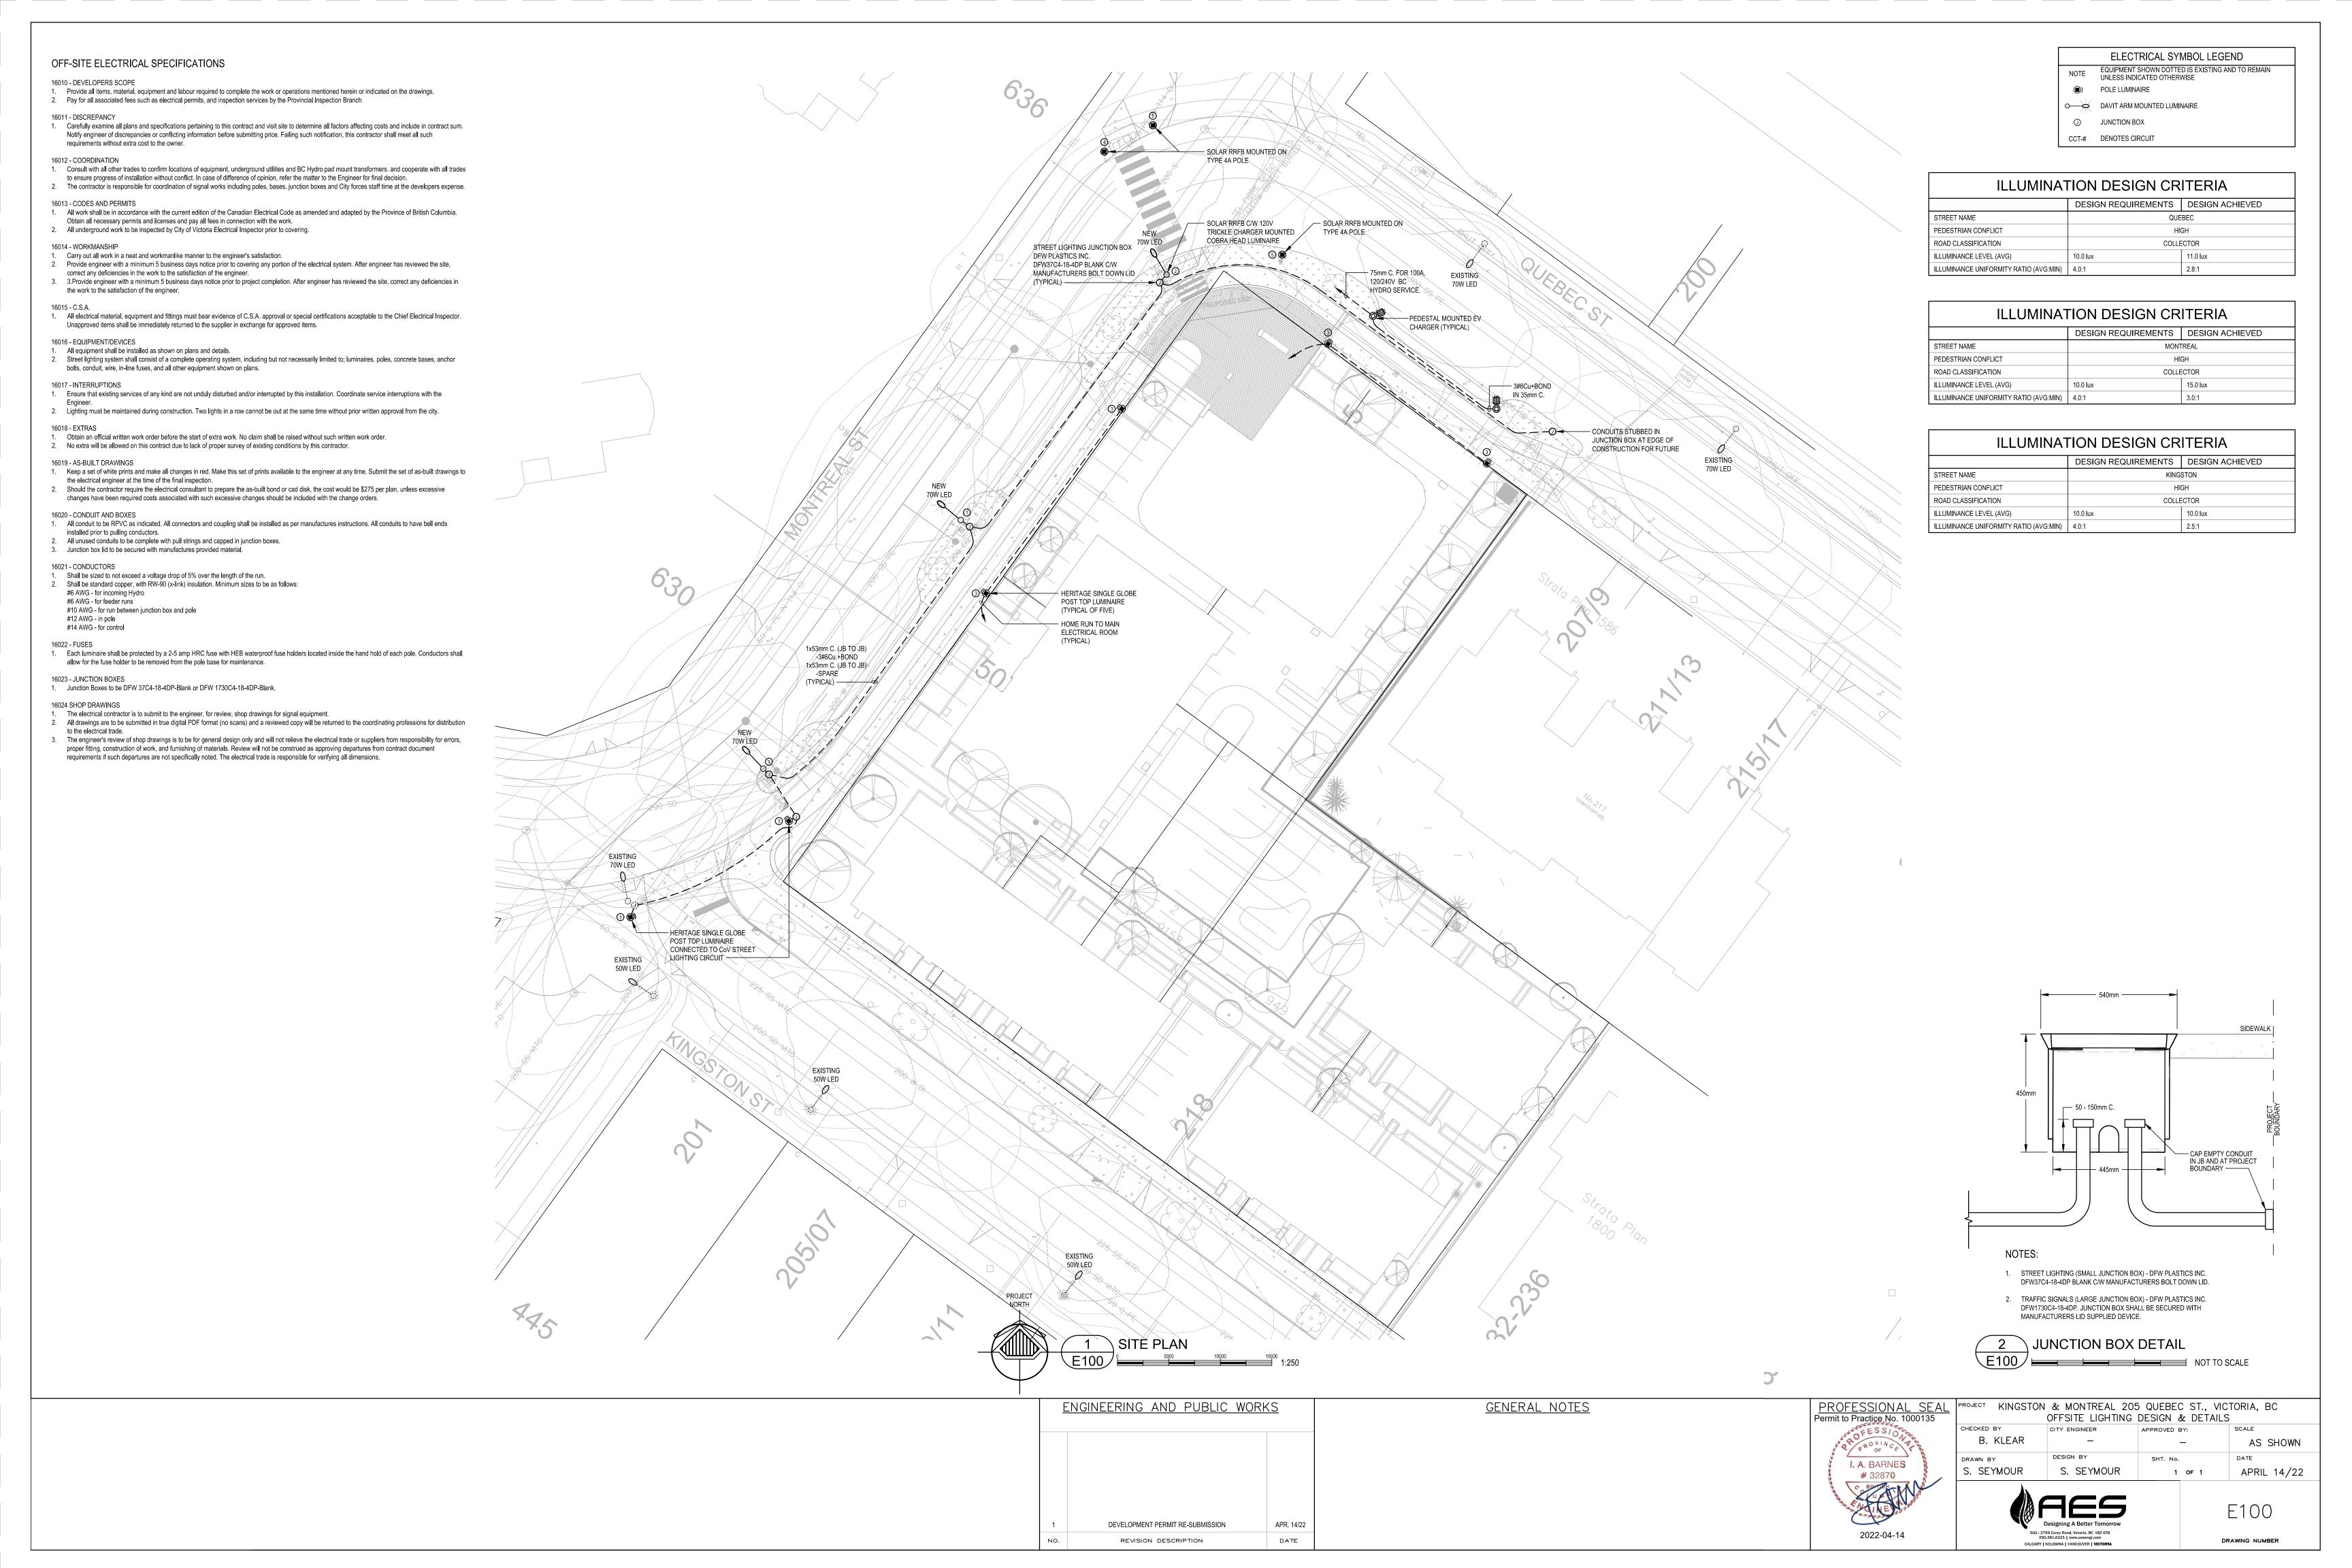

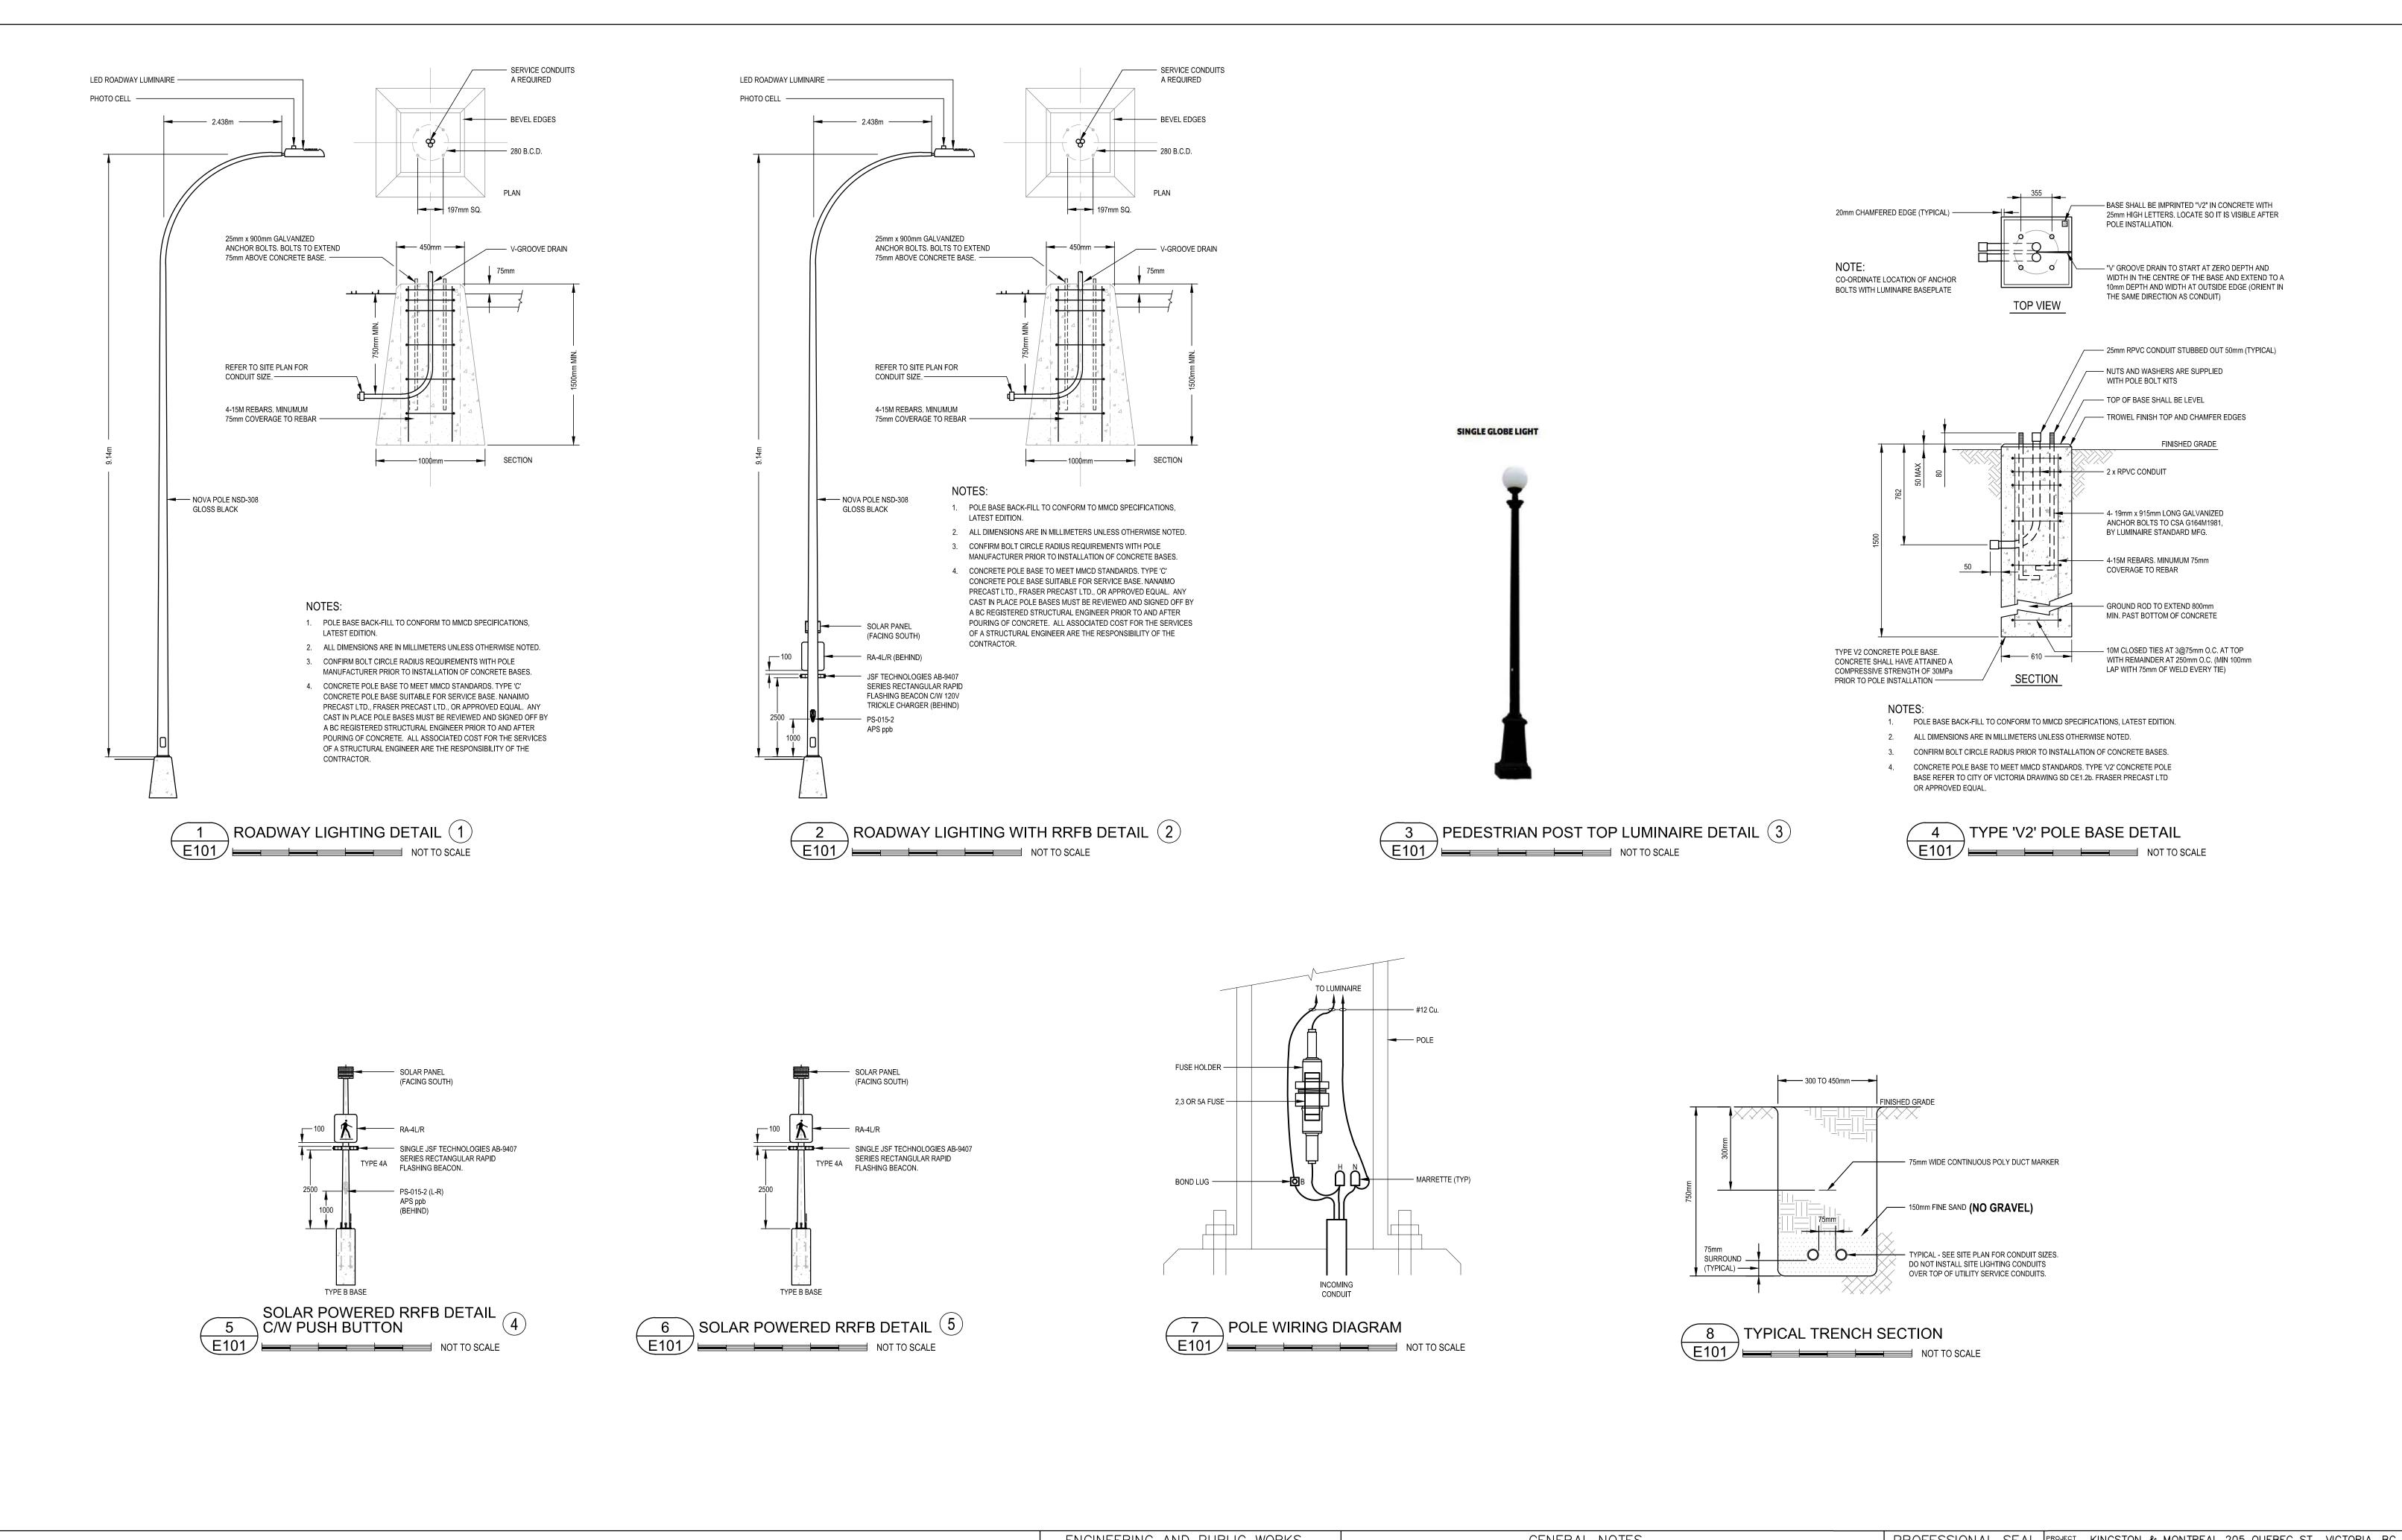

<u>ENGINEERING AND PUBLIC WORKS</u>		<u>GENERAL NOTES</u>	PROFESSIONAL SEAL Permit to Practice No. 1000135	OFFSITE LIGHTING DESIGN & DETAILS			
			OFESSION PERSONNELLE	B. KLEAR	CITY ENGINEER	APPROVED BY:	AS SHOWN
			I. A. BARNES # 32870	DRAWN BY S. SEYMOUR	S. SEYMOUR	SHT. No.	APRIL 14/22
1 DEVELOPMENT PERMIT RE-SUBMISSION	APR. 14/22				Designing A Better Tomorrow		E101
NO. REVISION DESCRIPTION	DATE		2022-04-14	500-3	3795 Carey Road, Victoria, BC V8Z 6T8 250.381.6121 www.aesengr.com		DRAWING NUMBER
NO. REVISION DESCRIPTION	DATE			CALGARY	/ KELOWNA VANCOUVER VICTORIA		DRAWING NUMBER