# ARYZE DEVELOPMENTS INC. - THE ESTOYA

**Received Date** August 21, 2025

1708 Quadra Street, Victoria, B.C.

Mixed-Use Residential/Commercial

2018 Division B Part 3

947.78 SM (10,201.82 SF)

76.50%

23.50%

25.58m

14 Storeys

712.57 SM

Suburban Lot: 4

3.0m @Bike Shelter

**Visitor Parking** 

Required

2.0m @Base

0.85m @Base

3.8m @Base

Plan: City 01516011

4.85m @Tower

4.0m @Tower

2.8m @Tower

6.5m @Tower

2 Van Accessible

1 Accessible

182

71%

25%

100%

1 Standard

North (Side)

East (Quadra Street)

South (Fisgard Street)

West (Rear)

Long Term Bicycle Parking

Short Term Bicycle Parking

UNIT COUNT

PARKING REQUIREMENTS

Parking Required

Parking Required

PROJECT INFORMATION

LEGAL DESCRIPTION

PROJECT DESCRIPTION

**B.C. BUILDING COD** 

SITE AREA

**BUILDING FOOTPRINT AREA** 

SITE COVERAGE

**OPEN SITE SPACE** 

AVERAGE GRADE

SETBACKS

STOREYS

**PARKING PROVIDED** 

BIKE PARKING PROVIDED

**RESIDENTIAL UNIT MIX** 

1 BEDROOM UNIT

2 BEDROOM UNIT

LIVE / WORK

Units/Floor Area

Short Term Bike Parking

Residential

(0.1 Stalls/Unit)

Restaurant CRU

(1.0 Stalls/100 sq.m

Zoning: R3-C

# **dys** architecture




1 | 2023/11/17 | ISSUED FOR 50% REVIEW 2 | 2024/01/26 | ISSUED FOR 65% REVIEW 3 |2024/02/22|ISSUED FOR BP

4 | 2024/05/09 | RE-ISSUED FOR BP 5 | 2024/07/05 | ISSUED FOR DRAFT IFT 6 | 2024/07/13 | ISSUED FOR IFT ADDENDUM #1 7 | 2024/07/31 | ISSUED FOR BP RESPONSE 8 | 2024/10/07 | ISSUED FOR BP RESPONSE #2 9 | 2024/10/20 | ISSUED FOR DRAFT IFC

10 | 2025/01/24 | ISSUED FOR IFC 11 | 2025/03/17 | ISSUED FOR BP RESUBMISSION 12 | 2025/08/07 | ISSUED FOR DDP

NO. | DATE | REVISION

THE ESTOYA

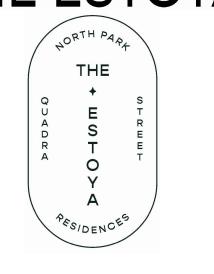



**COVER SHEET, DRAWING LIST &** 

This drawing, as an instrument of service, is the property of **dys** architecture and may not be reproduced

Written dimensions shall have precedence over scaled dimensions. Contractors shall verify and be responsible for all dimensions and conditions on the job and dys architecture shall be informed of any variations from the dimensions and conditions shown on the drawings. Shop drawings shall be submitted to


**PROJECT** A223587

# 1708 QUADRA STREET



SOUTHEAST PERSPECTIVE VIEW

DESIGN CONCEPT DRAWING ONLY - E & O.E.

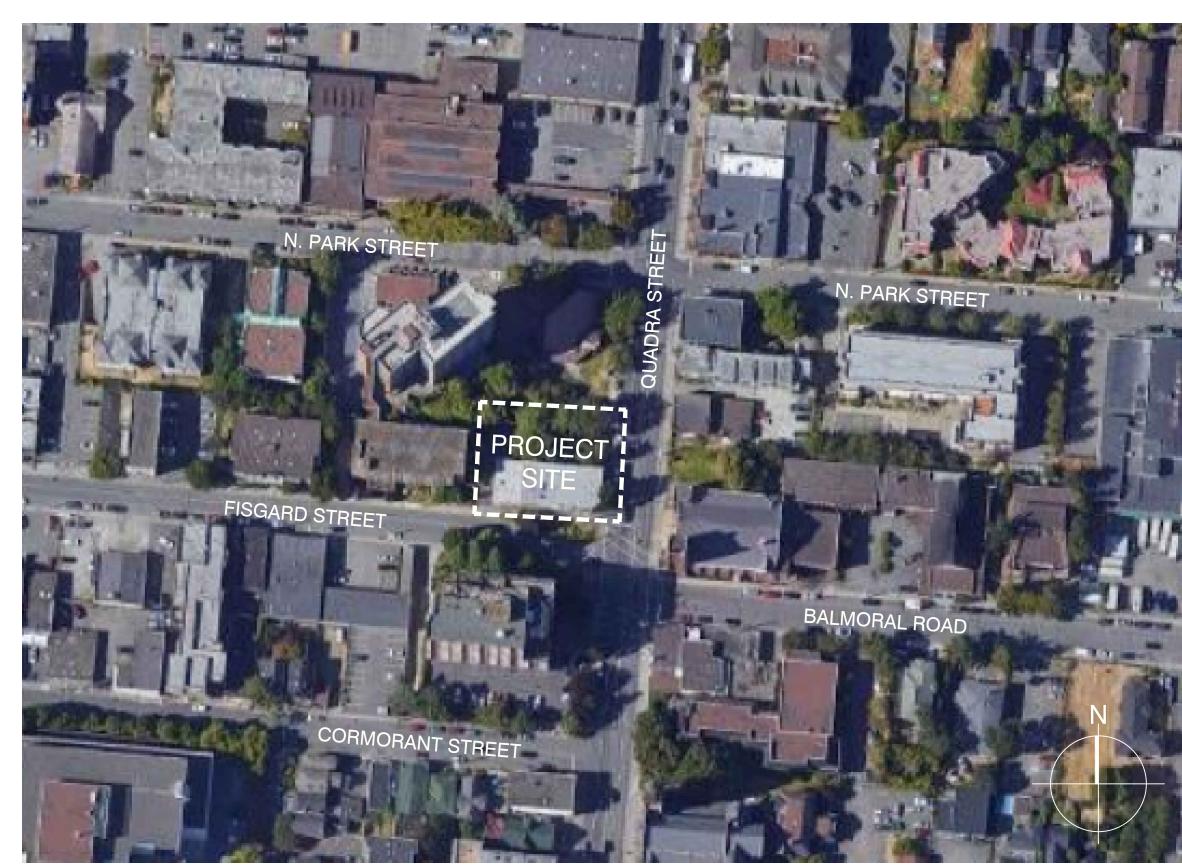

CONTEXT PLAN

# PROJECT TEAM

## **CLIENT**

ARYZE DEVELOPMENTS INC. 1839 FAIRFIELD ROAD, VICTORIA, B.C., V85 169 TEL: (250) 940-3568

# ARCHITECTURAL - C.R.P

DYS ARCHITECTURE 260-1770 BURRARD STREET, VANCOUVER, B.C., V6J 3G7 TEL: (604) 669-7710

# STRUCTURAL

RJC ENGINEERS 1515 DOUGLAS STREET, VICTORIA, B.C., V8W 2G4 TEL: (250) 386-7794

# LANDSCAPE

1608 CAMOSUN STREET VICTORIA, B.C., V8T 3E6 TEL: (250) 590-1156

# **ENVELOPE**

RDH BUILDING SCIENCE 602-740 HILLSIDE AVENUE VICTORIA, B.C., V8T IZ4 TEL: (250) 479-1110

A3.05 BUILDING ELEVATION - LEVEL 13 / ROOFTOP

A2.10A SLAB EDGE PLAN - ROOF

A3.10 NOT USED

A5.03 NOT USED

A5.21 NOT USED

A5.24 NOT USED

A5.25 NOT USED

A5.26 NOT USED

A3.01 BUILDING ELEVATION - SOUTH

A3.03 BUILDING ELEVATION - NORTH

A3.06 BLOWN UP ELEVATION - SOUTH

A3.07 BLOWN UP ELEVATION - SOUTH

A3.08 BLOWN UP ELEVATION - TOWER

A3.09 BLOWN UP ELEVATION - TOWER

A3.II SECTION @PODIUM (LIVE/WORK)

A3.12 SECTION @EXIT PATH (WEST)

A4.01 BUILDING SECTION A-A & B-B

A5.01 PLAN DETAILS - BIKE PARKING

A5.08 PLAN DETAILS - TOWER (EAST) A5.09 PLAN DETAILS - TOWER LEVEL 13

A5.23 SECTION DETAILS @ PODIUM (CRU)

A5.27 SECTION DETAILS @ TOWER

A5.51 BELOW GRADE SECTION DETAILS

A5.06 PLAN DETAILS - LEVEL 2 A5.07 PLAN DETAILS - TOWER (SOUTH)

A4.02 BUILDING SECTION C-C, D-D, E-E & F-F

A5.02 PLAN DETAILS - LOBBY LEVEL I LOWER

A5.04 PLAN DETAILS - LIVE / WORK IO9 ENTRY A5.05 PLAN DETAILS - LIVE / WORK 109 & 110

A5.22 SECTION DETAILS @ PODIUM (LIVE / WORK)

A5.29 SECTION DETAILS @ LEVEL 13/ ROOFTOP

A4.03 BUILDING SECTIONS LIVE/WORK STAIR & ELEVATOR LOBBY

A5.20 SECTION DETAILS @ PODIUM (LOBBY / BIKE PARKING

A3.04 BUILDING ELEVATION - WEST

A3.02 BUILDING ELEVATION - EAST

DRAWING LIST

### DYS ARCHITECTURE 201-560 JOHNSON STREET, VICTORIA, B.C., V8W 3C6

TEL: (250) 580-2855

# **MECHANCIAL**

AVALON MECHANICAL 300-1245 ESQUIMALT ROAD, VICTORIA, B.C., V9A 3P2 TEL: (250) 940-2976

# CIVIL

MCELHANNEY SUITE 500-3960 QUADRA STREET, VICTORIA, B.C., V8X 4A3 TEL: (778) 746-7417

## SURVEYOR

J.E. ANDERSON & ASSOCIATES 4212 GLANFORD AVENUE VICTORIA, B.C., V8Z 4B7 TEL: (250) 727-2214

1:50

1:100

1:100

1:100

1:100

1:25

1:25

1:25

1:25

1:100

1:100

AS NOTED

NOT USED

NOT USED

NOT USED

NOT USED

NOT USED

NOT USED

AS NOTED

1:10

1:10

NOT USED

AS NOTED AS NOTED

AS NOTED

# ARCHITECTURAL - DESIGN

5468796 ARCHITECTURE INC. 266 MCDERMOT AVENUE, WINNIPEG, M.B., R3B 058 TEL: (204) 480-8421

# **ELECTRICAL**

e2 ENGINEERING 549 HERALD STREET, VICTORIA, B.C., V&W 195 TEL: (778) 433-9391

# **GEOTECHNICAL**

RYZUK GEOTECHNICAL #6-40 CADILLAC AVENUE, VICTORIA, B.C., V8Z IT2 TEL: (250) 475-3131

GHL CONSULTANTS LTD 700 W. PENDER STREET, SUITE 800 VANCOUVER, B.C., V6C 1G8 TEL: (604) 689-4449

ARCH	HITECTURAL				
	COVER PAGE, PROJECT TEAM, DRAWING LISTS	PROJECT INFORMATION			REFLECTED CEILING PLAN - BASEMENT LEVEL B2
A0.02	GENERAL NOTES		N.T.S.		REFLECTED CEILING PLAN - BASEMENT LEVEL BI - PARKING
A0.03	SURVEY		AS NOTED		REFLECTED CEILING PLAN - LEVEL   LOWER
A L OL	CITE DI ANI		1.100		REFLECTED CEILING PLAN - LEVEL   UPPER
Al.Ol	SITE PLAN		1:100		REFLECTED CEILING PLAN - LEVEL 2
Al <i>.0</i> 2	FIRE ACCESS PLAN		1:100		REFLECTED CEILING PLAN - LEVEL 3
A2.01	BASEMENT LEVEL B2		I:5 <i>O</i>		REFLECTED CEILING PLAN - LEVEL 4, 6, 8, 10 & 12 REFLECTED CEILING PLAN - LEVEL 5, 7, 9 & 11
	BASEMENT LEVEL BI - PARKING		1:50 1:50		REFLECTED CEILING PLAN - LEVEL 3, 1, 4 ¢ 11  REFLECTED CEILING PLAN - LEVEL 13
	SLAB EDGE PLAN - BASEMENT LEVEL BI - PARK	ING	1:50 1:50	A0.04	ALI LECTED CEILING FLAN - LEVEL 13
	FLOOR PLAN - LEVEL I LOWER	NINO.	1:5 <i>0</i>	A7.01	STAIR SI, S2, S3, S4 & CRU STAIR DETAIL PLANS & SECTIONS
	SLAB EDGE PLAN - LEVEL I LOWER		1:50 1:50		L/W STAIR DETAIL PLAN & SECTION, TYP. STAIR & RAILING DETAILS
	FLOOR PLAN - LEVEL I UPPER		1:5 <i>0</i>	/11.02	LITT STATE OF THE PERIOD OF THE STATE OF THE
	SLAB EDGE PLAN - LEVEL I UPPER		1:50	A9.OIA	ASSEMBLY SCHEDULE
	FLOOR PLAN - LEVEL 2		1:50		ASSEMBLY SCHEDULE
	SLAB EDGE PLAN - LEVEL 2		1:50	A9.02	
	FLOOR PLAN - LEVEL 3		I:50		WINDOW SCHEDULE
A2.06A	SLAB EDGE PLAN - LEVEL 3		I:5 <i>O</i>	A9.04	WINDOW SCHEDULE
A2.07	FLOOR PLAN - LEVELS 4, 6, 8, 10 \$ 12 (LE	EVEL 4 SHOWN)	1:50	A9.05	WINDOW SCHEDULE
A2.07A	SLAB EDGE PLAN - LEVELS 4, 6, 8, 10 \$ 12		I:5 <i>O</i>		
A2.08	FLOOR PLAN - LEVELS 5, 7, 9 & II (LE	EVEL 5 SHOWN)	I:50		
A2.08A	SLAB EDGE PLAN - LEVELS 5, 7, 9 & 11		I:5 <i>O</i>		
A2.09	FLOOR PLAN - LEVEL 13		1:50		
A2.09A	SLAB EDGE PLAN - LEVEL 13		I:50		
A2.I0	ROOF PLAN		I:5 <i>O</i>		

REFLECTED CEILING PLAN - BASEMENT LEVEL B2 REFLECTED CEILING PLAN - BASEMENT LEVEL BI - PARKING REFLECTED CEILING PLAN - LEVEL I LOWER REFLECTED CEILING PLAN - LEVEL I UPPER REFLECTED CEILING PLAN - LEVEL 2 REFLECTED CEILING PLAN - LEVEL 3 REFLECTED CEILING PLAN - LEVEL 4, 6, 8, 10 & 12 REFLECTED CEILING PLAN - LEVEL 5, 7, 9 & 11	1:50 1:50 1:50 1:50 1:50 1:50 1:50
REFLECTED CEILING PLAN - LEVEL 13	l:50
STAIR SI, S2, S3, S4 & CRU STAIR DETAIL PLANS & SECTIONS L/W STAIR DETAIL PLAN & SECTION, TYP. STAIR & RAILING DETAILS	1:50 AS NOTED
ASSEMBLY SCHEDULE ASSEMBLY SCHEDULE DOOR SCHEDULE	AS NOTED AS NOTED AS NOTED

	1:5 <i>0</i>		
	1:5 <i>0</i>	7	
	1:5 <i>0</i>	>	
	1:5 <i>O</i>	>	_
	1:5 <i>0</i>		Re
	1:5 <i>0</i>	(	
		7	
TIONS	1:5 <i>0</i>	7	
ING DETAILS	AS NOTED	>	
		5	
	AS NOTED		
	AS NOTED		
	AS NOTED	7	
	AS NOTED	>	
	AS NOTED	>	
	AS NOTED	(	

(0.5 Stalls/ Unit)			
45 sq.m to 70 sq.m (0.6 Stalls/ Unit)	46	28	9
70 sq.m or more (1.0 Stalls/ Unit)	1	1	(0.1 spaces/un
Restaurant CRU (193.09 sq.m) (1.0 Stalls/ 40 sq.m)	1	5	
Total	92	56	9
			1
BIKE PAR Long Term Bike Parking	Number of Units	Parking Required	
	Number of Units		
Long Term Bike Parking  45 sq.m or less (1.0 Stalls/ Unit)		Parking Required  44	
Long Term Bike Parking  45 sq.m or less (1.0 Stalls/ Unit)  45 sq.m or more	Number of Units		
Long Term Bike Parking  45 sq.m or less (1.0 Stalls/ Unit)  45 sq.m or more (1.25 Stalls/ Unit)	Number of Units  44	44	
Long Term Bike Parking  45 sq.m or less (1.0 Stalls/ Unit)  45 sq.m or more (1.25 Stalls/ Unit)  Restaurant CRU (193.09 sq.m)	Number of Units  44	44	
Long Term Bike Parking  45 sq.m or less (1.0 Stalls/ Unit)  45 sq.m or more (1.25 Stalls/ Unit)	Number of Units  44  47	44 59	

Number of Units

193.09 sq.m

Number of Units

	Gross Flo	oor Area
	sq. m.	sq. ft.
Level 1 Lower	319.47	3,438.74
Level 1 Upper	132.18	1,422.77
Level 2	438.22	4,716.90
Level 3	423.22	4,555.44
Level 4	423.22	4,555.44
Level 5	423.22	4,555.44
Level 6	423.22	4,555.44
Level 7	423.22	4,555.44
Level 8	423.22	4,555.44
Level 9	423.22	4,555.44
Level 10	423.22	4,555.44
Level 11	423.22	4,555.44
Level 12	423.22	4,555.44
Level 13	81.57	878.01
Total	5,203.59	56,010.87
	sq. m.	sq. ft.
Area of Residential	5,010.49	53,932.44
Area of Commercial	193.09	2,078.43
Building Footprint Area	712.57	7,670.03
Site Area	947.78	
FSR	5.49	

Total Parking Required	NORTH PAP
	\
60	+ S T R E T R E



1708 QUADRA STREET VICTORIA, B.C.

# PROJECT INFORMATION

production carries their name. All designs and other information shown on this drawing are for use on the without written permission of **dys** architecture. Payment of all sums due to **dys** architecture up to the the use thereof.

dys architecture for review before proceeding with

tel 604 669 7710 www.dysarchitecture.com



NO. | DATE | ISSUE


1 | 2024/01/26 | ISSUED FOR 65% REVIEW 2 | 2024/02/22 | ISSUED FOR BP

3 | 2024/05/09 | RE-ISSUED FOR BP 4 | 2024/07/05 | ISSUED FOR DRAFT IFT 5 | 2024/07/13 | ISSUED FOR IFT ADDENDUM #1 6 | 2024/07/31 | ISSUED FOR BP RESPONSE

7 | 2024/10/07 | ISSUED FOR BP RESPONSE #2 8 | 2024/10/20 | ISSUED FOR DRAFT IFC 9 | 2025/01/24 | ISSUED FOR IFC

NO. | DATE | REVISION

# THE ESTOYA

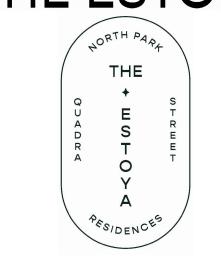

**PROJECT** 

1708 QUADRA STREET

**GENERAL NOTES** 

This drawing, as an instrument of service, is the property of **dys** architecture and may not be reproduced

production carries their name. All designs and other information shown on this drawing are for use on the

specified project only and shall not be used otherwise

without written permission of **dys** architecture. Payment of all sums due to **dys** architecture up to the

Written dimensions shall have precedence over scaled

the use thereof

PROJECT A223587

**DATE** JAN. 11, 2024

VICTORIA, B.C.

METERS A.F.F.

MATERIAL

5. KITCHEN BULKHEADS TO BE ±7'-0" A.F.F. (TOP OF UPPER MILLWORK CABINETS) U.N.O.

7. ALL FINISHED CEILING HEIGHTS NOT DENOTED AREA TO U/S OF STRUCTURE, TYP. 8'-0" A.F.F. AT SUSPENDED SLAB

(VALANCE IN FRONT OF WINDOWS, TYPICAL)

PAINTED GWB CEILING DROPS TO BE NO LESS THAN 7'-8" (2340mm) A.F.F. EXCEPT AS NOTED.

- 'OFF-STREET PARKING REGULATIONS.
- CEILING HEIGHTS TO ALL PARKING LEVELS SHALL HAVE A MININUM VERTICAL UNOBSTRUCTED CLEARANCE (INCLUDIG ALL PIPES AND
- CROSS-WALKS AND NON-PARKING AREAS SHALL BE YELLOW LINES.
- NUMBERS AT FRONT OF STALL. STALL NUMBERING AND SEQUENCING TO BE DETERMINED BY OWNER. 5. ALL PARKING STALLS DESIGNATED AS AN ACCESSIBLE STALL TO HAVE AN INTERNATIONAL SYMBOL OF ACCESSIBILITY CLEARLY PAINTED
- 6. ALL STALL MARKINGS AND PAINTED STALL LINES TO BE WHITE UNLESS DIRECTED OTHERWISE BY THE OWNER.

- 8. CLEAR SEAL FINISH ON CONCRETE WALLS.
- 9. ALL EXPOSED CONCRETE CORNERS TO COLUMNS AND WALLS TO HAVE 3/4" CHAMFER.
- URETHANE TRAFFIC MEMBRANE AS PER 'C.S.A. -5413 PARKADE STRUCTURES' TO BE APPLIED THROUGHOUT PARKING GARAGE SUSPENDED CONCRETE SLAB VEHICULAR ARES. ADDITIONAL MEMBRANE PER SPEC. TO BE APPLIED AT ALL DROPPED SLABS/ CONCRETE TOPPING
- 12. ALL PARKADE LEVEL EXTERIOR WALLS BELOW GRADE IN FIISHED CODITION TO BE WATER PROOFED AS PER SPEC. AND WATER STOP AT
- 14. ALL GLAZING, DOORS, WALLS AND SERVICES ENCLOSURES IN THE PARKING LEVELS STAIRS, STAIR VESTIBULES AND ELEVATOR LOBBIES TO
- 15. ALL GLAZING IN PARKING LEVELS TO BE WIRED SAFETY GLASS IN STEEL FRAMES.

# SYMBOL LEGEND

INDICATES HORIZONTAL ENCLOSURE, BULKHEAD OR DROP CEILING

F.E.C. = FIRE EXTINGUISHER CABINET

SC = OVERFLOW SCUPPER SP = STAND PIPE, SEE MECHANICAL DRAWINGS

DOOR TYPE (IOOA) WINDOW TYPE

WALL TYPE (WFI) CHANGE IN FINISH O HR SMOKE SEPARATION 3/4 HR FIRE SEPARATION I HR FIRE SEPARATION **—**060m **—**060m **—**060m **—**060m **—** 

-090m -090m -090m -090m -I-I/2 HR FIRE SEPARATION 2 HR FIRE SEPARATION

-120m -120m -120m -120m -120m --180m -180m -180m -180m -180m -3 HR FIRE SEPARATION

SHOWN AS FIRE RESISTANCE RATING WHERE REQUIRED AT EXTERIOR WALLS, FIRE RESISTANCE RATINGS ARE CONTINUOUS ACROSS TOP AND BOTTOM OF OPENINGS.

# **GENERAL NOTES**

- ALL INTERIOR STUD WALLS (IN RESIDENTIAL UNITS) ARE TYPE 'WI' U.N.O.
- 2. ALL RESIDENTIAL SUITE TO RESIDENTIAL SUITE DEMISING WALLS ARE TYPE 'PWI' U.N.O. 3. ALL RESIDENTIAL SUITE TO CORRIDOR DEMISING WALLS ARE TYPE 'PW2' U.N.O.
- 4. INSTALL STEEL STUD FRAMING AND GWB FROM SLAB TO SLAB, TYPICAL.
- 5. ALL INTERIOR WALL DIMENSIONS ARE TO FACE OF STUD, CONCRETE WALL, OR CONCRETE BLOCK U.N.O.
- 6. ALL EXTERIOR WALL DIMENSIONS ARE TO FACE OF EXTERIOR SHEATHING, CONCRETE WALL, CONCRETE BLOCK, CONCRETE SLAB U.N.O. LARGER STUD SIZES FOR PLUMBING LINES AS PER MECHANICAL DRAWINGS, CONFIRM SIZES & LOCATION OF STUDS AT EACH FLOOR.

BUILDING GRADE

EXISTING GRADE

NEW DESIGN GRADE

INTERPOLATED BUILDING GRADE

INTERPOLATED GRADE FROM SURVEY

SPOT ELEVATION (FOR ELEVATION)

SPOT ELEVATION (FOR INTERIOR)

TOP OF STRUCTURAL SLAB

TOP OF WALL

TOP OF CURB

TOP OF PARAPET

BOTTOM OF WALL

CEILING ELEVATION

- 8. PROVIDE CEILING DROPS AS REQUIRED IN BATHROOMS, KITCHENS, & WHERE NOTED & AS DETAILED. (SEE REFLECTED CEILING PLANS AND
- 9. SHADED AREAS ILLUSTRATE MINIMUM CEILING DROPS REQUIRED, COORDINATE ALL DROPS WITH MECH., ELEC., AND I.D. DRAWINGS. 10. PROVIDE SOLID BLOCKING FOR ALL GRAB BARS, AND ALL FUTURE GRAB BARS, MILLWORK, ETC. II. U.N.O., SEE INTERIOR DESIGN DRAWINGS FOR INTERIOR ELEVATIONS & FINISHES, AND MILLWORK DETAILS, TYPICAL.
- 12. AT FLUSH HEAD TO HEAD JOINTS BETWEEN TWO DRYWALL ASSEMBLIES WITH DIFFERENT THICKNESS OF GWB, ALWAYS USE THE THICKER GWB
- 13. ALL CONCRETE PLANTER WALLS, CONCRETE CORBELS, AND EXPOSED CONCRETE AT GRADE TO BE MEDIUM SANDBLASTED OR PATCHED AND
- 14. ALL CONCRETE BLOCK WALLS ARE TYPE 'BWI' U.N.O.

# CONSTRUCTION ASSEMBLY NOTES

- AT FIRE SEPARATIONS OR WHERE FIRE RATINGS ARE REQUIRED, RUN TYPE 'X' GWB BEHIND BATHTUBS, SHOWERS, CABINETS, WALL FURRING,
- CEILING DROPS & BULKHEADS, ETC. AT FULL WALL HEIGHT, TYPICAL . PROVIDE AQUA BOARD / WATER RESISTANT GWB IN ALL BATHROOMS, WASHROOMS, AND JANITOR ROOMS BEHIND
- ALL TUBS, SHOWERS, FIXTURES, VANITIES, AND AT CEILING, TYPICAL. (ALL GWB SHALL BE CONTINUOUS AT FULL WALL HEIGHT, TYP.) TYPICAL BATH TUB / SHOWER SURROUNDING WALL ASSEMBLY
- CERAMIC TILES ON THICK-SET ON
  - WATER RESISTANT GWB
- NOTE: WHERE TILES MEET THE TUB OR SHOWER PAN, THE JOINT TO BE A CAULKED JOINT.
- AT ALL PARTY WALLS BETWEEN SUITE TO SUITE AND SUITE TO CORRIDOR, APPLY TWO BEADS OF ACOUSTICAL CAULKING AT TOP AND BOTTOM TRACKS BETWEEN GWB AND CONCRETE STRUCTURE, TYPICAL
- APPLY ACOUSTICAL / DEFLECTION CAULKING AT ALL JOINTS BETWEEN GWB AND ALL OTHER SURFACES, TYPICAL
- 6. WHERE ABSORPTIVE MATERIAL IS NOTED IN WALL ASSEMBLIES, USE FIBERGLASS BATT INSULATION, TYPICAL. (EXCEPT AROUND HEAT PUMP
- ADD AND INSTALL SEMI RIGID MINERAL WOOL INSULATION IN WALL ASSEMBLIES AROUND HEAT PUMP CLOSET, TYPICAL 8. ADD AND INSTALL FIBERGLASS BATT INSULATION IN WALLS & CEILINGS AROUND BATHROOMS AND ENSUITES, TYPICAL
- 9. ALL FIRE SEPARATIONS / FIRE RATED WALL ASSEMBLIES TO DEMISE FROM FLOOR SLAB TO UNDERSIDE OF FLOOR SLAB ABOVE, INCLUDING AT ALL SHOWER HEADS, TUB FILLERS, AND MANIFOLD LOCATIONS. ADD 4" WALL FURRING ONTO THE FINISHED FIRE SEPARATIONS / FIRE RATED WALL ASSEMBLIES, WHERE SHOWN.

# REFLECTED CEILING GENERAL NOTES

- REFER TO MECHANICAL AND ELECTRICAL DRAWINGS FOR LOCATIONS OF CEILING MOUNTED DEVICES
- SPRINKLER HEADS TO BE CENTRED IN CORRIDORS
- 3. ALL HORIZONTAL RATED SHAFTS TO HAVE I HOUR FIRE RESISTANCE RATING U.N.O. 4. ALL CORRIDOR GWB DROPS TO BE FRAMED WITH STEEL STUD
- 6. SUITE GWB DROPPED CEILINGS IN KITCHEN AND WASHROOM TO BE 7'-6" A.F.F. U.N.O.
- ALSO REFER TO REFLECTED CEILING PLANS FOR CEILING HEIGHTS & FINISHES WHERE NOTED.
- PUBLIC CORRIDORS: PAINTED GWB CEILING DROPS TO BE NO LESS THAN 8'-O" (2440mm) A.F.F. EXCEPT AS NOTED
- LIVING / DINING: PAINTED CONCRETE. NO DROPPED CEILING EXCEPT AS NOTED. BEDROOM / DENS: PAINTED CONC. OR PAINTED GWB CEILING DROPS TO BE NO LESS THAN 7'-8" (2340mm) A.F.F. AS SHOWN.
- PAINTED GWB CEILING DROPS TO BE NO LESS THAN 7'-8" (2340mm) A.F.F. EXCEPT AS NOTED. ENSUITES / BATHROOMS LAUNDRY / STORAGE ROOMS: PAINTED GWB CEILING DROPS TO BE NO LESS THAN 7'-8" (2340mm) A.F.F. EXCEPT AS NOTED. KITCHENS: PAINTED GWB CEILING DROPS TO BE NO LESS THAN 7'-8" (2340mm) A.F.F. EXCEPT AS NOTED.
- CLOSETS: LI MAIN LOBBY: REFER TO I.D. DRAWINGS.

# PARKING LEVELS GENERAL NOTES

# THE DESIGN OF THE PARKING STRUCTURE REGARDING SAFETY AND SECURITY MEASURES SHALL BE IN ACCORDANCE WITH CITY OF VICTORIA

- MECHANICAL) OF 2100mm (6'-10 3/4" PER 'OFF-STREET PARKING REGULATIONS. THE PARKING LINES SHALL BE WHITE 4" WIDE AND EXTEND 4'-O" UP WALLS. FLOOR AREA DEMARCATION, PEDESTRIAN WALKWAYS,
- PARKING STALL NUMBERS AND 'SMALL CAR' AND/ OR 'VISITOR' TO DESIGNATIONS TO BE PAINTED IN "18" LETTERS. PROVIDE PAINTED STALL
- WITHIN THE STALL ON THE PARKADE SLAB.
- CLEAR SEAL FINISH ON CONCRETE COLUMNS WITH 12" BLUE STRIPE AT 48"
- 10. 3'-0" HIGH STEEL PIPE GUARDS 1/4" THICK AND PRIME PAINTED (UNDERSIDE MAX. 12" ABOVE FLOOR) TO BE PROVIDED FOR ALL EXPOSED PIPES IN PARKADE
- ALL VERTICAL AND HORIZONTAL JOINTS. 13. ALL PARKADE SHAFTS FOR EXHAUST, INTAKE AIR, EMERGENCY GENERATOR & VENTS ARE SEALED AS PER SPECIFICATION & HAVE FLOOR
- BE SUITABLE FOR REQUIRED FIRE SEPARATION RATING PER BC BUILDING CODE 2018.

<u>PLAN</u>

**ELEVATION** 

DOOR OPENER

-MIN. 600mm

MAX. 1500mm

-DOOR OPENER

- MIN. 150mm

MAX. 300mm

FOOT OPERATED

DOOR OPENER

STANDARD

CAR

ADAPTABLE BATHROOM ILLUSTRATION

- MIN. 600mm HORIZONTAL GB

INSTALLATION OF GRAB BAR

- BLOCKING FOR FUTURE

400-500mm

GB WITH MIN. 1000mm

COMPONENTS

HORIZONTAL AND

750mm VERTICAL

BLOCKING FOR FUTURE INSTALLATION

OF GRAB BAR

MIN. 1200mm

HORIZONTAL GB

BLOCKING FOR

OF GRAB BAR-

BATHTUB

FUTURE INSTALLATION

HATCHED AREA DENOTED REQUIRED SOLID BLOCKING

FOR FUTURE ORAB BARS

REFER TO INTERIOR DESIGN

DRAWINGS FOR CONFIGURATION

AND MATERIALS

-MIN. 1200mm VERTICAL

GB ON BOTH SIDES OF

FUTURE INSTALLATION

BATHTUB

BLOCKING FOR

OF GRAB BAR

80-120mm

GB WITH HORIZONTAL AND VERTICAL

50-80mm

COMPONENT WITH MIN. OF 760mm -

BLOCKING FOR FUTURE

WATER CLOSETS

MIN. 1000mm

VERTICAL GB-

BLOCKING FOR

INSTALLATION OF

GRAB BAR ---

MIN. 1200mm VERTICAL

GB ON BOTH SIDES OF

FUTURE INSTALLATION

FUTURE

**SHOWERS** 

Bathtub -

BLOCKING FOR

OF GRAB BAR -

INSTALLATION OF GRAB BAR-

# PLOT STAMP: 2025-Jan-28 @2:03pm - P:\A223587 - Aryze - Quadra Victoria\CAD\3-WD\A223587\_cover.dwg - A0.02

FIRE PROTECTION and LIFE SAFETY SYSTEMS

- AUTOMATIC ACTIVATION OF THE MECHANICAL SYSTEM TO PRESSURIZE BELOW-GRADE EXIT STAIRS - SENTENCE 3.2.6.2.(2)

- SMOKE DAMPERS WILL CLOSE UPON ACTIVATION OF SMOKE DETECTOR LOCATED WITHIN 1.5m HORIZONTALLY OF THE DUCT OR

CARGO

**BICYCLE STALL** 

-A VEHICLE PARKING SPACE THAT ABUTS A STRUCTURE ON ONE SIDE, SUCH AS A WALL OR COLUMN, MUST HAVE A MINIMUM WIDTH OF 2.7m

-A VEHICLE PARKING SPACE THAT ABUTS A STRUCTURE ON BOTH SIDES, SUCH AS A WALL OR COLUMN, MUST HAVE A MINIMUM WIDTH OF 3.0m

-WHERE A VEHICLE PARKING SPACE OR DRIVE AISLE IS LOCATED UNDERGROUND OR COVERED BY A ROOF, A MINIMUM UNOBSTRUCTED HEIGHT CLEARANCE OF 2.Im

MUST BE PROVIDE BETWEEN THE FLOOR AND ANY MECHANICAL EQUIPMENT, OR, IF THERE IS NO MECHANICAL EQUIPMENT, BETWEEN THE FLOOR AND THE CEILING.

**ACCESSIBLE** 

PARKING

- CORRIDOR PRESSURIZATION SYSTEM STAYS ON UNLESS DUCT SMOKE DETECTOR IS ACTIVATED - SENTENCE 3.2.6.2.(5)

- THE EXIT STAIR MECHANICAL PRESSURIZATION SYSTEM WILL BE USED TO PRESSURIZE THE VESTIBULE CONNECTION THE EXIT STAIR TO THE STORAGE ROOM

**AUTO DOOR OPERATOR** 

MAX. 1500mm

- AIR MOVING FANS IN A SYSTEM SERVING MORE THAN 2 STOREYS WILL SHUT OFF UPON DUCT SMOKE DETECTOR ACTIVATION - SENTENCE 3.2.6.2.(5)

UPON ACTIVATION OF A FIRE ALARM SIGNAL THE FOLLOWING WILL HAPPEN:

LOCATED AT LEVEL B2 - ALTERNATIVE SOLUTION I

AIR-TRANSFER OPENING - SENTENCE 3.1.8.11.(3)

BICYCLE STALL SIZES

GROUND

ANCHORED

-PROPOSED A MINIMUM CLEAR WIDTH OF 1.5m FOR PEDESTRIAN AISLE

WALL

MOUNTED


-ALL PARKING STALLS WILL BE EQUIPPED WITH AN ENERGIZED ELECTRIC VEHICLE OUTLETS.


PARKING STALL SIZES

ACCESSIBLE


PARKING

- ABOVE-GRADE EXIT STAIRS WILL BE BOTTOM-VENTED - SENTENCE 3.2.6.2.(3)

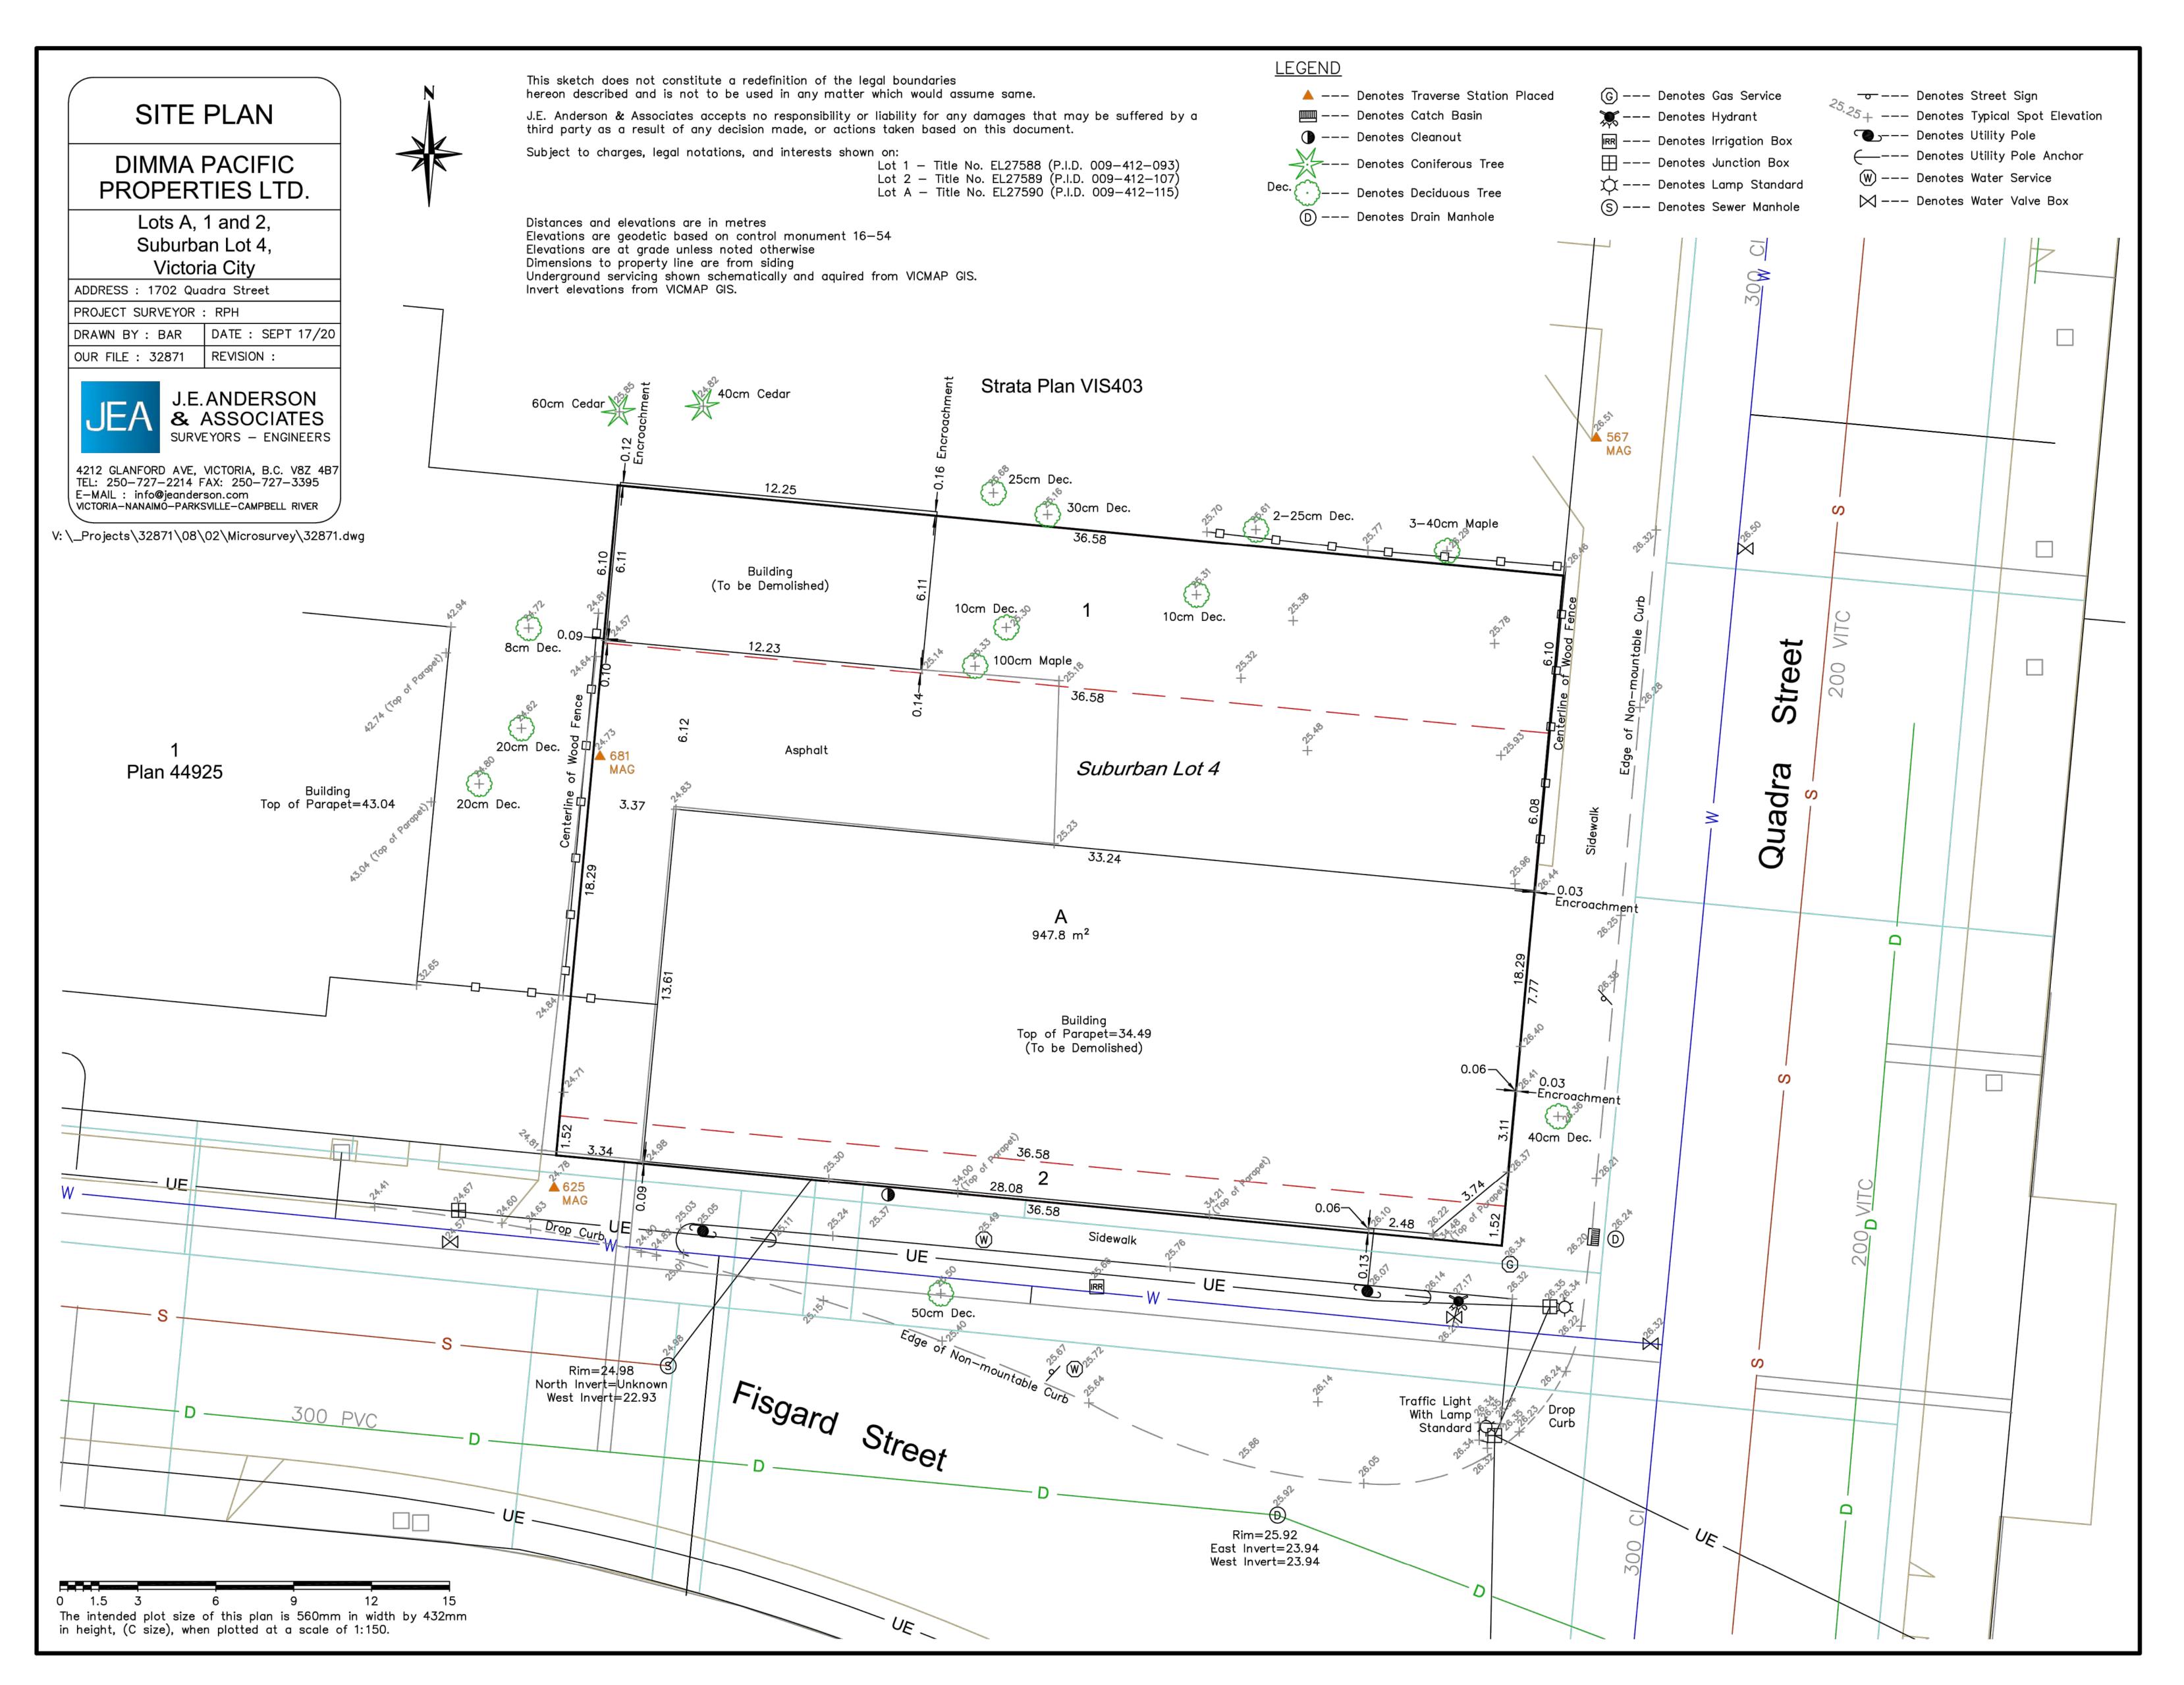

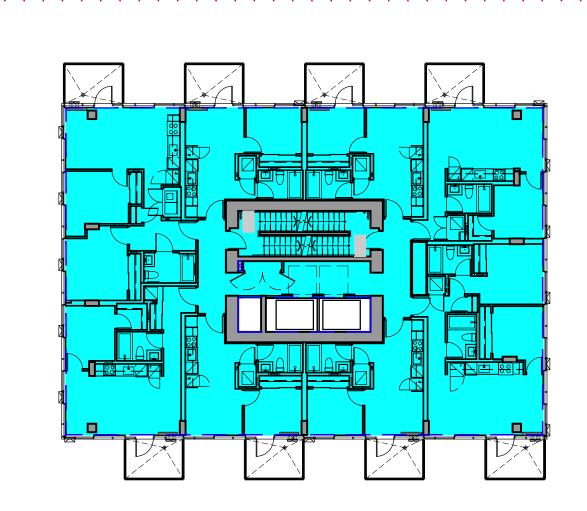


423.21 SQ. M.

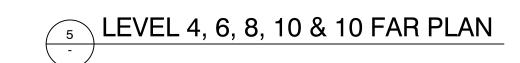


	Gross Flo	oor Area
	sq. m.	sq. ft.
Level 1 Lower	313.79	3,377.60
Level 1 Upper	145.88	1,570.24
Level 2	438.71	4,722.18
Level 3	423.21	4,555.34
Level 4	423.21	4,555.34
Level 5	423.21	4,555.34
Level 6	423.21	4,555.34
Level 7	423.21	4,555.34
Level 8	423.21	4,555.34
Level 9	423.21	4,555.34
Level 10	423.21	4,555.34
Level 11	423.21	4,555.34
Level 12	423.21	4,555.34
Level 13	81.40	876.18
Total	5,211.83	56,099.56
	sq. m.	sq. ft.
Area of Residential	5,018.73	54,021.13

4		
	sq. m.	sq. ft.
Area of Residential	5,018.73	54,021.13
Area of Commercial	193.09	2,078.43
Building Footprint Area	712.57	7,670.03
Site Area	947.78	
ECD	5 50	

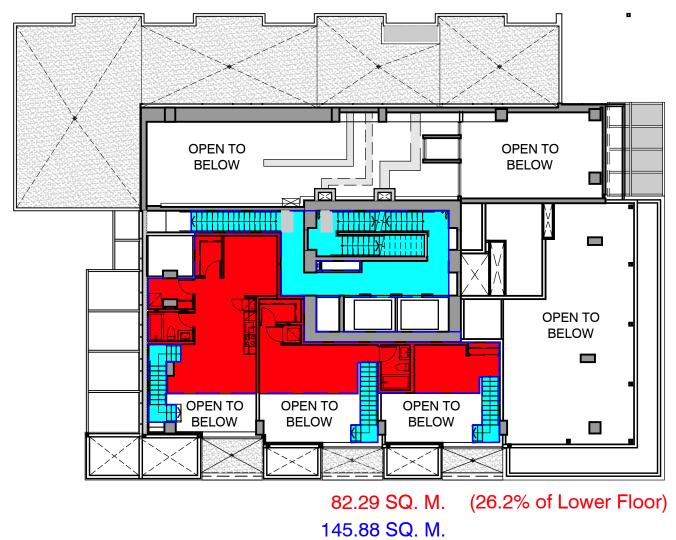


LEVEL 1 UPPER FAR PLAN

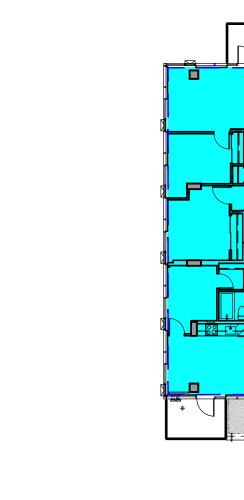


LEVEL 3 FAR PLAN


423.21 SQ. M.

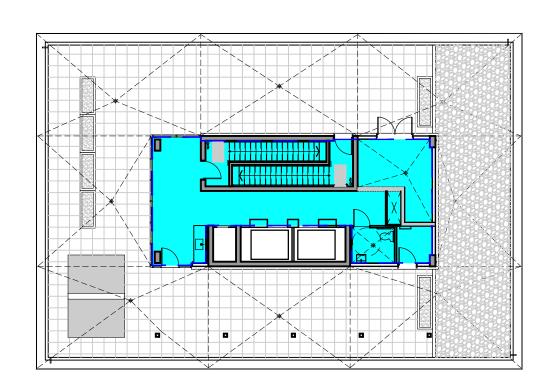


81.40 SQ. M.



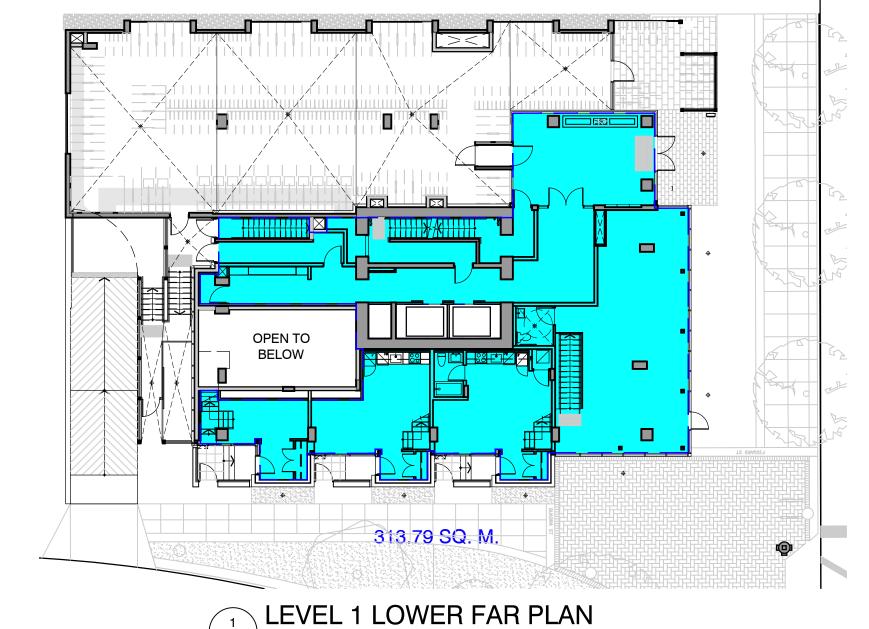


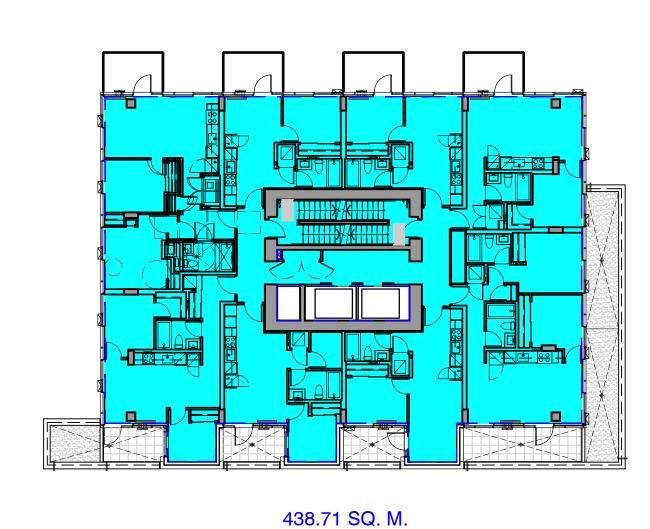

LEVEL 2 FAR PLAN

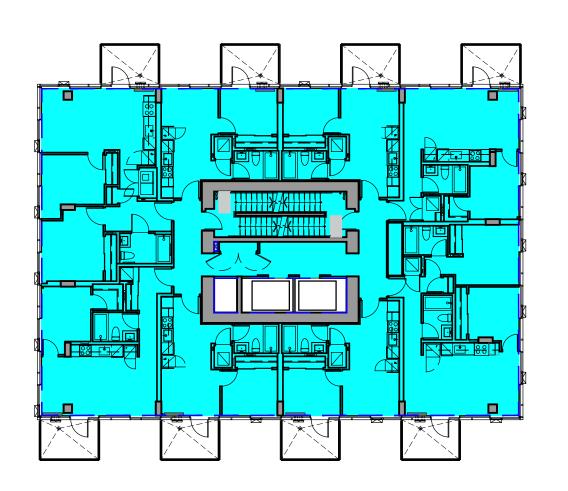


423.21 SQ. M.

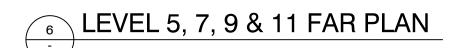



2 | 2025/08/07 | ISSUED FOR DDP

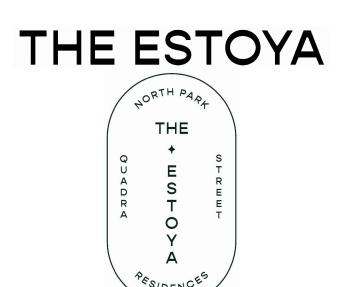



**PROJECT** 

1708 QUADRA STREET, VICTORIA, B.C.

FAR CALCULATION

This drawing, as an instrument of service, is the property of dys architecture and may not be reproduced without their permission and provided always that any production carries their name. All designs and other information shown on this drawing are for use on the specified project only and shall not be used otherwise without written permission of dys architecture. Payment of all sums due to dys architecture up to the date of use of this drawing is a condition precedent to the use thereof the use thereof.

Written dimensions shall have precedence over scaled dimensions. Contractors shall verify and be responsible for all dimensions and conditions on the job and **dys** architecture shall be informed of any variations from the dimensions and conditions shown on the drawings. Shop drawings shall be submitted to **dys** architecture for review before proceeding with tabrication

PROJECT A223587

fabrication.

**DATE** NOV. 29, 2024

dys architecture

260 - 1770 Burrard Street Vancouver BC V6J 3G7
tel 604 669 7710 www.dysarchitecture.com

5 4 6 8 7 9 6
ARCHITECTURE INC

NO. | DATE | ISSUE

| 2023/11/17 | ISSUED FOR 50% REVIEW
 | 2024/01/26 | ISSUED FOR 65% REVIEW
 | 2024/02/22 | ISSUED FOR BP

4 | 2024/05/09 | RE-ISSUED FOR BP 5 | 2024/07/05 | ISSUED FOR DRAFT IFT

| 2024/07/03 | ISSUED FOR DRAFT IFT | 2024/07/13 | ISSUED FOR IFT ADDENDUM # | 2024/07/31 | ISSUED FOR BP RESPONSE | 2024/10/07 | ISSUED FOR BP RESPONSE #2

10 |2025/01/24|ISSUED FOR IFC 11 |2025/08/07|ISSUED FOR DDP

9 | 2024/10/20 | ISSUED FOR DRAFT IFC

NO. | DATE | REVISION

THE ESTOYA

THE

STREET

OPADRA

PES/DEN

OPADRA



PROJECT

1708 QUADRA STREET, VICTORIA, B.C.

**SITE PLAN** 


This drawing, as an instrument of service, is the property of **dys** architecture and may not be reproduced without their permission and provided always that any production carries their name. All designs and other information shown on this drawing are for use on the specified project only and shall not be used otherwise without written permission of **dys** architecture. Payment of all sums due to **dys** architecture up to the date of use of this drawing is a condition precedent to the use thereof.

Written dimensions shall have precedence over scaled dimensions. Contractors shall verify and be responsible for all dimensions and conditions on the job and dys architecture shall be informed of any variations from the dimensions and conditions shown on the drawings. Shop drawings shall be submitted to dys architecture for review before proceeding with

PROJECT A223587

CHECKED NC

SCALE 1:100
DATE NOV. 01, 2023

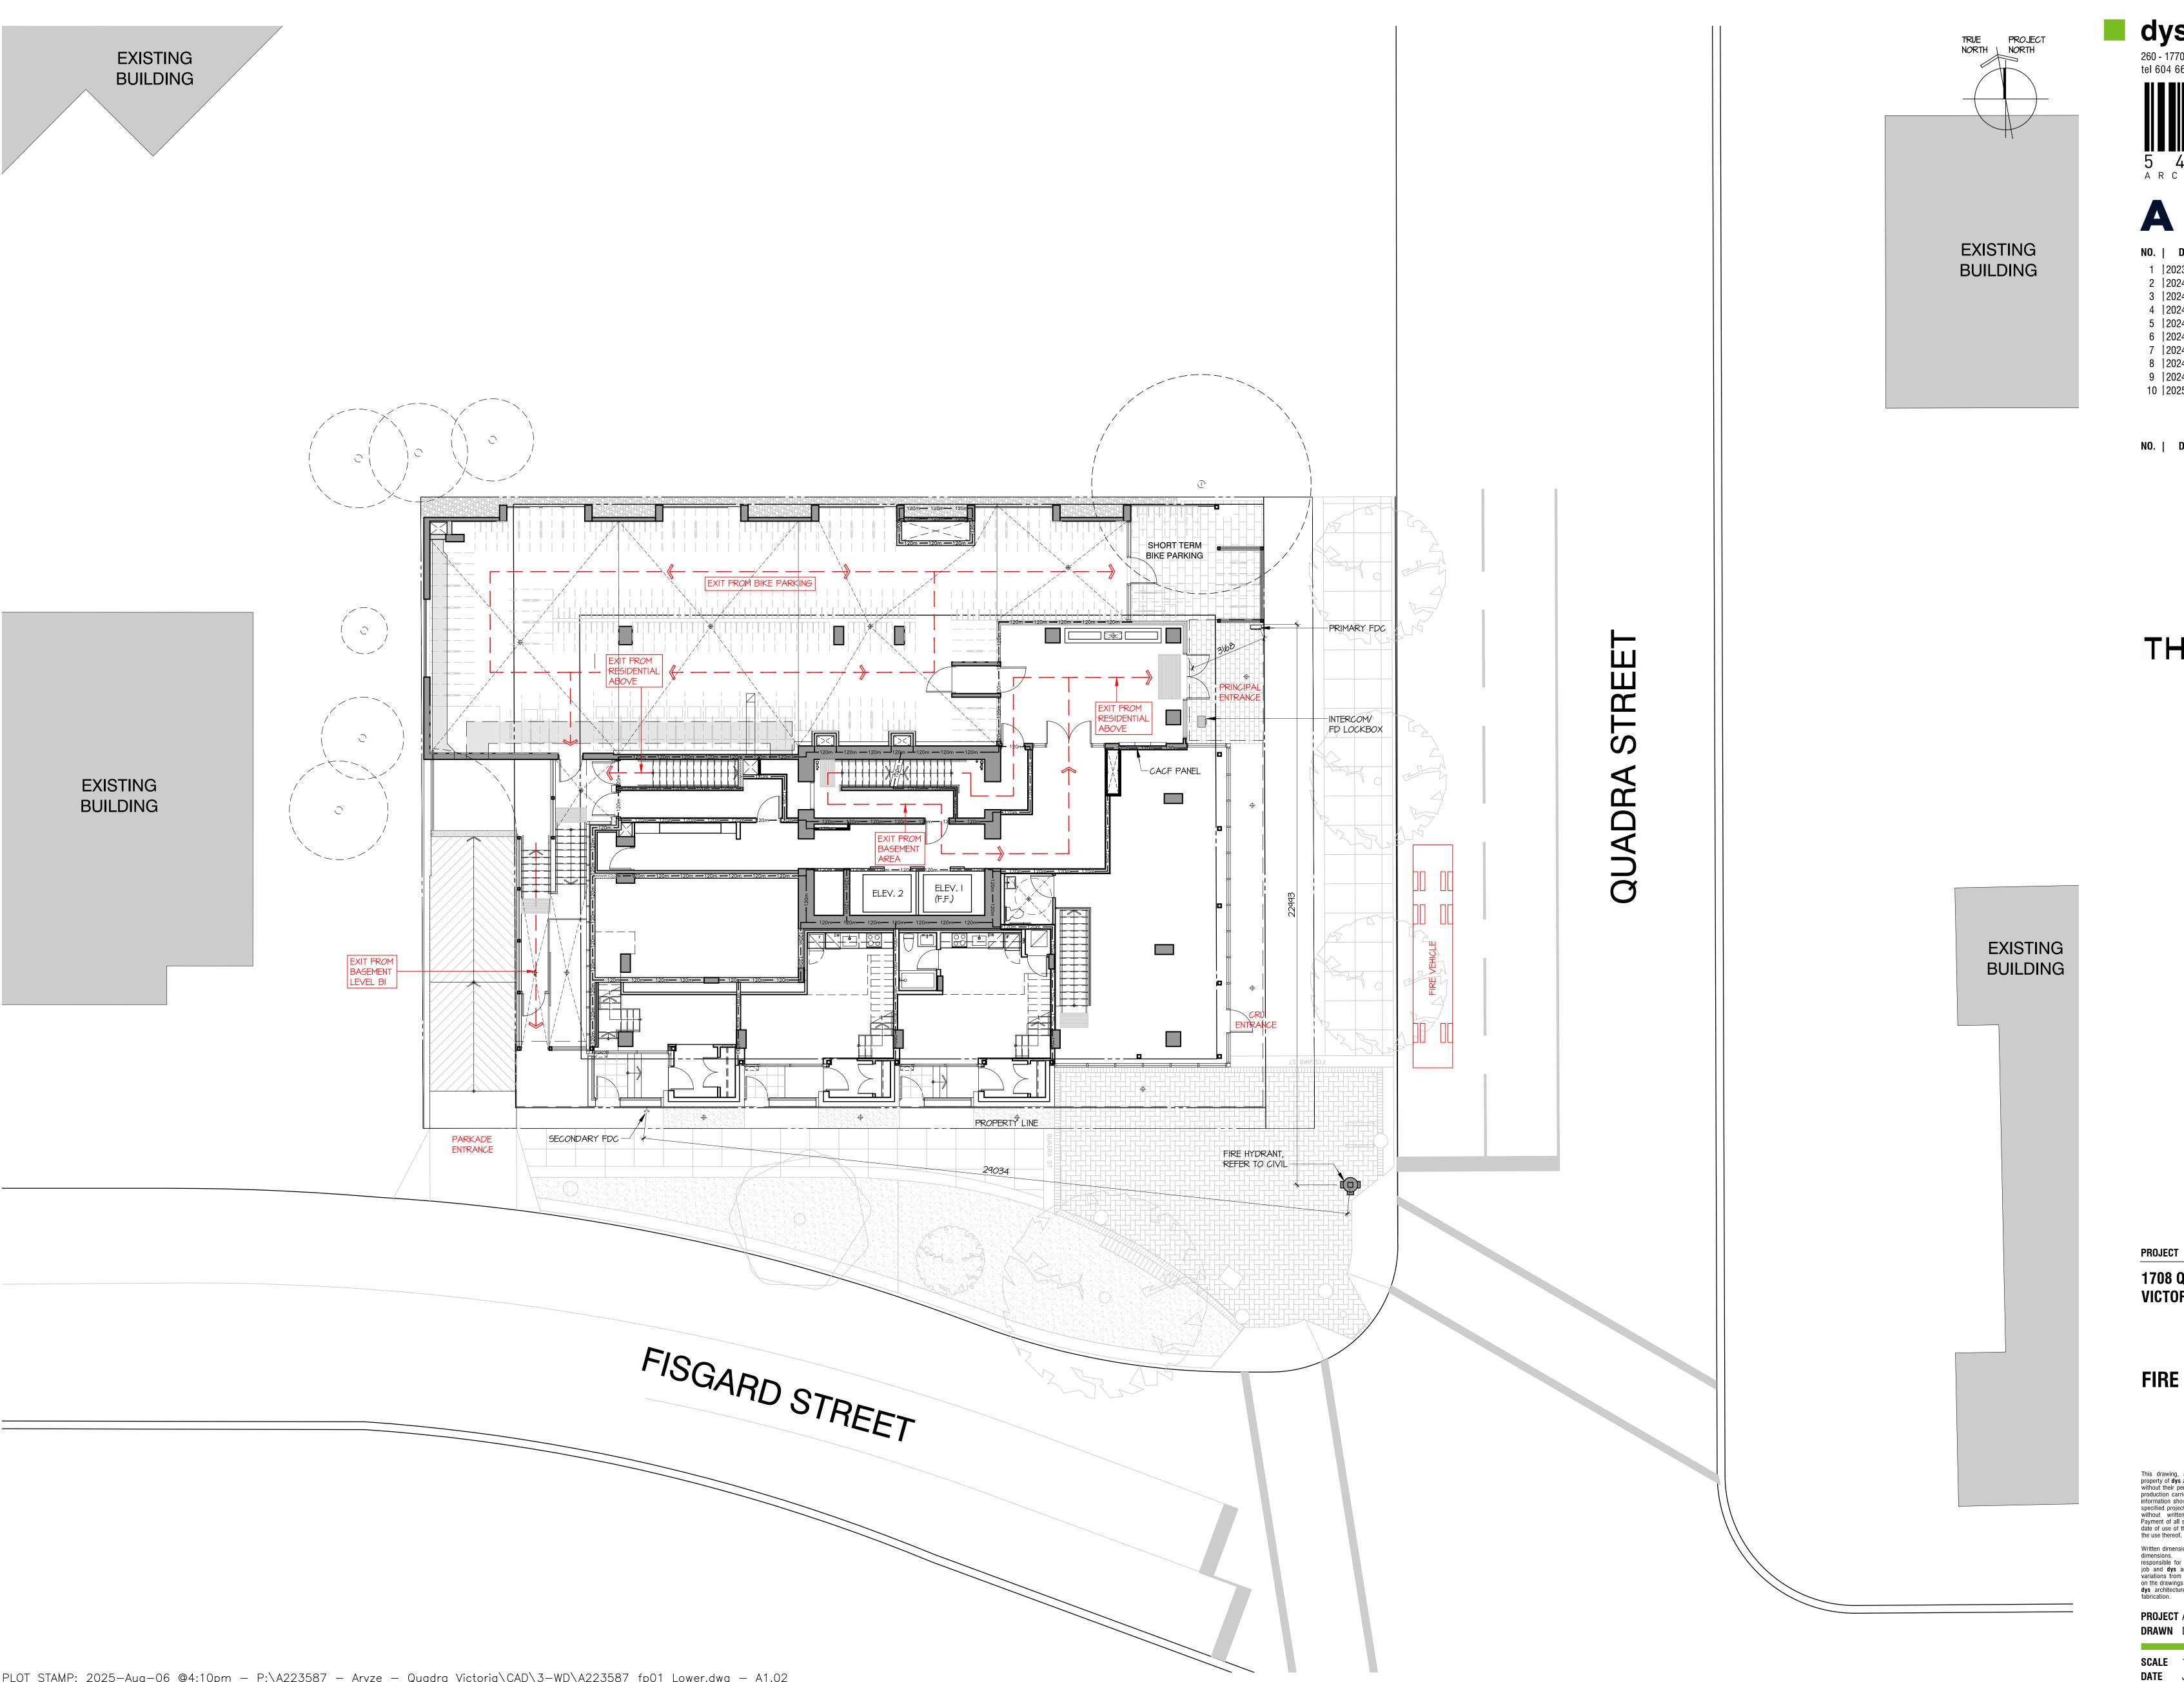

**dys** architecture 260 - 1770 Burrard Street Vancouver BC V6J 3G7 tel 604 669 7710 www.dysarchitecture.com

ARYZE


1 |2023/11/17|ISSUED FOR 50% REVIEW 2 |2024/01/26|ISSUED FOR 65% REVIEW

3 | 2024/02/22 | ISSUED FOR BP 4 |2024/05/09|RE-ISSUED FOR BP

9 | 2024/10/20 | ISSUED FOR DRAFT IFC 10 | 2025/01/24 | ISSUED FOR IFC

NO. | DATE | REVISION

THE ESTOYA

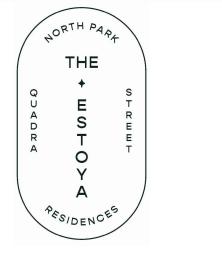


1708 QUADRA STREET, VICTORIA, B.C.

FIRE ACCESS PLAN

This drawing, as an instrument of service, is the property of dys architecture and may not be reproduced without their permission and provided always that any production carries their name. All designs and other information shown on this drawing are for use on the specified project only and shall not be used otherwise without written permission of dys architecture. Payment of all sums due to dys architecture up to the date of use of this drawing is a condition precedent to the use thereof

Written dimensions shall have precedence over scaled dimensions. Contractors shall verify and be responsible for all dimensions and conditions on the job and dys architecture shall be informed of any variations from the dimensions and conditions shown on the drawings. Shop drawings shall be submitted to dys architecture for review before proceeding with fabrication

PROJECT A223587

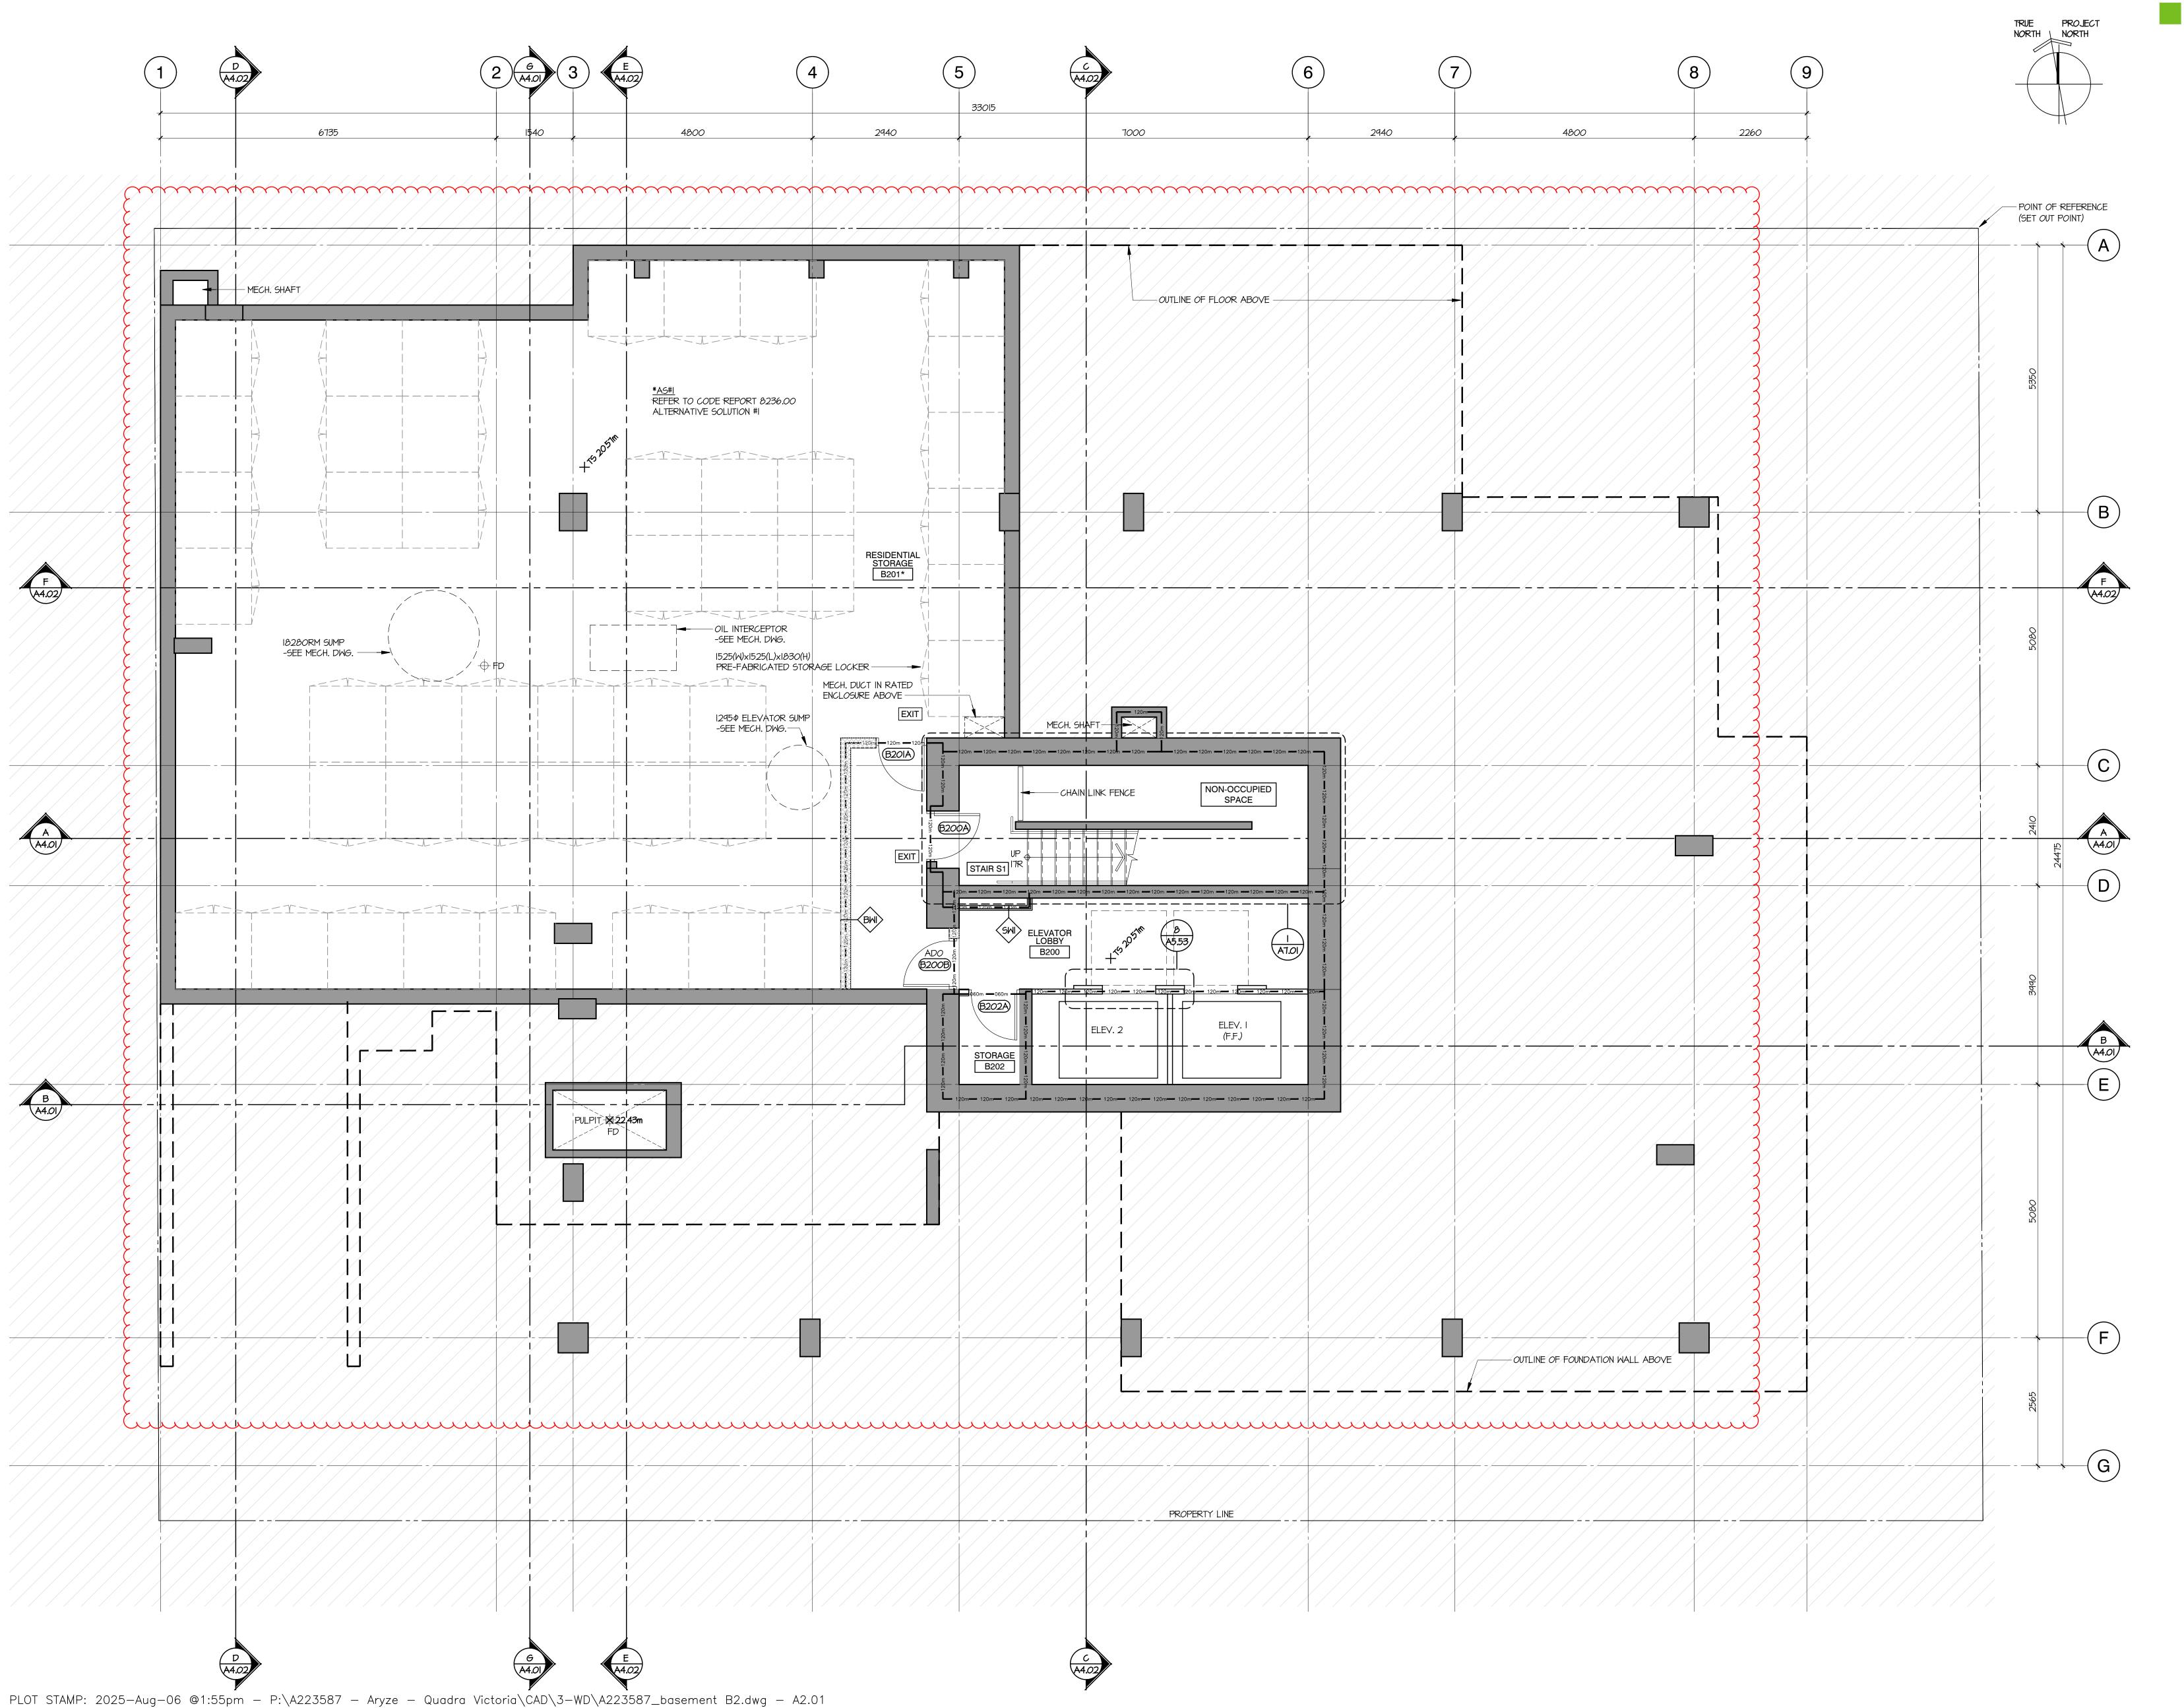

tel 604 669 7710 www.dysarchitecture.com

NO. | DATE | ISSUE


1 | 2023/11/17 | ISSUED FOR 50% REVIEW 2 | 2024/01/26 | ISSUED FOR 65% REVIEW 3 | 2024/02/22 | ISSUED FOR BP 4 | 2024/05/09|RE-ISSUED FOR BP 5 | 2024/07/05 | ISSUED FOR DRAFT IFT 8 | 2024/10/07 | ISSUED FOR BP RESPONSE #2

9 | 2024/10/20 | ISSUED FOR DRAFT IFC 10 | 2025/01/24 | ISSUED FOR IFC

NO. | DATE | REVISION

A | 2025/02/24 | ISSUED FOR AI#01 B | 2025/06/06 | ISSUED FOR AI#12 <u>∕C</u> |2025/06/27|ISSUED FOR AI#17 D | 2025/07/17 | ISSUED FOR AI#21 E | 2025/08/05 | ISSUED FOR AI#26

# THE ESTOYA

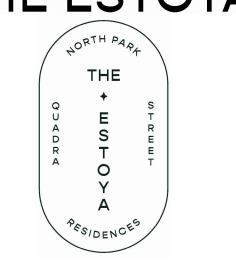



**PROJECT** 

1708 QUADRA STREET, VICTORIA, B.C.

**FLOOR PLAN BASEMENT LEVEL B2** 


This drawing, as an instrument of service, is the property of **dys** architecture and may not be reproduced without their permission and provided always that any production carries their name. All designs and other information shown on this drawing are for use on the specified project only and shall not be used otherwise without written permission of **dys** architecture. Payment of all sums due to **dys** architecture up to the the use thereof.

Written dimensions shall have precedence over scaled dimensions. Contractors shall verify and be responsible for all dimensions and conditions on the job and **dys** architecture shall be informed of any variations from the dimensions and conditions shown on the drawings. Shop drawings shall be submitted to dys architecture for review before proceeding with

PROJECT A223587

fabrication.

**DATE** OCT. 04, 2023

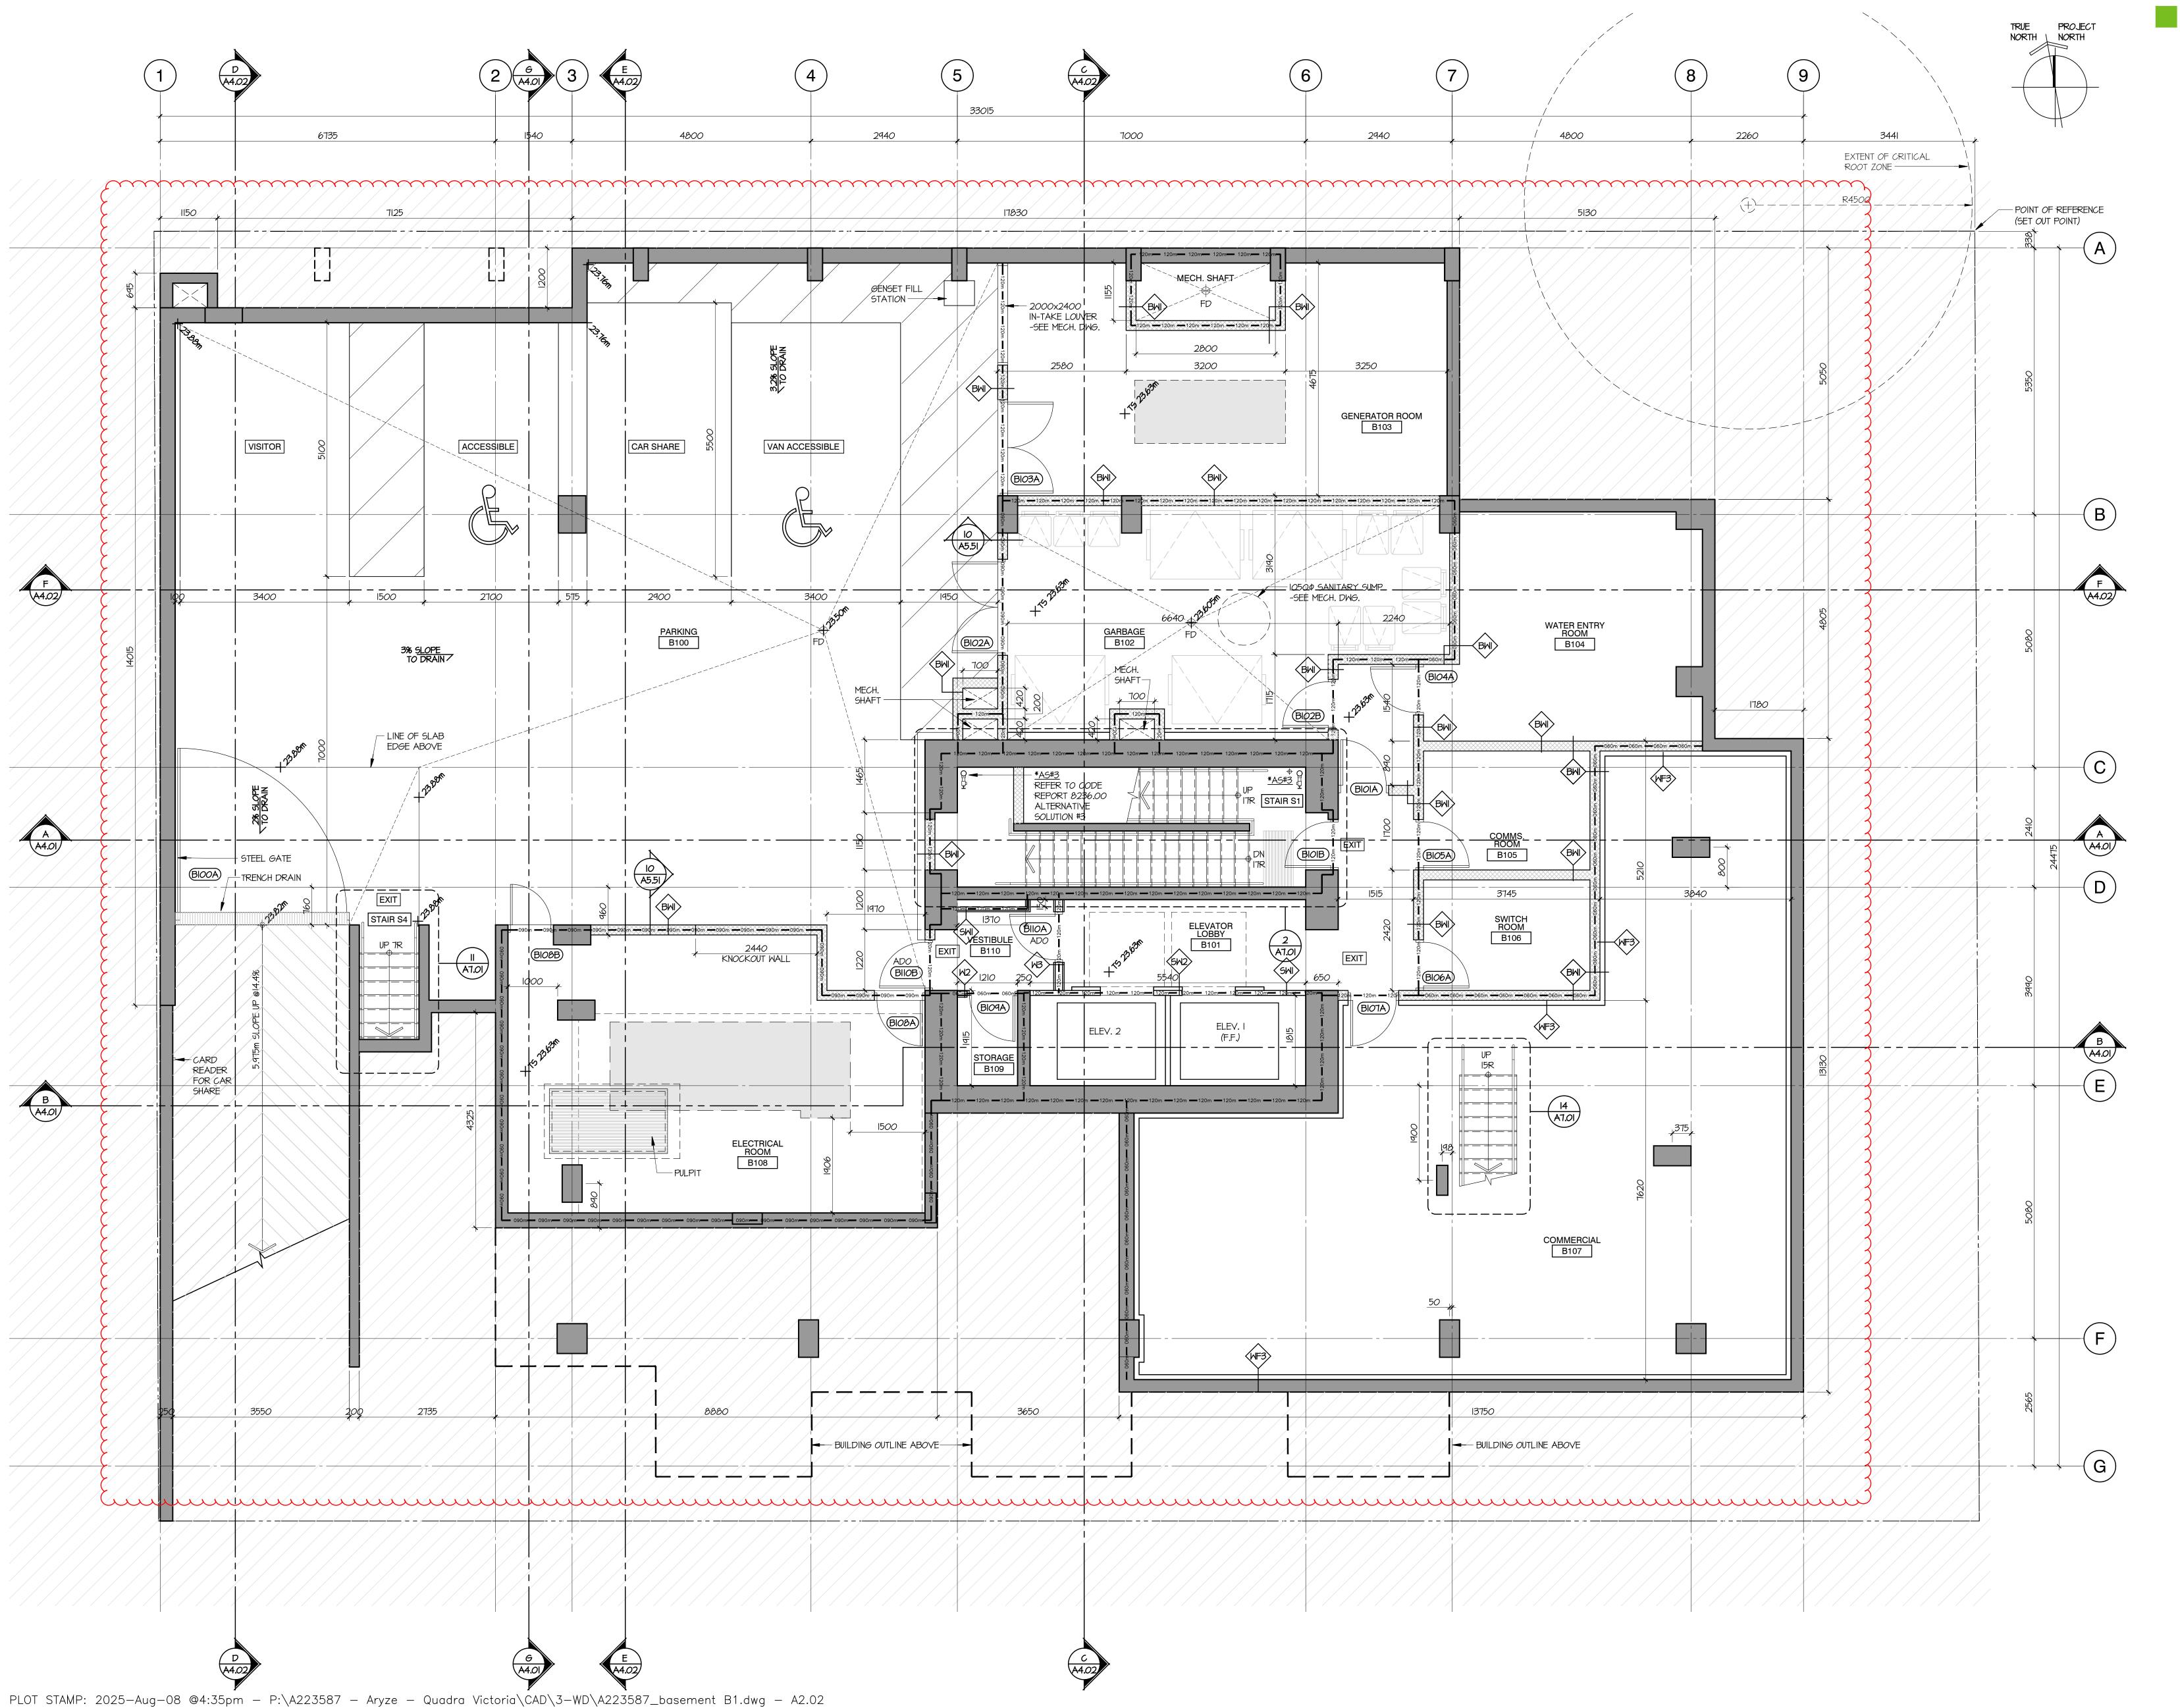

tel 604 669 7710 www.dysarchitecture.com

# ARYZE

NO. | DATE | ISSUE


1 | 2023/11/17 | ISSUED FOR 50% REVIEW 2 | 2024/01/26 | ISSUED FOR 65% REVIEW 3 |2024/02/22|ISSUED FOR BP 4 | 2024/05/09|RE-ISSUED FOR BP 5 | 2024/07/05 | ISSUED FOR DRAFT IFT 7 | 2024/07/31 | ISSUED FOR BP RESPONSE 8 | 2024/10/07 | ISSUED FOR BP RESPONSE #2 9 | 2024/10/20 | ISSUED FOR DRAFT IFC 10 | 2025/01/24 | ISSUED FOR IFC

### NO. | DATE | REVISION

11 | 2025/08/07 | ISSUED FOR DDP

A | 2025/02/24 | ISSUED FOR AI#01 B | 2025/04/14 | ISSUED FOR AI#05 \2025/06/06|ISSUED FOR AI#12 <u>E</u> | 2025/06/27 | ISSUED FOR AI#17 F | 2025/07/17 | ISSUED FOR AI#21 G | 2025/08/05 | ISSUED FOR AI#26

# THE ESTOYA

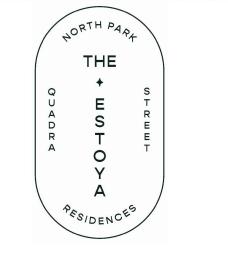



**PROJECT** 

1708 QUADRA STREET, VICTORIA, B.C.


# **FLOOR PLAN** BASEMENT LEVEL B1 PARKING

This drawing, as an instrument of service, is the property of **dys** architecture and may not be reproduced without their permission and provided always that any production carries their name. All designs and other information shown on this drawing are for use on the specified project only and shall not be used otherwise without written permission of dys architecture.
Payment of all sums due to dys architecture up to the the use thereof.

Written dimensions shall have precedence over scaled dimensions. Contractors shall verify and be responsible for all dimensions and conditions on the job and **dys** architecture shall be informed of any variations from the dimensions and conditions shown on the drawings. Shop drawings shall be submitted to dys architecture for review before proceeding with fabrication.

PROJECT A223587

**DATE** SEP. 12, 2023

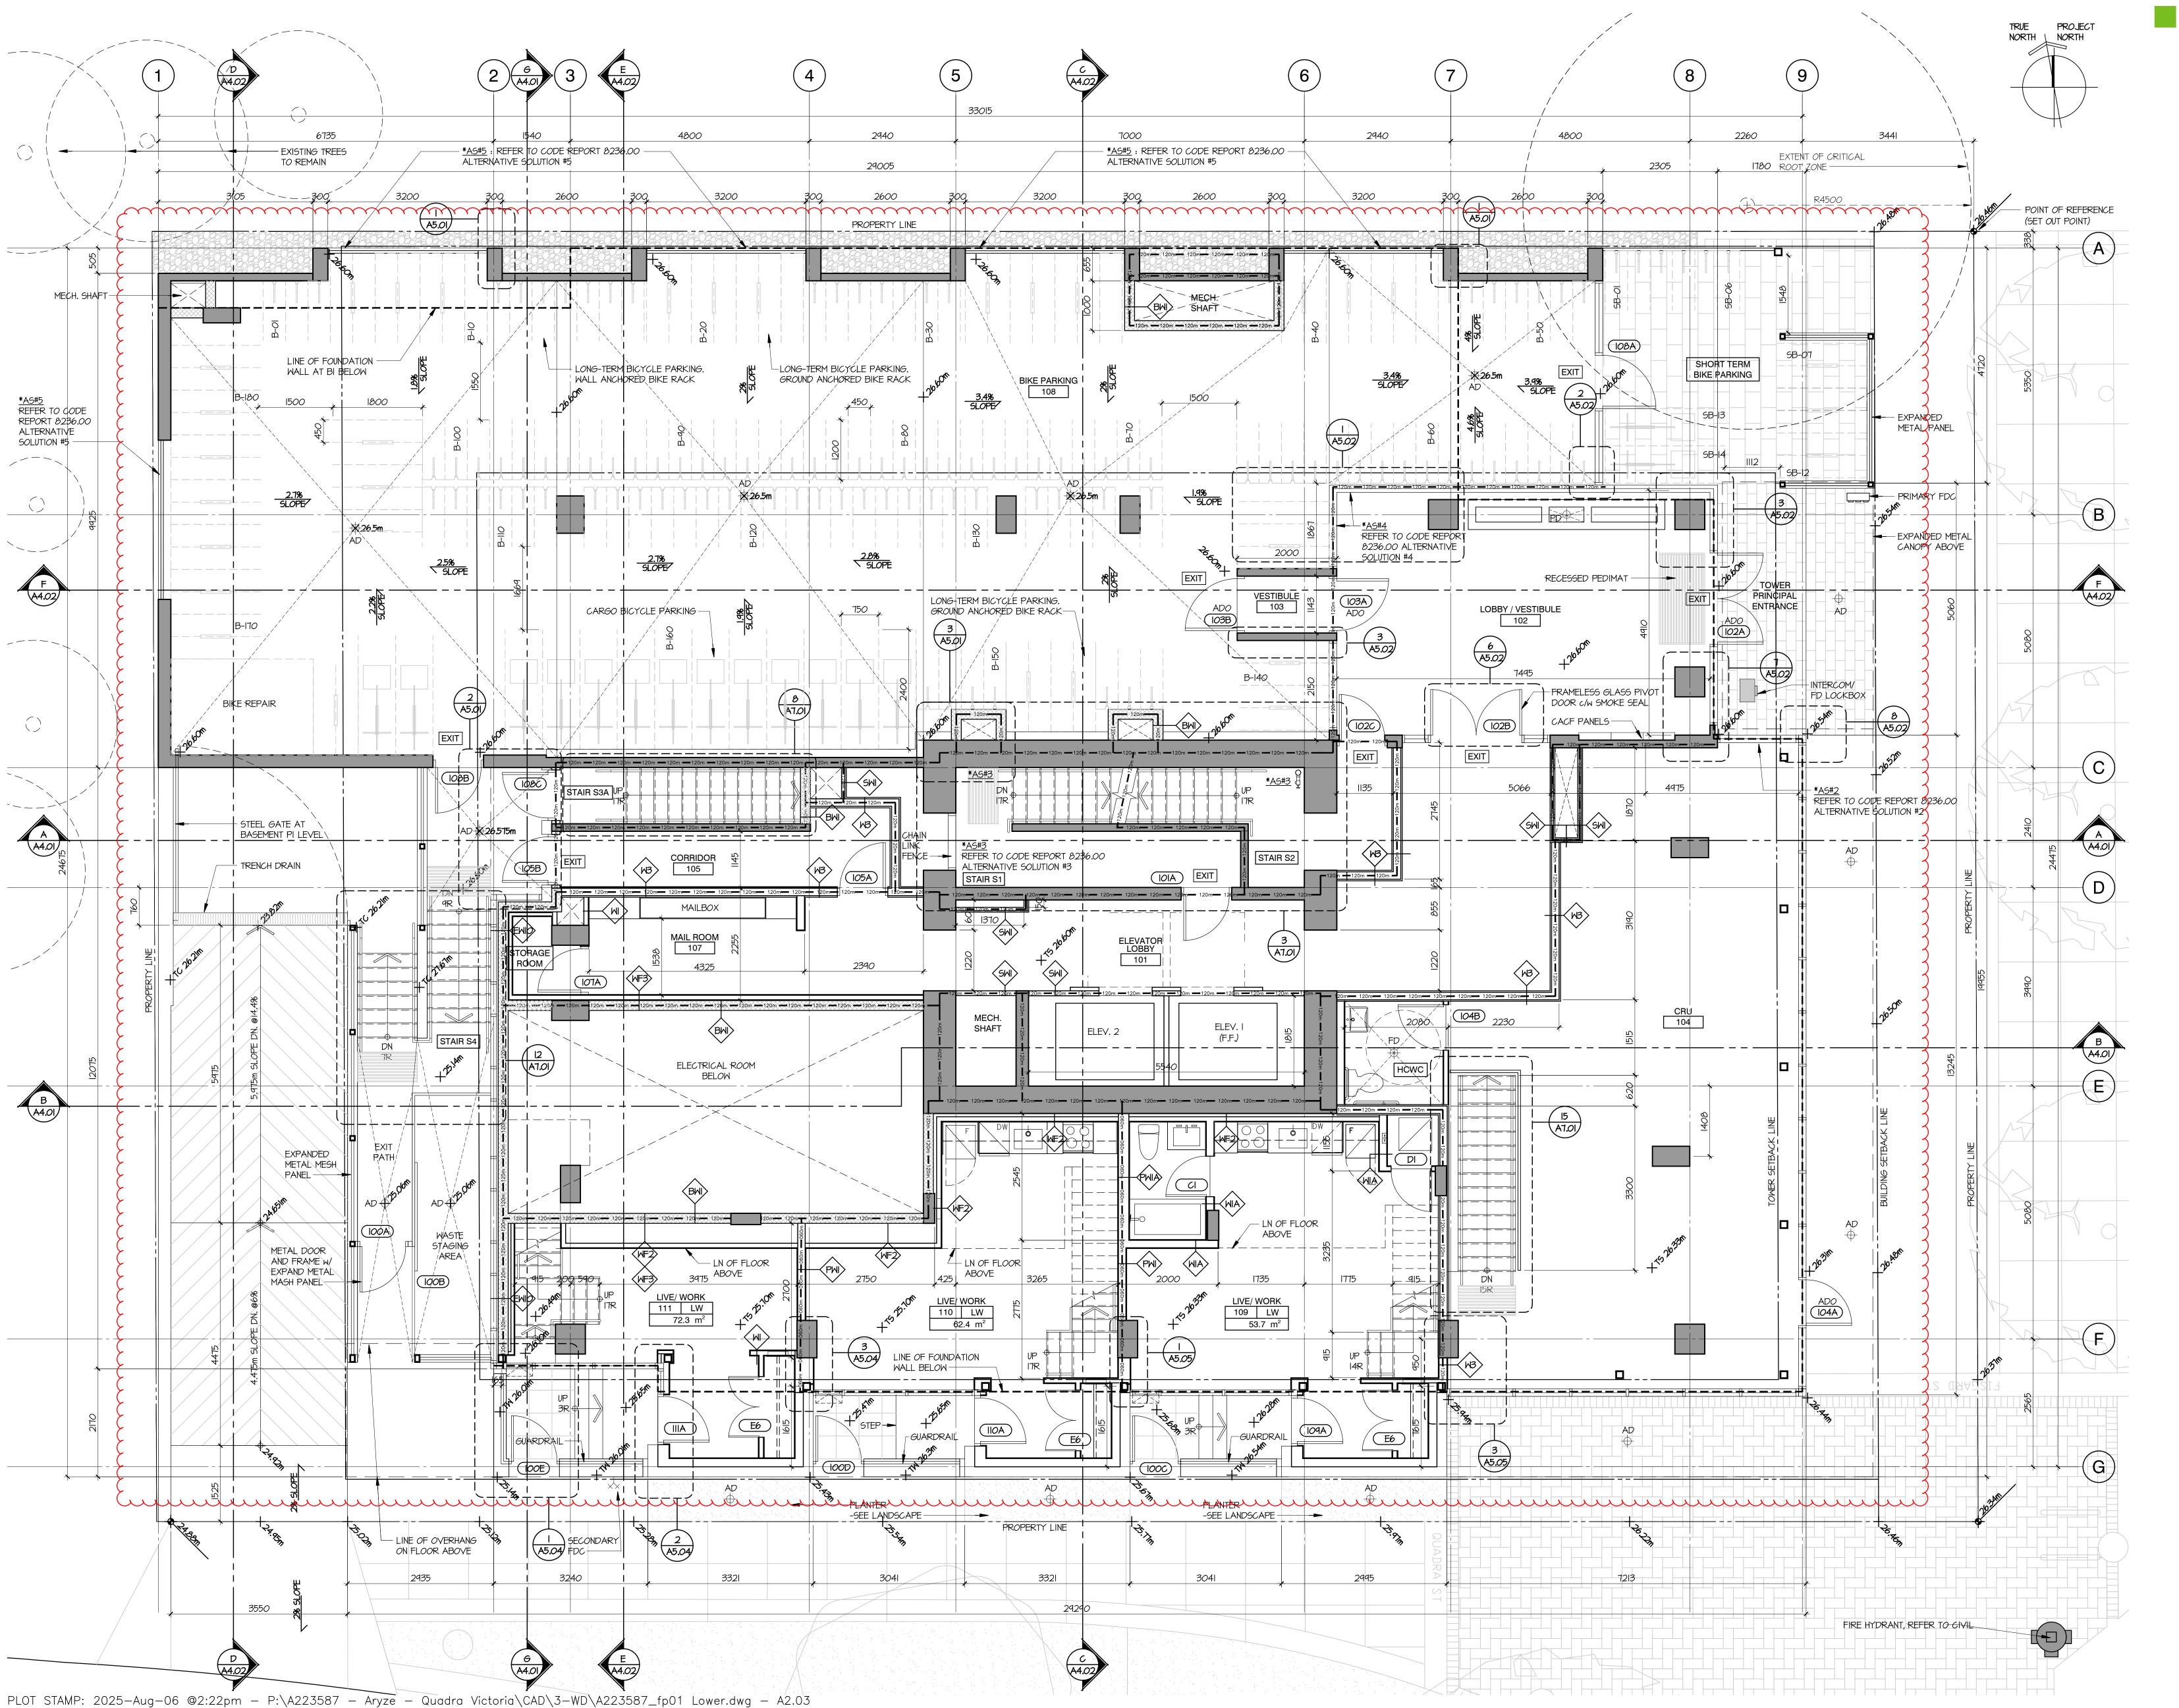

**dys** architecture

1 | 2023/11/17 | ISSUED FOR 50% REVIEW 2 | 2024/01/26 | ISSUED FOR 65% REVIEW 3 | 2024/02/22 | ISSUED FOR BP 4 | 2024/05/09 | RE-ISSUED FOR BP


NO. | DATE | REVISION

11 | 2025/01/24 | ISSUED FOR IFC

10 | 2024/10/20 | ISSUED FOR DRAFT IFC

\2025/02/24|ISSUED FOR AI#01 \ | 2025/03/17 | ISSUED FOR AI#03 2\ | 2025/04/14 | ISSUED FOR AI#05 12025/06/06 ISSUED FOR AI#12 🔁 | 2025/07/17 | ISSUED FOR AI#21 (G) | 2025/08/05 | ISSUED FOR AI#26

# THE ESTOYA

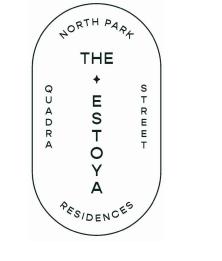



**PROJECT** 

1708 QUADRA STREET, VICTORIA, B.C.

**FLOOR PLAN LEVEL 1 LOWER** 


This drawing, as an instrument of service, is the property of **dys** architecture and may not be reproduced without their permission and provided always that any production carries their name. All designs and other information shown on this drawing are for use on the specified project only and shall not be used otherwise without written permission of **dys** architecture. Payment of all sums due to **dys** architecture up to the the use thereof.

Written dimensions shall have precedence over scaled dimensions. Contractors shall verify and be responsible for all dimensions and conditions on the job and **dys** architecture shall be informed of any variations from the dimensions and conditions shown on the drawings. Shop drawings shall be submitted to dys architecture for review before proceeding with fabrication.

PROJECT A223587

**DRAWN** DS **CHECKED** NC

**SCALE** 1:50 **DATE** SEP. 12, 2023

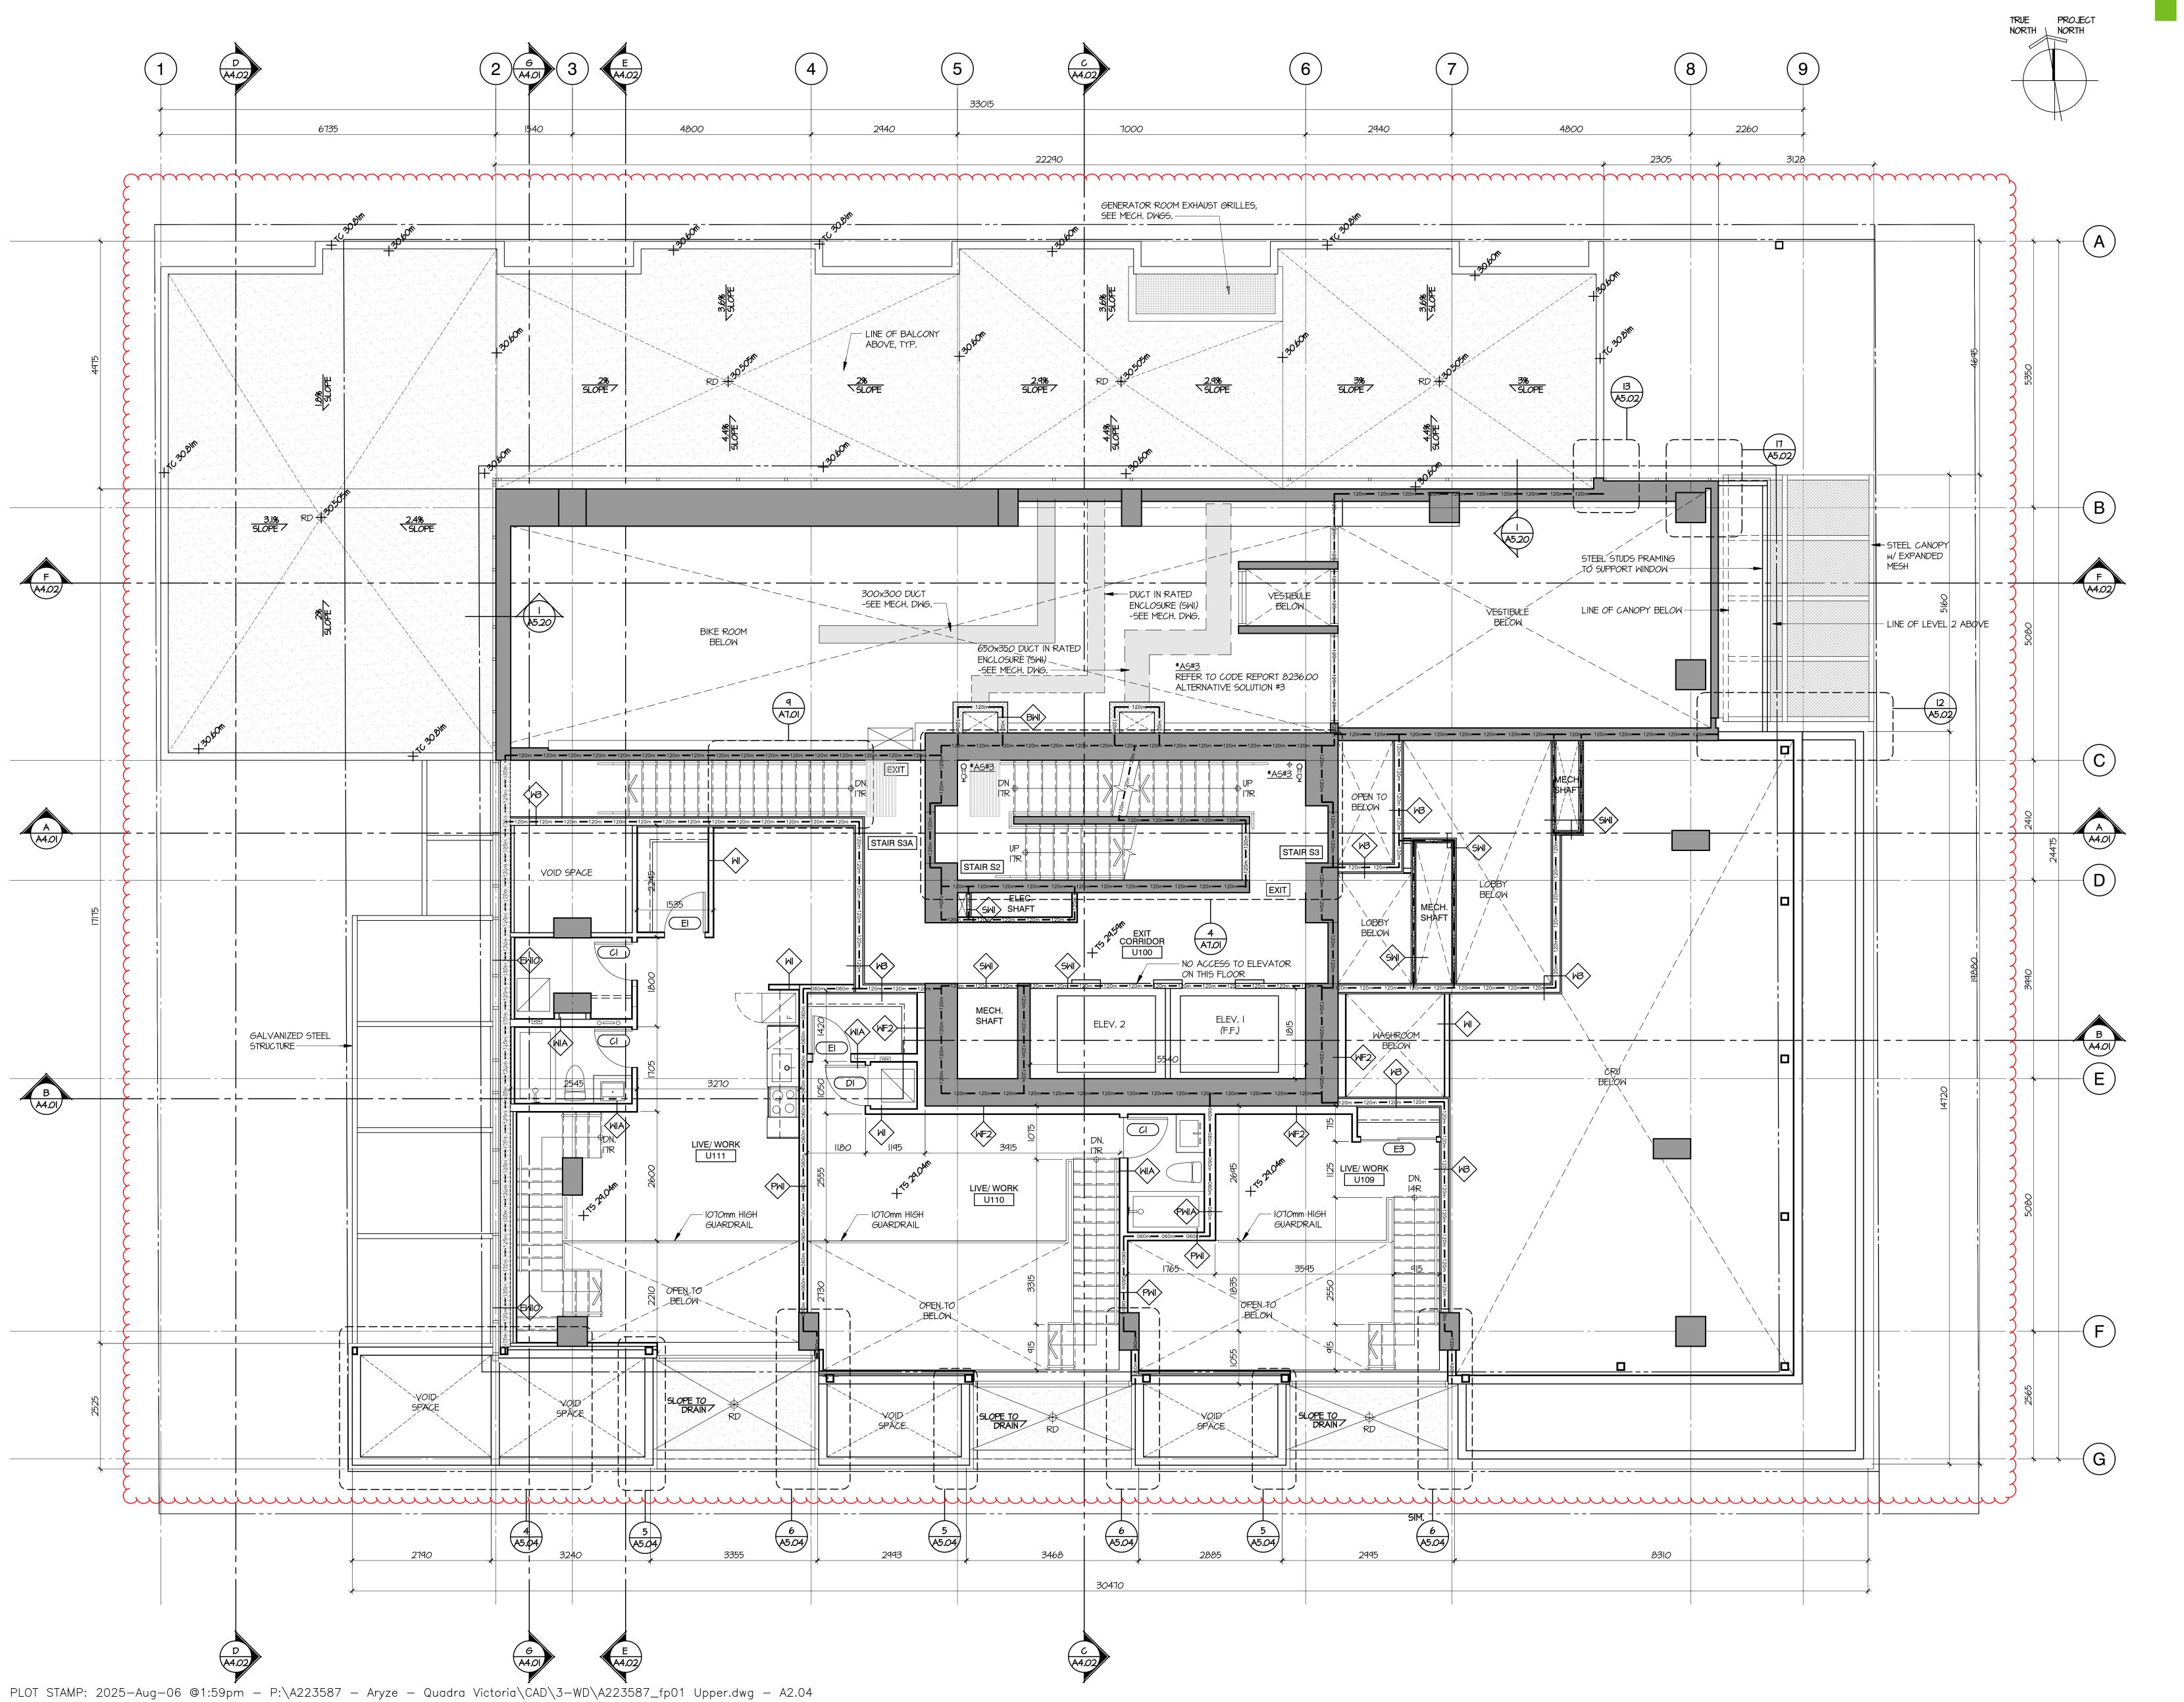

tel 604 669 7710 www.dysarchitecture.com

# ARYZE

IO. | DATE | ISSU

1 |2023/11/17 |ISSUED FOR 50% REVIEW
2 |2024/01/26 |ISSUED FOR 65% REVIEW
3 |2024/02/22 |ISSUED FOR BP
4 |2024/05/09 |RE-ISSUED FOR BP
5 |2024/07/05 |ISSUED FOR DRAFT IFT
6 |2024/07/13 |ISSUED FOR IFT ADDENDUM #1
7 |2024/07/31 |ISSUED FOR BP RESPONSE
8 |2024/09/09 |RE-ISSUED FOR IFT ADDENDUM
9 |2024/10/07 |ISSUED FOR BP RESPONSE #2


NO. | DATE | REVISION

10 | 2024/10/20 | ISSUED FOR DRAFT IFC

A | 2025/03/17 | ISSUED FOR AI#03 B | 2025/04/14 | ISSUED FOR AI#05

11 | 2025/01/24 | ISSUED FOR IFC

# THE ESTOYA

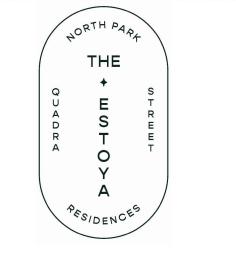



PROJECT

1708 QUADRA STREET, VICTORIA, B.C.

FLOOR PLAN LEVEL 1 UPPER


This drawing, as an instrument of service, is the property of **dys** architecture and may not be reproduced without their permission and provided always that any production carries their name. All designs and other information shown on this drawing are for use on the specified project only and shall not be used otherwise without written permission of **dys** architecture. Payment of all sums due to **dys** architecture up to the date of use of this drawing is a condition precedent to

Written dimensions shall have precedence over scaled dimensions. Contractors shall verify and be responsible for all dimensions and conditions on the job and dys architecture shall be informed of any variations from the dimensions and conditions shown on the drawings. Shop drawings shall be submitted to dys architecture for review before proceeding with

PROJECT A223587

CHECKED NC

SCALE 1:50
DATE SEP. 12, 2023

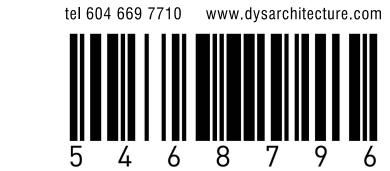

# ARYZE

NO. | DATE | ISSUE

1 | 2023/11/17 | ISSUED FOR 50% REVIEW
2 | 2024/01/26 | ISSUED FOR 65% REVIEW
3 | 2024/02/22 | ISSUED FOR BP
4 | 2024/05/09 | RE-ISSUED FOR BP
5 | 2024/07/05 | ISSUED FOR DRAFT IFT
6 | 2024/07/13 | ISSUED FOR IFT ADDENDUM #1
7 | 2024/07/31 | ISSUED FOR BP RESPONSE
8 | 2024/10/07 | ISSUED FOR BP RESPONSE #2
9 | 2024/10/20 | ISSUED FOR DRAFT IFC

NO. | DATE | REVISION

A | 2025/04/14 | ISSUED FOR AI#05
B | 2025/08/05 | ISSUED FOR AI#26

10 | 2025/01/24 | ISSUED FOR IFC

THE ESTOYA



PROJECT

1708 QUADRA STREET, VICTORIA, B.C.

FLOOR PLAN LEVEL 2


This drawing, as an instrument of service, is the property of **dys** architecture and may not be reproduced without their permission and provided always that any production carries their name. All designs and other information shown on this drawing are for use on the specified project only and shall not be used otherwise without written permission of **dys** architecture. Payment of all sums due to **dys** architecture up to the date of use of this drawing is a condition precedent to the use thereof.

Written dimensions shall have precedence over scaled dimensions. Contractors shall verify and be responsible for all dimensions and conditions on the job and dys architecture shall be informed of any variations from the dimensions and conditions shown on the drawings. Shop drawings shall be submitted to dys architecture for review before proceeding with

PROJECT A223587

3587 CHECKED NC

SCALE 1:50
DATE SEP. 11, 2023

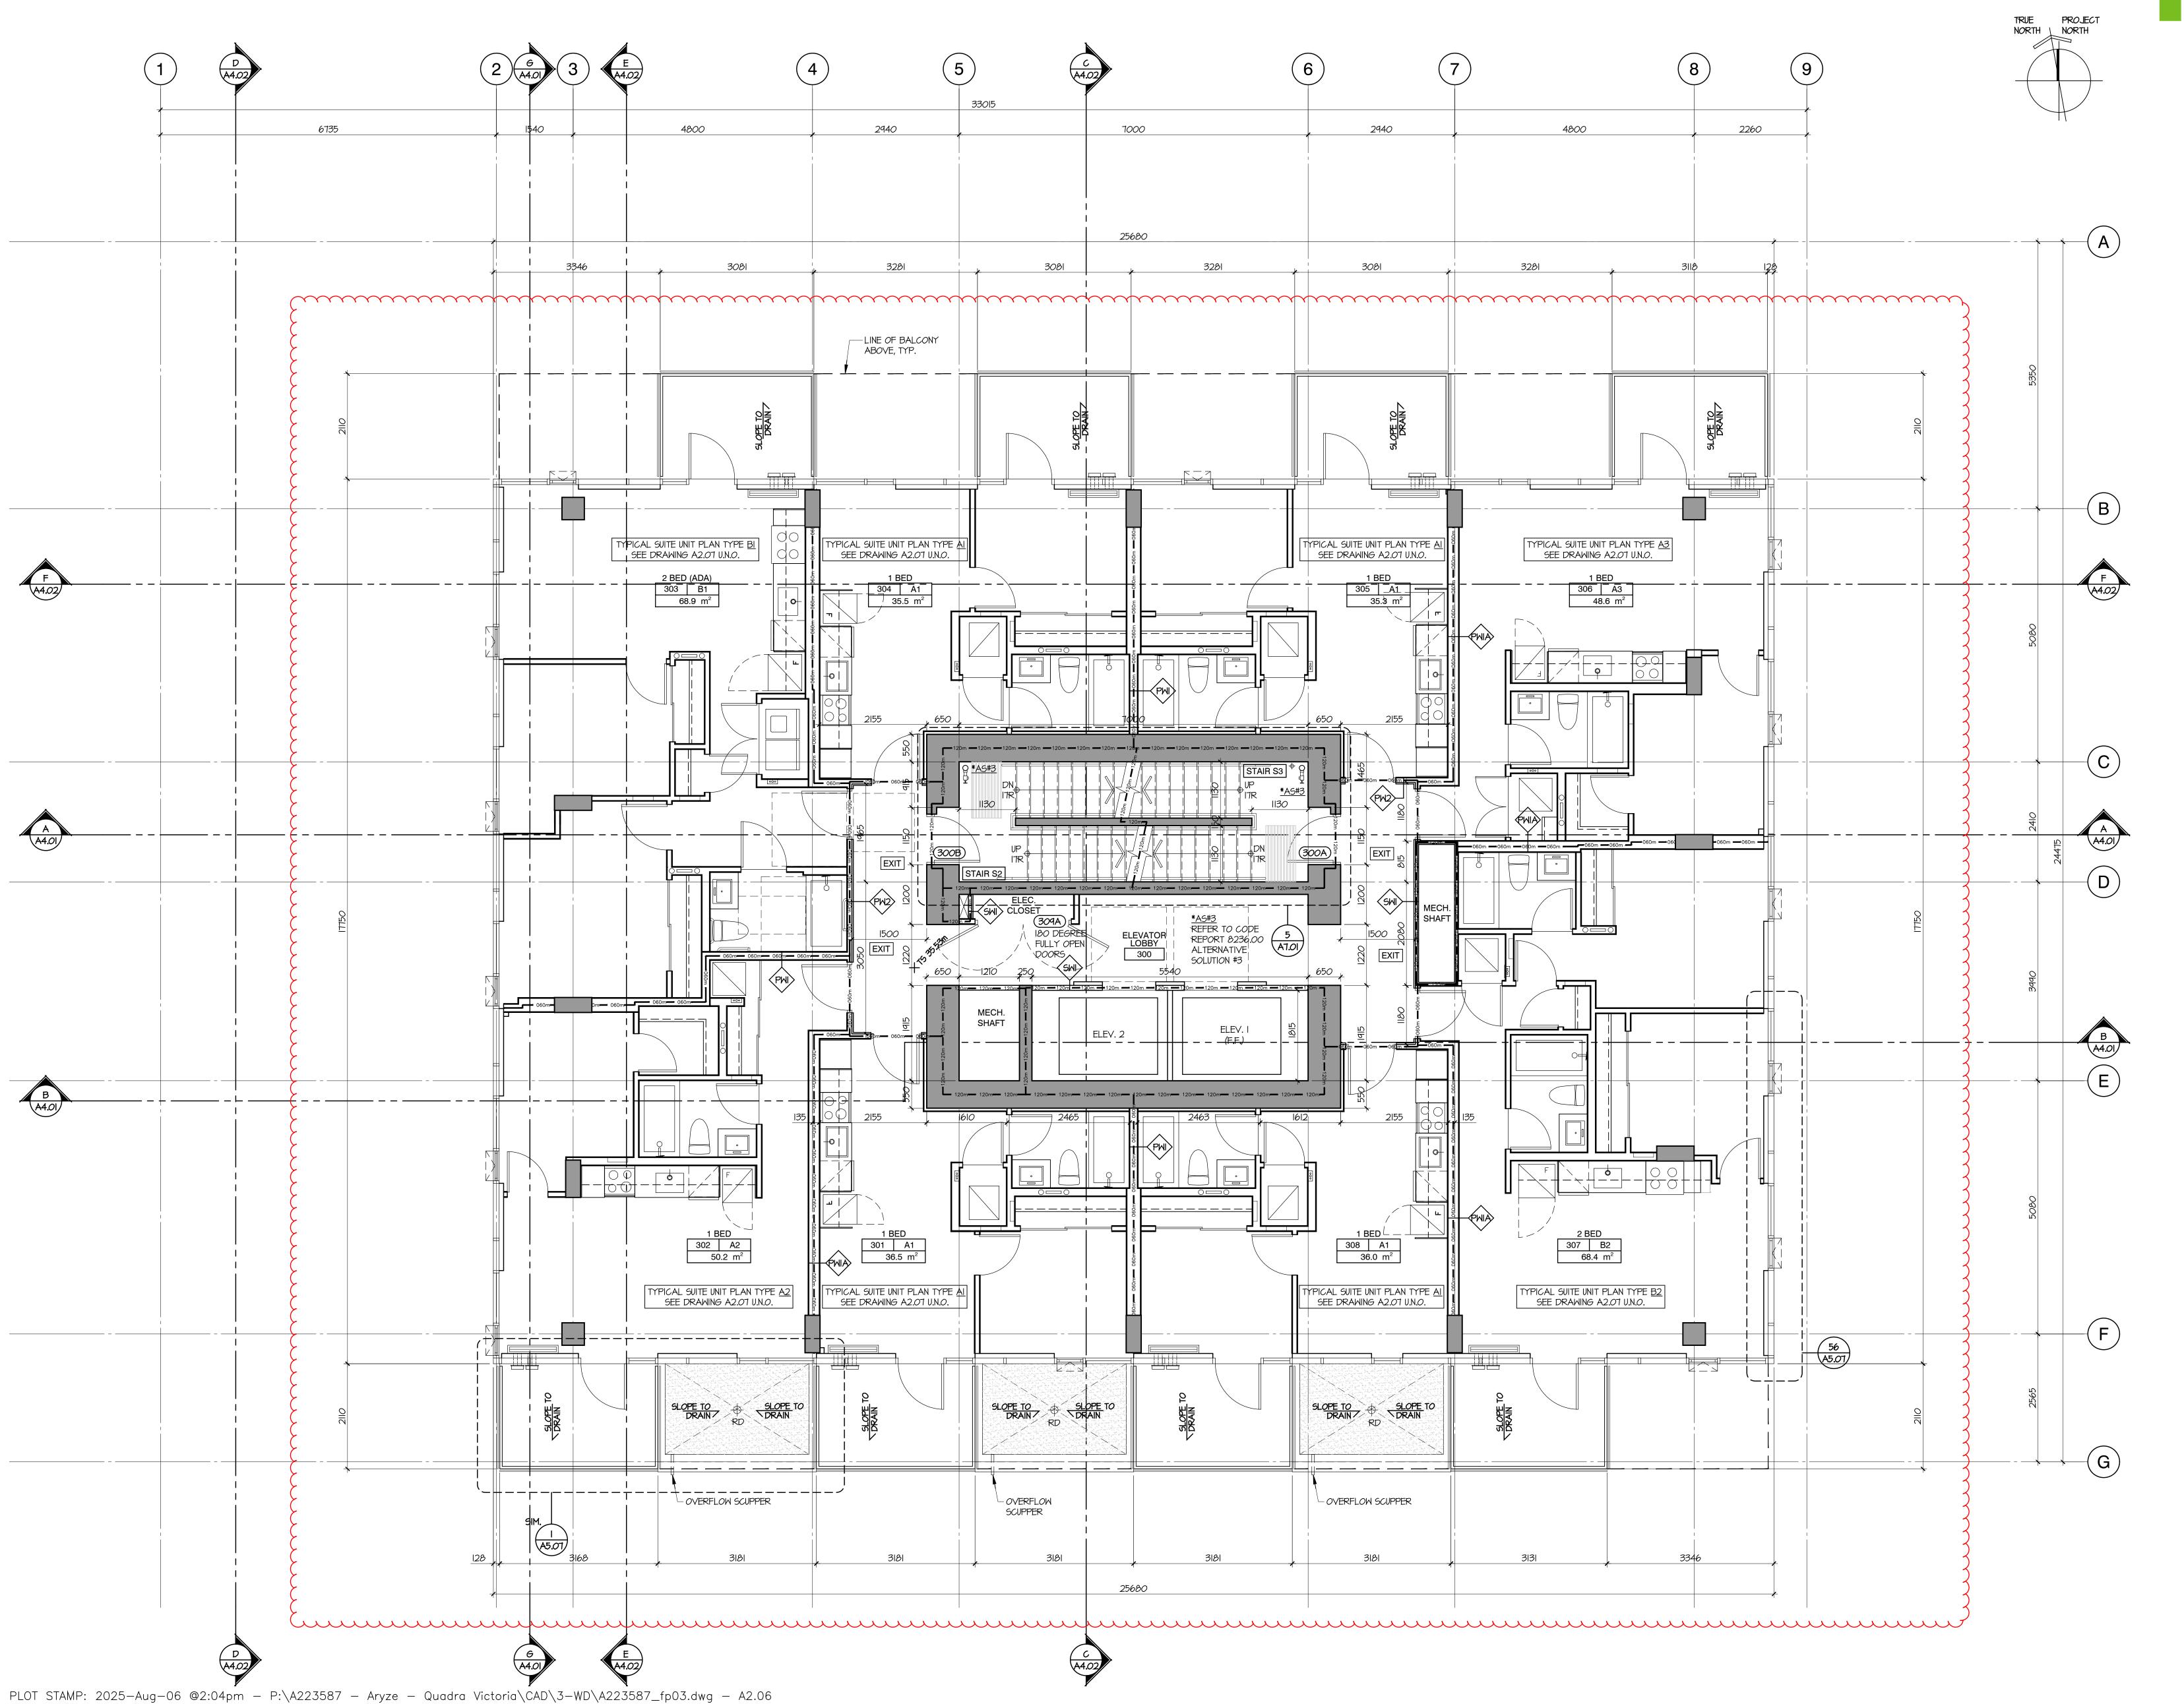

tel 604 669 7710 www.dysarchitecture.com

# ARYZE

NO. | DATE | ISSUE


1 |2023/11/17 |ISSUED FOR 50% REVIEW
2 |2024/01/26 |ISSUED FOR 65% REVIEW
3 |2024/02/22 |ISSUED FOR BP
4 |2024/05/09 |RE-ISSUED FOR BP
5 |2024/07/05 |ISSUED FOR DRAFT IFT
6 |2024/07/13 |ISSUED FOR IFT ADDENDUM #1
7 |2024/07/31 |ISSUED FOR BP RESPONSE
8 |2024/10/07 |ISSUED FOR BP RESPONSE #2
9 |2024/10/20 |ISSUED FOR DRAFT IFC

NO. | DATE | REVISION

10 | 2025/01/24 | ISSUED FOR IFC

A |2025/04/14|ISSUED FOR AI#05 B |2025/06/27|ISSUED FOR AI#17

# THE ESTOYA

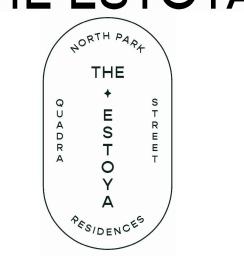



PROJECT

1708 QUADRA STREET, VICTORIA, B.C.

FLOOR PLAN LEVEL 3


This drawing, as an instrument of service, is the property of **dys** architecture and may not be reproduced without their permission and provided always that any production carries their name. All designs and other information shown on this drawing are for use on the specified project only and shall not be used otherwise without written permission of **dys** architecture. Payment of all sums due to **dys** architecture up to the date of use of this drawing is a condition precedent to the use thereof.

Written dimensions shall have precedence over scaled dimensions. Contractors shall verify and be responsible for all dimensions and conditions on the job and dys architecture shall be informed of any variations from the dimensions and conditions shown on the drawings. Shop drawings shall be submitted to dys architecture for review before proceeding with

PROJECT A223587

CHECKED NC

SCALE 1:50
DATE SEP. 11, 2023

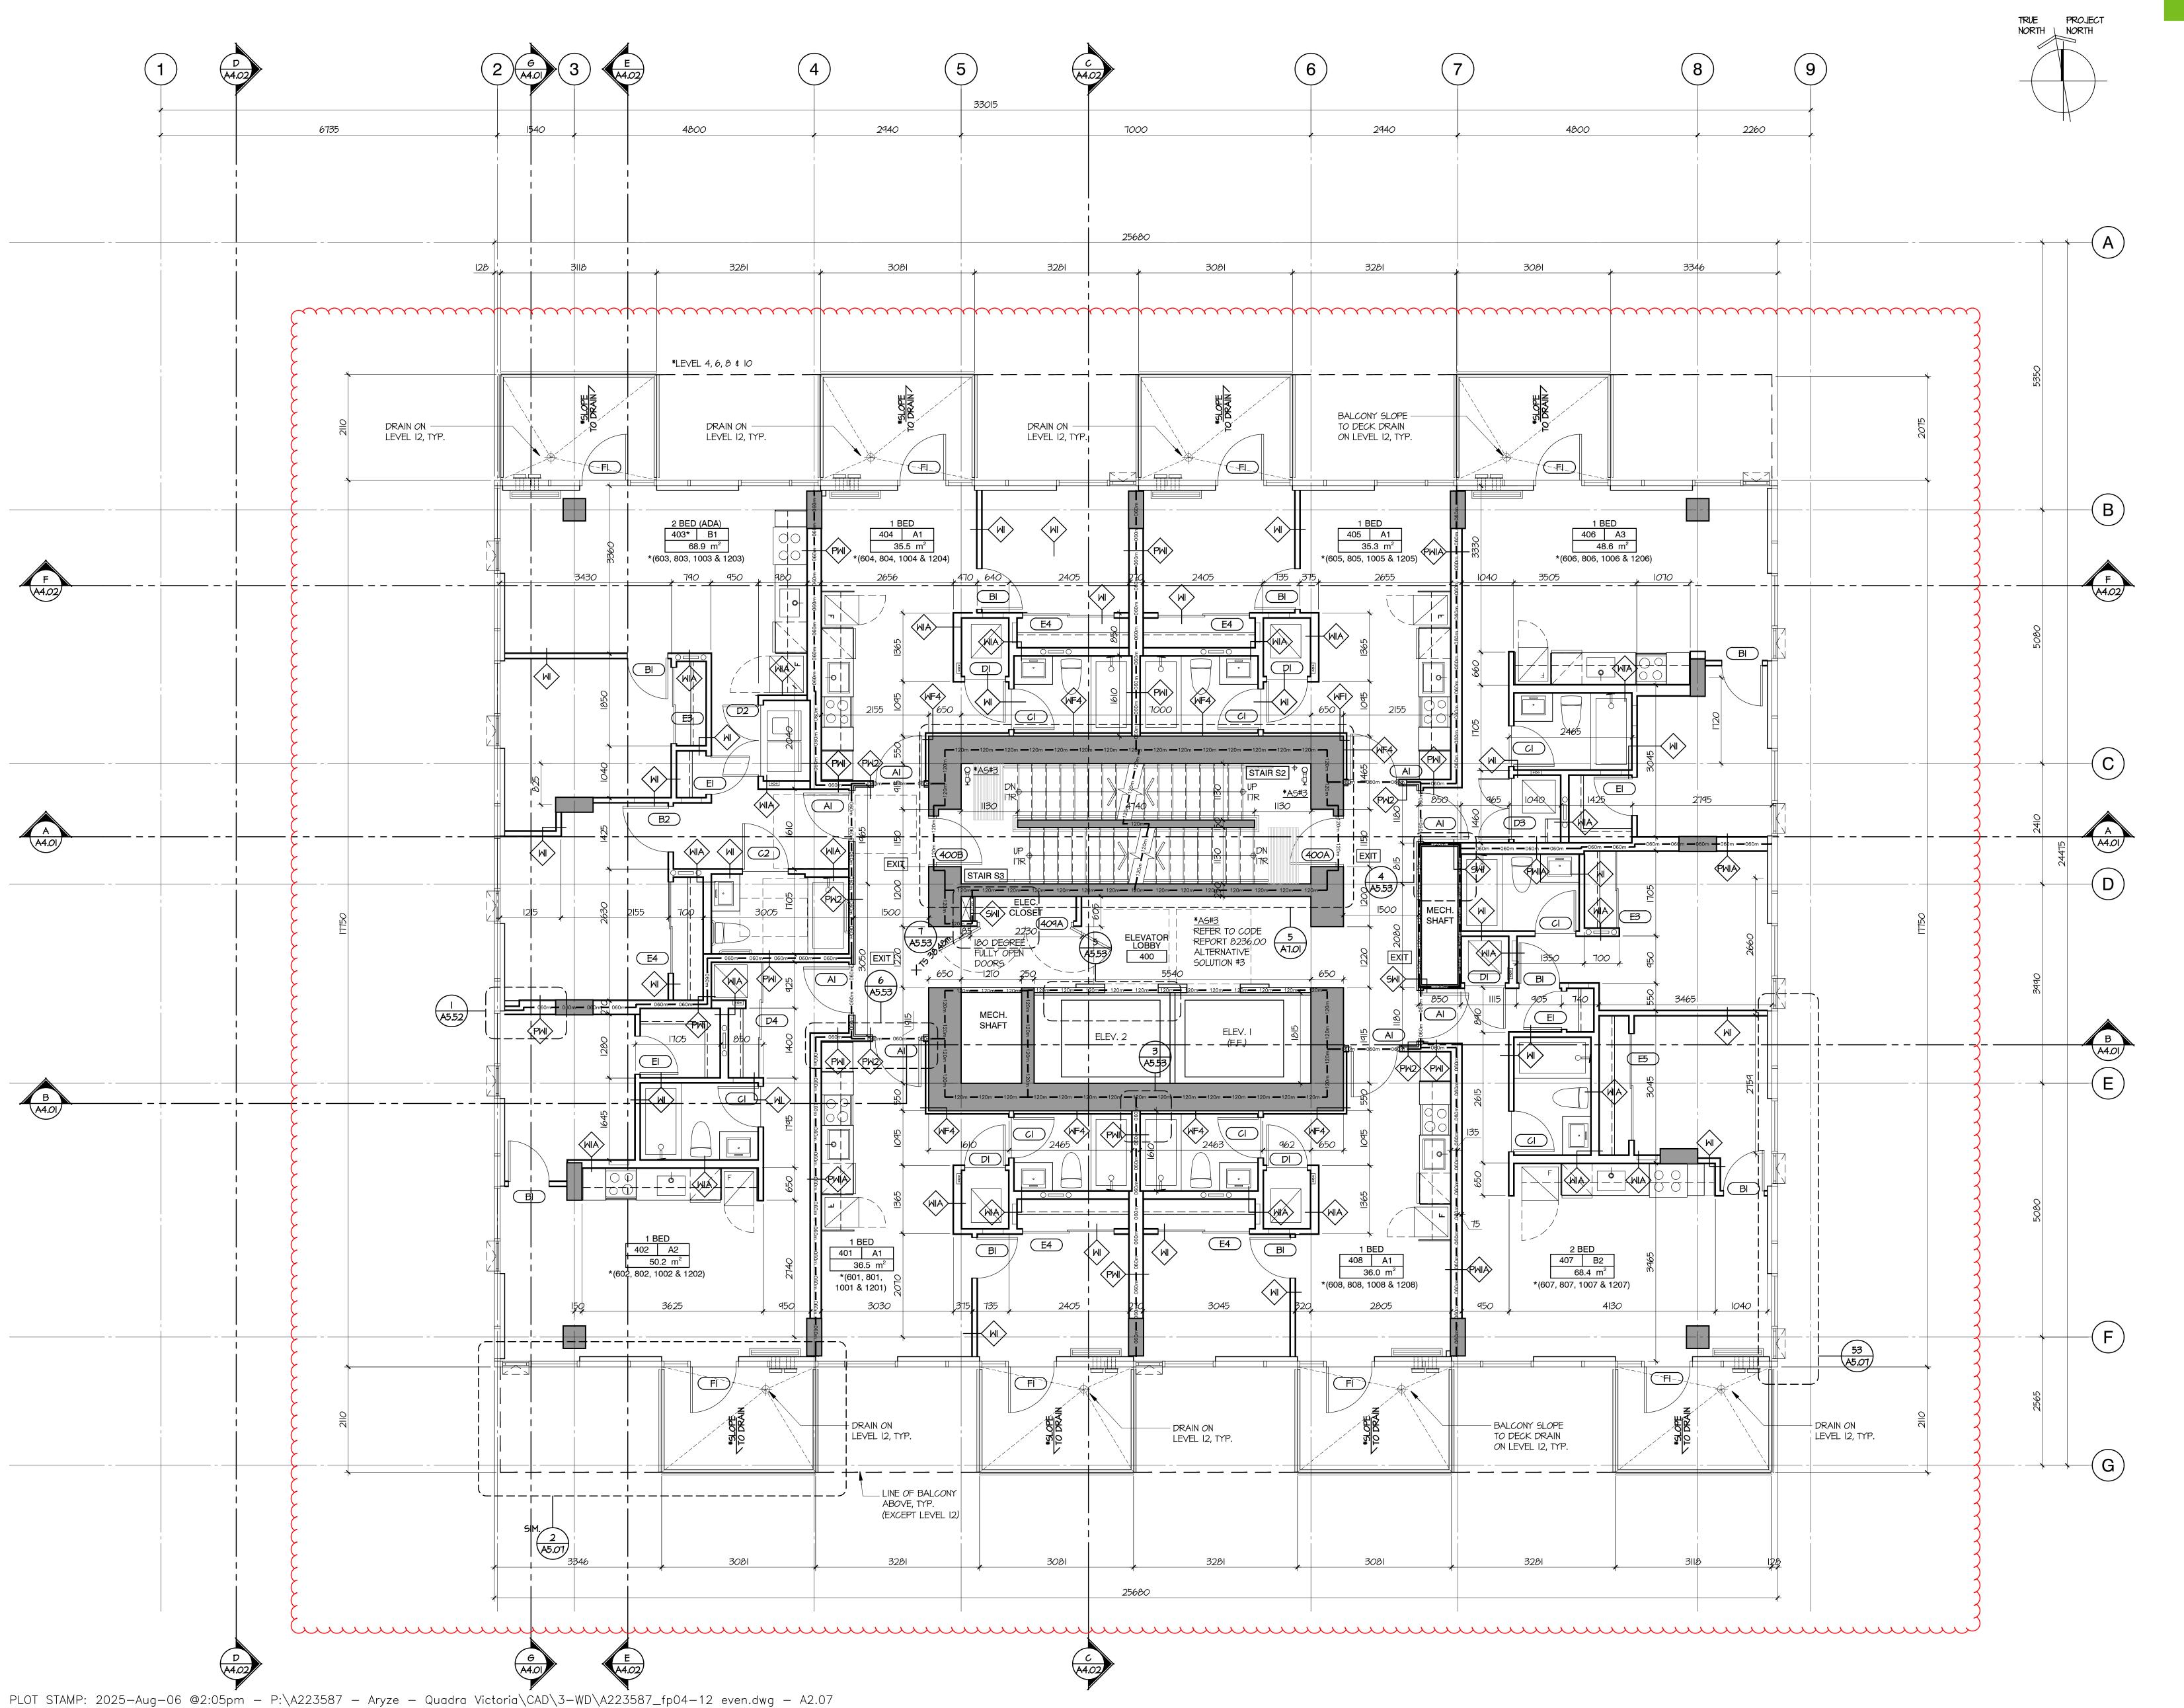

**dys** architecture

ARYZE

1 | 2023/11/17 | ISSUED FOR 50% REVIEW 2 | 2024/01/26 | ISSUED FOR 65% REVIEW 3 |2024/02/22|ISSUED FOR BP 4 | 2024/05/09 | RE-ISSUED FOR BP


9 | 2024/10/20 | ISSUED FOR DRAFT IFC

10 | 2025/01/24 | ISSUED FOR IFC

NO. | DATE | REVISION

A | 2025/04/14 | ISSUED FOR AI#05 B | 2025/06/27 | ISSUED FOR AI#17 C | 2025/XX/XX | ISSUED FOR AI#XX

THE ESTOYA

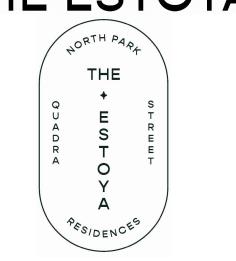



**PROJECT** 

1708 QUADRA STREET, VICTORIA, B.C.


FLOOR PLAN LEVEL 4, 6, 8, 10 & 12 LEVEL 4 SHOWN

This drawing, as an instrument of service, is the property of **dys** architecture and may not be reproduced without their permission and provided always that any production carries their name. All designs and other information shown on this drawing are for use on the without written permission of **dys** architecture. Payment of all sums due to **dys** architecture up to the the use thereof.

Written dimensions shall have precedence over scaled dimensions. Contractors shall verify and be responsible for all dimensions and conditions on the job and **dys** architecture shall be informed of any variations from the dimensions and conditions shown on the drawings. Shop drawings shall be submitted to dys architecture for review before proceeding with

PROJECT A223587

**DATE** AUG. 29, 2023

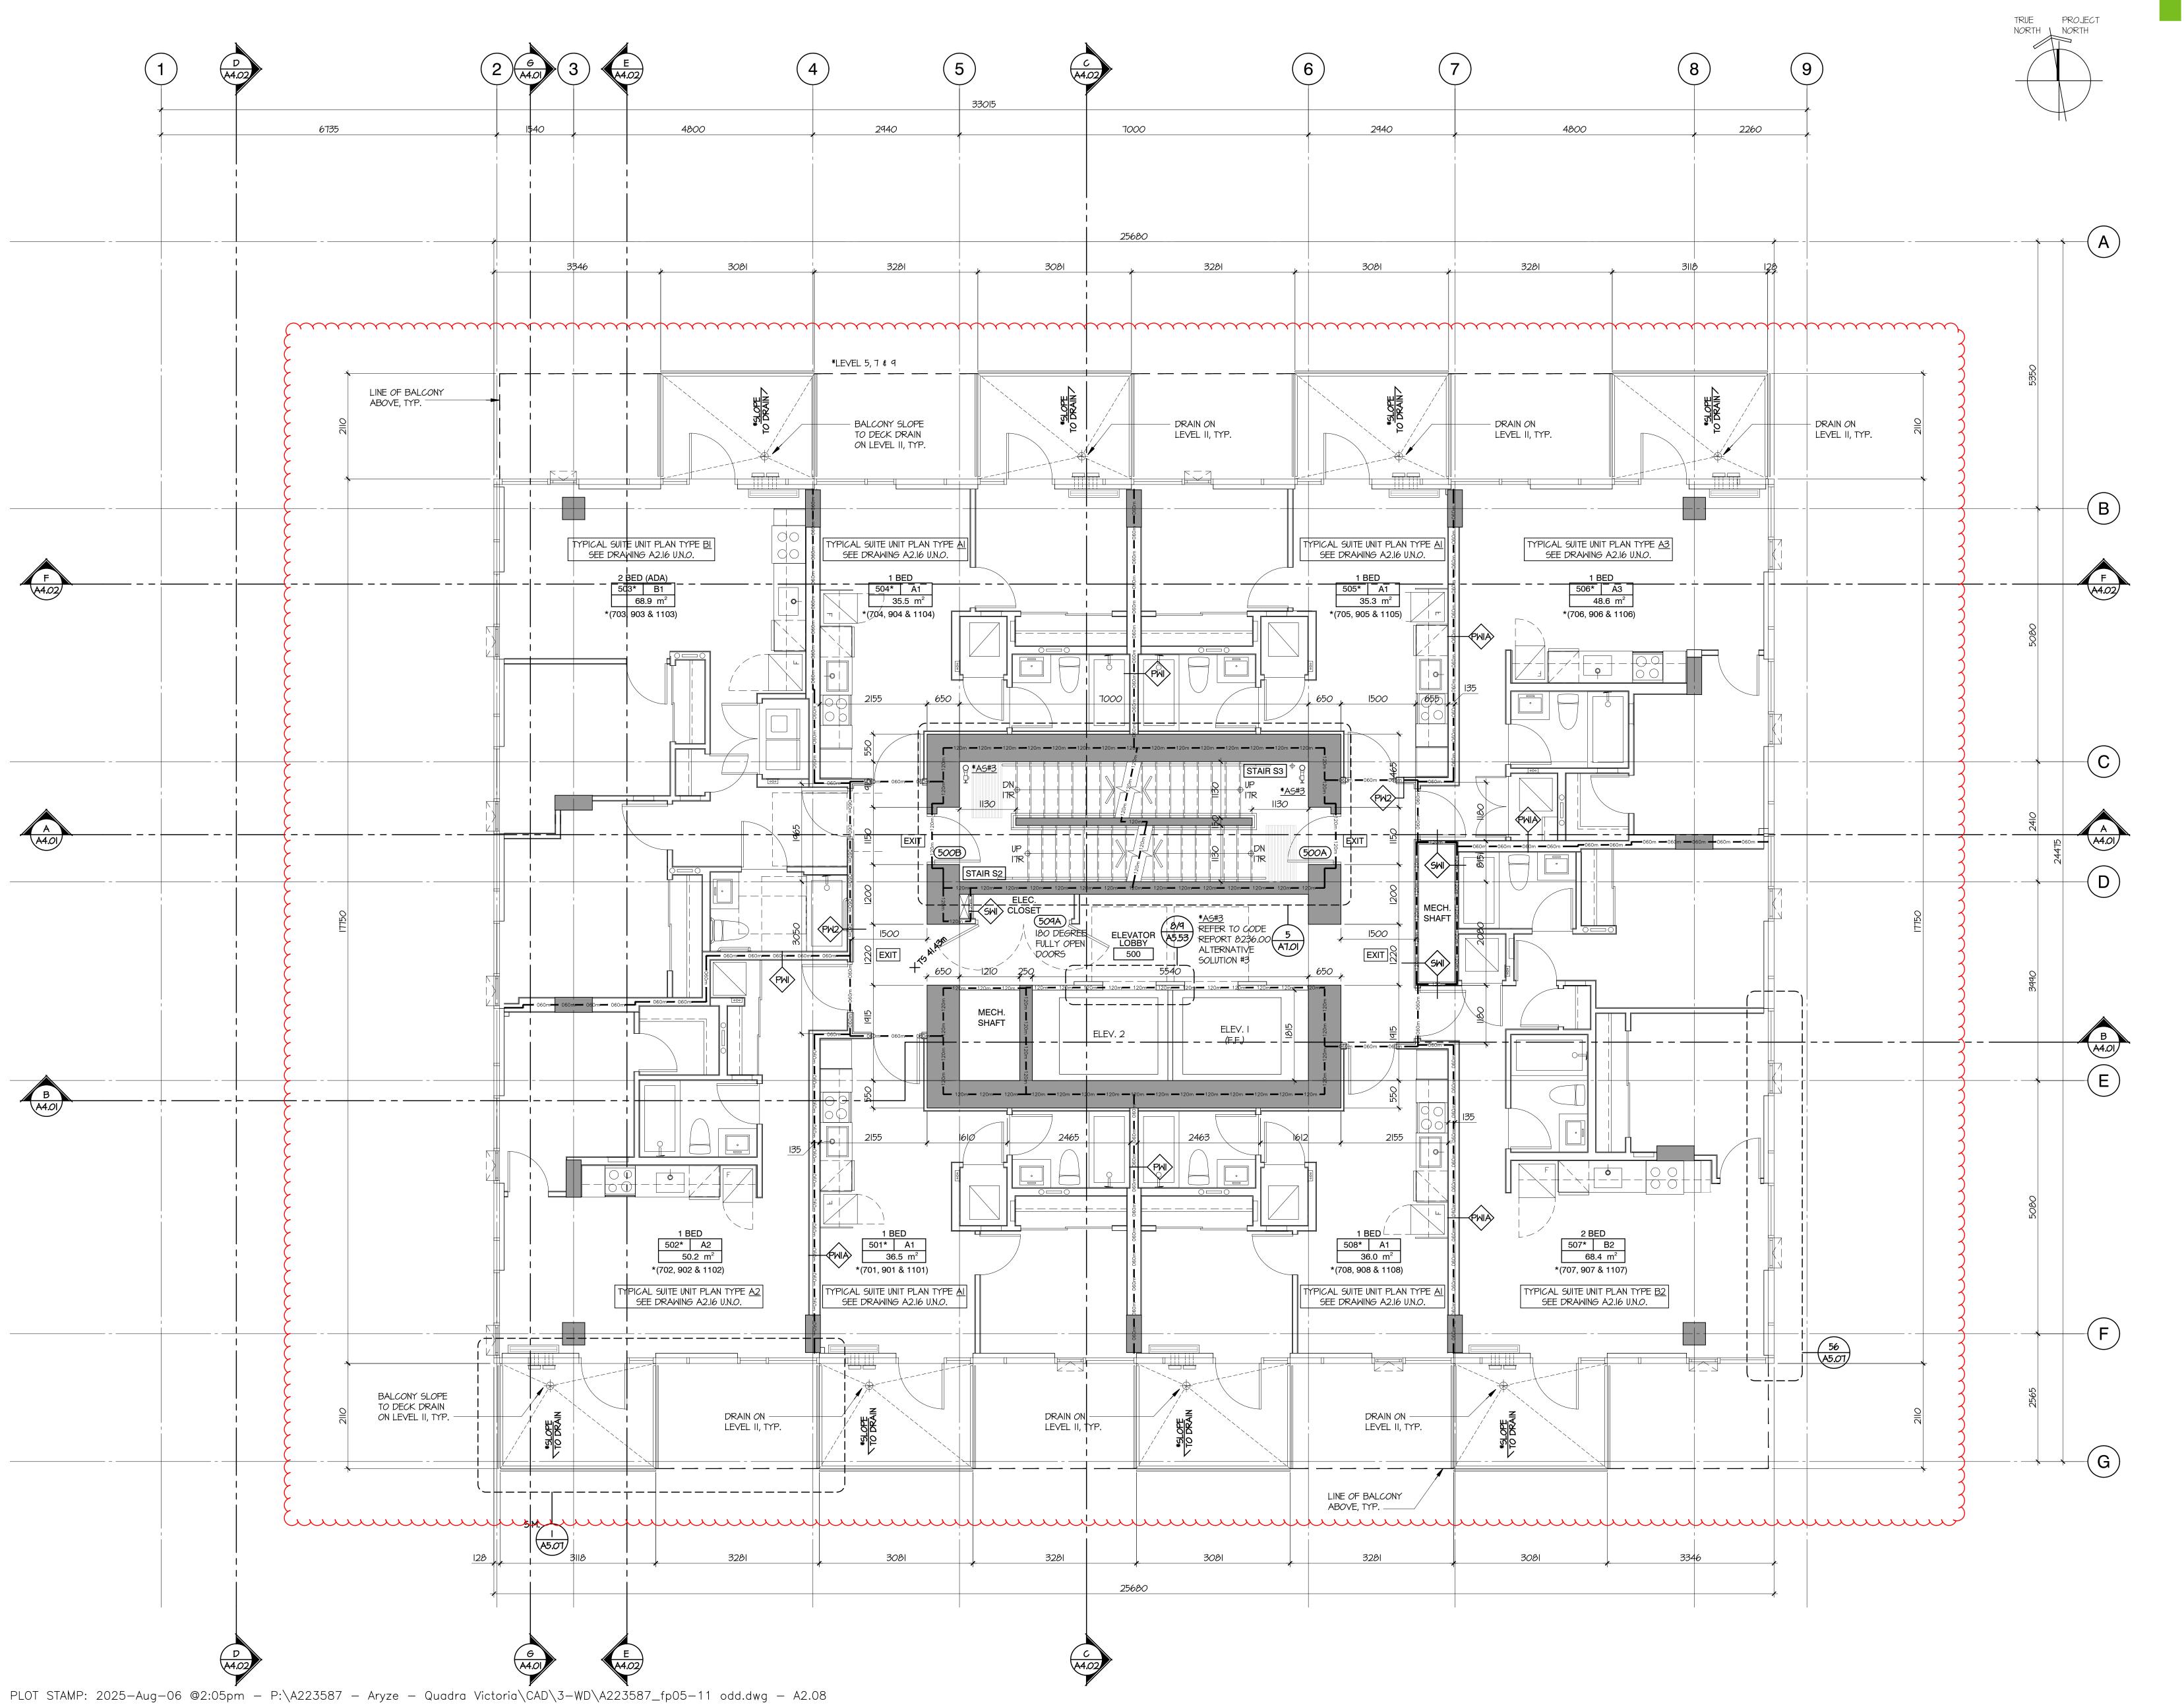

tel 604 669 7710 www.dysarchitecture.com

# ARYZE

IO. | DATE | ISSU

1 |2023/11/17 |ISSUED FOR 50% REVIEW
2 |2024/01/26 |ISSUED FOR 65% REVIEW
3 |2024/02/22 |ISSUED FOR BP
4 |2024/05/09 |RE-ISSUED FOR BP
5 |2024/07/05 |ISSUED FOR DRAFT IFT
6 |2024/07/13 |ISSUED FOR IFT ADDENDUM #1
7 |2024/07/31 |ISSUED FOR BP RESPONSE

8 | 2024/10/07 | ISSUED FOR BP RESPONSE #2


10 | 2025/01/24 | ISSUED FOR IFC

9 | 2024/10/20 | ISSUED FOR DRAFT IFC

NO. | DATE | REVISION

A | 2025/04/14 | ISSUED FOR AI#05
B | 2025/06/27 | ISSUED FOR AI#17
C | 2025/08/05 | ISSUED FOR AI#26

# THE ESTOYA

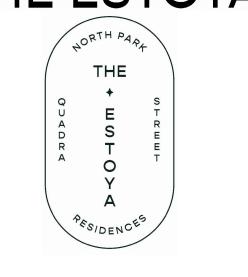



PROJECT

1708 QUADRA STREET, VICTORIA, B.C.

FLOOR PLAN LEVEL 5, 7, 9 & 11 LEVEL 5 SHOWN


This drawing, as an instrument of service, is the property of **dys** architecture and may not be reproduced without their permission and provided always that any production carries their name. All designs and other information shown on this drawing are for use on the specified project only and shall not be used otherwise without written permission of **dys** architecture. Payment of all sums due to **dys** architecture up to the date of use of this drawing is a condition precedent to the use thereof

Written dimensions shall have precedence over scaled dimensions. Contractors shall verify and be responsible for all dimensions and conditions on the job and dys architecture shall be informed of any variations from the dimensions and conditions shown on the drawings. Shop drawings shall be submitted to dys architecture for review before proceeding with

PROJECT A223587

DS CHECKED NC

SCALE 1:50
DATE AUG. 29, 2023

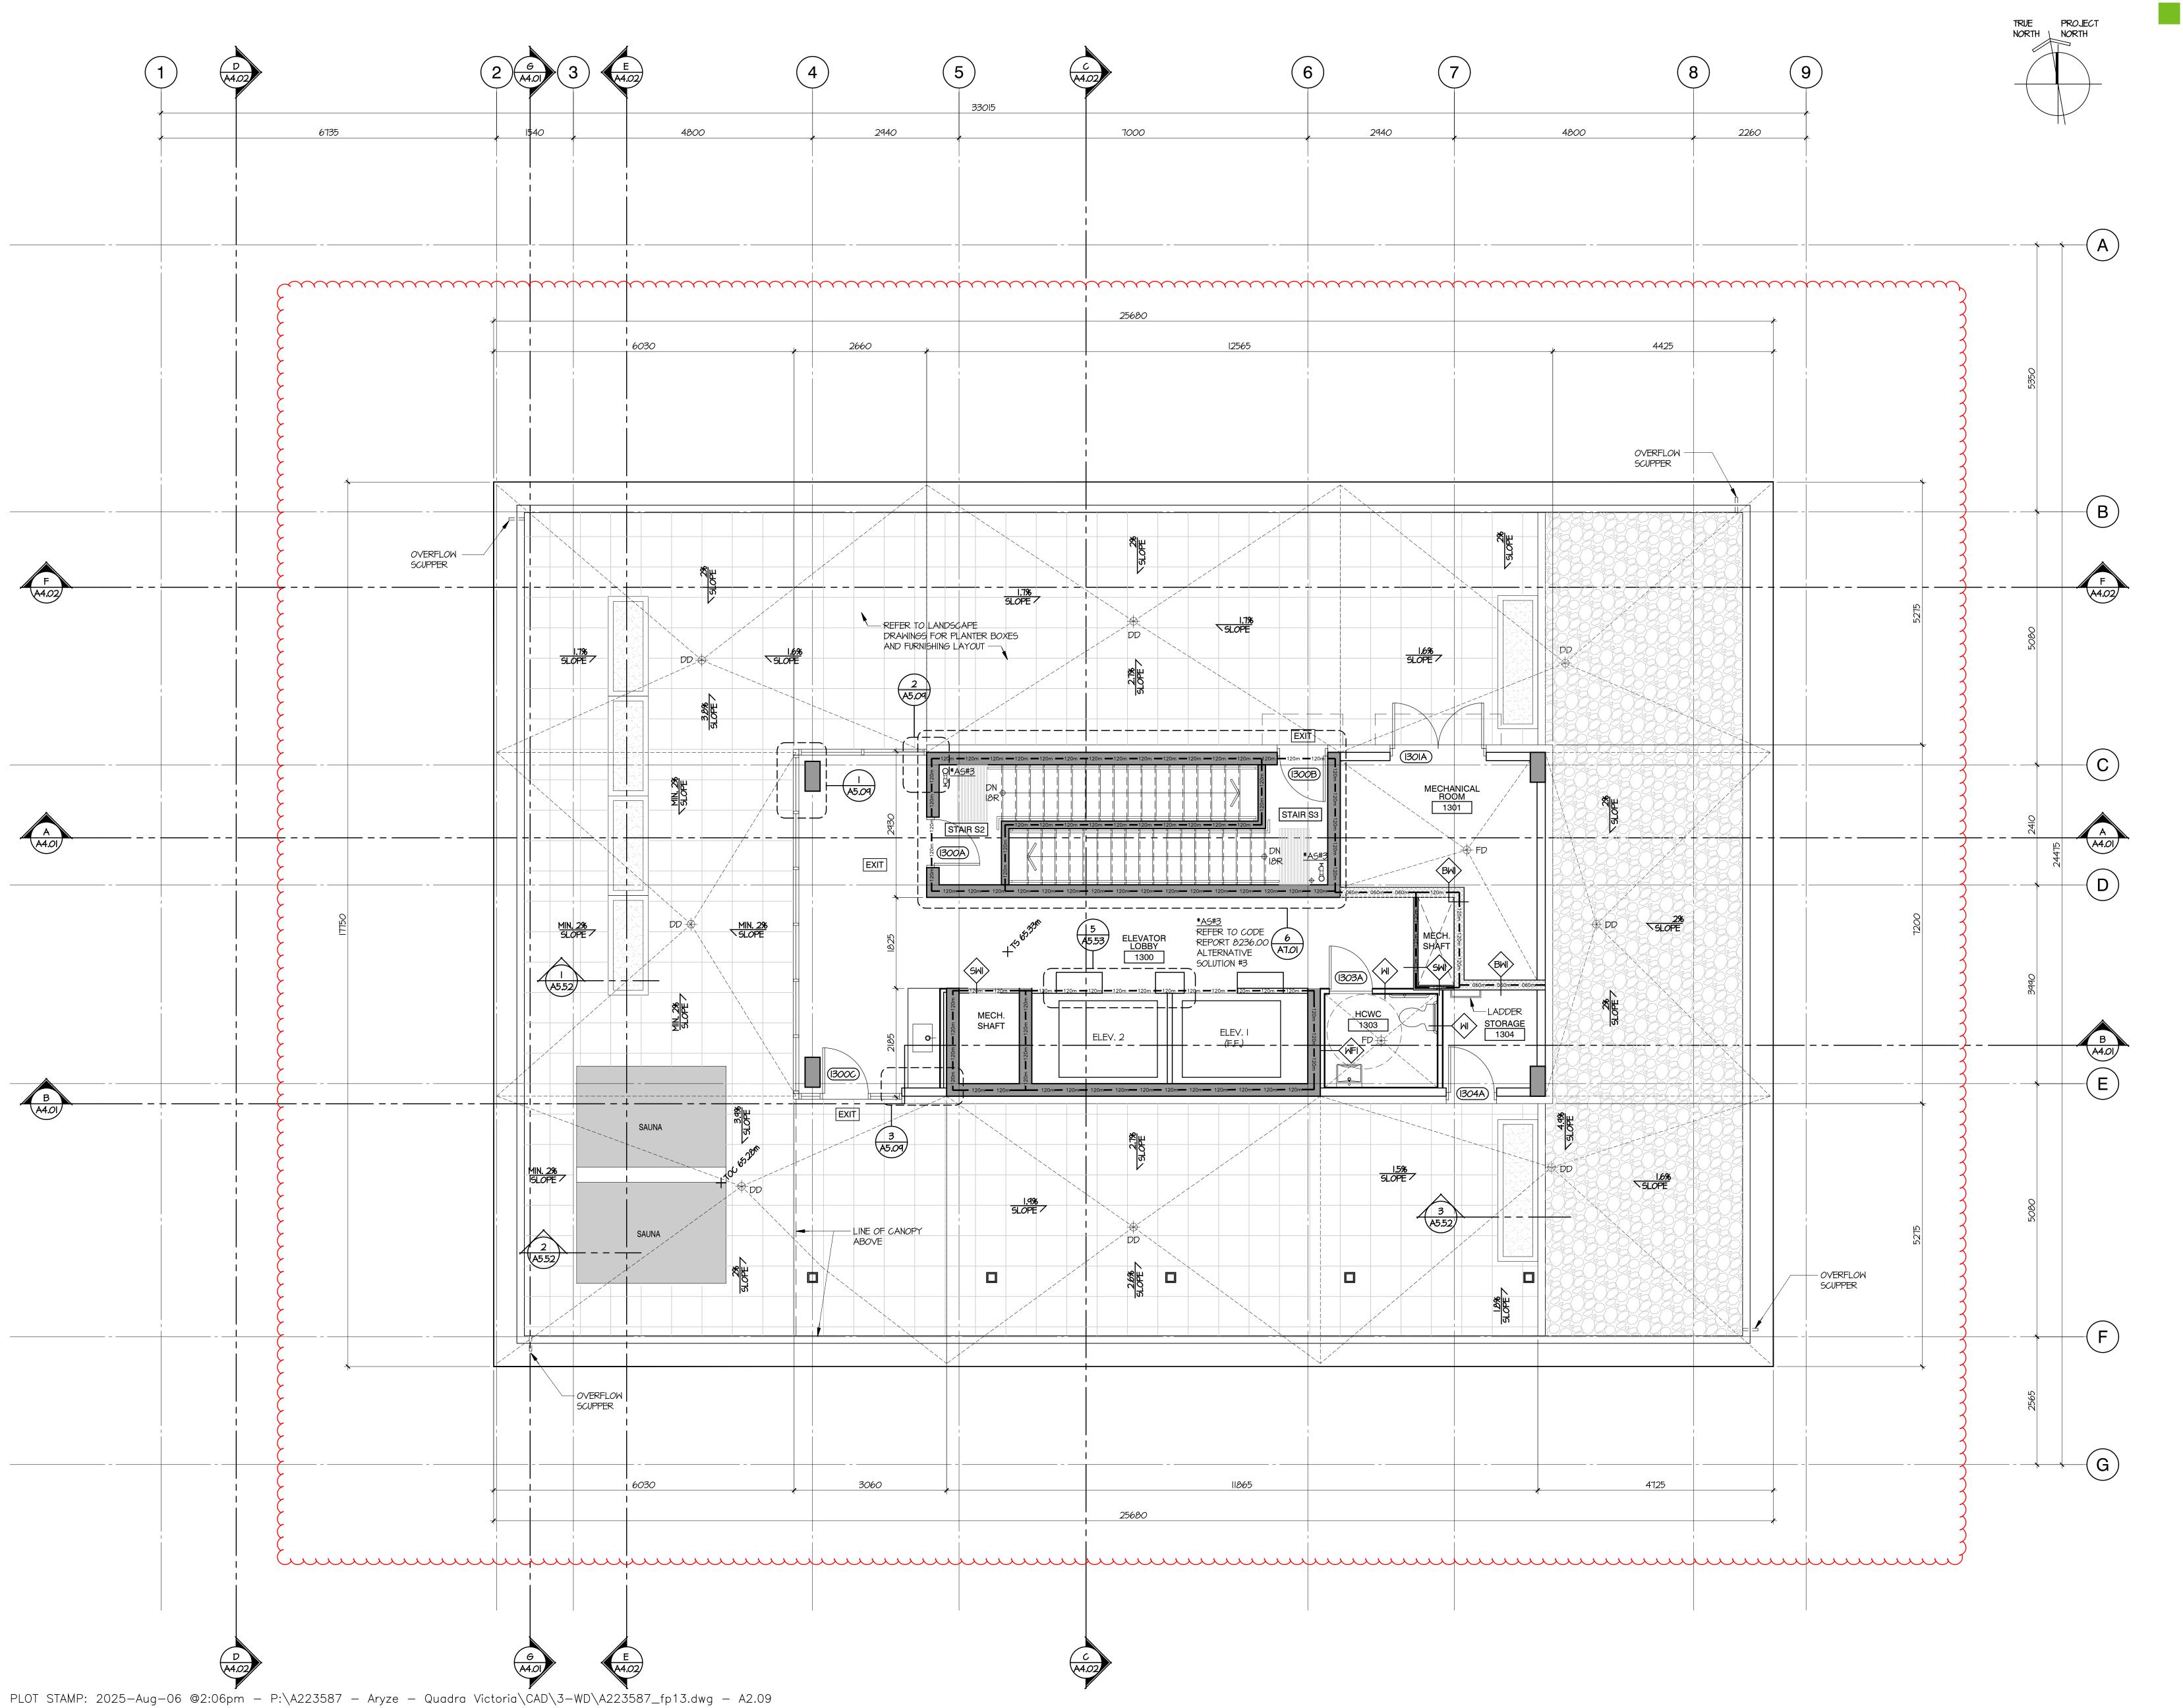

tel 604 669 7710 www.dysarchitecture.com

# ARYZE

10. | date | issui


1 | 2023/11/17 | ISSUED FOR 50% REVIEW
2 | 2024/01/26 | ISSUED FOR 65% REVIEW
3 | 2024/02/22 | ISSUED FOR BP
4 | 2024/05/09 | RE-ISSUED FOR BP
5 | 2024/07/05 | ISSUED FOR DRAFT IFT
6 | 2024/07/13 | ISSUED FOR IFT ADDENDUM #1
7 | 2024/07/31 | ISSUED FOR BP RESPONSE
8 | 2024/10/07 | ISSUED FOR BP RESPONSE #2

NO. | DATE | REVISION A | 2025/08/05 | ISSUED FOR AI#26

9 | 2024/10/20 | ISSUED FOR DRAFT IFC

10 | 2025/01/24 | ISSUED FOR IFC

THE ESTOYA

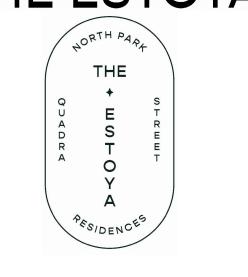



PROJECT

1708 QUADRA STREET, VICTORIA, B.C.

FLOOR PLAN LEVEL 13


This drawing, as an instrument of service, is the property of **dys** architecture and may not be reproduced without their permission and provided always that any production carries their name. All designs and other information shown on this drawing are for use on the specified project only and shall not be used otherwise without written permission of **dys** architecture. Payment of all sums due to **dys** architecture up to the date of use of this drawing is a condition precedent to the use thereof.

Written dimensions shall have precedence over scaled dimensions. Contractors shall verify and be responsible for all dimensions and conditions on the job and dys architecture shall be informed of any variations from the dimensions and conditions shown on the drawings. Shop drawings shall be submitted to dys architecture for review before proceeding with

PROJECT A223587

23587 CHECKED NC

SCALE 1:50
DATE SEP. 14, 2023

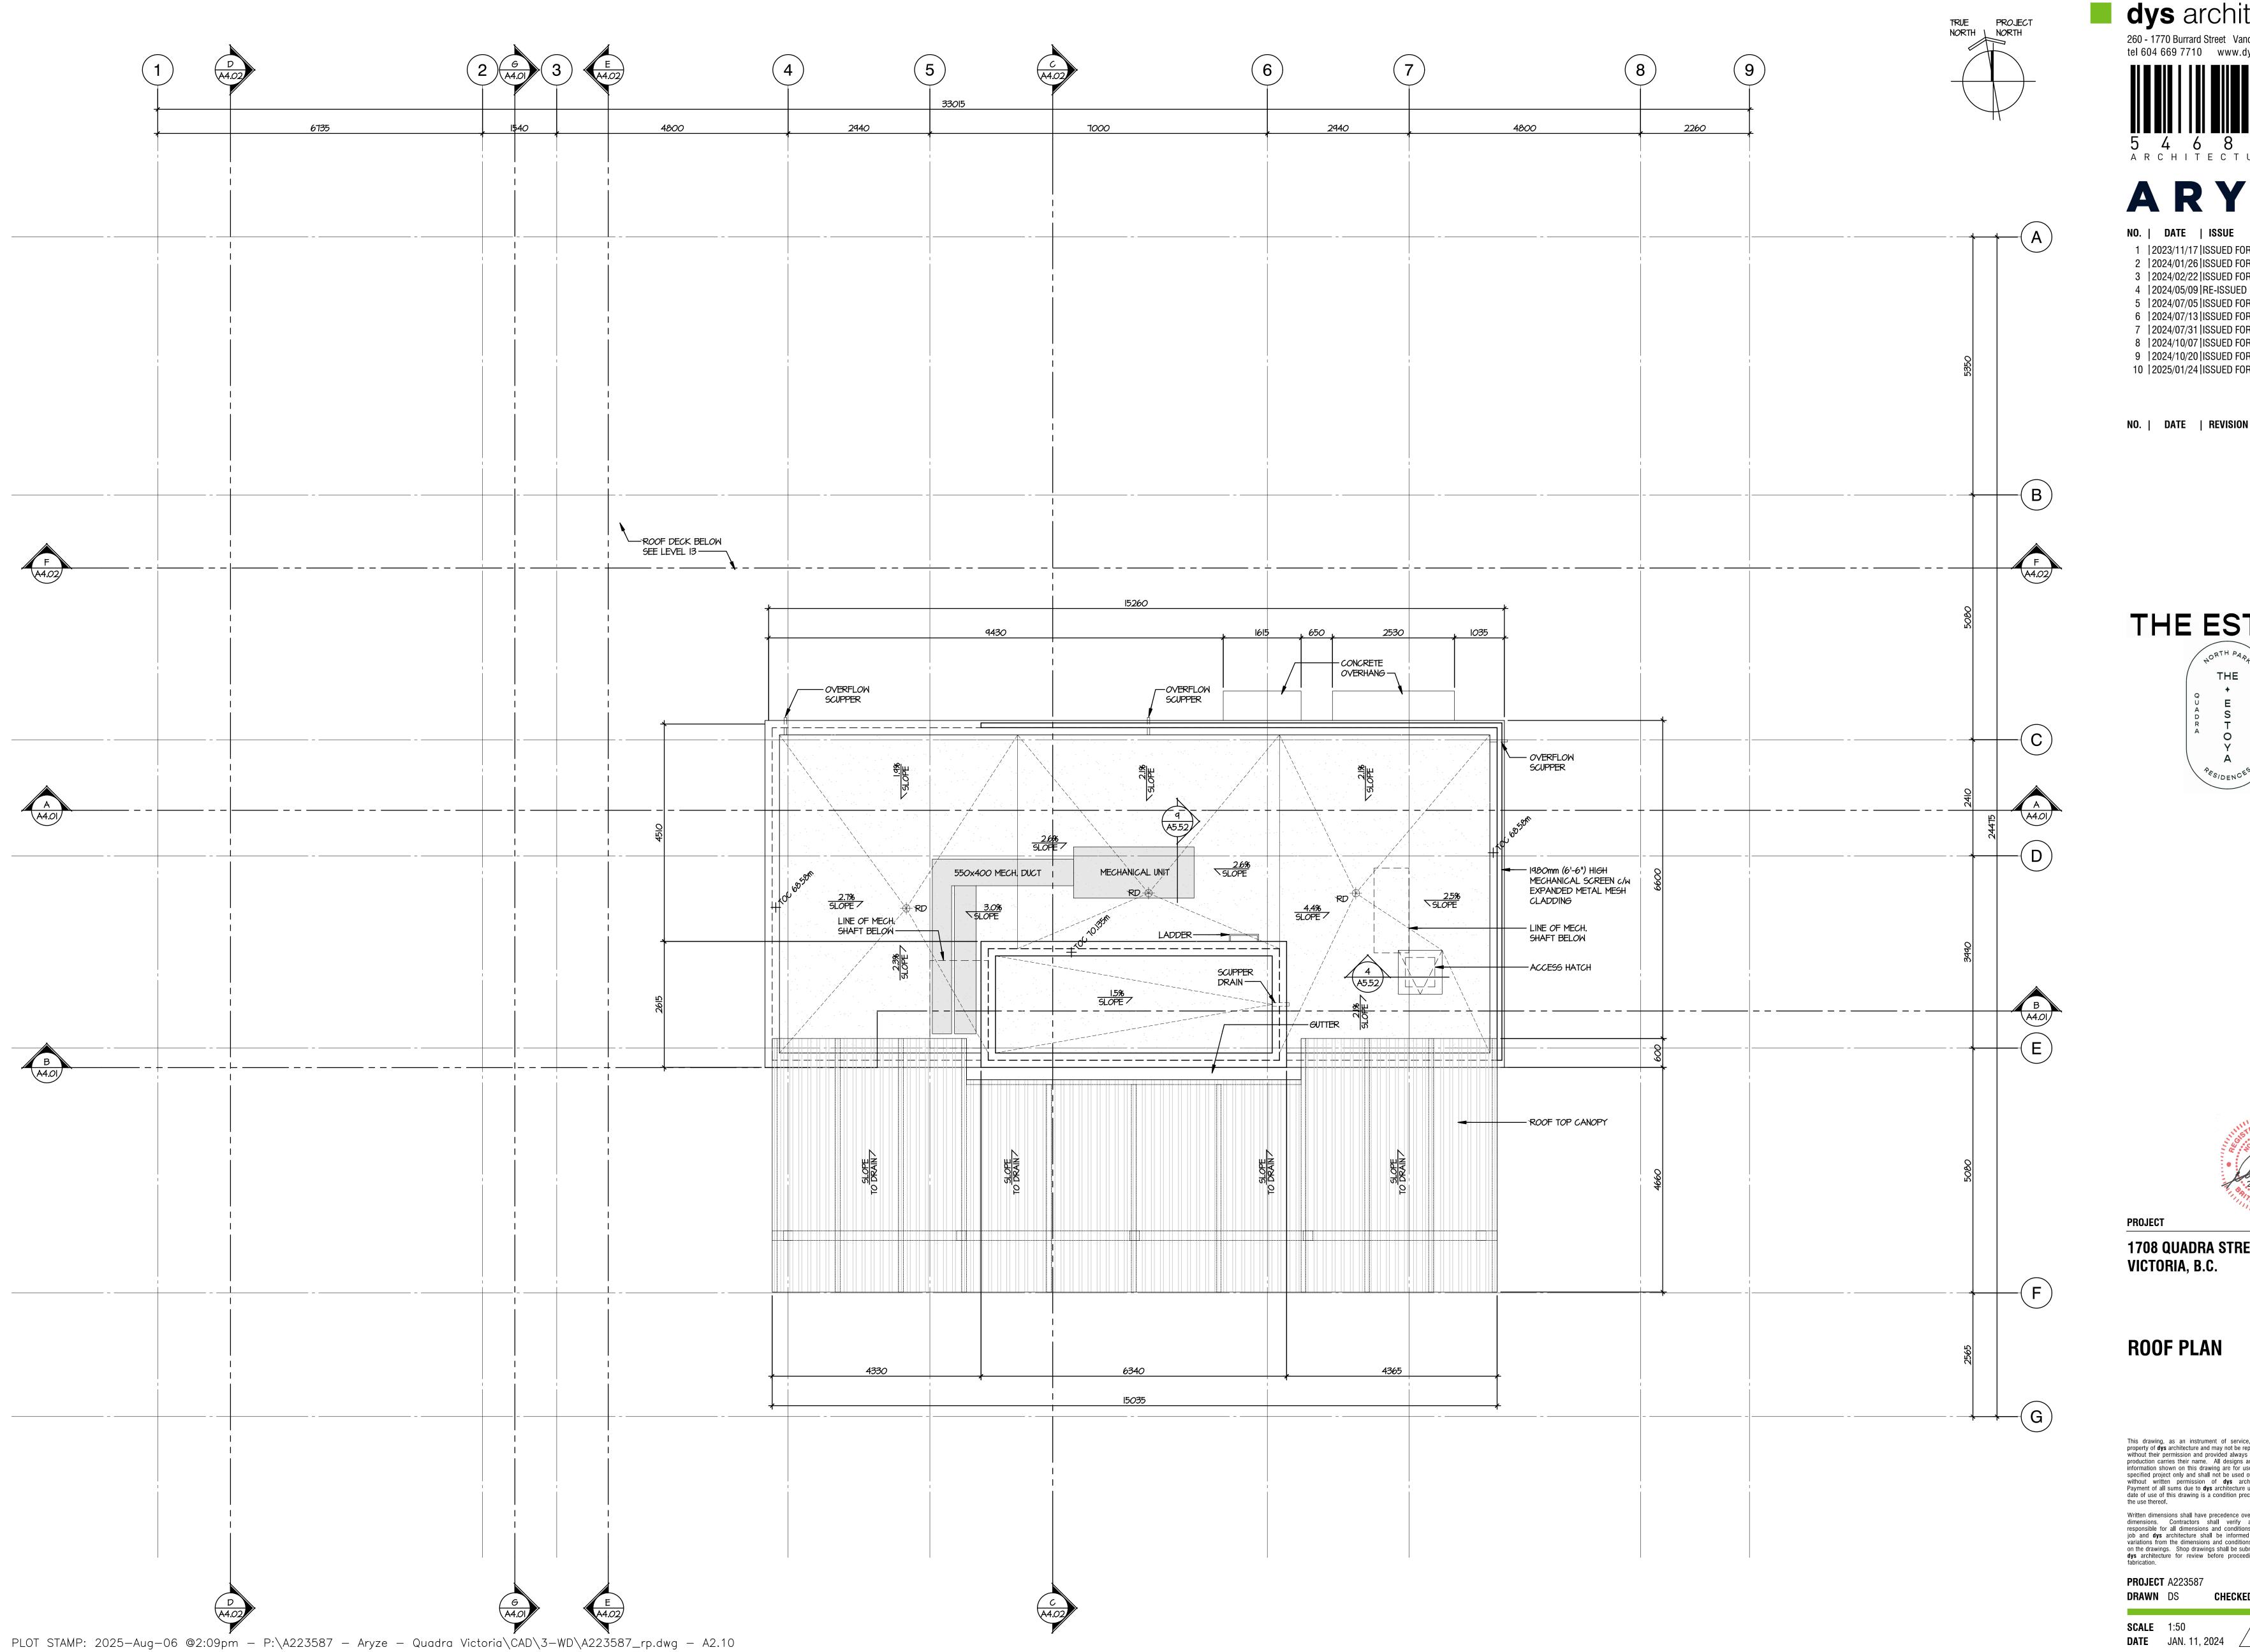

**dys** architecture

260 - 1770 Burrard Street Vancouver BC V6J 3G7 tel 604 669 7710 www.dysarchitecture.com

# ARYZE

NO. | DATE | ISSUE

1 | 2023/11/17 | ISSUED FOR 50% REVIEW 2 | 2024/01/26 | ISSUED FOR 65% REVIEW 3 |2024/02/22|ISSUED FOR BP 4 | 2024/05/09 | RE-ISSUED FOR BP 5 | 2024/07/05 | ISSUED FOR DRAFT IFT 6 | 2024/07/13 | ISSUED FOR IFT ADDENDUM #1 7 | 2024/07/31 | ISSUED FOR BP RESPONSE

8 | 2024/10/07 | ISSUED FOR BP RESPONSE #2 9 |2024/10/20|ISSUED FOR DRAFT IFC 10 | 2025/01/24 | ISSUED FOR IFC

THE ESTOYA



**PROJECT** 

1708 QUADRA STREET, VICTORIA, B.C.


**ROOF PLAN** 

This drawing, as an instrument of service, is the property of **dys** architecture and may not be reproduced without their permission and provided always that any production carries their name. All designs and other information shown on this drawing are for use on the specified project only and shall not be used otherwise without written permission of **dys** architecture. Payment of all sums due to **dys** architecture up to the date of use of this drawing is a condition precedent to the use thereof.

Written dimensions shall have precedence over scaled dimensions. Contractors shall verify and be responsible for all dimensions and conditions on the job and dys architecture shall be informed of any variations from the dimensions and conditions shown on the drawings. Shop drawings shall be submitted to dys architecture for review before proceeding with fabrication.

PROJECT A223587

**DATE** JAN. 11, 2024

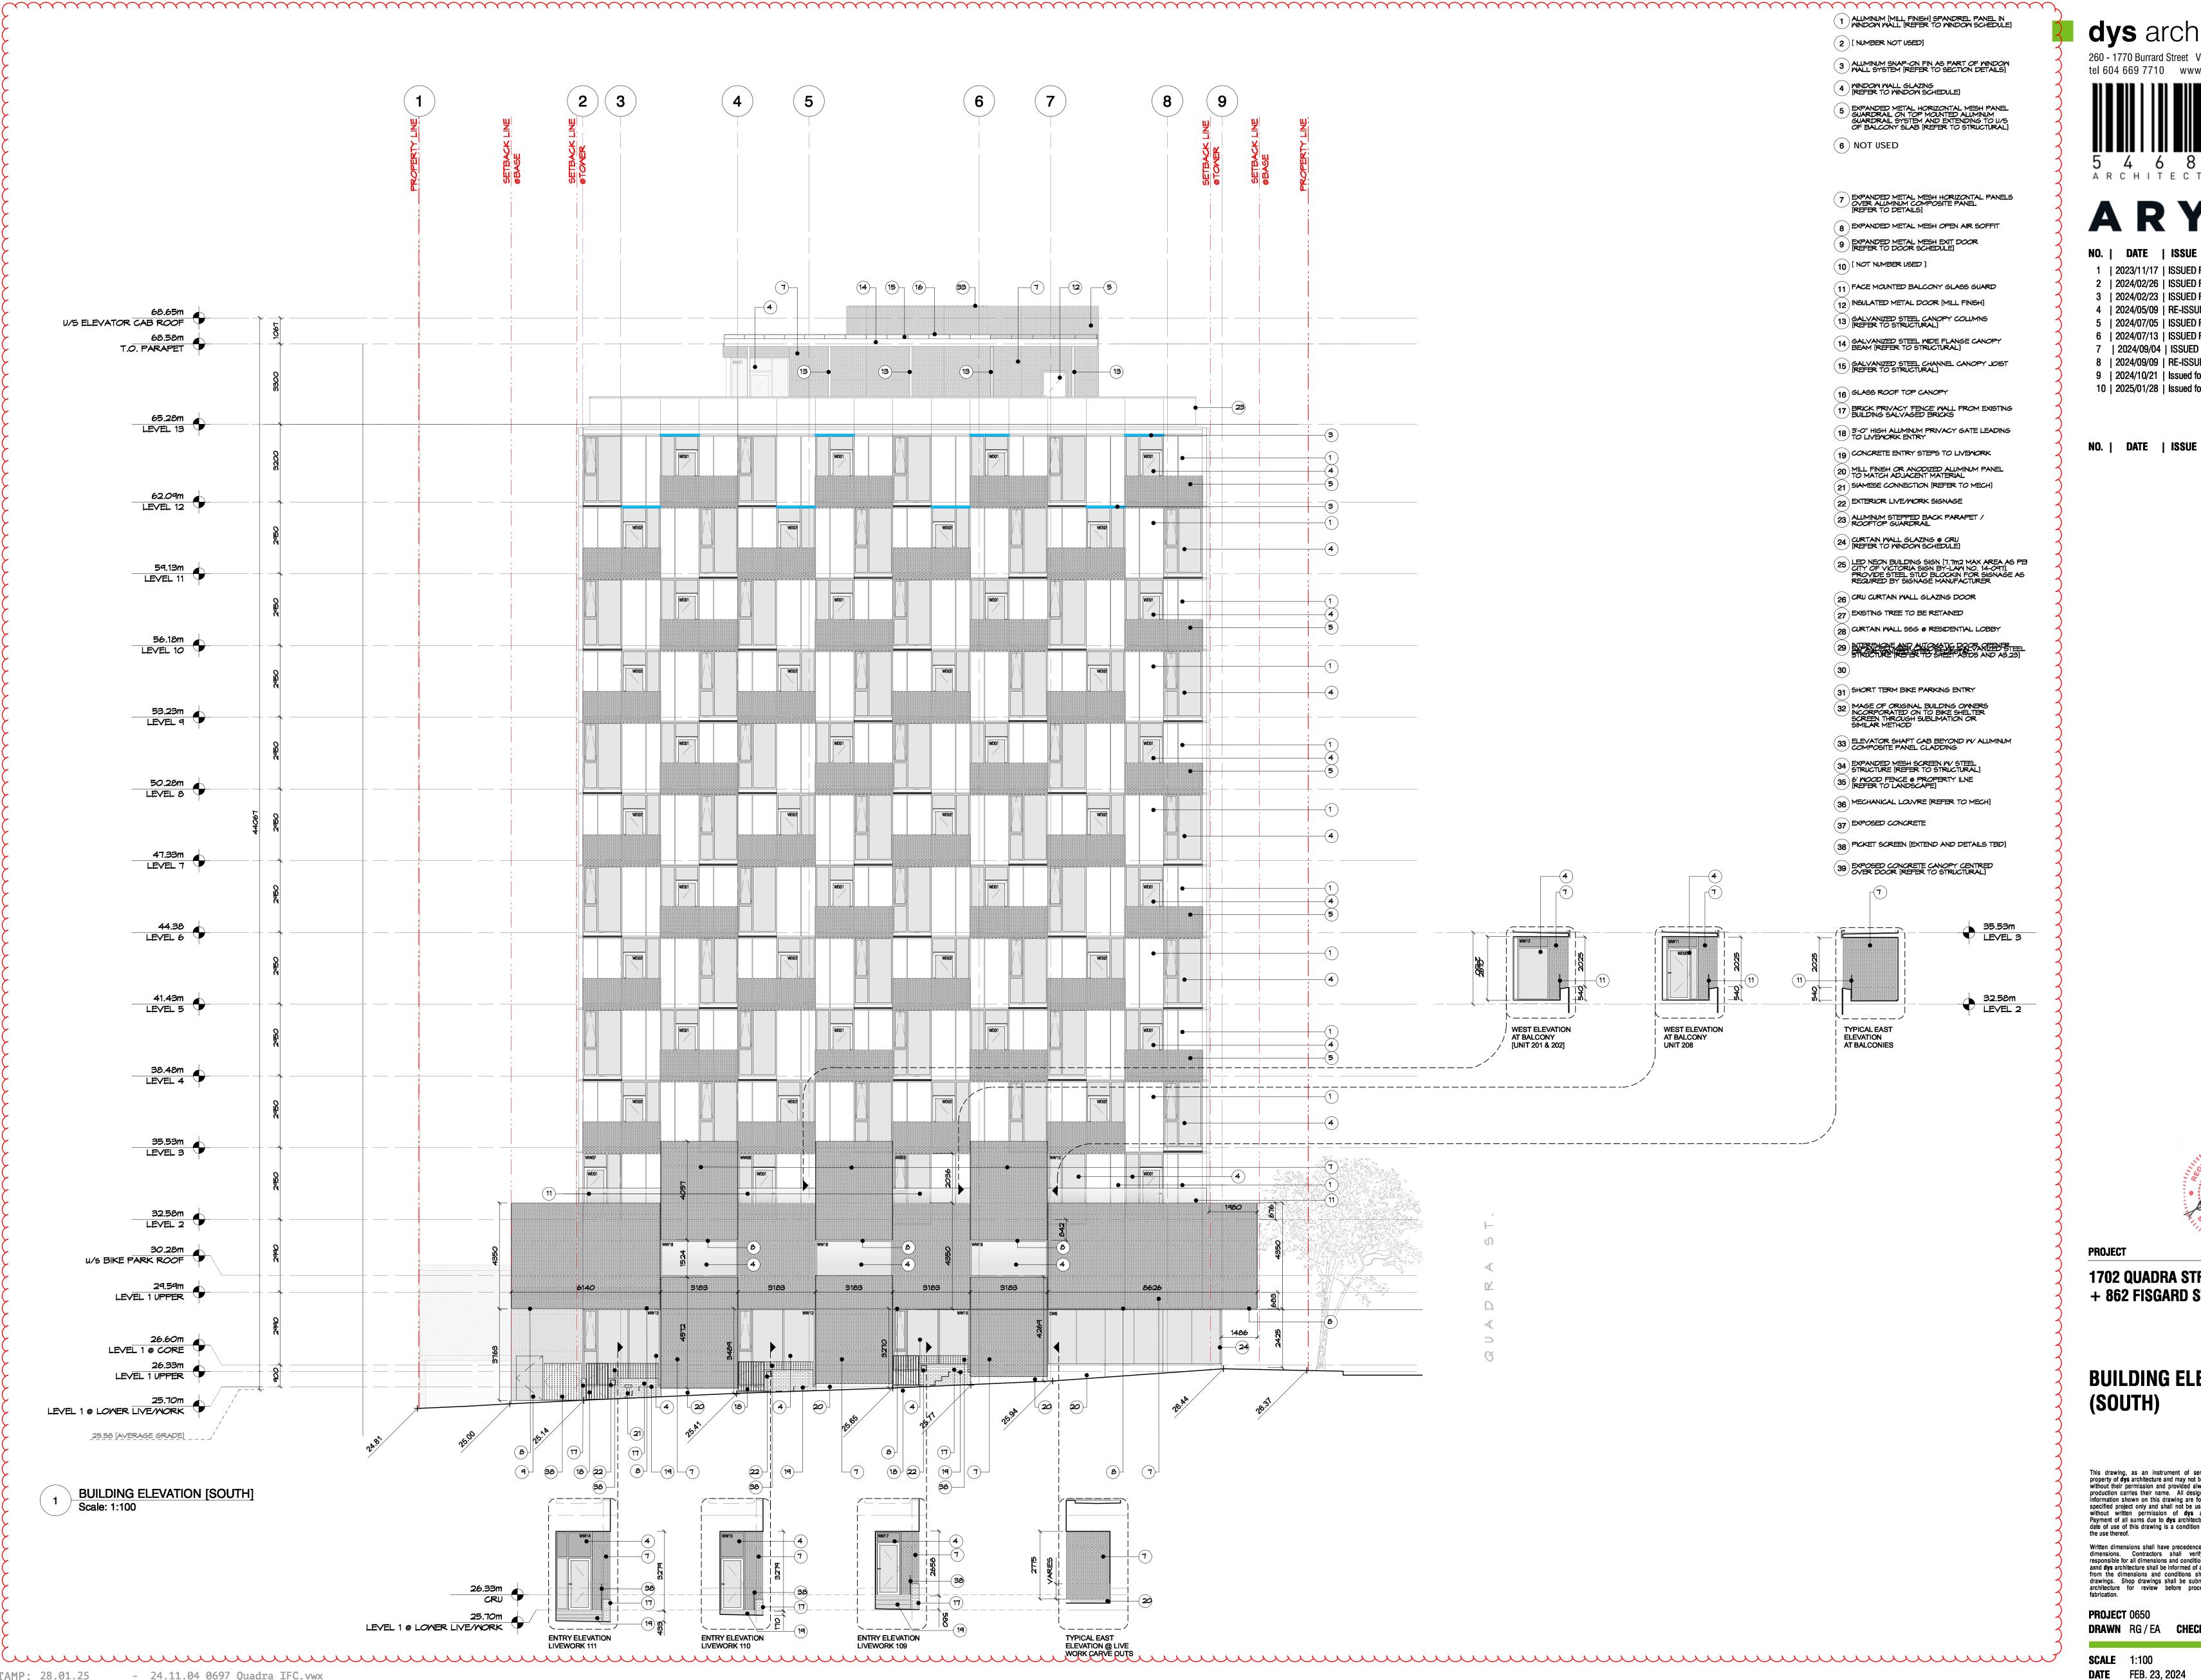

dys architecture

260 - 1770 Burrard Street Vancouver BC V6J 3G7 tel 604 669 7710 www.dysarchitecture.com



NO. | DATE | ISSUE 1 | 2023/11/17 | ISSUED FOR 50% REVIEW

2 | 2024/02/26 | ISSUED FOR 65% REVIEW 3 | 2024/02/23 | ISSUED FOR BUILDING PERMIT 4 | 2024/05/09 | RE-ISSUED FOR BUILDING PERMIT 5 | 2024/07/05 | ISSUED FOR DRAFT IFT

6 | 2024/07/13 | ISSUED FOR IFT ADDENDUM #1 7 | 2024/09/04 | ISSUED FOR PRICING 8 | 2024/09/09 | RE-ISSUED FOR IFT ADDENDUM #4 9 | 2024/10/21 | Issued for DRAFT IFC

10 | 2025/01/28 | Issued for IFC

**PROJECT** 

**1702 QUADRA STREET** + 862 FISGARD STREET

**BUILDING ELEVATIONS** (SOUTH)

This drawing, as an instrument of service, is the property of **dys** architecture and may not be reproduced without their permission and provided always that any production carries their name. All designs and other information shown on this drawing are for use on the specified project only and shall not be used otherwise without written permission of **dys** architecture. Payment of all sums due to **dys** architecture up to the date of use of this drawing is a condition precedent to the use thereof.

Written dimensions shall have precedence over scaled dimensions. Contractors shall verify and be responsible for all dimensions and conditions on the job axnd dys architecture shall be informed of any variations from the dimensions and conditions shown on the drawings. Shop drawings shall be submitted to dys architecture for review before proceeding with fabrication.

DRAWN RG/EA CHECKED

**DATE** FEB. 23, 2024



# 1 ALIMINUM [MILL FINISH] SPANDREL PANEL IN WINDOW WALL [REFER TO WINDOW SCHEDULE]

(2) [ NUMBER NOT USED]

3 ALLMINUM SNAP-ON FIN AS PART OF MINDOM WALL SYSTEM [REFER TO SECTION DETAILS]

4 WINDOW WALL GLAZING [REFER TO WINDOW SCHEDULE]

# 5 EXPANDED METAL HORIZONTAL MESH PANEL GUARDRAIL ON TOP MOUNTED ALUMINUM GUARDRAIL SYSTEM AND EXTENDING TO U/S OF BALCONY SLAB [REFER TO STRUCTURAL]

6 NOT USED

7 EXPANDED METAL MESH HORIZONTAL PANELS OVER ALIMINUM COMPOSITE PANEL [REFER TO DETAILS]

- 8 EXPANDED METAL MESH OPEN AIR SOFFIT
- 9 EXPANDED METAL MESH EXIT DOOR [REFER TO DOOR SCHEDULE] (10) [ NOT NUMBER USED ]
- (11) FACE MOUNTED BALCONY GLASS GUARD
- 12 INSULATED METAL DOOR [MILL FINISH] (13) GALVANIZED STEEL CANOPY COLUMNS [REFER TO STRUCTURAL]
- 14 GALVANIZED STEEL MIDE FLANGE CANOPY BEAM [REFER TO STRUCTURAL]
- (15) GALVANIZED STEEL CHANNEL CANOPY JOIST [REFER TO STRUCTURAL]
- (16) GLASS ROOF TOP CANOPY
- 17) BRICK PRIVACY FENCE WALL FROM EXISTING BUILDING SALVAGED BRICKS
- 18 3'-0" HIGH ALUMINUM PRIVACY GATE LEADING TO LIVENORK ENTRY
- 19 CONCRETE ENTRY STEPS TO LIVEWORK
- 20 MILL FINISH OR ANODIZED ALUMINUM PANEL TO MATCH ADJACENT MATERIAL 21 SIAMESE CONNECTION [REFER TO MECH]
- (22) EXTERIOR LIVE/WORK SIGNAGE
- 23 ALUMINUM STEPPED BACK PARAPET / ROOFTOP GUARDRAIL
- 24 CURTAIN WALL GLAZING @ CRU [REFER TO WINDOW SCHEDULE]
- 25 LED NEON BUILDING SIGN [7.7m2 MAX AREA AS PEI CITY OF VICTORIA SIGN BY-LAW NO. 14-09T]. PROVIDE STEEL STUD BLOCKIN FOR SIGNAGE AS REQUIRED BY SIGNAGE MANUFACTURER
- 26 CRU CURTAIN WALL GLAZING DOOR
- 27 EXISTING TREE TO BE RETAINED (28) CURTAIN WALL 55G @ RESIDENTIAL LOBBY
- 29 NERSHONE AND AUTOMATIC DOOR OF THE STEEL STREET AS 05 AND A5.23]
- - $\binom{31}{31}$  SHORT TERM BIKE PARKING ENTRY

# 32 IMAGE OF ORIGINAL BUILDING OWNERS INCORPORATED ON TO BIKE SHELTER SCREEN THROUGH SUBLIMATION OR SIMILAR METHOD

- 33 ELEVATOR SHAFT CAB BEYOND W ALUMINUM COMPOSITE PANEL CLADDING
- 34 EXPANDED MESH SCREEN W/ STEEL STRUCTURE [REFER TO STRUCTURAL]
- 35 6' MOOD FENCE @ PROPERTY ILNE [REFER TO LANDSCAPE]
- (36) MECHANICAL LOUVRE [REFER TO MECH]
- (37) EXPOSED CONCRETE
- (38) PICKET SCREEN [EXTEND AND DETAILS TBD]
- 39 EXPOSED CONCRETE CANOPY CENTRED OVER DOOR [REFER TO STRUCTURAL]

# dys architecture

260 - 1770 Burrard Street Vancouver BC V6J 3G7 tel 604 669 7710 www.dysarchitecture.com

NO. | DATE | ISSUE

1 | 2023/11/17 | ISSUED FOR 50% REVIEW 2 | 2024/02/26 | ISSUED FOR 65% REVIEW

3 | 2024/02/23 | ISSUED FOR BUILDING PERMIT 4 | 2024/05/09 | RE-ISSUED FOR BUILDING PERMIT 5 | 2024/07/05 | ISSUED FOR DRAFT IFT

6 | 2024/07/13 | ISSUED FOR IFT ADDENDUM #1 7 | 2024/09/04 | ISSUED FOR PRICING 8 | 2024/09/09 | RE-ISSUED FOR IFT ADDENDUM #4

9 | 2024/10/21 | Issued for DRAFT IFC 10 | 2025/01/28 | Issued for IFC

NO. | DATE | ISSUE



**PROJECT** 


**1702 QUADRA STREET** + 862 FISGARD STREET

**BUILDING ELEVATIONS** (EAST)

This drawing, as an instrument of service, is the property of **dys** architecture and may not be reproduced without their permission and provided always that any production carries their name. All designs and other information shown on this drawing are for use on the specified project only and shall not be used otherwise without written permission of **dys** architecture. Payment of all sums due to **dys** architecture up to the date of use of this drawing is a condition precedent to the use thereof

Written dimensions shall have precedence over scaled dimensions. Contractors shall verify and be responsible for all dimensions and conditions on the job axnd dys architecture shall be informed of any variations from the dimensions and conditions shown on the drawings. Shop drawings shall be submitted to dys architecture for review before proceeding with fabrication.

**PROJECT** 0650

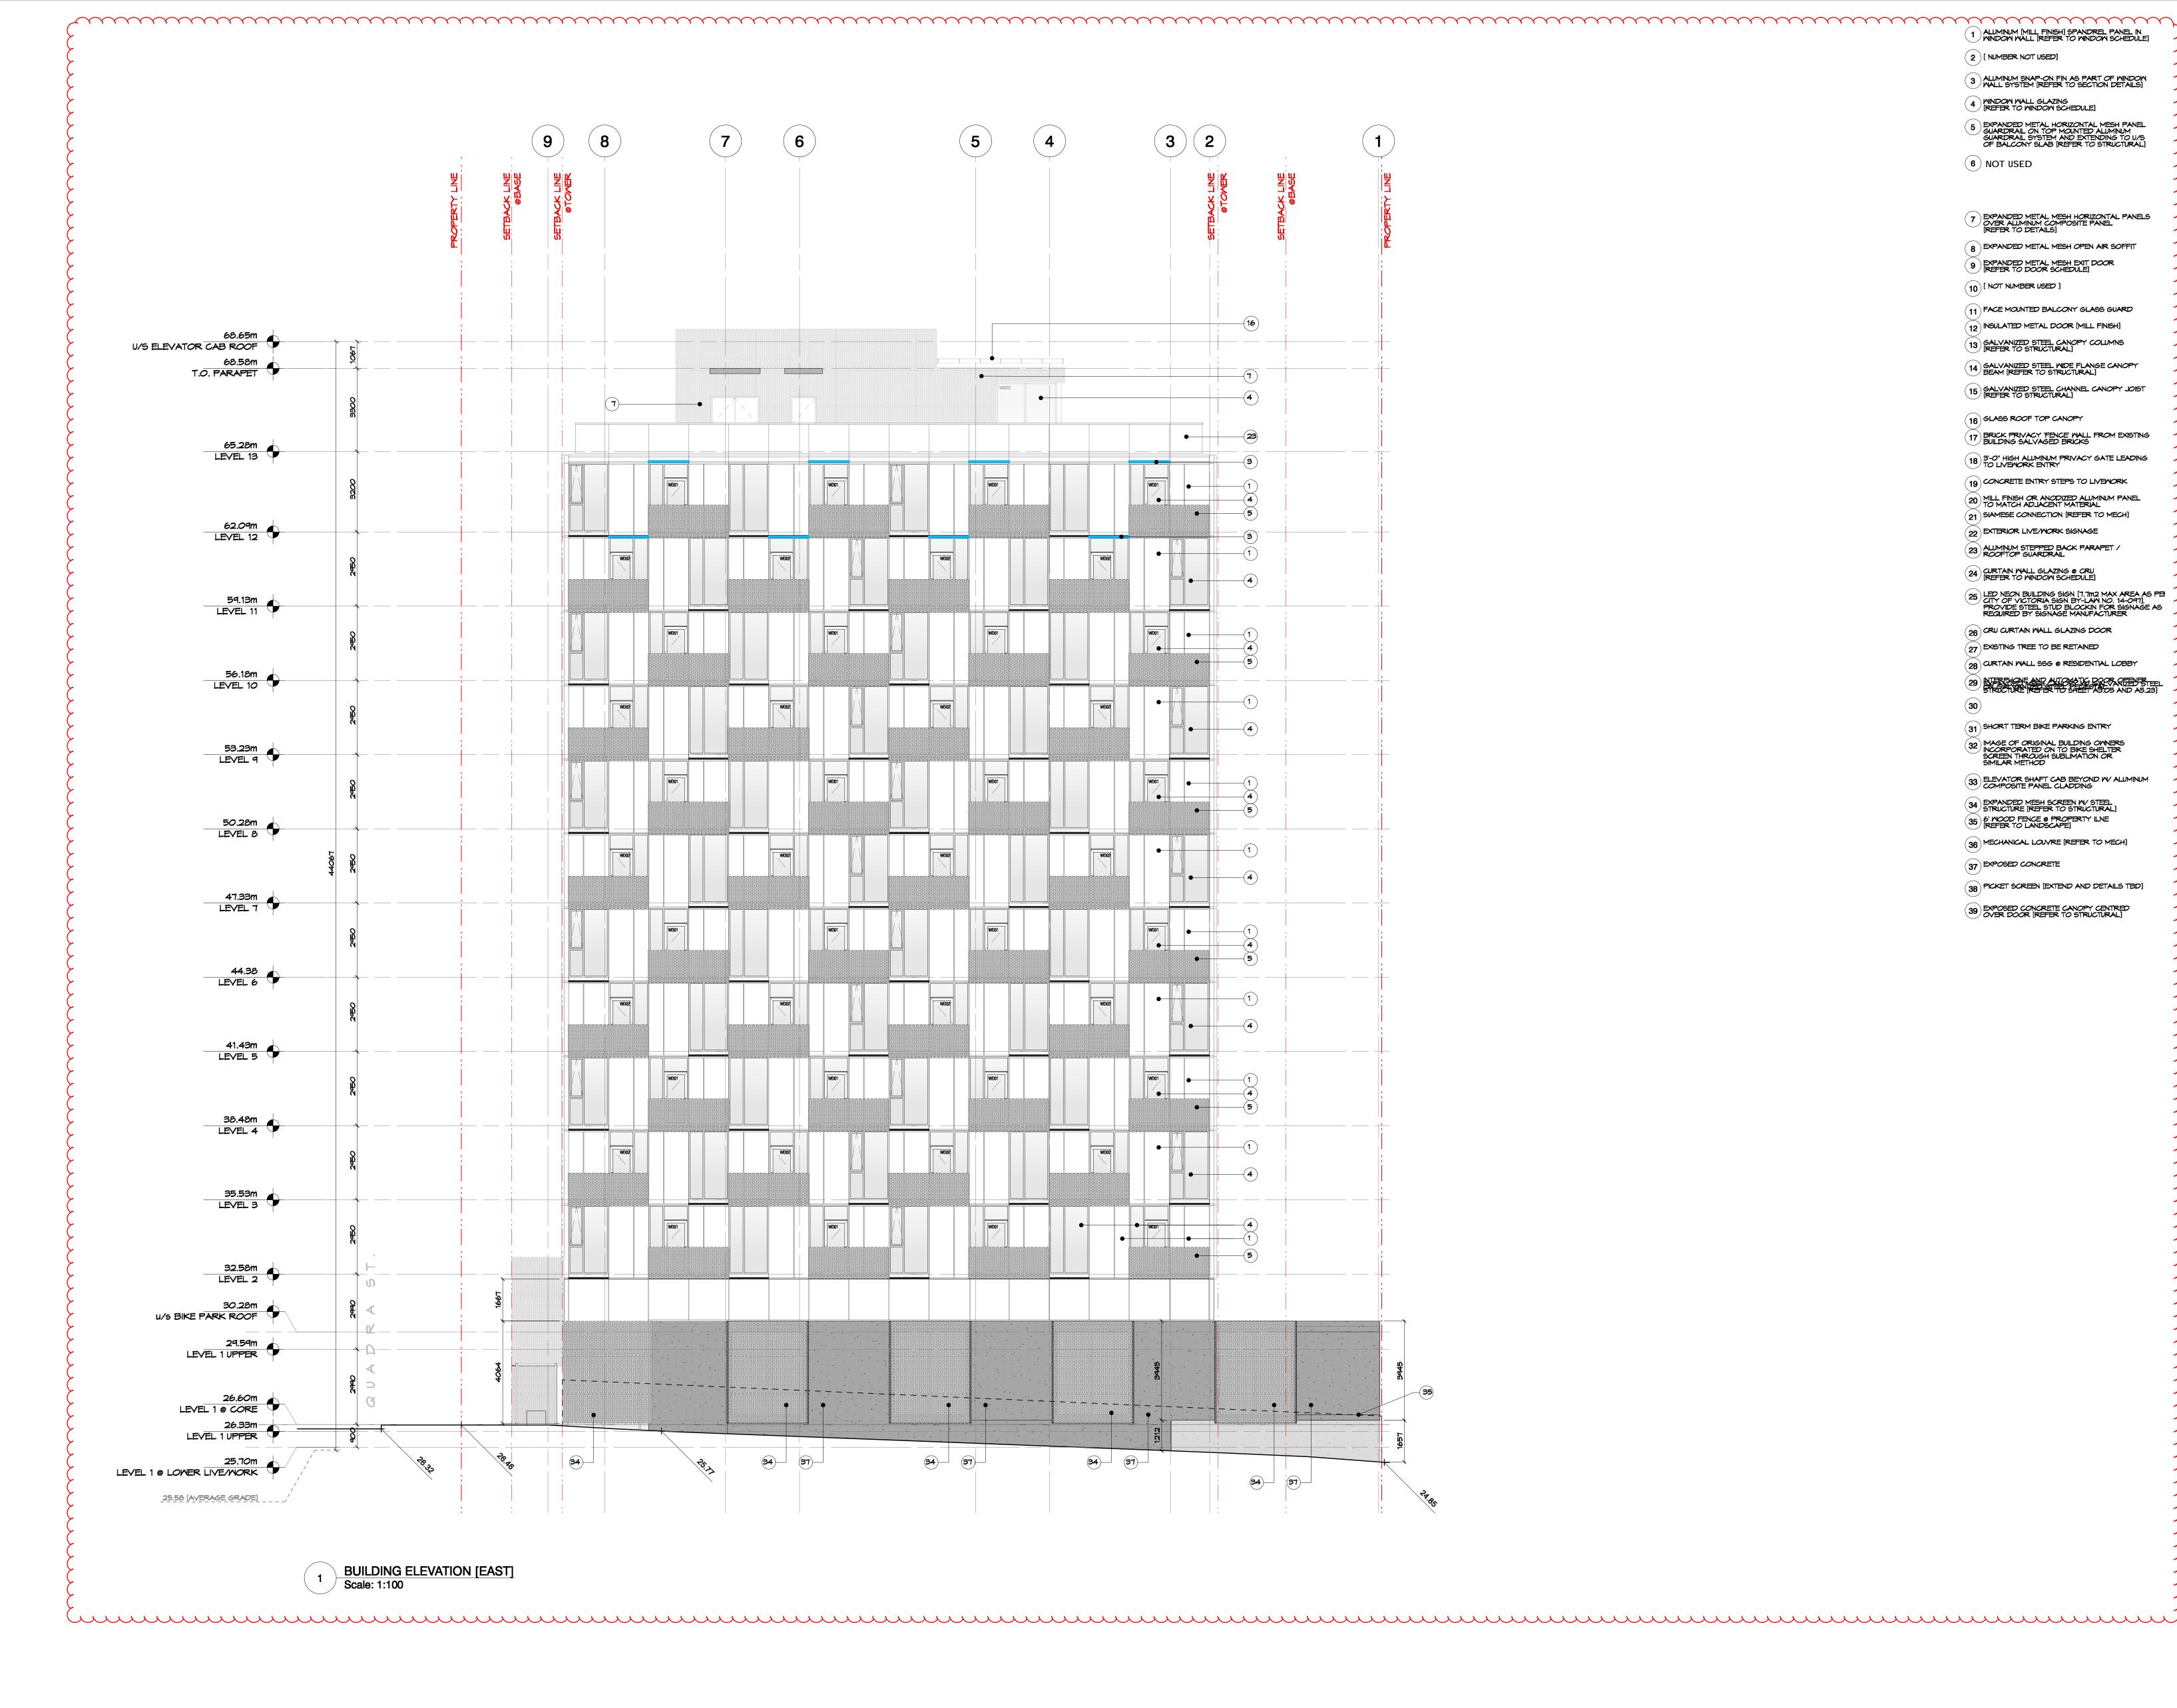

1 ALIMINUM [MILL FINISH] SPANDREL PANEL IN WINDOW WALL [REFER TO WINDOW SCHEDULE]

(2) [ NUMBER NOT USED]

3 ALLMINIM SNAP-ON FIN AS PART OF MINDOM WALL SYSTEM [REFER TO SECTION DETAILS] 4 MINDOW WALL GLAZING [REFER TO MINDOM SCHEDULE]

# 5 EXPANDED METAL HORIZONTAL MESH PANEL GUARDRAIL ON TOP MOUNTED ALUMINUM GUARDRAIL SYSTEM AND EXTENDING TO U/S OF BALCONY SLAB [REFER TO STRUCTURAL]

(6) NOT USED

7 EXPANDED METAL MESH HORIZONTAL PANELS OVER ALIMINUM COMPOSITE PANEL [REFER TO DETAILS]

- 8 EXPANDED METAL MESH OPEN AIR SOFFIT
- 9 EXPANDED METAL MESH EXIT DOOR [REFER TO DOOR SCHEDULE]
- (10) [ NOT NUMBER USED ]
- (11) FACE MOUNTED BALCONY GLASS GUARD 12 INSULATED METAL DOOR [MILL FINISH]
- (13) GALVANIZED STEEL CANOPY COLUMNS [REFER TO STRUCTURAL] 14 GALVANIZED STEEL MIDE FLANGE CANOPY BEAM [REFER TO STRUCTURAL]
- (15) GALVANIZED STEEL CHANNEL CANOPY JOIST [REFER TO STRUCTURAL]
- (16) GLASS ROOF TOP CANOPY
- 17 BRICK PRIVACY FENCE WALL FROM EXISTING BUILDING SALVAGED BRICKS
- 18 3'-0" HIGH ALUMINUM PRIVACY GATE LEADING TO LIVENORK ENTRY 19 CONCRETE ENTRY STEPS TO LIVEWORK
- 20 MILL FINISH OR ANODIZED ALUMINUM PANEL TO MATCH ADJACENT MATERIAL (21) SIAMESE CONNECTION [REFER TO MECH]
- (22) EXTERIOR LIVE/WORK SIGNAGE
- 23 ALUMINUM STEPPED BACK PARAPET / ROOFTOP GUARDRAIL
- 24 CURTAIN WALL GLAZING @ CRU [REFER TO WINDOW SCHEDULE]
- 25 LED NEON BUILDING SIGN [7.7m2 MAX AREA AS PEI CITY OF VICTORIA SIGN BY-LAM NO. 14-097]. PROVIDE STEEL STUD BLOCKIN FOR SIGNAGE AS REQUIRED BY SIGNAGE MANUFACTURER
- 26 CRU CURTAIN WALL GLAZING DOOR 27 EXISTING TREE TO BE RETAINED
- (28) CURTAIN WALL 55G @ RESIDENTIAL LOBBY
- $\binom{31}{31}$  SHORT TERM BIKE PARKING ENTRY
- 32 IMAGE OF ORIGINAL BUILDING OWNERS INCORPORATED ON TO BIKE SHELTER SCREEN THROUGH SUBLIMATION OR SIMILAR METHOD
- 33 ELEVATOR SHAFT CAB BEYOND W ALUMINUM COMPOSITE PANEL CLADDING
- 34 EXPANDED MESH SCREEN W/ STEEL STRUCTURE [REFER TO STRUCTURAL] 35 6' MOOD FENCE @ PROPERTY ILNE [REFER TO LANDSCAPE]
- (36) MECHANICAL LOUVRE [REFER TO MECH]
- (37) EXPOSED CONCRETE
- (38) PICKET SCREEN [EXTEND AND DETAILS TBD]
- 39 EXPOSED CONCRETE CANOPY CENTRED OVER DOOR [REFER TO STRUCTURAL]

dys architecture



NO. | DATE | ISSUE

1 | 2023/11/17 | ISSUED FOR 50% REVIEW 2 | 2024/02/26 | ISSUED FOR 65% REVIEW 3 | 2024/02/23 | ISSUED FOR BUILDING PERMIT

4 | 2024/05/09 | RE-ISSUED FOR BUILDING PERMIT 5 | 2024/07/05 | ISSUED FOR DRAFT IFT 6 | 2024/07/13 | ISSUED FOR IFT ADDENDUM #1 7 | 2024/09/04 | ISSUED FOR PRICING

8 | 2024/09/09 | RE-ISSUED FOR IFT ADDENDUM #4 9 | 2024/10/21 | Issued for DRAFT IFC

10 | 2025/01/28 | Issued for IFC

NO. | DATE | ISSUE


**PROJECT** 

**1702 QUADRA STREET** + 862 FISGARD STREET


This drawing, as an instrument of service, is the property of dys architecture and may not be reproduced without their permission and provided always that any production carries their name. All designs and other information shown on this drawing are for use on the specified project only and shall not be used otherwise without written permission of dys architecture. Payment of all sums due to dys architecture up to the date of use of this drawing is a condition precedent to the use thereof

Written dimensions shall have precedence over scaled dimensions. Contractors shall verify and be responsible for all dimensions and conditions on the job axnd dys architecture shall be informed of any variations from the dimensions and conditions shown on the drawings. Shop drawings shall be submitted to dys architecture for review before proceeding with fabrication.

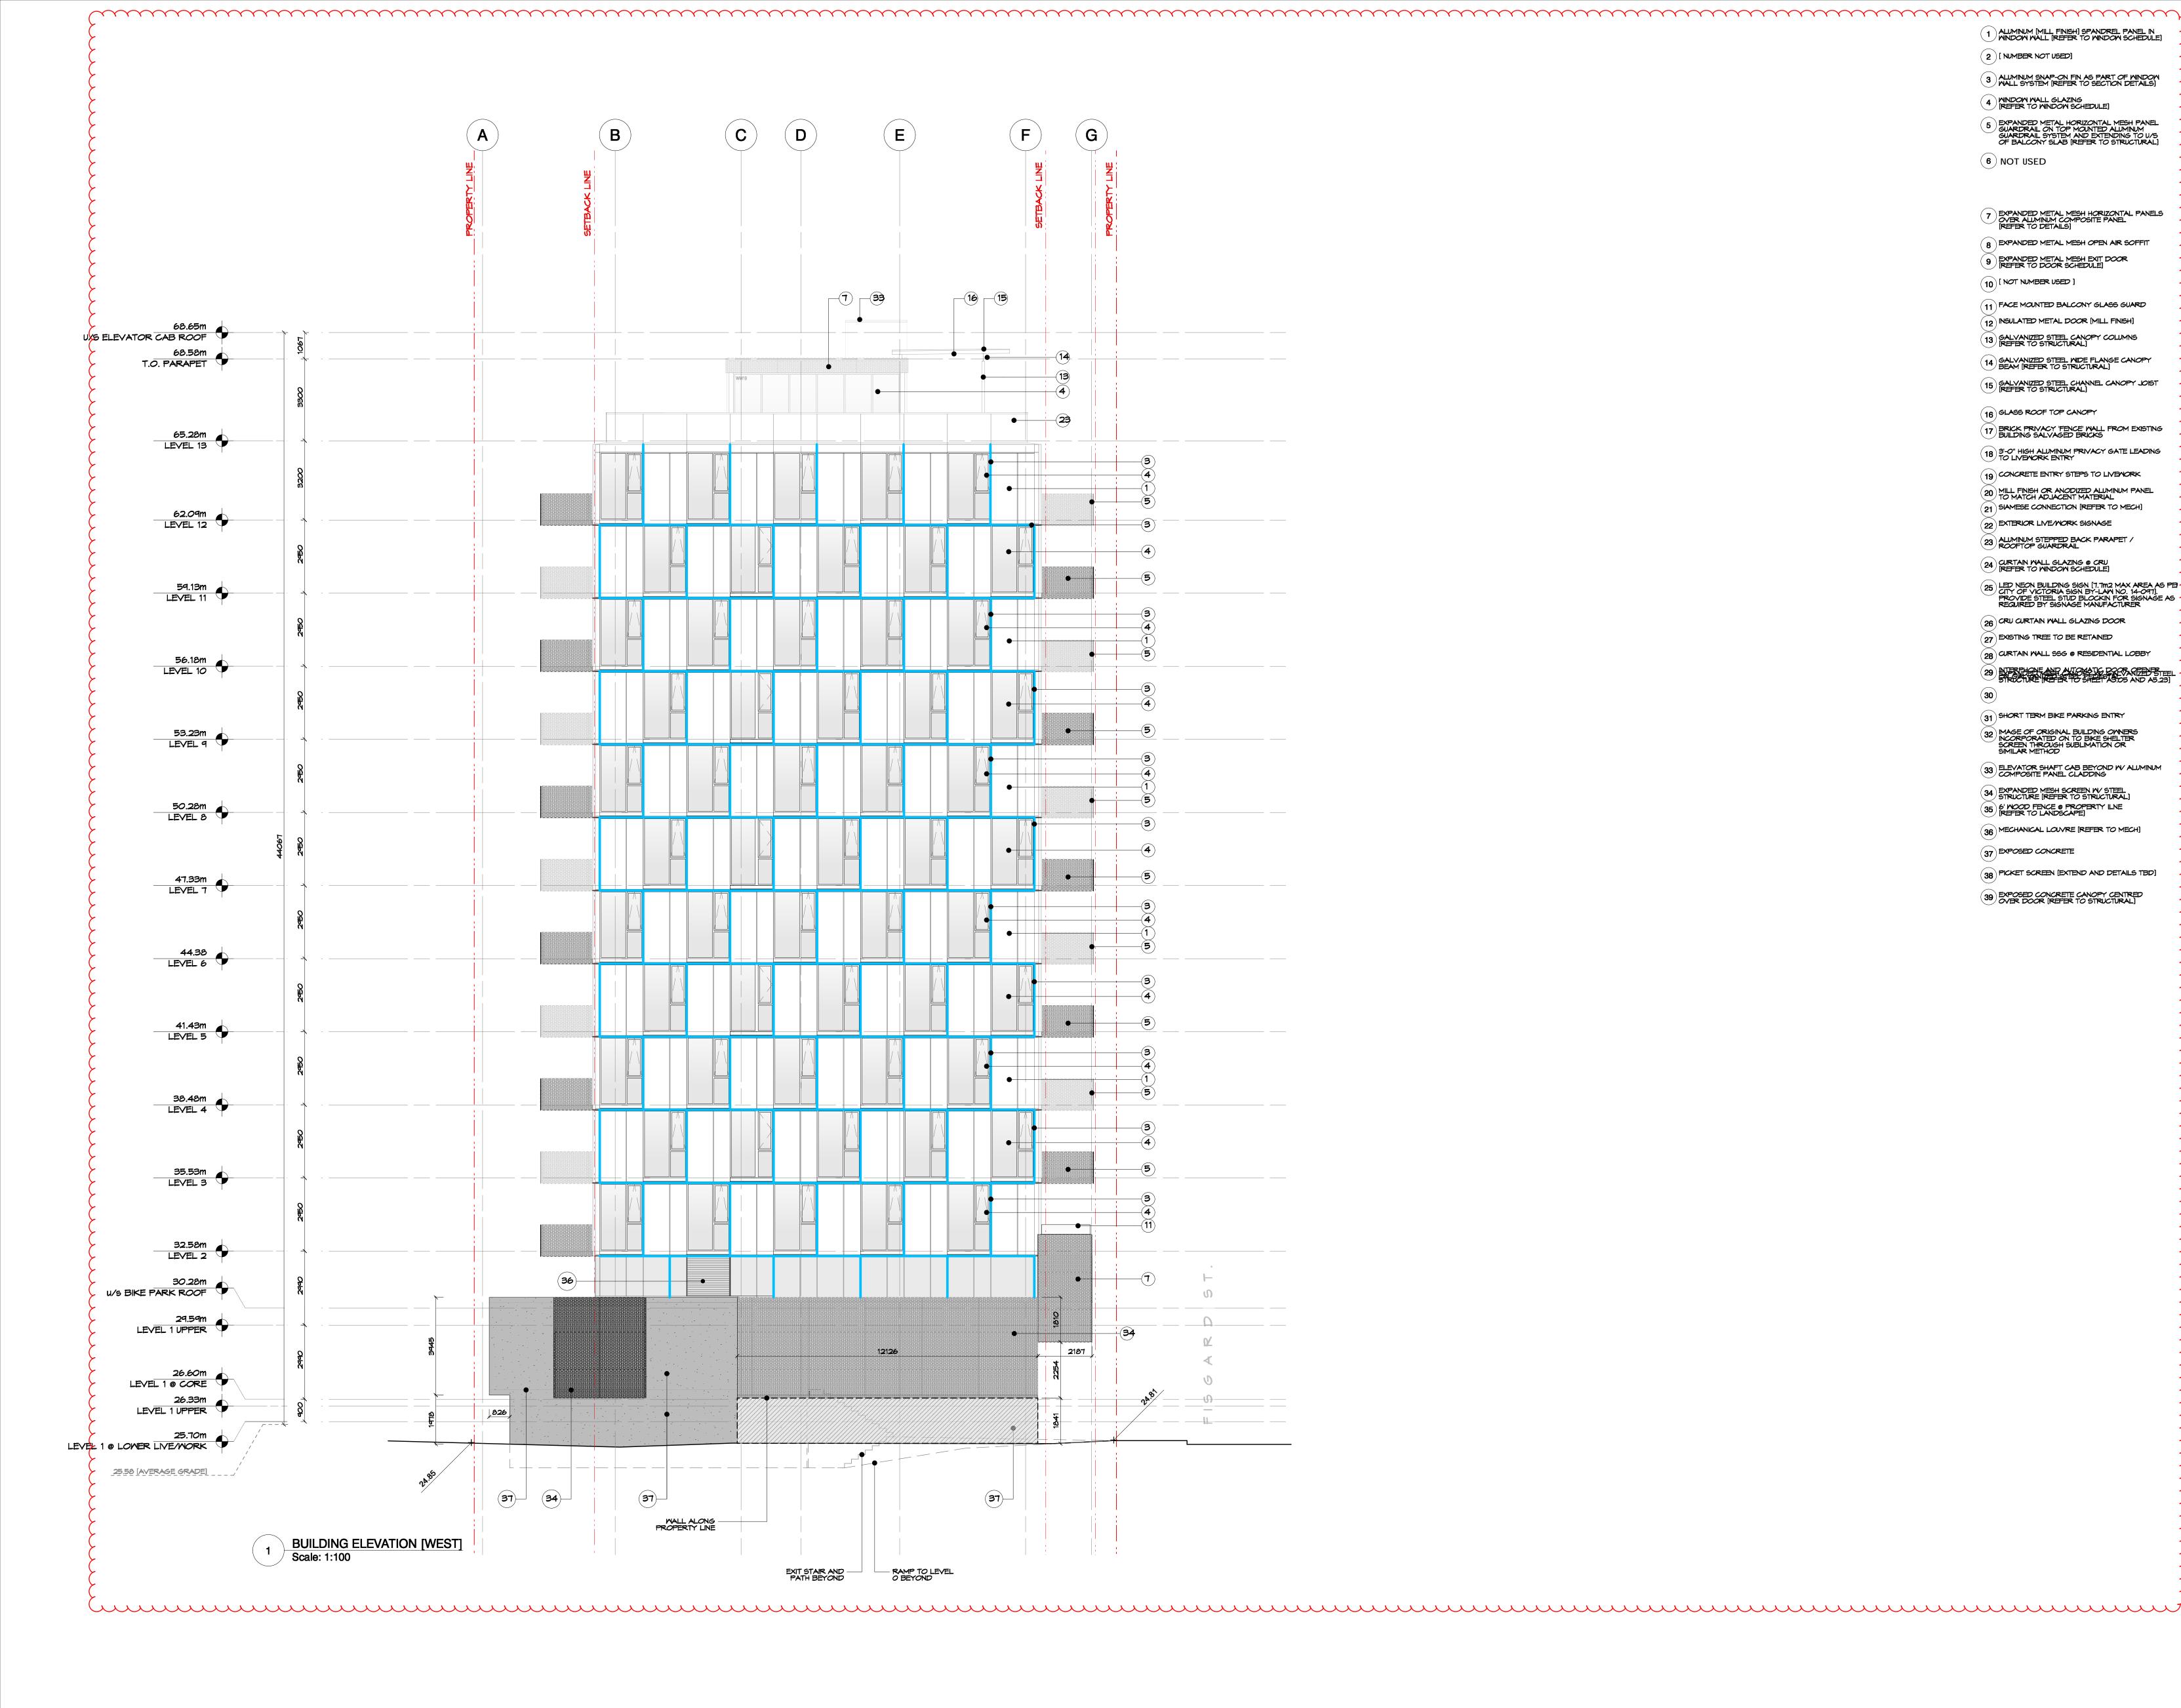

1 ALUMINUM [MILL FINISH] SPANDREL PANEL IN WINDOW WALL [REFER TO WINDOW SCHEDULE]

2 [ NUMBER NOT USED]

3 ALLMINUM SNAP-ON FIN AS PART OF MINDOM WALL SYSTEM [REFER TO SECTION DETAILS] 4 WINDOW WALL GLAZING [REFER TO WINDOW SCHEDULE]

# 5 EXPANDED METAL HORIZONTAL MESH PANEL GUARDRAIL ON TOP MOUNTED ALIMINUM GUARDRAIL SYSTEM AND EXTENDING TO U/S OF BALCONY SLAB [REFER TO STRUCTURAL]

6 NOT USED

7 EXPANDED METAL MESH HORIZONTAL PANELS OVER ALIMINUM COMPOSITE PANEL [REFER TO DETAILS]

- 8 EXPANDED METAL MESH OPEN AIR SOFFIT
- 9 EXPANDED METAL MESH EXIT DOOR [REFER TO DOOR SCHEDULE]
- (10) [ NOT NUMBER USED ]
- 11 FACE MOUNTED BALCONY GLASS GUARD 12 INSULATED METAL DOOR [MILL FINISH]
- (13) GALVANIZED STEEL CANOPY COLUMNS [REFER TO STRUCTURAL]
- 14) GALVANIZED STEEL MIDE FLANGE CANOPY BEAM [REFER TO STRUCTURAL] (15) GALVANIZED STEEL CHANNEL CANOPY JOIST [REFER TO STRUCTURAL]
- (16) GLASS ROOF TOP CANOPY
- 17 BRICK PRIVACY FENCE WALL FROM EXISTING BUILDING SALVAGED BRICKS
- 18 3'-0" HIGH ALLMINUM PRIVACY GATE LEADING TO LIVENORK ENTRY
- 19 CONCRETE ENTRY STEPS TO LIVEWORK
- 20 MILL FINISH OR ANODIZED ALUMINUM PANEL TO MATCH ADJACENT MATERIAL 21 SIAMESE CONNECTION [REFER TO MECH]
- 22 EXTERIOR LIVE/WORK SIGNAGE
- 23 ALUMINUM STEPPED BACK PARAPET / ROOFTOP GUARDRAIL
- 24 CURTAIN WALL GLAZING @ CRU [REFER TO WINDOW SCHEDULE]
- 25 LED NEON BUILDING SIGN [7.7m2 MAX AREA AS PEI CITY OF VICTORIA SIGN BY-LAW NO. 14-09T].
  PROVIDE STEEL STUD BLOCKIN FOR SIGNAGE AS REQUIRED BY SIGNAGE MANUFACTURER
- 26 CRU CURTAIN MALL GLAZING DOOR 27 EXISTING TREE TO BE RETAINED
- (28) CURTAIN MALL SSG @ RESIDENTIAL LOBBY
- (31) SHORT TERM BIKE PARKING ENTRY

# 32 IMAGE OF ORIGINAL BUILDING OWNERS INCORPORATED ON TO BIKE SHELTER SCREEN THROUGH SUBLIMATION OR SIMILAR METHOD

- 33 ELEVATOR SHAFT CAB BEYOND W ALUMINUM COMPOSITE PANEL CLADDING
- 34 EXPANDED MESH SCREEN W/ STEEL STRUCTURE [REFER TO STRUCTURAL] 35 6' MOOD FENCE @ PROPERTY ILNE [REFER TO LANDSCAPE]
- (36) MECHANICAL LOUVRE [REFER TO MECH]
- (37) EXPOSED CONCRETE
- 38 PICKET SCREEN [EXTEND AND DETAILS TBD]
- 39 EXPOSED CONCRETE CANOPY CENTRED OVER DOOR [REFER TO STRUCTURAL]

dys architecture 260 - 1770 Burrard Street Vancouver BC V6J 3G7



NO. | DATE | ISSUE

1 | 2023/11/17 | ISSUED FOR 50% REVIEW 2 | 2024/02/26 | ISSUED FOR 65% REVIEW

3 | 2024/02/23 | ISSUED FOR BUILDING PERMIT 4 | 2024/05/09 | RE-ISSUED FOR BUILDING PERMIT 5 | 2024/07/05 | ISSUED FOR DRAFT IFT 6 | 2024/07/13 | ISSUED FOR IFT ADDENDUM #1

7 | 2024/09/04 | ISSUED FOR PRICING 8 | 2024/09/09 | RE-ISSUED FOR IFT ADDENDUM #4 9 | 2024/10/21 | Issued for DRAFT IFC

10 | 2025/01/28 | Issued for IFC

NO. | DATE | ISSUE



**PROJECT** 

**1702 QUADRA STREET** + 862 FISGARD STREET


# **BUILDING ELEVATIONS** [WEST]


This drawing, as an instrument of service, is the property of **dys** architecture and may not be reproduced without their permission and provided always that any production carries their name. All designs and other information shown on this drawing are for use on the specified project only and shall not be used otherwise without written permission of **dys** architecture. Payment of all sums due to **dys** architecture up to the date of use of this drawing is a condition precedent to the use thereof


Written dimensions shall have precedence over scaled dimensions. Contractors shall verify and be responsible for all dimensions and conditions on the job axnd dys architecture shall be informed of any variations from the dimensions and conditions shown on the drawings. Shop drawings shall be submitted to dys architecture for review before proceeding with fabrication.


ELEVATION @ LEVEL 13/ROOFTOP [NORTH]

Scale: 1:100

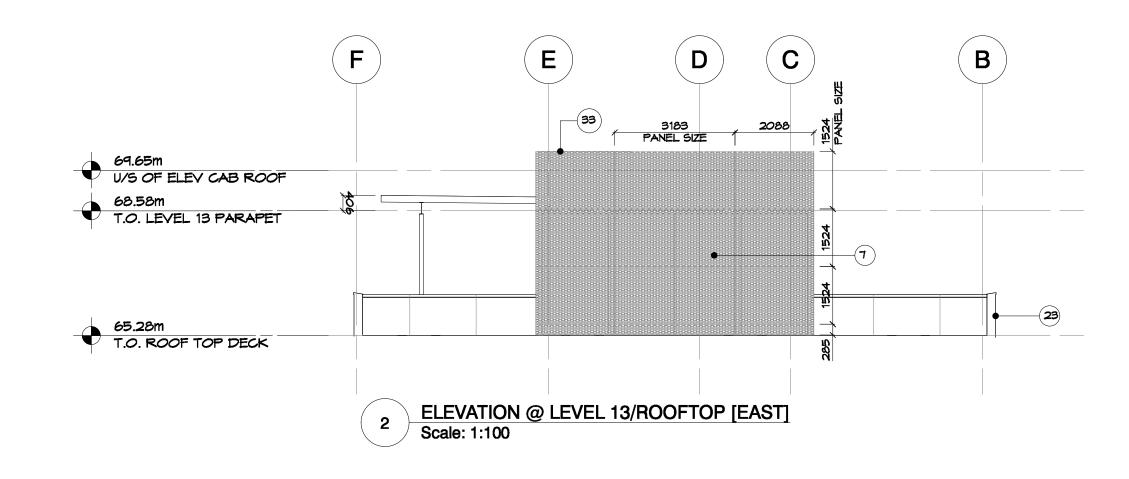

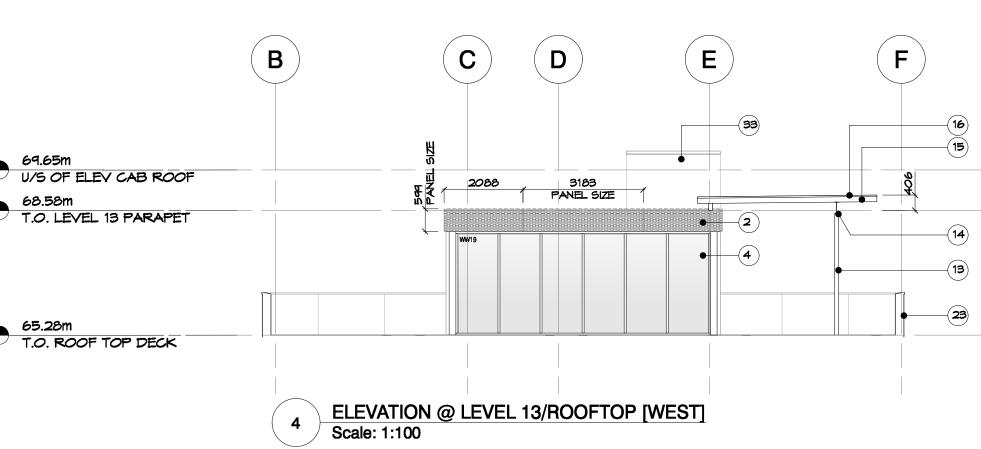

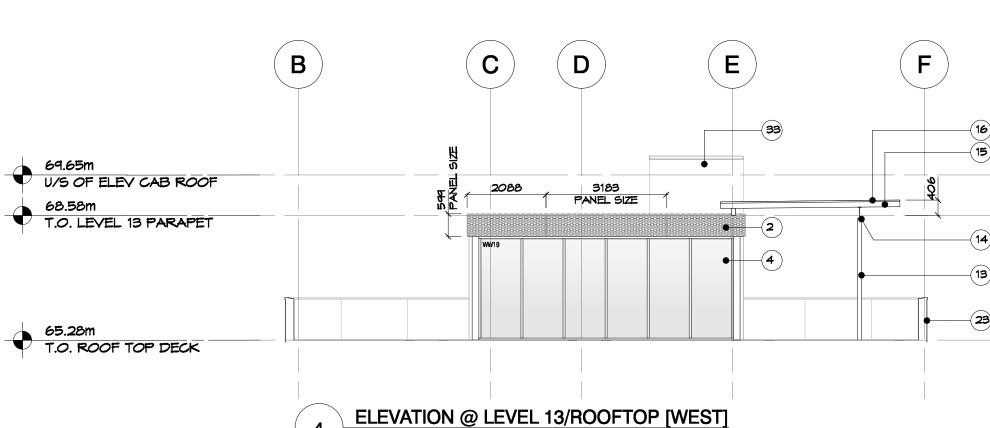

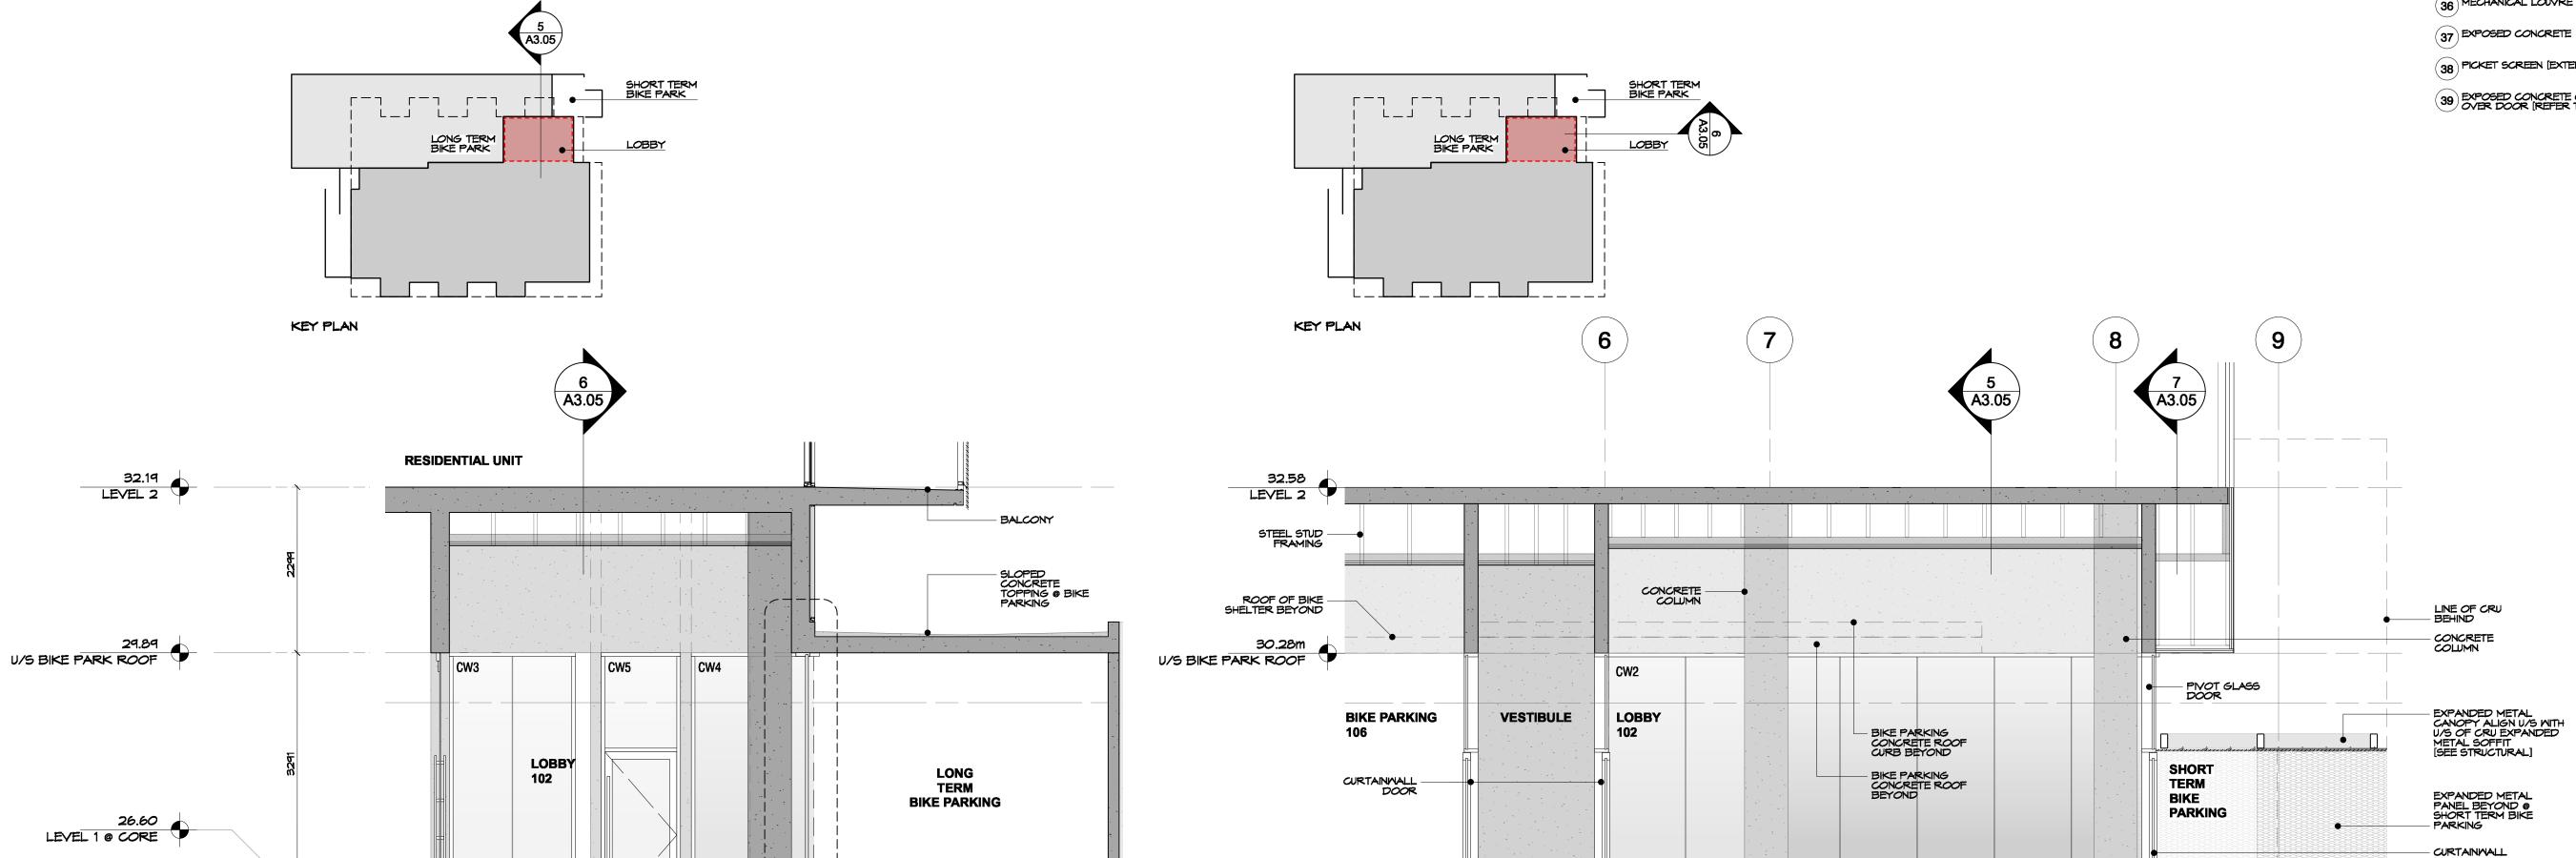

26.60m LEVEL 1 @ CORE

1/A5.20

5 PARTIAL SECTION
Scale: 1:50

6 PARTIAL SECTION
Scale: 1:50

1 ALUMINUM [MILL FINISH] SPANDREL PANEL IN MINDOM WALL [REFER TO MINDOM SCHEDULE] 2 [ NUMBER NOT USED]

3 ALLMINUM SNAP-ON FIN AS PART OF MINDOW WALL SYSTEM [REFER TO SECTION DETAILS] 4 WINDOW WALL GLAZING [REFER TO WINDOW SCHEDULE]

5 EXPANDED METAL HORIZONTAL MESH PANEL GUARDRAIL ON TOP MOUNTED ALIMINUM GUARDRAIL SYSTEM AND EXTENDING TO U/S OF BALCONY SLAB [REFER TO STRUCTURAL]

6 NOT USED

7 EXPANDED METAL MESH HORIZONTAL PANELS OVER ALIMINUM COMPOSITE PANEL [REFER TO DETAILS]

8 EXPANDED METAL MESH OPEN AIR SOFFIT

9 EXPANDED METAL MESH EXIT DOOR [REFER TO DOOR SCHEDULE] (10) [ NOT NUMBER USED ]

11 FACE MOUNTED BALCONY GLASS GUARD

12 INSULATED METAL DOOR [MILL FINISH] (13) GALVANIZED STEEL CANOPY COLUMNS [REFER TO STRUCTURAL]

14) GALVANIZED STEEL MIDE FLANGE CANOPY BEAM [REFER TO STRUCTURAL] (15) GALVANIZED STEEL CHANNEL CANOPY JOIST [REFER TO STRUCTURAL]

(16) GLASS ROOF TOP CANOPY

17 BRICK PRIVACY FENCE WALL FROM EXISTING BUILDING SALVAGED BRICKS

18 3'-0" HIGH ALUMINUM PRIVACY GATE LEADING TO LIVENORK ENTRY (19) CONCRETE ENTRY STEPS TO LIVEWORK

20 MILL FINISH OR ANODIZED ALUMINUM PANEL TO MATCH ADJACENT MATERIAL 21 SIAMESE CONNECTION [REFER TO MECH]

22 EXTERIOR LIVE/WORK SIGNAGE 23 ALUMINUM STEPPED BACK PARAPET / ROOFTOP GUARDRAIL

24 CURTAIN WALL GLAZING @ CRU [REFER TO WINDOW SCHEDULE]

25 LED NEON BUILDING SIGN [7.7m2 MAX AREA AS PEI CITY OF VICTORIA SIGN BY-LAW NO. 14-091]. PROVIDE STEEL STUD BLOCKIN FOR SIGNAGE AS REQUIRED BY SIGNAGE MANUFACTURER

26 CRU CURTAIN WALL GLAZING DOOR 27 EXISTING TREE TO BE RETAINED

28 CURTAIN WALL SSG @ RESIDENTIAL LOBBY 29 STRUCTURE (REFER TO SHEET AS 05 AND A5.23)

31) SHORT TERM BIKE PARKING ENTRY

32 IMAGE OF ORIGINAL BUILDING OWNERS INCORPORATED ON TO BIKE SHELTER SCREEN THROUGH SUBLIMATION OR SIMILAR METHOD

33 ELEVATOR SHAFT CAB BEYOND W ALUMINUM COMPOSITE PANEL CLADDING

34 EXPANDED MESH SCREEN W/ STEEL STRUCTURE [REFER TO STRUCTURAL] 35 6' MOOD FENCE @ PROPERTY ILNE [REFER TO LANDSCAPE]

(36) MECHANICAL LOUVRE [REFER TO MECH]

(38) PICKET SCREEN [EXTEND AND DETAILS TBD]

39 EXPOSED CONCRETE CANOPY CENTRED OVER DOOR [REFER TO STRUCTURAL]

**dys** architecture 260 - 1770 Burrard Street Vancouver BC V6J 3G7



NO. | DATE | ISSUE

10 | 2025/01/28 | Issued for IFC

5 | 2024/07/05 | ISSUED FOR DRAFT IFT 6 | 2024/07/13 | ISSUED FOR IFT ADDENDUM #1 9 | 2024/10/21 | Issued for DRAFT IFC

NO. | DATE | ISSUE

**PROJECT** 

**1702 QUADRA STREET** + 862 FISGARD STREET

**BUILDING ELEVATIONS** (L13/R00FT0P)

This drawing, as an instrument of service, is the property of **dys** architecture and may not be reproduced without their permission and provided always that any production carries their name. All designs and other information shown on this drawing are for use on the specified project only and shall not be used otherwise without written permission of **dys** architecture. Payment of all sums due to **dys** architecture up to the date of use of this drawing is a condition precedent to the use thereof

Written dimensions shall have precedence over scaled dimensions. Contractors shall verify and be responsible for all dimensions and conditions on the job axnd dys architecture shall be informed of any variations from the dimensions and conditions shown on the drawings. Shop drawings shall be submitted to dys architecture for review before proceeding with fabrication.


the use thereof.

**PROJECT** 0650

26.33 LEVEL 1 @ CRU

65.28m

T.O. ROOF TOP DECK

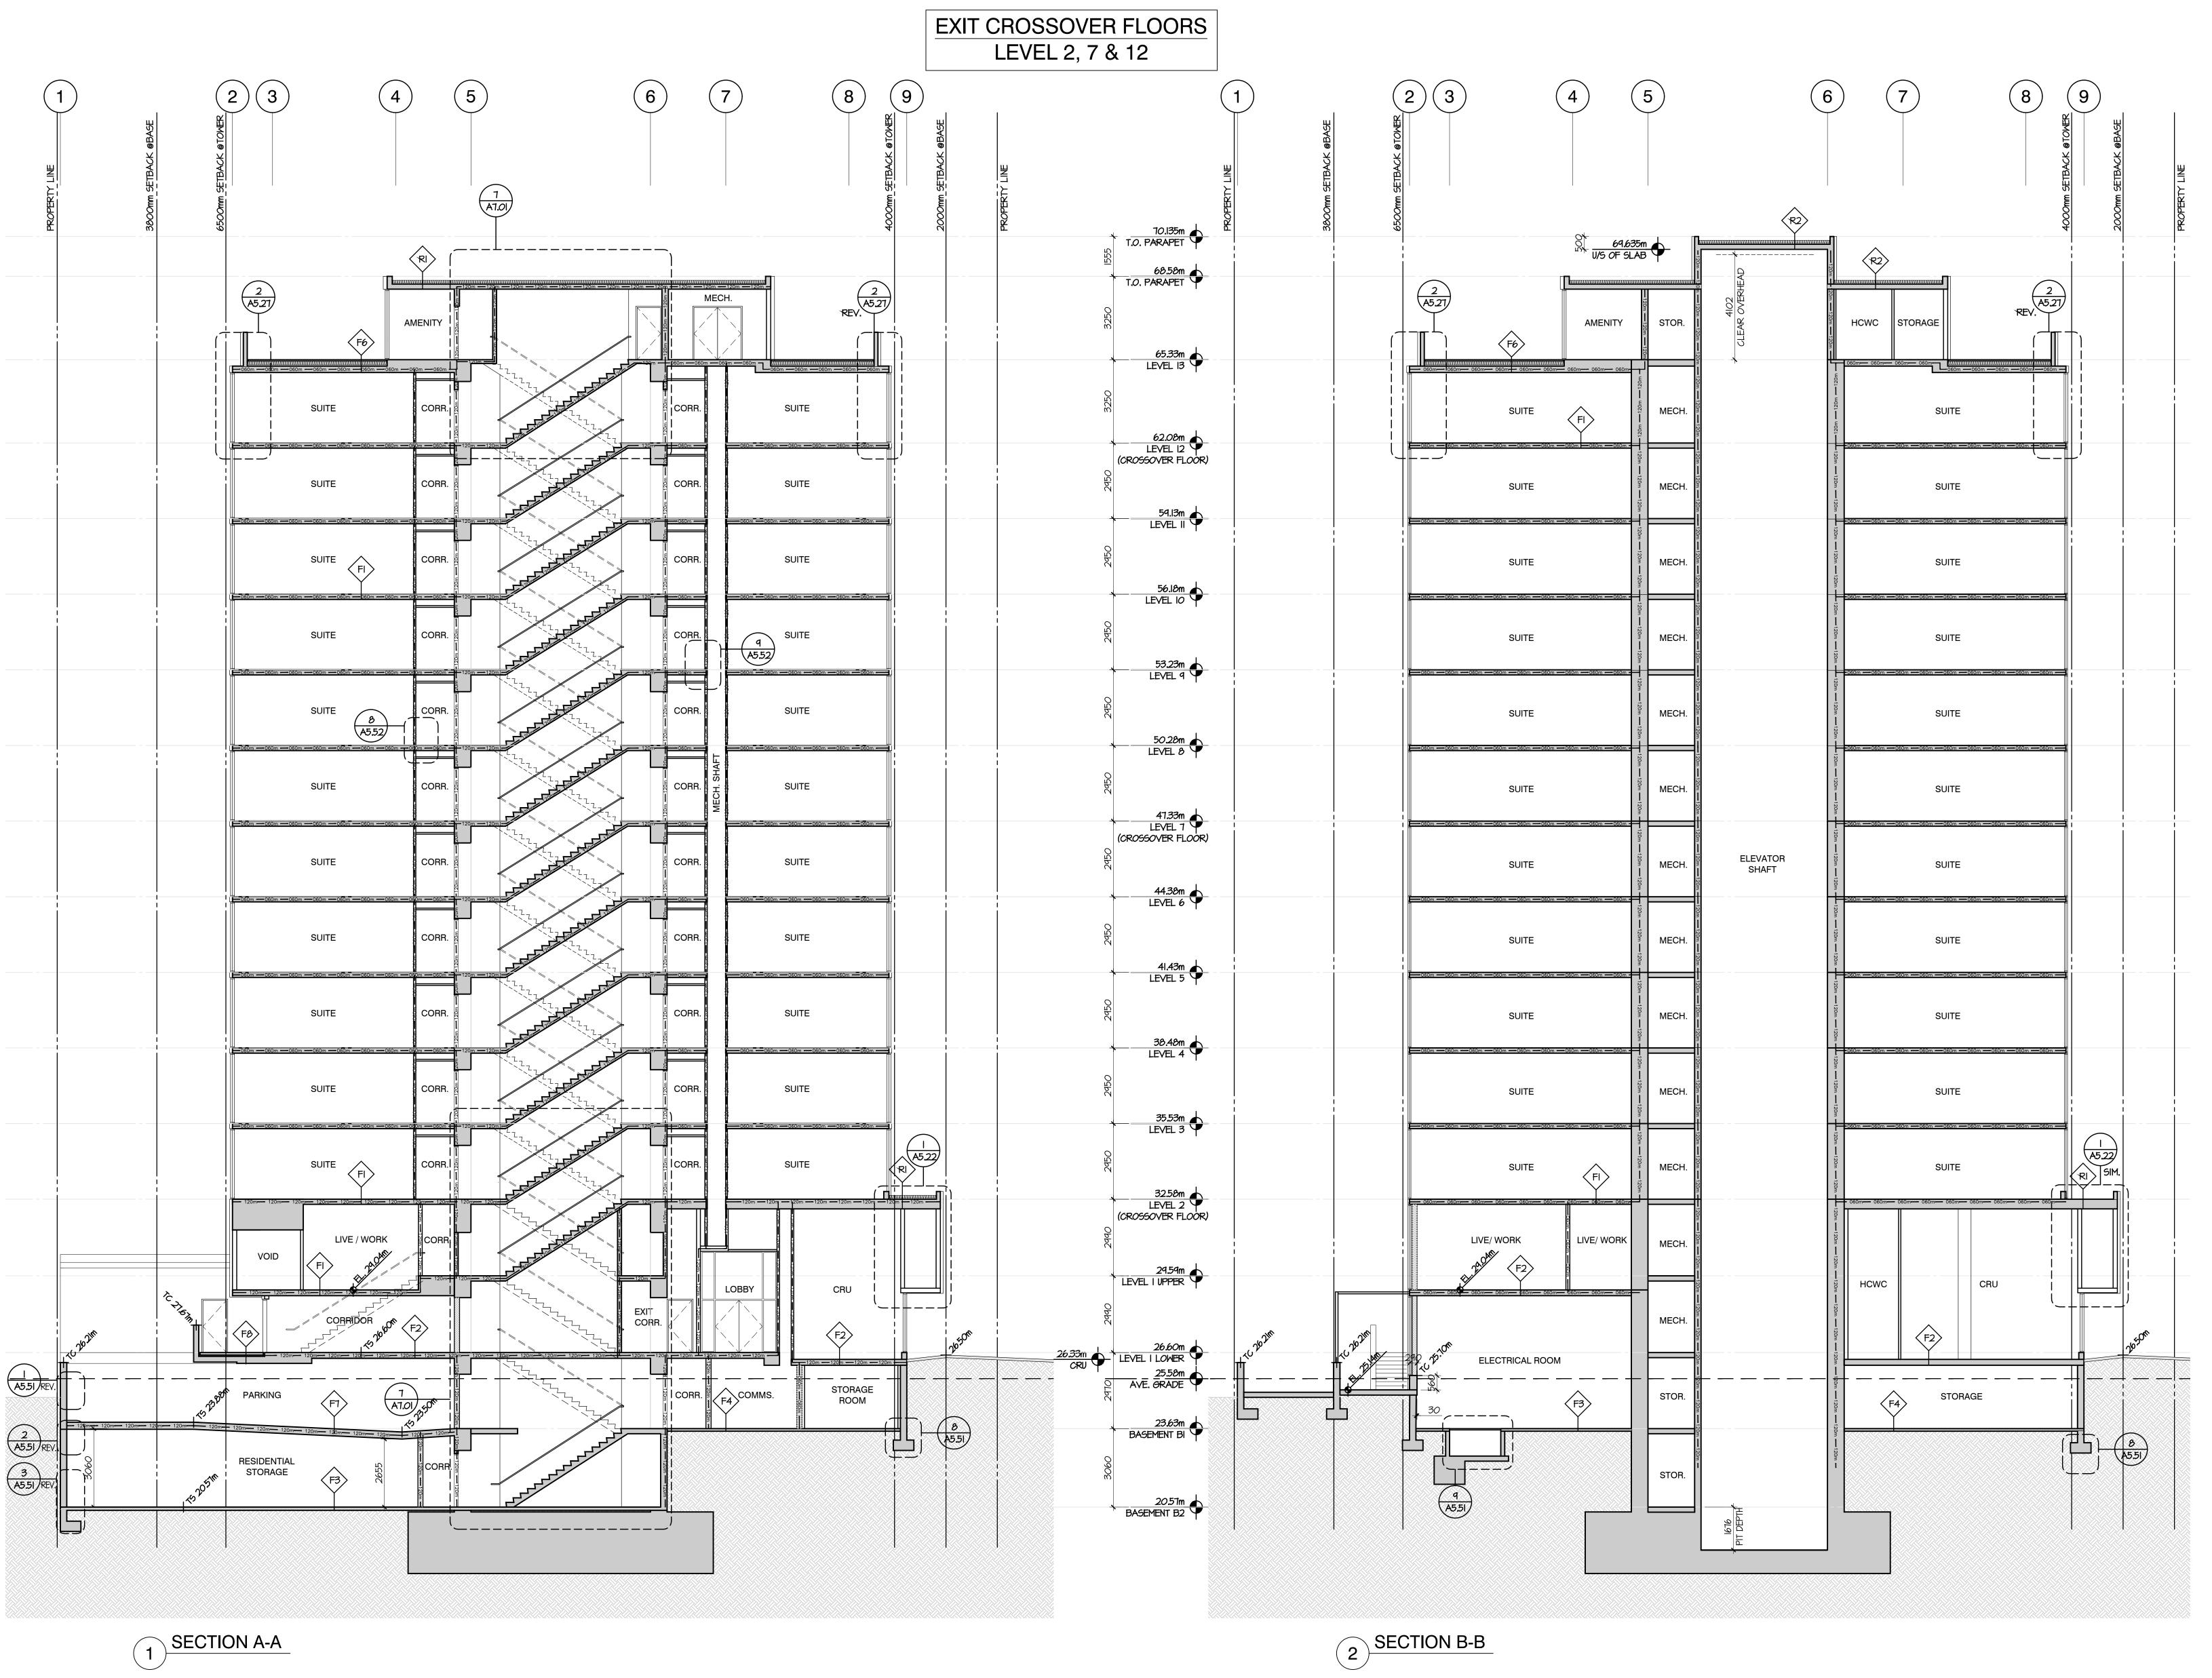

**dys** architecture


# ARYZE

3 | 2024/02/22 | ISSUED FOR BP 4 | 2024/05/09 | RE-ISSUED FOR BP

9 | 2024/10/20 | ISSUED FOR DRAFT IFC 10 | 2025/01/24 | ISSUED FOR IFC

NO. | DATE | REVISION A | 2025/04/14 | ISSUED FOR AI#05 B | 2025/06/06 | ISSUED FOR AI#12

# THE ESTOYA

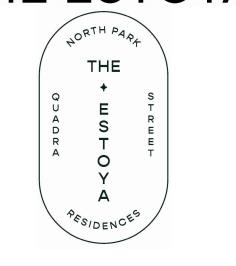



**PROJECT** 

1708 QUADRA STREET, VICTORIA, B.C.

# **BUILDING SECTIONS A & B**

This drawing, as an instrument of service, is the property of **dys** architecture and may not be reproduced without their permission and provided always that any production carries their name. All designs and other information shown on this drawing are for use on the without written permission of **dys** architecture. Payment of all sums due to **dys** architecture up to the the use thereof.


Written dimensions shall have precedence over scaled dimensions. Contractors shall verify and be responsible for all dimensions and conditions on the job and **dys** architecture shall be informed of any variations from the dimensions and conditions shown on the drawings. Shop drawings shall be submitted to dys architecture for review before proceeding with

PROJECT A223587

**DATE** AUG. 29, 2023

DRAWN DS/GL CHECKED NC

**SCALE** 1:100

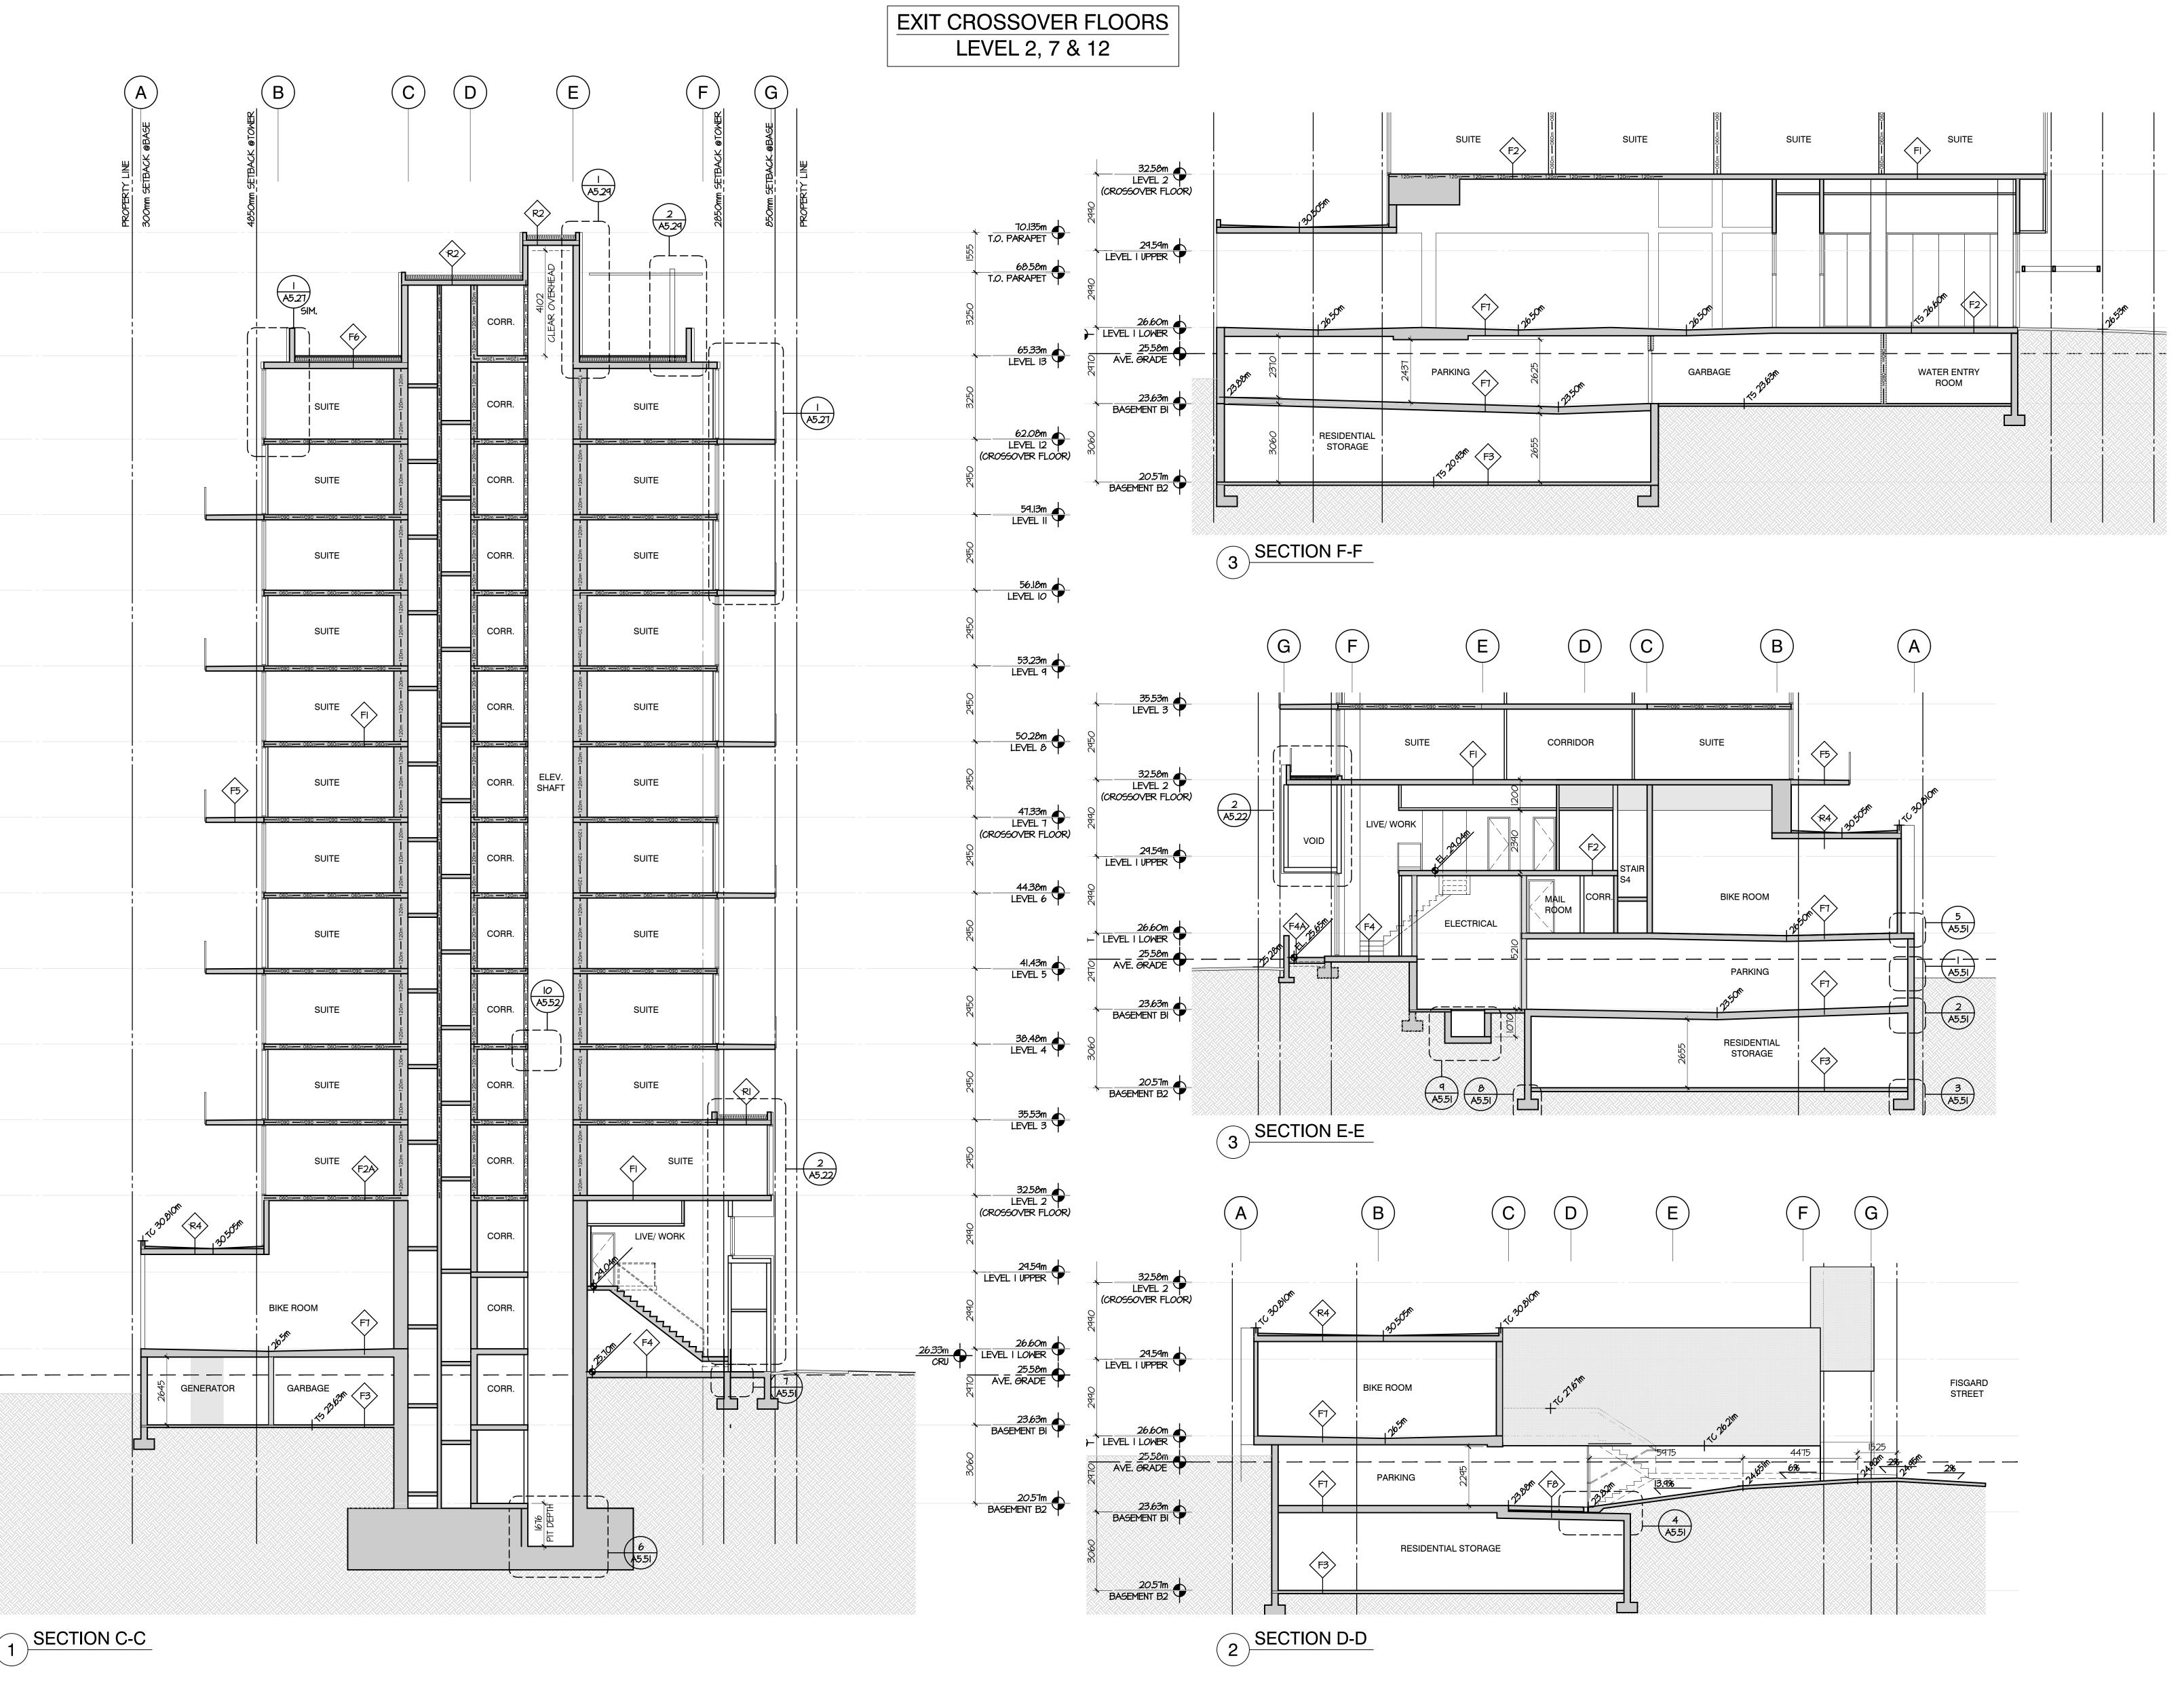

**dys** architecture

260 - 1770 Burrard Street Vancouver BC V6J 3G7 tel 604 669 7710 www.dysarchitecture.com




ARYZE

1 | 2023/11/17 | ISSUED FOR 50% REVIEW 3 | 2024/02/22 | ISSUED FOR BP 4 | 2024/05/09 | RE-ISSUED FOR BP

9 | 2024/10/20 | ISSUED FOR DRAFT IFC 10 | 2025/01/24 | ISSUED FOR IFC

NO. | DATE | REVISION A | 2025/06/06 | ISSUED FOR AI#12

THE ESTOYA

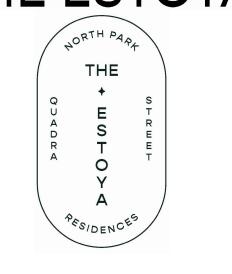



**PROJECT** 

1708 QUADRA STREET, VICTORIA, B.C.

**BUILDING SECTIONS** C, D, E & F

This drawing, as an instrument of service, is the property of **dys** architecture and may not be reproduced without their permission and provided always that any production carries their name. All designs and other information shown on this drawing are for use on the without written permission of **dys** architecture. Payment of all sums due to **dys** architecture up to the the use thereof.

Written dimensions shall have precedence over scaled dimensions. Contractors shall verify and be responsible for all dimensions and conditions on the job and **dys** architecture shall be informed of any variations from the dimensions and conditions shown on the drawings. Shop drawings shall be submitted to dys architecture for review before proceeding with

PROJECT A223587

DRAWN DS/GL CHECKED NC

### MATERIAL SPECIFICATIONS

### ON-SITE GROWING MEDIUM:

- 1. GROWING MEDIUM TESTING, MIXING, HANDLING AND PLACEMENT AS PER WRITTEN SPECIFICATIONS.
- ON SITE GROWING MEDIUM TYPE TO BE: AS PER DRAWING LEGEND.
- 3. PLANTER GROWING MEDIUM TO BE: • 50% BY VOLUME 1P GROWING MEDIUM (CLS)
  - 50% BY VOLUME Pro-Mix HP Mychorrizae OR APPROVED EQUAL

### OFF-SITE GROWING MEDIUM:

- 1. GROWING MEDIUM TESTING, MIXING, HANDLING AND PLACEMENT TO MMCD SECTION GROWING MEDIUM.
- 2. BOULEVARD GROWING MEDIUM TO BE:
- MMCD Planting Areas Growing Medium to City of Victoria Supplementary Specifications Schedule 'B', Table 2. 3. SOIL CELL GROWING MEDIUM TO BE:

### • AS PER CITY GREEN TECHNICAL SPECIFICATION filler Soil for Citygreen Soil Cell Treepits V2.0.

1. MULCH TO BE: Mitchell Excavating Ltd. Fine Bark Mulch - fir/hemlock OR APPROVED EQUAL. HANDLING AND PLACEMENT AS PER WRITTEN SPECIFICATIONS.

- ROOT BARRIER TO BE: Deeproot 18" Universal Guide OR APPROVED EQUAL.
- INSTALL AS PER MANUFACTURER'S SPECIFICATIONS AND LANDSCAPE DETAILS.

- **GEOTEXTILE:**

- 1. FILTER FABRIC TO BE: Soprema Soprafiltre non-woven geotextile OR APPROVED EQUAL.
- COMBIGRID TO BE: TERRAFIX COMBIGRID 4040 OR APPROVED EQUAL 3. INSTALL AS PER MANUFACTURER'S SPECIFICATIONS AND LANDSCAPE DETAILS

### **SUBMITTALS**

SUBMITTALS					
SPECIFICATION SECTION	TITLE	SHOP DRAWINGS	MOCK-UP	SUBMITTALS	FOR APPROVAL
03 30 20	CONCRETE WALKS, CURBS AND GUTTERS				
03 30 53	CAST IN PLACE CONCRETE				
06 20 13	EXTERIOR ROUGH CARPENTRY	yes		yes	Shop drawings, colour and material samples
12 93 02	SITE FURNISHINGS	yes		yes	Shop drawings, colour and material samples
12 93 13	BIKE RACKS			yes	Product cutsheet
31 05 17	AGGREGATES AND GRANULAR MATERIALS				
31 22 01	GRADING AND DRAINAGE				
31 24 13	ROADWAY EXCAVATION, EMBANKMENT AND COMPACTION				
32 11 23	GRANULAR BASE				
32 14 10	MORTAR SET UNIT PAVING		yes	yes	Product cutsheet and mockup 3.0 m. paved area on-site
32 14 13	ARCHITECTURAL PAVER ON PEDESTAL		yes	yes	Product cutsheet and mockup 3.0 m. paved area on site
31 22 01	GRADING AND DRAINAGE				
32 91 21	GROWING MEDIUM			yes	Supplier name, growing medium test results
32 93 10	PLANTING OF TREES, SHRUBS AND GROUNDCOVERS		yes	yes	Nursery name, tree and shrub layout on site prior to planting
32 84 00	IRRIGATION SYSTEMS - DESIGN BUILD	yes			Record drawings, maintenance manual, tools, irrigation inspection reports during 1 year maintenance period
32 93 03	LANDSCAPE OVER STRUCTURES				
REFERENCE	STRATAVAULT STRUCTURAL CELL PITS	yes	yes	yes	Supplier shop drawings, supplier installation specifications and details, mockup of minimum 6 cells on site



# THE ESTOYA

### 1702 QUADRA STREET, VICTORIA, BC

### SHEET LIST

LO TREE REMOVAL AND PROTECTION PLAN

L1.1 SITE PLAN - GROUND FLOOR

mmm L3.1 PLANTING PLAN - GROUND FLOOR

GENERAL LANDSCAPE NOTES

1. DO NOT PROCEED IN UNCERTAINTY.

L1.2 LAYOUT PLAN - GROUND FLOOR

SCHEDULING AND STORAGE, WATERING AND IRRIGATION, TIME OF PLANTING, PLANTING, CONDITIONS FOR ACCEPTANCE, AND L2.1 SITE PLAN - ROOFTOP AMENITY INSECTS PESTS AND DISEASE CONTROL, AS PER WRITTEN SPECIFICATIONS AND LANDSCAPE DETAILS. 2. CONDITIONS FOR TOTAL PERFORMANCE AS PER WRITTEN SPECIFICATIONS. L2.2 LAYOUT PLAN - ROOFTOP AMENITY

3. IN THE EVENT OF A DISCREPANCY BETWEEN QUANTITIES LISTED ON THE PLANTING PLAN AND IN THE PLANT LIST. THE PLANTING PLAN QUANTITIES TO TAKE PRECEDENCE.

1. ALL PRODUCTS AND WORKMANSHIP, INCLUDING: PLANT MATERIAL, TRANSPORTATION, HANDLING AND PROTECTION,

### CAST IN PLACE CONCRETE:

STRUCTURAL SOIL CELLS:

PLANT MATERIAL AND PLANTING:

1. ALL CAST IN PLACE CONCRETE AND ASSOCIATED WORK AND MATERIALS AS PER WRITTEN SPECIFICATIONS; ASSOCIATED WORK INCLUDES GRADING, SUBGRADE COMPACTION, GRANULAR BASE MATERIALS AND COMPACTION.

### **UNIT PAVERS:**

1. PAVERS TO BE: AS PER DRAWING LEGEND

1. SOIL CELLS TO BE: CITY GREEN SOIL CELLS.

2. INSTALL AS PER MANUFACTURER'S SPECIFICATIONS AND LANDSCAPE DETAILS.

2. INSTALL AS PER MANUFACTURER'S SPECIFICATIONS AND LANDSCAPE DETAILS.

GENERAL:

- 2. DO NOT SCALE DRAWINGS. 3. DRAWINGS AND SPECIFICATIONS ARE TO BE READ IN CONJUNCTION WITH ALL OTHER DRAWINGS/SPECIFICATIONS IN THIS PROJECT SET. ANY DISCREPANCIES AMONG DRAWINGS, SPECIFICATIONS AND INDUSTRY BEST PRACTICES TO BE REPORTED TO THE PROJECT / CONSTRUCTION MANAGER AND THE LANDSCAPE CONSULTANT FOR DIRECTION.
- 4. ALL LANDSCAPE SPECIFICATION SECTIONS AND DRAWINGS ARE AFFECTED BY REQUIREMENTS OF DIVISION 01 SECTIONS (PROVIDED IN THE PROJECT MANUAL). 5. CONTRACTOR TO FAMILIARIZE THEMSELVES WITH ALL SITE CONDITIONS, INCLUDING THE LIMITS OF WORK AND EXISTING FEATURES TO BE PROTECTED, PRIOR TO SUBMITTING BIDS/QUOTES.
- 6. CONTRACTOR TO CONFIRM LOCATION AND ELEVATION OF ALL UNDERGROUND UTILITIES/FEATURES PRIOR TO COMMENCING WORK. 7. CONTRACTOR TO TAKE NECESSARY PRECAUTIONS TO PROTECT SITE FEATURES / CONDITIONS, WITHIN AND BEYOND THE LIMITS OF WORK EXISTING AT THE TIME OF CONSTRUCTION. ALL DISTURBED
- SURFACES, AREAS, STRUCTURES, VEGETATION, HABITAT ETC. ON PUBLIC / PRIVATE PROPERTY TO PROMPTLY BE RESTORED TO EQUAL OR BETTER CONDITION THAN EXISTING AND TO THE SATISFACTION OF THE MUNICIPALITY HAVING JURISDICTION / PROPERTY OWNER.

L4.1 HARDSCAPE DETAILS

L4.4 PLANTING DETAILS

L4.2 CUSTOM SITE FURNITURE DETAILS

L4.3 CUSTOM SITE FURNITURE DETAILS

L5.1 STRUCTURAL SOIL CELL DETAILS

L6.1 MUNICIPAL HARDSCAPE DETAILS

L6.3 MUNICIPAL LANDSCAPE DETAILS

L6.2 MUNICIPAL SITE FURNITURE DETAILS

IR01 - IRRIGATION PLANS

IRO3 - IRRIGATION DETAILS

IRO2- IRRIGATION SCHEDULES

8. CONTRACTOR TO MAINTAIN THE SITE IN A SAFE AND TIDY CONDITION AT ALL TIMES. DO NOT OBSTRUCT PEDESTRIAN OR VEHICULAR CIRCULATION. DO NOT LEAVE UNPROTECTED HOLES / PITS / OPENINGS OVERNIGHT. ALL EXCESS MATERIALS AND REFUSE TO BE REMOVED FROM THE SITE DAILY UNLESS OTHERWISE DIRECTED BY THE CONSTRUCTION MANAGER.

- ALL WORK ON MUNICIPAL PROPERTY TO CONFORM TO THE CITY OF VICTORIA DEVELOPMENT STANDARDS (AUTHORITY HAVING JURISDICTION) INCLUDING BUT NOT LIMITED TO:
- 1.1. CITY OF VICTORIA SUPPLEMENTARY SPECIFICATIONS SCHEDULE 'B' TO THE SUBDIVISION AND DEVELOPMENT SERVICING BYLAW NO. 12-042 1.2. CITY OF VICTORIA SUPPLEMENTAL DRAWINGS
- 1.3. CITY OF VICTORIA SUPPLEMENTARY SPECIFICATIONS FOR STREET TREES AND IRRIGATION, SCHEDULE C.
- 2. ALL LANDSCAPE WORK ON THE DEVELOPMENT SITE TO CONFORM TO THE CURRENT EDITION AT TIME OF ISSUE OF THE Canadian Landscape Standard (CLS), UNLESS SPECIFICALLY STATED OTHERWISE IN WRITTEN SPECIFICATIONS AND ON DRAWINGS.
- 3. ALL HARD SURFACE (INCLUDING BUT NOT LIMITED TO PAVING, CONCRETE RETAINING WALLS AND CONCRETE PLANTERS) TO CONFORM TO THE Master Municipal Construction Documents Association
- PLATINUM EDITION (MMCD) AND MMCD SUPPLEMENTAL DRAWINGS AND SPECIFICATIONS, UNLESS SPECIFICALLY STATED OTHERWISE IN WRITTEN SPECIFICATIONS AND ON DRAWINGS.
- 4. LANDSCAPE CONTRACTOR TO BE FAMILIAR WITH MUNICIPAL DEVELOPMENT STANDARDS AND BE IN POSSESSION OF THE CLS AND MMCD MANUALS AND SUPPLEMENTAL DRAWINGS AND SPECIFICATIONS.
- 5. GROWING MEDIUM AND GROWING MEDIUM TESTING AS PER WRITTEN SPECIFICATIONS.
- 6. IRRIGATION DESIGN AND INSTALLATION TO IIABC STANDARDS AND AS PER WRITTEN SPECIFICATIONS.

## COORDINATION:

1. CONTRACTOR TO COORDINATE INSTALLATION OF IRRIGATION AND ELECTRICAL SLEEVES WITH ARCHITECTURAL, MECHANICAL, ELECTRICAL AND CIVIL WORKS.

- 1. CONTRACTOR TO PROVIDE SAMPLES, TEST RESULTS AND SHOP DRAWINGS TO LANDSCAPE CONSULTANT FOR REVIEW AND APPROVAL 45 DAYS PRIOR TO INSTALLATION. 2. SEE ALSO SUBMITTALS TABLE BELOW FOR ADDITIONAL INFORMATION.

### GROWING MEDIUM TESTING:

- 1. GROWING MEDIUM TEST RESULTS ARE MANDATORY. TEST RESULTS TO INCLUDE ANALYSIS OF ALL GROWING MEDIUM NUTRIENTS NOTED IN WRITTEN SPECIFICATIONS AND ARE TO BE REPORTED IN THE SAME UNITS AS NOTED IN THAT SECTION.
- 3. TEST RESULTS TO INCLUDE ANALYSIS OF SOIL TEXTURE, ORGANIC CONTENT AND ACIDITY AS PER WRITTEN SPECIFICATIONS AND BE REPORTED IN THE SAME UNITS AS NOTED IN THAT SECTION.
- 4. TEST RESULTS TO INCLUDE RECOMMENDATIONS FOR AMENDMENTS TO MEET THE REQUIREMENTS FOR EACH GROWING MEDIUM TYPE. 5. RECOMMENDED GROWING MEDIUM TESTING FACILITY: Pacific Soil Analysis Inc. 11720 Voyageur Way, Richmond, BC V6X 3G9 OR APPROVED EQUAL.

### COMPACTION TESTING:

1. COMPACTION TESTS FOR HARD SURFACE SUBGRADE, GRANULAR SUB-BASE, AND GRANULAR BASE ARE MANDATORY.

1. CONTRACTOR TO ALERT THE LANDSCAPE CONSULTANT A MINIMUM OF 3 WORKING DAYS PRIOR TO REQUIRED LANDSCAPE INSPECTIONS.

1. REQUESTS FOR SUBSTITUTIONS TO CONFORM TO THE DIVISION 01 SECTION AND BE SUBMITTED TO THE LANDSCAPE CONSULTANT, THROUGH THE PROJECT ADMINISTRATOR, A MINIMUM OF 45 DAYS PRIOR TO SCHEDULED WORK.

### 2. PLEASE NOTE THAT SOME SUBSTITUTIONS MAY REQUIRE MUNICIPAL APPROVAL.

1. CONTRACTOR SHALL WARRANTY ALL WORKMANSHIP AND MATERIALS FOR 1 FULL YEAR FOLLOWING THE DATE OF TOTAL PERFORMANCE AS PER MMCD UNLESS SPECIFICALLY NOTED OTHERWISE. FAULTY MATERIALS AND WORKMANSHIP SHALL BE PROMPTLY REPAIRED / REPLACED TO THE SATISFACTION OF THE LANDSCAPE CONSULTANT.

1. CONTRACTOR TO INSTALL AND MAINTAIN SEDIMENTATION FILTRATION MEASURES AS REQUIRED FOR LANDSCAPE WORKS TO PREVENT MATERIALS FROM LEAVING THE SITE AND / OR ENTERING STORM DRAINS; STOCKPILED LANDSCAPE MATERIALS ARE TO BE KEPT TARPED.


### **IRRIGATION**

- 1. IT IS THE INTENTION OF THE PROJECT THAT THE LANDSCAPE CONTRACTOR FURNISH A FUNCTIONAL AUTOMATIC IRRIGATION SYSTEM TO ALL ON-SITE AND OFF SITE LANDSCAPE AREAS AS
- DESCRIBED ON THE LANDSCAPE DRAWINGS AND IN THIS SECTION. 2. SEE IRRIGATION DRAWINGS.
- 3. THE SCOPE OF WORK INCLUDES SUPPLY AND INSTALLATION OF BACKFLOW PREVENTER, CONTROLLER, ALL IRRIGATION COMPONENTS, IRRIGATION SLEEVES, 1 YEAR MAINTENANCE/WARRANTY
- (SEE WRITTEN SPECIFICATIONS AND REQUIREMENTS BELOW) AND AN OPERATION MANUAL. 4. THE IRRIGATION CONTRACTOR SHALL COORDINATE WITH THE GENERAL CONTRACTOR AND ELECTRICAL CONTRACTOR FOR THE INSTALLATION OF IRRIGATION SLEEVES.

- 5. UPON COMPLETION OF IRRIGATION INSTALLATION, CONTRACTOR TO SUBMIT AS-CONSTRUCTED DRAWINGS, OPERATION AND MAINTENANCE MANUAL, TOOLS PROVIDED BY THE
- MANUFACTURER AND BASE IRRIGATION SCHEDULE TO IIABC STANDARDS (SECTION 10 OF CLS). 6. INSPECT AND CALIBRATE IRRIGATION SYSTEM AS PER SEASONAL REQUIREMENTS.
- 7. INSPECT GROWING MEDIUM FREQUENTLY (MINIMUM MONTHLY AND WEEKLY DURING PERIODS OF DROUGHT AND HIGH HEAT) FOR MOISTURE CONTENT AND ADJUST IRRIGATION SCHEDULE AS OFTEN AS REQUIRED TO MAINTAIN THE HEALTH OF THE PLANT MATERIAL DUE TO: RAPID DRAINAGE IN THE GROWING MEDIUM, ABSENCE OF A WATER TABLE, FINITE AMOUNT OF GROWING MEDIUM, AND EXPOSURE TO CLIMATIC CONDITIONS.
- 8. CONTRACTOR TO COORDINATE WITH THE OWNER'S MAINTENANCE REPRESENTATIVE AND TOGETHER PERFORM ONE WINTERIZATION AND ONE SPRING START-UP DURING THE ONE YEAR

## ELECTRICAL / IRRIGATION COORDINATION

- 1. ELECTRICAL CONTRACTOR TO COORDINATE WITH CONSTRUCTION MANAGER AND IRRIGATION DESIGNER / INSTALLER TO PROVIDE ELECTRICAL FOR THE OPERATION OF AN AUTOMATIC IRRIGATION SYSTEM AND CONTROLLER.
- 2. IRRIGATION CONTRACTOR TO CONFIRM PIPE SIZE FOR ELECTRICAL.

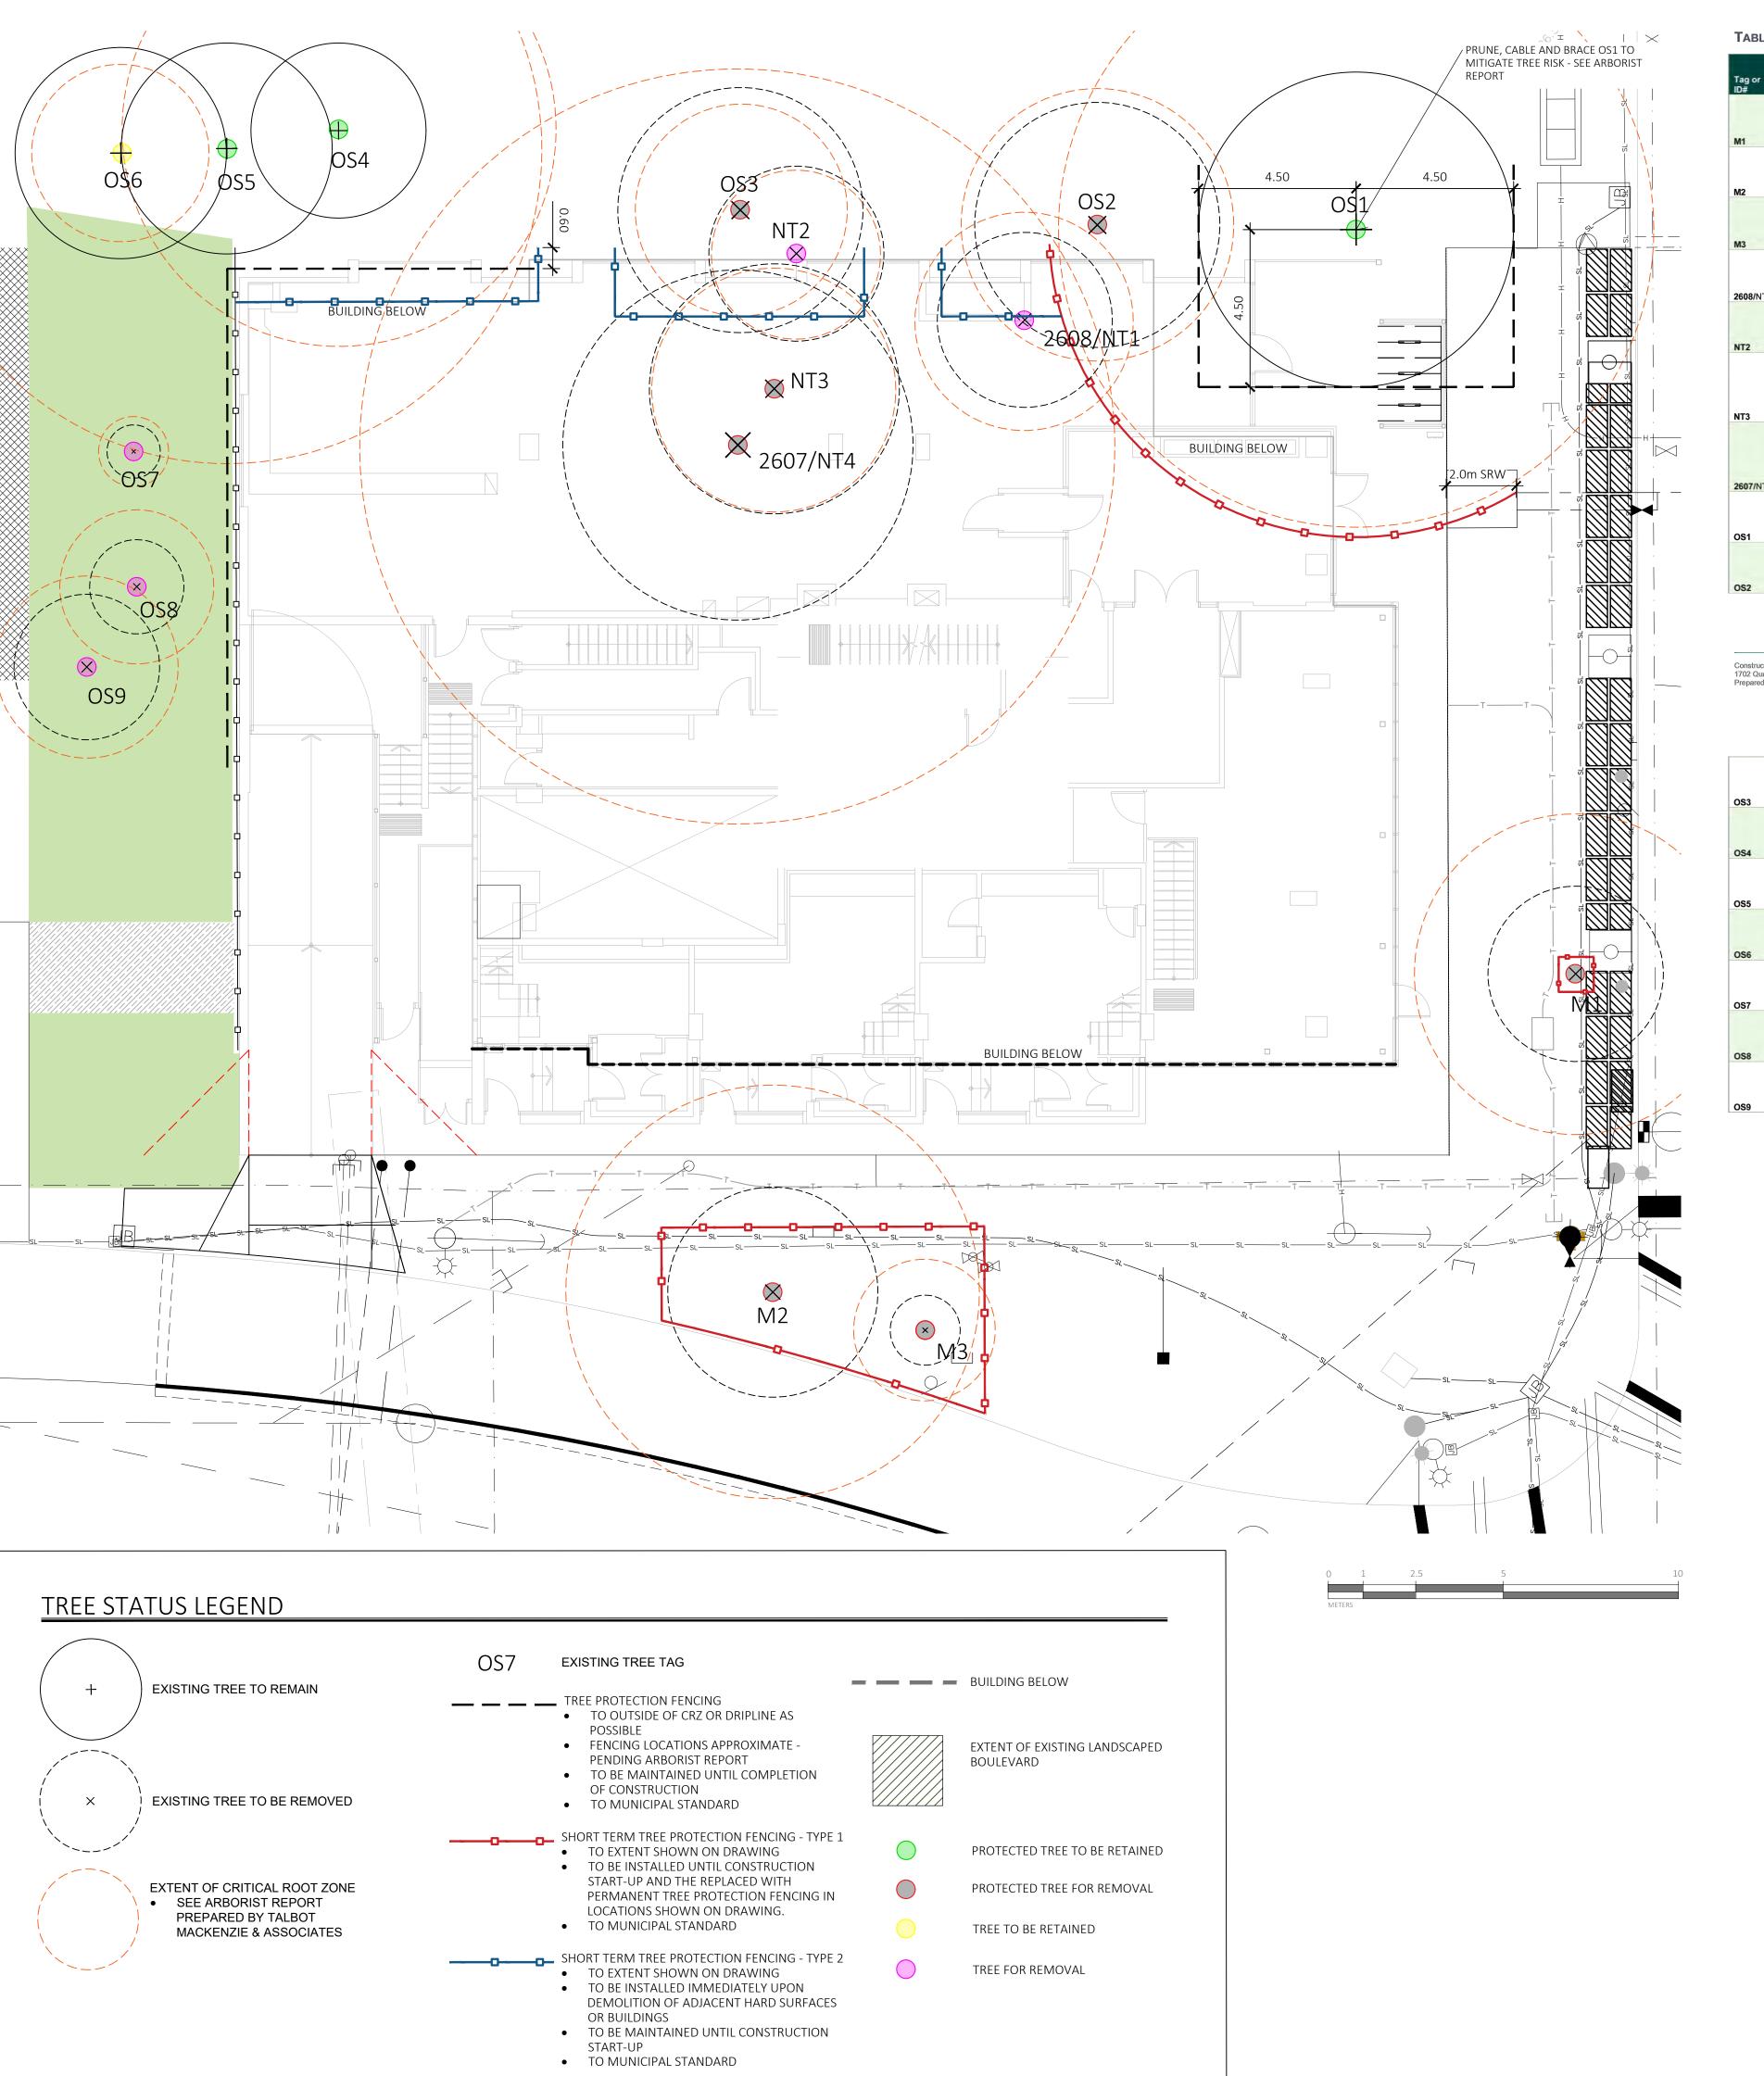

### TABLE 1. TREE INVENTORY

Location (On, Off, Byl		Bylaw	Name	Name		Critical	Dripline	Condition		Retention Suitability					
ag or D#	Surveyed? (Yes/No)	Shared, City)	protected? (Yes/No)	Common	Botanical	dbh (cm)	root zone radius (m)	diameter (m)	Health	Structural	(onsite trees)	Relative tolerance	General field observations/remarks	Tree retention / location comments	Retention status
1	Yes	Municipal	Municipal	English Oak	Quercus robur	46	4.6	5	Fair	Fair	N/A	Good	Columnar form. Clearance pruned away from building.	Conflict with proposed underground hydro.	x
2	Yes	Municipal	Municipal	Cut-leaf Beech	Fagus sylvatica 'Asplenifolia'	49 (below union)	5.9	6	Good	Fair	N/A	Poor	Measured at 1m. Hydro clearance pruned.	Conflict with proposed underground hydro.	x
				Deciduous	Stewartia										
3	Yes	Municipal	Municipal	Camellia	pseudocamellia	4	1	1	Fair	Fair	N/A	Moderate	Juvenile tree. Weedwacker damage.	Frontage improvements.	X
6 <b>08</b> /NT1	Yes	On-site	No	Pear	Pyrus spp.	26	3.1	5	Fair	Fair	Unsuitable	Moderate	Topped. Gravel parking adjacent.	Within building footprint.	x
Т2	Yes	On-site	No	Ash	Fraxinus spp.	~18,10	2.4	5	Fair	Fair-poor	Unsuitable	Good	Located between fence and storage shed. Topped, epicormic growth.	Within building footprint.	x
Т3	Yes	On-site	Yes	Ash	Fraxinus spp.	~35	3.5	7	Fair-poor	Poor	Unsuitable	Good	Located between storage shed and brick garage. Large seam up trunk, likely from past failure, decaying. Lowest limb actively failing,has been shortened, will rest on garage roof.	Within building footprint.	x
				Big-Leaf	Acer	90 (below				_			Large deadwood/decay north canopy. Pruning stubs and deadwood in primary stem, response growth lower stem. Large surface		
607/NT4	Yes	On-site	Yes	Maple	macrophyllum	unions)	10.8	10	Fair-poor	Fair-poor	Unsuitable	Moderate	roots lifting surrounding asphalt.	Within building footprint.	X
S1	Yes	Off-site	Yes	Big-Leaf Maple	Acer macrophyllum	~50,35	8.5	9	Fair	Fair	N/A	Moderate	North neighbouring property. Codominant stems, narrow attachments. Previous thinning. Located against fence.	Conflict with building footprint.	Retain
													North neighbouing property. Located against fence. Previous thinning and raising. Epicormic		
S2	Yes	Off-site	Yes	Ash	Fraxinus spp.	~30,15	3.9	7	Fair	Fair	N/A	Good	growth.	Conflict with building footprint.	X

Construction Impact Assessment and Tree Management Plan
1702 Quadra Street
Prepared for Aryze Developments
Page 4

OS3	Yes	Off-site	Yes (if estimate is correct)	Ash	Fraxinus spp.	~30	3	7	Fair	Fair	N/A	Good	North neighbouring property. Located against fence. Previously topped, epicormic growth, heavy seed crop.	Conflict with building footprint.	x
OS4	Yes	Off-site	Yes	Western Red Cedar	Thuja plicata	56	6	5	Good	Good	N/A	Poor	North neighbouring property.	Potential impacts from building footprint.	Retain*
OS5	Yes	Off-site	Yes	Western Red Cedar	Thuja plicata	60	9	6	Good	Good	N/A	Poor	North neighbouring property, active inclusion in secondary stem attachment.	Potential impacts from building footprint.	Retain*
OS6	Yes	Off-site	No	English Oak	Quercus robur	~25	2.5	6	Good	Fair	N/A	Good	North neighbouring property.	Possibly removed.	Retain
OS7	Yes	Off-site	No	Maidenhair Tree	Gingko biloba	~8	1	2	Good	Fair	N/A	Moderate	West neighbouring property.		Retain
OS8	Yes	Off-site	No	Maidenhair Tree	Gingko biloba	~18	2.2	3	Good	Fair	N/A	Moderate	West neighbouring property. Codominant top. Canopy beginning to encroach on driveway on subject property.		Retain
OS9	Yes	Off-site	No	Maidenhair Tree	Gingko biloba	~22	2.6	4	Good	Fair	N/A	Moderate	West neighbouring property. Codominant top. Canopy beginning to encroach on driveway on subject property.		Retain

### 8.4. TREE IMPACT SUMMARY TABLE

Pursuant to City of Victoria Tree Preservation Bylaw No. 21-035, the tree replacement calculations are as follows:

	Α	В	С	D	
Tree Status	Total # of	# Of Trees	# Of NEW or	# Of EXISTING	NET
	Protected	to be	REPLACEMENT	non-protected	CHANGE
	Trees	REMOVED	Trees to be	Trees Counted as	(A-B+C+D)
			Planted*	Replacements	
Onsite Trees	2	2	0	0	-2
Private Offsite Trees	5	2	2	0	0
Municipal Trees	3	3	6	N/A	3
Total	10	7	4	0	1

**Figure 2—Tree Impact Summary Table:** Based on bylaw criteria, a lot of this size (947.8m²) requires a 5-tree minimum onsite. Replacement tree/tree minimum requirements will be compensated cash-in-lieu, as there do not appear to be sufficient planting opportunities post-construction. The landscape plan shows the two (2) required Schedule E—Part 1 replacement trees for the neighbouring property at 877 North Park Street and six (6) replacement trees on the Quadra & Fisgard Street municipal boulevards.

# NOTES:

- SEE THE CONSTRUCTION IMPACT ASSESSMENT AND TREE MANAGEMENT PLAN, APPENDIX B, PREPARED BY TALMAC, FOR TREE PRESERVATION SUMMARY.
- 2607 (NT4), 2608 (NT1), NT2, AND NT3 ARE PROPOSED FOR REMOVAL AT THE DEMOLITION PHASE.
  ARBORIST SUPERVISION IS REQUIRED AS IDENTIFIED IN THE CONSTRUCTION IMPACT ASSESSMENT



1608 Camosun Street, Victoria BC V8T 3E6 Info@biophiliacollective.ca 250 590 1156

PROJECT NAME:

THE ESTOYA

VICTORIA, BC

PROJECT ADDRESS:

1702 QUADRA STREET

DESIGNED BY: BIANCA BODLEY DRAWN BY: KIM TANG

NO.	ISSUED FOR	YY\MM\DE
1	CIS PRESENTATION	12/07/2021
2	DEVELOPMENT PERMIT	12/22/2021
3	ADP MEETING	04/13/2022
4	REVISED AND RE-ISSUED FOR DP	2023/06/01
5	REVISED AND RE-ISSUED FOR DP	2023/09/21
6	REVISED AND RE-ISSUED FOR DP	2023/12/15
7	ISSUED FOR BP RESUBMISSION	2024/04/30
8	ISSUED FOR TENDER	2024/06/28
9	ISSUED FOR BP RESUBMISSION	2024/07/31
10	ISSUED FOR BP RESUBMISSION	2024/09/27
11	ISSUED FOR CONSTRUCTION	2024/10/25
12	ISSUED FOR BP RESUBMISSION	2024/12/19
13	RE-ISSUED FOR CONSTRUCTION	2025/01/22
14	RE-ISSUED FOR BP	2025/06/12
15	ISSUED FOR DDP	2025/07/22

SEAL

NORTH ARROW


DRAWING TITLE:

TREE REMOVAL & PROTECTION PLAN

DWG NO:

LO

SCALE: 1:100

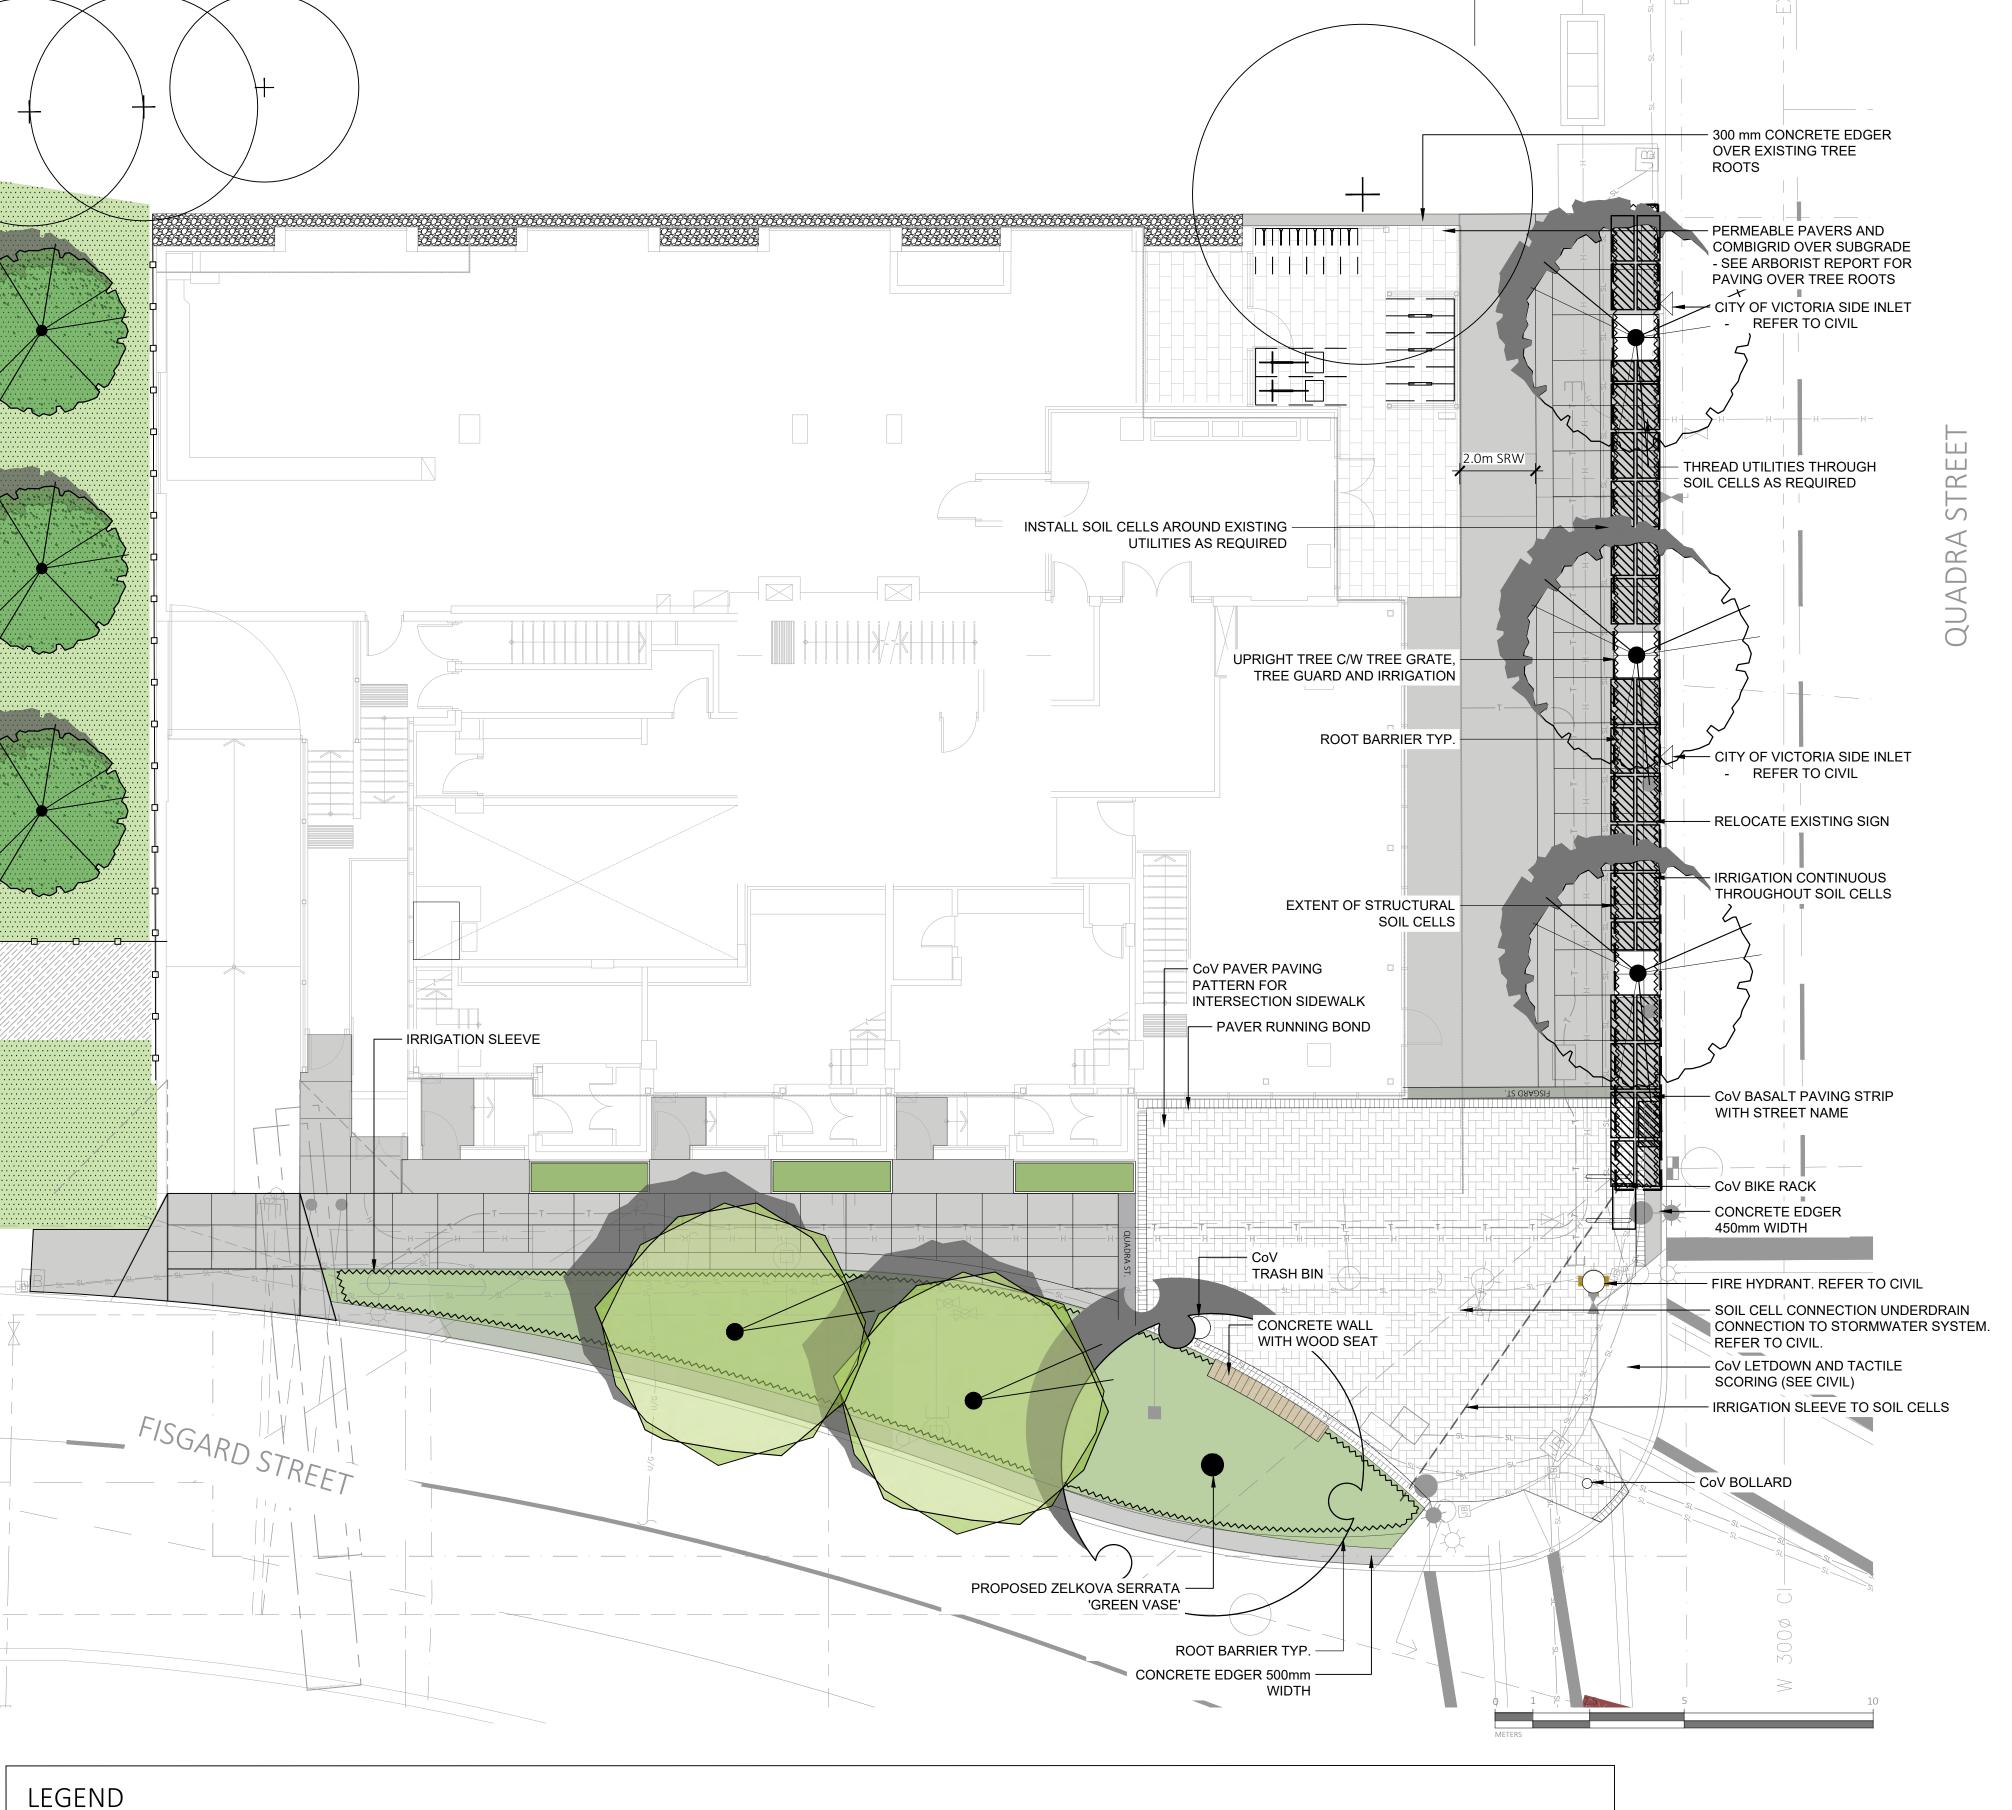

### LEGEND PROPERTY LINE CONCRETE EDGER PLANTING BED (55m<sup>2</sup>) 6' HT BLACK METAL FENCING WIDTH AND DEPTH VARIES • 700mm DEPTH 1L GROWING ALONG WEST PROPERTY LINE **— — —** SRW SEE DRAWINGS AND DETAILS MEDIUM (CLS) 2.0m WIDTH ON QUADRA STREET • 50 mm DEPTH MULCH MUNICIPAL SITE FURNITURE BASALT PAVER BANDING **LINE OF FOUNDATIONS** 450 - 500mm WIDTH - AS NOTED BOLLARD (2) MORTAR SET CONCRETE SIDEWALK ON-SITE PLANTING BED TO CITY OF VICTORIA 'NEW TOWN' DESIGN TRASH BIN (1) ACCENT PAVING 450mm DEPTH 1L GROWING GUIDELINE STANDARDS MEDIUM (BCLS) PERMEABLE PAVER ON COMBIGRID OVER SAW CUT JOINTING PATTERN BIKE RACK (2) 50 mm DEPTH MULCH SUBGRADE LIGHT BROOM FINISH BELGARD AQUALINE PERMEABLE PAVER TREE GRATE (3) COLOUR: NATURAL SIDEWALK INTERSECTION PAVING TO CITY OF VICTORIA 'NEW TOWN' DESIGN ROOT BARRIER • TREE GUARD (3) GRAVEL MAINTENANCE STRIP **GUIDELINE STANDARDS** • 300mm DEPTH RIVER ROCK ABBOTSFORD CONCRETE; NATURAL GREY ALUMINIUM EDGER PLACED ON SAND BED POLYMERIC SAND JOINTS SEAT WALL CONCRETE BASE, ARCHITECTURAL SIDEWALK STREET NAME PAVING STRUCTURAL SOIL CELLS (34.67m<sup>2</sup>) TO CITY OF VICTORIA 'NEW TOWN' DESIGN • 1400mm DEPTH SOIL CELL GROWING • CUSTOM WOOD SEAT TOP GUIDELINE STANDARDS MEDIUM

IRRIGATION

BASALT PAVING STRIP WITH STREET NAME

MORTAR SET

## IRRIGATION

- ALL AT-GRADE LANDSCAPE BEDS AND ROOFTOP PLANTERS TO BE IRRIGATED WITH AN AUTOMATIC IRRIGATION SYSTEM.
- DETAILED IRRIGATION PLAN TO BE SUBMITTED TO PARKS FOR REVIEW A MINIMUM OF 30
- DAYS PRIOR TO INSTALLATION. ALL IRRIGATION DESIGNS AND INSTALLATIONS SHALL MEET THE MINIMUM STANDARDS OF
- THE IRRIGATION INDUSTRY ASSOCIATION OF B.C. (IIABC). • SEE IRRIGATION PLANS, DETAILS AND WRITTEN SPECIFICATIONS.

- MUNICIPAL PLANTING BED AND STREET TREES TO BE IRRIGATED BY A SEPARATE SYSTEM FROM A SEPARATE CITY SOURCE CONFORMING TO THE CITY OF VICTORIA SUPPLEMENTARY SPECIFICATIONS FOR STREET TREES AND IRRIGATION SCHEDULE C TO BYLAW 12-042, SUBDIVISION BYLAW.
- IRRIGATION DESIGN DRAWINGS MUST BE SENT TO PARKS FOR REVIEW 30 DAYS PRIOR TO INSTALLATION.
- DRAWINGS SHOULD INDICATE ALL COMPONENTS, MODELS AND MATERIALS FROM WATER SUPPLY TO IRRIGATION HEADS.
- THE CITY WILL REQUIRE 4 INSPECTIONS FOR IRRIGATION INSTALLATION:
- 1)SLEEVING,
- 2) OPEN TRENCH MAINLINE AND PRESSURE TEST,
- 3) OPEN TRENCH AND LATERAL LINE,
- 4) OPERATION AND COVERAGE, AND 5) BACKFLOW PREVENTER ASSEMBLY TEST REPORT

## MUNICIPAL BOULEVARD TREES

- TREES MUST HAVE ONE DOMINANT CENTRAL LEADER OR SINGLE STRAIGHT TRUNK, 5-8 cm DIAMETER, CALIPER MEASURED 15 cm ABOVE GROUND, WELL BALANCED CROWN WITH BRANCHING STARTING AT 1.8m-2.5m ABOVE GROUND
- TREES TO BE PLANTED AS PER PLANTIG OF TREES, SHRUBS AND GROUND COVERS (32 93 01 MMCD 2009 AND CITY OF VICTORIA SUPPLEMENTAL DRAWINGS SD P3 AND SD P4) • PARKS WILL REQUIRE (3) INSPECTIONS FOR TREE PLANTING:
- 1) INSPECTION OF SOIL AND PLANTING AREA,
- 2) INSPECTION OF STOCK UPON DELIVERY, AND
- 3) INSPECTION OF INSTALLED TREE WITH MULCH AND STAKING. TRUNK FLARE MUST BE VISIBLE AND PLANTED AT OR SLIGHTLY ABOVE GRADE UPON INSPECTION
- THE APPLICANT IS RESPONSIBLE FOR PROCURING AND PLANTING THE PROPOSED
- BOULEVARD TREES.
- THE APPLICANT MUST MAINTAIN THE TREE IN GOOD HEALTH AND STRUCTURAL CONDITION FOR 1 YEAR FROM THE SUBSTANTIAL COMPLETION TO BE ELIGIBLE FOR DEPOSIT RETURN.

## PRE-CONSTRUCTION MEETING

 PARKS REQUIRES A PRE-CONSTRUCTION MEETING TO BE HELD PRIOR TO COMMENCEMENT OF CONSTRUCTING THE FRONTAGE WORKS



1608 Camosun Street, Victoria BC V8T 3E6 Info@biophiliacollective.ca 250 590 1156

PROJECT NAME:

THE ESTOYA

PROJECT ADDRESS:

1702 QUADRA STREET VICTORIA, BC

DESIGNED BY: BIANCA BODLEY DRAWN BY: KIM TANG

1	CIS PRESENTATION	12/07/202
2	DEVELOPMENT PERMIT	12/22/2021
3	ADP MEETING	04/13/2022
4	REVISED AND RE-ISSUED FOR DP	2023/06/0
5	REVISED AND RE-ISSUED FOR DP	2023/09/2
6	REVISED AND RE-ISSUED FOR DP	2023/12/1
7	ISSUED FOR BP RESUBMISSION	2024/04/30
8	ISSUED FOR TENDER	2024/06/28
9	ISSUED FOR BP RESUBMISSION	2024/07/3
10	ISSUED FOR BP RESUBMISSION	2024/09/2
11	ISSUED FOR CONSTRUCTION	2024/10/2
12	ISSUED FOR BP RESUBMISSION	2024/12/19
13	RE-ISSUED FOR CONSTRUCTION	2025/01/22
14	RE-ISSUED FOR BP	2025/06/12
15	ISSUED FOR DDP	2025/07/22

YY\MM\DD

SEAL

NO. **ISSUED FOR** 


NORTH ARROW

DRAWING TITLE:

LANDSCAPE SITE PLAN

DWG NO:

SCALE: 1:100

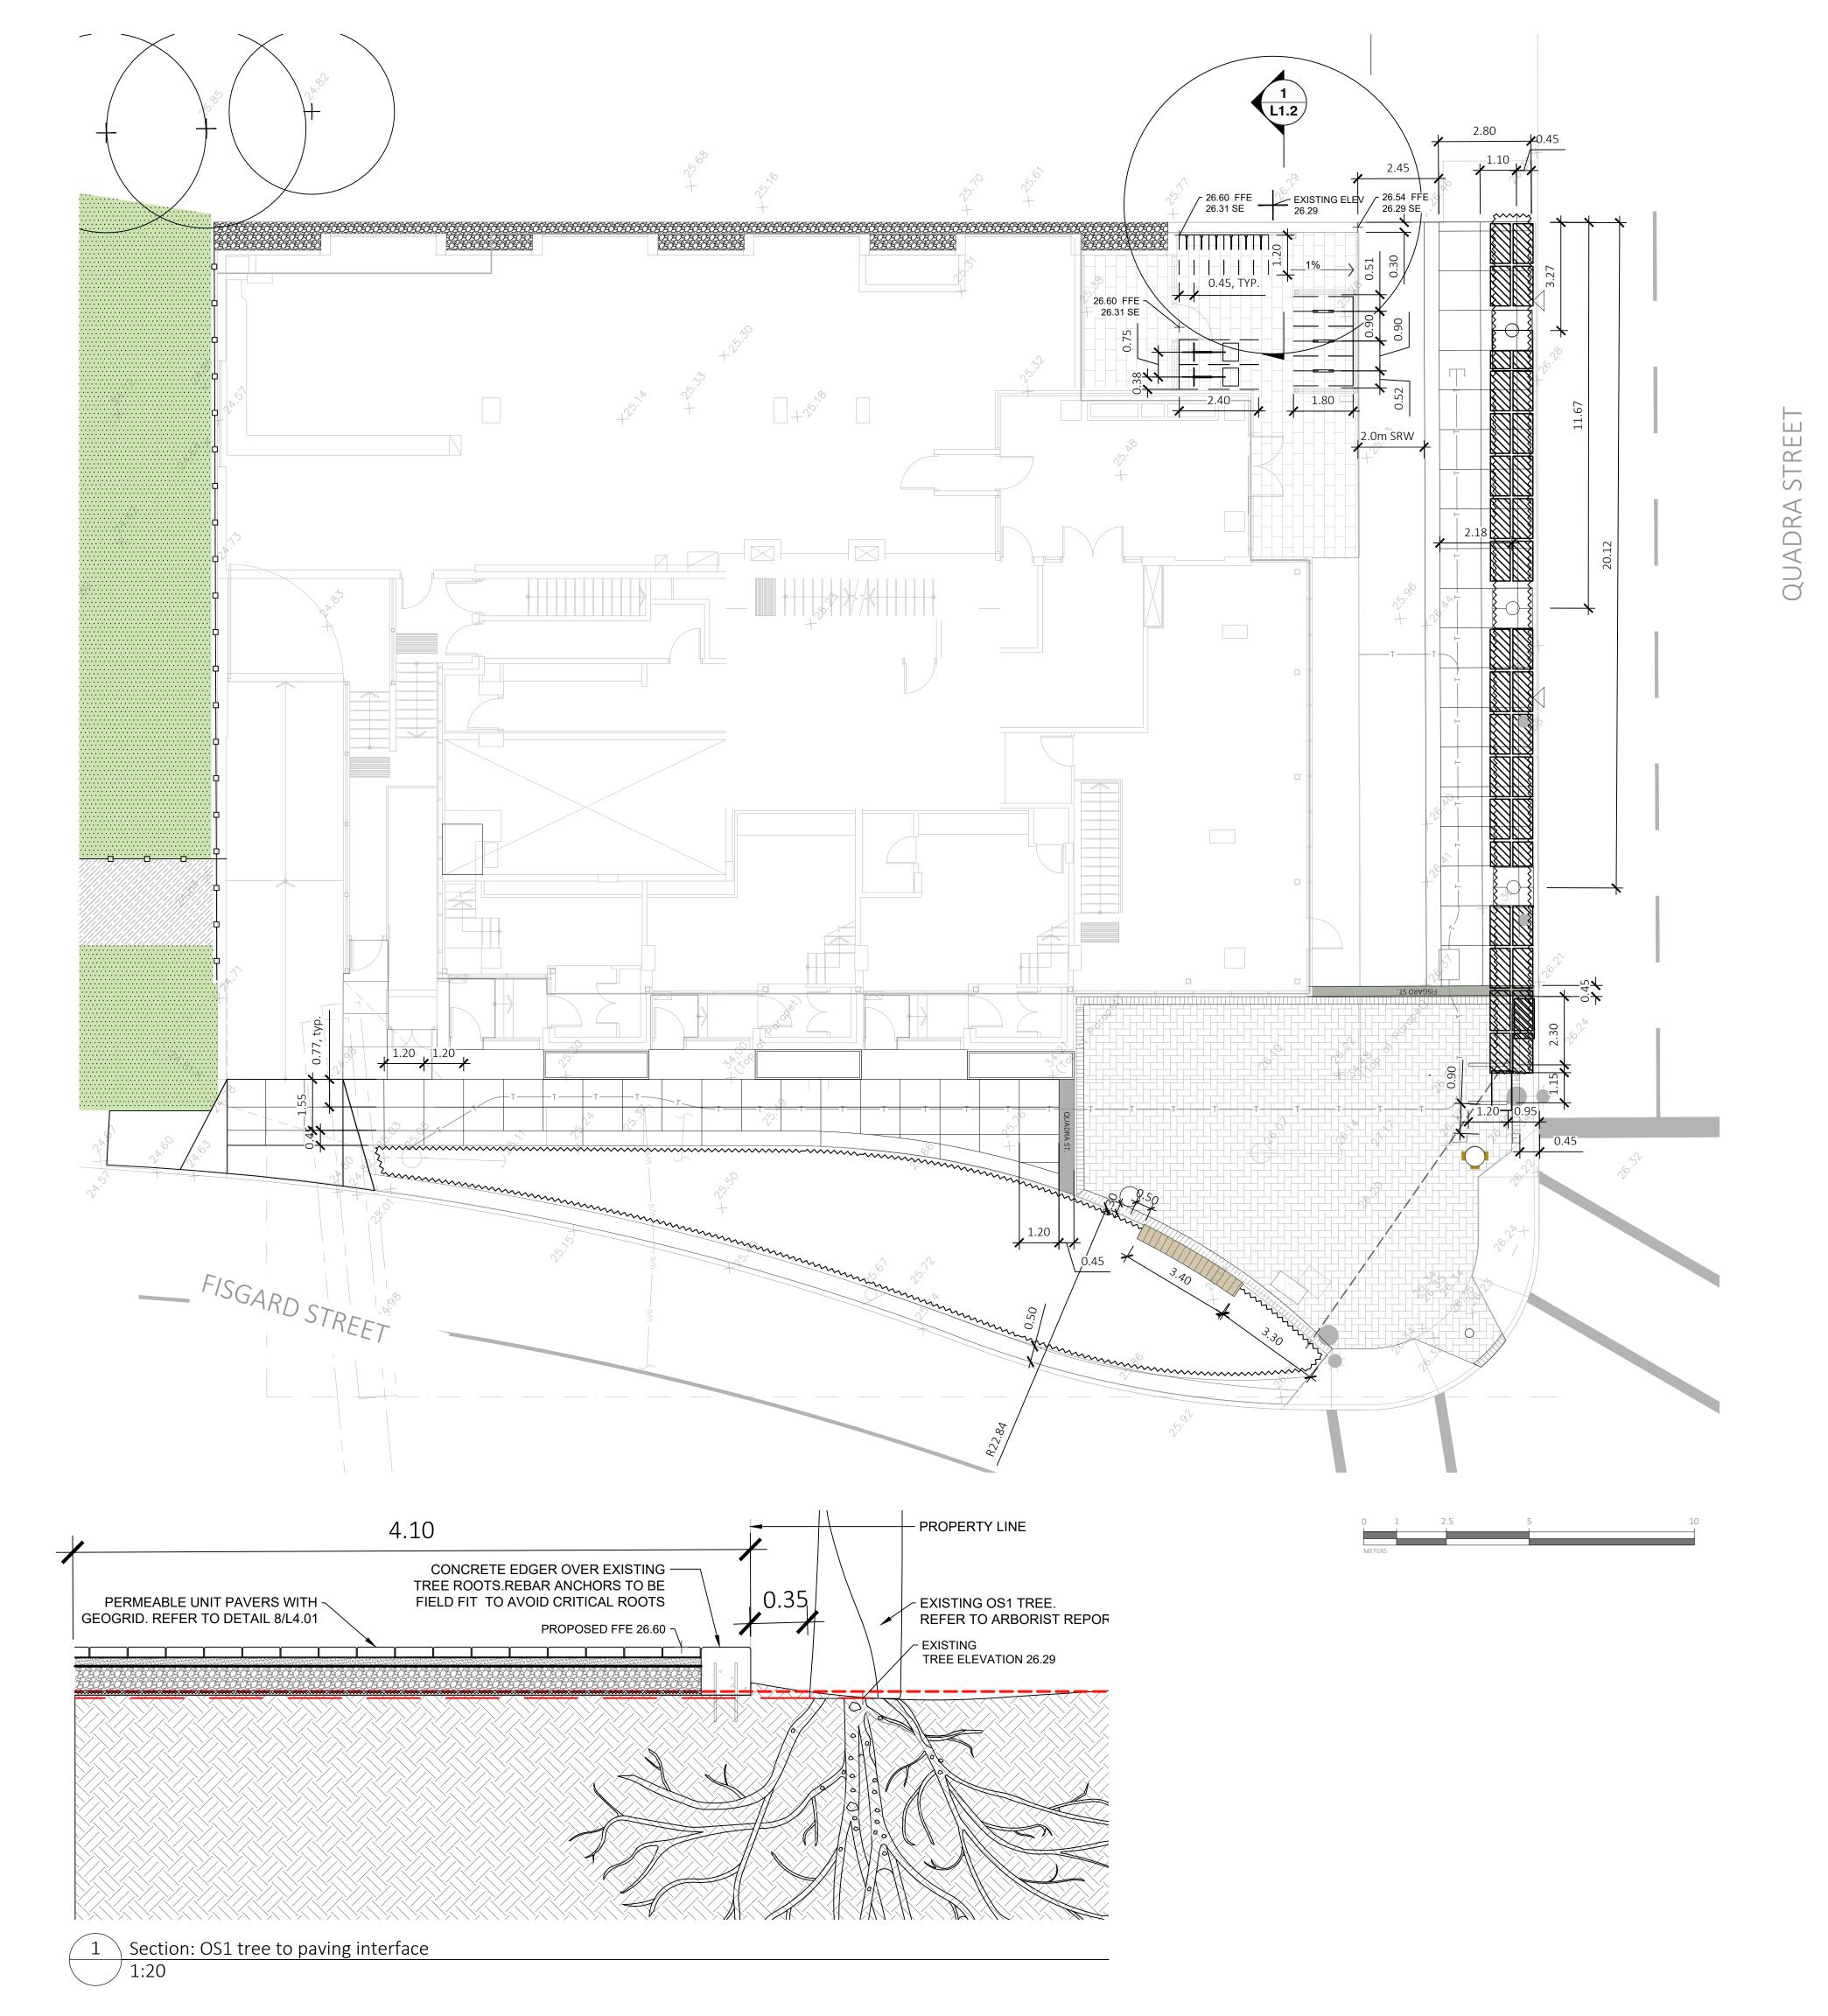

PROPERTY LINE
SRW
2.0m WIDTH ON QUADRA STREET
LINE OF FOUNDATIONS

EXISTING GRADE

26.60 LANDSCAPE PROPOSED GRADE

SLOPE
FFE FINISH FLOOR ELEVATION

BIO PHI LIA

1608 Camosun Street, Victoria BC V8T 3E6 Info@biophiliacollective.ca 250 590 1156

PROJECT NAME:

THE ESTOYA

PROJECT ADDRESS:

1702 QUADRA STREET VICTORIA, BC

DESIGNED BY: BIANCA BODLEY DRAWN BY: KIM TANG

NO.	ISSUED FOR	YY\MM\DD
1	CIS PRESENTATION	12/07/2021
2	DEVELOPMENT PERMIT	12/22/2021
3	ADP MEETING	04/13/2022
4	REVISED AND RE-ISSUED FOR DP	2023/06/01
5	REVISED AND RE-ISSUED FOR DP	2023/09/21
6	REVISED AND RE-ISSUED FOR DP	2023/12/15
7	ISSUED FOR BP RESUBMISSION	2024/04/30
8	ISSUED FOR TENDER	2024/06/28
9	ISSUED FOR BP RESUBMISSION	2024/07/31
10	ISSUED FOR BP RESUBMISSION	2024/09/27
11	ISSUED FOR CONSTRUCTION	2024/10/25
12	ISSUED FOR BP RESUBMISSION	2024/12/19
13	RE-ISSUED FOR CONSTRUCTION	2025/01/22
14	RE-ISSUED FOR BP	2025/06/12
15	ISSUED FOR DDP	2025/07/22

SEAL

NORTH ARROW


DRAWING TITLE:


LAYOUT AND GRADING PLAN


DWG NO:

L1.2

SCALE: 1:100

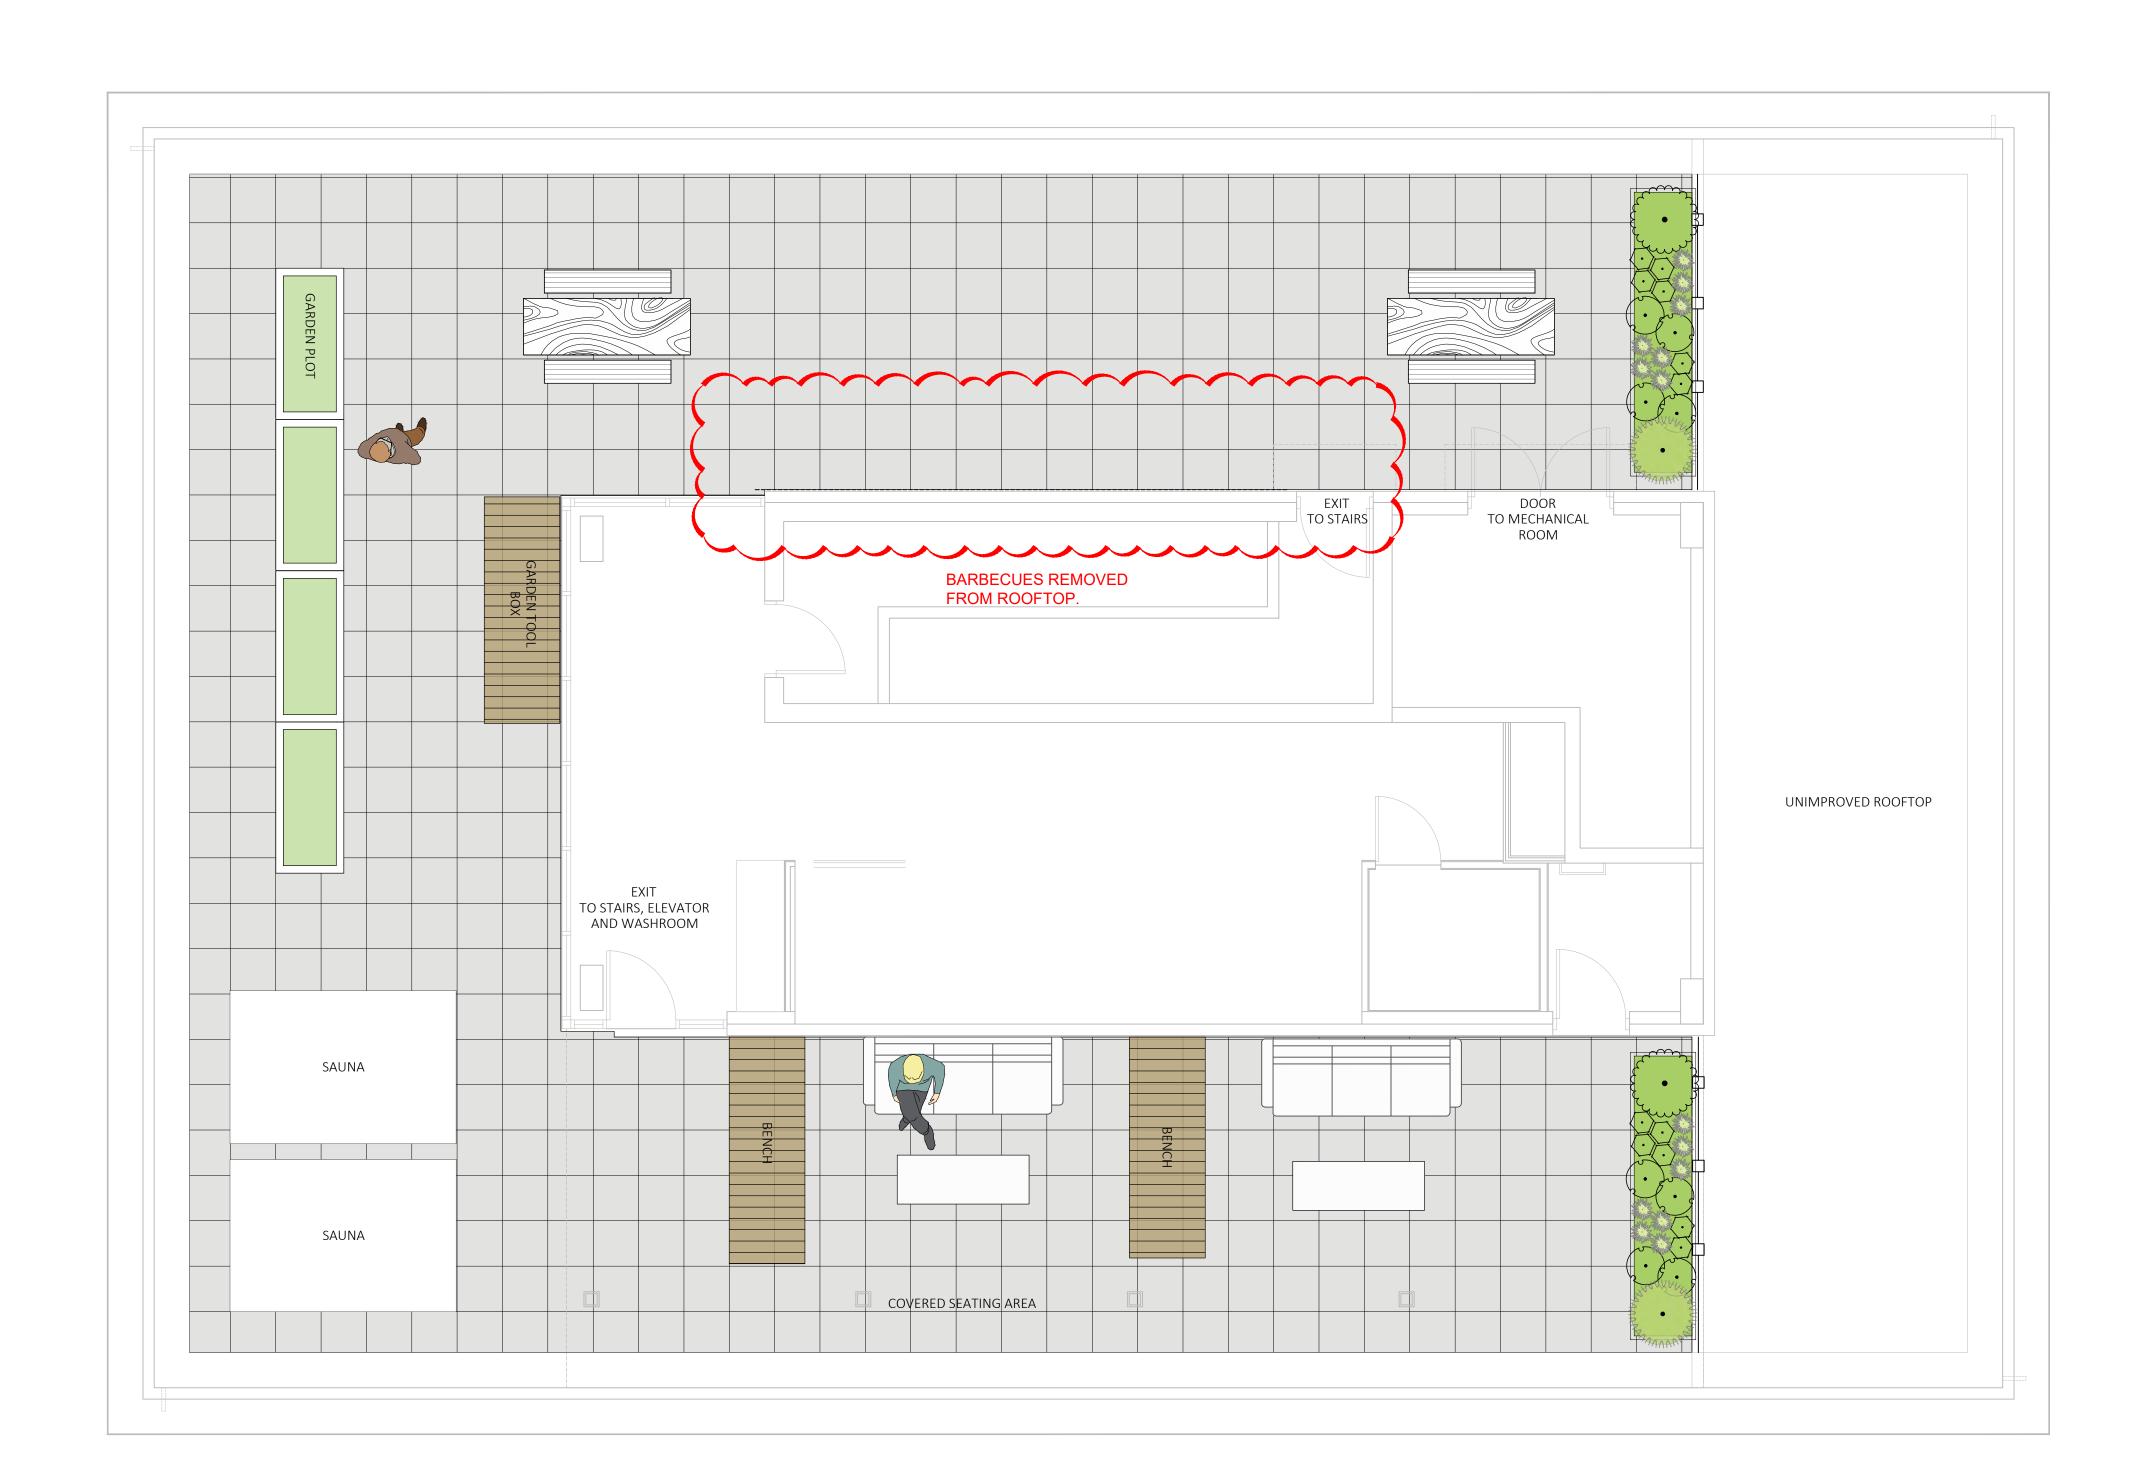

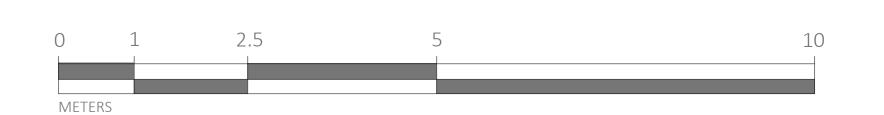

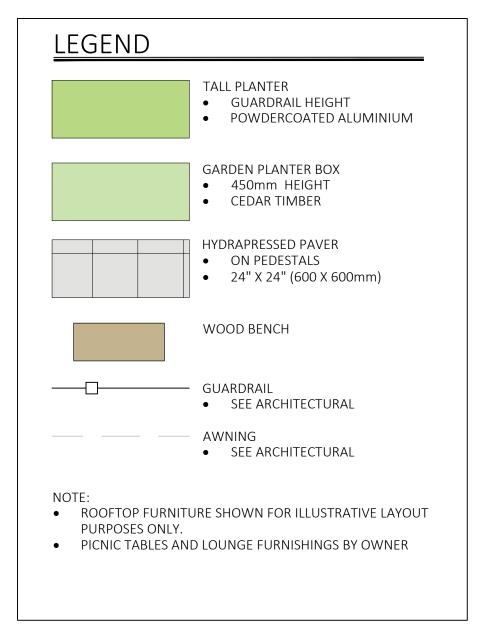



1608 Camosun Street, Victoria BC V8T 3E6 Info@biophiliacollective.ca 250 590 1156

PROJECT NAME:

THE ESTOYA

PROJECT ADDRESS:

1702 QUADRA STREET VICTORIA, BC

DESIGNED BY: BIANCA BODLEY DRAWN BY: KIM TANG

NO.	ISSUED FOR	YY\MM\DD
1	CIS PRESENTATION	12/07/2021
2	DEVELOPMENT PERMIT	12/22/2021
3	ADP MEETING	04/13/2022
4	REVISED AND RE-ISSUED FOR DP	2023/06/01
5	REVISED AND RE-ISSUED FOR DP	2023/09/21
6	REVISED AND RE-ISSUED FOR DP	2023/12/15
7	ISSUED FOR BP RESUBMISSION	2024/04/30
8	ISSUED FOR TENDER	2024/06/28
9	ISSUED FOR BP RESUBMISSION	2024/07/31
10	ISSUED FOR BP RESUBMISSION	2024/09/27
11	ISSUED FOR CONSTRUCTION	2024/10/25
12	ISSUED FOR BP RESUBMISSION	2024/12/19
13	RE-ISSUED FOR CONSTRUCTION	2025/01/22
14	RE-ISSUED FOR BP	2025/06/12
15	ISSUED FOR DDP	2025/07/22


SEAL


NORTH ARROW

DRAWING TITLE:

SITE PLAN - ROOFTOP AMENITY

DWG NO:

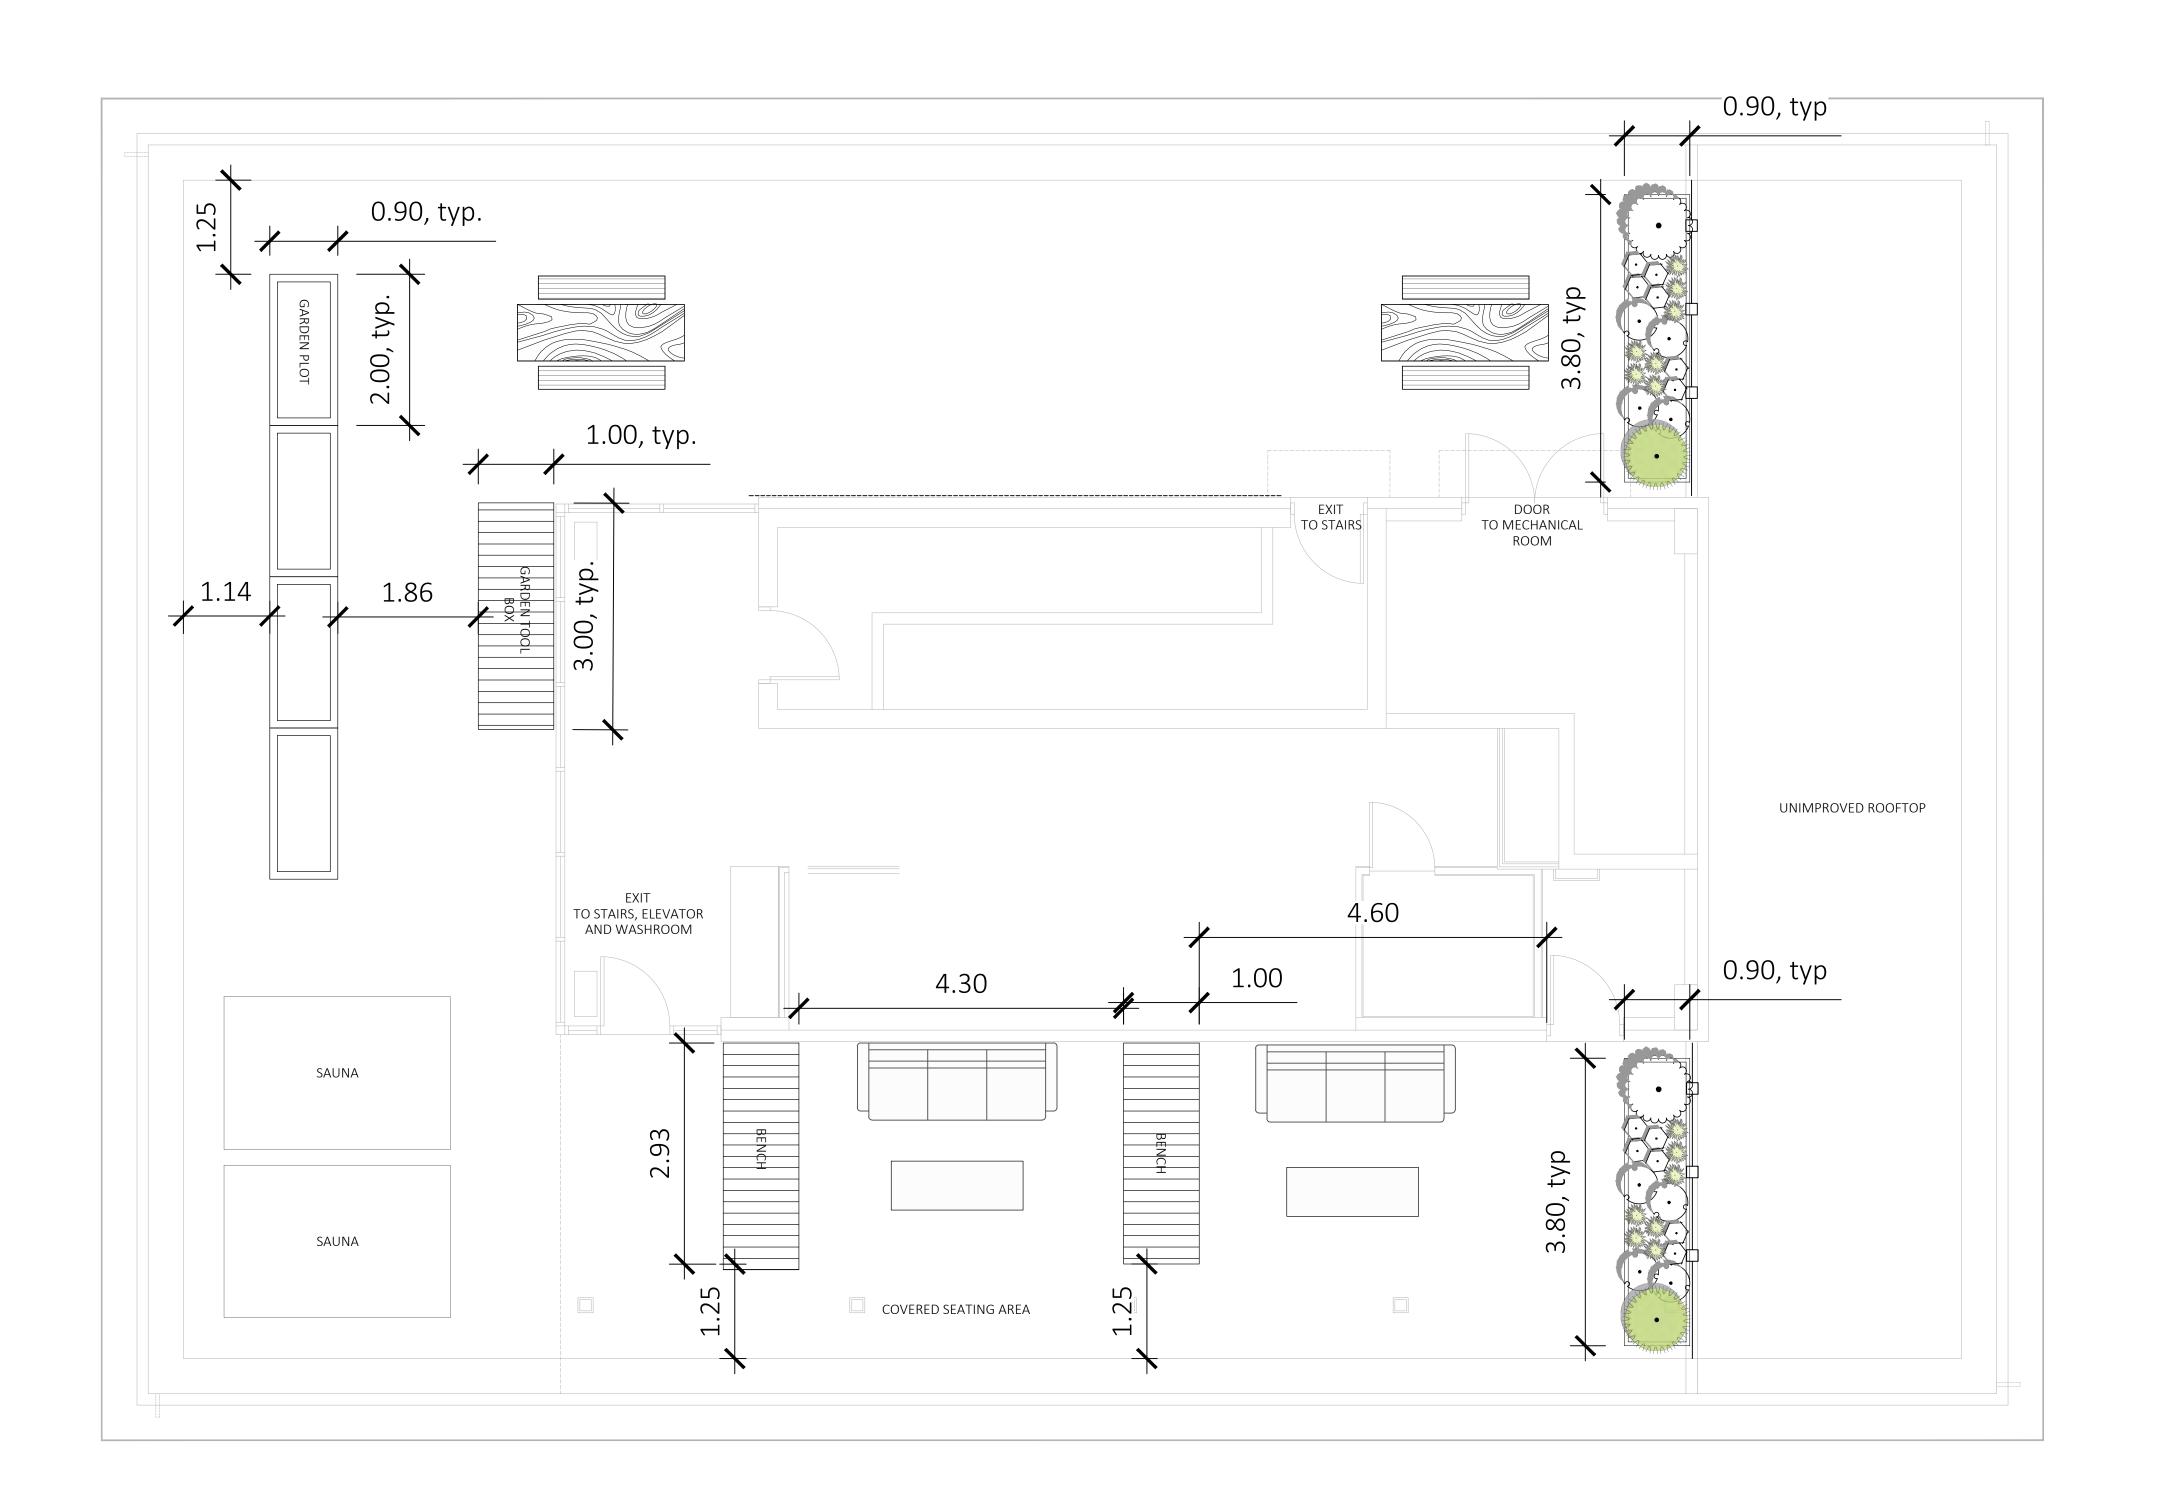

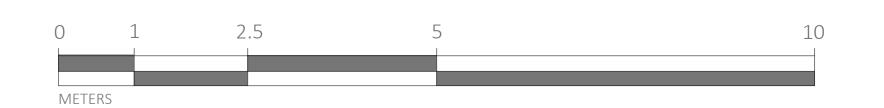



1608 Camosun Street, Victoria BC V8T 3E6 Info@biophiliacollective.ca 250 590 1156

PROJECT NAME:

THE ESTOYA

PROJECT ADDRESS:

1702 QUADRA STREET VICTORIA, BC

DESIGNED BY: BIANCA BODLEY DRAWN BY: KIM TANG

NO.	1000ED TOK	
1	CIS PRESENTATION	12/07/20
2	DEVELOPMENT PERMIT	12/22/20
3	ADP MEETING	04/13/2
4	REVISED AND RE-ISSUED FOR DP	2023/06
5	REVISED AND RE-ISSUED FOR DP	2023/09
6	REVISED AND RE-ISSUED FOR DP	2023/12
7	ISSUED FOR BP RESUBMISSION	2024/04
8	ISSUED FOR TENDER	2024/06
9	ISSUED FOR BP RESUBMISSION	2024/07
10	ISSUED FOR BP RESUBMISSION	2024/09
11	ISSUED FOR CONSTRUCTION	2024/10
12	ISSUED FOR BP RESUBMISSION	2024/12
13	RE-ISSUED FOR CONSTRUCTION	2025/01
14	RESUSSIVEOR BP	2025/06
15	ISSUED FOR DDP	2025/07

SEAL

NORTH ARROW

DRAWING TITLE:

LAYOUT PLAN - ROOFTOP AMENITY

DWG NO:

L2.2

l



SOIL VOLUME					REPLACEM PROPOSED			SOIL VOL	JME REQU	IIRED (m3)	
PLANTING AREA ID	ARE	A (m2)	sc	A.ESTIMATED SOIL VOLUME	1	C. # MEDIUM			F. MEDIUM	G.	TOTAL
			•	ON-SITE	AREA						
QUADRA STREET SOIL CELLS		34	1.4000	45		3			15		45
FISGARD PLANTING BED		55	1	67	1		1	6		30	36

## PLANT RATIOS - OFF SITE

- NATIVE PLANTS
- % BY QUANTITY = 2%
- % BY AREA = 1%

### POLLINATOR PLANTS • % BY QUANTITY = 56% % BY AREA = 56%

## PLANT RATIOS - ON SITE

- NATIVE PLANTS
- % BY QUANTITY = 0%
- % BY AREA = 0%
- POLLINATOR PLANTS % BY QUANTITY = 80% % BY AREA = 50%

## PLANT SCHEDULE MAIN LEVEL

SYMBOL	CODE	BOTANICAL / COMMON NAME	SIZE	CONTAINER	QTY
TREES	SP	Stewartia pseudocamellia / Japanese Stewartia	70mm Cal.	As Shown	2
	UL	Ulmus x 'Lobel' / Lobel Elm	70mm Cal.	As Shown	3
	ZG	Zelkova serrata `Green Vase` / Green Vase Japanese Zelkova	70mm Cal.	As Shown	1
OFF-SITE	SHRUBS				
$\langle \cdot \rangle$	He	Hebe x 'Emerald Green' / Emerald Green Hebe	#2 POT	450mm	62
	Mr2	Mahonia repens / Creeping Mahonia	#2 POT	500mm	125
AND THE REAL PROPERTY OF THE PARTY OF THE PA	Mm	Miscanthus sinensis 'Morning Light' / Morning Light Eulalia Grass	#3 POT	900mm	27
·	Pc	Pinus mugo 'Compacta' / Dwarf Mugo Pine	#3 POT	900mm	16
	Rn	Rosa nutkana / Nootka Rose	#2 POT	1500mm	5
	Vb2	Verbena bonariensis / Tall Verbena	#1 POT	450mm	29
ON-SITE S	HRUBS				
	Ср	Carex testacea 'Prairie Fire' / Prairie Fire Orange Sedge	#1 POT	500mm	8
A ROBERT OF THE PARTY OF THE PA	Mm2	Miscanthus sinensis 'Morning Light' / Morning Light Eulalia Grass	#3 POT	900mm	3
£	Pc2	Pinus mugo 'Compacta' / Dwarf Mugo Pine	#2 POT	900mm	3
	Vb	Verbena bonariensis / Tall Verbena	#1 POT	450mm	7

1. PLANTS IN PLANT LISTS ARE SPECIFIED ACCORDING TO THE CANADIAN NURSERY LANDSCAPE ASSOCIATION CANADIAN STANDARDS FOR NURSERY STOCK AND SECTION 12, CONTAINER GROWN PLANTS FROM THE BC LANDSCAPE STANDARD, CURRENT EDITION.

### IRRIGATION

- ALL AT-GRADE LANDSCAPE BEDS AND ROOFTOP PLANTERS TO BE IRRIGATED WITH AN AUTOMATIC IRRIGATION SYSTEM.
- DETAILED IRRIGATION PLAN TO BE SUBMITTED TO PARKS FOR REVIEW A MINIMUM OF 30 DAYS PRIOR TO INSTALLATION.
- ALL IRRIGATION DESIGNS AND INSTALLATIONS SHALL MEET THE MINIMUM STANDARDS OF THE IRRIGATION INDUSTRY ASSOCIATION OF B.C. (IIABC).
- SEE IRRIGATION PLANS, DETAILS AND WRITTEN SPECIFICATIONS.

## OFF-SITE (MUNICIPAL)

- MUNICIPAL PLANTING BED AND STREET TREES TO BE IRRIGATED BY A SEPARATE SYSTEM FROM A SEPARATE CITY SOURCE CONFORMING TO THE **CITY OF VICTORIA** SUPPLEMENTARY SPECIFICATIONS FOR STREET TREES AND IRRIGATION SCHEDULE C TO BYLAW 12-042,
- IRRIGATION DESIGN DRAWINGS MUST BE SENT TO PARKS FOR REVIEW 30 DAYS PRIOR TO
- INSTALLATION. DRAWINGS SHOULD INDICATE ALL COMPONENTS, MODELS AND MATERIALS FROM WATER
- SUPPLY TO IRRIGATION HEADS. THE CITY WILL REQUIRE 4 INSPECTIONS FOR IRRIGATION INSTALLATION:
- 1)SLEEVING,
- 2) OPEN TRENCH MAINLINE AND PRESSURE TEST, 3) OPEN TRENCH AND LATERAL LINE,
- 4) OPERATION AND COVERAGE, AND
- 5) BACKFLOW PREVENTER ASSEMBLY TEST REPORT.

# MUNICIPAL BOULEVARD TREES

- TREES MUST HAVE ONE DOMINANT CENTRAL LEADER OR SINGLE STRAIGHT TRUNK, 5-8 cm DIAMETER, CALIPER MEASURED 15 cm ABOVE GROUND, WELL BALANCED CROWN WITH BRANCHING STARTING AT 1.8m-2.5m ABOVE GROUND
- TREES TO BE PLANTED AS PER PLANTIG OF TREES, SHRUBS AND GROUND COVERS (32 93
- 01 MMCD 2009 AND CITY OF VICTORIA SUPPLEMENTAL DRAWINGS SD P3 AND SD P4) PARKS WILL REQUIRE (3) INSPECTIONS FOR TREE PLANTING:
- 1) INSPECTION OF SOIL AND PLANTING AREA, 2) INSPECTION OF STOCK UPON DELIVERY, AND
- 3) INSPECTION OF INSTALLED TREE WITH MULCH AND STAKING. TRUNK FLARE MUST BE
- VISIBLE AND PLANTED AT OR SLIGHTLY ABOVE GRADE UPON INSPECTION THE APPLICANT IS RESPONSIBLE FOR PROCURING AND PLANTING THE PROPOSED
- BOULEVARD TREES.
- THE APPLICANT MUST MAINTAIN THE TREE IN GOOD HEALTH AND STRUCTURAL CONDITION FOR 1 YEAR FROM THE SUBSTANTIAL COMPLETION TO BE ELIGIBLE FOR DEPOSIT RETURN.

# PRE-CONSTRUCTION MEETING

 PARKS REQUIRES A PRE-CONSTRUCTION MEETING TO BE HELD PRIOR TO COMMENCEMENT OF CONSTRUCTING THE FRONTAGE WORKS



1608 Camosun Street, Victoria BC V8T 3E6 Info@biophiliacollective.ca 250 590 1156

PROJECT NAME:

THE ESTOYA

PROJECT ADDRESS:

1702 QUADRA STREET VICTORIA, BC

DESIGNED BY: BIANCA BODLEY DRAWN BY: KIM TANG

	NO.	ISSUED FOR	YY\MM\DD
	1	CIS PRESENTATION	12/07/2021
	2	DEVELOPMENT PERMIT	12/22/2021
	3	ADP MEETING	04/13/2022
	4	REVISED AND RE-ISSUED FOR DP	2023/06/01
	5	REVISED AND RE-ISSUED FOR DP	2023/09/21
	6	REVISED AND RE-ISSUED FOR DP	2023/12/15
	7	ISSUED FOR BP RESUBMISSION	2024/04/30
	8	ISSUED FOR TENDER	2024/06/28
	9	ISSUED FOR BP RESUBMISSION	2024/07/31
	10	ISSUED FOR BP RESUBMISSION	2024/09/27
	11	ISSUED FOR CONSTRUCTION	2024/10/25
	12	ISSUED FOR BP RESUBMISSION	2024/12/19
	13	RE-ISSUED FOR CONSTRUCTION	2025/01/22
	14	RE-ISSUED FOR BP	2025/06/12
	15	ISSUED FOR DDP	2025/07/22
_			


SEAL


NORTH ARROW

DRAWING TITLE:

PLANTING PLAN -GROUND FLOOR

DWG NO:

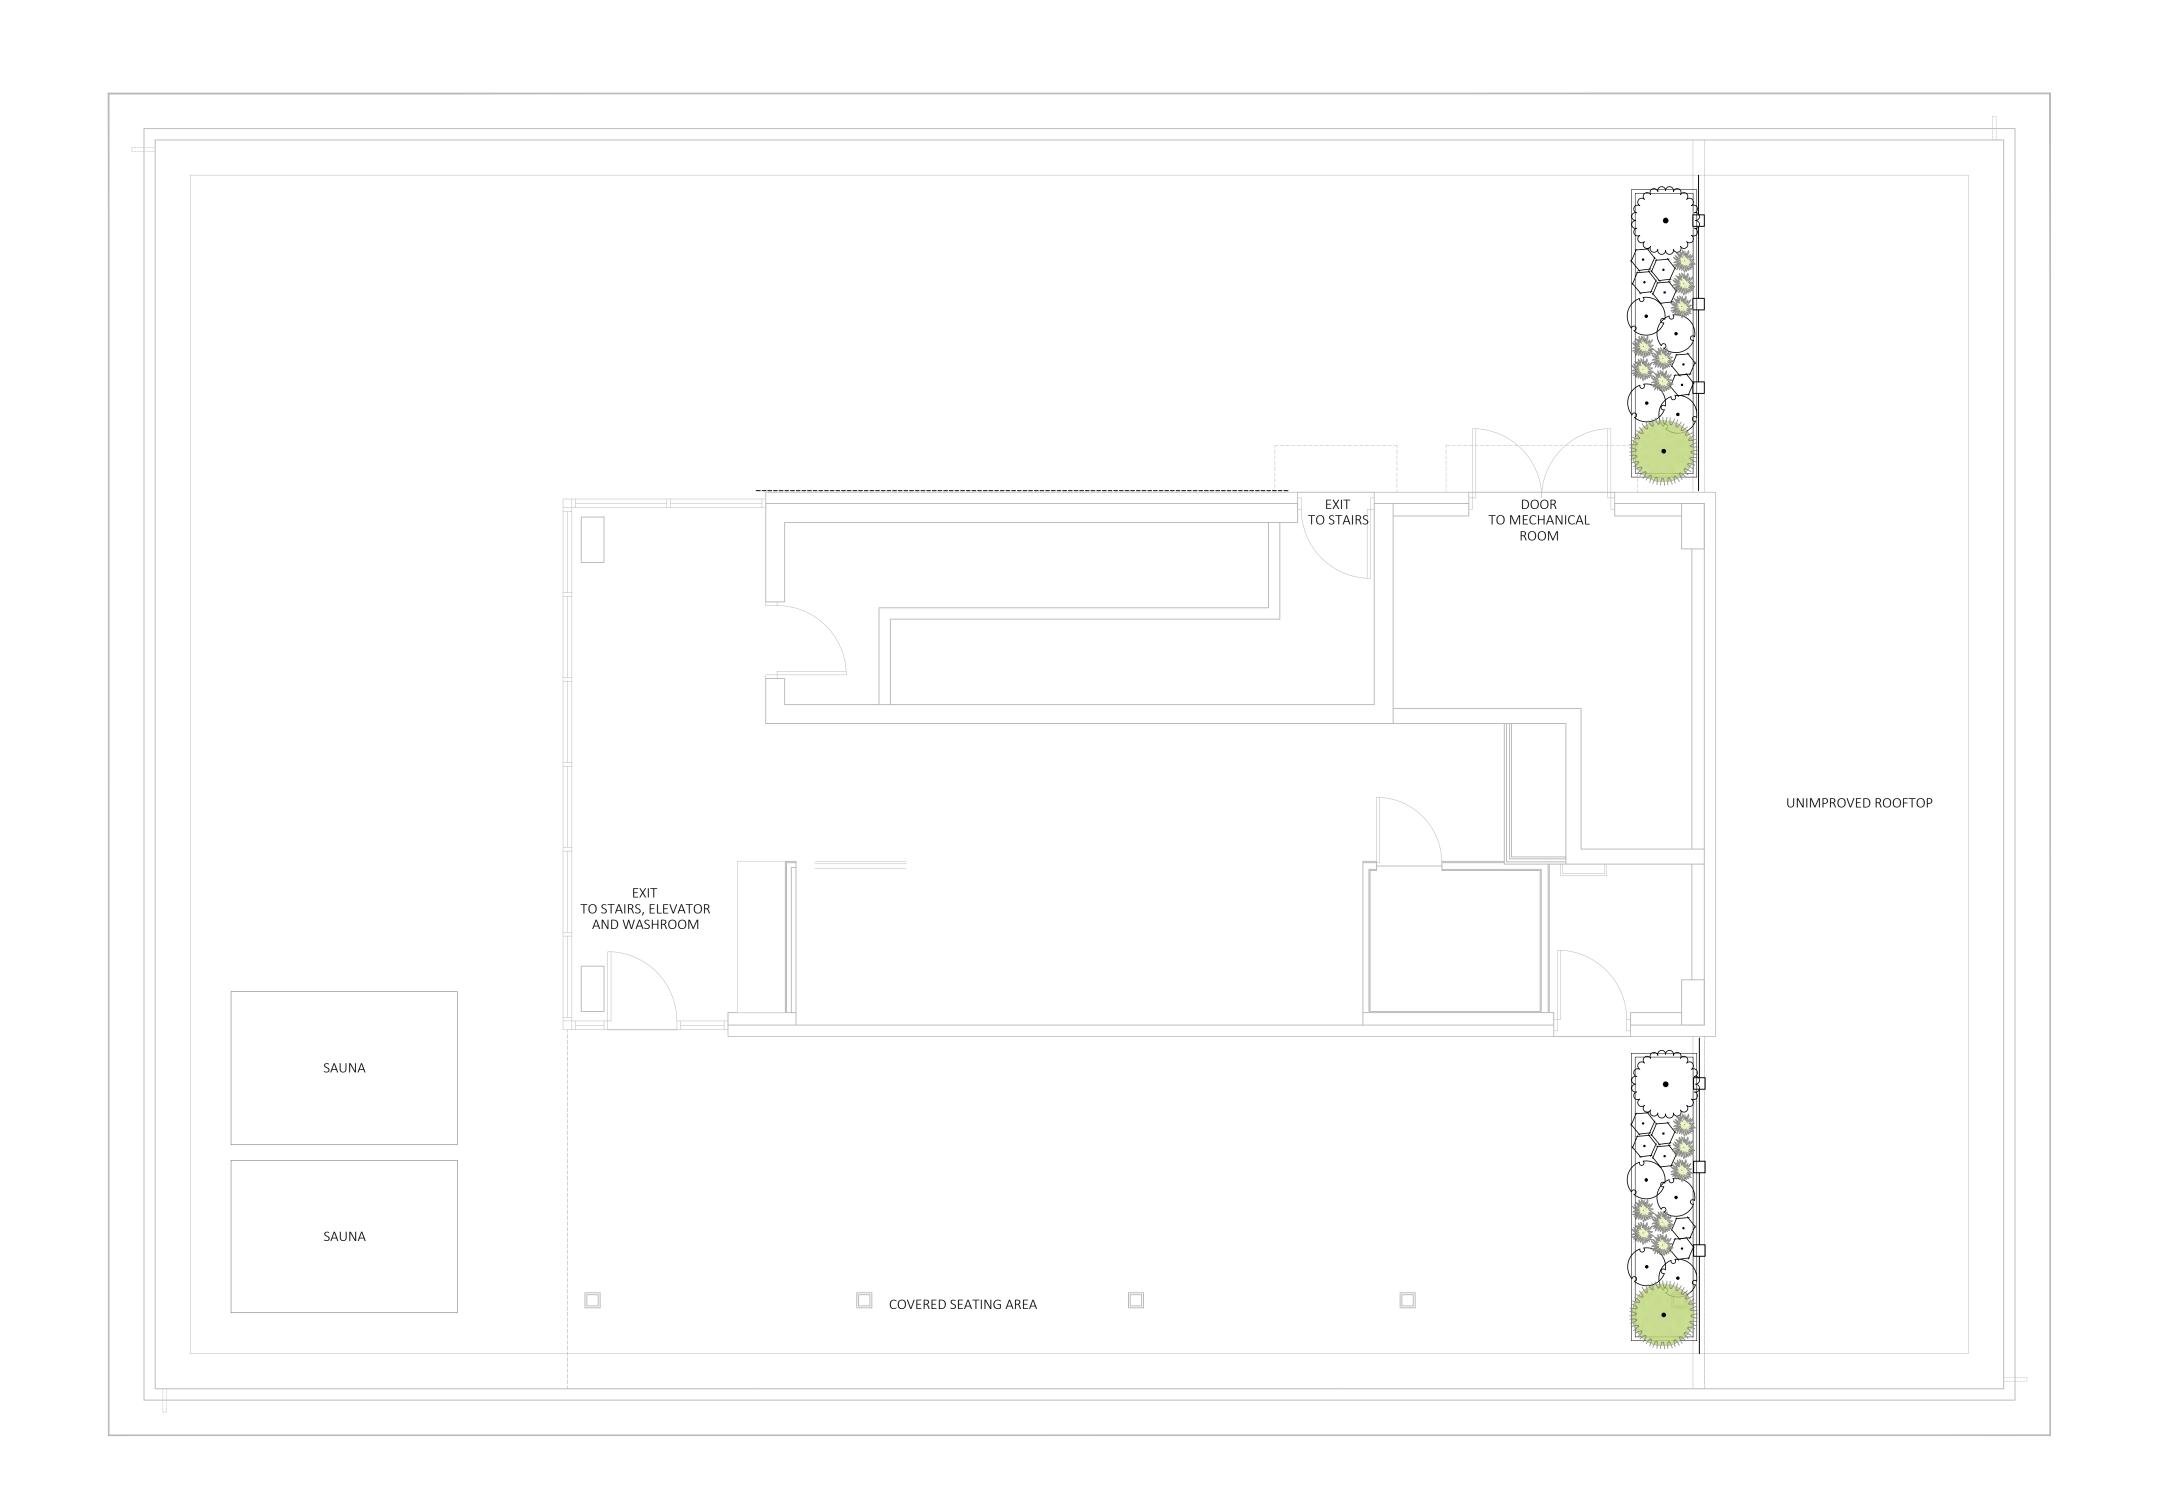

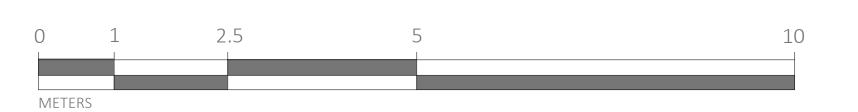

# PLANT SCHEDULE ROOFTOP

SYMBOL	CODE	BOTANICAL / COMMON NAME	SIZE	CONTAINER	QTY
ON-SITE S	HRUBS				
$\langle \cdot \rangle$	Cf	Calluna vulgaris 'Firefly' / Firefly Heather	#1 POT	300mm	12
Manage State of the State of th	El	Eriophyllum lanatum / Woolly Sunflower	#1 POT	300mm	14
The state of the s	Mm2	Miscanthus sinensis 'Morning Light' / Morning Light Eulalia Grass	#3 POT	900mm	2
£()	Pc2	Pinus mugo 'Compacta' / Dwarf Mugo Pine	#2 POT	900mm	2
· c	Vb	Verbena bonariensis / Tall Verbena	#1 POT	450mm	8



1608 Camosun Street, Victoria BC V8T 3E6 Info@biophiliacollective.ca 250 590 1156

PROJECT NAME:

THE ESTOYA

PROJECT ADDRESS:

1702 QUADRA STREET VICTORIA, BC

DESIGNED BY: BIANCA BODLEY DRAWN BY: KIM TANG

NO.	ISSUED FOR	
1	CIS PRESENTATION	12/07/202
2	DEVELOPMENT PERMIT	12/22/202
3	ADP MEETING	04/13/202
4	REVISED AND RE-ISSUED FOR DP	2023/06/0
5	REVISED AND RE-ISSUED FOR DP	2023/09/2
6	REVISED AND RE-ISSUED FOR DP	2023/12/1
7	ISSUED FOR BP RESUBMISSION	2024/04/3
8	ISSUED FOR TENDER	2024/06/2
9	ISSUED FOR BP RESUBMISSION	2024/07/3
10	ISSUED FOR BP RESUBMISSION	2024/09/2
11	ISSUED FOR CONSTRUCTION	2024/10/2
12	ISSUED FOR BP RESUBMISSION	2024/12/1
13	RE-ISSUED FOR CONSTRUCTION	2025/01/2
14	RE-ISSUED FOR BP	2025/06/1
15	ISSUED FOR DDP	2025/07/2


NORTH ARROW


DRAWING TITLE:

PLANTING PLAN -ROOFTOP AMENITY

DWG NO:


L3.2

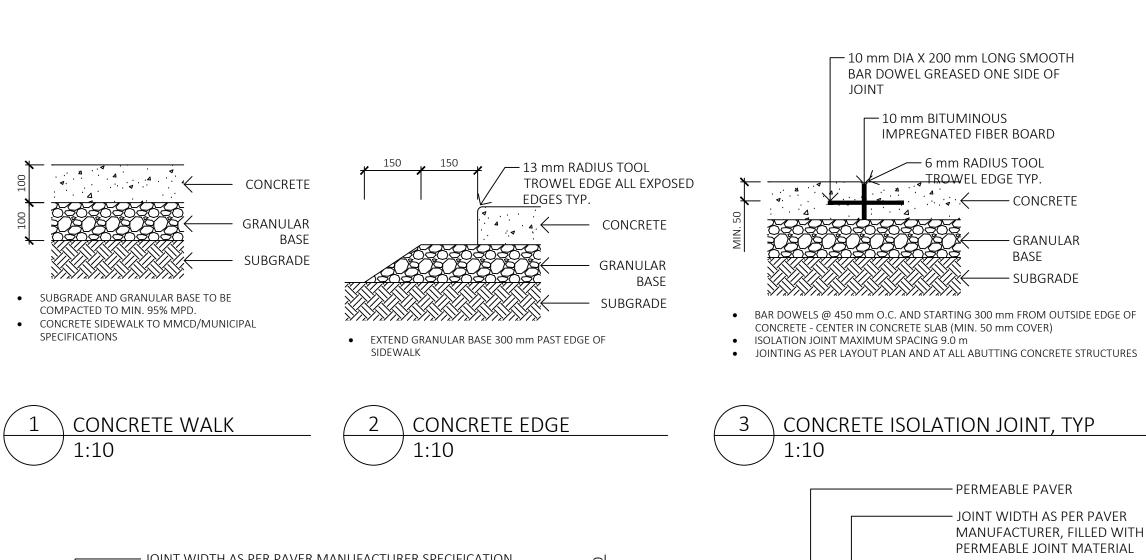

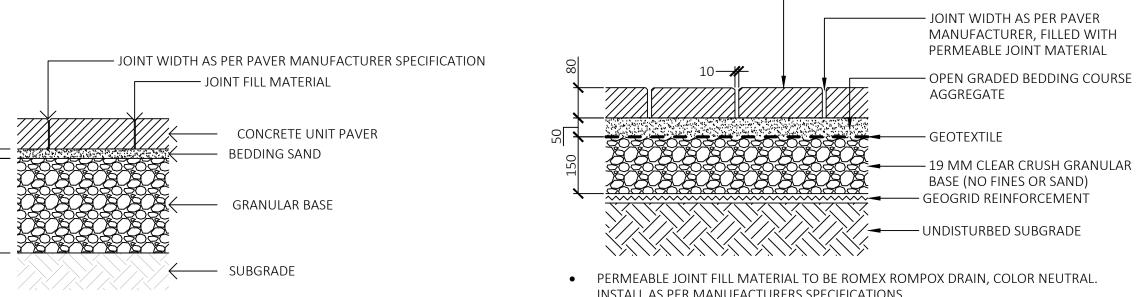

- INSTALL AS PER MANUFACTURERS SPECIFICATIONS
- GEOGRID REINFORCEMENT TO BE COMBIGRID 30/30 OR EQUIVALENT SEE ALSO TALMACK - PAVING OVER EXISTING TREE ROOTS DETAIL AND ARBORIST
- REPORT FOR ADDITIONAL SPECIFICATIONS
- SEE WRITTEN SPECIFICATIONS FOR AGGREGATES
- AGGREGATES COMPACTED TO 95% M.P.D.



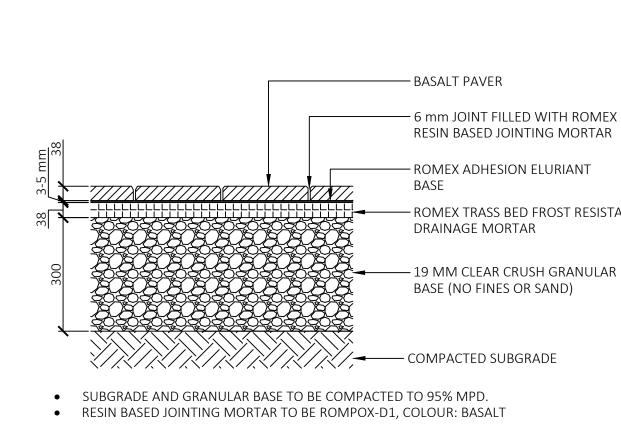

— SAW CUT CONTROL JOINT

4 \ CONCRETE CONTROL JOINT

JOINT DEPTH 1/3 SLAB THICKNESS

CONTROL JOINT MAXIMUM SPACING 3.0 m

JOINTING PATTERN AS PER LAYOUT PLAN


← CONCRETE


— GRANULAR

— SUBGRADE

BASE



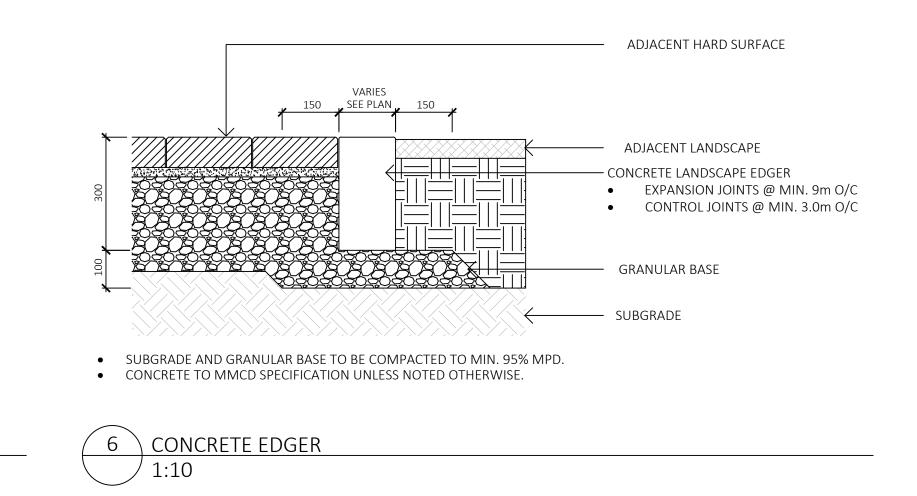

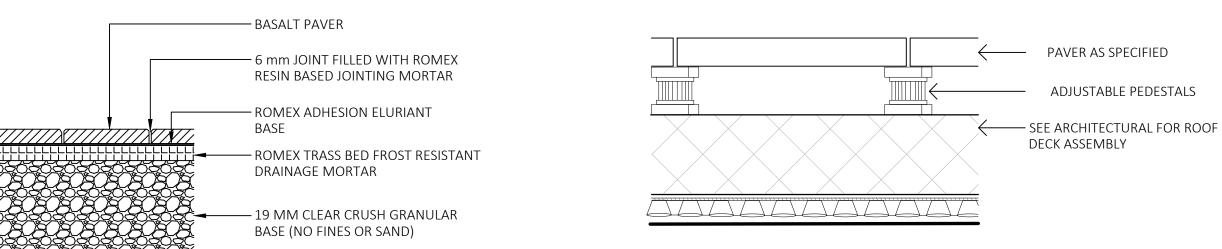

LANDSCAPE FINISH GRADE (MULCH OR

. ← CONCRETE

- GRANULAR

— SUBGRADE


SOD) 25mm BELOW CONCRETE


5 \ CONCRETE - LANDSCAPE INTERFACE

EXTEND GRANULAR BASE 300 mm PAST EDGE OF

- PRIOR TO INSTALLATION, CONTRACTOR TO CONFIRM WITH ARCHITECTURAL / MEMBRANE CONSULTANT IF PROTECTION BOARD IS REQUIRED FOR PAVER PEDESTAL INSTALLATION; IF PROTECTION BOARD IS REQUIRED AND HAS NOT BEEN INSTALLED BY ARCHITECTURAL, CONTRACTOR TO NOTIFY GENERAL CONTRACTOR.
- ADJUSTABLE PEDESTALS TO BE BlackJack OneStep or BlackJack ScrewJack PEDESTALS AS REQUIRED OR APPROVED EQUAL.
- INSTALLATION TO MANUFACTURER'S SPECIFICATIONS.



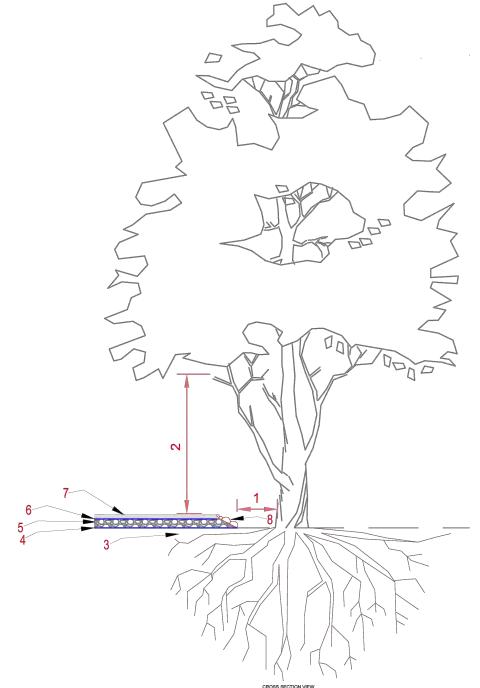

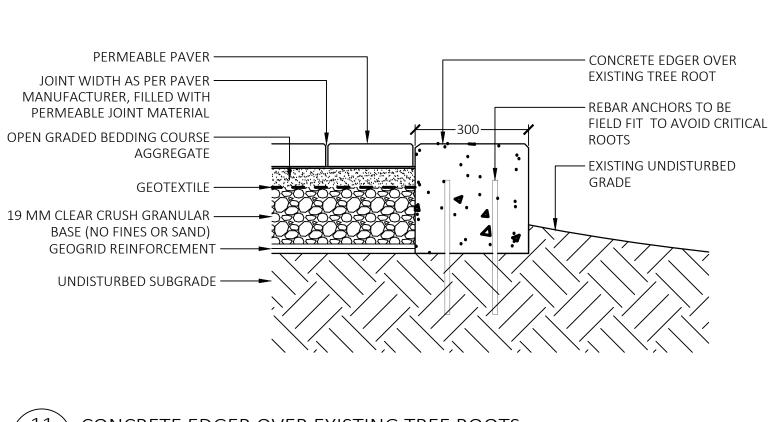

CONCRETE EDGER OVER EXISTING TREE ROOTS

JOINT FILL MATERIAL TO BE POLYMERIC SAND

SPECIFICATION UNLESS NOTED OTHERWISE.


UNIT PAVER ON GRADE

GRANULAR BASE TO BE COMPACED IN MAX. 100mm LIFTS.

• SUBGRADE AND GRANULAR BASE TO BE COMPACTED TO MIN. 95% MPD.

PAVER AND PAVER INSTALLATION TO MMCD AND MANUFACTURER'S

- 2. Review any canopy clearance pruning requirements to accommodate vehicle or pedestrian clearances (Pruning to be performed
- 3. Excavate the new footprint of the driveway or sidewalk under the supervision of the project arborist. Excavation will be limited to
- the removal of the existing sod layer. Excavation around root structures must be performed by hand, airspade, or
- 5. Install a 150mm depth layer of clear crushed gravel (no fines) using 20mm and/or 75mm diameter material or approved
- 6. Install meduim weight geotextile fabric (such as Nilex 4535 or similar) over the clear crushed gravel layer to prevent fine particles
- 7. The bedding or base layer and new driveway or sidewalk surface can be installed directly on top of the felted filter fabric.
- 8. Fill slopes where possible install loose stacked boulders to reduce the footprint of the fill slopes that encroach within the critical root zone. Fill slope materials must be permeable to air and water. Do not pile fill material directly against the trunk of a tree.

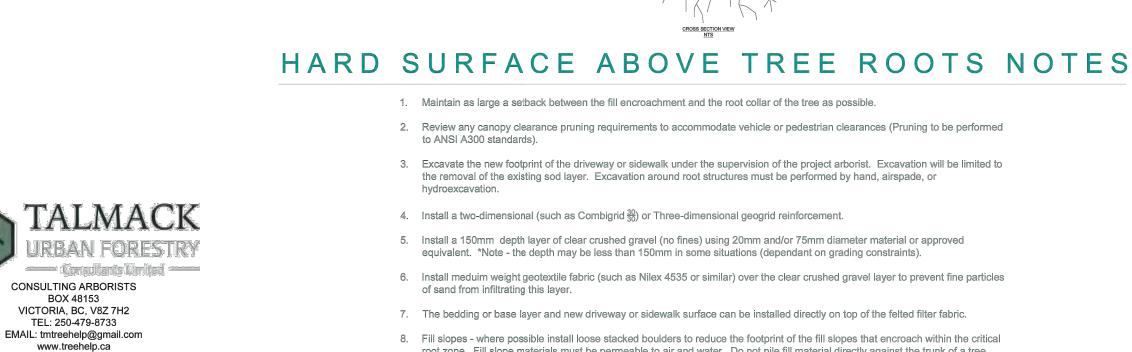

IO. ISSUED FOR lyy\mm\dd CIS PRESENTATION DEVELOPMENT PERMIT 3 ADP MEETING 04/13/2022 REVISED AND RE-ISSUED FOR DP 023/06/01 REVISED AND RE-ISSUED FOR DP REVISED AND RE-ISSUED FOR DP 023/12/15 ISSUED FOR BP RESUBMISSION 024/04/30 8 ISSUED FOR TENDER 2024/06/28 9 ISSUED FOR BP RESUBMISSION 024/07/31 10 ISSUED FOR BP RESUBMISSION 024/09/26 ISSUED FOR CONSTRUCTION ISSUED FOR BP RESUBMISSION 2024/12/18 13 RE-ISSUED FOR CONSTRUCTION SEAL

1608 Camosun Street, Victoria BC V8T 3E6

PROJECT NAME:

THE ESTOYA

VICTORIA, BC

DESIGNED BY: BIANCA BODLEY

DRAWN BY: ELIZABETH BALDERSTON


1702 QUADRA STREET


PROJECT ADDRESS:

Info@biophiliacollective.ca 250 590 1156

DRAWING TITLE: PAVING DETAILS

\ TALMACK - PAVING OVER EXISTING TREE ROOTS

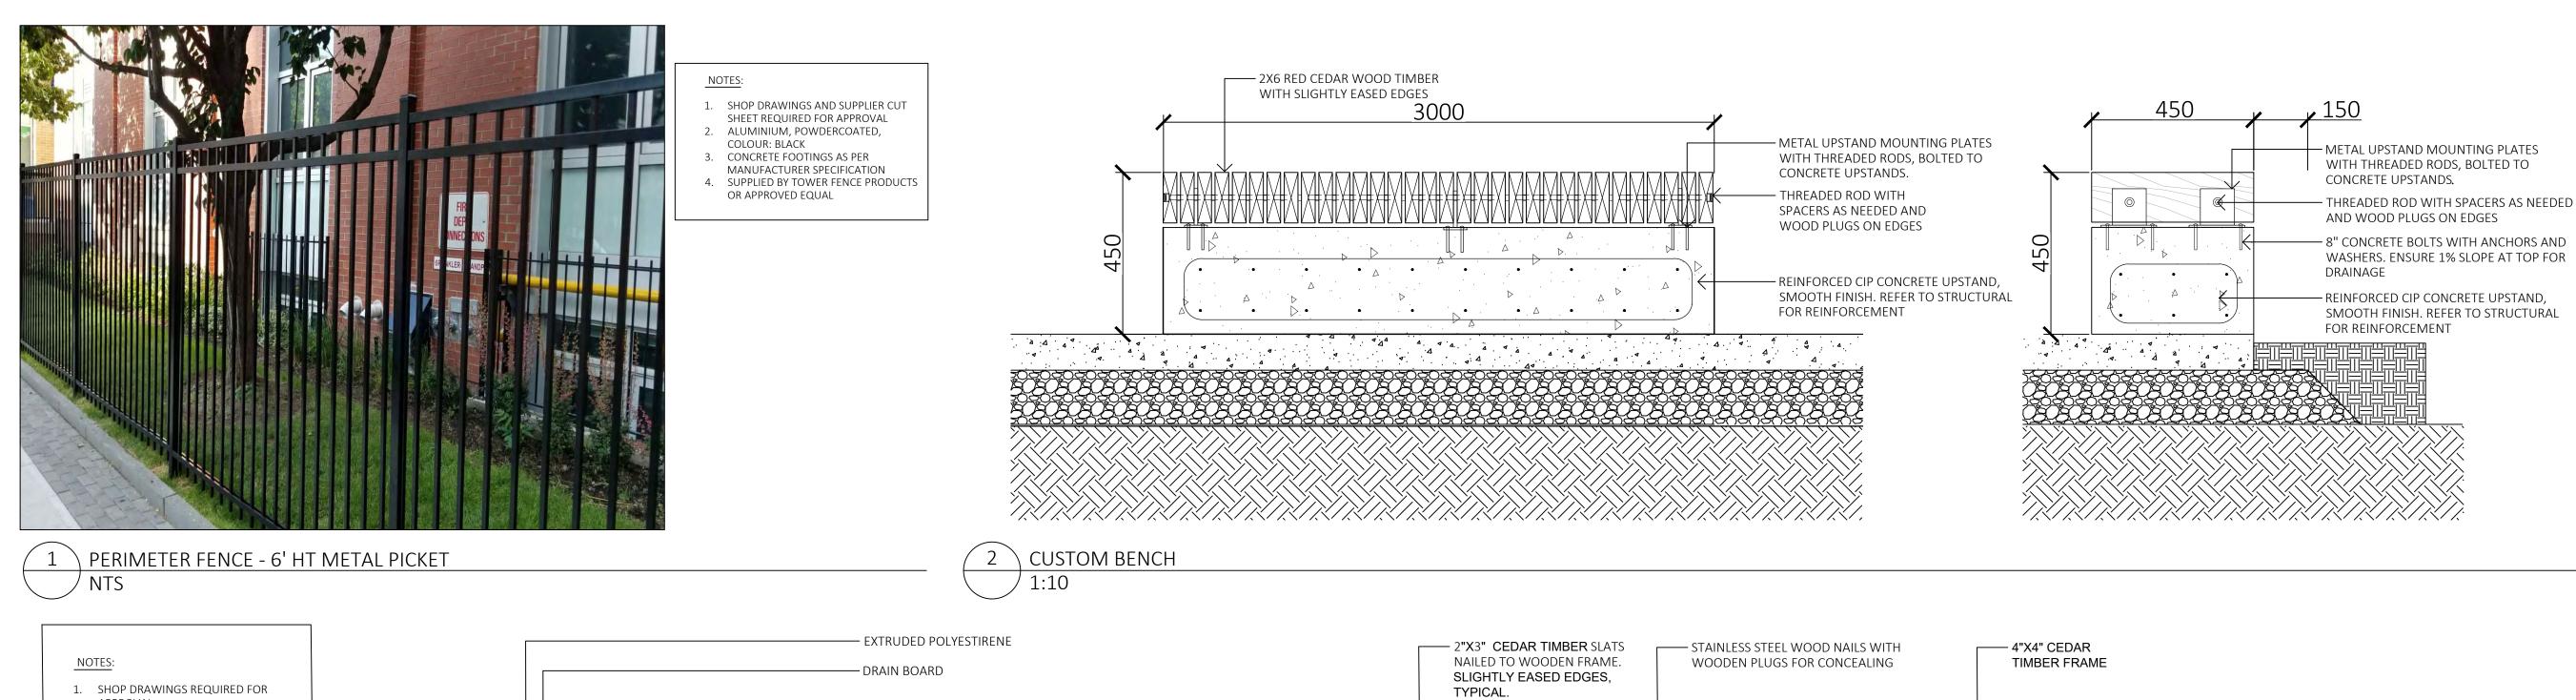

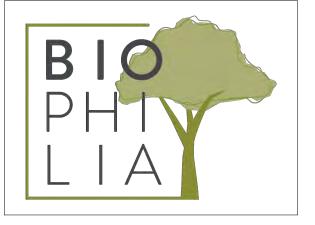

1608 Camosun Street, Victoria BC V8T 3E6 Info@biophiliacollective.ca 250 590 1156

PROJECT NAME: THE ESTOYA

1. SHOP DRAWINGS REQUIRED FOR

WOOD TIMBERS: TIGHT-KNOT YELLOW

OR RED CEDAR PLANED FOR SMOOTH

FINISH, SLIGHTLY EASED EDGES. SEE

INCLUDING ROD CLIPS ,THREADED

CONCRETE; WITH ARCHITECTURAL

5. PROVIDE CLOSED WOOD PLUGS AT ALL ROD ASSEMBLY CONNECTIONS.

RODS, BOLTS AND NUTS, AND ALL MISC

APPROVAL

HARDWARE;

5mm BLACK NYLON SPACER

- 4"X4" CEDAR TIMBER FRAME

- 2"X3" CEDAR TIMBER SLATS

- 4"X4" CEDAR

TIMBER FRAME

— **HEAVY DUTY** LIFT UP

HYDRAULIC HINGE

— 4"X4" CEDAR TIMBER FRAME

- 2"X3" CEDAR TIMBER SLATS

NAILED TO WOODEN FRAME.

SLIGHTLY EASED EDGES,

TYPICAL.

SLIGHTLY EASED EDGES, TYPICAL.

- STAINLESS STEEL THREADED ROD

WITH NUT/WASHER ASSEMBLY BOTH

SPECS FOR FINISH;

CONCRETE FINISH.

3. ALL STEEL: STAINLESS STEEL,

4. CONCRETE BASE: 32MPA C-2

PROJECT ADDRESS:

1702 QUADRA STREET VICTORIA, BC

DESIGNED BY: BIANCA BODLEY DRAWN BY: ELIZABETH BALDERSTON


NO.	ISSUED FOR	YY\MM\DD
1	CIS PRESENTATION	12/07/2021
2	DEVELOPMENT PERMIT	12/22/2021
3	ADP MEETING	04/13/2022
4	REVISED AND RE-ISSUED FOR DP	2023/06/01
5	REVISED AND RE-ISSUED FOR DP	2023/09/21
6	REVISED AND RE-ISSUED FOR DP	2023/12/15
7	ISSUED FOR BP RESUBMISSION	2024/04/30
8	ISSUED FOR TENDER	2024/06/28
9	ISSUED FOR BP RESUBMISSION	2024/07/31
10	ISSUED FOR BP RESUBMISSION	2024/09/26
11	ISSUED FOR CONSTRUCTION	2024/10/25
12	ISSUED FOR BP RESUBMISSION	2024/12/18
13	RE-ISSUED FOR CONSTRUCTION	2025/01/22

SEAL

DRAWING TITLE:

FURNISHING DETAILS

DWG NO:

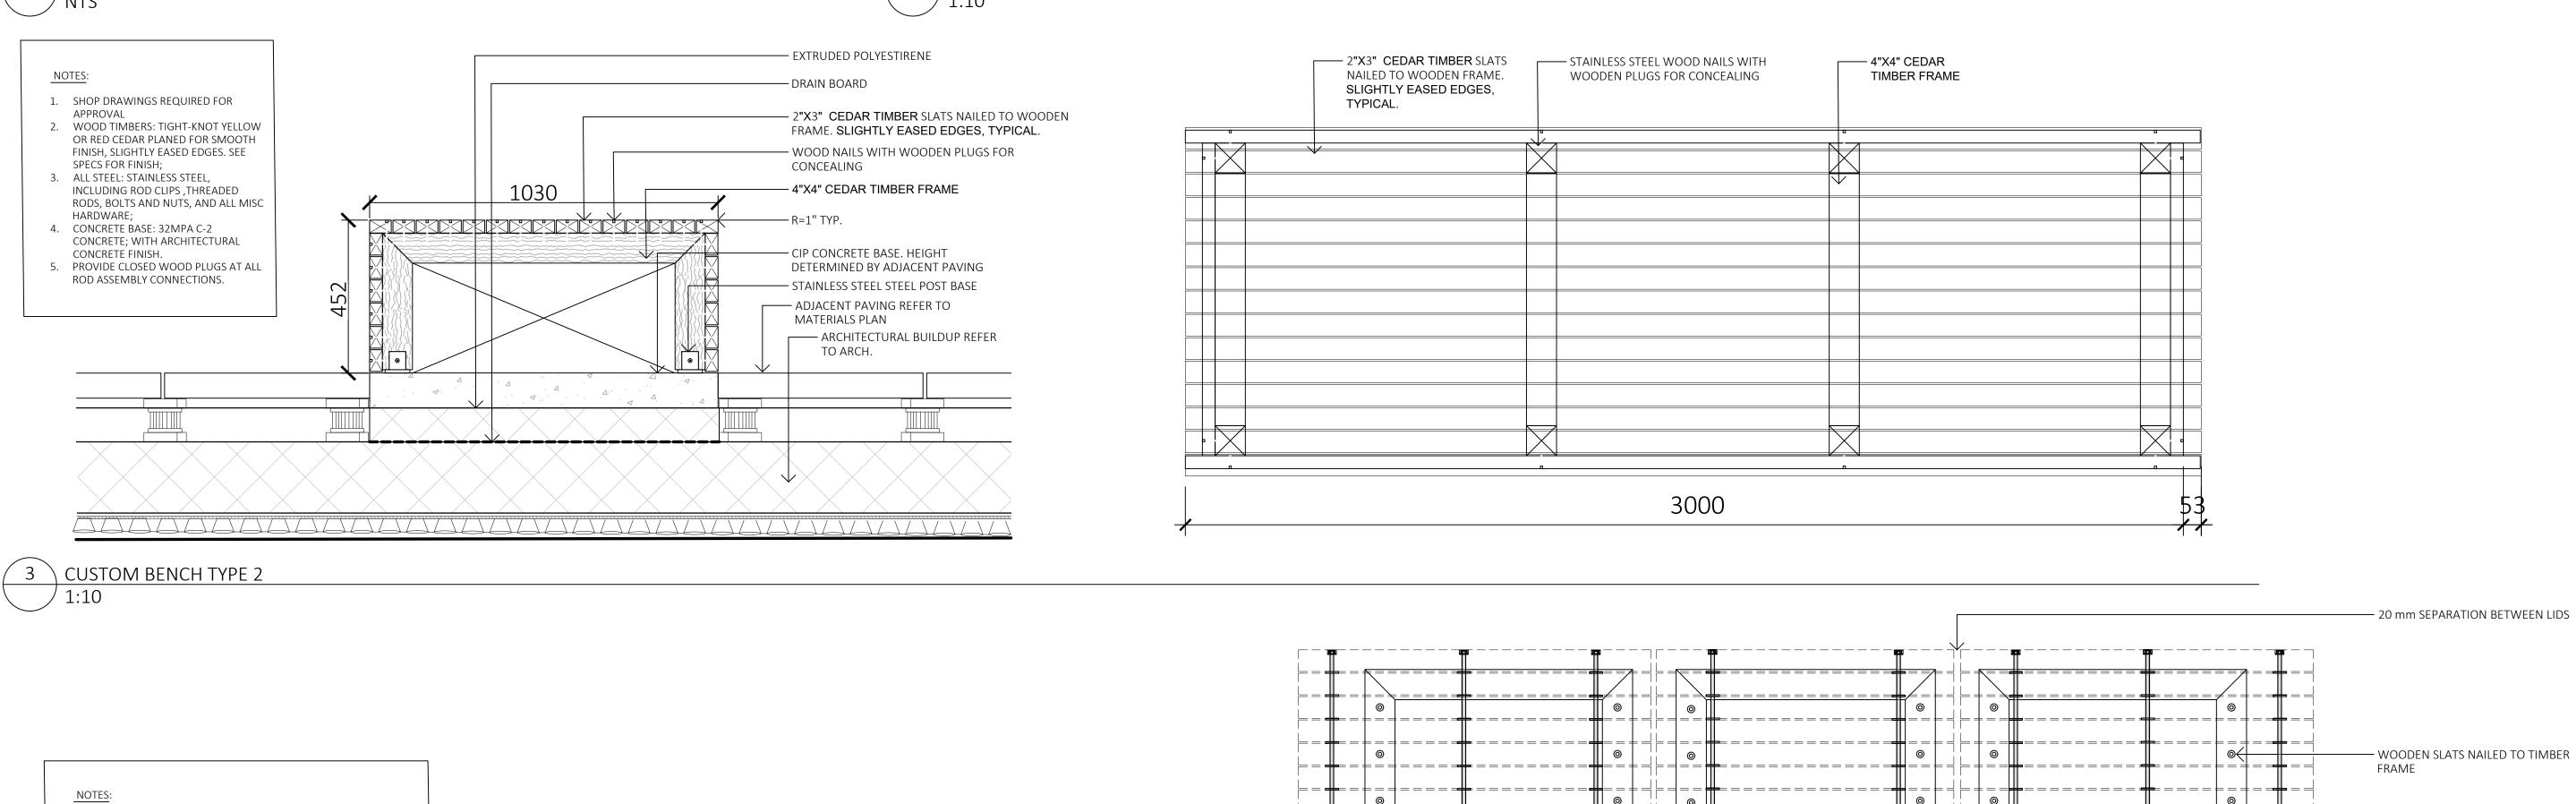

— 5mm BLACK NYLON SPACER

EASED EDGES, TYPICAL.

EDGES, TYPICAL.

FRAME

CONCEALING

ADJACENT PAVING REFER TO MATERIALS PLAN

– DRAIN BOARD

- DRAIN BOARD

ARCHITECTURAL BUILDUP REFER TO ARCH.

SLAB

- 4"X4" CEDAR TIMBER

– STAINLESS STEEL WOOD NAILS WITH WOODEN PLUGS FOR

- STAINLESS STEEL STEEL POST

- 4" CIP CONCRETE FLOATING

- 4"X4" CEDAR TIMBER FRAME

- HEAVY DUTY LIFT UP HYDRAULIC

- 2"X3" CEDAR TIMBER SLATS NAILED

TO WOODEN FRAME. SLIGHTLY EASED

- STAINLESS STEEL THREADED ROD

WITH NUT/WASHER ASSEMBLY BOTH

- 2"X3" CEDAR TIMBER SLATS SLIGHTLY

CUSTOM BENCH TYPE 3 WITH STORAGE

1. SHOP DRAWINGS REQUIRED FOR APPROVAL

CONCRETE FINISH.

CONNECTIONS.

2. WOOD TIMBERS: TIGHT-KNOT YELLOW OR RED CEDAR PLANED

FOR SMOOTH FINISH, SLIGHTLY EASED EDGES. SEE SPECS FOR

3. ALL STEEL: STAINLESS STEEL, INCLUDING ROD CLIPS ,THREADED

4. CONCRETE BASE: 32MPA C-2 CONCRETE; WITH ARCHITECTURAL

1030

### # #

RODS, BOLTS AND NUTS, AND ALL MISC HARDWARE;

5. PROVIDE CLOSED WOOD PLUGS AT ALL ROD ASSEMBLY


3000

EQ

2900


89

EQ

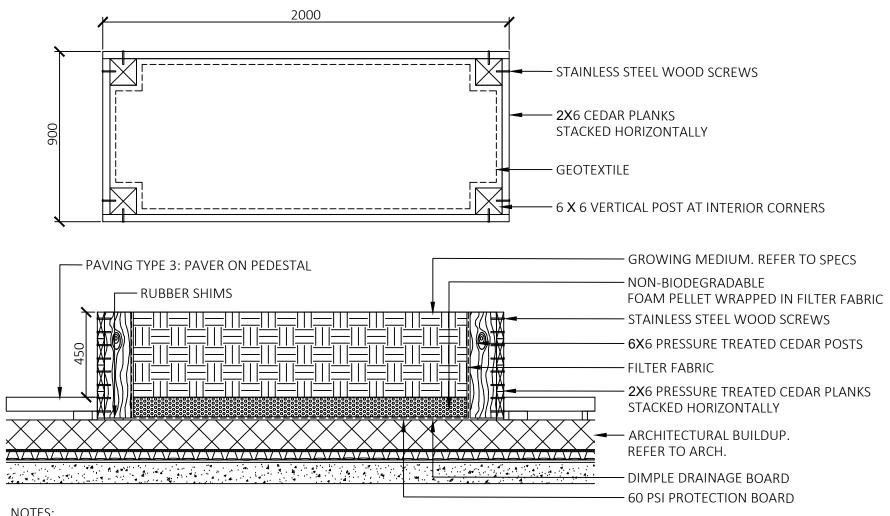


- 1. WOOD TO BE PRESSURE TREATED RED CEDAR, WITH ROUNDED EDGES ON TOP PLANK.
- FINISH PREPARED BOARDS WITH TWO COATS OF LifeTime Wood Treatment OR APPROVED EQUAL PRIOR TO ASSEMBLY.
- 3. ALL FASTENERS IN CONTACT WITH CEDAR TO BE STAINLESS STEEL.
- 4. SHOP DRAWING AND WOOD SAMPLE REQUIRED FOR APPROVAL PRIOR TO FABRICATION.



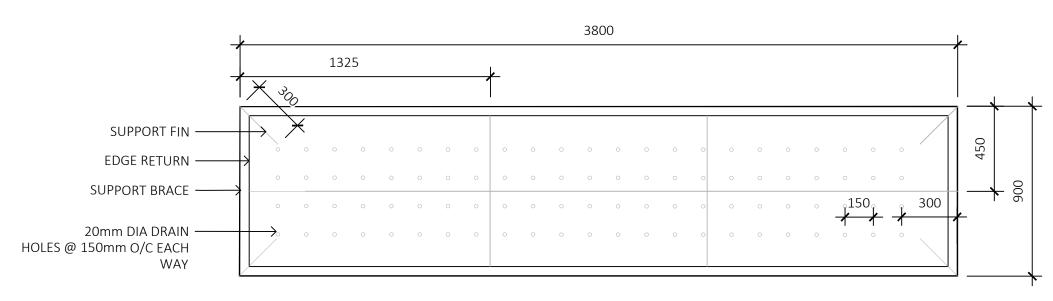

- SHOP DRAWINGS REQUIRED SAMPLE OF FINISH REQUIRED
- FINISH: AGED PATINA WITH MATTE LACQUER SEALANT
- SUPPORT FIN AND BRACE TO BE 1/8" RAW STEEL SECURELY TACK WELDED TO PLANTER FRAME
- NO FINISH REQUIRED ON INTERNAL SUPPORT STRUCTURES

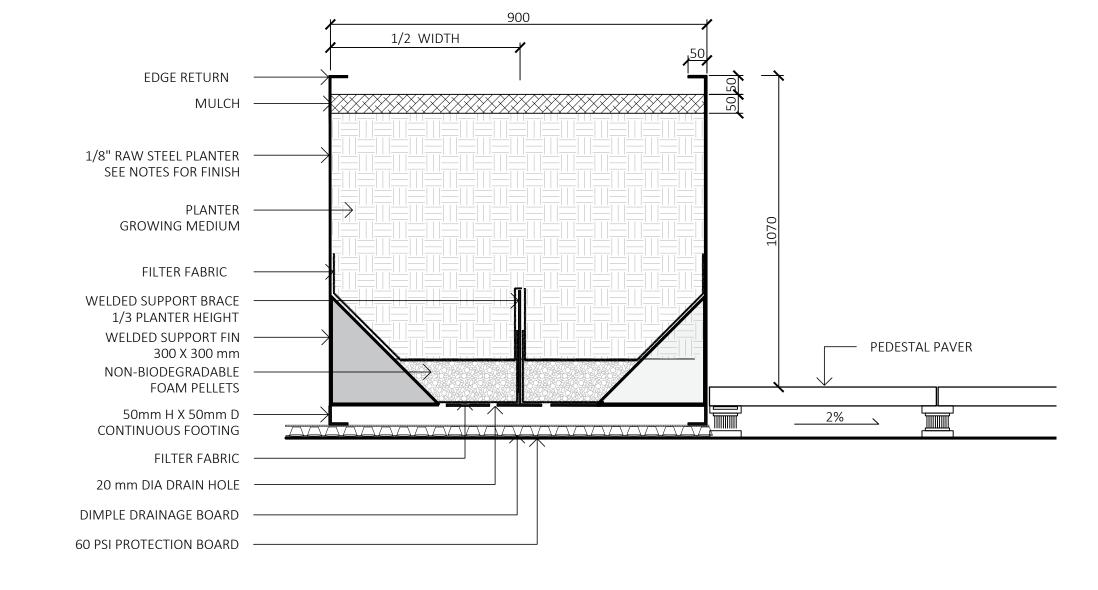



NO. **ISSUED FOR** YY\MM\DD 1 CIS PRESENTATION 12/07/2021 2 DEVELOPMENT PERMIT 2/22/2021 3 ADP MEETING 04/13/2022 4 REVISED AND RE-ISSUED FOR DP 2023/06/01 5 REVISED AND RE-ISSUED FOR DP 2023/09/21 6 REVISED AND RE-ISSUED FOR DP 2023/12/15 7 ISSUED FOR BP RESUBMISSION 2024/04/30 8 ISSUED FOR TENDER 2024/06/28 9 ISSUED FOR BP RESUBMISSION 2024/07/31 10 ISSUED FOR BP RESUBMISSION 2024/09/26 1 ISSUED FOR CONSTRUCTION

2024/12/18

1608 Camosun Street, Victoria BC V8T 3E6 Info@biophiliacollective.ca 250 590 1156

1702 QUADRA STREET VICTORIA, BC

PROJECT NAME:

PROJECT ADDRESS:

THE ESTOYA

DESIGNED BY: BIANCA BODLEY DRAWN BY: ELIZABETH BALDERSTON

SEAL


DRAWING TITLE:

FURNISHING DETAILS

12 ISSUED FOR BP RESUBMISSION


13 RE-ISSUED FOR CONSTRUCTION

DWG NO:

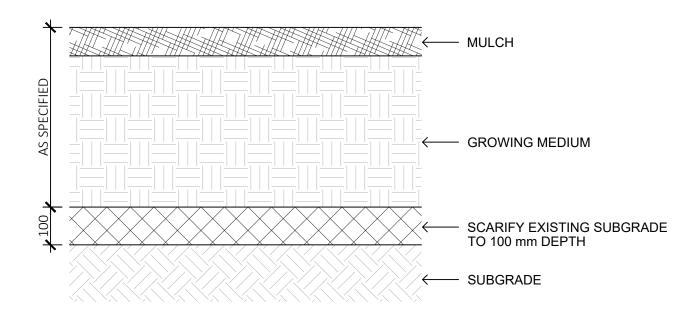



- 1. PLACE AND COMPACT SUBGRADE AS PER WRITTEN SPECIFICATIONS
- 2. SUBGRADE TO BE COMPACTED TO A CONSISTENT 80% M.P.D 3. GROWING MEDIUM AND MULCH AS PER WRITTEN SPECIFICATIONS

SOIL PROFILE ON GRADE

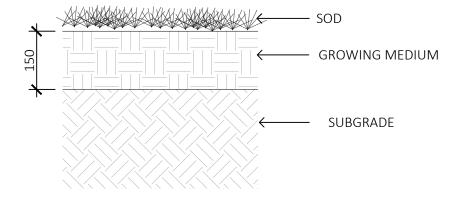


1. SUBGRADE TO BE COMPACTED TO A CONSISTENT 80%

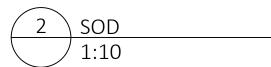


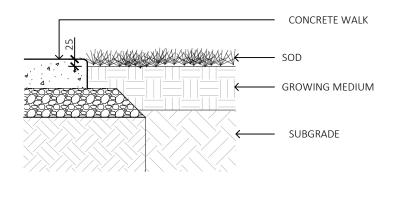

SOD 25mm BELOW ADJACENT SIDEWALK
 SUBGRADE UNDER SOD TO BE COMPACTED TO 80% MPD.
 SUBGRADE UNDER CONCRETE WALK TO BE COMPACTED TO 95% MPD.



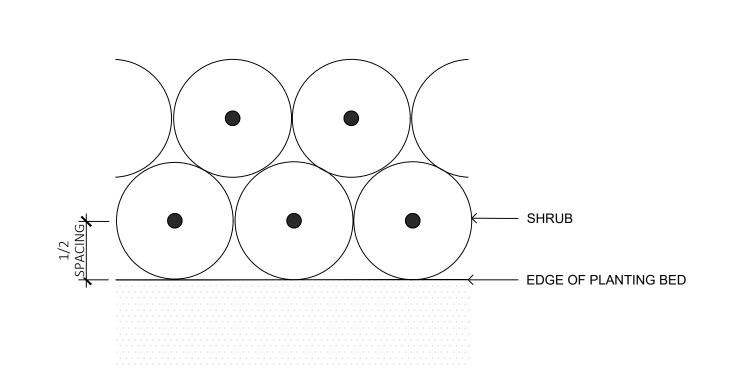


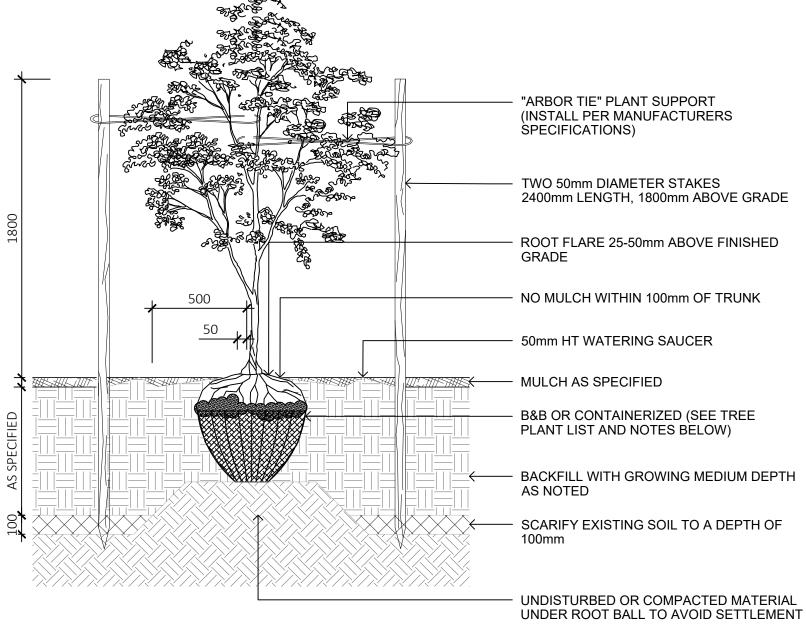


- 2. FOR B&B: REMOVE TOP 1/3 OF BURLAP AND CAGE PRIOR TO BACKFILLING WITH GROWING MEDIUM
- AND ENSURE NO CIRCLING ROOTS BY LIGHT ROOT PRUNING 4. INSTALL TREE TIE AT APPROX. 50% OF TREE
- 100mm BELOW LOWEST BRANCH FOR DECIDUOUS LESS THAN 100mm CAL. DO NOT REMOVE OR CONSTRAIN ANY BRANCHES. 5. STANDARD TREE PLANTING DETAILS TO
- 6. TREE PLANTING ON MUNICIPAL PROPERTY TO

PLANTING TRIANGULAR SPACING




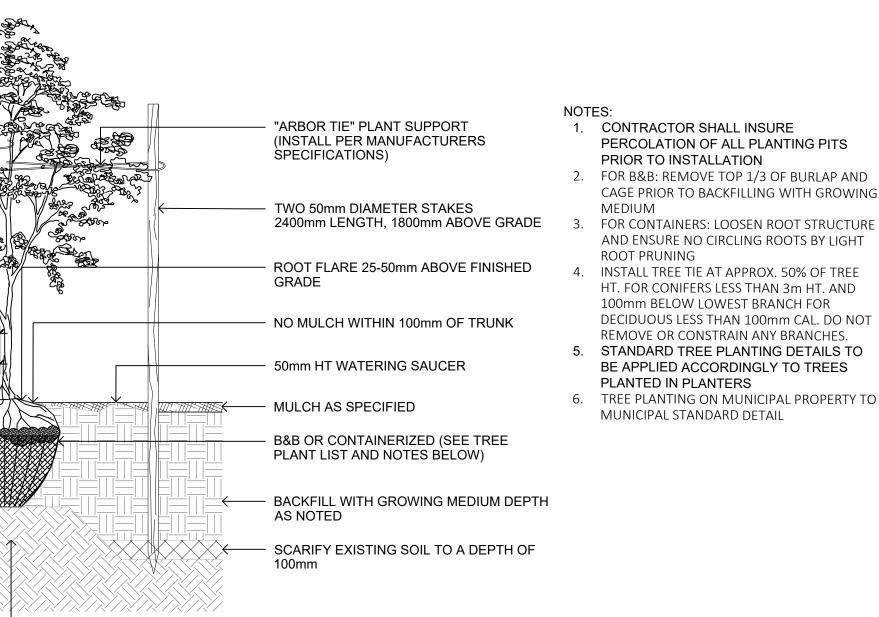

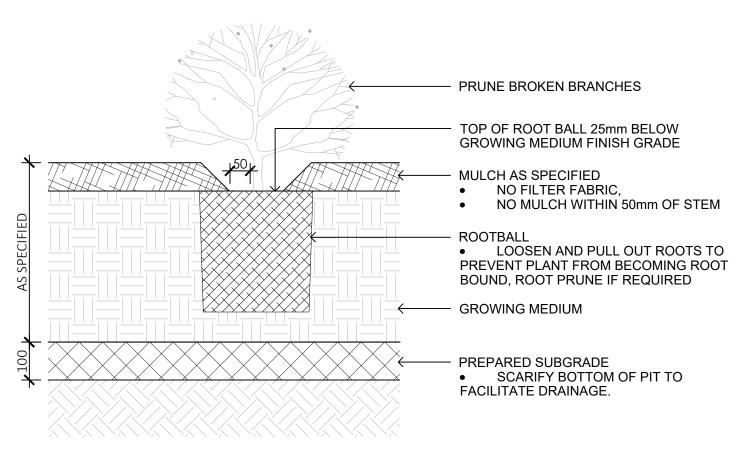

1. SHRUB PLANTING AS PER WRITTEN SPECIFICATIONS 2. GROWING MEDIUM AND MULCH AS PER WRITTEN SPECIFICATIONS

4 SHRUB PLANTING

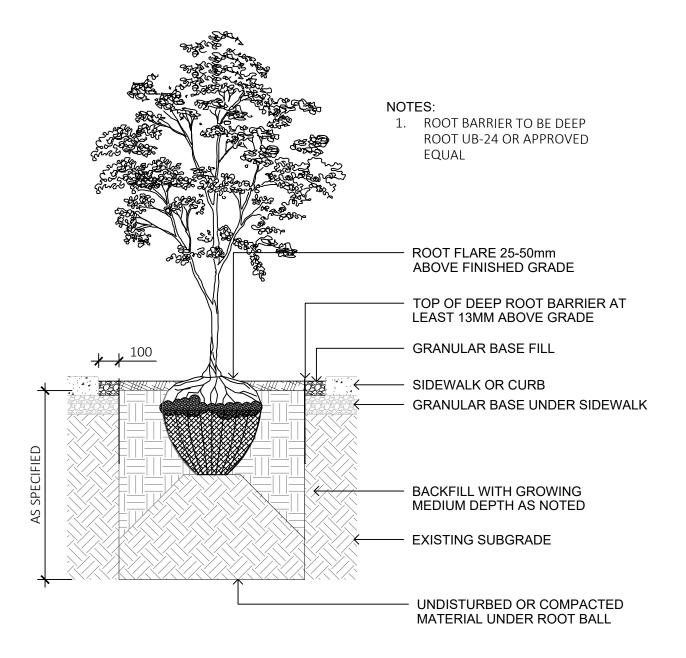

7 ROOT BARRIER / 1:10



1608 Camosun Street, Victoria BC V8T 3E6 Info@biophiliacollective.ca 250 590 1156

PROJECT NAME: THE ESTOYA

PROJECT ADDRESS: 1702 QUADRA STREET VICTORIA, BC

DESIGNED BY: BIANCA BODLEY DRAWN BY: ELIZABETH BALDERSTON


NO.	ISSUED FOR	YY\MM\DD
1	CIS PRESENTATION	12/07/2021
2	DEVELOPMENT PERMIT	12/22/2021
3	ADP MEETING	04/13/2022
4	REVISED AND RE-ISSUED FOR DP	2023/06/01
5	REVISED AND RE-ISSUED FOR DP	2023/09/21
6	REVISED AND RE-ISSUED FOR DP	2023/12/15
7	ISSUED FOR BP RESUBMISSION	2024/04/30
8	ISSUED FOR TENDER	2024/06/28
9	ISSUED FOR BP RESUBMISSION	2024/07/31
10	ISSUED FOR BP RESUBMISSION	2024/09/26
11	ISSUED FOR CONSTRUCTION	2024/10/25
12	ISSUED FOR BP RESUBMISSION	2024/12/18
13	RE-ISSUED FOR CONSTRUCTION	2025/01/22


SEAL

DRAWING TITLE:

PLANTING DETAILS

DWG NO:

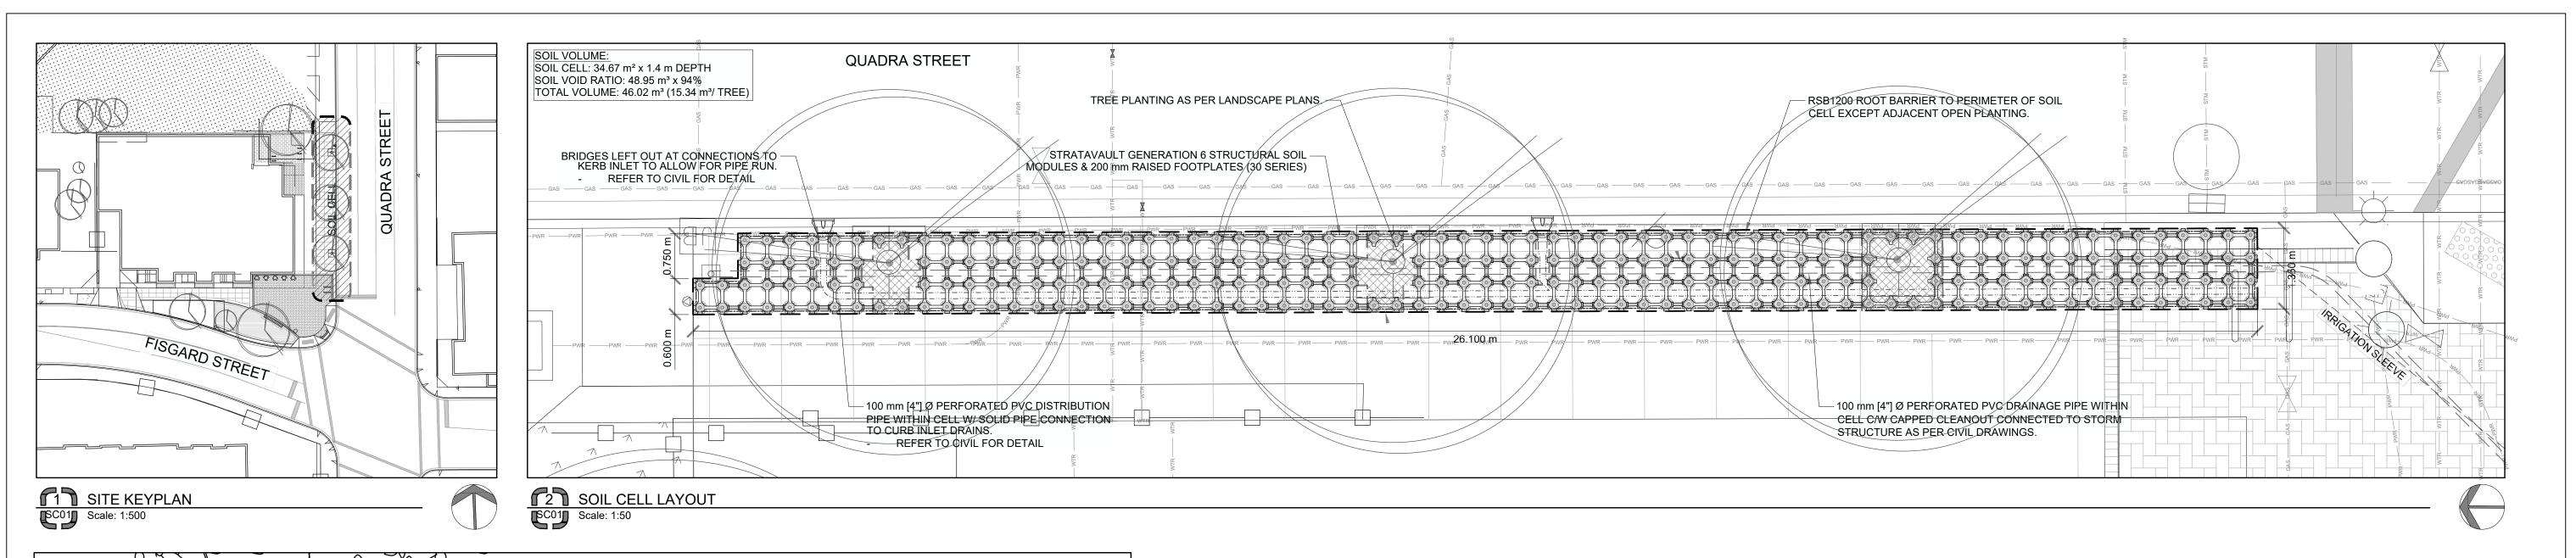

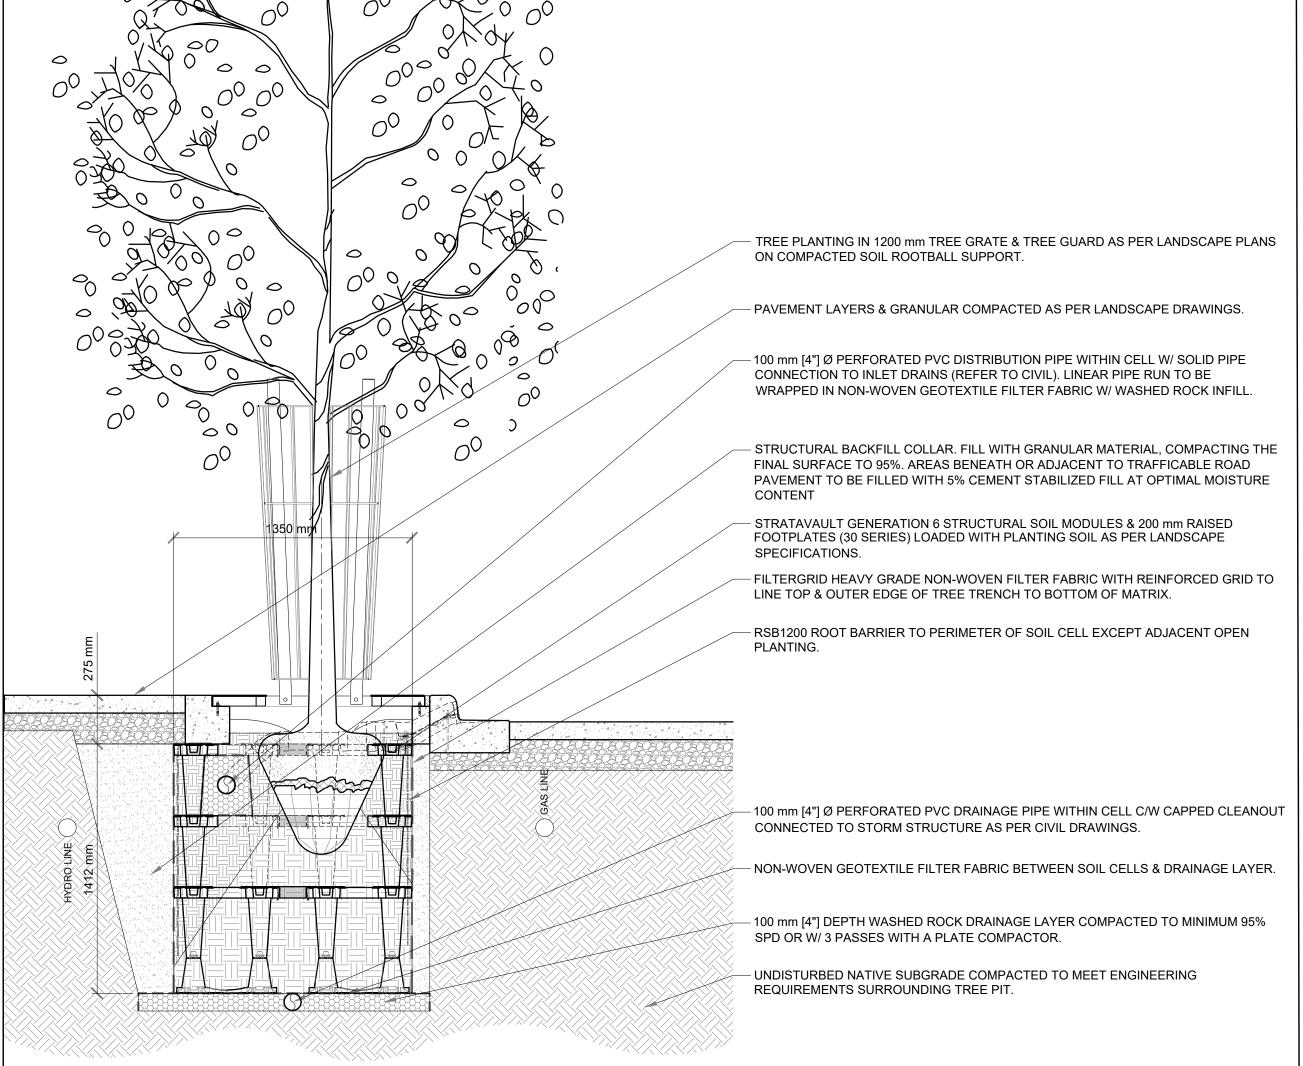

Consultant Drawings:

DS4557 Reference No: Issue# 4

DRAWING TITLE:

1608 Camosun Street, Victoria BC V8T 3E6 Info@biophiliacollective.ca 250 590 1156

PROJECT NAME:

THE ESTOYA

VICTORIA, BC

DESIGNED BY: BIANCA BODLEY DRAWN BY: ELIZABETH BALDERSTON

D. ISSUED FOR

ADP MEETING

CIS PRESENTATION

DEVELOPMENT PERMIT

REVISED AND RE-ISSUED FOR DP

REVISED AND RE-ISSUED FOR DP REVISED AND RE-ISSUED FOR DP

ISSUED FOR BP RESUBMISSION

ISSUED FOR BP RESUBMISSION ISSUED FOR CONSTRUCTION

ISSUED FOR BP RESUBMISSION

3 RE-ISSUED FOR CONSTRUCTION

B ISSUED FOR TENDER

YY\MM\DD

04/13/2022

023/06/01

2024/04/30

2024/06/28

2024/12/18

1702 QUADRA STREET

PROJECT ADDRESS:

STRUCTURAL SOIL CELLS

DWG NO:



Drawn: A.R. Checked: H.L. 2025.06.12 REVISED AS PER COMMENTS Date: 2024.03.04 Approved: T.B. 2024.09.26 REVISED AS PER COMMENTS Scale 1:200, & 1:50 AS SHOWN 2024.07.29 REVISED AS PER COMMENTS 2024.04.29 REVISED AS PER COMMENTS 2024.04.17 ISSUED FOR PRELIMINARY REVIEW Issue Details

1702 QUADRA STREET - VICTORIA

SCO1 Scale: 1:20

NOTES & DISCLAIMERS:
1.Installation to be completed in accordance with manufacturer's specifications. 2.Do not scale drawings.3.These drawings serve to illustrate specified products exclusively, and how they interface with other built elements within These drawings are to be read in conjunction with project specifications and consultant drawing packages.

 Citygreen drawings work off of information created and provided by the principal design lead (engineering or landscape architecture role). Whilst Citygreen makes every effort to maintain accuracy of provided documents and specifications, Citygreen bears no responsibility for design elements beyond defined scope, knowledge of unforeseen site conditions.


W/ CITYGREEN STRATAVAULT GENERATION 6 Drawing Title:
SITE KEYPLAN, SOIL CELL LAYOUT, & SOIL CELL SECTION

TACMACK URBAN FORESTRY

Sheet No. 1 of 1

### CITY OF VICTORIA DOWNTOWN REALM PLAN AND STREETSCAPE STANDARDS - NEW TOWN



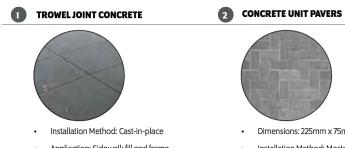

Application: Sidewalk fill and frame

Colour: Natural

Finish: Fine broom finish

 Dimensions: 225mm x 75mm x 60 Installation Method: Mortar set Application: Paving field Colours: Natural greu

 Dimensions: 300mm x 450mm x 60mm Installation Method: Mortar set Finish: Unsealed

Application: Entry banding Colour: Charcoal grey Finish: Flamed

3 BASALT PAVERS



**NEW TOWN PAVING APPLICATIONS** 

1200mm score line pattern perpendicular to the curb with a centre line parallel to the curb 450mm concrete band along curb and building face

 Control joits shall be provided accross 450mm bands every 3rd panel Narrow sidewalks - 2m or less: eliminate 450mm banding along

TROWELIOINTS

STREET NAME BANG -

45° Herringbone field with single row soldier course

continuous 450mm concrete band adjacend to curb with tactile scoring at let down

Installation: Mortar set

**Tactile band** 

BASALT ENTRY BANDING WITH STREET NAME INSERT - - -Pattern: 450mm wide single row soldier course band with larger slab where street name appears Material: Streetname Sandblasted into basalt slabs Font: Tisa Pro Bold, all caps Note: Care should be taken to the letter spacing and kerning

DOWNTOWN PUBLIC REALM PLAN STRATEGY + STREETSCAPE PLAN | 75

# **NEW TOWN PLANTING DETAILS**

APPLICATION For all sidewalks in New Town area there are be two types of trees-in-sidewalk condition:

Adaptation of existing tree locations to sidewalk improvements:


Small modifications of proposed trowel joint pattern are recommended to best accommodate for existing tree locations. Detailed design and recommendations to be provided on a case-by-case basis for each improvement area.

Use of proposed poured-in-place resin bound material instead of tree grates is highly recommended to best accommodate heaving and overgrown tree routes and large tree trunks.

2. New development condition: A street tree spacing of between 8 - 10 metres is desired

Tree grates should be set in a concrete band that runs across the sidewalk from curb to building face as illustrated on the diagram below with trowel joint defining the band always aligned with tree grates Street trees should be sited to correspond with architectural features of building

Typical Tree Pit Detai Soil Cell Option

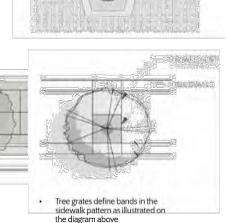

Concrete Sidewalk

2 Curb and Gutter 3 Growing Medium

Structural Growing Medium

Structural Soil Cell

PROJECT NAME: THE ESTOYA PROJECT ADDRESS: 1702 QUADRA STREET VICTORIA, BC

> DESIGNED BY: BIANCA BODLEY DRAWN BY: ELIZABETH BALDERSTON

1608 Camosun Street, Victoria BC V8T 3E6

Info@biophiliacollective.ca 250 590 1156

38 | CITY OF VICTORIA

- OR EQUIVALENT

Fig. 12 Tree Pit Details

# CITY OF VICTORIA NEW TOWN STANDARD DETAILS - SIDEWALKS

SUPPLIER:

SPECIAL NOTES:

74 | CITY OF VICTORIA

Basalt Banding-street name PRODUCT NAME: **INSTALLATION METHOD:** Mortar Set COLOUR/FINISH: **APPLICATION:** DISTRIBUTION:

Basalt Band Natural Broom Finish 450 mm Wide x lenght varies Entry Banding


Bedrock Natural Stone or equivalent See Character area section of Streetscape Standards for specific location guidelines.




**INSTALLATION METHOD:** Mortar set COLOUR/ FINISH: **APPLICATION: DISTRIBUTION:** SUPPLIER: **SPECIAL NOTES:** 


**CONCRETE UNIT PAVER** 

Concrete Unit Paver Natural Grey Unsealed 225mm Width x 75mm Depth x 60mm Thick Paving Field Abbotsford Concrete Products Ltd. or equivalent See Character area section of Streetscape Standards for specific location guidelines.

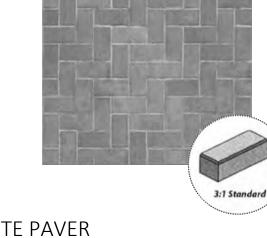


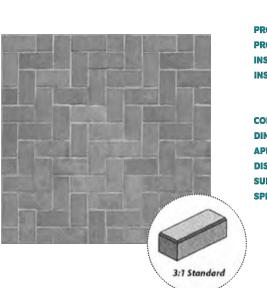



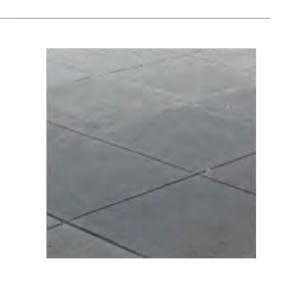



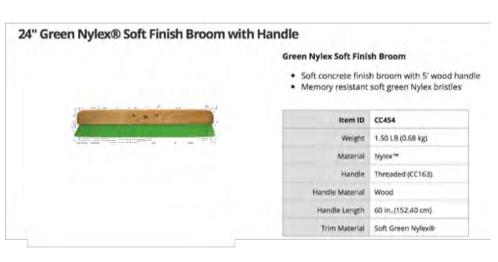

# 2 \ NEW TOWN - BASALT STREET NAME PAVER






TROWEL JOINT CONCRETE

4 \ NEW TOWN - CONCRETE SIDEWALK

# ROMPOX®-D1 The proven paving jointing mortar 2 component epoxy resin paving jointing mortar • for light to medium traffic loads • self compacting • for joint widths from 3 mm | 1/4" • water emulsifiable • for joint depths from 30 mm | 1 % • can be applied to ground temperatures of > 0 °C | > 32 °F





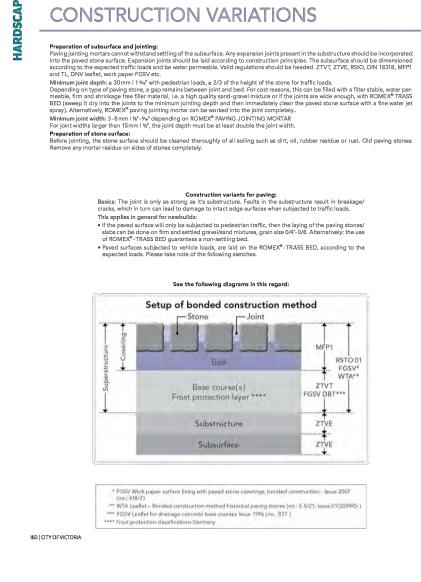



1 CIS PRESENTATION 12/07/2021 2 DEVELOPMENT PERMIT 12/22/2021 04/13/2022 3 ADP MEETING 4 REVISED AND RE-ISSUED FOR DP 2023/06/01 5 REVISED AND RE-ISSUED FOR DP 6 REVISED AND RE-ISSUED FOR DP 2023/12/15 ISSUED FOR BP RESUBMISSION 2024/04/30 8 ISSUED FOR TENDER 2024/06/28 9 ISSUED FOR BP RESUBMISSION 2024/07/31 10 ISSUED FOR BP RESUBMISSION 2024/09/27 11 ISSUED FOR CONSTRUCTION 2024/10/25 12 ISSUED FOR BP RESUBMISSION 2024/12/18 13 RE-ISSUED FOR CONSTRUCTION 2025/01/22

YY\MM\DD

NO. **ISSUED FOR** 

DRAWING TITLE:

MUNICIPAL HARDSCAPE DETAILS

DWG NO:

POMEX

1 NEW TOWN TREE GUARD

**MODERN METAL BIN** PRODUCT TYPE: Type A Litter Bin with Recycling Component Modern Metal Bin **PRODUCT NAME: DESIGN STYLE:** Modern Metal Frame Glossy Black (RAL 9017) Baked-on **COLOUR/ FINISH:** Powder Coat 42" Height **DIMENSIONS: DISTRIBUTION:** Inner Harbour, Old Town, Rock Bay, New Town, Government Street, Douglas Street **MANUFACTURER:** City of Victoria

> See Character area section of Streetscape Standards for specific

location guidelines.

NOTE: INSTALL AS PER MUNICIPAL SPECIFICATIONS

**SPECIAL NOTES:** 

2 NEW TOWN LITTER RECEPTACLE

**STANDARD BIKE RACK** 

PRODUCT TYPE: 2 Capacity Bike Rack Standard Bike Rack Standard

1.5" Galvanized Steel Pipe **MATERIALS:** Glossy Black (RAL 9017) Baked-on **COLOUR/FINISH:** Powder Coat 12" Length, 3' Height **DIMENSIONS:** 

Inner Harbour, Old Town, Rock Bay, New Town, Government Street,


Streetscape Standards for specific


location guidelines.


Douglas Street Sleeve Mount **MANUFACTURER:** City of Victoria See Character area section of

NOTE: INSTALL AS PER MUNICIPAL SPECIFICATIONS

3 NEW TOWN BIKE RACK

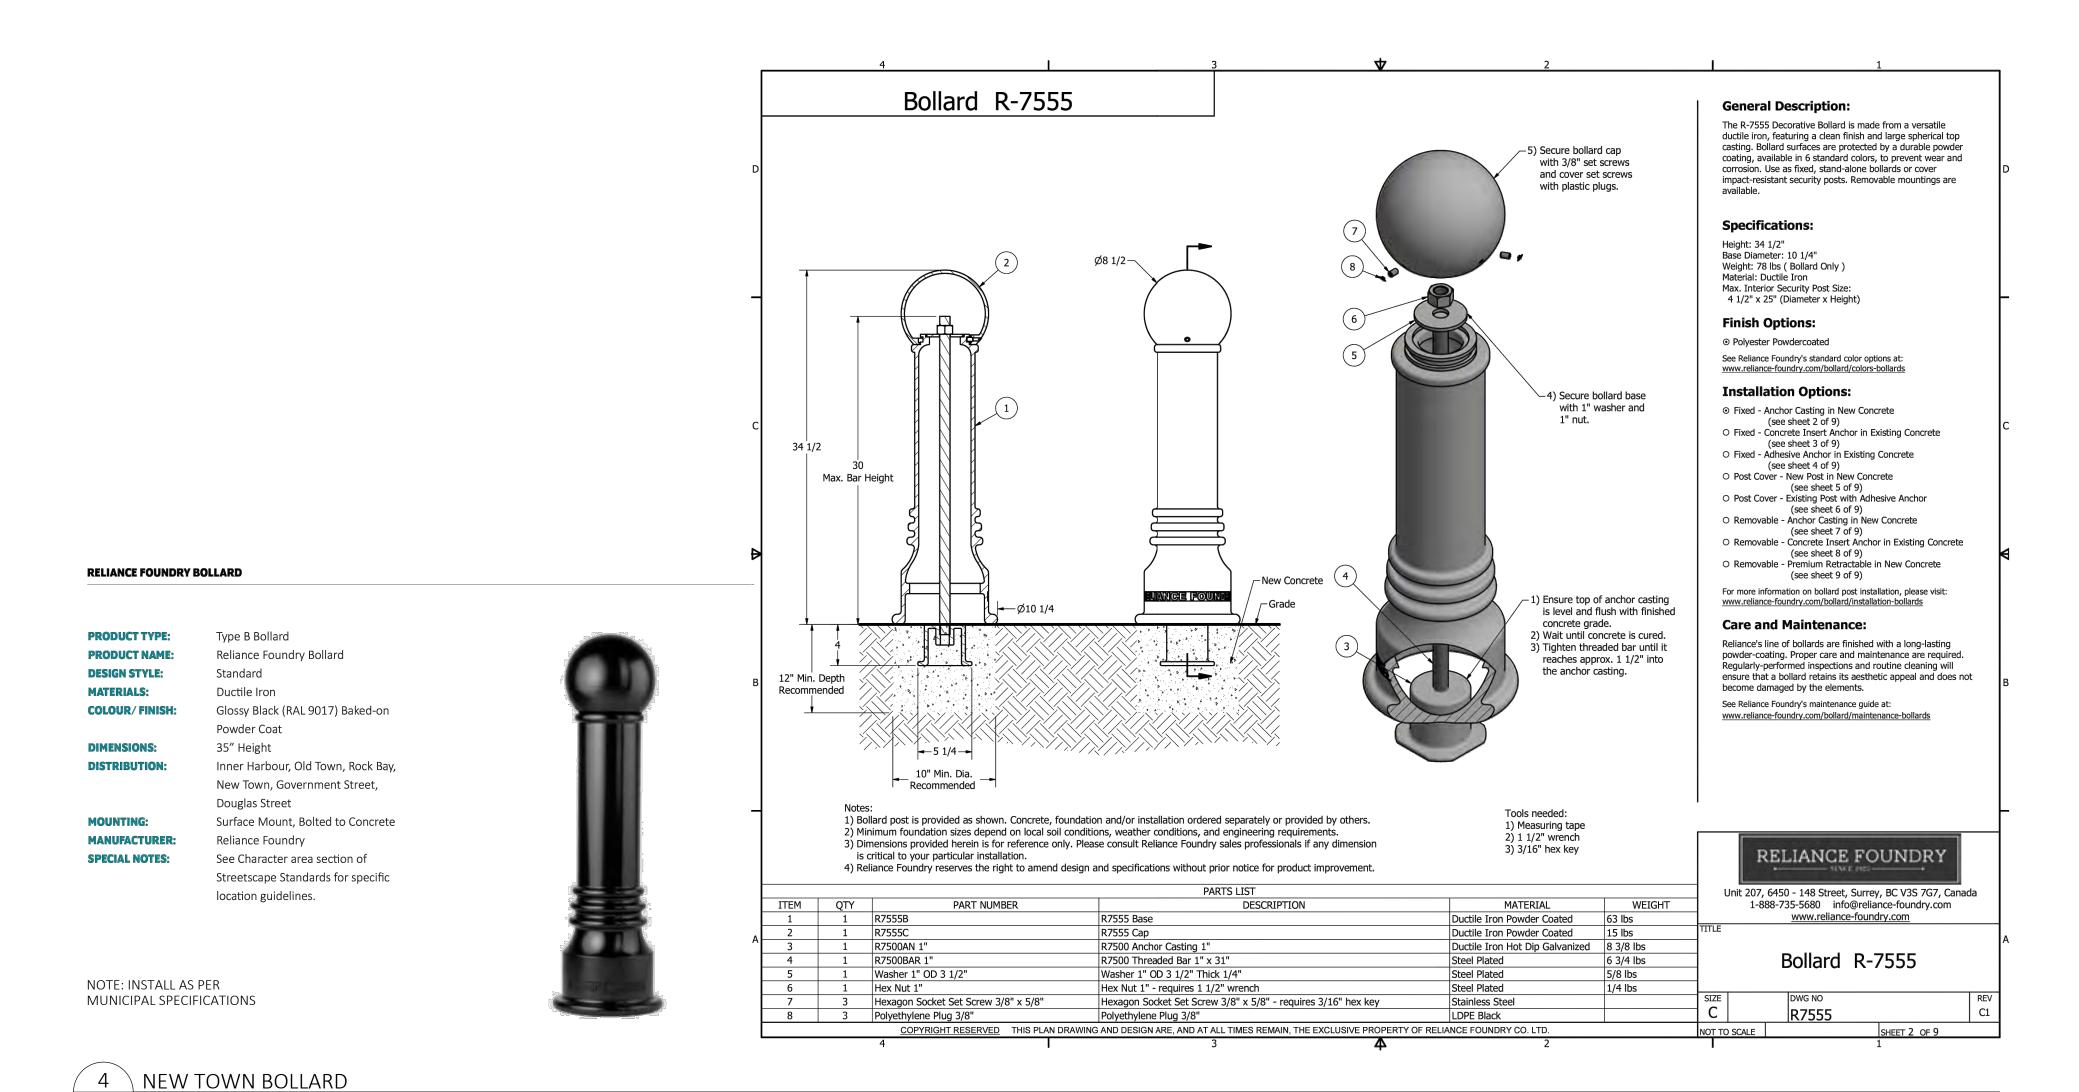

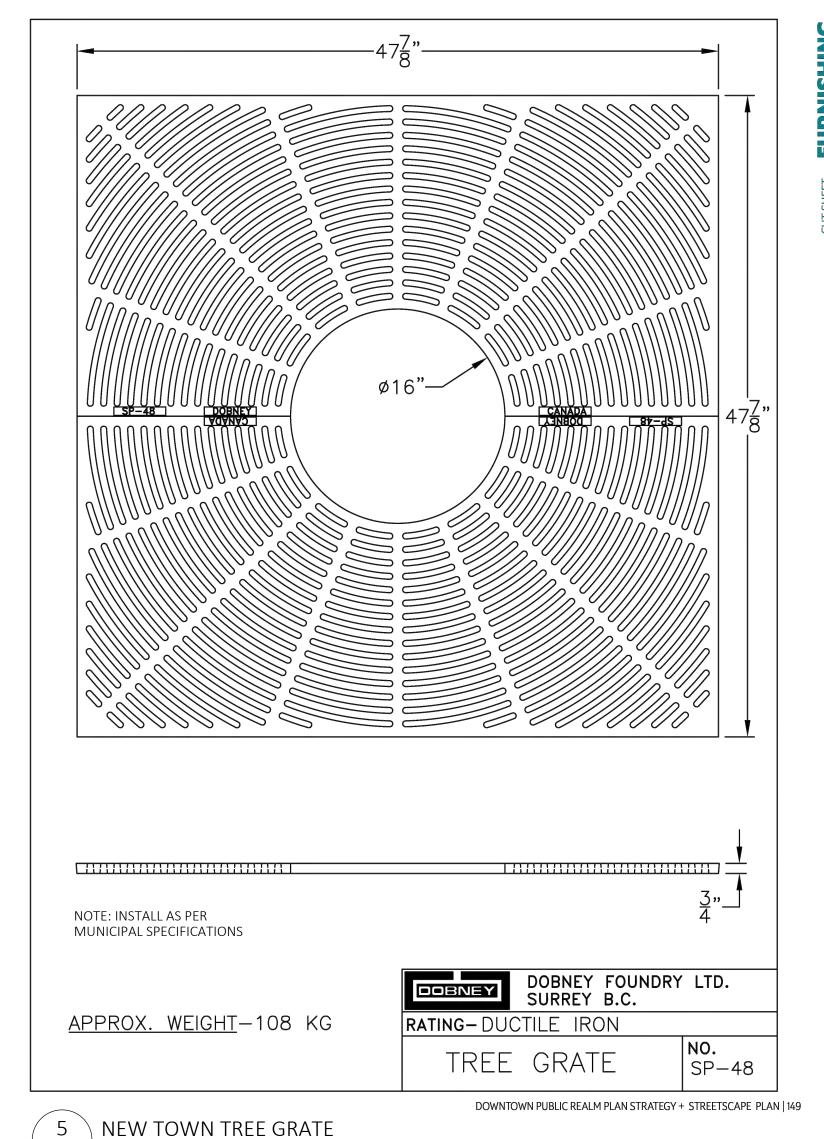

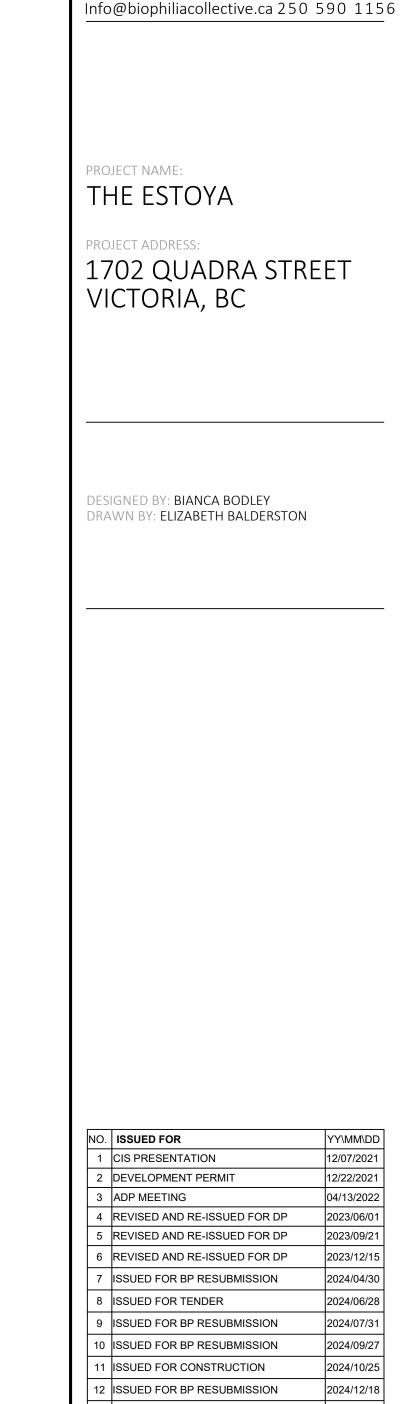


1608 Camosun Street, Victoria BC V8T 3E6


12/07/2021 12/22/2021 04/13/2022 4 REVISED AND RE-ISSUED FOR DP 2023/06/01 REVISED AND RE-ISSUED FOR DP 6 REVISED AND RE-ISSUED FOR DP 2023/12/15 ISSUED FOR BP RESUBMISSION 2024/04/30 2024/06/28 ISSUED FOR BP RESUBMISSION 2024/07/31 10 ISSUED FOR BP RESUBMISSION 2024/09/27 2024/10/25 2 ISSUED FOR BP RESUBMISSION 2024/12/18 13 RE-ISSUED FOR CONSTRUCTION


YY\MM\DD


DRAWING TITLE: MUNICIPAL SITE **FURNITURE DETAILS** 


DWG NO:

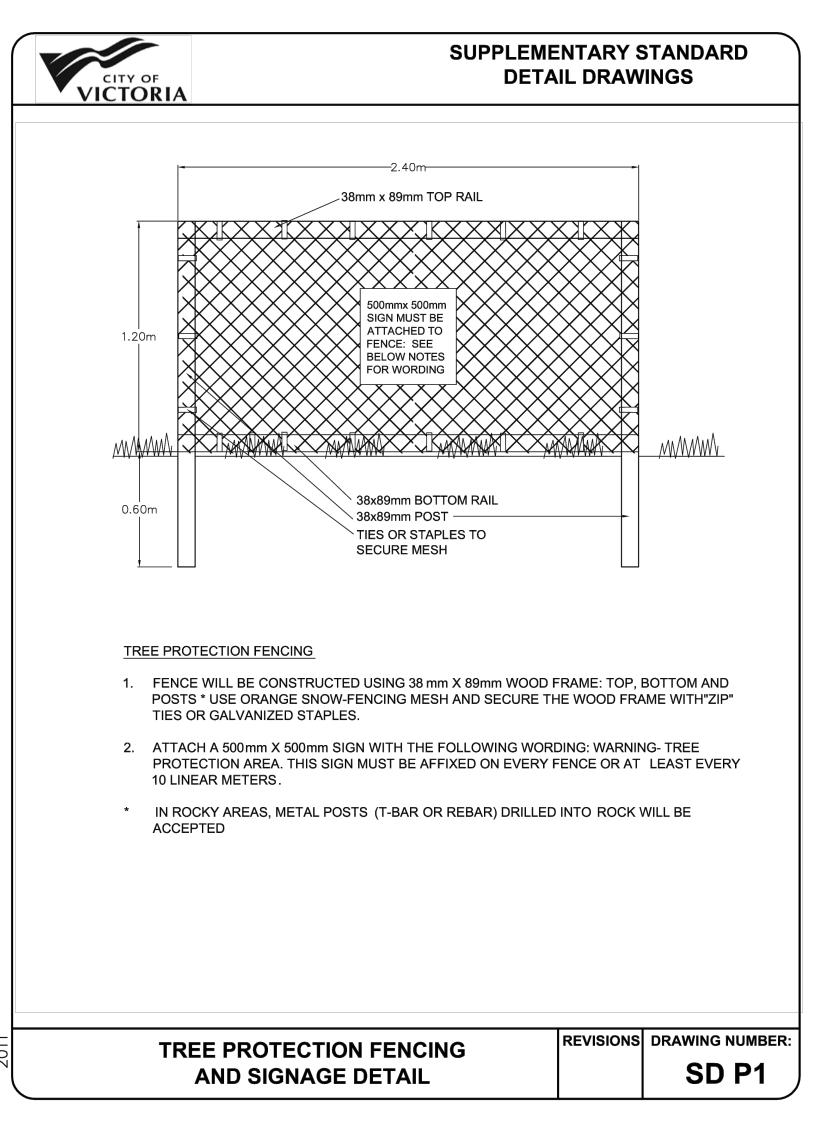

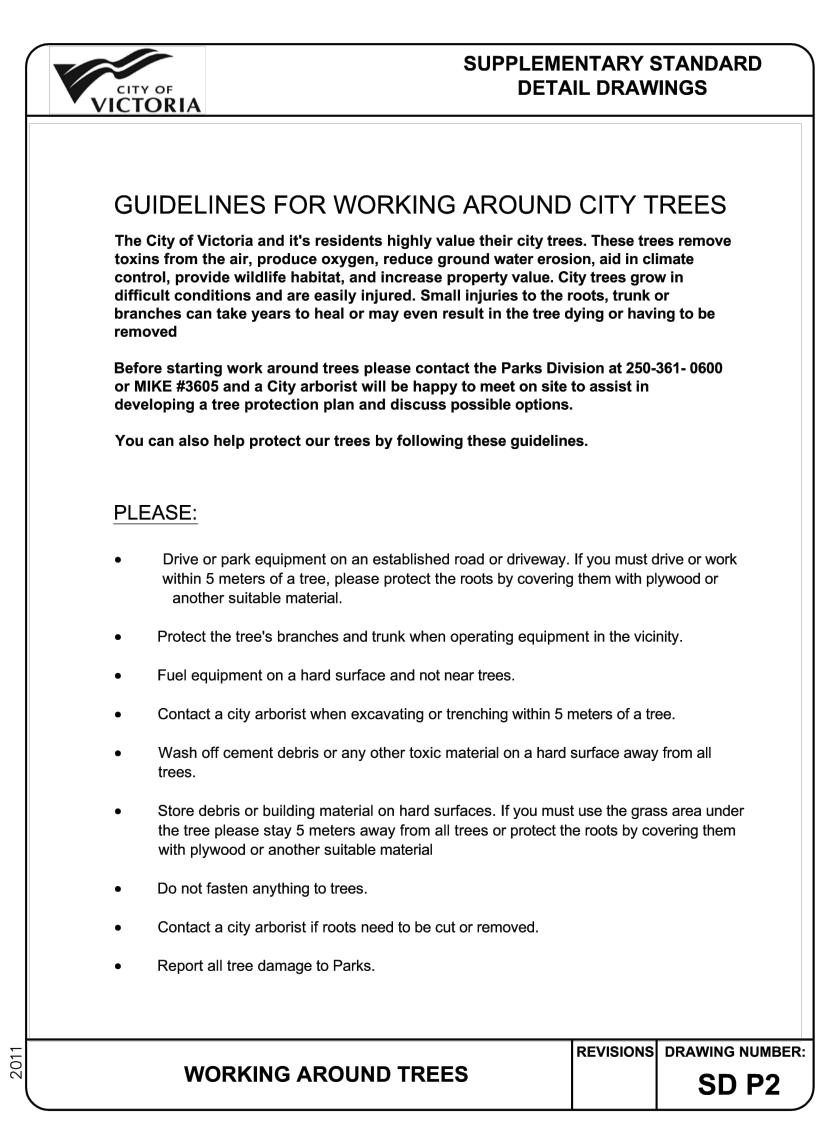


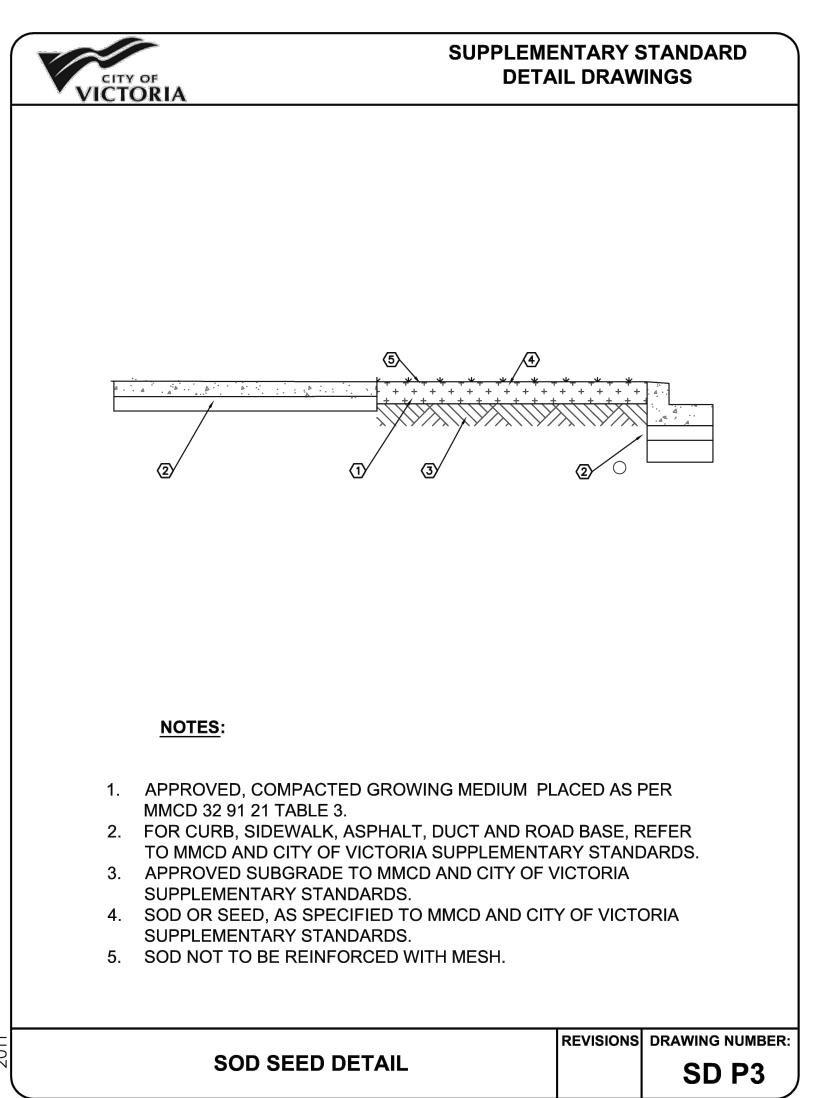


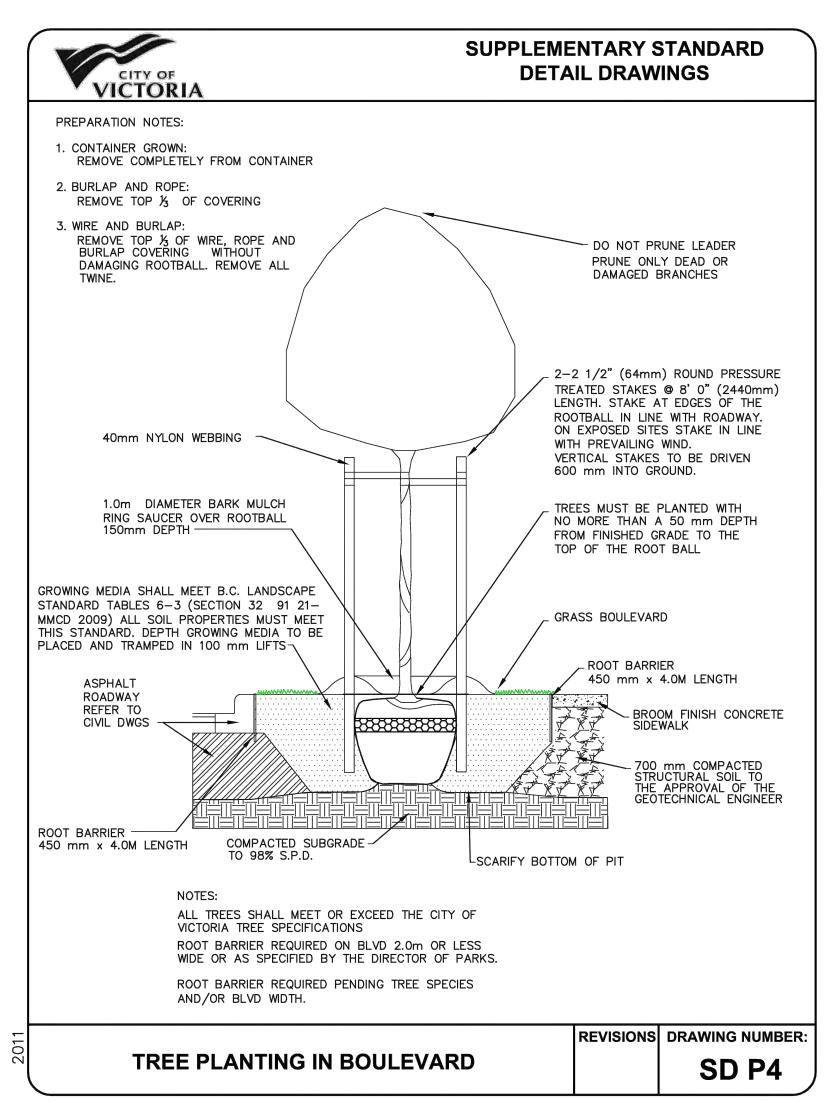

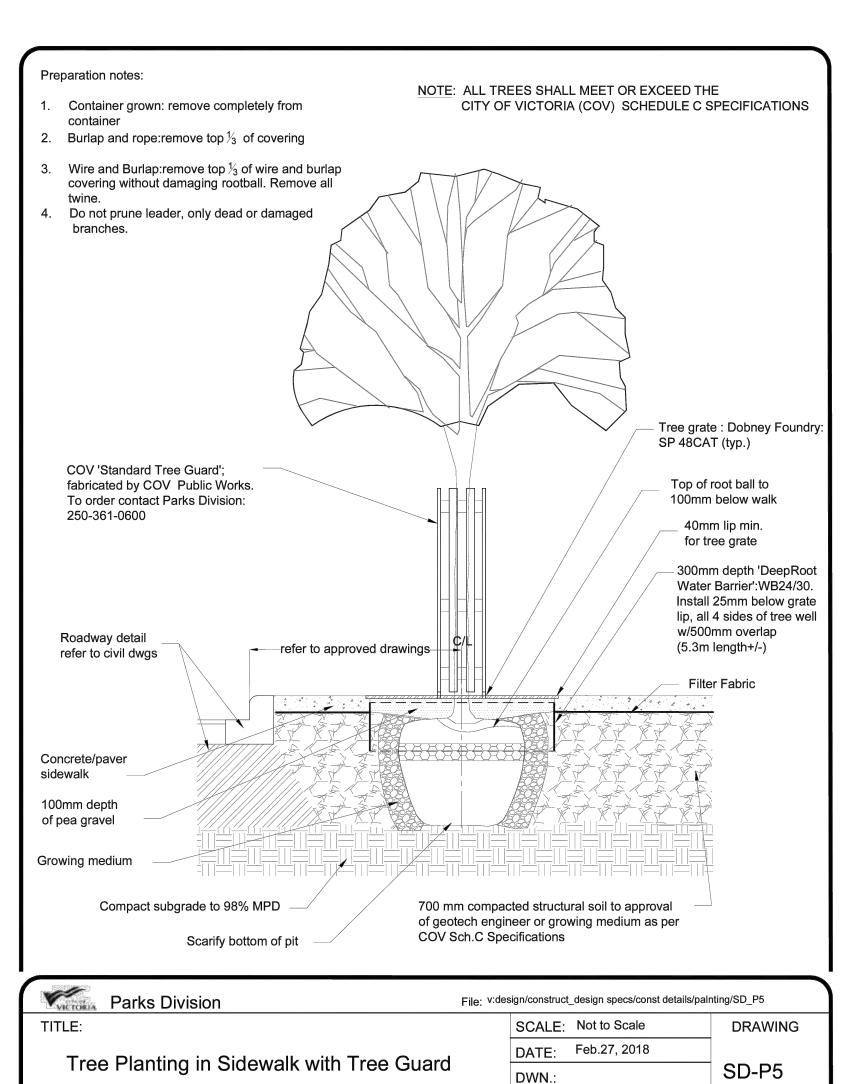

APP'D.:

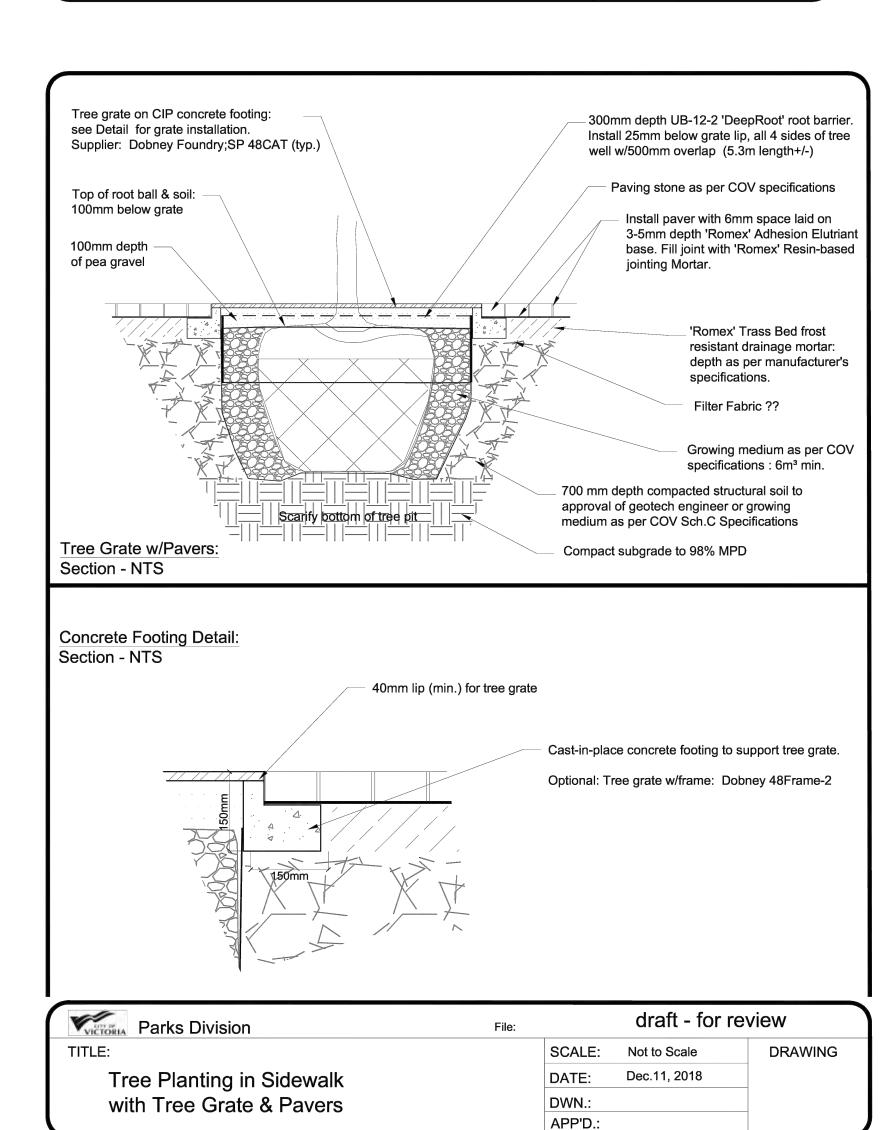

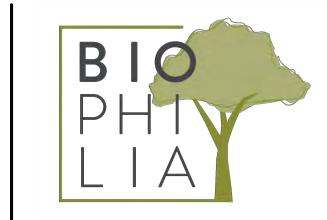

1608 Camosun Street, Victoria BC V8T 3E6
Info@biophiliacollective.ca 250 590 1156

PROJECT NAME:

THE ESTOYA

PROJECT ADDRESS:

1702 QUADRA STREET VICTORIA, BC

DESIGNED BY: BIANCA BODLEY
DRAWN BY: ELIZABETH BALDERSTON

NO.	ISSUED FOR	YY\MM\DD
1	CIS PRESENTATION	12/07/2021
2	DEVELOPMENT PERMIT	12/22/2021
3	ADP MEETING	04/13/2022
4	REVISED AND RE-ISSUED FOR DP	2023/06/01
5	REVISED AND RE-ISSUED FOR DP	2023/09/21
6	REVISED AND RE-ISSUED FOR DP	2023/12/15
7	ISSUED FOR BP RESUBMISSION	2024/04/30
8	ISSUED FOR TENDER	2024/06/28
9	ISSUED FOR BP RESUBMISSION	2024/07/31
10	ISSUED FOR BP RESUBMISSION	2024/09/27
11	ISSUED FOR CONSTRUCTION	2024/10/25
12	ISSUED FOR BP RESUBMISSION	2024/12/18
13	RE-ISSUED FOR CONSTRUCTION	2025/01/22

DRAWING TITLE:

MUNICIPAL LANDSCAPE DETAILS

DWG NO:

SCALE: AS NOTED 6

1608 Camosun Street, Victoria BC V8T 3E6

PROJECT NAME:



PROJECT ADDRESS:

VICTORIA, BC

DRAWN BY: KIM TANG


1702 QUADRA STREET

Info@biophiliacollective.ca 250 590 1156

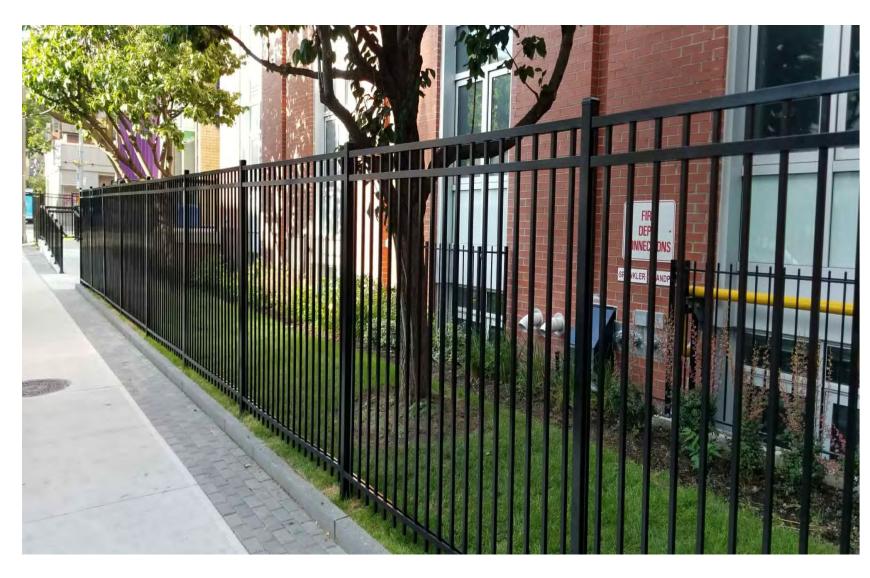

1 6' HT METAL PICKET FENCE

L3 NTS

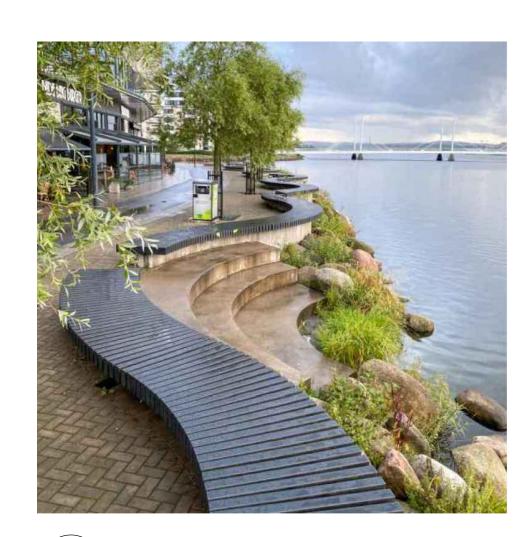

CUSTOM SEAT WALL BENCH

L3 NTS



BELGARD AQUALINE PERMEABLE PAVER

### enhance wheelchair comfort Can be utilized to construct an **♦** AVAILABLE COLOURS

Interlocking spacer bars for increased structural performance

Smooth surface with a microchamfer to minimize vibration and

ADA-compliant pavement True installed dimensions for

Can eliminate stormwater runoff

Meets the requirements of ASTM

and improve water quality

Chamfer Width: 3 mm

joint infill gradation) Surface Open Area: 10%

Spacer Bar Width: 10 mm

Surface Infiltration Rate: > 500 inches per hour (varies based on


Can be installed mechanically

design optimization Optimal joint openings for infiltration and maintenance







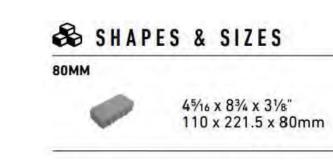

DURAFUSION™ Unmatched Durability

DESIGNED BY: BIANCA BODLEY

### RELIANCE FOUNDRY BOLLARD

L3 NTS

Type B Bollard Reliance Foundry Bollard Ductile Iron

Powder Coat

35" Height Inner Harbour, Old Town, Rock Bay, New Town, Government Street, Douglas Street Surface Mount, Bolted to Concrete

Glossy Black (RAL 9017) Baked-on

Reliance Foundry See Character area section of Streetscape Standards for specific



**MATERIALS: COLOUR/FINISH:** 

**MODERN METAL BIN** 

PRODUCT TYPE:

PRODUCT NAME:

**DESIGN STYLE:** 

**DIMENSIONS:** 


Modern Metal Bin Modern Metal Frame Glossy Black (RAL 9017) Baked-on

Type A Litter Bin with Recycling

Component

Powder Coat 42" Height Inner Harbour, Old Town, Rock Bay, New Town, Government Street,

Douglas Street City of Victoria See Character area section of Streetscape Standards for specific location guidelines.

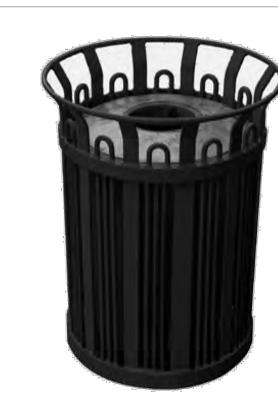

4 NEW TOWN BOLLARD



### STANDARD BIKE RACK


1.5" Galvanized Steel Pipe Glossy Black (RAL 9017) Baked-on

Inner Harbour, Old Town, Rock Bay, New Town, Government Street,

Powder Coat 12" Length, 3' Height

Sleeve Mount See Character area section of Streetscape Standards for specific location guidelines.

Douglas Street

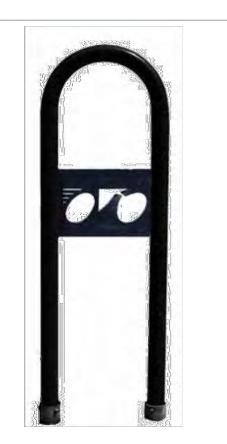

6 NEW TOWN BIKE RACK
L3 NTS






COV PUBLIC WORKS TO ORDER CONTACT PARKS DIVISION: 250-361-0600

TREE GUARD FABRICATED BY

7 NEW TOWN TREE GUARD L3 NTS

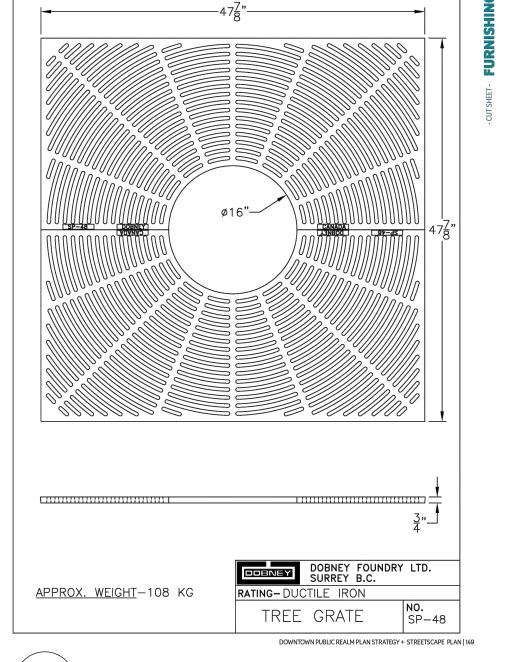

8 NEW TOWN TREE GRATE

L3 NTS

DRAWING TITLE:

LANDSCAPE SITE PLAN

NO. **ISSUED FOR** 

3 ADP MEETING

1 CIS PRESENTATION

2 DEVELOPMENT PERMIT


4 REVISED AND RE-ISSUED FOR DP

5 REVISED AND RE-ISSUED FOR DP

YY\MM\DD

12/07/2021

04/13/2022

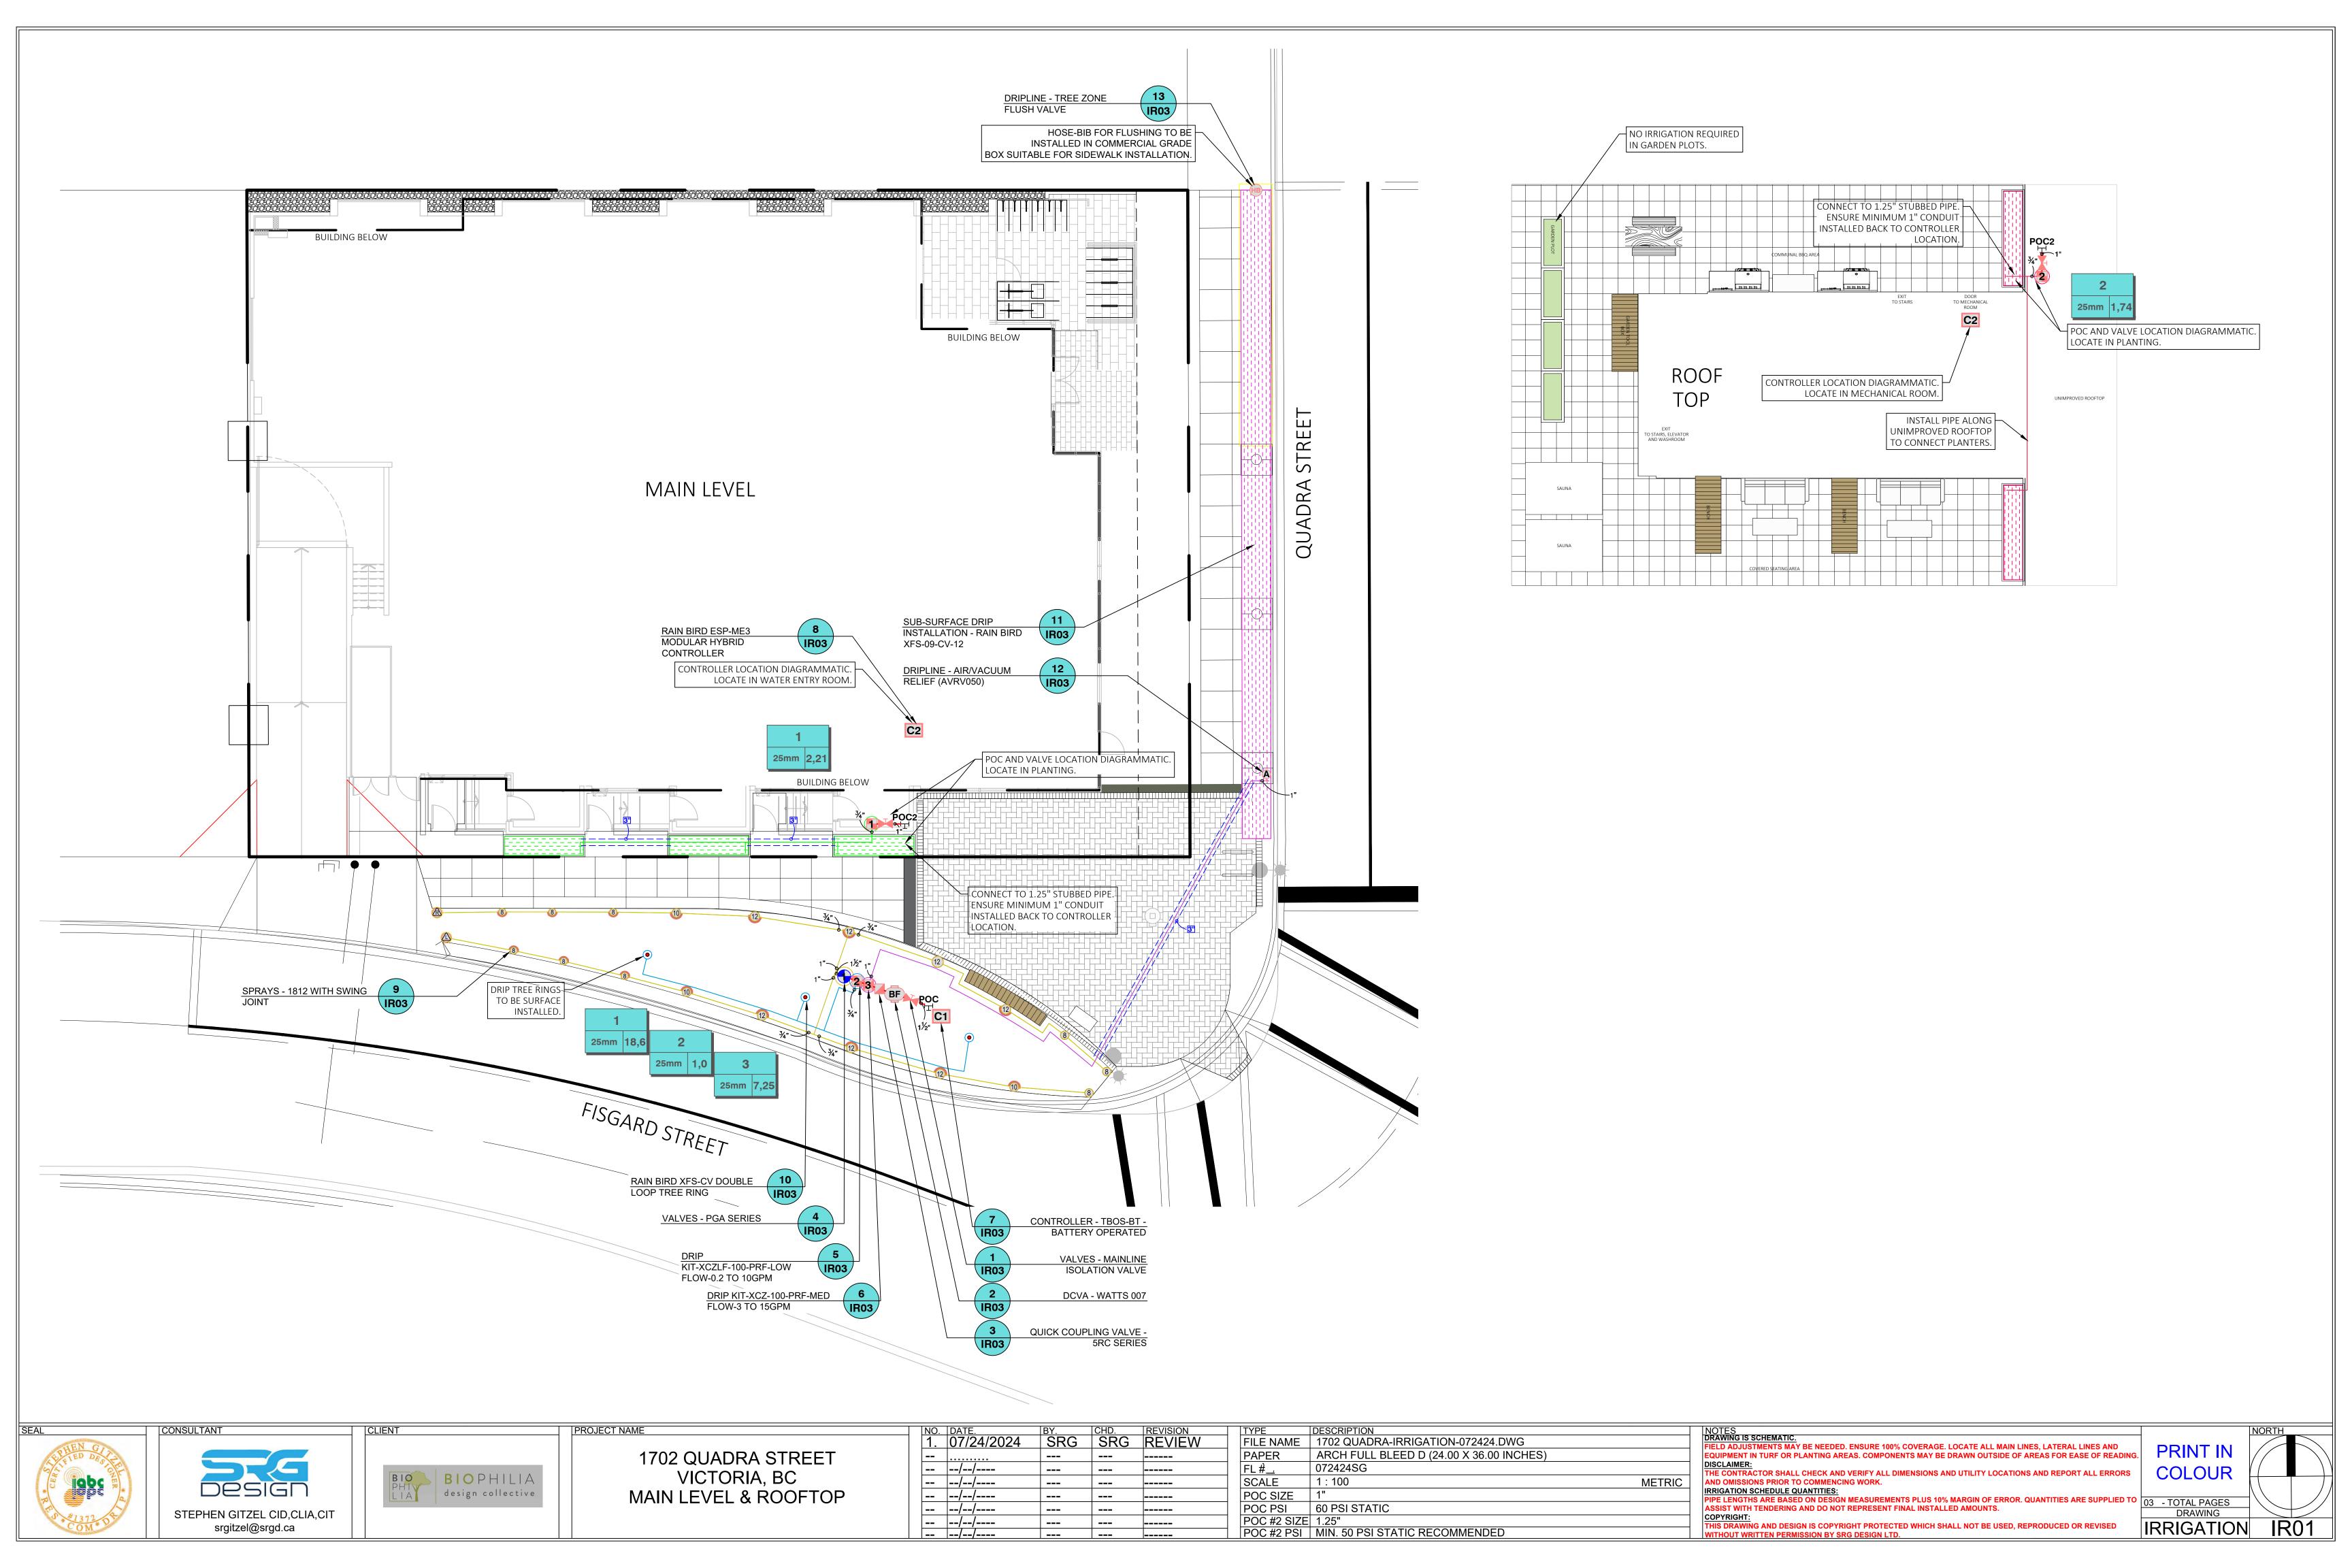

IRRIGATION	SCHEDULE OFF-SITE					
SYMBOL	MANUFACTURER/MODEL	QTY	ARC	PSI	GPM	RADIUS
	RAIN BIRD 1812 C/W MPR NOZZLE 15LCS	1	LCS	30	0,49	1,2x4,6
<u>@</u>	RAIN BIRD 1812 C/W MPR NOZZLE 15RCS	1	RCS	30	0,49	1,2x4,6
8	RAIN BIRD 1812 C/W MPR NOZZLE 08H	6	180	30	0,52	2,4 m
(1)	RAIN BIRD 1812 C/W MPR NOZZLE 10H	3	180	30	0,79	3,0 m
(12)	RAIN BIRD 1812 C/W MPR NOZZLE 12H	6	180	30	1,3	3,7 m
8	RAIN BIRD 1812 C/W MPR NOZZLE 08V	3	ADJ	30	≤ 2,88	2,4 m
12	RAIN BIRD 1812 C/W MPR NOZZLE 12V	1 ADJ 30 ≤ 2,3				3,7 m
SYMBOL	MANUFACTURER/MODEL	QTY				
X	RAIN BIRD XCZ-100-PRF MEDIUM FLOW DRIP CONTROL KIT 25MM	1				
8	RAIN BIRD XCZLF-100-PRF LOW FLOW DRIP CONTROL KIT 25MM	1				
Ą	RAIN BIRD ARV050 13MM	1				
•	RAIN BIRD XFS-CV-09-12 DRIP TREE RING	3				
	AREA TO RECEIVE DRIPLINE RAIN BIRD XFS-CV-09-12 LANDSCAPE DRIPLINE	160 m				
SYMBOL	MANUFACTURER/MODEL	QTY				
	RAIN BIRD PGA ELECTRIC REMOTE CONTROL VALVE 25MM	1				
	RAIN BIRD 5-RC QUICK-COUPLING VALVE 25MM	1				
НВ	HOSE-BIB FLUSH FOR TREE ZONE.	1				
<b>—</b>	ISOLATION VALVE SIZED TO MAIN	1				
BF	WATTS 007 DCVA 25MM	1				
C1	RAIN BIRD TBOS-BT4 BATTERY OPERATED CONTROLLER	1				
POC	POINT OF CONNECTION 1"	1				
	- IRRIGATION LATERAL LINE: PVC CLASS 200 SDR 21 3/4"	80 m	80 m			
	IRRIGATION LATERAL LINE: PVC CLASS 200 SDR 21 1"	36 m				
	- IRRIGATION LATERAL LINE: PVC CLASS 200 SDR 21 1 1/2"	1 m				
	- IRRIGATION MAINLINE: PVC SCHEDULE 40 1 1/2"	6 m				
	PIPE SLEEVE: PVC SCHEDULE 40 - 2X DIAM. OF THE PIPE CARRYING 3"	12 m				

Valve Callout Valve Numbe #" # ● Valve Flow

VALVE SCHEDULE OFF-SITE						
NUMBER	MODEL	SIZE	TYPE	GPM		
1	RAIN BIRD PGA ELECTRIC REMOTE CONTROL VALVE	25mm	SHRUB SPRAY	18,59		
2	RAIN BIRD XCZLF-100-PRF LOW FLOW DRIP CONTROL KIT	25mm	DRIP EMITTER	1,0		
3	RAIN BIRD XCZ-100-PRF MEDIUM FLOW DRIP CONTROL KIT	25mm	AREA FOR DRIPLINE	7,25		

## CRITICAL ANALYSIS OFF-SITE

2024-07-25

Generated:

P.O.C. NUMBER: 01 Water Source Information: 1" POC @ 60PSI FLOW AVAILABLE Point of Connection Size: 25mm Flow Available 19,88 GPM PRESSURE AVAILABLE 60 PSI 60 PSI Static Pressure at POC: Pressure Available: **DESIGN ANALYSIS** 18,59 GPM Maximum Station Flow: Flow Available at POC: 19,88 GPM 1,3 GPM Residual Flow Available: Critical Station: Design Pressure: 30 PSI 0,64 PSI Friction Loss: 0,06 PSI Fittings Loss: 0 PSI Elevation Loss: 7,25 PSI Loss through Valve: Pressure Req. at Critical Station: 37,9 PSI 0,0 PSI Loss for Fittings: Loss for Main Line: 0,01 PSI Loss for POC to Valve Elevation: Loss for Backflow: Critical Station Pressure at POC: 41,0 PSI Pressure Available: Residual Pressure Available: 19,0 PSI

REFERENCE NOTES SCHEDULE OFF-SITE DESCRIPTION ALL IRRIGATION WORK, INCLUDING REQUIRED INSPECTIONS, SHALL FOLLOW THE SUPPLEMENTARY SPECIFICATIONS FOR STREET TREES & IRRIGATION, SCHEDULE C TO THE VICTORIA SUBDIVISION & DEVELOPMENT SERVICING BYLAW 12-042, AND COMPLY WITH HABC STANDARDS. IRRIGATION INSPECTIONS ARE REQUIRED FOR ALL SLEEVING, OPEN TRENCH MAIN LINE AND LATERAL LINES, SYSTEM OPERATION, CONTROLLER AND BACKFLOW PREVENTER (INCL. INSPECTION TAG & TESTING REPORT). CALL PARKS AT 250-361-0600 AT LEAST 2 WORKING DAYS IN ADVANCE TO ARRANGE FOR IRRIGATION INSPECTIONS. IRRIGATION AS-BUILT SUBMITTALS (PDF AND .DWG FILES) COVERAGE ADJUSTMENTS AND DEFICIENCIES TO BE CORRECTED PRIOR TO ACCEPTANCE. 100MM SDR 28 PIPE BE USED FOR IRRIGATION SLEEVING UNDER HARD SURFACES. INSTALLATIONS WHERE A 90-DEGREE BEND IS REQUIRED SHOULD BE INSTALLED USING 100MM SDR 28 GSX (22.5 DEGREE) LONG SWEEPS. PLEASE INSTALL AT 400MM DEPTH. "SLEEVES INSTALLED BY OTHERS"

City of Victoria - Inspection instructions: IRRIGATION SYSTEMS - Tom Sherbo – tsherbo@victoria.ca Irrigation Systems on City property shall comply to City of Victoria Supplementary Specifications for Street Trees and Irrigation Schedule C, Bylaw 12-042, Subdivision Bylaw. Irrigation drawings must be submitted to Parks Division for review and approval 30 days prior to installation work. The following irrigation and sleeving inspections by Parks Staff are required by Schedule C. 1. Irrigation Sleeving prior to backfilling 2. Open trench Main Line and Pressure Test 3. Open trench Lateral Line 4. Irrigation system, Controller, Coverage test, Backflow Preventer Assembly Test Report required, Backflow Assembly is to have an inspection tag completed and attached.

PROJECT NAME

### IRRIGATION SCHEDULE ON-SITE QTY MANUFACTURER/MODEL SYMBOL RAIN BIRD XCZLF-100-PRF LOW FLOW DRIP CONTROL KIT AREA TO RECEIVE DRIPLINE 90 m RAIN BIRD XFS-CV-09-12 LANDSCAPE DRIPLINE QTY SYMBOL MANUFACTURER/MODEL ISOLATION VALVE SIZED TO MAIN C2 RAIN BIRD ESP4ME3 MODULAR CONTROLLER POINT OF CONNECTION 1 1/4" IRRIGATION LATERAL LINE: PVC CLASS 200 SDR 21 3/4" --- --- IRRIGATION MAINLINE: PVC SCHEDULE 40 1" PIPE SLEEVE: PVC SCHEDULE 40 - 2X DIAM. OF THE PIPE CARRYING 3"

Valve Callout Valve Flow Valve Size

VALVE SCHEDULE ON-SITE						
NUMBER	MODEL	SIZE	TYPE	GPM		
1	RAIN BIRD XCZLF-100-PRF LOW FLOW DRIP CONTROL KIT	25mm	AREA FOR DRIPLINE	2,21		
2	RAIN BIRD XCZLF-100-PRF LOW FLOW DRIP CONTROL KIT	25mm	AREA FOR DRIPLINE	1,74		

# CRITICAL ANALYSIS MAIN LEVEL CRITICAL ANALYSIS ROOF TOP

ONTHORE ANALTOID MAIN LEVEL		CITITIONE ANALTOIS ROOF TO		
Generated:	2024-07-25	Generated:	2024-07-25	
P.O.C. NUMBER: 02		P.O.C. NUMBER: 02		
Water Source Information:	1.25" POC @ 50PSI MIN.	Water Source Information:	1.25" POC @ 50PSI MII	
FLOW AVAILABLE		FLOW AVAILABLE		
Point of Connection Size:	32mm	Point of Connection Size:	32mm	
Flow Available	28,64 GPM	Flow Available	28,64 GPM	
PRESSURE AVAILABLE		PRESSURE AVAILABLE		
Static Pressure at POC:	50 PSI	Static Pressure at POC:	50 PSI	
Pressure Available:	50 PSI	Pressure Available:	50 PSI	
DESIGN ANALYSIS		DESIGN ANALYSIS		
Maximum Station Flow:	2,21 GPM	Maximum Station Flow:	1,74 GPM	
Flow Available at POC:	28,64 GPM	Flow Available at POC:	28,64 GPM	
Residual Flow Available:	26,43 GPM	Residual Flow Available:	26,9 GPM	
Critical Station:	1	Critical Station:	2	
Design Pressure:	30 PSI	Design Pressure:	30 PSI	
Friction Loss:	0,04 PSI	Friction Loss:	0,02 PSI	
Fittings Loss:	0 PSI	Fittings Loss:	0 PSI	
Elevation Loss:	0 PSI	Elevation Loss:	0 PSI	
Loss through Valve:	4,76 PSI	Loss through Valve:	4,62 PSI	
Pressure Req. at Critical Station:	34,8 PSI	Pressure Req. at Critical Station:	34,6 PSI	
Loss for Fittings:	0,0 PSI	Loss for Fittings:	0,0 PSI	
Loss for Main Line:	0,01 PSI	Loss for Main Line:	0,0 PSI	
Loss for POC to Valve Elevation:	0 PSI	Loss for POC to Valve Elevation:	0 PSI	
Loss for Backflow:	0 PSI	Loss for Backflow:	0 PSI	
Critical Station Pressure at POC:	34,8 PSI	Critical Station Pressure at POC:	34,6 PSI	
Pressure Available:	50 PSI	Pressure Available:	50 PSI	
Residual Pressure Available:	15,2 PSI	Residual Pressure Available:	15,4 PSI	



CONSULTANT



CLIENT

1702 QUADRA STREET VICTORIA, BC SCHEDULES

NO.	DATE.	BY.	CHD.	REVISION	TYPE	DESCRIPTION	
1.	07/24/2024	SRG	SRG	REVIEW	FILE NAME	1702 QUADRA-IRRIGATION-072424.DWG	
	//				PAPER	ARCH FULL BLEED D (24.00 X 36.00 INCHES)	
	//				FILE#	072424SG	
	//				SCALE	1:100	METRIC
	//				POC SIZE	1"	
	//				POC PSI	60 PSI STATIC	
	//				POC #2 SIZE	1.25"	
	//				POC #2 PSI	MIN. 50 PSI STATIC RECOMMENDED	

FIELD ADJUSTMENTS MAY BE NEEDED. ENSURE 100% COVERAGE. LOCATE ALL MAIN LINES, LATERAL LINES AND EQUIPMENT IN TURF OR PLANTING AREAS. COMPONENTS MAY BE DRAWN OUTSIDE OF AREAS FOR EASE OF READING. DISCLAIMER:
THE CONTRACTOR SHALL CHECK AND VERIFY ALL DIMENSIONS AND UTILITY LOCATIONS AND REPORT ALL ERRORS AND OMISSIONS PRIOR TO COMMENCING WORK.

IRRIGATION SCHEDULE QUANTITIES:
PIPE LENGTHS ARE BASED ON DESIGN MEASUREMENTS PLUS 10% MARGIN OF ERROR. QUANTITIES ARE SUPPLIED TO

OBJECT WITH TENDERING AND DO NOT REPRESENT FINAL INSTALLED AMOUNTS.

DRAWING COPYRIGHT:
THIS DRAWING AND DESIGN IS COPYRIGHT PROTECTED WHICH SHALL NOT BE USED, REPRODUCED OR REVISED WITHOUT WRITTEN PERMISSION BY SRG DESIGN LTD.

COLOUR

PRINT IN

IRRIGATION IR02

NORTH

