

Mixed Use Seniors Residential & Commercial Development

829-899 Fort Street & 846-856 Broughton Street, Victoria, B.C.

parc
retirement
living

PACIFIC ARBOUR SIX RESIDENCES LTD

bfa studio
architects

ECO-REGIONAL ARCHITECTURE + INTERIOR DESIGN

(Formerly BESHARAT FRIARS ARCHITECTS)

600 - 355 Burrard Street T 604 662 8544
Vancouver, BC V6C 2G8 F 604 662 4060
www.bfastudioarchitects.com



Revisions

Bubbled areas indicate revisions
compared to the previously
submitted plans

Received Date:
March 2, 2022



ABBREVIATIONS LEGEND					
A.F.F.	ABOVE FINISHED FLOOR	MTL	METAL	ENCL	ENCLOSURE
A.B.	AIR BARRIER	NA	NOT APPLICABLE	EG.	EQUAL
ALUM.	ALUMINIUM	N.I.C.	NOT IN CONTRACT	EXT.	EXTERIOR
BS	BASEMENT	N.T.S.	NOT TO SCALE	F.D.	FLOOR DRAIN
BD	BOARD	O.C.	ON CENTRE	FDN	FOUNDATION
B.O.S.	BOTTOM OF SLAB	OPG.	OPENING	FIN.	FINISH
B.O.W.	BOTTOM OF WALL	P.A.S.	PEEL & STICK	FLR.	FLOOR
BLDG.	BUILDING	PLYWD.	PLYWOOD	FTG.	FOOTING
C.B.	CATCH BASIN	PREFIN.	PRE-FINISHED	GA.	GALVE
C.F.P.	CAST-IN-PLACE	P.T.	PRESSURE TREATED	GL	GLASS
CUS.	CHALKING	PL	PROPERTY LINE	GR.	GRADE
CL.	CENTRE LINE	R.	RADIUS	GNB	GYPSUM WALLBOARD
CL	CENTRE LINE	R.	RISER	H.C.	HANDICAPPED
C.W.	COMPLETE WITH	R.W.L.	RAIN WATER LEADER	HT.	HEIGHT
CONC.	CONCRETE	REQD.	REQUIRED	HORIZ.	HORIZONTAL
CONT.	CONTINUOUS	REV	REVISION	H.B.	HORE BIB
CJ	CONTROL JOINT	R & S	ROD & SHELF	HR.	HOUR
CORR.	CORROSION	R/L	ROOF DRAIN	HWH	HOT WATER HEATER
CL.	DIAMETER	R.D.	ROUGH DRAIN	UNL	UNDER
DN	DOWN	R.O.	ROUGH OPENING	MAX.	MAXIMUM
DWS	DRAWINGS	STL	STEEL	MECH.	MECHANICAL
DW	DISHWASHER	STRUCT.	STRUCTURAL	MEZZ.	MEZZANINE
ELECT.	ELECTRICAL	SPEC	SPECIFICATION	MIN.	MINIMUM
ELEV	ELEVATION	SF	SQUARE FEET	MISC.	MISCELLANEOUS
				WR	WASHROOM

PROJECT / CONSULTANT TEAM						
ARCHITECT	LAND SURVEYOR	LANDSCAPE ARCHITECT	COMMUNITY ENGAGEMENT	STRUCTURAL ENGINEER	MECHANICAL ENGINEER	ELECTRICAL ENGINEER
BESHARAT FRIARS ARCHITECTS #600 - 355 BURRARD ST. VANCOUVER, BC TEL: 604.662.8544	BRAD CUNNING LAND SURVEYOR #101-2610 DOUGLAS ST. VICTORIA, BC TEL: 250.381.2257	PWL PARTNERSHIP LANDSCAPE ARCHITECTS INC. 500-1201 WEST PENDER ST. VANCOUVER, BC TEL: 604.688.6111	MARZOLF & ASSOCIATES STRATEGIC COMMUNICATIONS ULC 2687 YORK AVE. VANCOUVER, BC TEL: 604.742.3211	RJC ENGINEERS 300-1285 WEST BROADWAY VANCOUVER, BC TEL: 604.738.0048	AME GROUP 721 JOHNSON ST. VICTORIA, BC TEL: 604.585.9381	AES ENGINEERING #300 - 1815 BLANSHARD ST. VICTORIA, BC TEL: 250.381.5121
GEOTECHNICAL ENGINEER	CODE CONSULTANT	TRAFFIC CONSULTANT	CIVIL ENGINEER	WIND CONSULTANT	ENVIRONMENTAL ENGINEER	LEED CONSULTANT
RYZLIK GEOTECHNICAL 28 CREASE AVE. VICTORIA, BC TEL: 250.475.3131	LMDC BUILDING CODE CONSULTANTS LTD. 4th FLOOR - 780 BEATTY ST. VANCOUVER, BC TEL: 604.682.7146	BUNT & ASSOCIATES #421 - 645 FORT ST. VICTORIA, BC TEL: 604.685.9381	J.E. ANDERSON & ASSOCIATES 4212 GLANFORD AVENUE VICTORIA, BC TEL: 250.727.2214	ROWAN WILLIAMS DAVIES & IRWIN 650 WOODLAWN ROAD WEST QUELPH, ON TEL: 919.823.1311	ACTIVE EARTH ENGINEERING LTD. #160-2250 BOUNDARY ROAD BURNABY, BC TEL: 778.866.0064	MORRISON HERSHFIELD #310-4321 STILL CREEK DRIVE BURNABY, BC TEL: 604.454.0402

ARCHITECTURAL DRAWING INDEX	
A000 PROJECT STATISTICS / CODE ANALYSIS SUMMARY A001 ZONING DATA A002 PROJECT STATISTICS A003 PROJECT STATISTICS A004 AREA DIAGRAMS A005 COMPARISON DIAGRAM - LEVEL 1 A006 3D PERSPECTIVES A007 3D PERSPECTIVES A008 3D PERSPECTIVES A009 3D PERSPECTIVES A010 FORM OF DEVELOPMENT - MASSING A011 FORM OF DEVELOPMENT - STREETScape A012 FORM OF DEVELOPMENT - MAIN LEVEL SETBACKS A013 FORM OF DEVELOPMENT - TYPICAL LEVEL SETBACKS A014 FORM OF DEVELOPMENT - ENVELOPE / PASSIVE DESIGN STRATEGIES A100 AERIAL A101 CONTEXT PLAN A102 CONTEXT 3D VIEWS A103 CONTEXT 3D VIEWS A104 CONTEXT 3D VIEWS A200 P2 LEVEL FLOOR PLAN A201 P1 LEVEL FLOOR PLAN A202A SITEPLAN / LEVEL 1 FLOOR PLAN A202B SITEPLAN / LEVEL 1 FLOOR PLAN A203 MECHANICAL LEVEL FLOOR PLAN A204 LEVEL 2 FLOOR PLAN A205 LEVEL 3 FLOOR PLAN A206 LEVEL 4 FLOOR PLAN A207 LEVEL 5 FLOOR PLAN A208 LEVEL 6 FLOOR PLAN A209 LEVEL 7 FLOOR PLAN A210 LEVEL 8 FLOOR PLAN A211 LEVEL 9 FLOOR PLAN A212 LEVEL 10 FLOOR PLAN A213 ROOF PLAN A300A P2 LEVEL PARTIAL FLOOR PLAN A300B P2 LEVEL PARTIAL FLOOR PLAN A300C P2 LEVEL PARTIAL FLOOR PLAN A301A P1 LEVEL PARTIAL FLOOR PLAN A301B P1 LEVEL PARTIAL FLOOR PLAN A301C P1 LEVEL PARTIAL FLOOR PLAN A302A LEVEL 1 PARTIAL FLOOR PLAN A302B LEVEL 1 PARTIAL FLOOR PLAN A302C LEVEL 1 PARTIAL FLOOR PLAN A401 NORTH ELEVATION A402 EAST ELEVATION A403 SOUTH ELEVATION A404 NORTH ELEVATION A405 EAST ELEVATION A406 SOUTH ELEVATION A407 FORT (NORTH) STREETScape / PARTIAL SECTION A408 FORT (NORTH) STREETScape / PARTIAL SECTION A409 FORT (NORTH) STREETScape / PARTIAL SECTION	A410 FORT (NORTH) STREETScape / PARTIAL SECTION A411 QUADRA (EAST) STREETScape / PARTIAL SECTION A412 QUADRA (EAST) STREETScape / PARTIAL SECTION A413 QUADRA (EAST) STREETScape / PARTIAL SECTION A414 BROUGHTON (SOUTH) STREETScape / PARTIAL SECTION A415 BROUGHTON (SOUTH) STREETScape / PARTIAL SECTION A501 BUILDING SECTION A A502 BUILDING SECTION B A503 BUILDING SECTION C A504 BUILDING SECTION D A505 BUILDING SECTION E / INTERNAL WEST ELEVATION / WEST ELEVATION A506 BUILDING SECTION F / INTERNAL EAST ELEVATION A507 BUILDING SECTION G A508 BUILDING SECTION H / INTERNAL WEST ELEVATION A509 BUILDING SECTION J A510 BUILDING SECTION K O01 LEVEL 1 AREA OVERLAY O02 MECHANICAL LEVEL AREA OVERLAY O03 LEVEL 2 AREA OVERLAY O04 LEVEL 3 AREA OVERLAY O05 LEVEL 4 AREA OVERLAY O06 LEVEL 5 AREA OVERLAY O07 LEVEL 6 AREA OVERLAY O08 LEVEL 7 AREA OVERLAY O09 LEVEL 8 AREA OVERLAY O10 LEVEL 9 AREA OVERLAY O11 LEVEL 10 AREA OVERLAY O12 ROOF AREA OVERLAY SH01 SHADOW ANALYSIS SH02 SHADOW ANALYSIS SURVEY DRAWING
REISSUED FOR REZONING & DP 24 NOVEMBER 2021	

[illegible]

AREA CALCULATIONS SUMMARY / SF

A	B	C	D=BxC	E	F	G	H	I	J	K	L	M	N	O=L+M+N	P	Q=E+F	R	S	T	U	V	W	X	Y=U+V+W+X	Z=S-Y	
																				EXCLUSION						
	NUMBER OF FLOORS	UNIT COUNT	UNIT COUNT SUB TOTAL	NET COMMERCIAL (SF)	N/A	CHILD CARE (SF)	MEDICAL OFFICES (SF)	MEDICAL WASHROOMS	PARKING / LOADING / MECHANICAL LEVEL (SF)	COMM. GARBAGE/ RECYCLING & SERVICE RM (SF)	RES. GARBAGE/ RECYCLING & SERVICE RM (SF)	AMENITY (SF)	NET RESIDENTIAL UNITS (SF)	TOTAL RESIDENTIAL INC. RES GARBAGE/RECYCLING AREA/ FLOOR (SF)	TOTAL RESIDENTIAL AREA/ FLOOR (SM)	TOTAL COMM. AREA/ FLOOR (SF)	TOTAL COMM. AREA/ FLOOR (SM)	TOTAL GROSS (SF)	TOTAL GROSS (SM)	PARKING / LOADING (SF)	WALL THICKNESS (SF)	ASSUMED ELEVATOR SHAFTS (SF)	BICYCLE STORAGE (SF)	TOTAL EXCLUSIONS (SF)	TOTAL FSR (SF)	TOTAL FSR (SM)
MAIN LEVEL	1	0	0	9,695	0	215	215	0	13,760	386	944	16,279	0	17,223	1,600	9,695	901	49,356	4,585	13,760	484	546	252	15,042	34,314	3,188
PARTIAL MECHANICAL	0	0	0	0	0	0	0	0	4,977	0	0	0	0	0	0	0	0	4,977	462	0	322	0	0	322	4,655	432
LEVEL 2	1	16	16	0	0	3,501	2,612	440	0	0	0	17,225	11,442	28,667	2,663	0	0	41,693	3,873	0	657	546	0	1,203	40,490	3,762
LEVEL 3	1	41	41	0	0	0	0	0	0	0	0	0	27,577	27,577	2,562	0	0	33,581	3,120	0	905	433	0	1,338	32,243	2,995
LEVEL 4	1	40	40	0	0	0	0	0	0	0	0	294	26,690	26,984	2,507	0	0	32,851	3,052	0	900	433	0	1,333	31,518	2,928
LEVEL 5	1	40	40	0	0	0	0	0	0	0	0	0	26,863	26,863	2,496	0	0	32,851	3,052	0	900	433	0	1,333	31,518	2,928
LEVEL 6	1	40	40	0	0	0	0	0	0	0	0	0	26,862	26,862	2,496	0	0	32,851	3,052	0	900	433	0	1,333	31,518	2,928
LEVEL 7	1	34	34	0	0	0	0	0	0	0	0	0	22,902	22,902	2,128	0	0	28,807	2,676	0	904	433	0	1,337	27,470	2,552
LEVEL 8	1	25	25	0	0	0	0	0	0	0	0	982	16,294	17,276	1,605	0	0	21,950	2,039	0	850	433	0	1,283	20,667	1,920
LEVEL 9	1	25	25	0	0	0	0	0	0	0	0	0	16,516	16,516	1,534	0	0	20,938	1,945	0	809	433	0	1,242	19,696	1,830
LEVEL 10	1	19	19	0	0	0	0	0	0	0	0	0	12,192	12,192	1,133	0	0	16,092	1,495	0	657	433	0	1,090	15,002	1,394
ROOFTOP SERVICE ROOMS	1	0	0	0	0	0	0	0	0	0	0	0	0	0	0	0	0	3,506	326	0	344	433	0	777	2,729	254
TOTAL			280	9,695	0	3,716	2,827	440	18,737	386	944	34,780	187,338	223,062	20,723	9,695	901	319,453	29,678	13,760	8,631	4,989	252	27,632	291,821	27,111
SITE AREA:		55,585	SF	5,164				3,267																		
TOTAL FSR:		291,821	SF	5,25																						
				901	SM	345	263	41	1,741	36	88	3,231	17,404													
								304																		

OFF STREET PARKING SUMMARY

	RATE/REQUIRED/BYLAW	PROVIDED	NOTES
RETAIL / PERSONAL SERVICE	1 PER 80 SM (861 SF)	11	PROVIDED ON P1 LEVEL
INDEPENDENT SENIORS UNITS	0.35 PER UNIT	93	
INDEPENDENT SENIORS UNITS-VISITORS	0.1 PER UNIT	27	
AFFORDABLE UNITS	0.2 PER UNIT	3	
AFFORDABLE UNITS-VISITORS	0.1 PER UNIT	1	
CHILD CARE	1 PER 100 SM (1076 SF)	3	ASSUMED & PROVIDED ON P1 LEVEL
MEDICAL OFFICES	1 PER 50 SM (538 SF)	6	BASED ON NET 3,272 SF. PROVIDED ON P1 LEVEL
CAFÉ	1 PER 40 SM (430.5 SF)	4	SOUTHEAST CORNER OF P1 LEVEL
ADDITIONAL PARKING STALLS		59	PROVIDED ON P1 LEVEL
TOTAL		144	
SCOOTER STALLS		0	PROVIDED ON LEVEL 1 FOR SENIORS SAFETY & CONVENIENCE

OFF STREET BICYCLE PARKING SUMMARY

	AREA	LONG TERM BICYCLE SPACES	SHORT TERM BICYCLE SPACES	NOTES
		REQUIRED/BYLAW SUPPLY	PROVIDED	
RETAIL	901 SM	1 PER 200 SM 5	5	1 PER 200 SM 5
INDEPENDENT SENIORS UNITS	268 UNIT S	1 PER 20 UNITS 13	13	1 PER 50 UNITS 5
AFFORDABLE UNITS	14 UNIT S	10	10	0.1/UNIT OR 6 2
CHILD CARE	345 SM	1 PER 700 SM 1	1	1 PER 200 SM 2
MEDICAL OFFICE	304 SM	1 PER 200 SM 2	2	1 PER 300 SM 1
ADDITIONAL BICYCLE STALLS		0	23	0
TOTAL		31	54	15

PARKING STALL SUMMARY

	2	SF	28 VISITOR STALLS ARE PROVIDED ON P 1 LEVEL
L1			
P1 - PUBLIC + SENIORS RESIDENCE	115 P1	53,500	
P2 - SENIORS RESIDENCE	92 P2	53,500	
TOTAL	209 TOTAL	107,000	

NOTES:

- ALL AREAS AND CALCULATIONS ARE APPROXIMATE. & MAY BE ADJUSTED DURING WORKING DRAWINGS COORDINATION
- VALUES LISTED IN ABOVE AREA CALCULATIONS ARE DETERMINED IN GENERAL ACCORDANCE WITH THE METHODOLOGY REQUIRED IN CITY OF VICTORIA BYLAWS
- VALUES LISTED IN BUILDING CODE DATA SHEET ARE DETERMINED IN ACCORDANCE WITH THE METHODOLOGY REQUIRED IN BCBC
- WALL THICKNESS EXCLUSION AREAS ARE APPROXIMATE AND WILL BE ADJUSTED BASED ON FINAL WALL ASSEMBLIES & REQUIRED ENERGY ANALYSIS

BUILDING HEIGHT DATA

LEVEL	Use	Elevation (Geodetic)	Clear floor height	Slab to Slab height	Total Height (from Ave. Grade)
1	Commerical	71.00' 21.64m	16'-0" 4.88m	16'-8" 5.08m	NA
2	Daycare / Offices	87.67' 26.72m	12'-0" 3.66m	12'-8" 3.86m	14.50' 4.41m
3	Residential Units	100.33' 30.58m	8'-0" 2.44m	8'-8" 2.64m	27.16' 8.27m
4	Residential Units	109.00' 33.22m	8'-0" 2.44m	8'-8" 2.64m	35.83' 10.91m
5	Residential Units	117.67' 35.86m	8'-0" 2.44m	8'-8" 2.64m	44.50' 13.56m
6	Residential Units	126.33' 38.51m	9'-0" 2.74m	9'-8" 2.95m	53.16' 16.20m
7	Residential Units	136.00' 41.45m	9'-0" 2.74m	9'-8" 2.95m	62.83' 19.14m
8	Residential Units	145.67' 44.40m	9'-0" 2.74m	9'-8" 2.95m	72.50' 22.09m
9	Residential Units	155.33' 47.35m	9'-0" 2.74m	9'-8" 2.95m	82.16' 25.04m
10	Penthouse Units	165.00' 50.29m	8'-3" 2.51m	8'-11" 2.72m	91.83' 27.98m
	T.O. Roof Slab	173.92' 53.01m			100.73' 30.70m
	T.O. Roof Parapet	176.92' 53.93m			103.75' 31.62m
11	T.O. Mech. Enclosure	184.00' 56.08m			110.83' 33.77m

QUADRA BRIDGE / BROUGHTON MIDRISE

LEVEL	Use	Elevation (Geodetic)	Clear floor height	Slab to Slab height	Total Height (from Ave. Grade)
1	Commerical	75.00' 22.86m	12'-0" 3.66m	12'-8" 3.86m	1.83' 0.55m
2	Amenities	87.67' 26.72m	12'-0" 3.66m	12'-8" 3.86m	14.50' 4.41m
2 RES	Residential Units	91.67' 27.94m	8'-0" 2.44m	8'-8" 2.64m	18.50' 5.63m
3	Residential Units	100.33' 30.58m	8'-0" 2.44m	8'-8" 2.64m	27.16' 8.27m
4	Residential Units	109.00' 33.22m	8'-0" 2.44m	8'-8" 2.64m	35.83' 10.91m
5	Residential Units	117.67' 35.86m	8'-0" 2.44m	8'-8" 2.64m	44.50' 13.56m
6	Residential Units	126.33' 38.51m	9'-0" 2.74m	9'-8" 2.95m	53.16' 16.20m
7	Residential Units	136.00' 41.45m	9'-0" 2.74m	9'-8" 2.95m	62.83' 19.14m
8	Residential Units	145.67' 44.40m	9'-0" 2.74m	9'-8" 2.95m	72.50' 22.09m
9	Residential Units	154.33' 47.04m	9'-0" 2.74m	9'-8" 2.94m	82.16' 25.04m
10	Penthouse Units	164.00' 49.99m	8'-3" 2.51m	8'-11" 2.72m	91.83' 27.98m
	T.O. Roof Slab	173.92' 53.01m			100.73' 30.70m
	T.O. Roof Parapet	176.92' 53.93m			103.75' 31.62m
11	T.O. Mech. Enclosure	184.00' 56.08m			110.83' 33.77m

PARKING LEVELS

Level	Use	Elevation (Geodetic)	Notes
P2	Parking	50.00' 15.24m	Bottom of ramp elevation
P1	Parking	59.00' 17.98m	Bottom of ramp elevation


REVISIONS

NO.	DESCRIPTION	DATE
1	ISSUED FOR RECORDING & DP	18 SEP 2017
2	REDESIGNED FOR RECORDING & DP	20 FEB 2018
3	REDESIGNED FOR ADP	02 APR 2018
4	REDESIGNED FOR RECORDING & DP	18 JAN 2019
5	REDESIGNED FOR ADP	24 APR 2019
6	REDESIGNED FOR RECORDING & DP	20 MAY 2019
7	REDESIGNED FOR RECORDING & DP	28 AUG 2020
8	REDESIGNED FOR RECORDING & DP	06 MAY 2021
9	REDESIGNED FOR RECORDING & DP	24 NOV 2021


DISCLAIMER

THESE PLANS AND SPECIFICATIONS ARE THE PROPERTY OF THE ARCHITECT AND SHALL NOT BE USED FOR ANY OTHER PROJECT WITHOUT THE ARCHITECT'S WRITTEN PERMISSION. THE ARCHITECT'S LIABILITY IS LIMITED TO THE DESIGN AND CONSTRUCTION OF THE BUILDING AND SHALL NOT BE EXTENDED TO ANY OTHER MATTER. THE ARCHITECT'S LIABILITY IS LIMITED TO THE DESIGN AND CONSTRUCTION OF THE BUILDING AND SHALL NOT BE EXTENDED TO ANY OTHER MATTER.


AVERAGE NATURAL EXISTING & FINISHED GRADE CALCULATIONS						
Point	Elev. (ft)	Point	Elev. (ft)	Segment	Average Elevation	Length (ft)
A	71.36	B	70.70	AB	71.03	304.71
B	70.70	C	76.80	BC	73.75	232.00
C	76.80	D	74.31	CD	75.56	180.25
D	74.31	E	74.80	DE	74.56	120.25
E	74.80	F	72.74	EF	73.77	121.33
F	72.74	A	71.36	FA	72.05	112.17
					TOTAL	TOTAL LENGTH
					440.7	1070.71
					Total 'Z'	
					78369.94	
					AVERAGE NATURAL EXISTING GRADE	
					73.19	
					MAXIMUM HEIGHT	
					A.N.E.G. + 98.43' =	
					171.62	

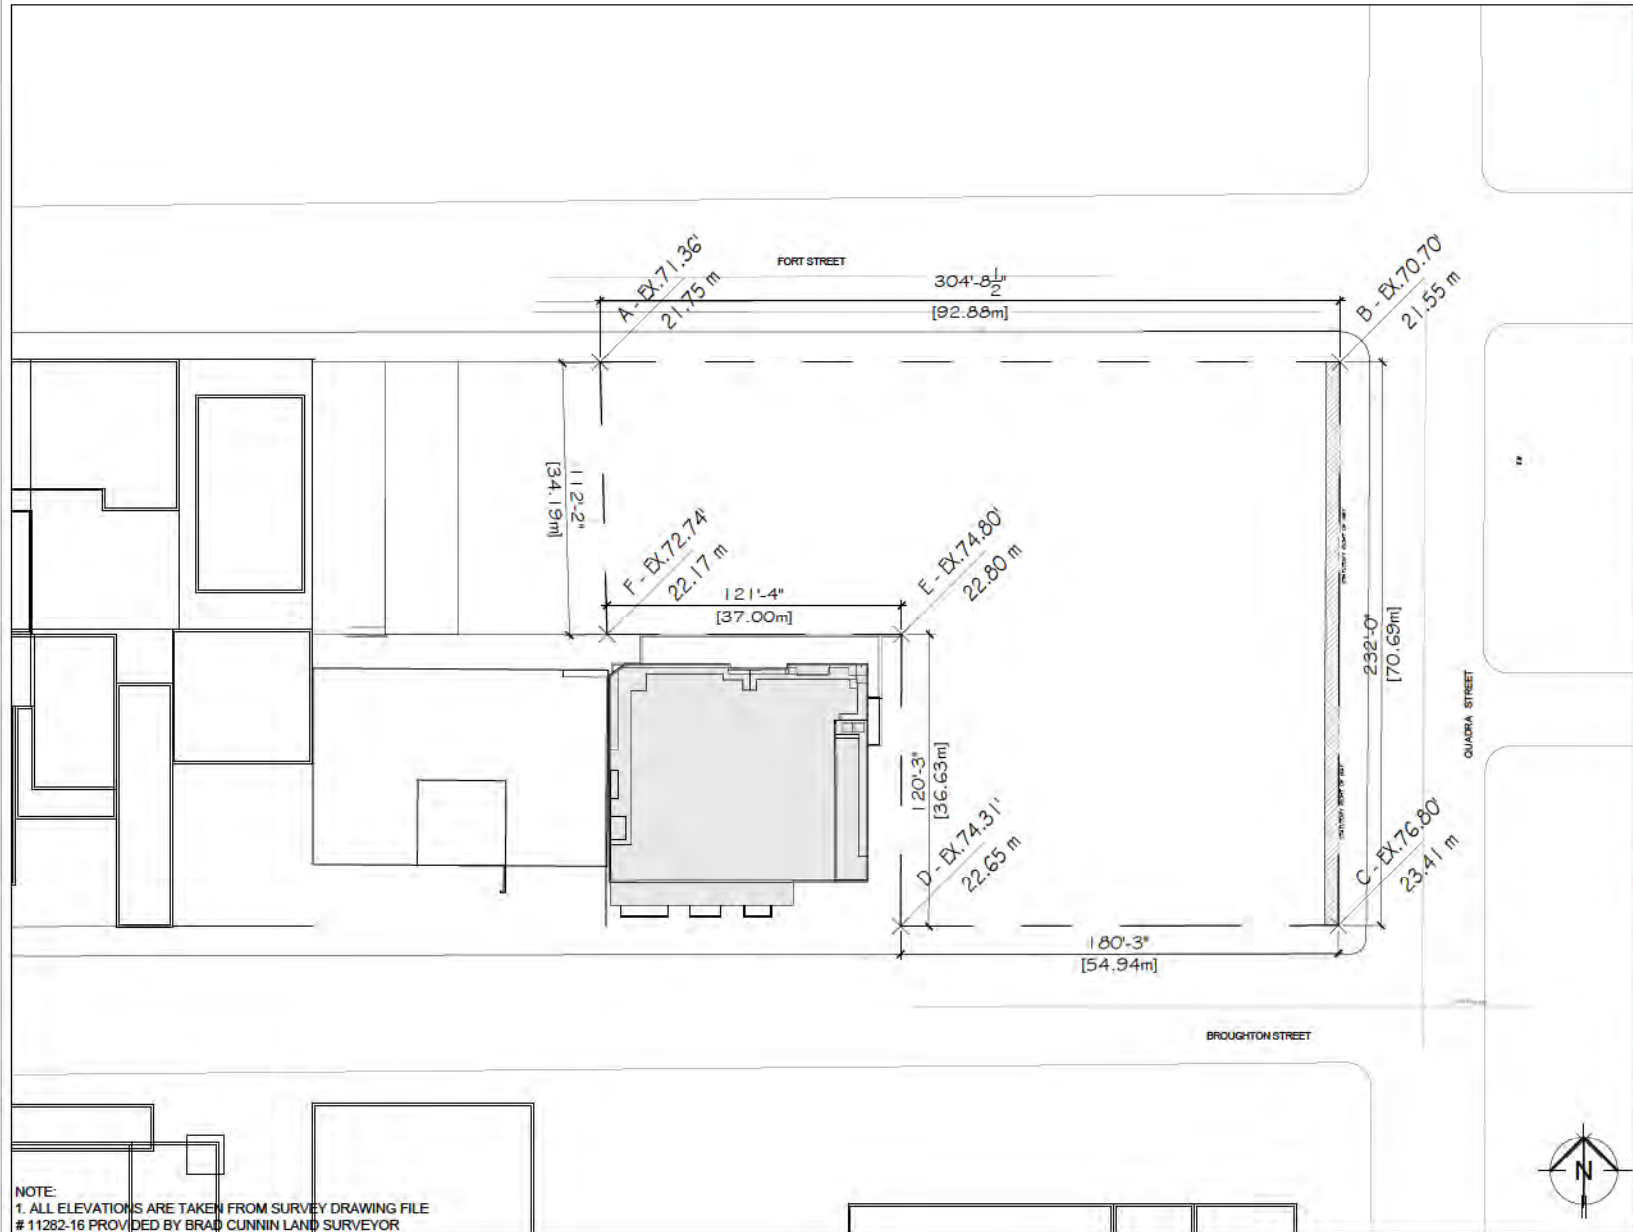


RESIDENTIAL UNIT SUMMARY		LEVEL - QUADRA STREET ENTRANCE										LEVEL - FORT STREET ENTRANCE													NOTES	
UNIT TYPE	AREA (SF)	1	2	3	4	5	6	7	8	9	10	SUB-TOTAL	1	2	3	4	5	6	7	8	9	10	SUB-TOTAL	TOTAL		%
STUDIO																										
A1	428	1										1											0	1		AFFORDABLE SENIOR UNIT
A2	393		1	1	1	1	1	1				6											0	6		AFFORDABLE SENIOR UNIT
A3	625		1									1											0	1		
A4	515											0			1	1	1	1	1	1	1		7	7		STUDENT UNIT
A5	386											0			2	2	2						6	6		STUDENT UNIT
A6	441											0			1	1	1	1	1	1	1		7	7		STUDENT UNIT
A7	484		1									1											0	1		AFFORDABLE SENIOR UNIT
SUB-TOTAL		0	2	2	1	1	1	1	1	0	0	9	0	0	2	4	4	4	2	2	2	0	20	29	10.4%	
1 BEDROOM																										
B1	663										1	1											0	1		
B2	664		1	1	1	1	1					5											0	5		
B3	525											0			1	1	1	1	1	1	1		7	7		STUDENT UNIT
B4	586			2	2	2	2	2	2	2		14											0	14		
B5	605			1	1	1	1	1	1	1		6											0	6		
B6	582			1								1											0	1		
B7	566			3	3	3	3					12											0	12		
B8	542			1	1	1	1	1	1	1		7											0	7		
B9	555										1	1											0	1		
B10	622											0			1	1	1	1	1	1	1		7	7		STUDENT UNIT
B11	459			1	1	1	1	1	1			5											0	5		AFFORDABLE SENIOR UNIT
B12	434											0										1	1	1		STUDENT UNIT
B13	697										1	1											0	1		
B14	601			1	1	1	1	1	1	1	1	7			1	1	1	1	1	1	1		7	14		STUDENT UNIT (FORT STREET ENTRANCE)
B15	698										1	1											0	1		
B16	743										1	1											0	1		
B17	545								1			1											0	1		
B18	425											0										1	1	1		STUDENT UNIT
B19	486										1	1											0	1		
B20	509											0										2	2	2		STUDENT UNIT
B21	597										1	1											0	1		
B22	568										1	1											0	1		
B23	580											0			1	1	1	1	1	1	1		7	7		STUDENT UNIT
B24	636										1	1											0	1		
B25	785										1	1											0	1		
B26	701										1	1											0	1		
B27	617										2	2											0	2		
B28	504											0			1	1	1	1	1	1	1		7	7		STUDENT UNIT
B29	466											0			1	1	1	1	1	1	1		7	7		STUDENT UNIT
B30	540											1											0	1		
B31	774											1											0	1		
B32	617			2								2											0	2		
B33	485			1								1											0	1		AFFORDABLE SENIOR UNIT
SUB-TOTAL		0	4	11	11	10	10	9	7	8	8	78	0	0	6	6	6	6	6	6	6	4	46	124	44.3%	
1 BEDROOM + FLEX																										
C1	706			5	5	5	5	5				25											0	25		
C2	689								1			1											0	1		
C3	770			1	1	1	1	1	1	1		7											0	7		
C4	637			2	1	1	1					5											0	5		
SUB-TOTAL		0	5	8	7	7	7	2	1	1	0	38	0	0	0	0	0	0	0	0	0	0	0	38	13.6%	
2 BEDROOM																										
D1	814		1	1	1	1	1	1	1	1		8											0	8		
D2	888		1	1	1	1	1	1	1	1		7											0	7		
D3	852			1	1	1	1	1	1	1		6											0	6		
D4	884		1	1	1	1	1	1	1	1		8											0	8		
D5	970			2	2	2	2					8											0	8		
D6	810										1	1											0	1		
D7	800									1	1	2											0	2		
D8	887										1	1											0	1		
D9	768									2		2											0	2		
D10	910									2		2											0	2		
D11	691									1		1											0	1		
D12	716										1	1											0	1		
D13	718										1	1											0	1		
D14	755											0										1	1	1		
D15	727											0										1	1	1		
D16	870										1	1											0	1		
D17	936										1	1											0	1		
D18	889										1	1											0	1		
D19	829			1	1	1	1	1	1	1	1	7											0	7		
D20	588			1	1	1	1	1	1	1	1	7											0	7		
D21	657									1	1	2											0	2		
D22	846									1		1											0	1		
D23	896		1	1	1	1	1	1				5											0	5		
D24	827										1	1											0	1		
D25	775											0			1								1	1		STUDENT AMENITY ROOM
D26	754											0			1								1	1		STUDENT UNIT
D27	737										1	1											0	1		
D28	1074		1									1											0	1		
D29	532					1	1	1				3											0	3		
D30	957											2											0	2		
SUB-TOTAL		0	5	9	10	11	11	14	8	8	5	81	0	0	2	0	0	0	0	0	0	2	4	85	30.4%	
2 BEDROOM + FLEX																										
E1	926			1	1	1	1					4											0	4		
SUB-TOTAL		0	0	1	1	1	1	0	0	0	0	4	0	0	0	0	0	0	0	0	0	0	0	4	1.4%	
3 BEDROOM																										
F1												0											0	0		RESERVED
SUB-TOTAL		0	0	0	0	0	0	0	0	0	0	0	0	0	0	0	0	0	0	0	0	0	0	0	0.0%	
TOTAL		0	16	31	30	30	30	26	17	17	13	210	0	0	10	10	10	10	8	8	8	6	70	280	100%	
NOTES: 1 - FIRST 4 YEARS UNIT TOTALS; 14 AFFORDABLE SENIOR UNITS / 67 STUDENT UNITS / 1 STUDENT AMENITY ROOM / 138 INDEPENDENT LIVING SENIOR UNITS = 280 TOTAL																										
2 - AFTER 4 YEARS UNIT TOTALS; 14 AFFORDABLE SENIOR UNITS / 266 INDEPENDENT LIVING SENIOR UNITS = 280 TOTAL																										
3 - STUDENT UNITS / STUDENT AMENITY ROOM ARE ASSIGNED ONLY FOR THE FIRST 4 YEARS. AFTER 4 YEARS THEY REVERT TO INDEPENDENT LIVING SENIOR UNITS																										
4 - ALL UNIT AREA CALCULATIONS ARE APPROXIMATE																										

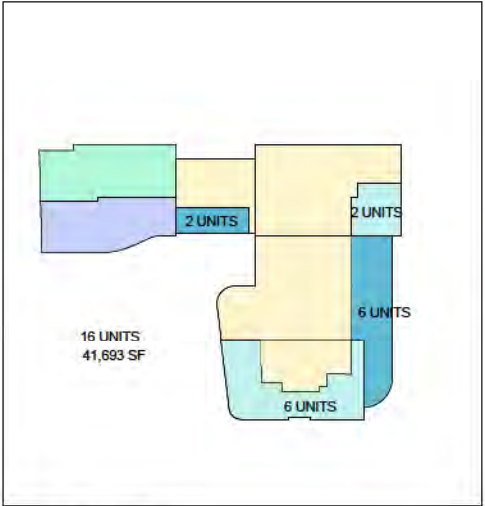


3 LEVEL 2

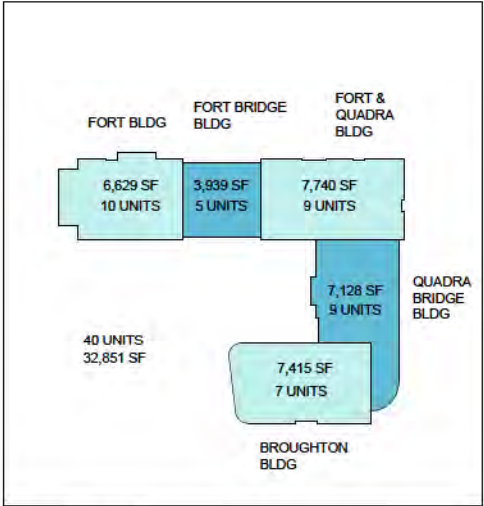


6 LEVEL 5

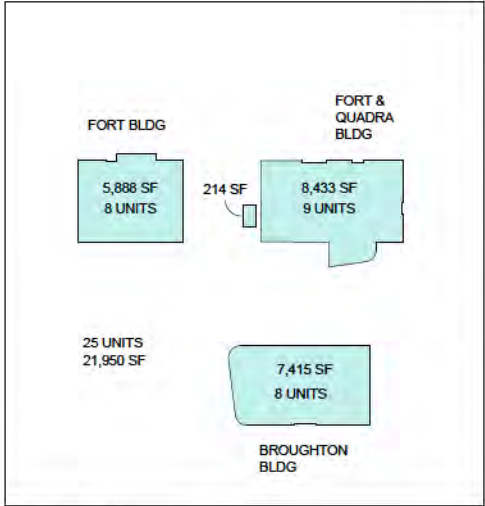


9 LEVEL 8

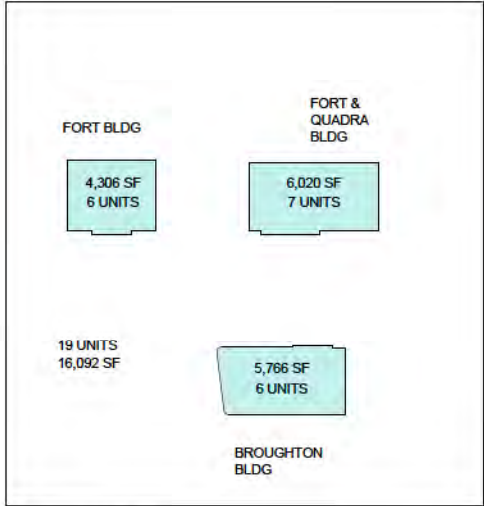


11 LEVEL 10

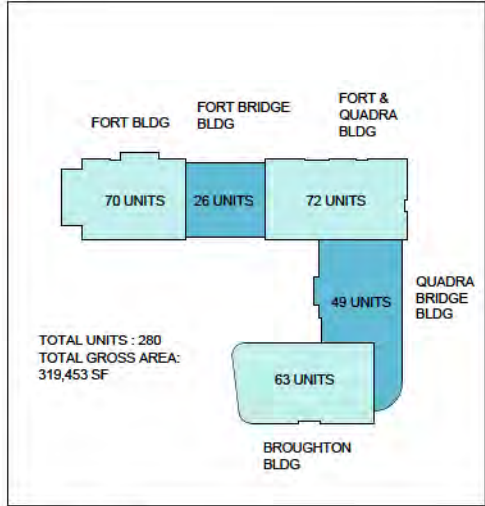


13 TOTAL

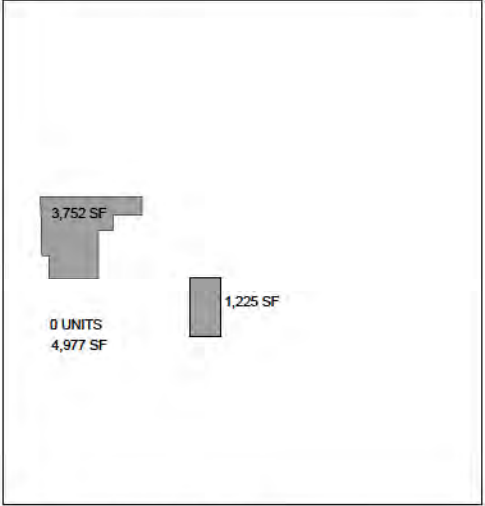


2 MECHANICAL LEVEL

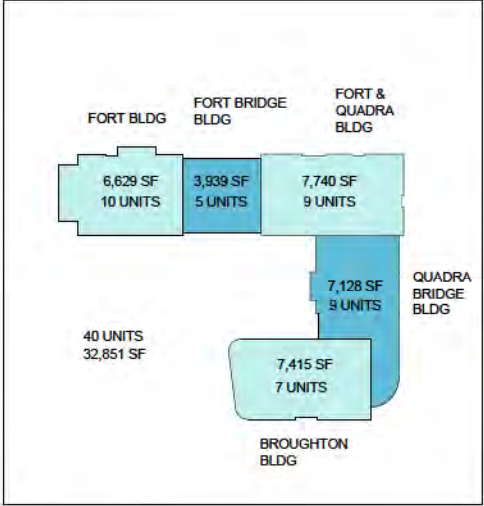


5 LEVEL 4

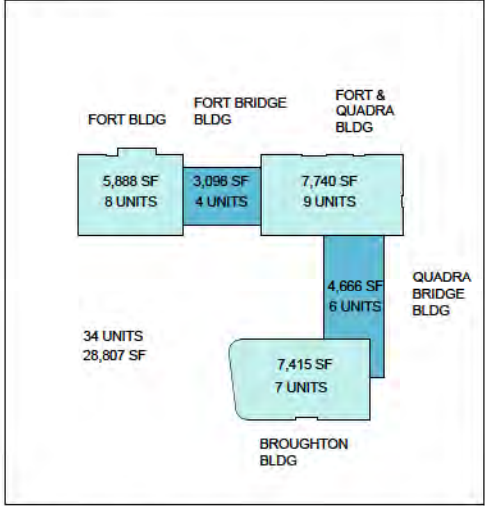


8 LEVEL 7

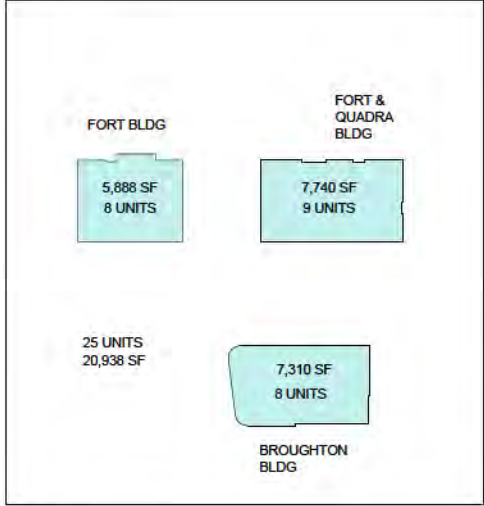


10 LEVEL 9

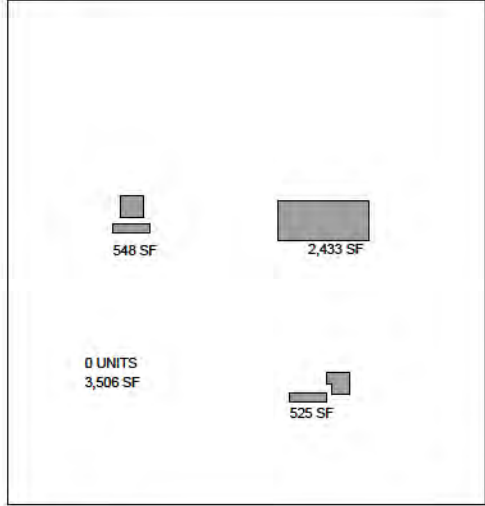


12 ROOF

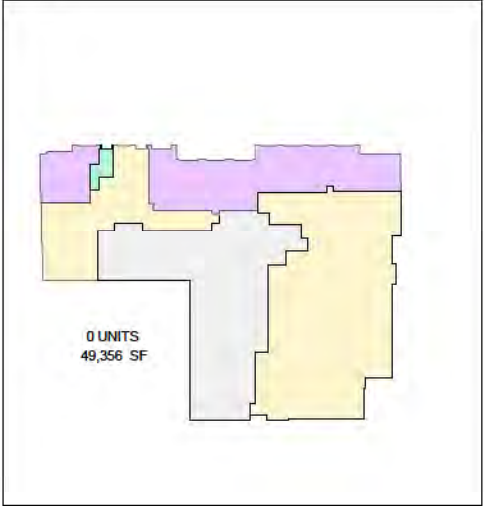

1 LEVEL 1

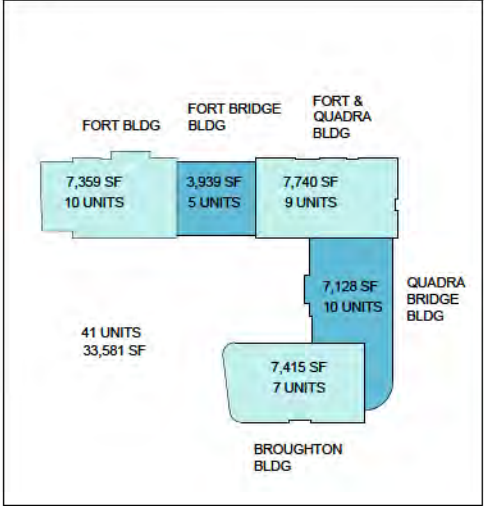

4 LEVEL 3

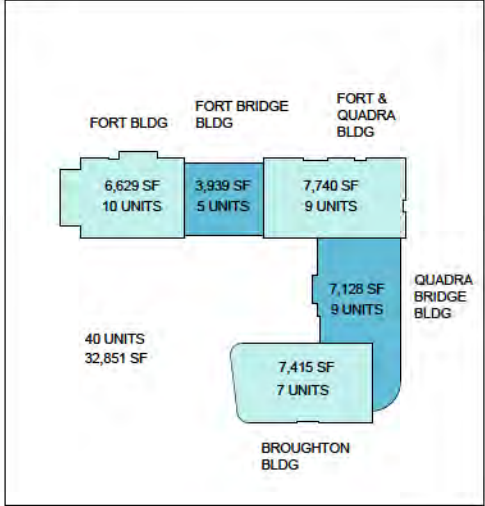

7 LEVEL 6

BUILDING BREAKDOWN FLOOR AREA CALCULATIONS						
LEVEL	FORT BUILDING (SF)	FORT BRIDGE BUILDING (SF)	FORT / QUADRA BUILDING (SF)	QUADRA BRIDGE BUILDING (SF)	BROUGHTON BUILDING (SF)	TOTAL
1			49,356			49,356
MECHANICAL			4,977			4,977
2	9,315	3,939	9,017	11,984	7,438	41,693
3	7,359	3,939	7,740	7,128	7,415	33,581
4	6,629	3,939	7,740	7,128	7,415	32,851
5	6,629	3,939	7,740	7,128	7,415	32,851
6	6,629	3,939	7,740	7,128	7,415	32,851
7	5,888	3,098	7,740	4,686	7,415	28,807
8	5,888	214	8,433	0	7,415	21,950
9	5,888	0	7,740	0	7,310	20,938
10	4,306	0	6,020	0	5,766	16,092
ROOF	548	0	2,433	0	525	3,506
TOTAL						319,453

bfa studio
architects
ECO-REGIONAL ARCHITECTURE + INTERIOR DESIGN
(formerly BISHAY FRANK ARCHITECTS)
www.bfaarchitects.com

REVISIONS

NO.	DESCRIPTION	DATE
1	ISSUED FOR REVISION & DP	18 SEP 2017
2	RE-DESIGNED FOR REVISION & DP	20 FEB 2018
3	RE-DESIGNED FOR ADP	02 APR 2018
4	RE-DESIGNED FOR REVISION & DP	18 JAN 2019
5	RE-DESIGNED FOR ADP	24 APR 2019
6	RE-DESIGNED FOR REVISION & DP	28 MAY 2019
7	RE-DESIGNED FOR REVISION & DP	28 AUG 2020
8	RE-DESIGNED FOR REVISION & DP	08 MAY 2021
9	RE-DESIGNED FOR REVISION & DP	24 NOV 2021

Copyright Reserved
This plan and drawing are the property of BFA Studio Architects. No part of this plan and drawing may be reproduced or transmitted in any form or by any means electronic or mechanical, including photocopying, recording, or by any information storage and retrieval system, without permission in writing from BFA Studio Architects. The user of this plan and drawing is responsible for obtaining all necessary permits and approvals from the appropriate authorities. BFA Studio Architects is not responsible for any errors or omissions in this plan and drawing. 

parc
retirement
living

17420

PARC VICTORIA
Mixed Use Seniors Residential & Commercial Development

AREA DIAGRAMS

A004

APR 2017
1/64" = 1'-0"







$$1/16" = 1'-0"$$



1 VIEW OF BUILDING NORTH-EAST AT FORT & QUADRA STREET



2 VIEW OF FORT STREET COMMERCIAL & RETAIL UNITS

bfa studio
architects

ECO-REGIONAL ARCHITECTURE • INTERIOR DESIGN

(Formerly **BEKHARAT FRIBAS** ARCHITECTS)
600 - 335 Burrard Street
Vancouver, BC V6C 2G8
www.bfstudiostudio.com

T 604 682 9544
F 604 682 4080

REVISIONS

NO.	DESCRIPTION	DATE
1	ISSUED FOR PERMITTING & DP	18 SEP 2017
2	RE-ISSUED FOR PERMITTING & DP	20 FEB 2018
3	RE-ISSUED FOR ADP	02 APR 2018
4	RE-ISSUED FOR PERMITTING & DP	18 JAN 2019
5	RE-ISSUED FOR ADP	24 APR 2019
6	RE-ISSUED FOR PERMITTING & DP	20 MAY 2019
7	RE-ISSUED FOR PERMITTING & DP	26 AUG 2020
8	RE-ISSUED FOR PERMITTING & DP	08 MAY 2021
9	RE-ISSUED FOR PERMITTING & DP	24 NOV 2021

COPYRIGHT RESERVED

THIS PLAN SET IS THE PROPERTY OF THE ARCHITECT AND SHALL NOT BE USED IN ANY MANNER WITHOUT THE WRITTEN CONSENT OF THE ARCHITECT. ANY REPRODUCTION OR TRANSMISSION OF THIS PLAN SET WITHOUT THE WRITTEN CONSENT OF THE ARCHITECT IS PROHIBITED. THE ARCHITECT ASSUMES NO LIABILITY FOR ANY DAMAGE OR LOSS OF ANY KIND, INCLUDING BUT NOT LIMITED TO, CONSEQUENTIAL DAMAGES, ARISING FROM THE USE OF THIS PLAN SET. THE ARCHITECT'S LIABILITY IS LIMITED TO THE DESIGN OF THE BUILDING AND THE ARCHITECT'S LIABILITY IS LIMITED TO THE DESIGN OF THE BUILDING.

CLIENT

parc
retirement
living

PROJECT NO.

17420

PROJECT

PARC VICTORIA
Mixed Use Seniors Residential &
Commercial Development

DRAWING TITLE

3D PERSPECTIVES

SCALE

DRAWING NO.

A006

DATE

APR 2017

SCALE

N.T.S.



1 VIEW OF PROPOSED BUILDING GREEN ROOFS AND SURROUNDING CONTEXT



2 VIEW OF COURTYARD & GREEN ROOFS FROM ROOF OF ESCHER BUILDING



3 VIEW OF FORT BUILDING ENTRANCE AND ADJACENT BUILDING



4 VIEW OF SENIORS' COURTYARD ON LEVEL 2

bfa studio
architects

ECO-REGIONAL ARCHITECTURE • INTERIOR DESIGN

(Formerly **RESHAFY FRIMAS** ARCHITECTS)
600 - 355 Burrard Street
Vancouver, BC V6C 2G8
www.bfaarchitects.com

REVISIONS

NO.	DESCRIPTION	DATE
1	ISSUED FOR REZONING & DP	18 SEP 2017
2	RE-ISSUED FOR REZONING & DP	20 FEB 2018
3	RE-ISSUED FOR ADP	02 APR 2018
4	RE-ISSUED FOR REZONING & DP	18 JAN 2019
5	RE-ISSUED FOR ADP	24 APR 2019
6	RE-ISSUED FOR REZONING & DP	20 MAY 2019
7	RE-ISSUED FOR REZONING & DP	20 AUG 2020
8	RE-ISSUED FOR REZONING & DP	05 MAY 2021
9	RE-ISSUED FOR REZONING & DP	24 NOV 2021

COPYRIGHT RESERVED

THIS PLAN AND DESIGN ARE THE PROPERTY OF BFA STUDIO ARCHITECTS. ANY REPRODUCTION OR DISTRIBUTION OF THIS PLAN AND DESIGN WITHOUT THE WRITTEN PERMISSION OF BFA STUDIO ARCHITECTS IS STRICTLY PROHIBITED. THE CLIENT AGREES TO HOLD BFA STUDIO ARCHITECTS HARMLESS FROM ALL LIABILITY FOR ANY LOSS OR DAMAGE TO ANY PROPERTY OR PERSONS ARISING FROM THE USE OF THIS PLAN AND DESIGN.

parc
retirement
living

PROJECT NO. 17420

PROJECT **PARC VICTORIA**
Mixed Use Seniors Residential & Commercial Development

DRAWING TITLE

3D PERSPECTIVES

SCALE

DRAWING NO. REVISION

A008

DATE APR 2017

SCALE CHECKED

N.T.S.



1 VIEW OF BROUGHTON AND QUADRA CORNER



2 VIEW OF CAFE ENTRANCE AT BROUGHTON



3 VIEW OF URBAN CAFE CORNER AT BROUGHTON AND QUADRA



4 VIEW OF MAIN ENTRANCE AT QUADRA

bfa studio
 architects
ECO-REGIONAL ARCHITECTURE • INTERIOR DESIGN
(Formerly BISHARAT FRIDMAN ARCHITECTS)
600 - 335 Burrard Street
 Vancouver, BC V6C 2G8
 www.bfstudiostudio.com
T 604 682 9544
 F 604 682 4060

NO.	DESCRIPTION	DATE
1	ISSUED FOR PERMITTING & DP	18 SEP 2017
2	RE-DESIGNED FOR PERMITTING & DP	20 FEB 2018
3	RE-DESIGNED FOR ADP	02 APR 2018
4	RE-DESIGNED FOR PERMITTING & DP	18 JAN 2019
5	RE-DESIGNED FOR ADP	24 APR 2019
6	RE-DESIGNED FOR PERMITTING & DP	20 MAY 2019
7	RE-DESIGNED FOR PERMITTING & DP	28 AUG 2020
8	RE-DESIGNED FOR PERMITTING & DP	05 MAY 2021
9	RE-DESIGNED FOR PERMITTING & DP	24 NOV 2021

COPYRIGHT RESERVED
 THE ARCHITECTURE AND DESIGN ARE THE PROPERTY OF THE ARCHITECT AND SHALL NOT BE USED OR REPRODUCED WITHOUT WRITTEN CONSENT. ANY REPRODUCTION OR USE OF THE ARCHITECTURE OR DESIGN FOR ANY PURPOSE WITHOUT THE WRITTEN CONSENT OF THE ARCHITECT SHALL BE CONSIDERED A VIOLATION OF THE ARCHITECT'S RIGHTS AND SHALL BE SUBJECT TO LEGAL ACTION.

CLIENT
parc retirement living

PROJECT NO.
 17420


PROJECT
PARC VICTORIA
 Mixed Use Seniors Residential & Commercial Development

DESIGNING TITLE
 3D PERSPECTIVES

DATE
 APR 2017


SCALE
 N.T.S.

REVISION
A009

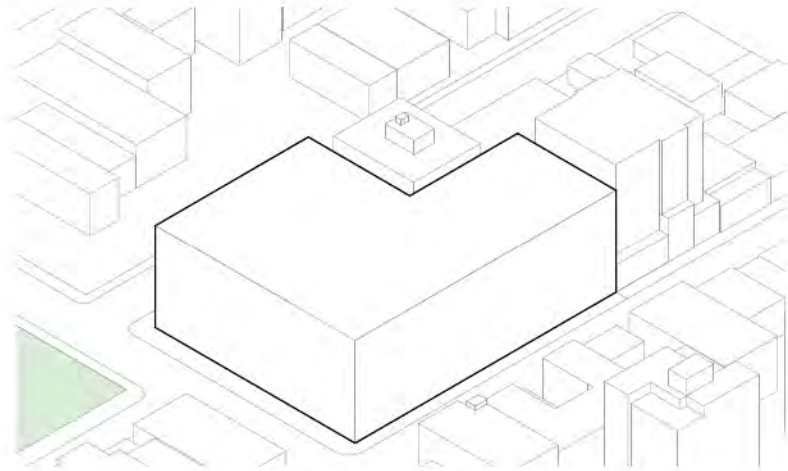


INITIAL MASSING POTENTIAL

Initial massing is created by taking the site footprint and extruding it up 30 m.

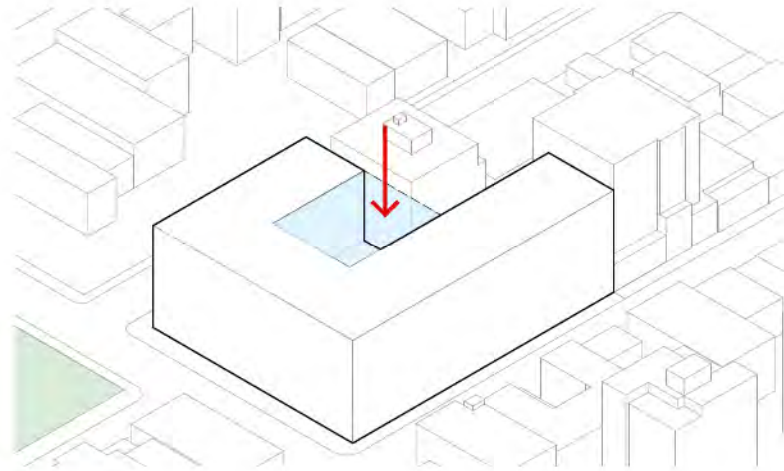


INTERNAL COURTYARD

An internal courtyard is created following extraction from the center of the initial massing.

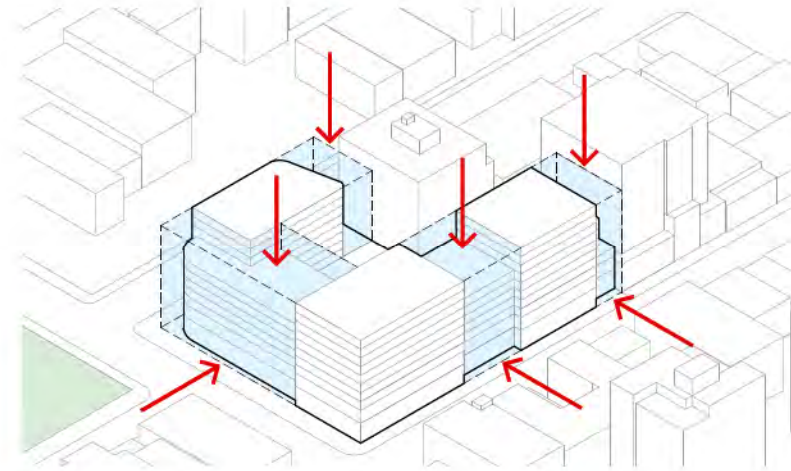

CARVE

The massing is carved in response to context to create view corridors and a sense of openness through the site.

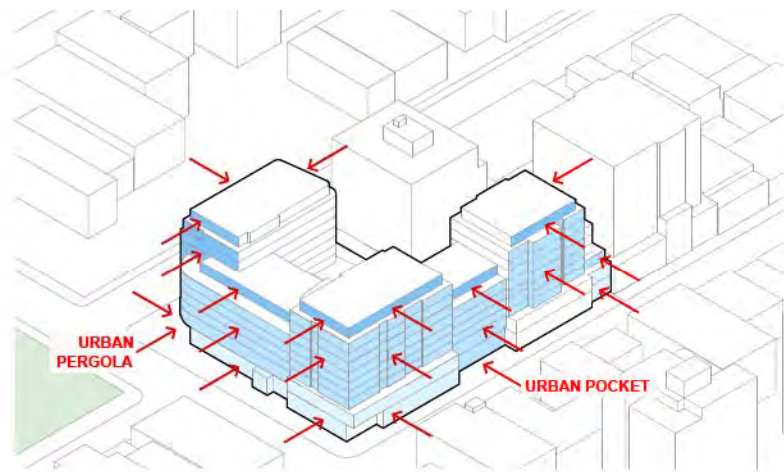

STEPPED SETBACKS

The building is stepped back in response to City of Victoria guidelines and policies including the Downtown Core Area Plan as well as site context and existing and future urban fabric, creating a facade that acknowledges the scale of the neighbourhood. The southeast corner is articulated in reference to Pioneer Square and Christ Church Cathedral across the street.



GREEN ROOFS

Carving and mass reduction provide the opportunity for terraced green roofs. Rooftop amenity spaces offer residents the ability to enjoy year-round activities. These amenities will be accessible to the public at certain times of the day.

- Potential roof top PV panels / solar hot water collector
- Accessible green roof
- Roof top Amenity

bfa studio
architects

ECO-REGIONAL ARCHITECTURE + INTERIOR DESIGN

(formerly BESHABAT FRANKS ARCHITECTS)
800 - 355 Blupard Street T 604 682 2543
Vancouver, BC V6C 2B5 F 604 682 4060
www.bfashitects.com

REVISIONS

NO.	DESCRIPTION	DATE
1	REQUIRED FOR REZONING & DP	18 JAN 2019
2	REQUIRED FOR ADP	24 APR 2019
3	REQUIRED FOR REZONING & DP	26 MAY 2019
4	REQUIRED FOR REZONING & DP	26 AUG 2020
5	REQUIRED FOR REZONING & DP	05 MAY 2021
6	REQUIRED FOR REZONING & DP	24 NOV 2021

DISCLAIMER: THE INFORMATION CONTAINED HEREIN IS THE PROPERTY OF BFA STUDIO ARCHITECTS. IT IS TO BE USED FOR THE PROJECT AND SITE SPECIFICALLY IDENTIFIED. IT IS NOT TO BE REPRODUCED OR TRANSMITTED IN ANY FORM OR BY ANY MEANS, ELECTRONIC OR MECHANICAL, INCLUDING PHOTOCOPYING, RECORDING, OR BY ANY INFORMATION STORAGE AND RETRIEVAL SYSTEM, WITHOUT THE WRITTEN PERMISSION OF BFA STUDIO ARCHITECTS. THE INFORMATION CONTAINED HEREIN IS NOT TO BE USED FOR ANY OTHER PROJECT OR SITE WITHOUT THE WRITTEN PERMISSION OF BFA STUDIO ARCHITECTS.

parc
retirement
living

17420


PROJECT
PARC VICTORIA
Mixed Use Seniors Residential & Commercial Development

FORM OF DEVELOPMENT -
MASSING

A010

APR 2017

N.T.S.

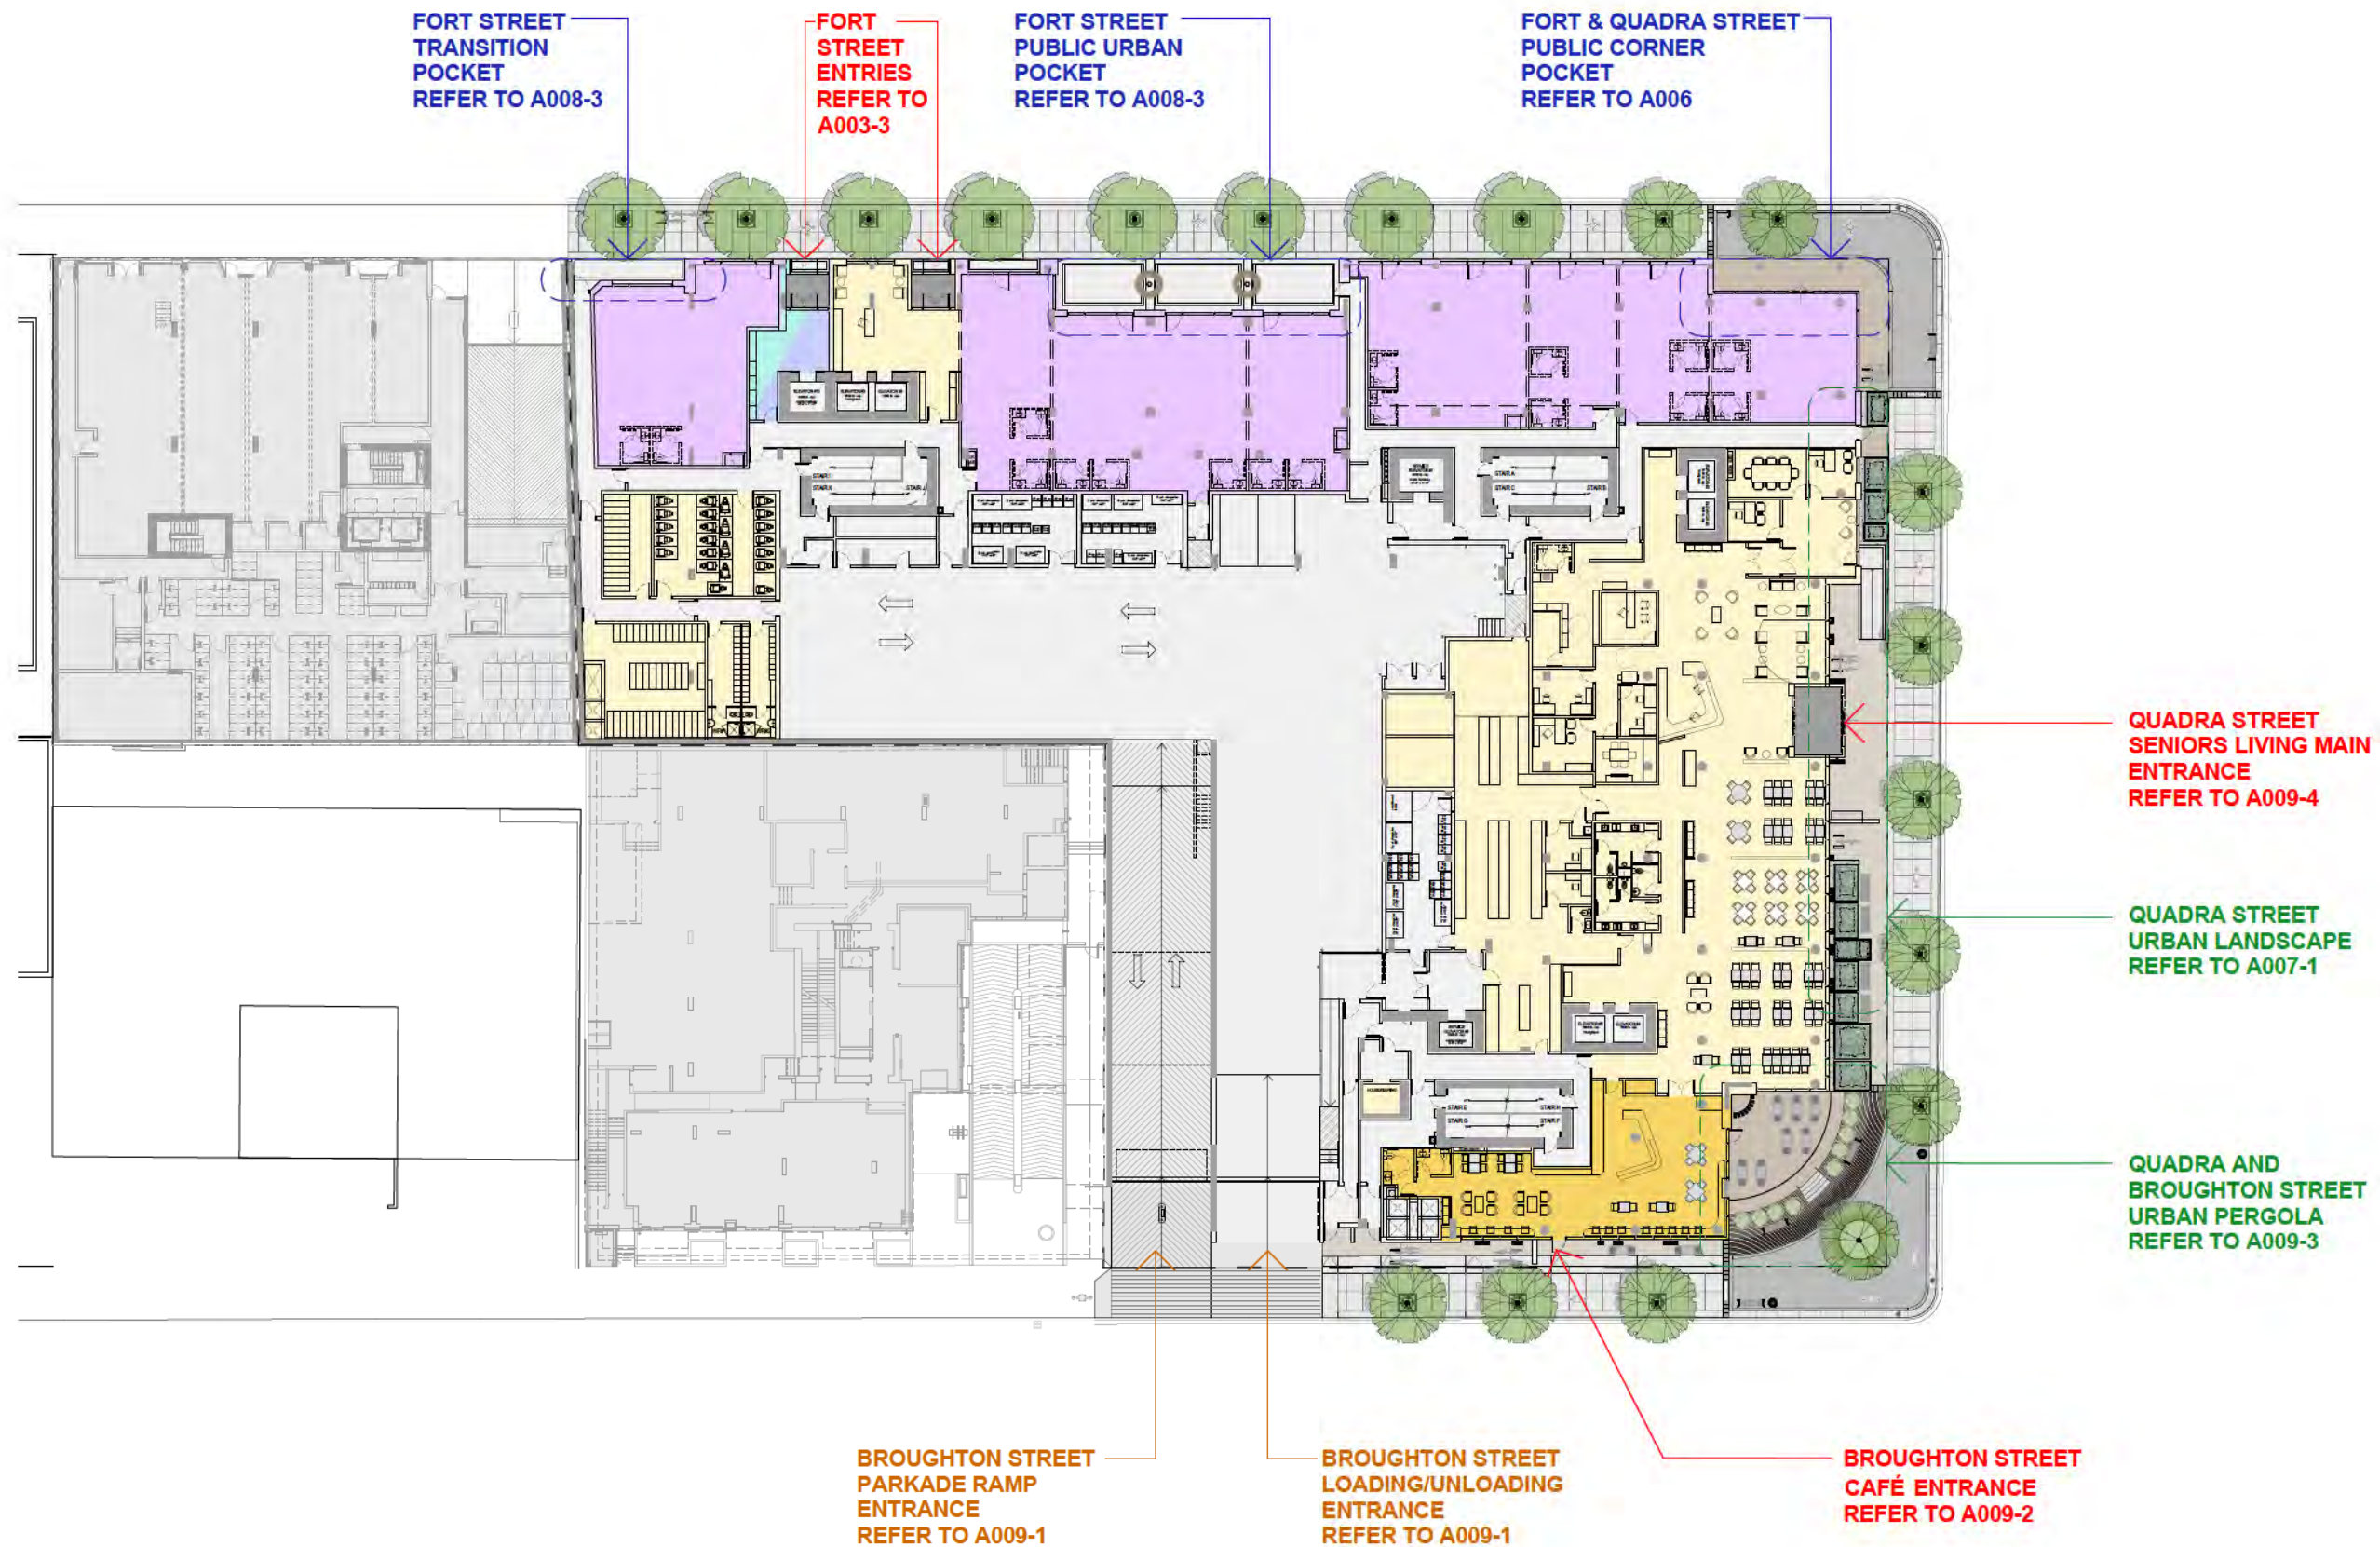


REVISIONS

NO.	DESCRIPTION	DATE
1	REQUIRED FOR ADP	24 APRIL 2019
2	REQUIRED FOR REZONING & DP	20 MAY 2019
3	REQUIRED FOR REZONING & DP	28 AUG 2020
4	REQUIRED FOR REZONING & DP	09 MAY 2021
5	REQUIRED FOR REZONING & DP	24 NOV 2021

DISCLAIMER



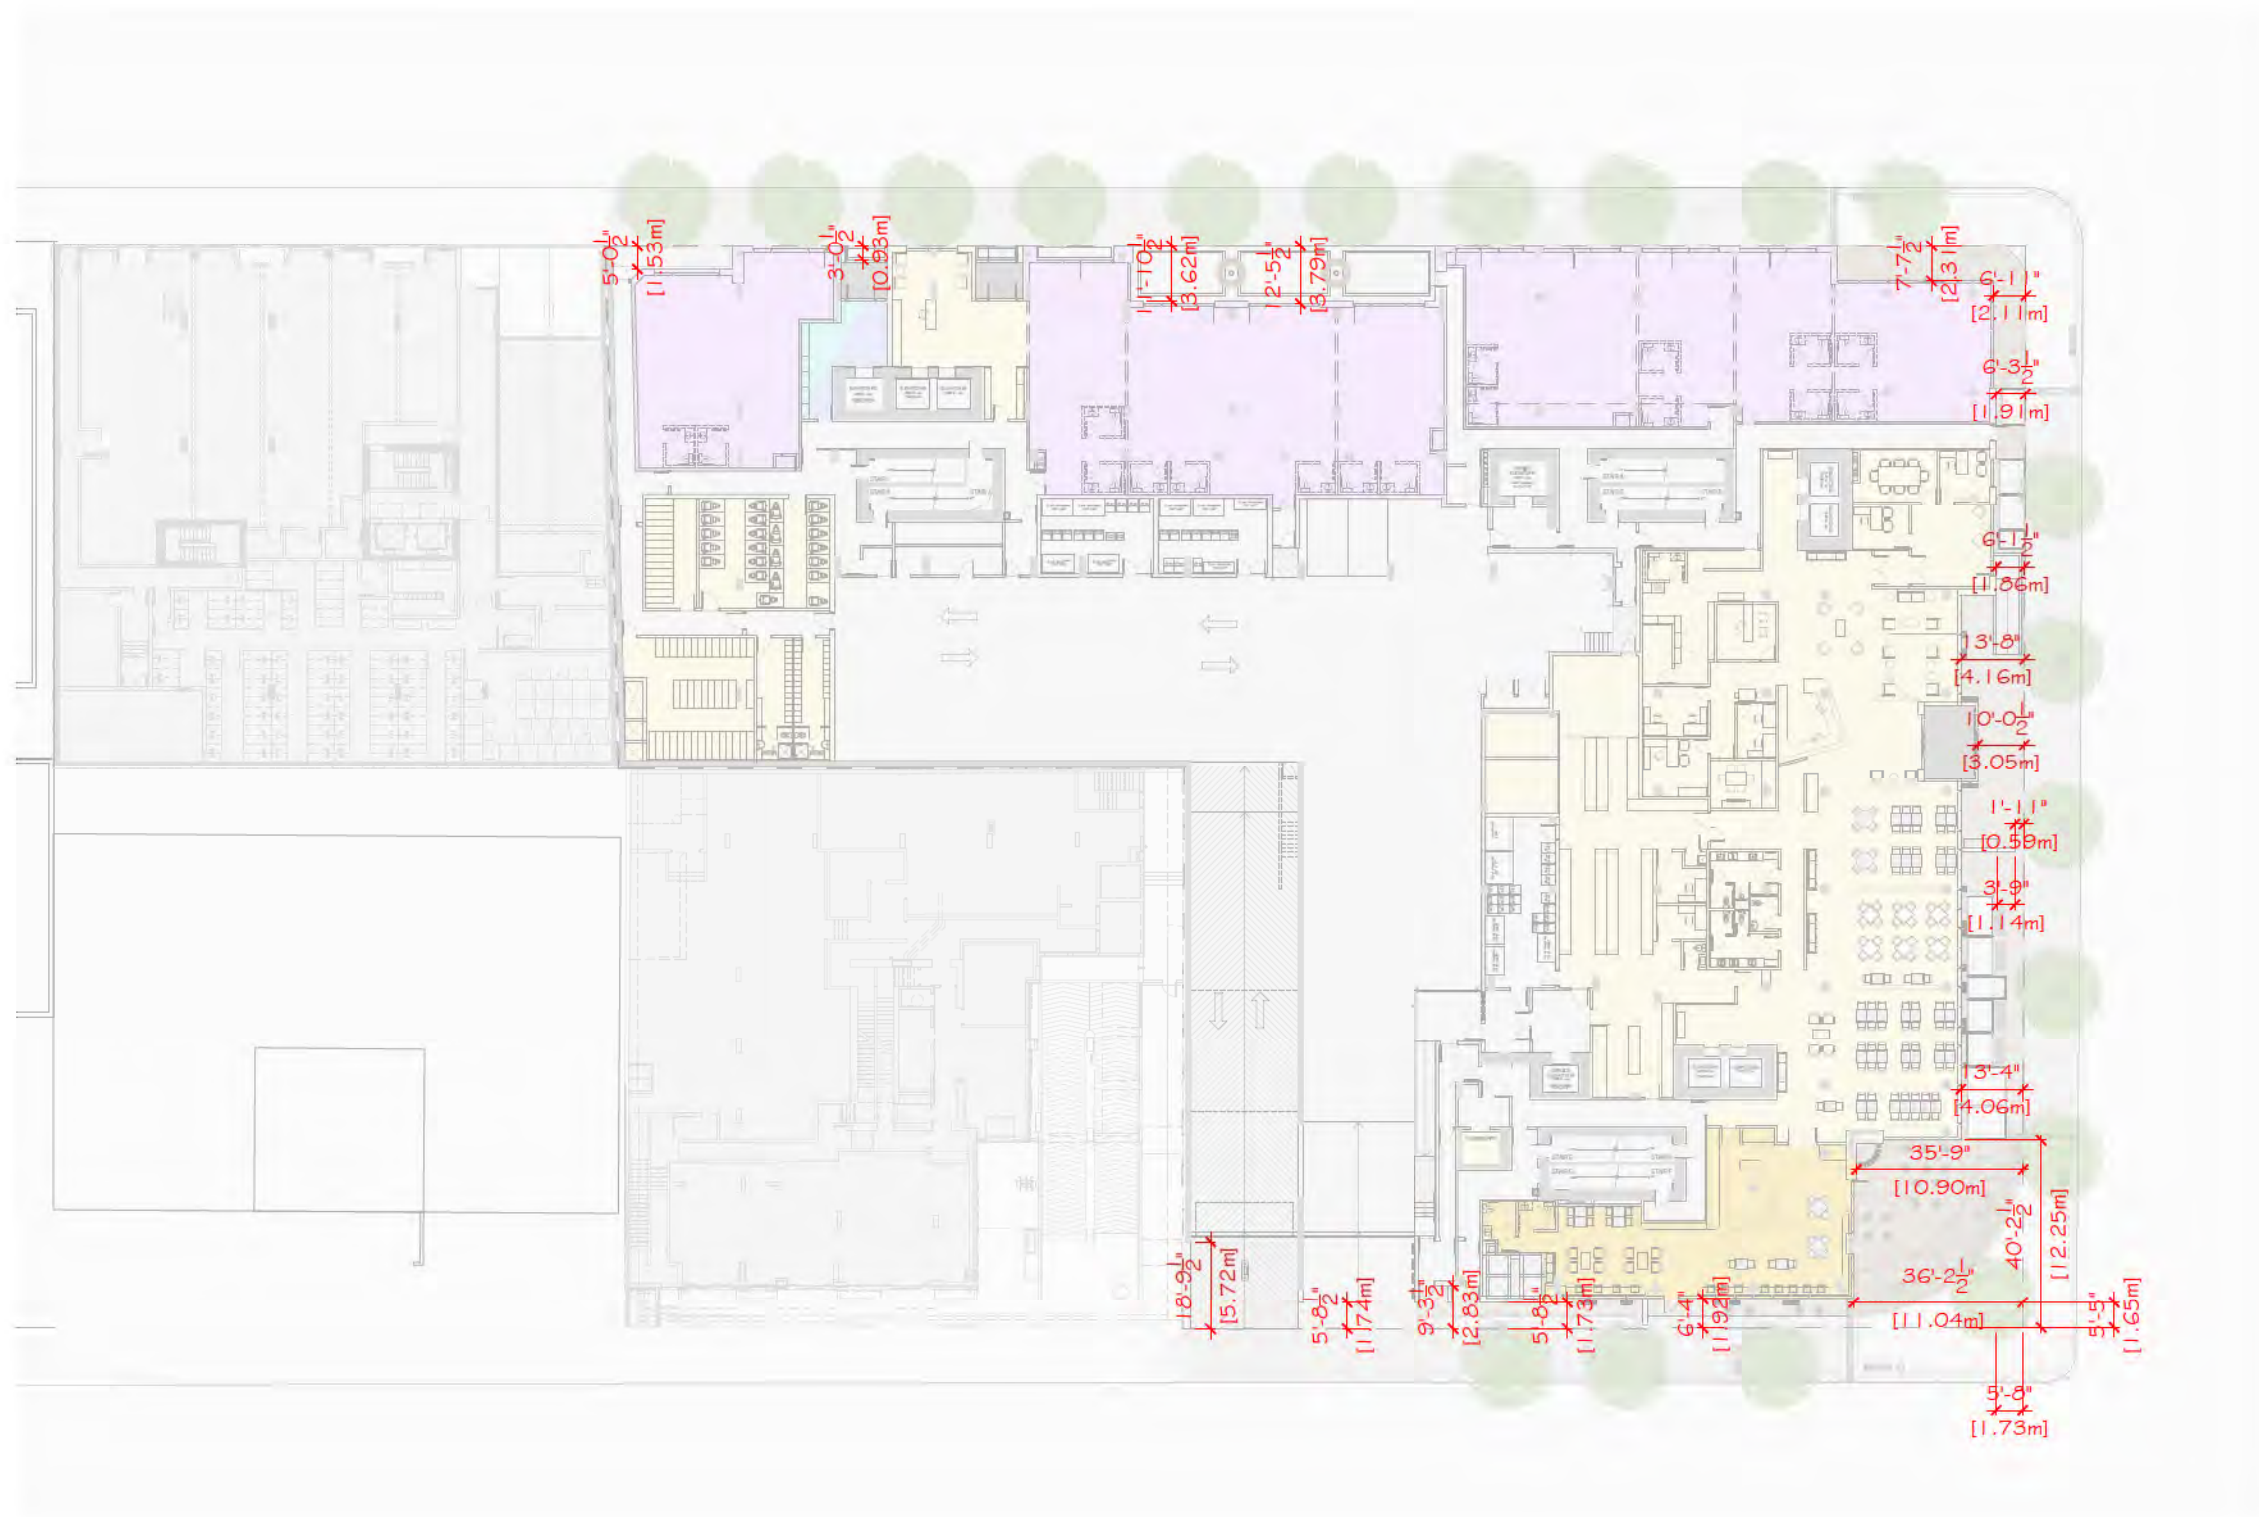

REVISIONS		
NO.	DESCRIPTION	DATE
RE-ISSUED FOR ADP		24 APR 2019
RE-ISSUED FOR REZONING & DP		29 MAY 2019
RE-ISSUED FOR REZONING & DP		29 AUG 2020
RE-ISSUED FOR REZONING & DP		05 MAY 2021
RE-ISSUED FOR REZONING & DP		24 NOV 2021

COPYRIGHT RESERVED

CLIENT

parc
retirement
living

PROJECT NO. _____

17420

PROJECT

PARC VICTORIA
Mixed Use Seniors Residential &
Commercial Development


DRAWING TITLE

FORM OF DEVELOPMENT -
MAIN LEVEL SETBACKS

A012

APR 2017

N.T.S.

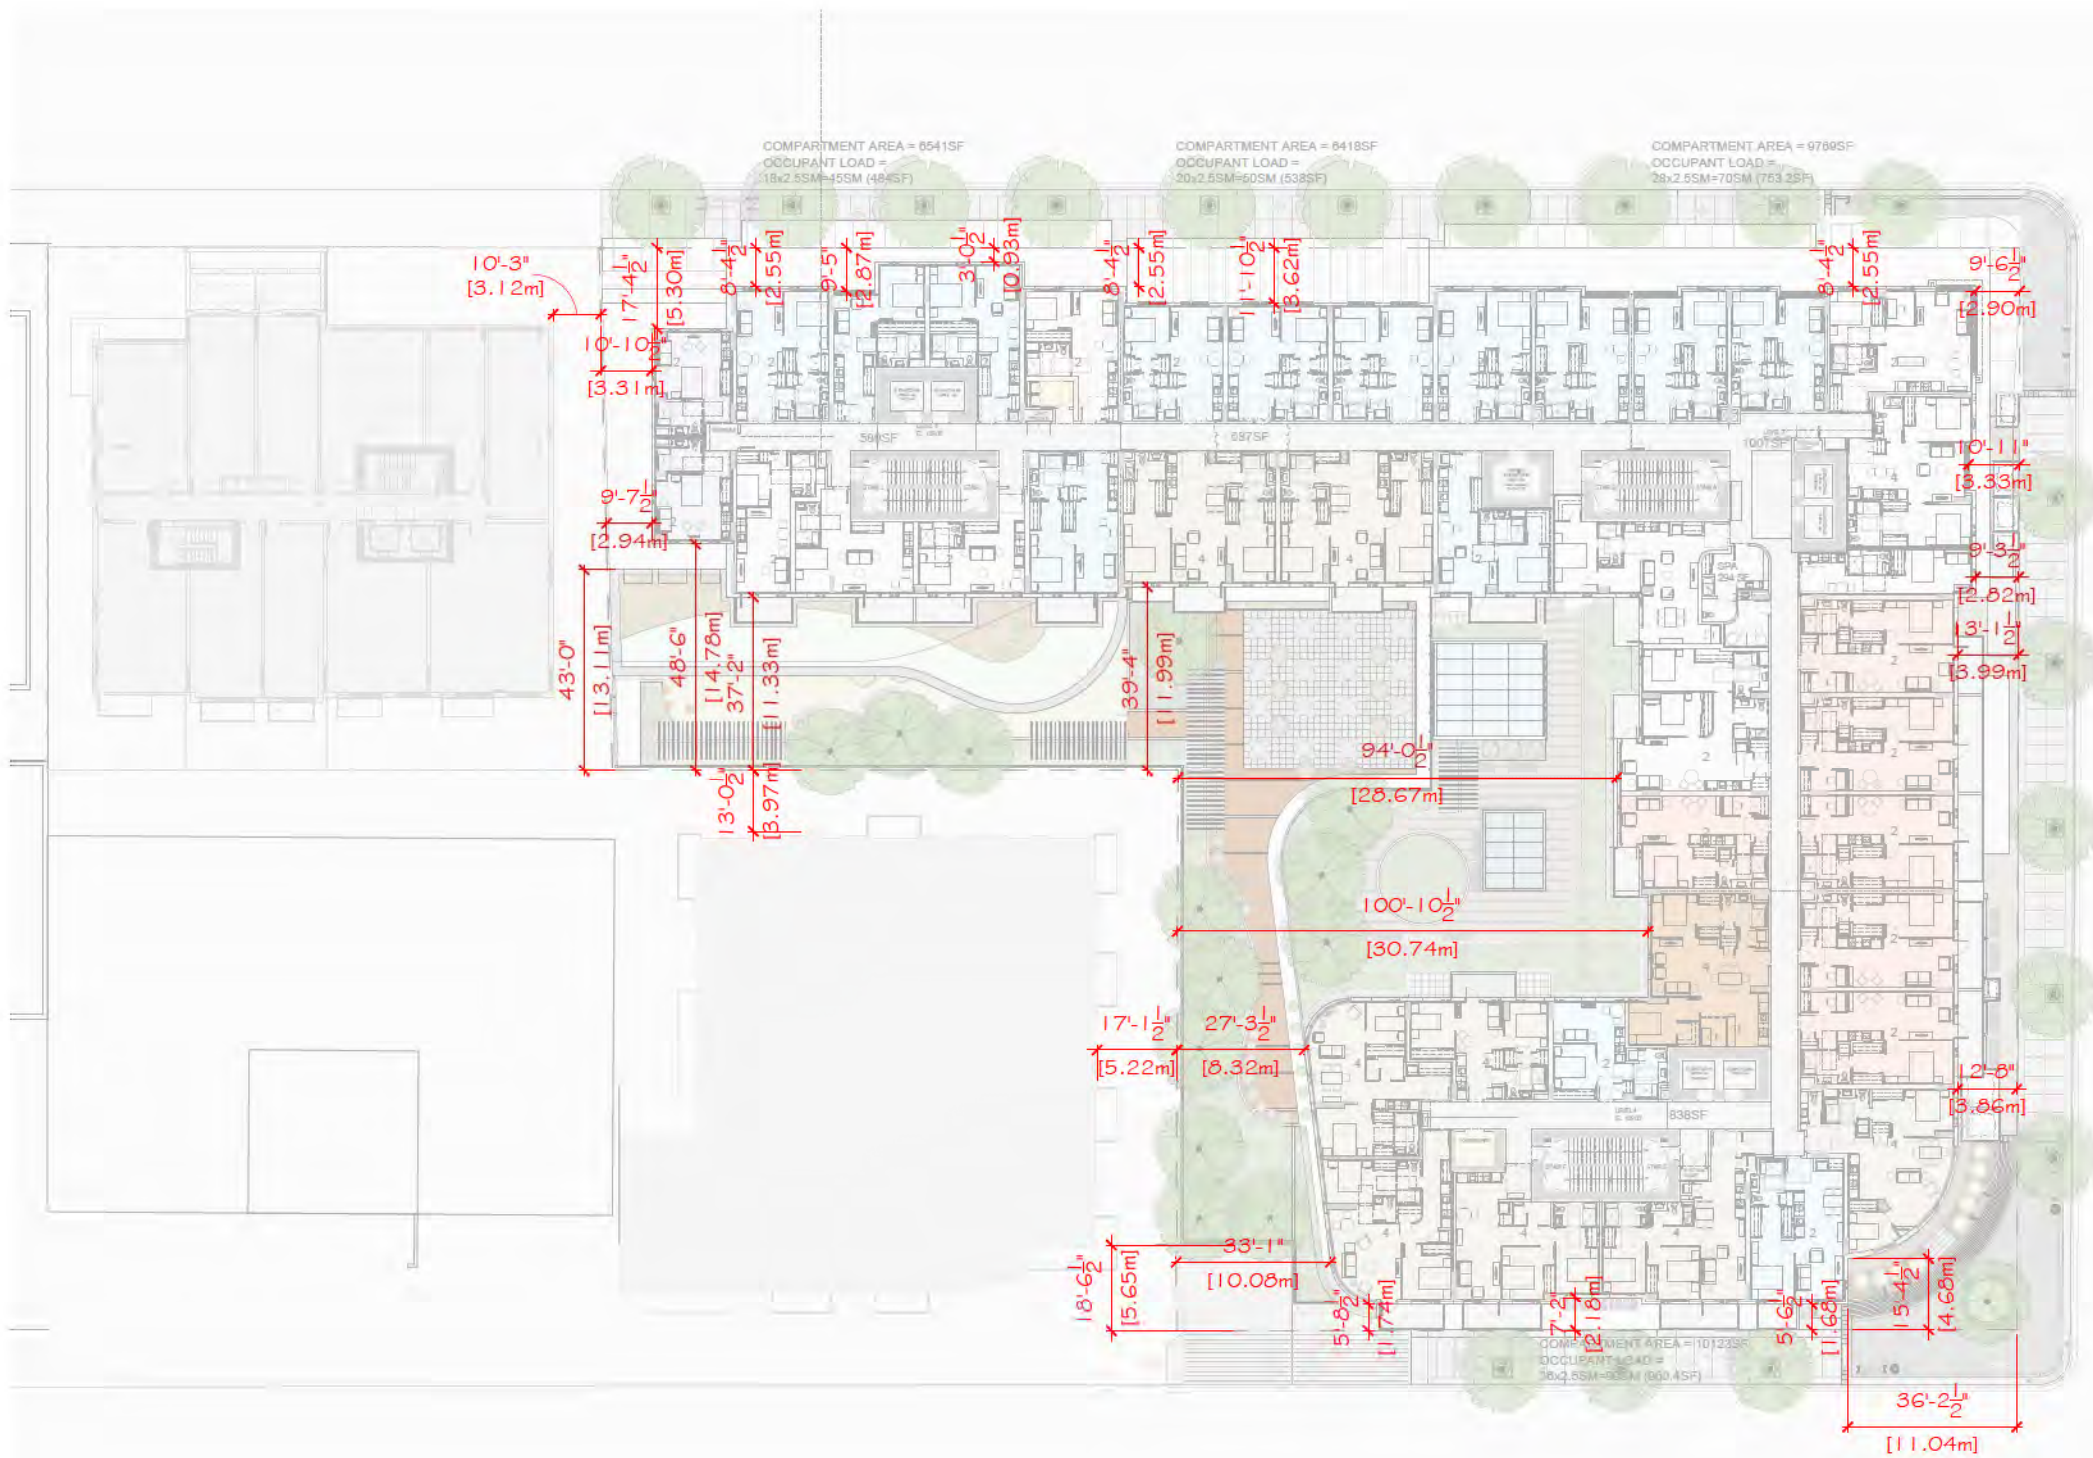



RAINSCREEN WALL ASSEMBLY

FUTURE ROOF PV PANELS



FUTURE ROOF PV PANELS

TRIPLE GLAZING IN METAL & VINYL WINDOWS ON RESIDENTIAL LEVELS

RATIO OF RESIDENTIAL GLAZING TO SOLID WALL: LESS THAN 40%

FUTURE ROOF PV PANELS



QUADRA BUILDING BALCONIES & BRISE SOLEIL ACT AS SHADING DEVICES

SOUTH FACING SHADING DEVICES & BALCONIES

GREEN ROOFS TO REDUCE STORM WATER RUNOFF & HEAT ISLAND EFFECT

QUADRA & BROUGHTON BUILDINGS MAIN LEVEL VERTICAL STREET LEVEL SHADING

bfa studio
architects

ECO-REGIONAL ARCHITECTURE + INTERIOR DESIGN

Formerly BESHABAT FRANKS ARCHITECTS

800 - 355 Blenheim Street
Vancouver, BC V6C 2S8
www.bfaarchitects.com

T 604 682 3543
F 604 542 4060

REVISIONS

NO.	DESCRIPTION	DATE
1	REQUIRED FOR ADP	28 APRIL 2019
2	REQUIRED FOR REVISIONS & DP	20 MAY 2019
3	REQUIRED FOR REVISIONS & DP	26 AUG 2020
4	REQUIRED FOR REVISIONS & DP	09 MAY 2021
5	REQUIRED FOR REVISIONS & DP	24 NOV 2021

Copyright Reserved



CLIENT

parc
retirement
living

PROJECT NO.

17420

PROJECT

PARC VICTORIA
Mixed Use Seniors Residential &
Commercial Development

DESIGN TITLE

FORM OF DEVELOPMENT -
ENVELOPE / PASSIVE
DESIGN STRATEGIES

SCALE

DATE


APR 2017

SCALE

N.T.S.

REVISION

A014

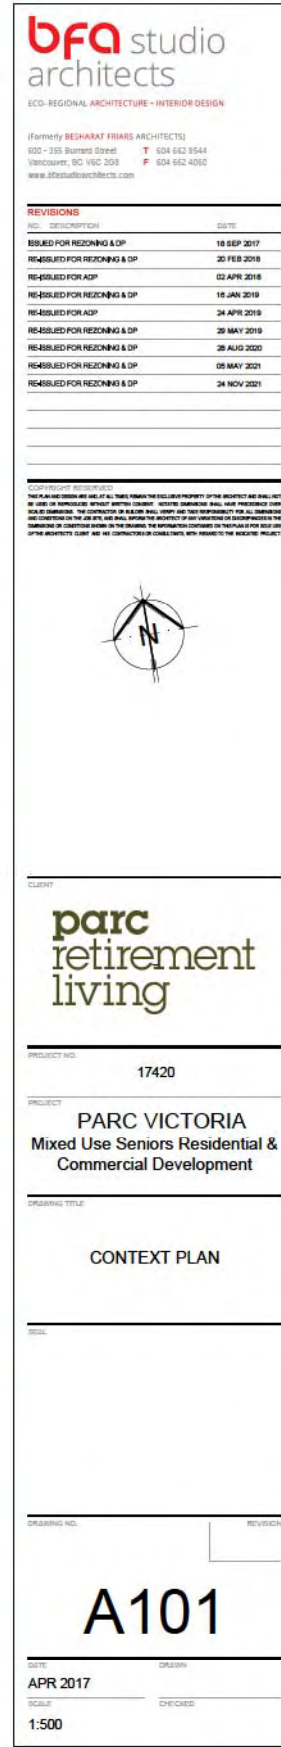



1 AERIAL VIEW OF THE BUILDING & CONTEXT

REVISIONS

NO.	DESCRIPTION	DATE

DISCLAIMER


parc
retirement
living

17420

PROJECT
PARC VICTORIA
Mixed Use Seniors Residential &
Commercial Development

CONTEXT
3D VIEWS


A102

APR 2017

1:500



1 STREET VIEW AT FORT LOOKING WEST

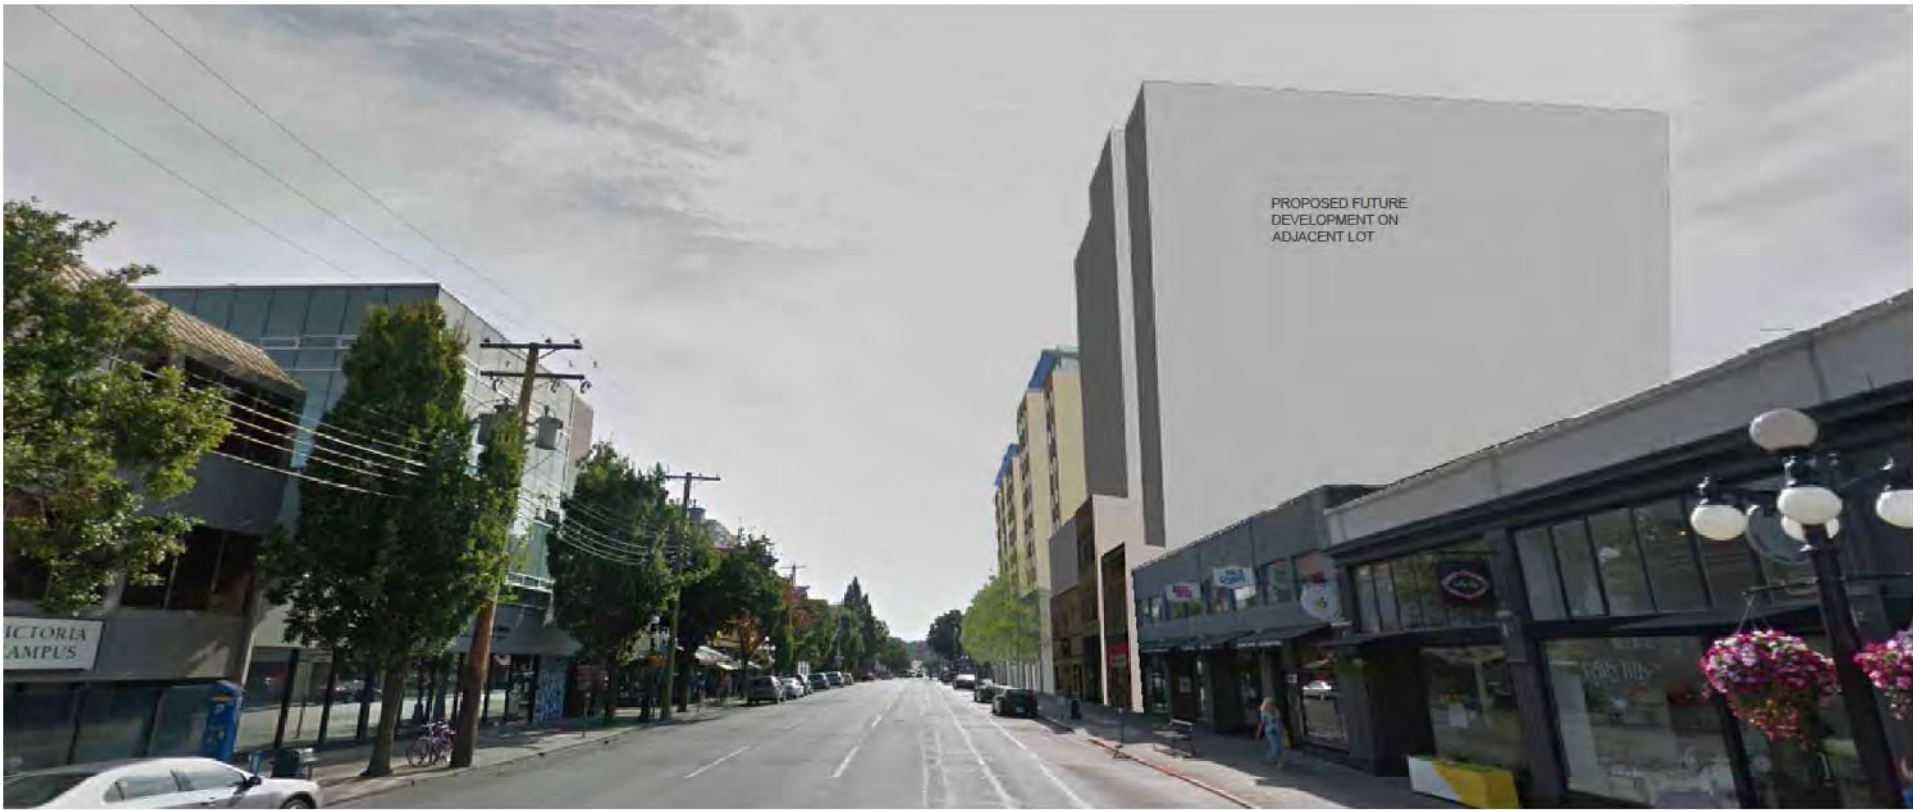

2 STREET VIEW AT FORT LOOKING EAST

NO.	DESCRIPTION	DATE





1 STREET VIEW AT QUADRA LOOKING NORTH



2 STREET VIEW AT QUADRA LOOKING SOUTH

bfa studio
architects

ECO-REGIONAL ARCHITECTURE • INTERIOR DESIGN

(Formerly BESHARAT FRIARS ARCHITECTS)
605 - 335 Burrard Street
Vancouver, BC V6C 2G8
www.bfaarchitects.com

REVISIONS

NO.	DESCRIPTION	DATE



CLIENT

parc
retirement
living

PROJECT NO.

17420

PROJECT

PARC VICTORIA
Mixed Use Seniors Residential &
Commercial Development

DRAWING TITLE

CONTEXT
3D VIEWS

SCALE

DRAWING NO.

REVISION

A104

DATE


APR 2017

SCALE

1:500

DESIGN

CHECKED

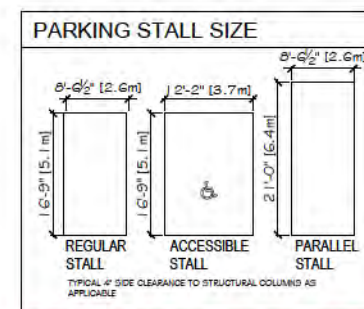


NOTES

- FOR DIMENSIONS OF PARKING STALLS, REFER DWG A300A - A300C
- BUILDING ENTRANCES FROM ADJACENT AREAS WILL INCLUDE GRATES, GRILLES OR SLOTTED SYSTEMS TO LEED REQUIREMENTS

NO.	DESCRIPTION	DATE

Copyright Reserved


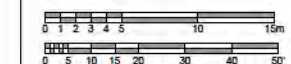

parc
retirement
living


17420

PARC VICTORIA
Mixed Use Seniors Residential & Commercial Development

P1 LEVEL FLOOR PLAN

A201

APR 2017
SCALE
1:200

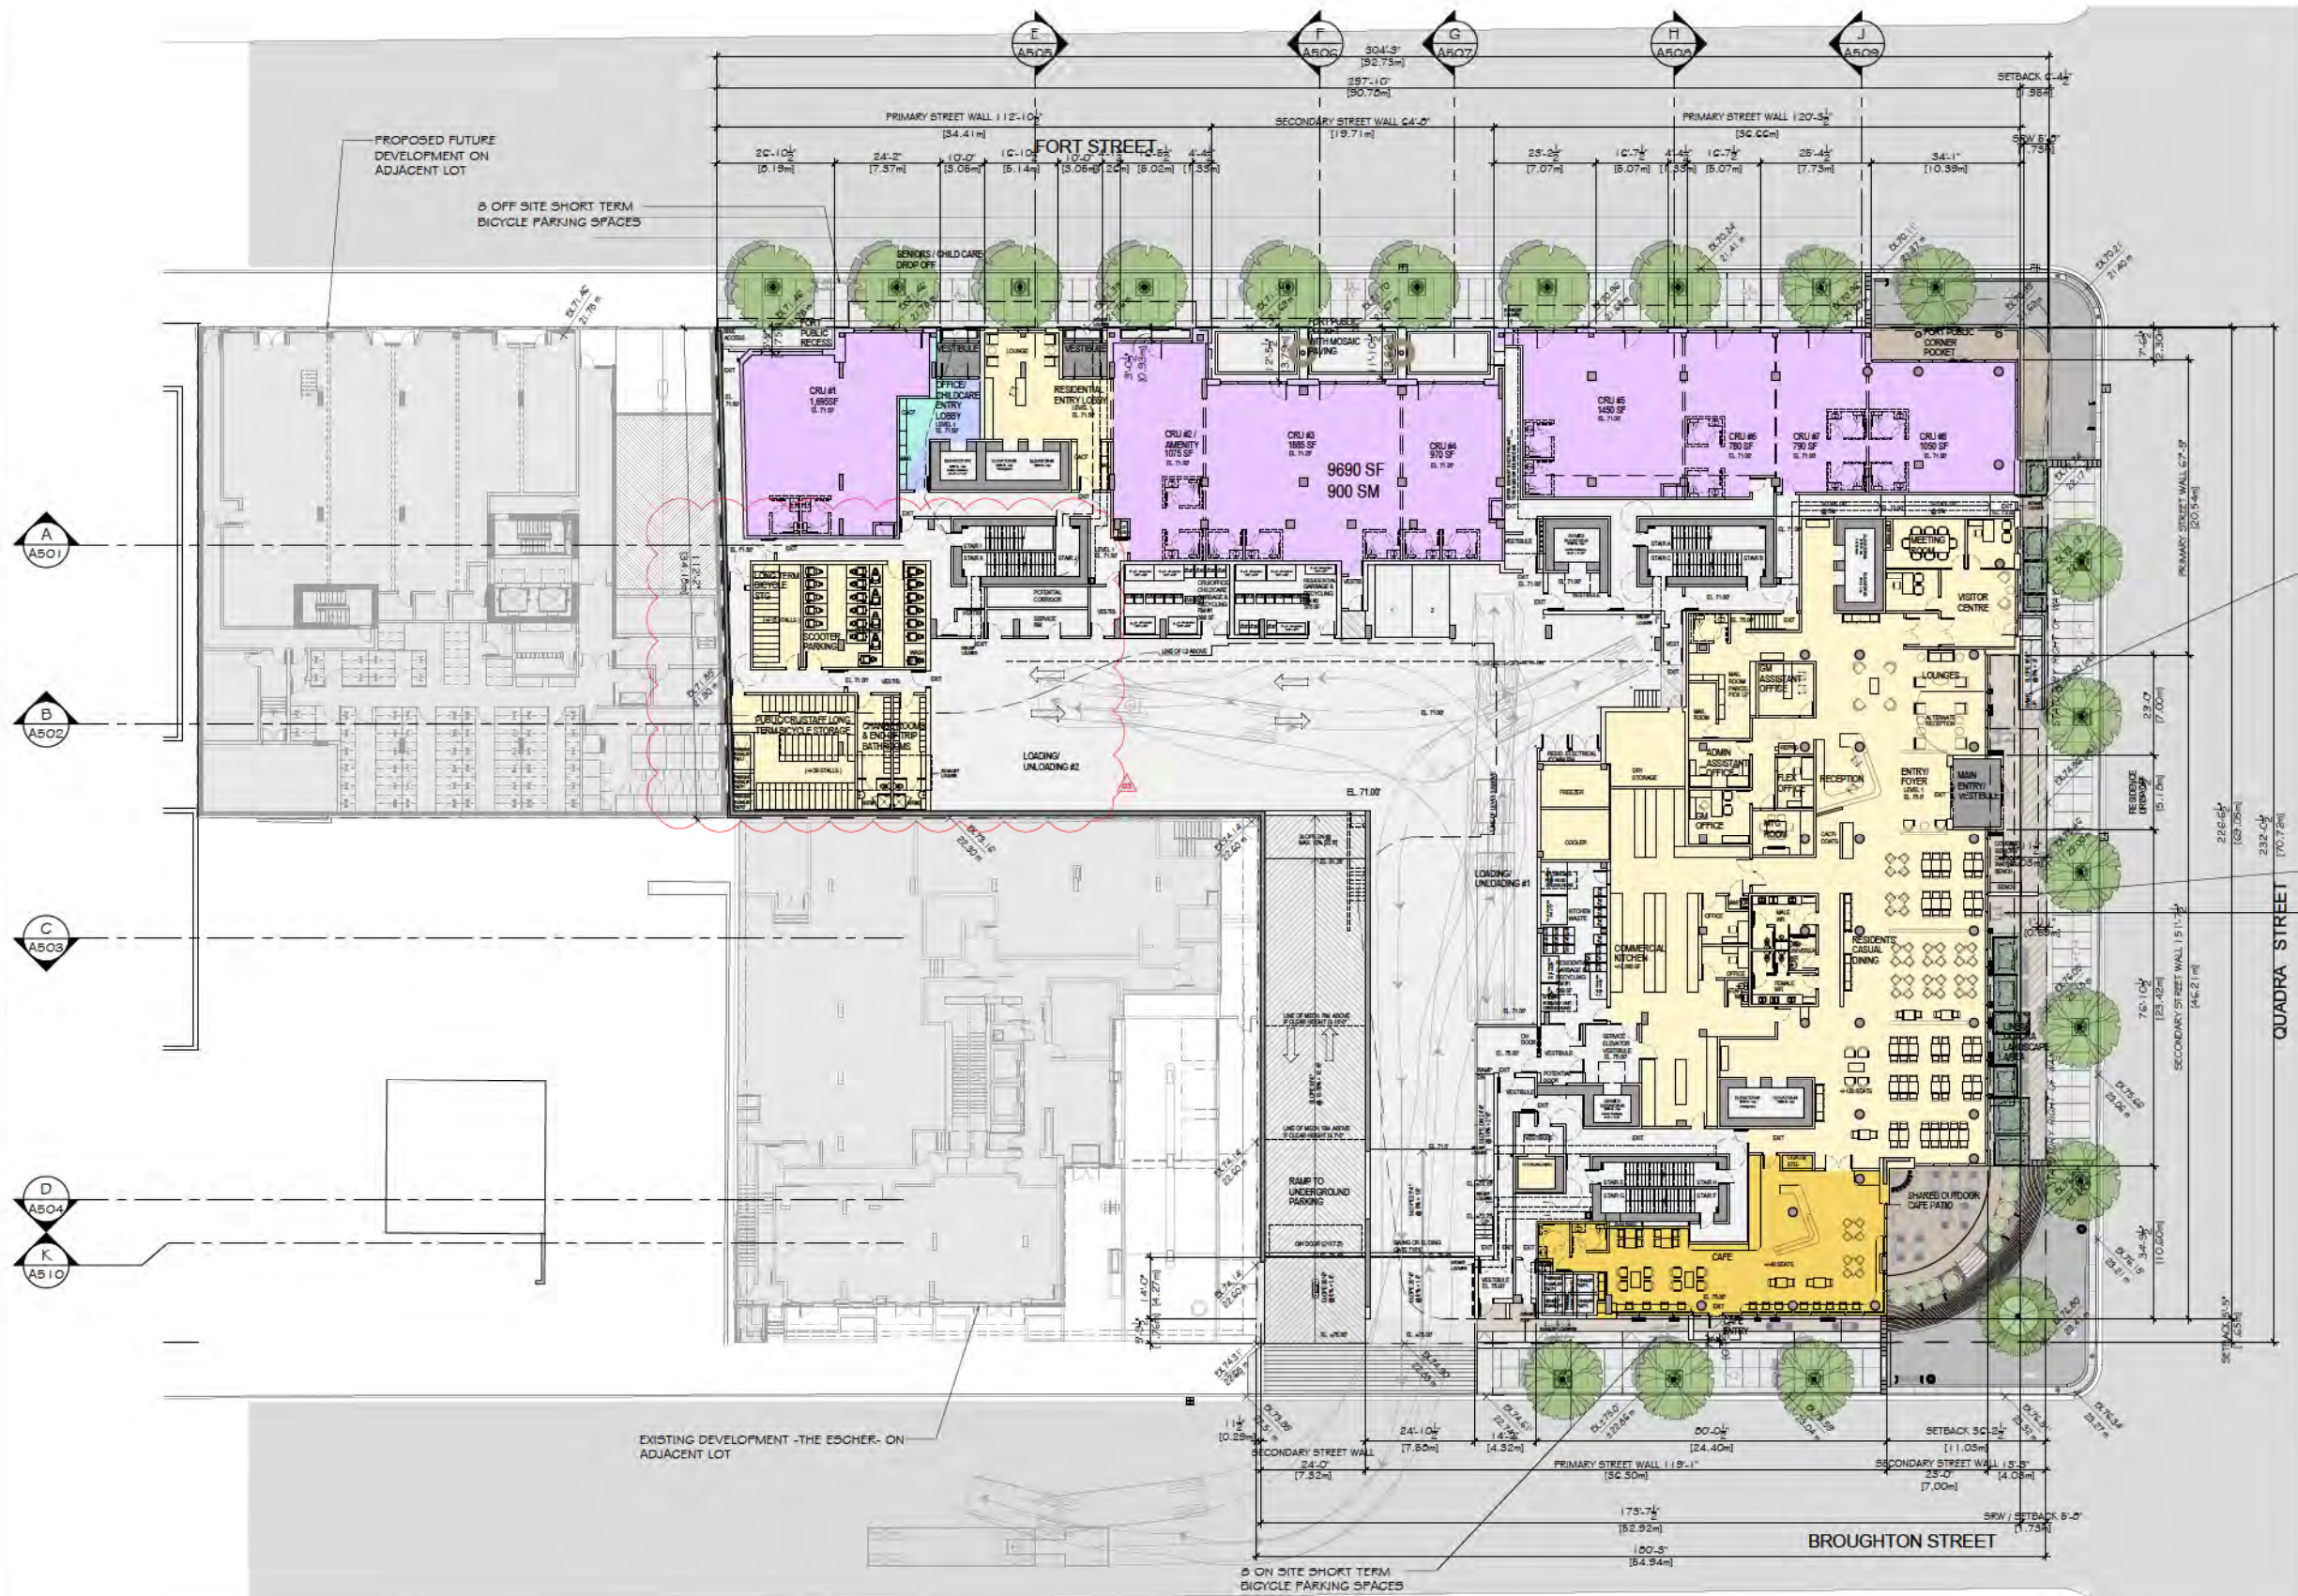

COLOR LEGEND

- AMENITY
- COMMERCIAL RETAIL
- CHILDCARE
- OFFICE MEDICAL
- CIRCULATION/STG/SERVICE RM
- A - STUDIO
- B - 1 BEDROOM
- C - 1 BEDROOM + FLEX
- D - 2 BEDROOM
- E - 2 BEDROOM + FLEX
- F - 3 BEDROOM

NOTES

- FOR DIMENSIONS OF PARKING STALLS, REFER TO DWG A500K - A500C
- FOR FINISH GRADE ELEVATIONS, REFER TO CIVIL DRAWINGS
- BUILDING ENTRANCES FROM ADJACENT AREAS WILL INCLUDE GRATES, GRILLES OR SLOTTED SYSTEMS TO LEED REQUIREMENTS

PARKING STALL SIZE




TYPICAL 4" SIDE CLEARANCE TO STRUCTURAL COLUMNS AS APPLICABLE

bfa studio architects




WWW.BFASSTUDIOARCHITECTS.COM

REVISIONS

NO.	DESCRIPTION	DATE
1	ISSUED FOR REZONING & DP	19 SEP 2017

parc retirement living


17420

PARC VICTORIA
Mixed Use Seniors Residential & Commercial Development

SITE PLAN/LEVEL 1 FLOOR PLAN

A202A

SCALE: 1:200

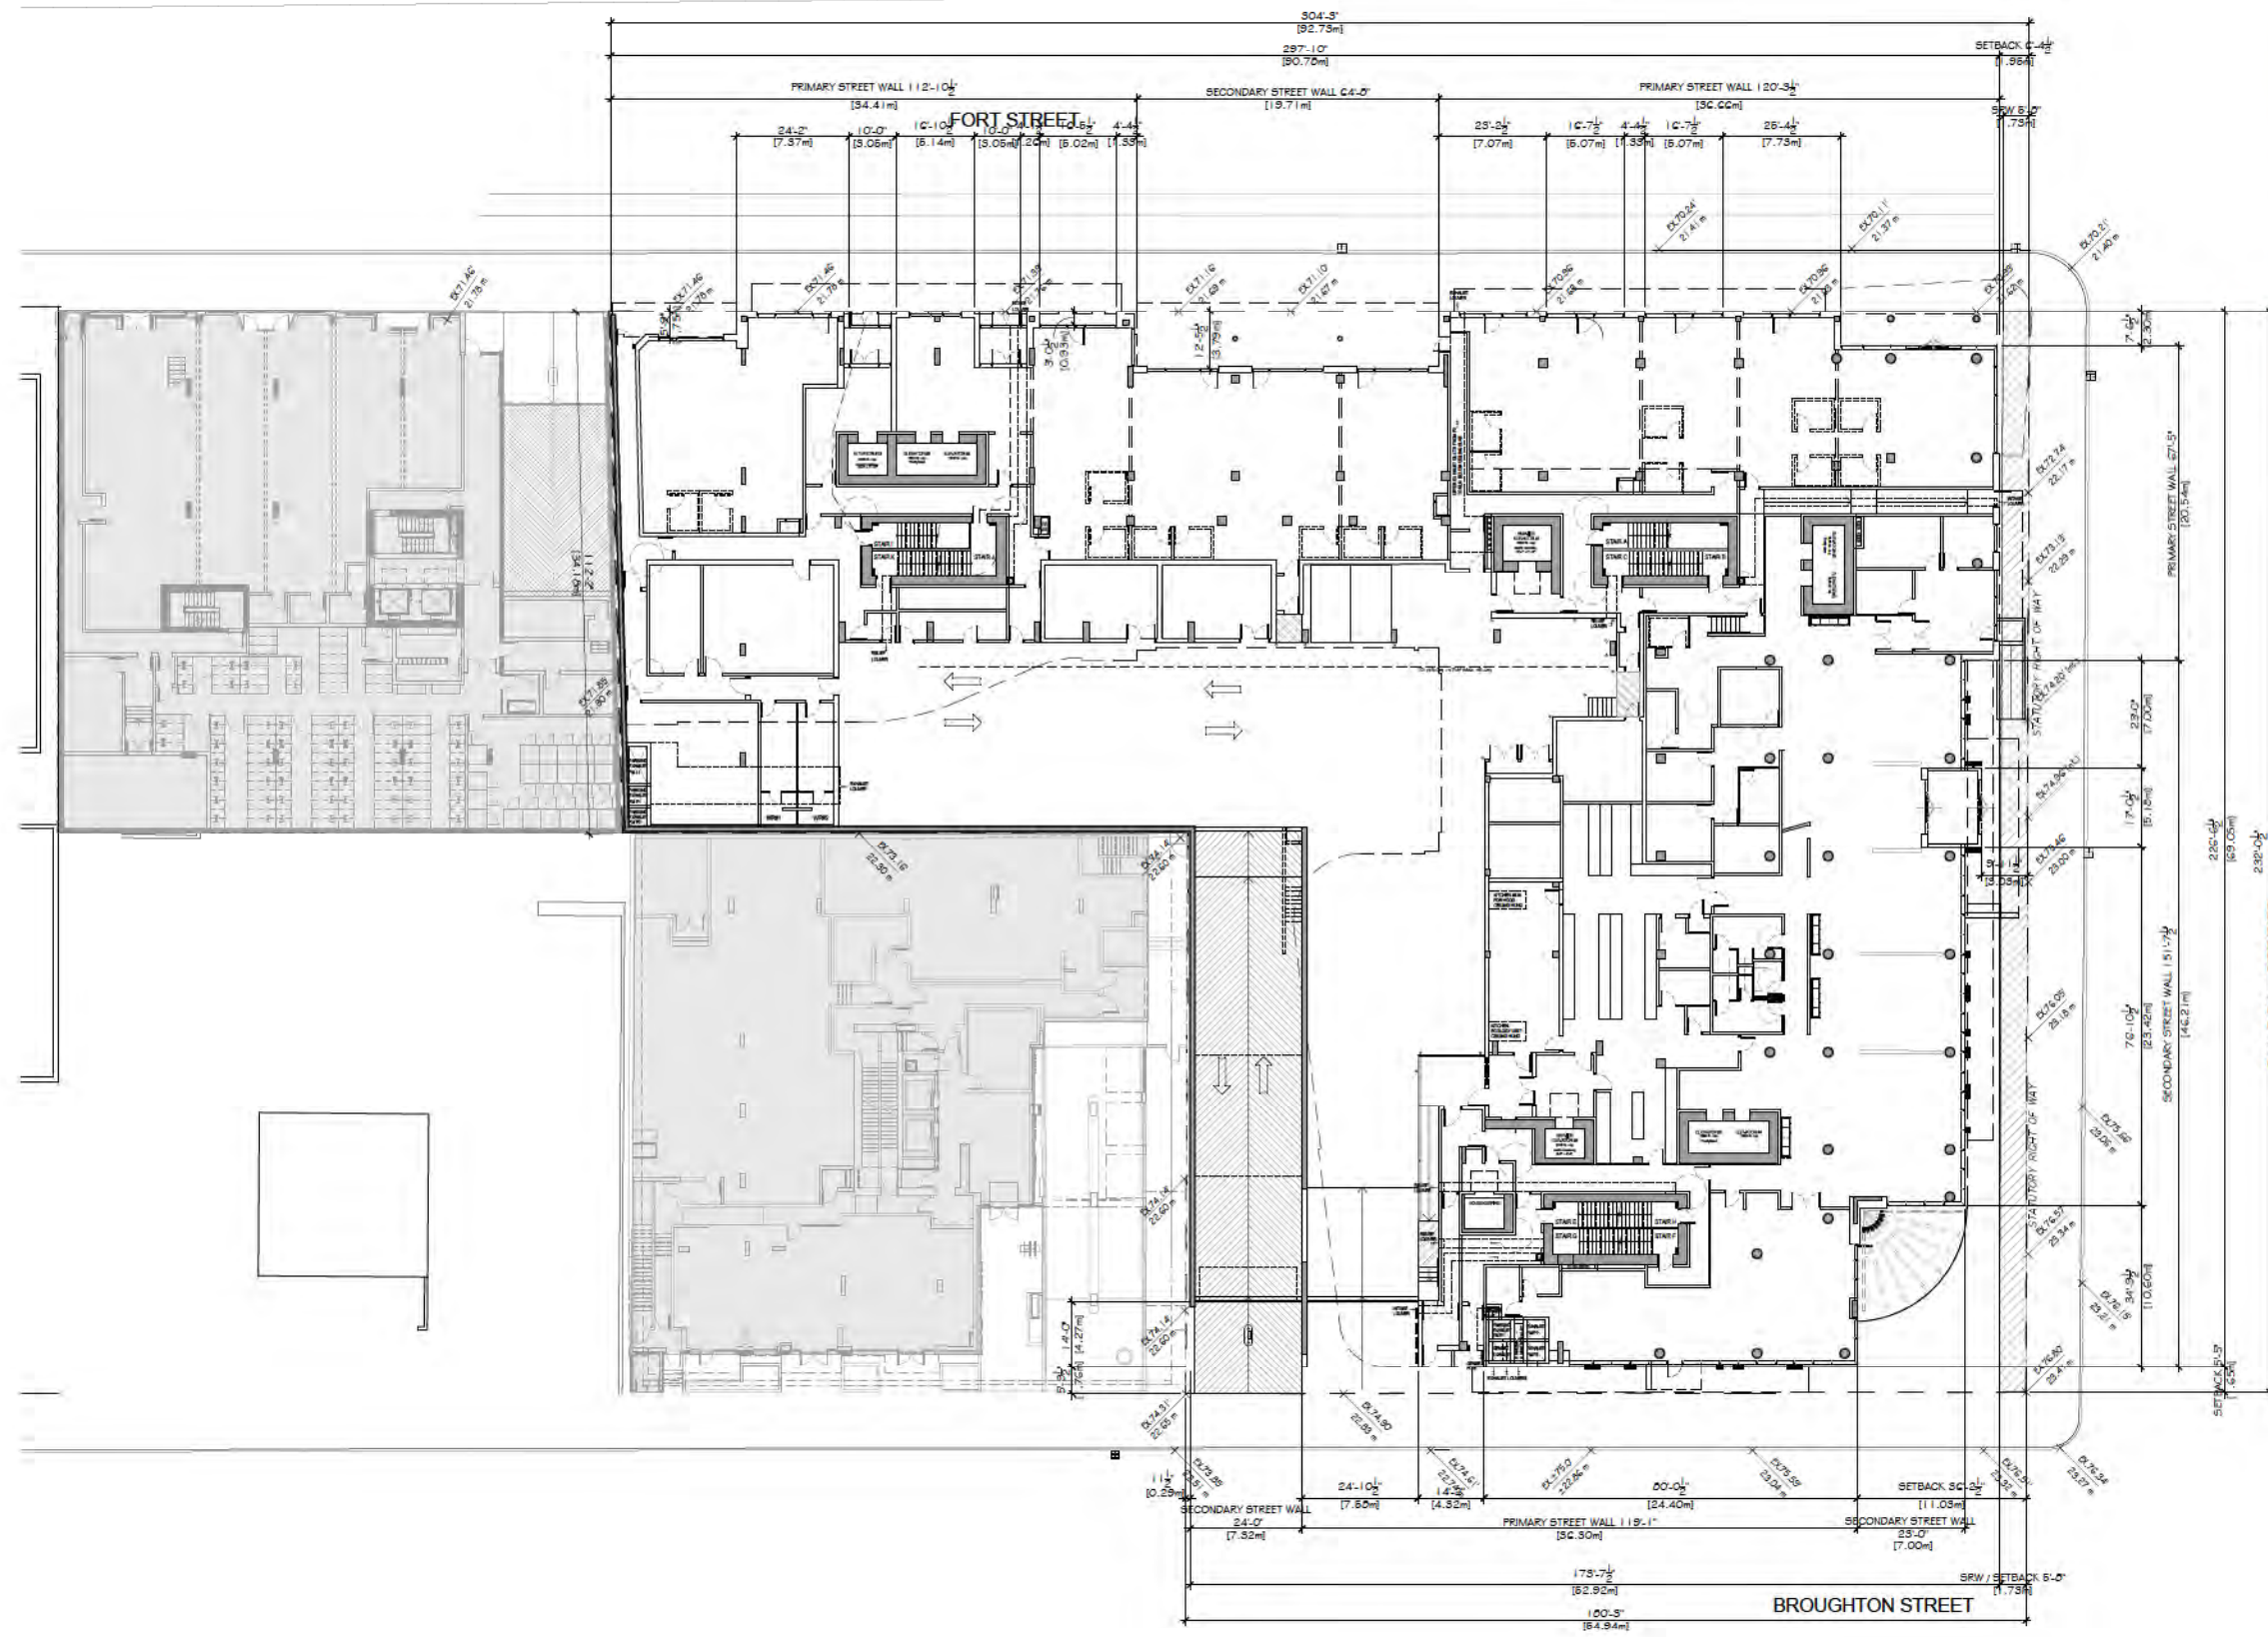

COLOR LEGEND

- AMENITY
- COMMERCIAL RETAIL
- CHILDCARE
- OFFICE MEDICAL
- CIRCULATION/STG/SERVICE RM
- A - STUDIO
- B - 1 BEDROOM
- C - 1 BEDROOM + FLEX
- D - 2 BEDROOM
- E - 2 BEDROOM + FLEX
- F - 3 BEDROOM

bfa studio architects
ECO-REGIONAL ARCHITECTURE + INTERIOR DESIGN

(Formerly) BESHARAT FARRAS ARCHITECTS
607 - 555 Burrard Street
Vancouver, BC V6C 2S8
www.bfaarchitects.com

T 604 942 1544
F 604 942 4582

REVISIONS

NO.	DESCRIPTION	DATE
1	ISSUED FOR REZONING & DP	18 SEP 2017
2	REVISUED FOR REZONING & DP	20 FEB 2018
3	REVISUED FOR ADP	02 APR 2018
4	REVISUED FOR REZONING & DP	18 JAN 2019
5	REVISUED FOR ADP	24 APR 2019
6	REVISUED FOR REZONING & DP	26 MAY 2019
7	REVISUED FOR REZONING & DP	28 AUG 2020
8	REVISUED FOR REZONING & DP	09 MAY 2021
9	REVISUED FOR REZONING & DP	24 NOV 2021


17420

PARC VICTORIA
Mixed Use Seniors Residential & Commercial Development

**SITE PLAN/ LEVEL 1
FLOOR PLAN**

A202B

SCALE: 1:200

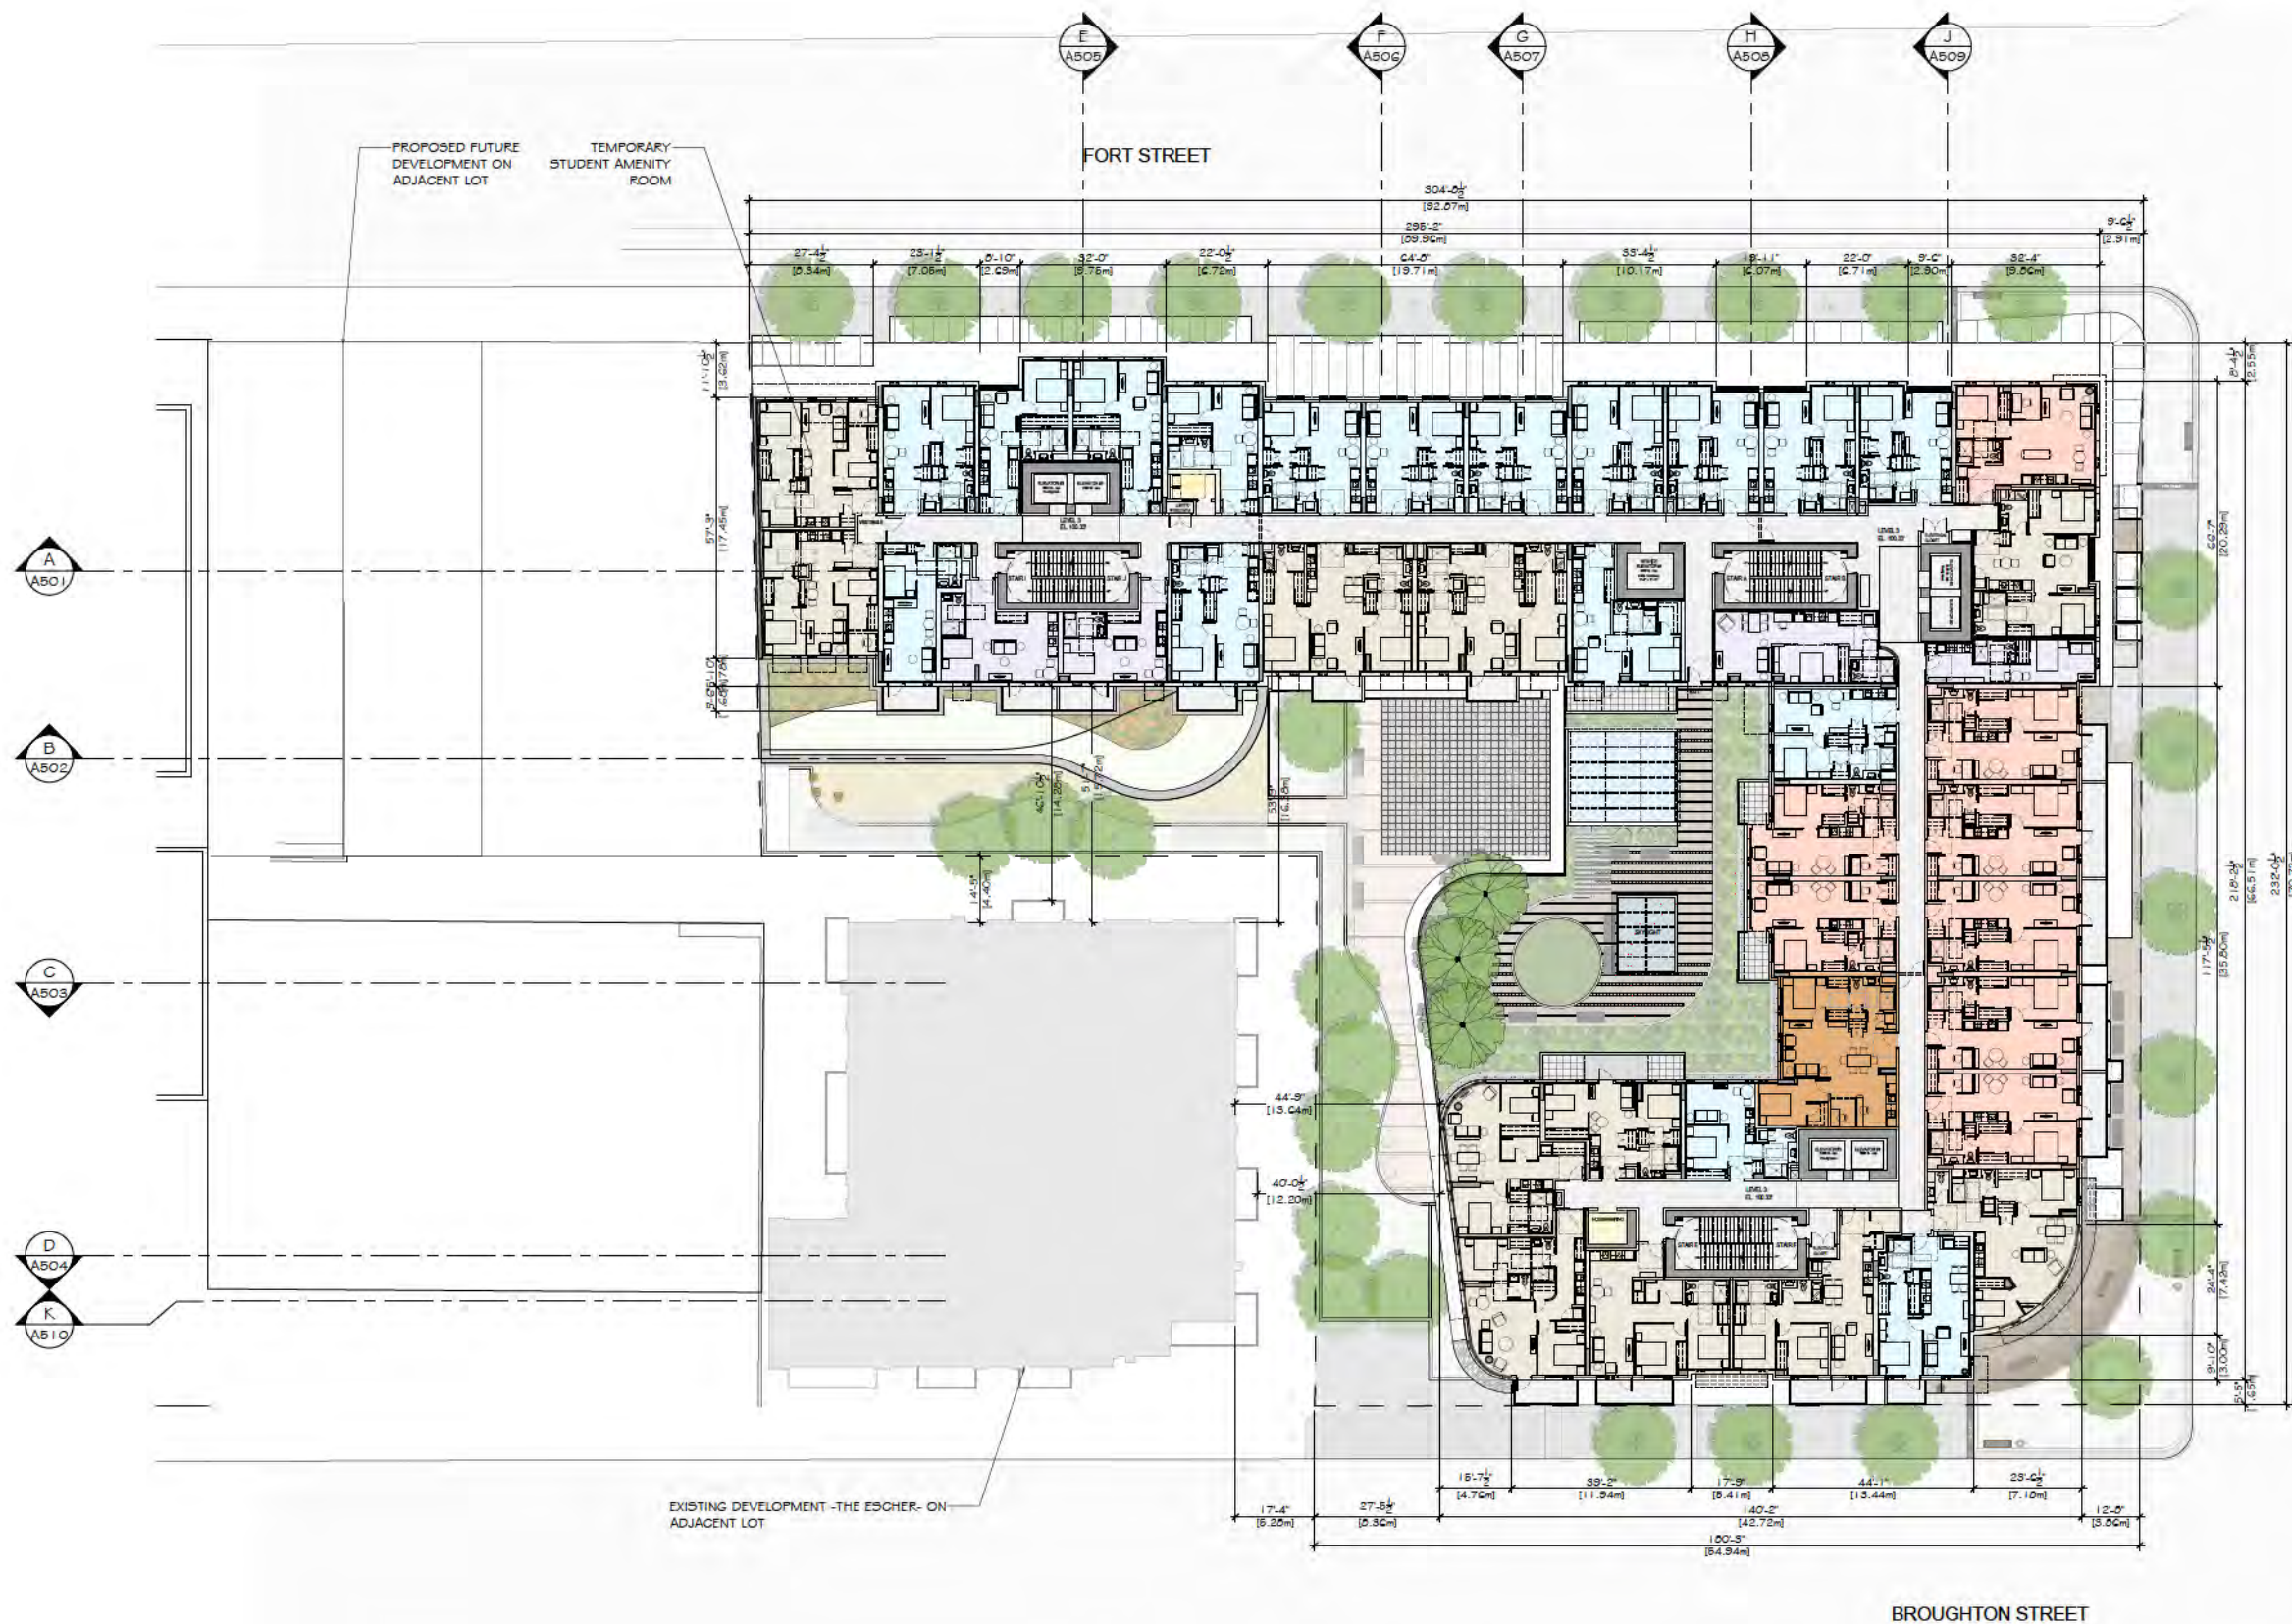

COLOR LEGEND

- AMENITY
- COMMERCIAL RETAIL
- CHILDCARE
- OFFICE MEDICAL
- CIRCULATION/STG/SERVICE RM
- A - STUDIO
- B - 1 BEDROOM
- C - 1 BEDROOM + FLEX
- D - 2 BEDROOM
- E - 2 BEDROOM + FLEX
- F - 3 BEDROOM

NOTES

1. BUILDING ENTRANCES FROM ADJACENT AREAS WILL INCLUDE GRATES, GRILLES OR SLOTTED SYSTEMS TO LEED REQUIREMENTS.

bfa studio architects
ECO-REGIONAL ARCHITECTURE + INTERIOR DESIGN

(Formerly BISHOP & FRANK ARCHITECTS)
600 - 355 Burrard Street
Vancouver, BC V6C 2S6
www.bfaarchitects.com

REVISIONS

NO.	DESCRIPTION	DATE
1	ISSUED FOR REZONING & DP	18 SEP 2017
2	RE-REVISED FOR REZONING & DP	30 FEB 2018
3	RE-REVISED FOR ADP	02 APR 2018
4	RE-REVISED FOR REZONING & DP	18 JAN 2019
5	RE-REVISED FOR ADP	24 APR 2019
6	RE-REVISED FOR REZONING & DP	28 MAY 2019
7	RE-REVISED FOR REZONING & DP	28 AUG 2020
8	RE-REVISED FOR REZONING & DP	08 MAY 2021
9	RE-REVISED FOR REZONING & DP	24 NOV 2021

parc retirement living

PROJECT: 17420

SUBJECT: PARC VICTORIA
Mixed Use Seniors Residential & Commercial Development

LEVEL 3
UNITS FLOOR PLAN

A205

SCALE: 1:200



COLOR LEGEND	
	AMENITY
	COMMERCIAL RETAIL
	CHILDCARE
	OFFICE MEDICAL
	CIRCULATION/STG/SERVICE RM
	A - STUDIO
	B - 1 BEDROOM
	C - 1 BEDROOM + FLEX
	D - 2 BEDROOM
	E - 2 BEDROOM + FLEX
	F - 3 BEDROOM

bfa studio
architects
ECO. REGIONAL ARCHITECTURE + INTERIOR DESIGN

Formerly BISHOP & FRANK ARCHITECTS
 500 - 105 Summit Street
 Vancouver, BC V6C 2S8
 Tel: 604 682 4541
 Fax: 604 682 4550
 www.bfaarchitects.com

REV.	DESCRIPTION	DATE
1	ISSUED FOR PERMITS	18 SEP 2017
2	ISSUED FOR PERMITS & DP	20 FEB 2018
3	RE-ISSUED FOR PERMITS & DP	22 APR 2018
4	RE-ISSUED FOR PERMITS & DP	18 JAN 2019
5	RE-ISSUED FOR PERMITS & DP	24 APR 2019
6	RE-ISSUED FOR PERMITS & DP	26 MAY 2019
7	RE-ISSUED FOR PERMITS & DP	26 AUG 2020
8	RE-ISSUED FOR PERMITS & DP	05 MAY 2021
9	RE-ISSUED FOR PERMITS & DP	24 NOV 2021

parc
retirement
living

PROJECT NO. 17420


PROJECT PARC VICTORIA
Mixed Use Seniors Residential & Commercial Development

DATE 17420-04-01

LEVEL 4
FLOOR PLAN

A206

SCALE 1:200

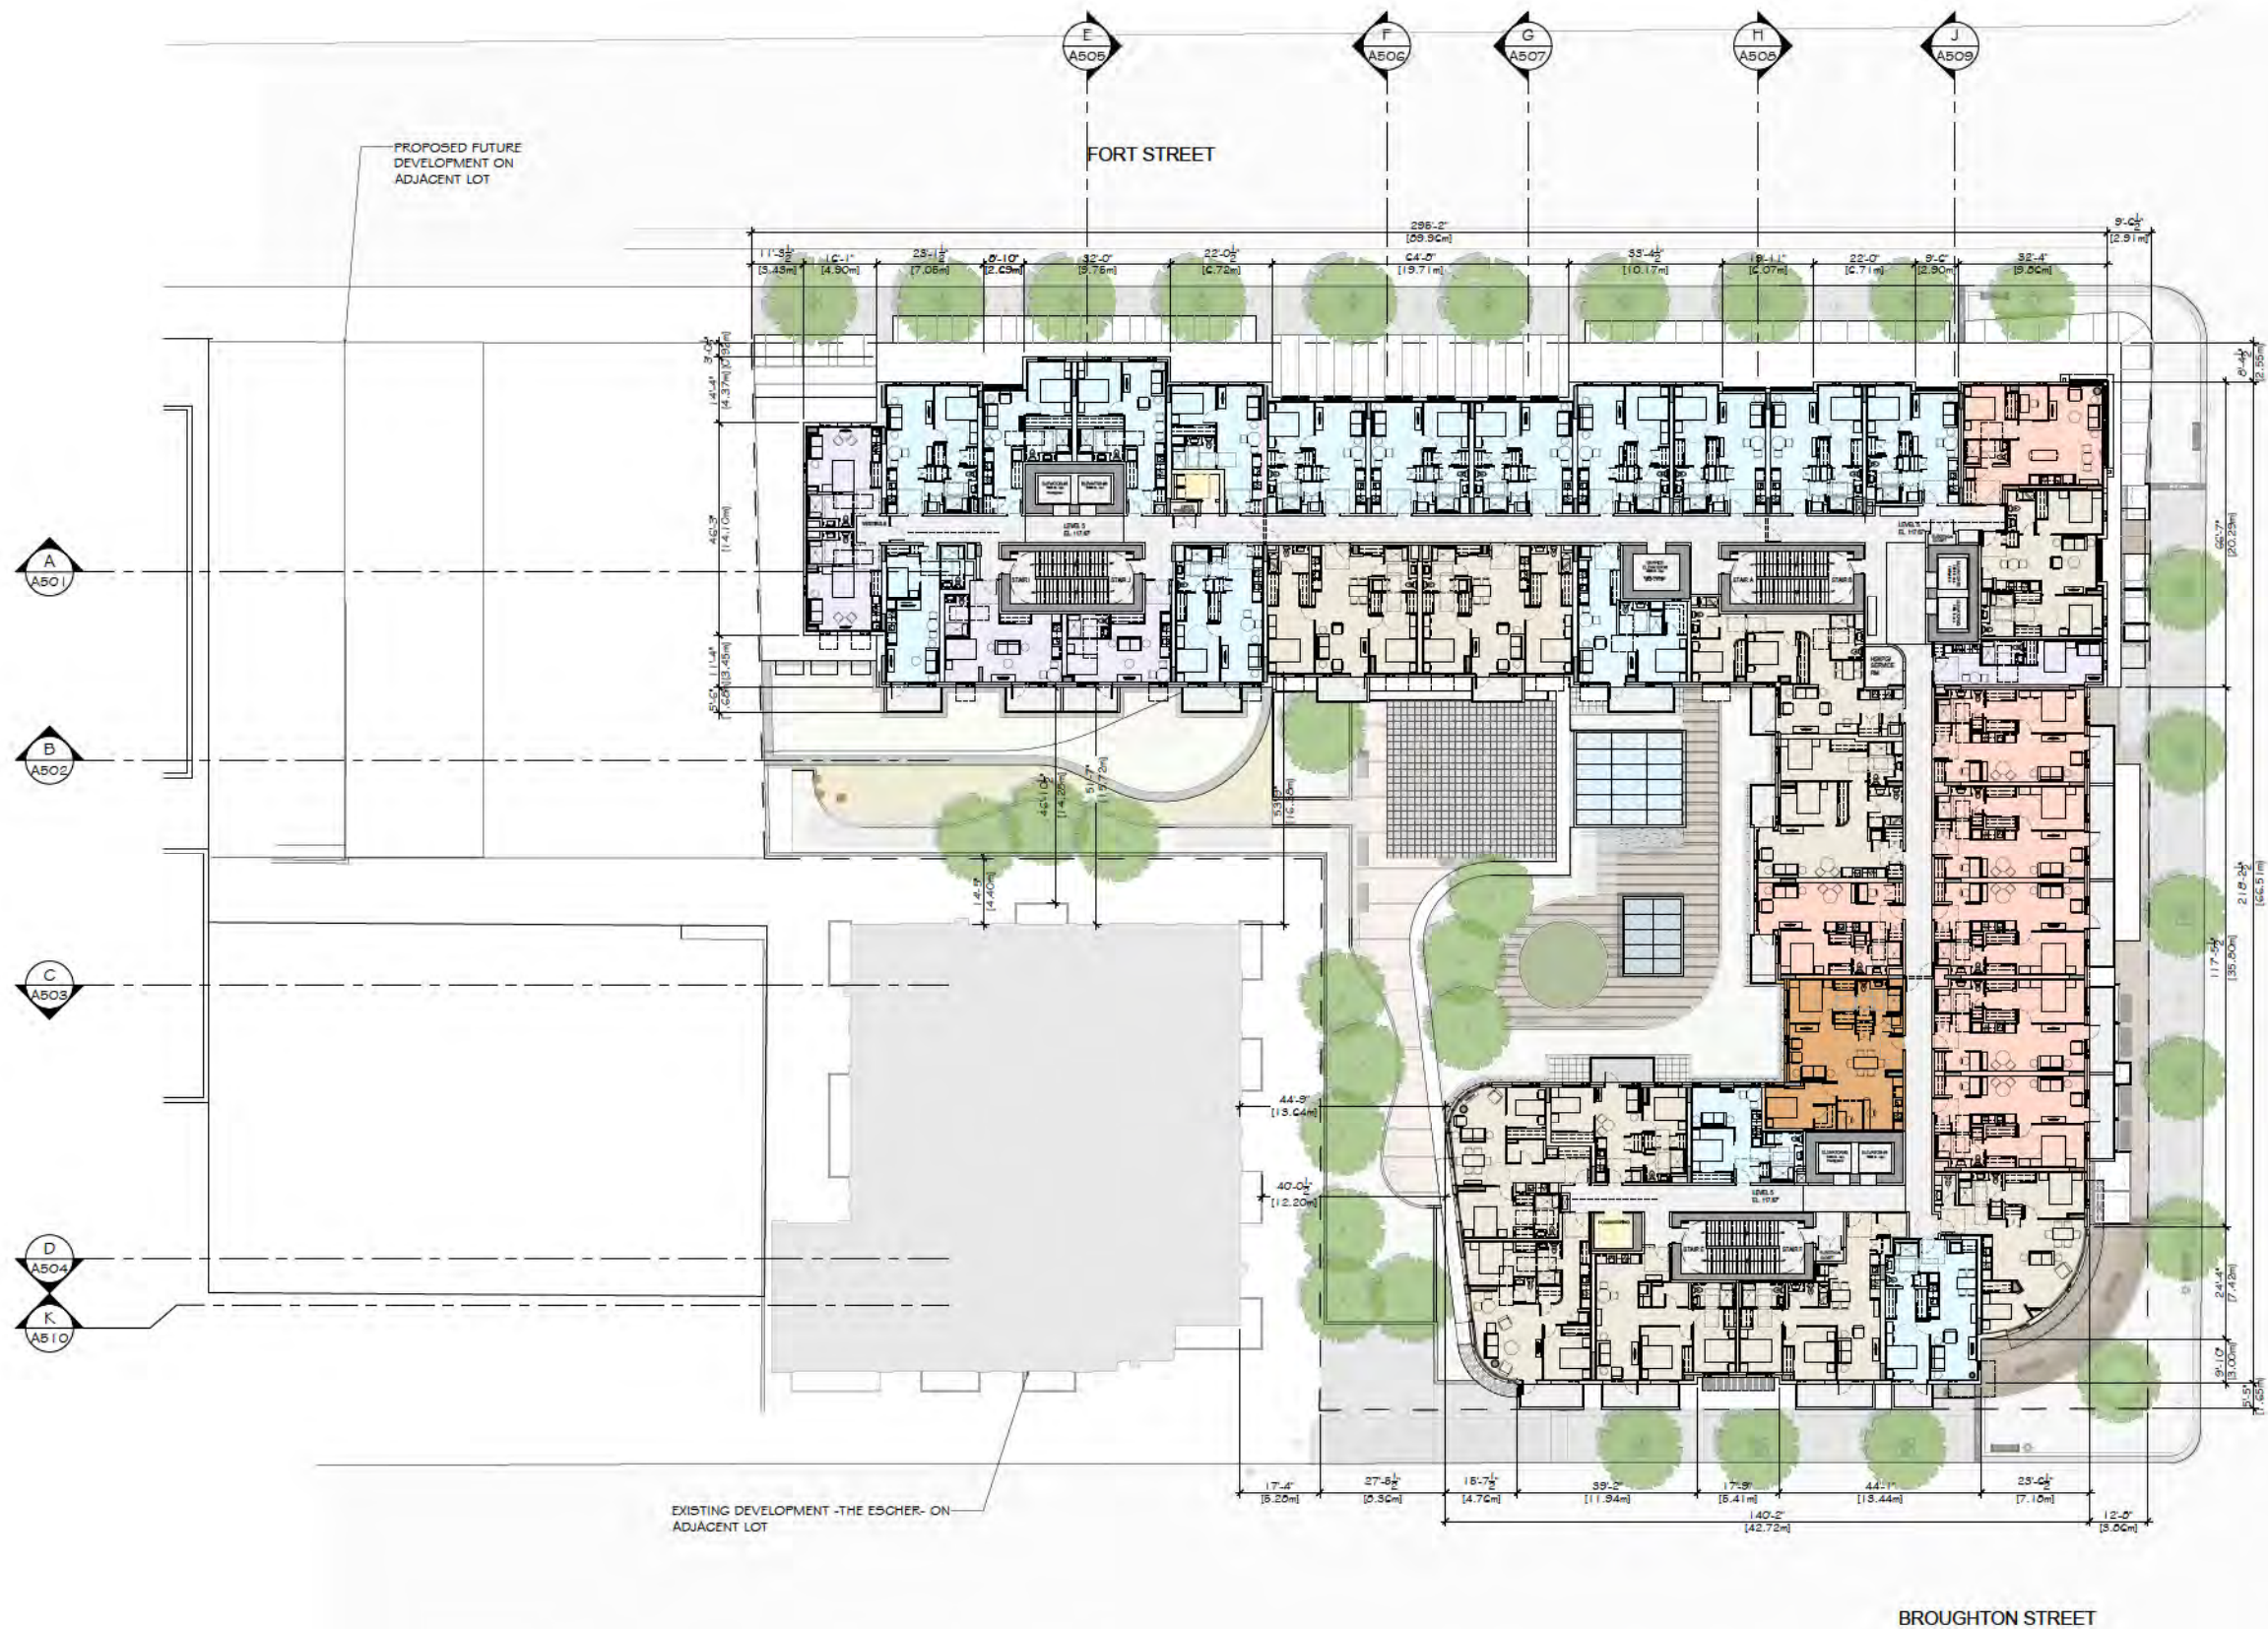

COLOR LEGEND

AMENITY
COMMERCIAL RETAIL
CHILDCARE
OFFICE MEDICAL
CIRCULATION/STG/SERVICE RM
A - STUDIO
B - 1 BEDROOM
C - 1 BEDROOM + FLEX
D - 2 BEDROOM
E - 2 BEDROOM + FLEX
F - 3 BEDROOM

bfa studio architects
ECO. REGIONAL ARCHITECTURE + INTERIOR DESIGN

Formerly BISHAW FRANK ARCHITECTS
500 - 105 Summit Street
Vancouver, BC V6C 2S8
www.bfaarchitects.com

REVISIONS

NO.	DESCRIPTION	DATE
1	ISSUED FOR REZONING & DP	18 SEP 2017
2	RE-ISSUED FOR REZONING & DP	20 FEB 2018
3	RE-ISSUED FOR ADP	02 APR 2018
4	RE-ISSUED FOR REZONING & DP	18 JAN 2019
5	RE-ISSUED FOR ADP	24 APR 2019
6	RE-ISSUED FOR REZONING & DP	26 MAY 2019
7	RE-ISSUED FOR REZONING & DP	26 AUG 2020
8	RE-ISSUED FOR REZONING & DP	05 MAY 2021
9	RE-ISSUED FOR REZONING & DP	24 NOV 2021

DISCLAIMER
THIS PLAN AND DRAWING ARE NOT TO BE USED FOR ANY OTHER PURPOSE THAN THAT FOR WHICH THEY WERE PREPARED. THE ARCHITECT ASSUMES NO LIABILITY FOR ANY OTHER USE OF THIS PLAN AND DRAWING. 

parc retirement living

PROJECT NO. 17420

PROJECT PARC VICTORIA
Mixed Use Seniors Residential & Commercial Development

LEVEL 5
FLOOR PLAN

A207

SCALE 1:200



- COLOR LEGEND
- AMENITY
 - COMMERCIAL RETAIL
 - CHILDCARE
 - OFFICE MEDICAL
 - CIRCULATION/STG/SERVICE RM
 - A - STUDIO
 - B - 1 BEDROOM
 - C - 1 BEDROOM + FLEX
 - D - 2 BEDROOM
 - E - 2 BEDROOM + FLEX
 - F - 3 BEDROOM

bfa studio
architects
ECO. REGIONAL ARCHITECTURE + INTERIOR DESIGN

Formerly BISHOP & FRANK ARCHITECTS
500 - 105 Summit Street
Vancouver, BC V6C 2S8
www.bfaarchitects.com

REVISIONS

NO.	DESCRIPTION	DATE



parc
retirement
living


PROJECT NO. 17420

PROJECT PARC VICTORIA
Mixed Use Seniors Residential & Commercial Development

LEVEL 6
FLOOR PLAN

A208

SCALE 1:200

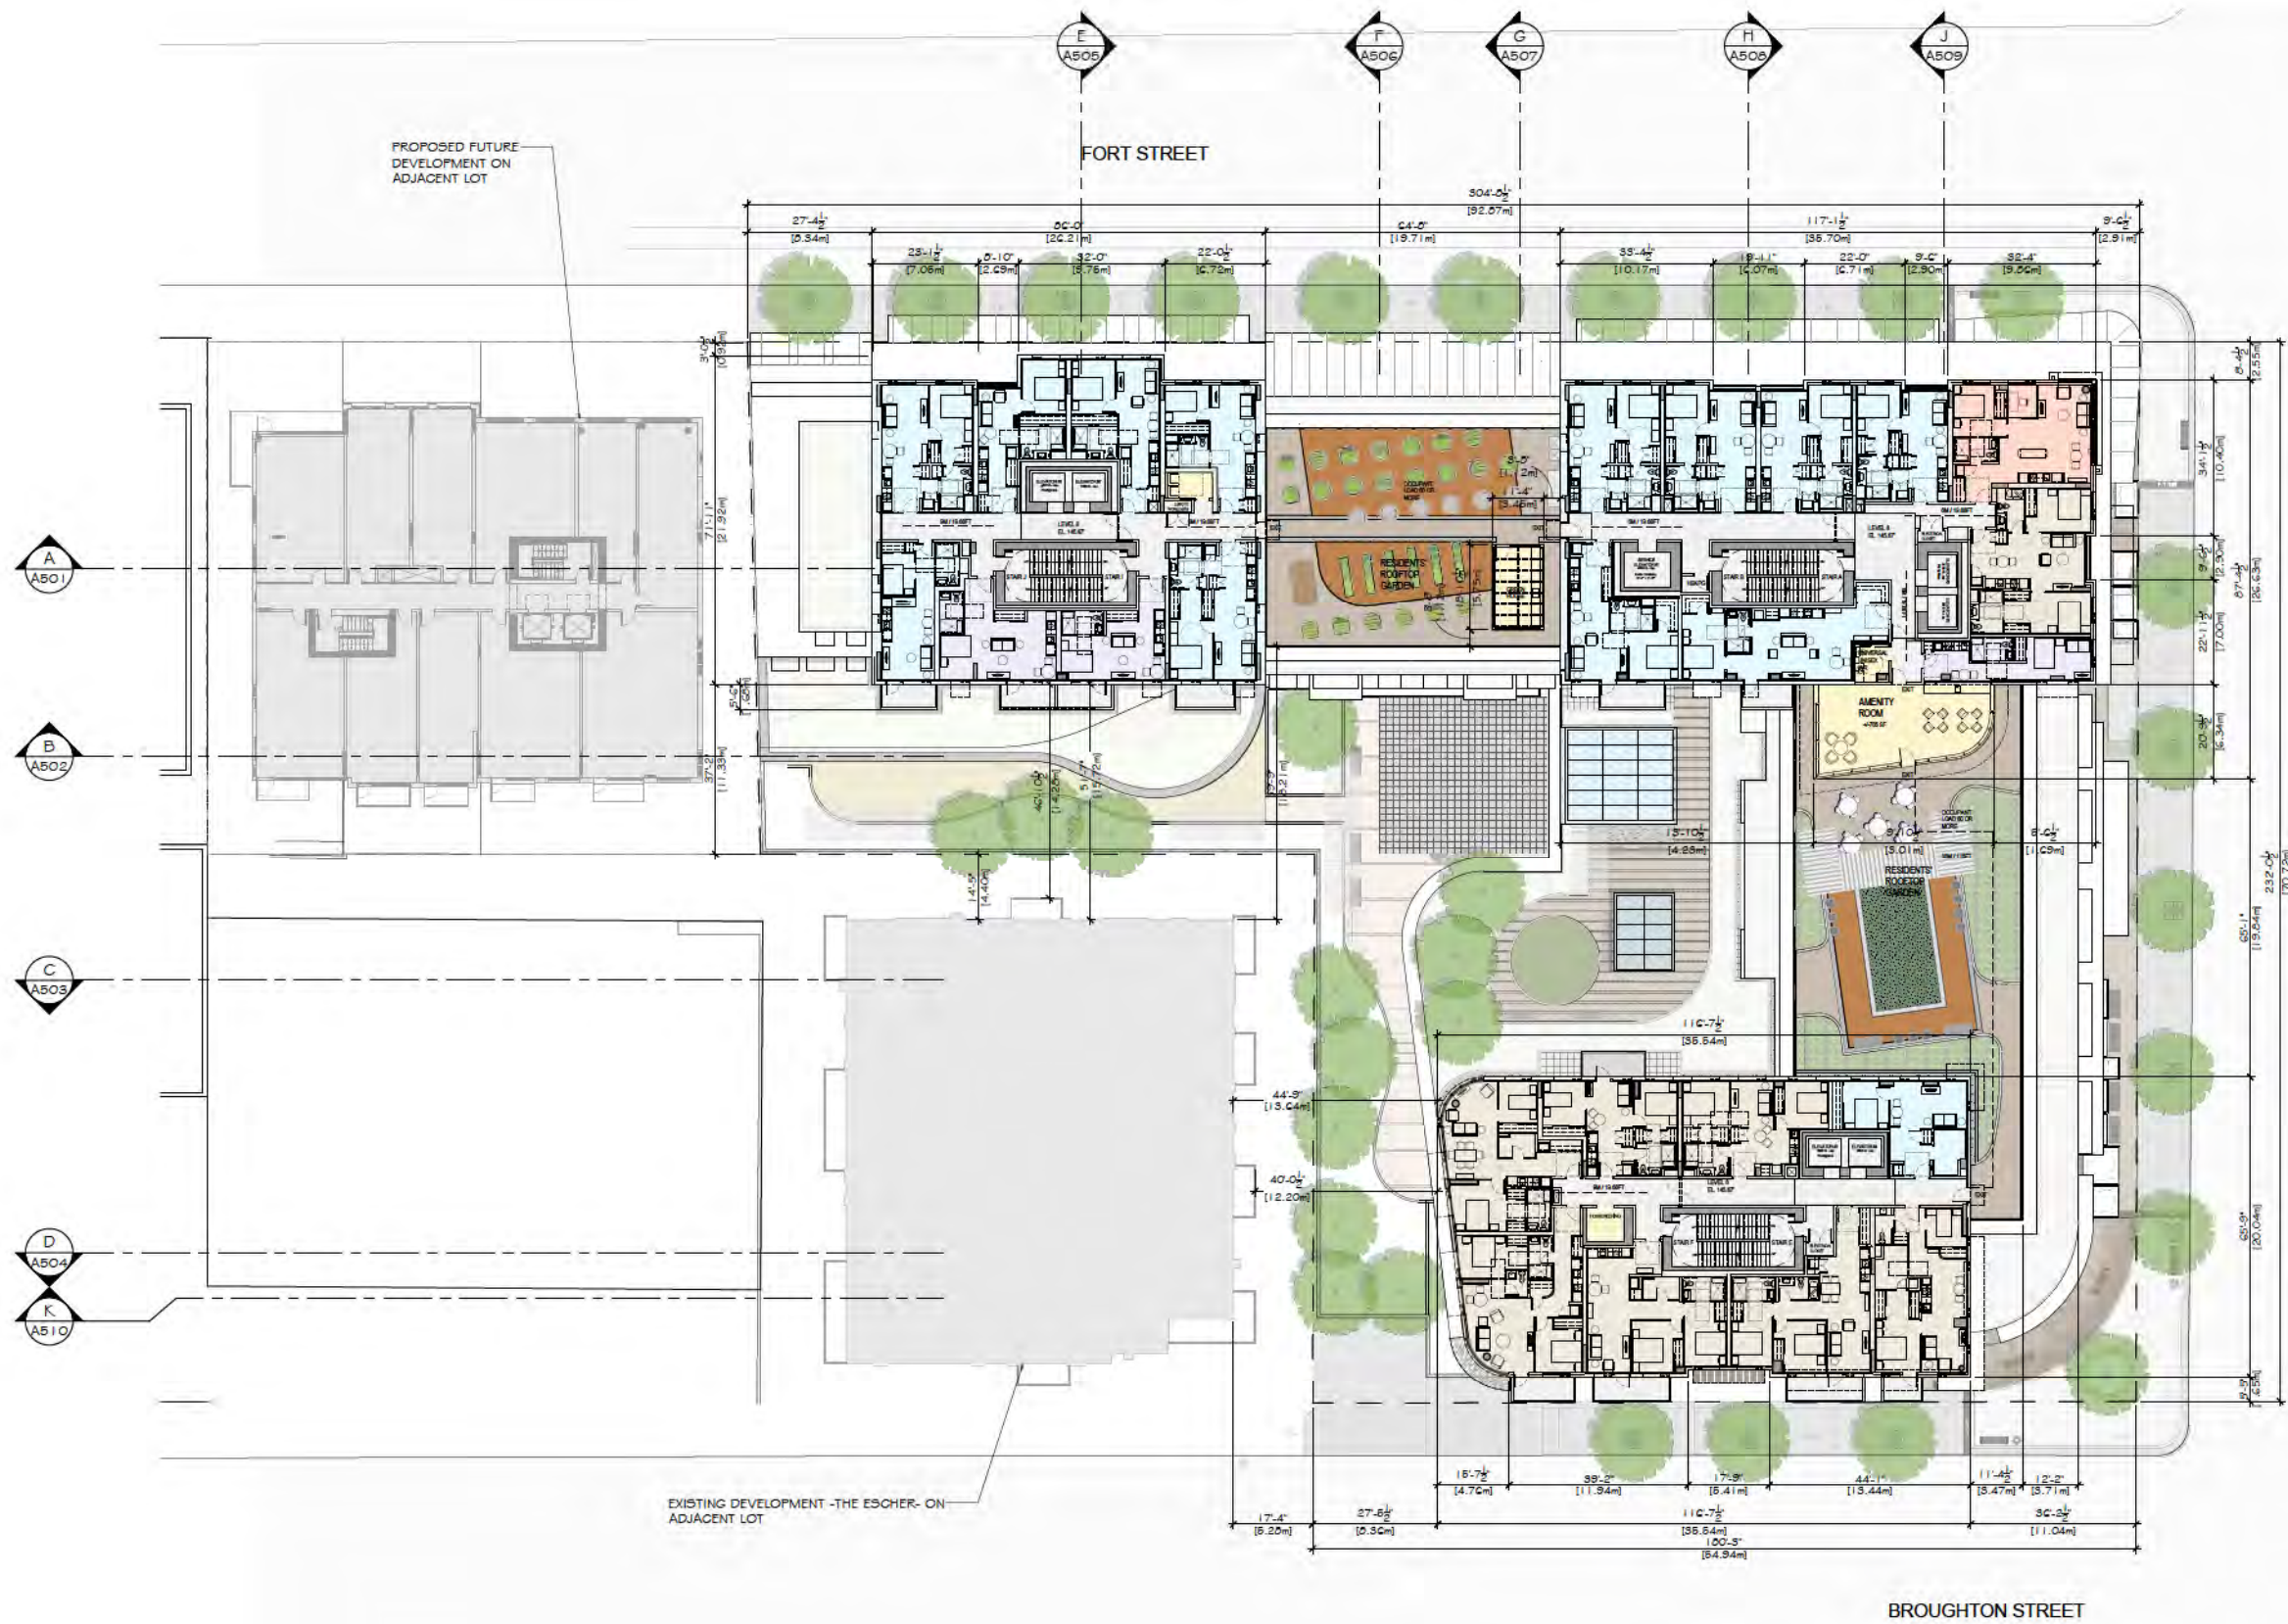

COLOR LEGEND

- AMENITY
- COMMERCIAL RETAIL
- CHILDCARE
- OFFICE MEDICAL
- CIRCULATION/STG/SERVICE RM
- A - STUDIO
- B - 1 BEDROOM
- C - 1 BEDROOM + FLEX
- D - 2 BEDROOM
- E - 2 BEDROOM + FLEX
- F - 3 BEDROOM

NOTES

1. BUILDING ENTRANCES FROM ADJACENT AREAS WILL INCLUDE GRATES, GRILLES OR SLOTTED SYSTEMS TO LEED REQUIREMENTS.

bfa studio architects
bfa studio architects

REVISIONS

NO.	DESCRIPTION	DATE

parc retirement living


PROJECT NO. 17420

PROJECT PARC VICTORIA
Mixed Use Seniors Residential & Commercial Development

LEVEL 8
FLOOR PLAN

A210

SCALE 1:200

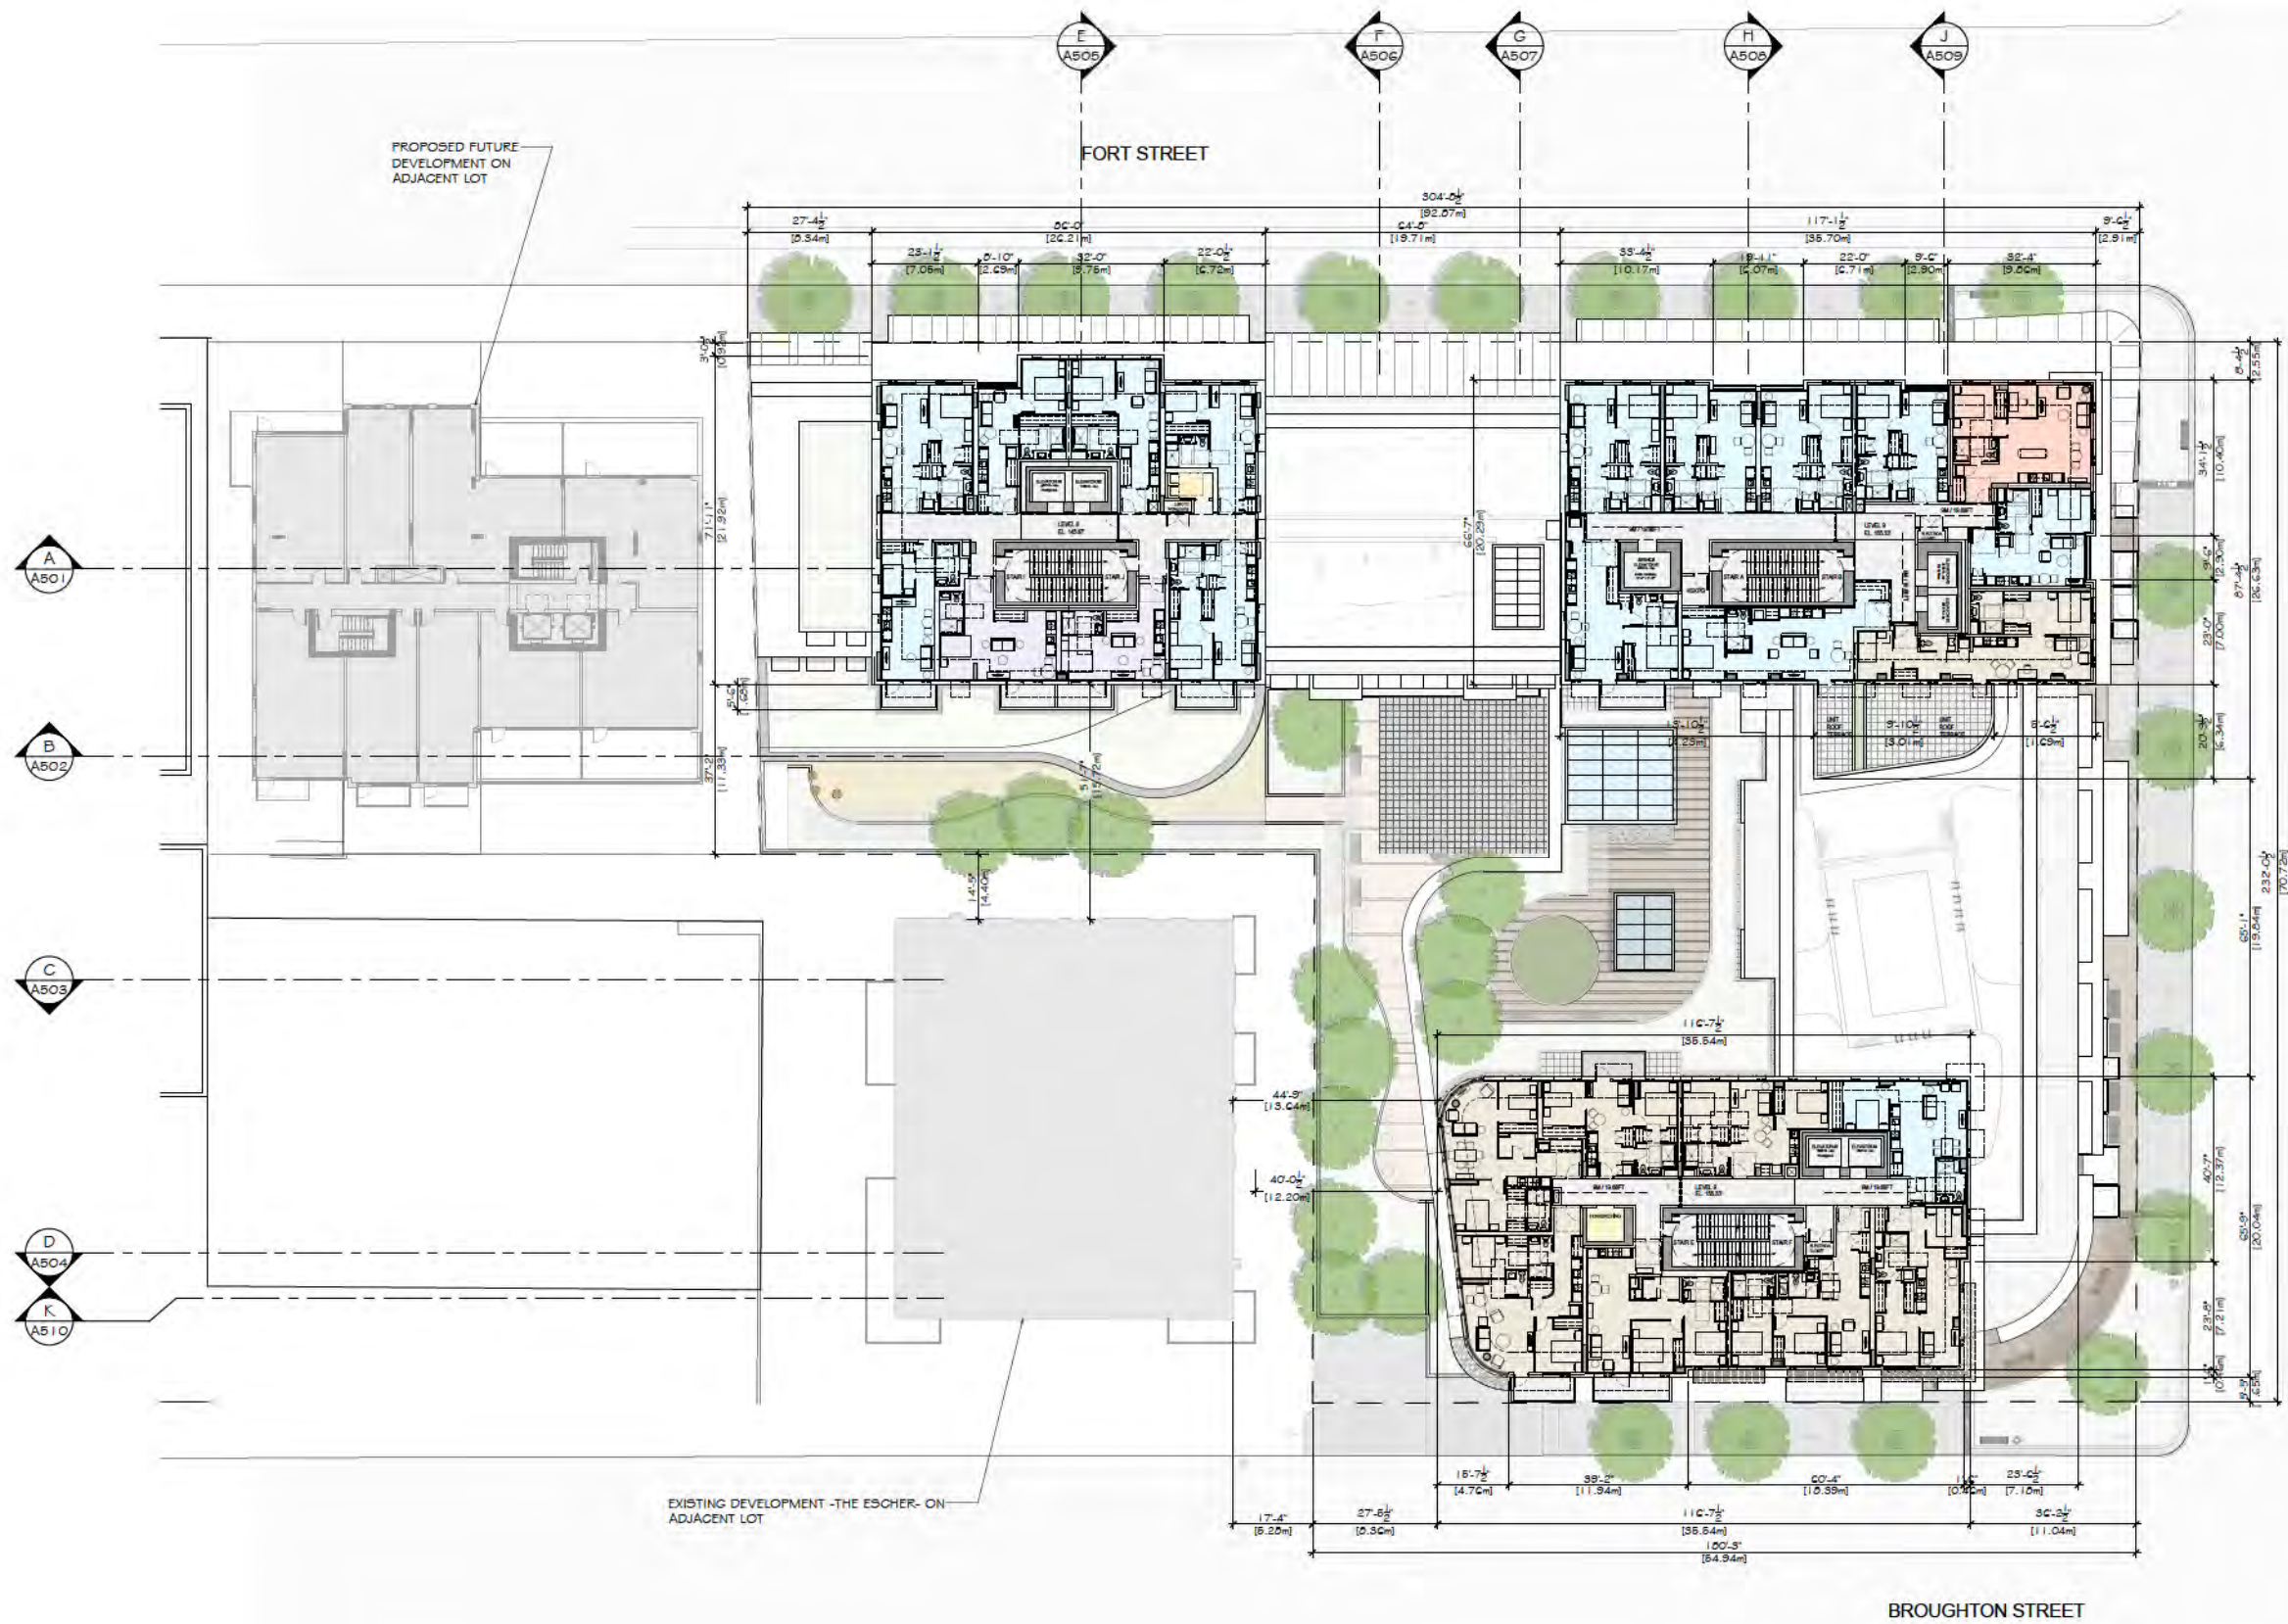

- COLOR LEGEND**
- AMENITY
 - COMMERCIAL RETAIL
 - CHILDCARE
 - OFFICE MEDICAL
 - CIRCULATION/STG/SERVICE RM
 - A - STUDIO
 - B - 1 BEDROOM
 - C - 1 BEDROOM + FLEX
 - D - 2 BEDROOM
 - E - 2 BEDROOM + FLEX
 - F - 3 BEDROOM

bfa studio architects

REVISIONS

NO.	DESCRIPTION	DATE
1	ISSUED FOR REVISION & OP	19 SEP 2017
2	RE-DESIGNED FOR REVISION & OP	20 FEB 2018
3	RE-DESIGNED FOR REVISION & OP	02 APR 2018
4	RE-DESIGNED FOR REVISION & OP	19 JAN 2018
5	RE-DESIGNED FOR REVISION & OP	24 APR 2018
6	RE-DESIGNED FOR REVISION & OP	28 MAY 2018
7	RE-DESIGNED FOR REVISION & OP	28 MAY 2018
8	RE-DESIGNED FOR REVISION & OP	08 MAY 2019
9	RE-DESIGNED FOR REVISION & OP	24 NOV 2021

parc retirement living


PROJECT NO. 17420


PROJECT PARC VICTORIA
Mixed Use Seniors Residential & Commercial Development

LEVEL 9
FLOOR PLAN

A211

SCALE 1:200

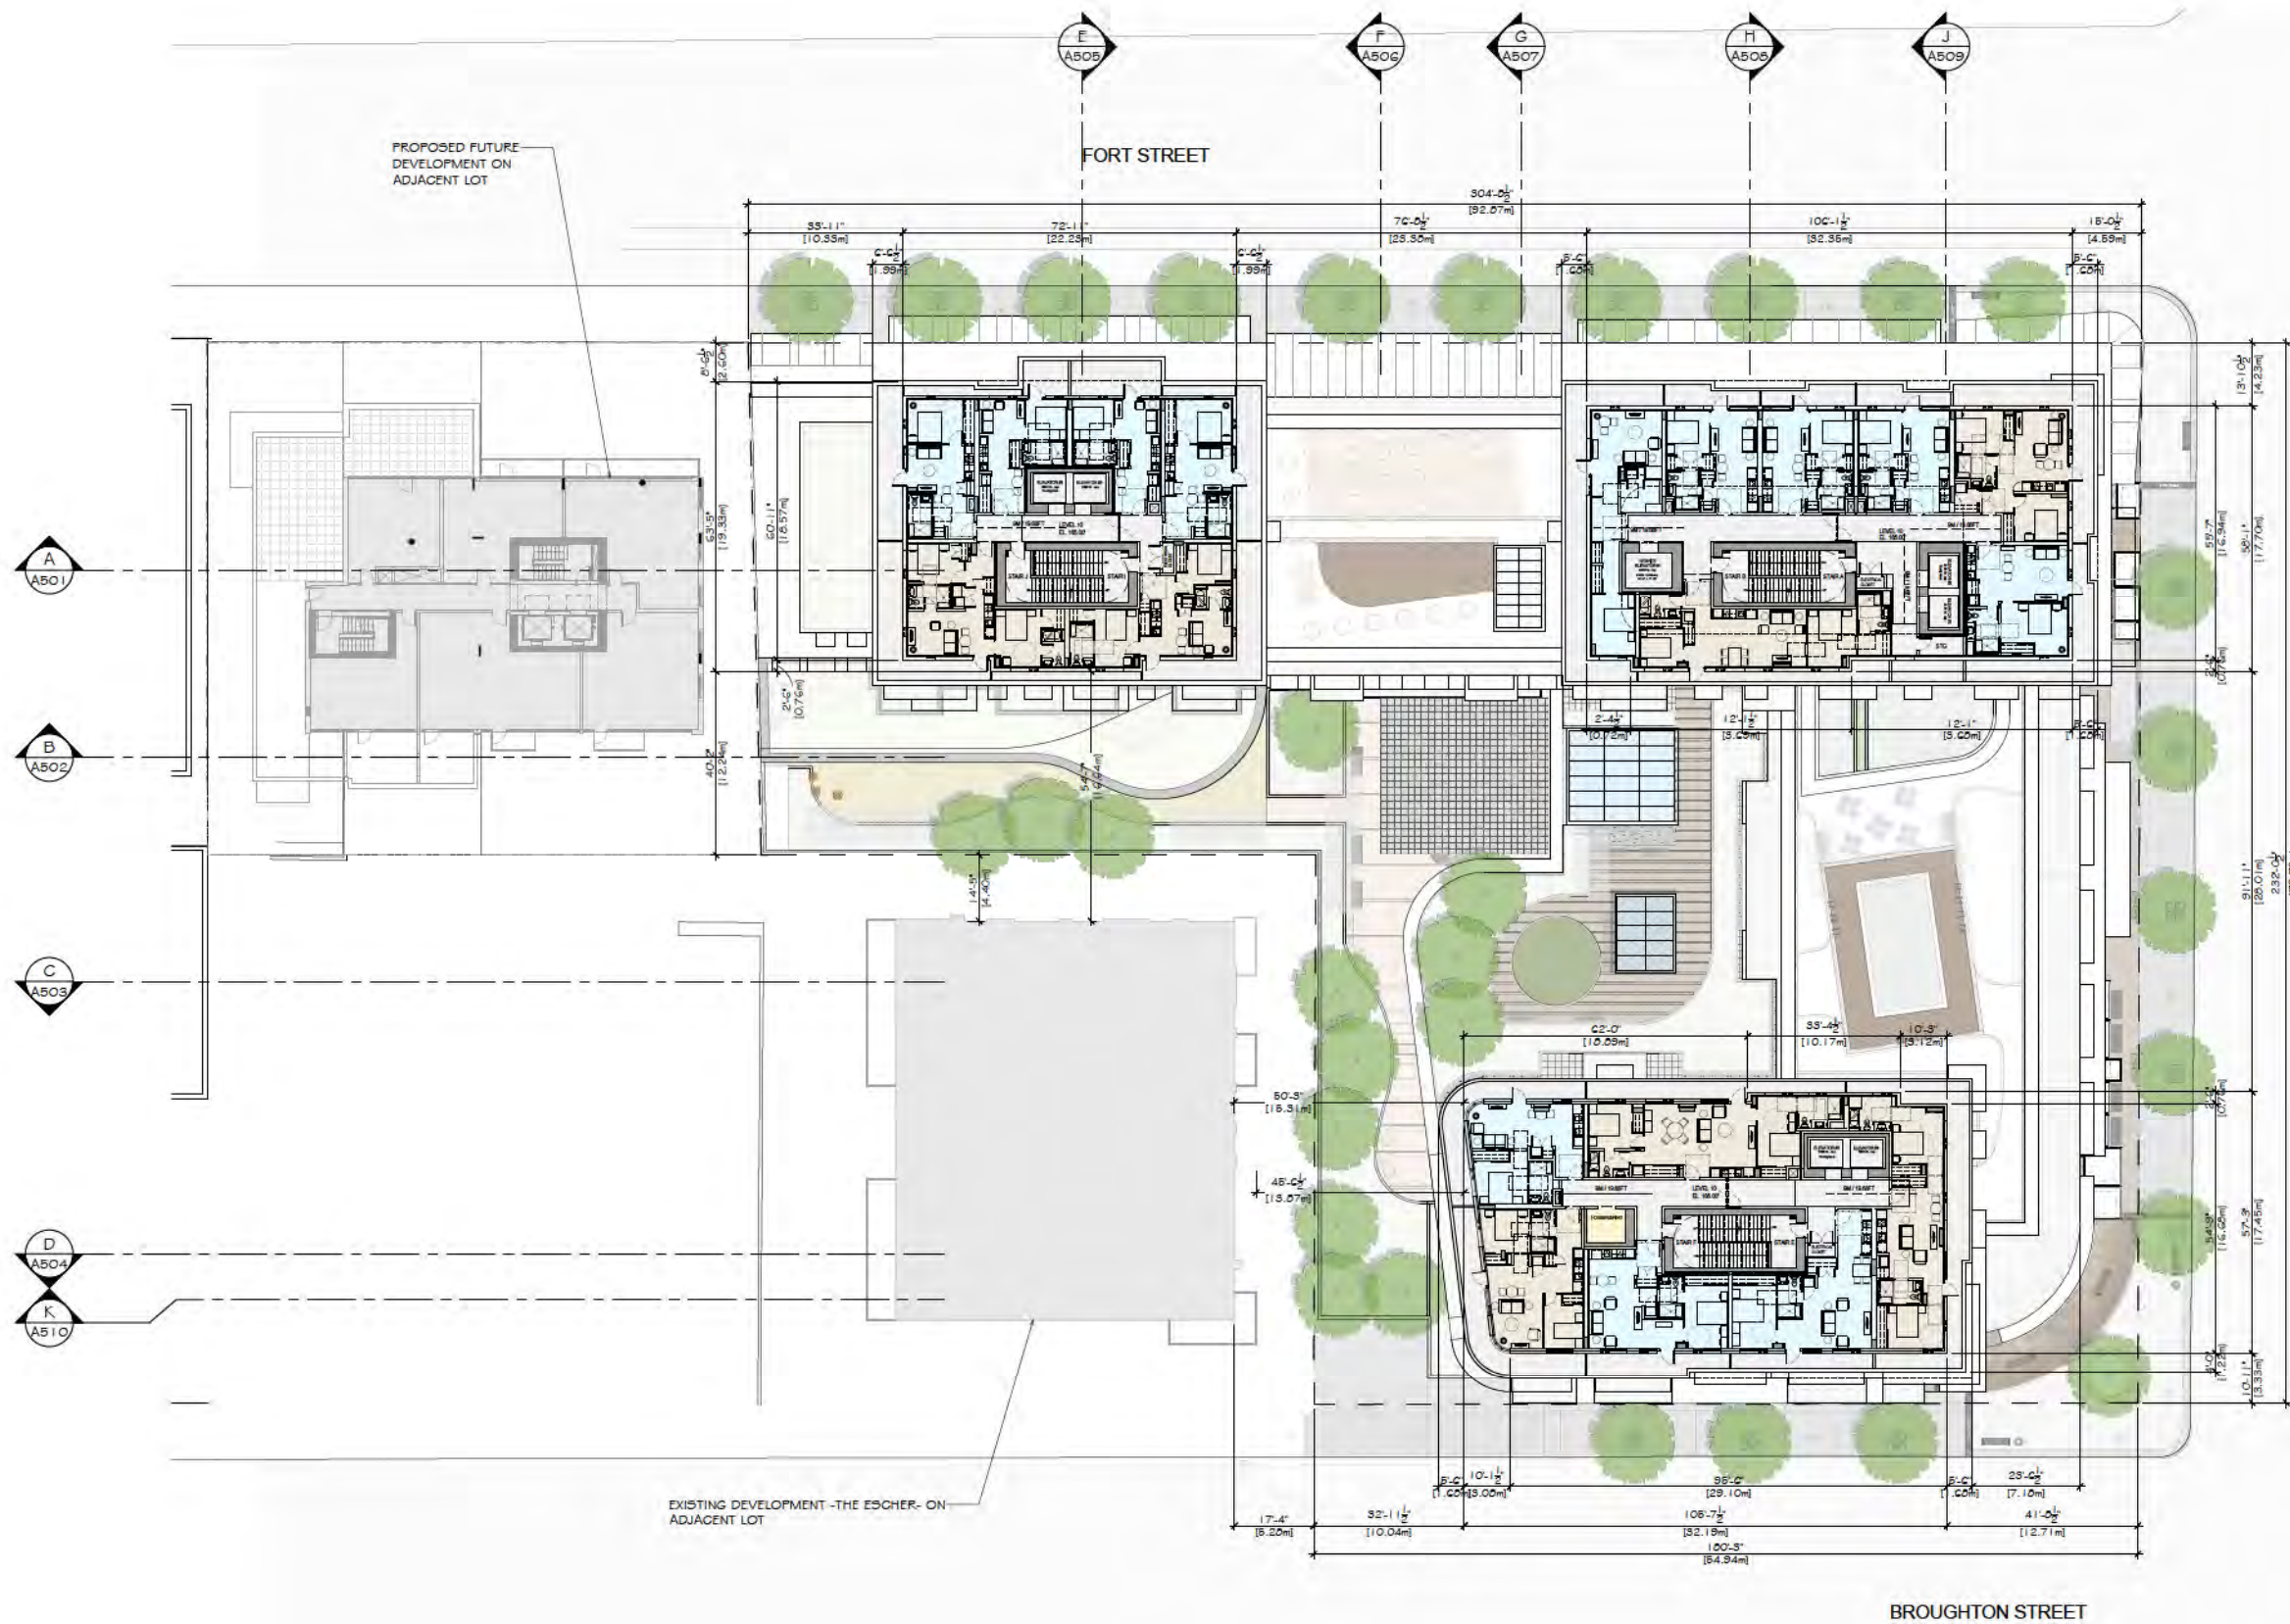

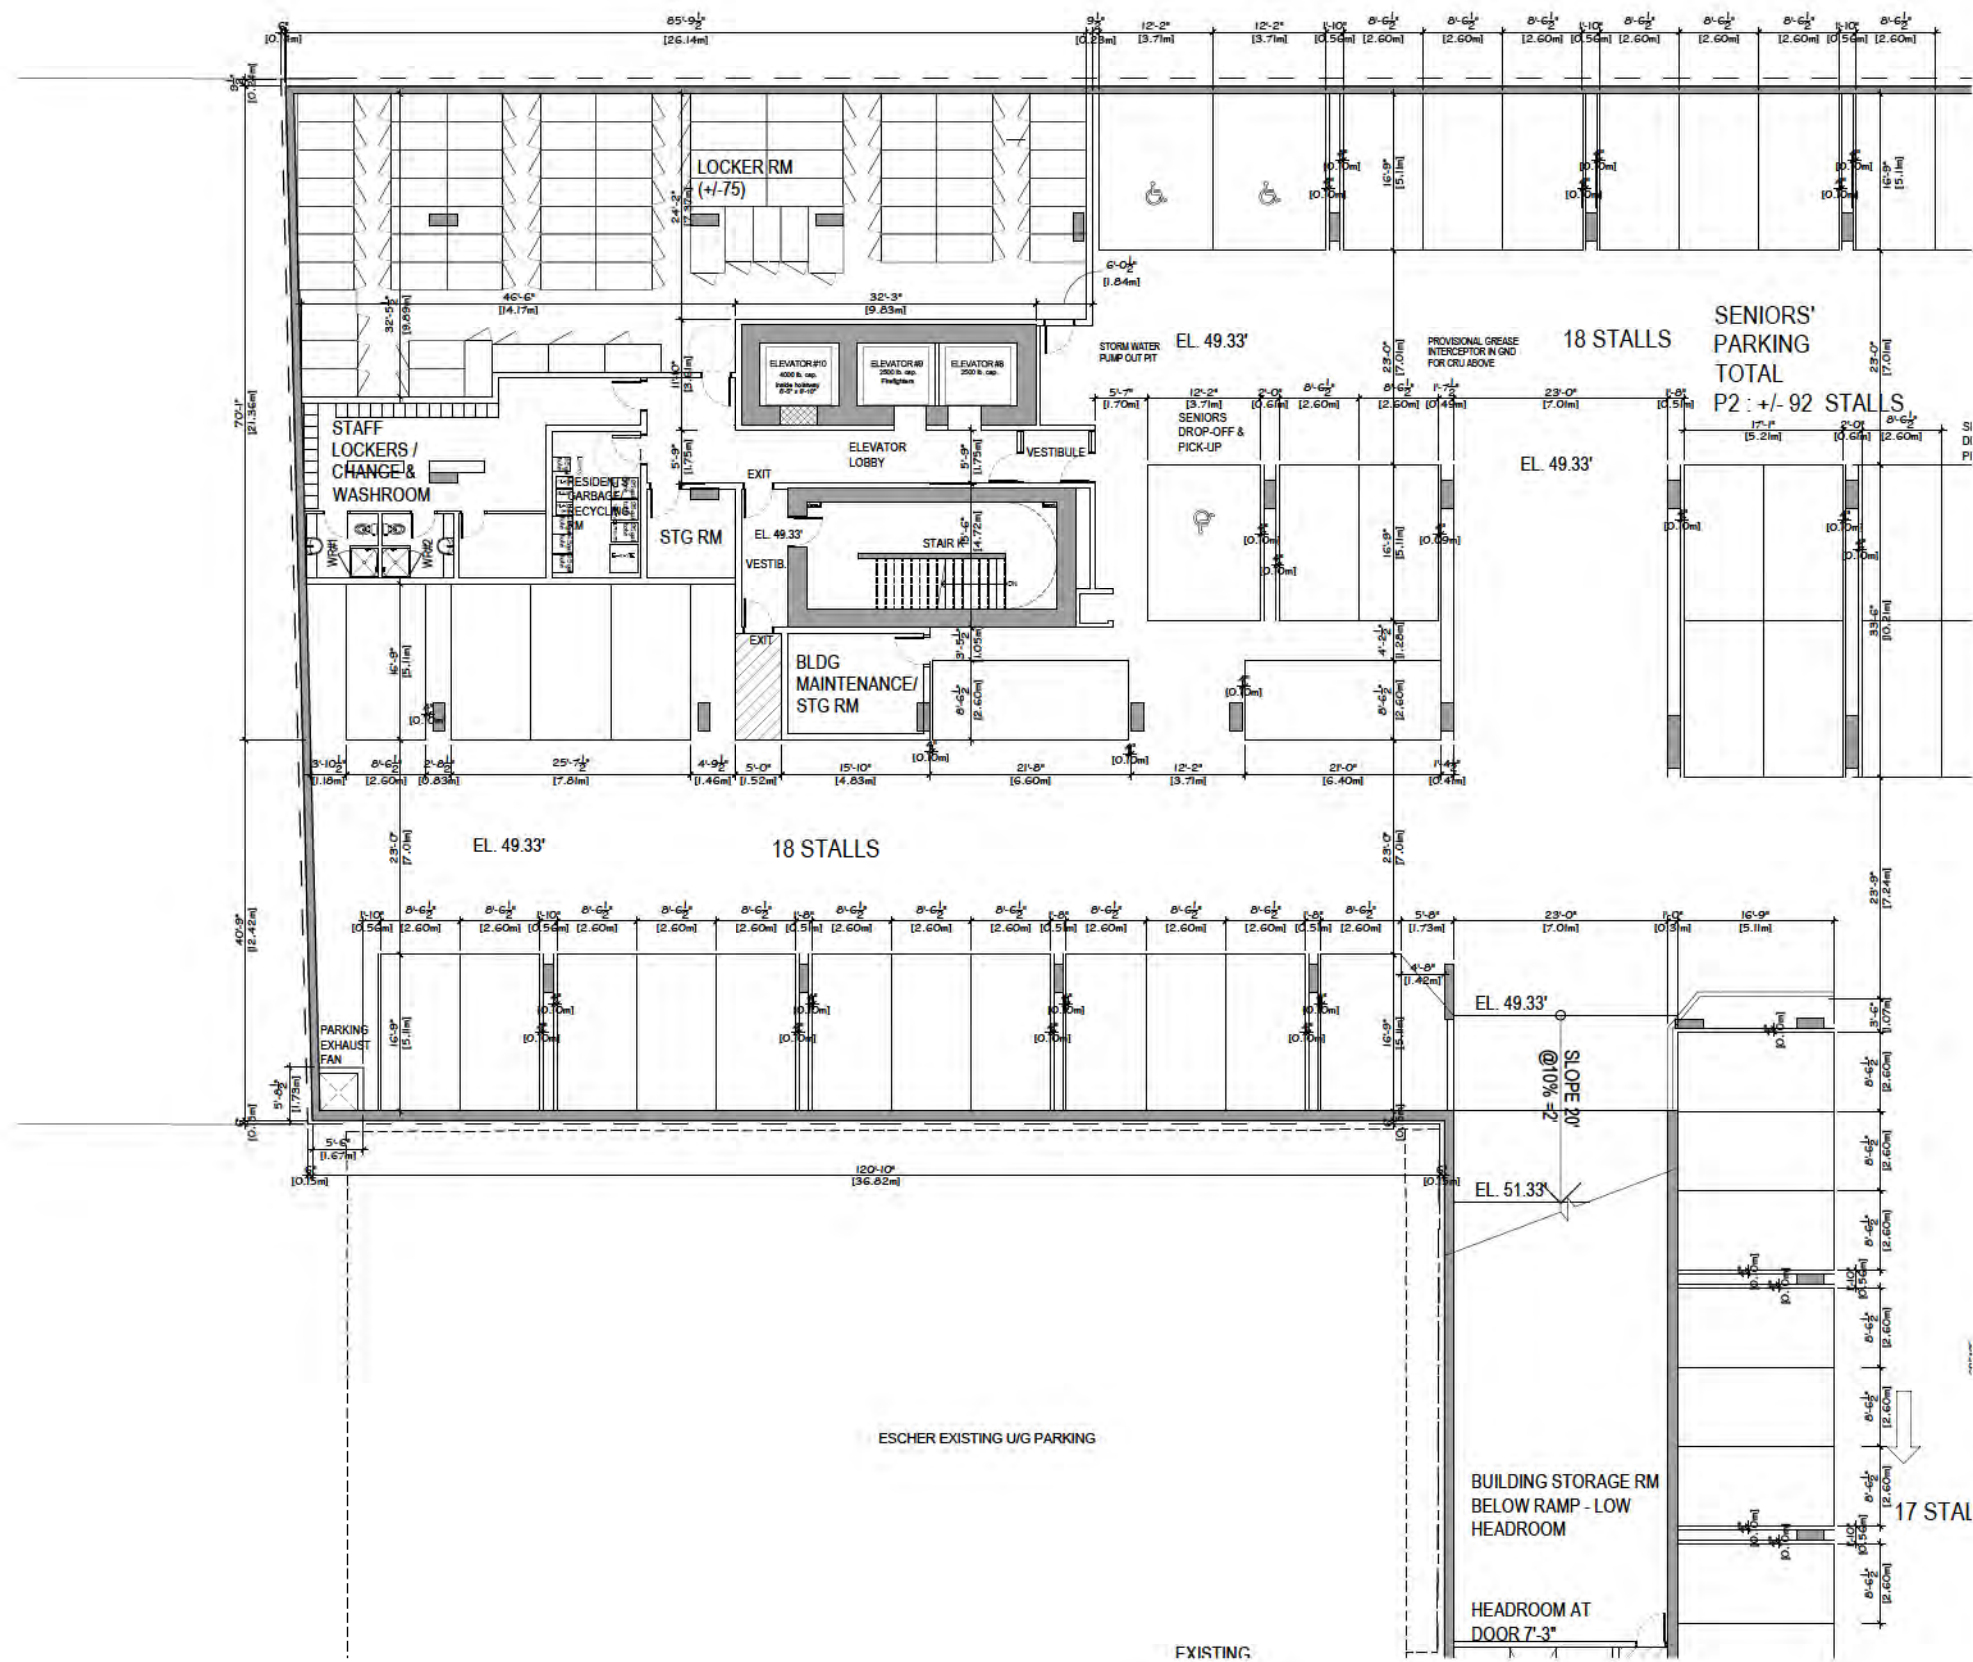

REVISIONS

NO.	DESCRIPTION	DATE
1	ISSUED FOR REVISION & DP	18 SEP 2017
2	REISSUED FOR REVISION & DP	20 FEB 2018
3	REISSUED FOR ADP	02 APR 2018
4	REISSUED FOR REVISION & DP	18 JAN 2019
5	REISSUED FOR ADP	24 APR 2019
6	REISSUED FOR REVISION & DP	30 MAY 2019
7	REISSUED FOR REVISION & DP	30 AUG 2020
8	REISSUED FOR REVISION & DP	08 MAY 2021
9	REISSUED FOR REVISION & DP	30 NOV 2021





parc
retirement
living

17420


PARC VICTORIA
Mixed Use Seniors Residential &
Commercial Development

P2 LEVEL
PARTIAL FLOOR PLAN

A300A

APR 2017

1:100

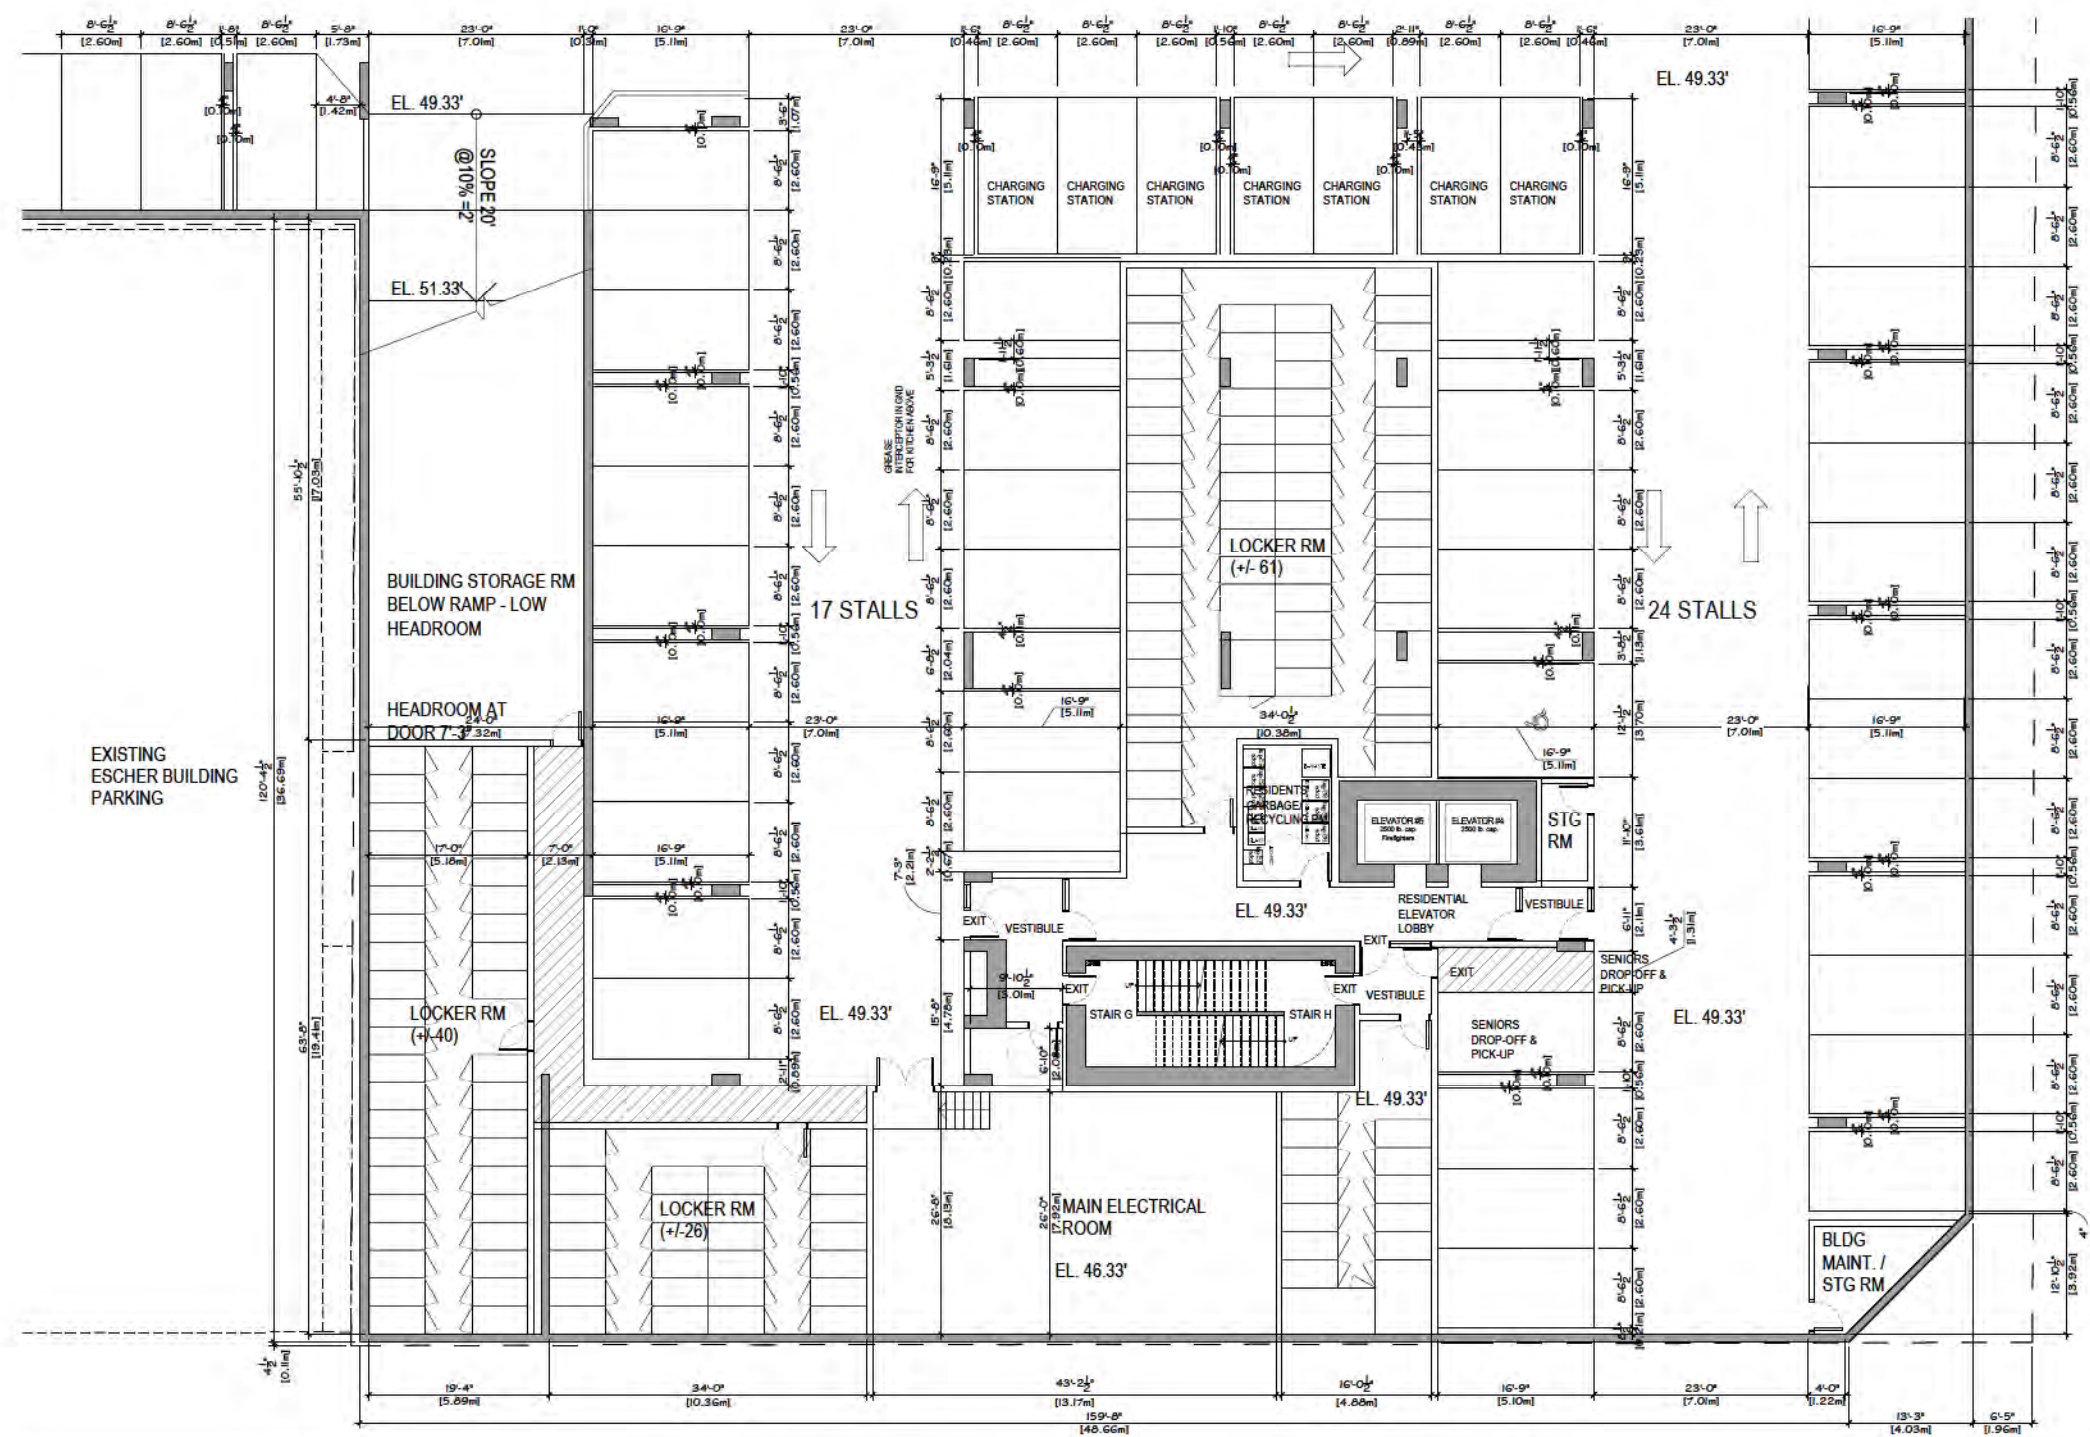

P2 : +/- 92 STALLS

bfa studio architects
 ECO-REGIONAL ARCHITECTURE INTERIOR DESIGN

(formerly BESHAY FRANK ARCHITECTS)
 310 - 515 Burnside Street T 504 462 1544
 Vancouver, BC V6Z 2S8 F 504 462 4655
 www.bfaarchitects.com

REVISIONS	DATE
ISSUED FOR REVISION & DP	18 SEP 2017
RE-ISSUED FOR REVISION & DP	20 FEB 2018
RE-ISSUED FOR ADP	02 APR 2018
RE-ISSUED FOR REVISION & DP	18 JAN 2019
RE-ISSUED FOR ADP	24 APR 2019
RE-ISSUED FOR REVISION & DP	29 MAY 2019
RE-ISSUED FOR REVISION & DP	28 AUG 2020
RE-ISSUED FOR REVISION & DP	08 MAY 2021
RE-ISSUED FOR REVISION & DP	24 NOV 2021

parc retirement living


17420

PARC VICTORIA
 Mixed Use Seniors Residential & Commercial Development

P2 LEVEL
 PARTIAL FLOOR PLAN

A300C

APR 2017
 1:100

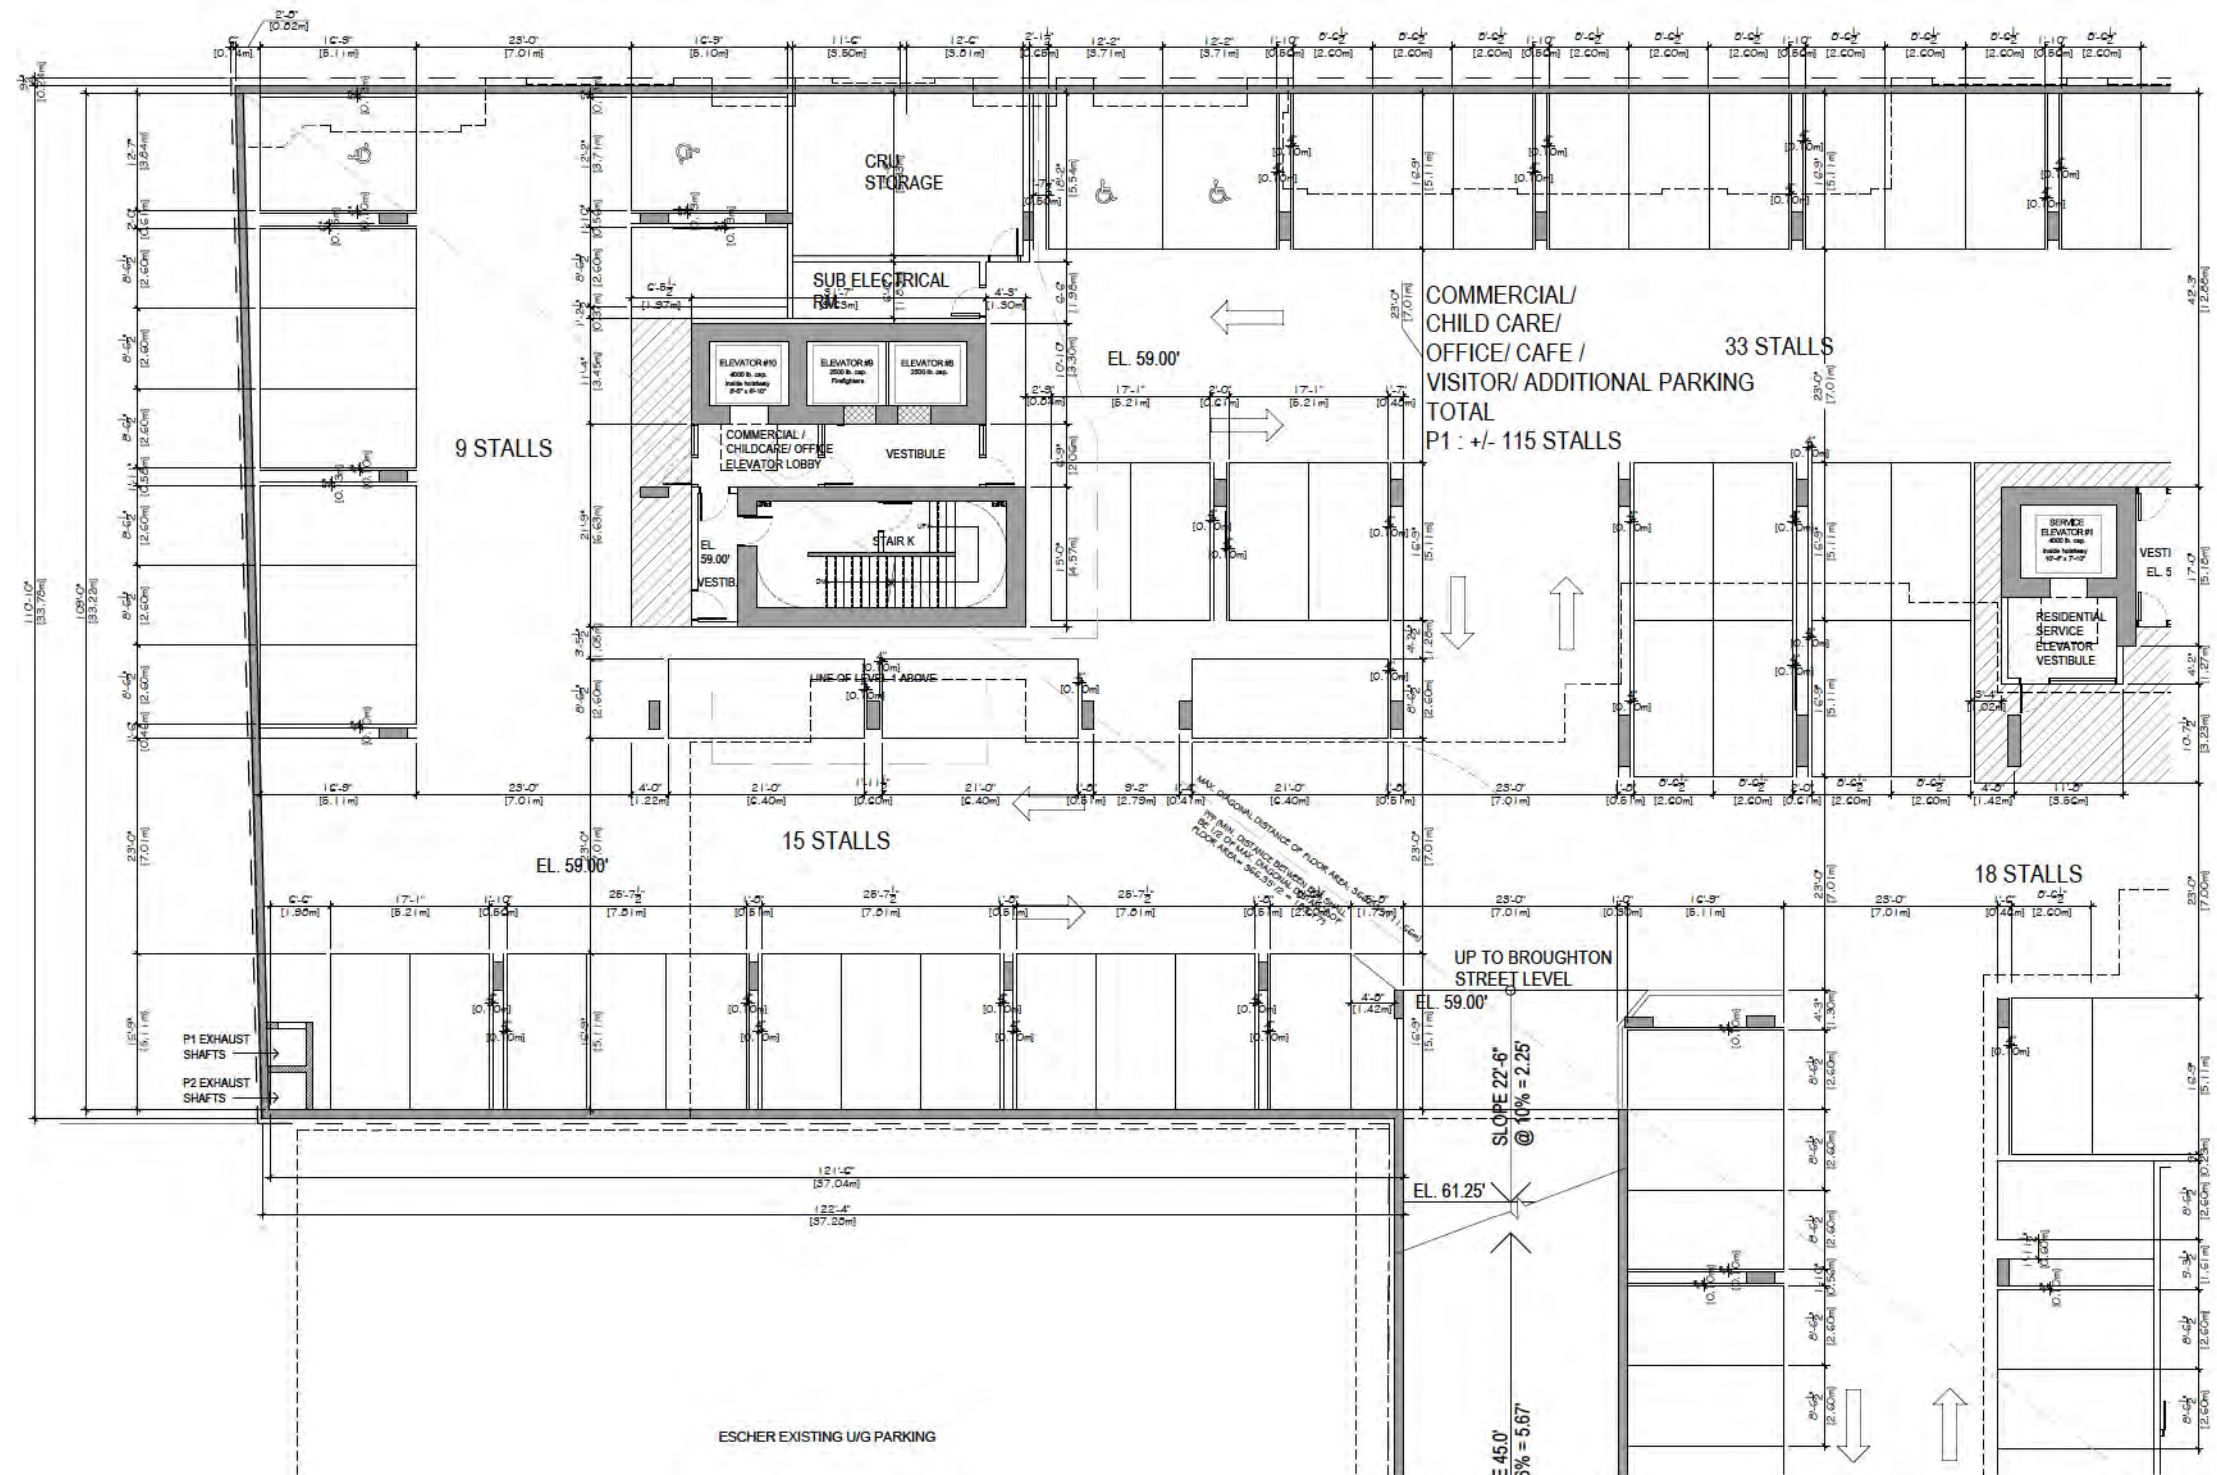

REVISIONS

NO.	DESCRIPTION	DATE
1	ISSUED FOR REVISION & DP	18 SEP 2017





parc
retirement
living

17420


PARC VICTORIA
Mixed Use Seniors Residential &
Commercial Development

P1 LEVEL
PARTIAL FLOOR PLAN

A301A


APR 2017

1:100

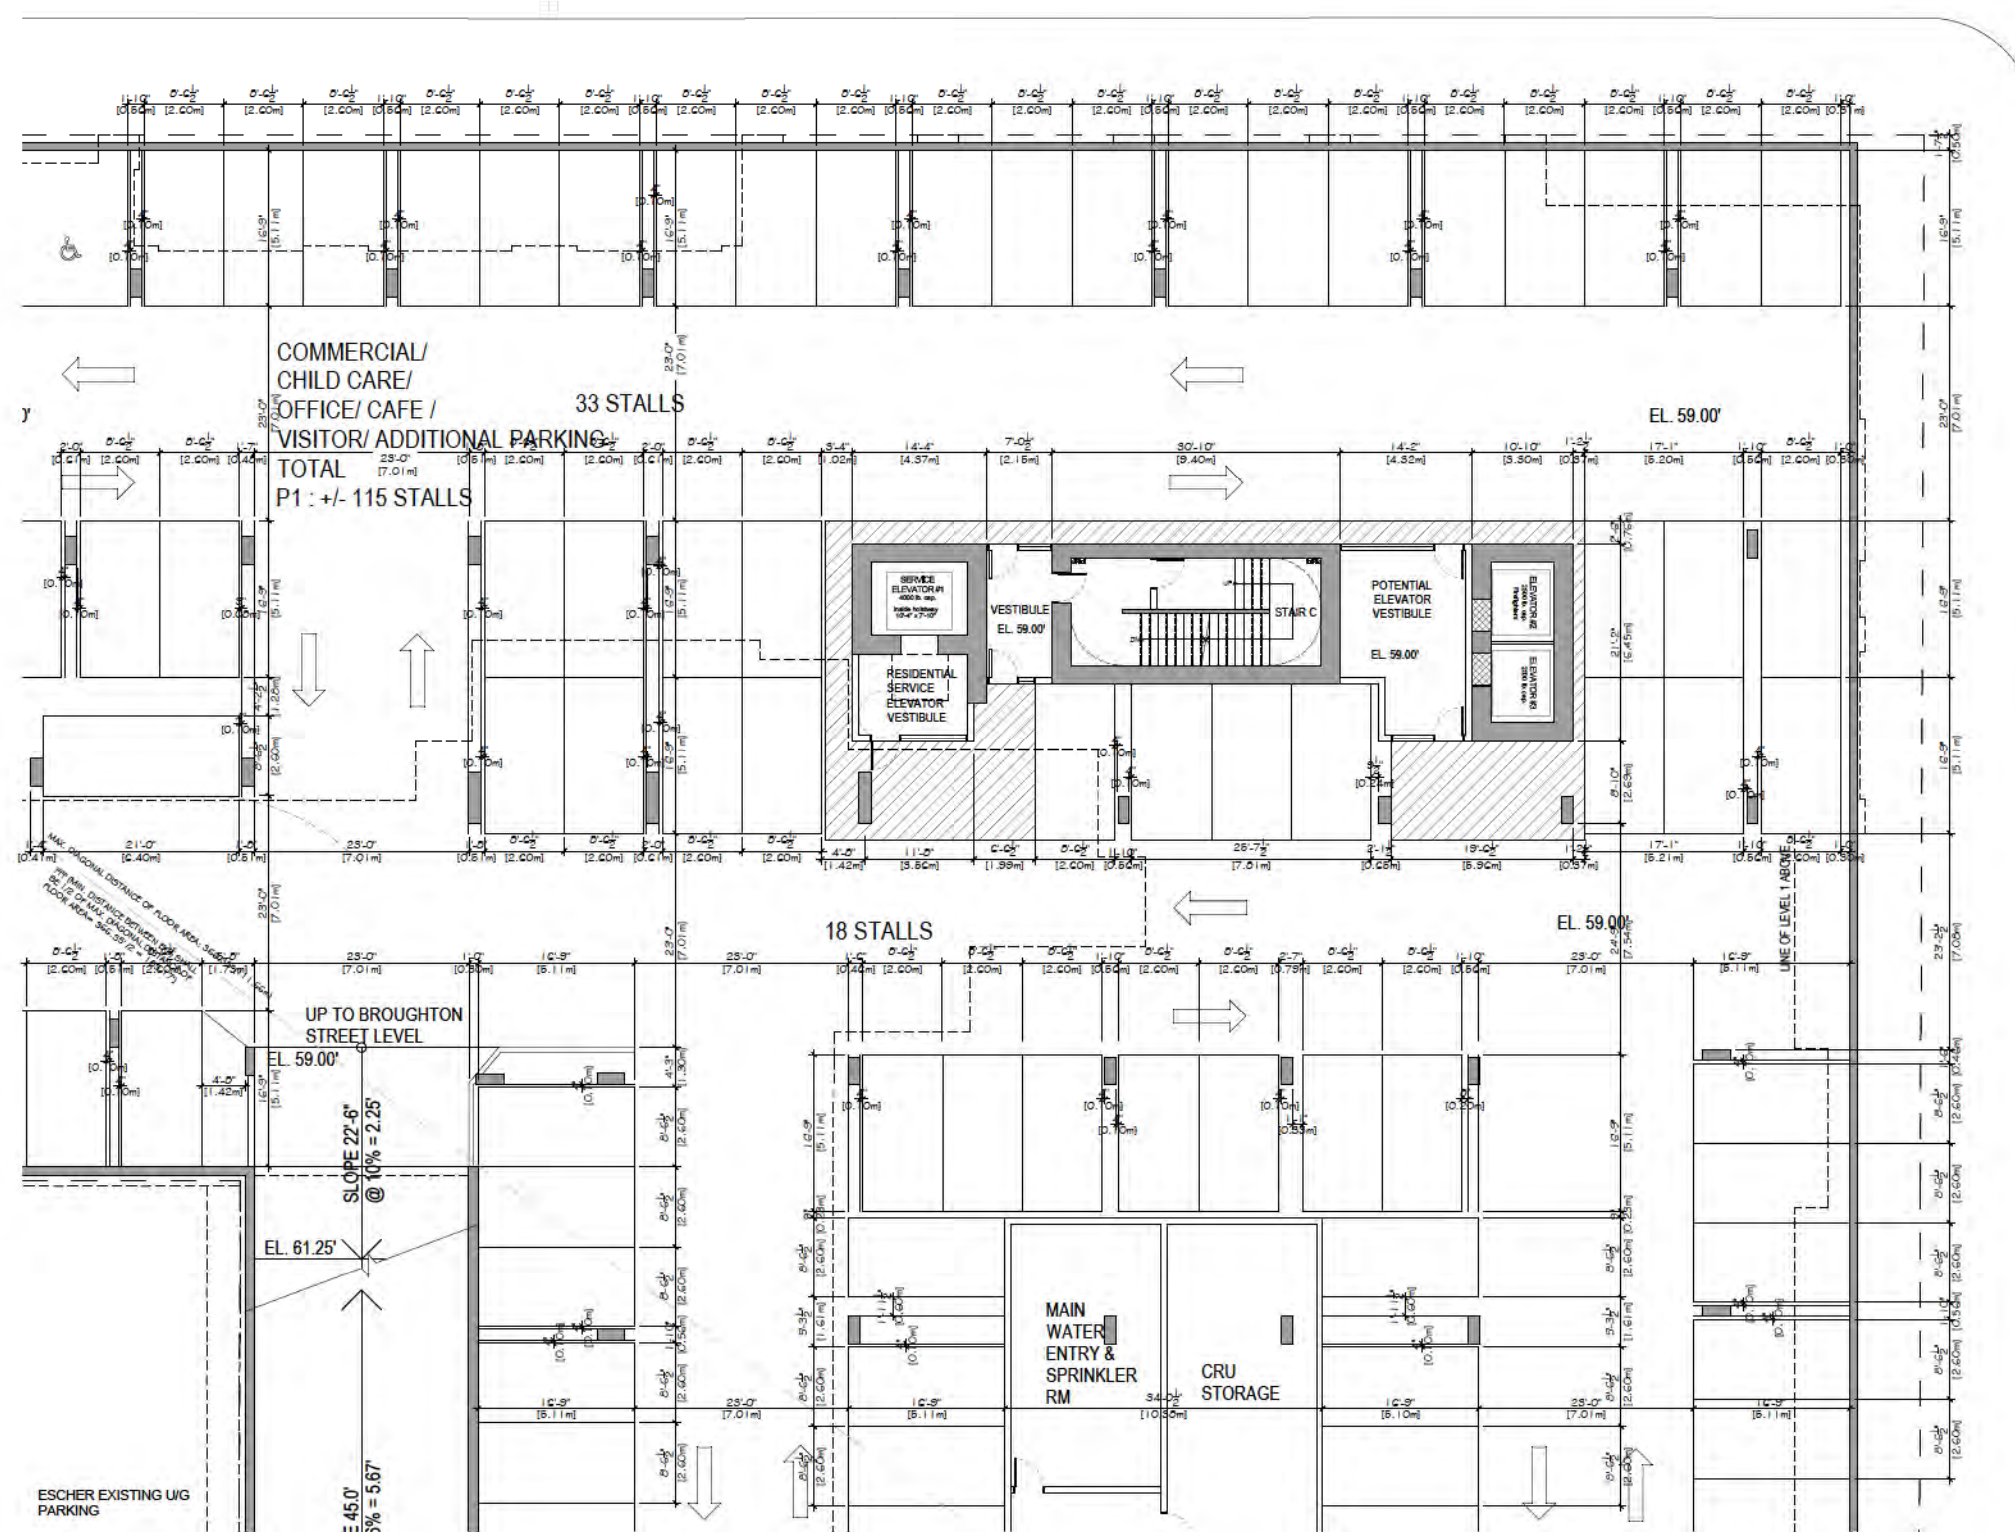

REVISIONS	DATE
ISSUED FOR REVISION & DP	18 SEP 2017
RE-ISSUED FOR REVISION & DP	20 FEB 2018
RE-ISSUED FOR ADP	02 APR 2018
RE-ISSUED FOR REVISION & DP	18 JAN 2019
RE-ISSUED FOR ADP	24 APR 2019
RE-ISSUED FOR REVISION & DP	20 MAY 2019
RE-ISSUED FOR REVISION & DP	20 AUG 2020
RE-ISSUED FOR REVISION & DP	08 MAY 2021
RE-ISSUED FOR REVISION & DP	24 NOV 2021


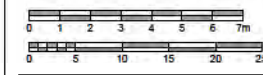

parc
retirement
living


17420

PARC VICTORIA
Mixed Use Senior Residential &
Commercial Development

P1 LEVEL
PARTIAL FLOOR PLAN

A301B

APR 2017
1:100

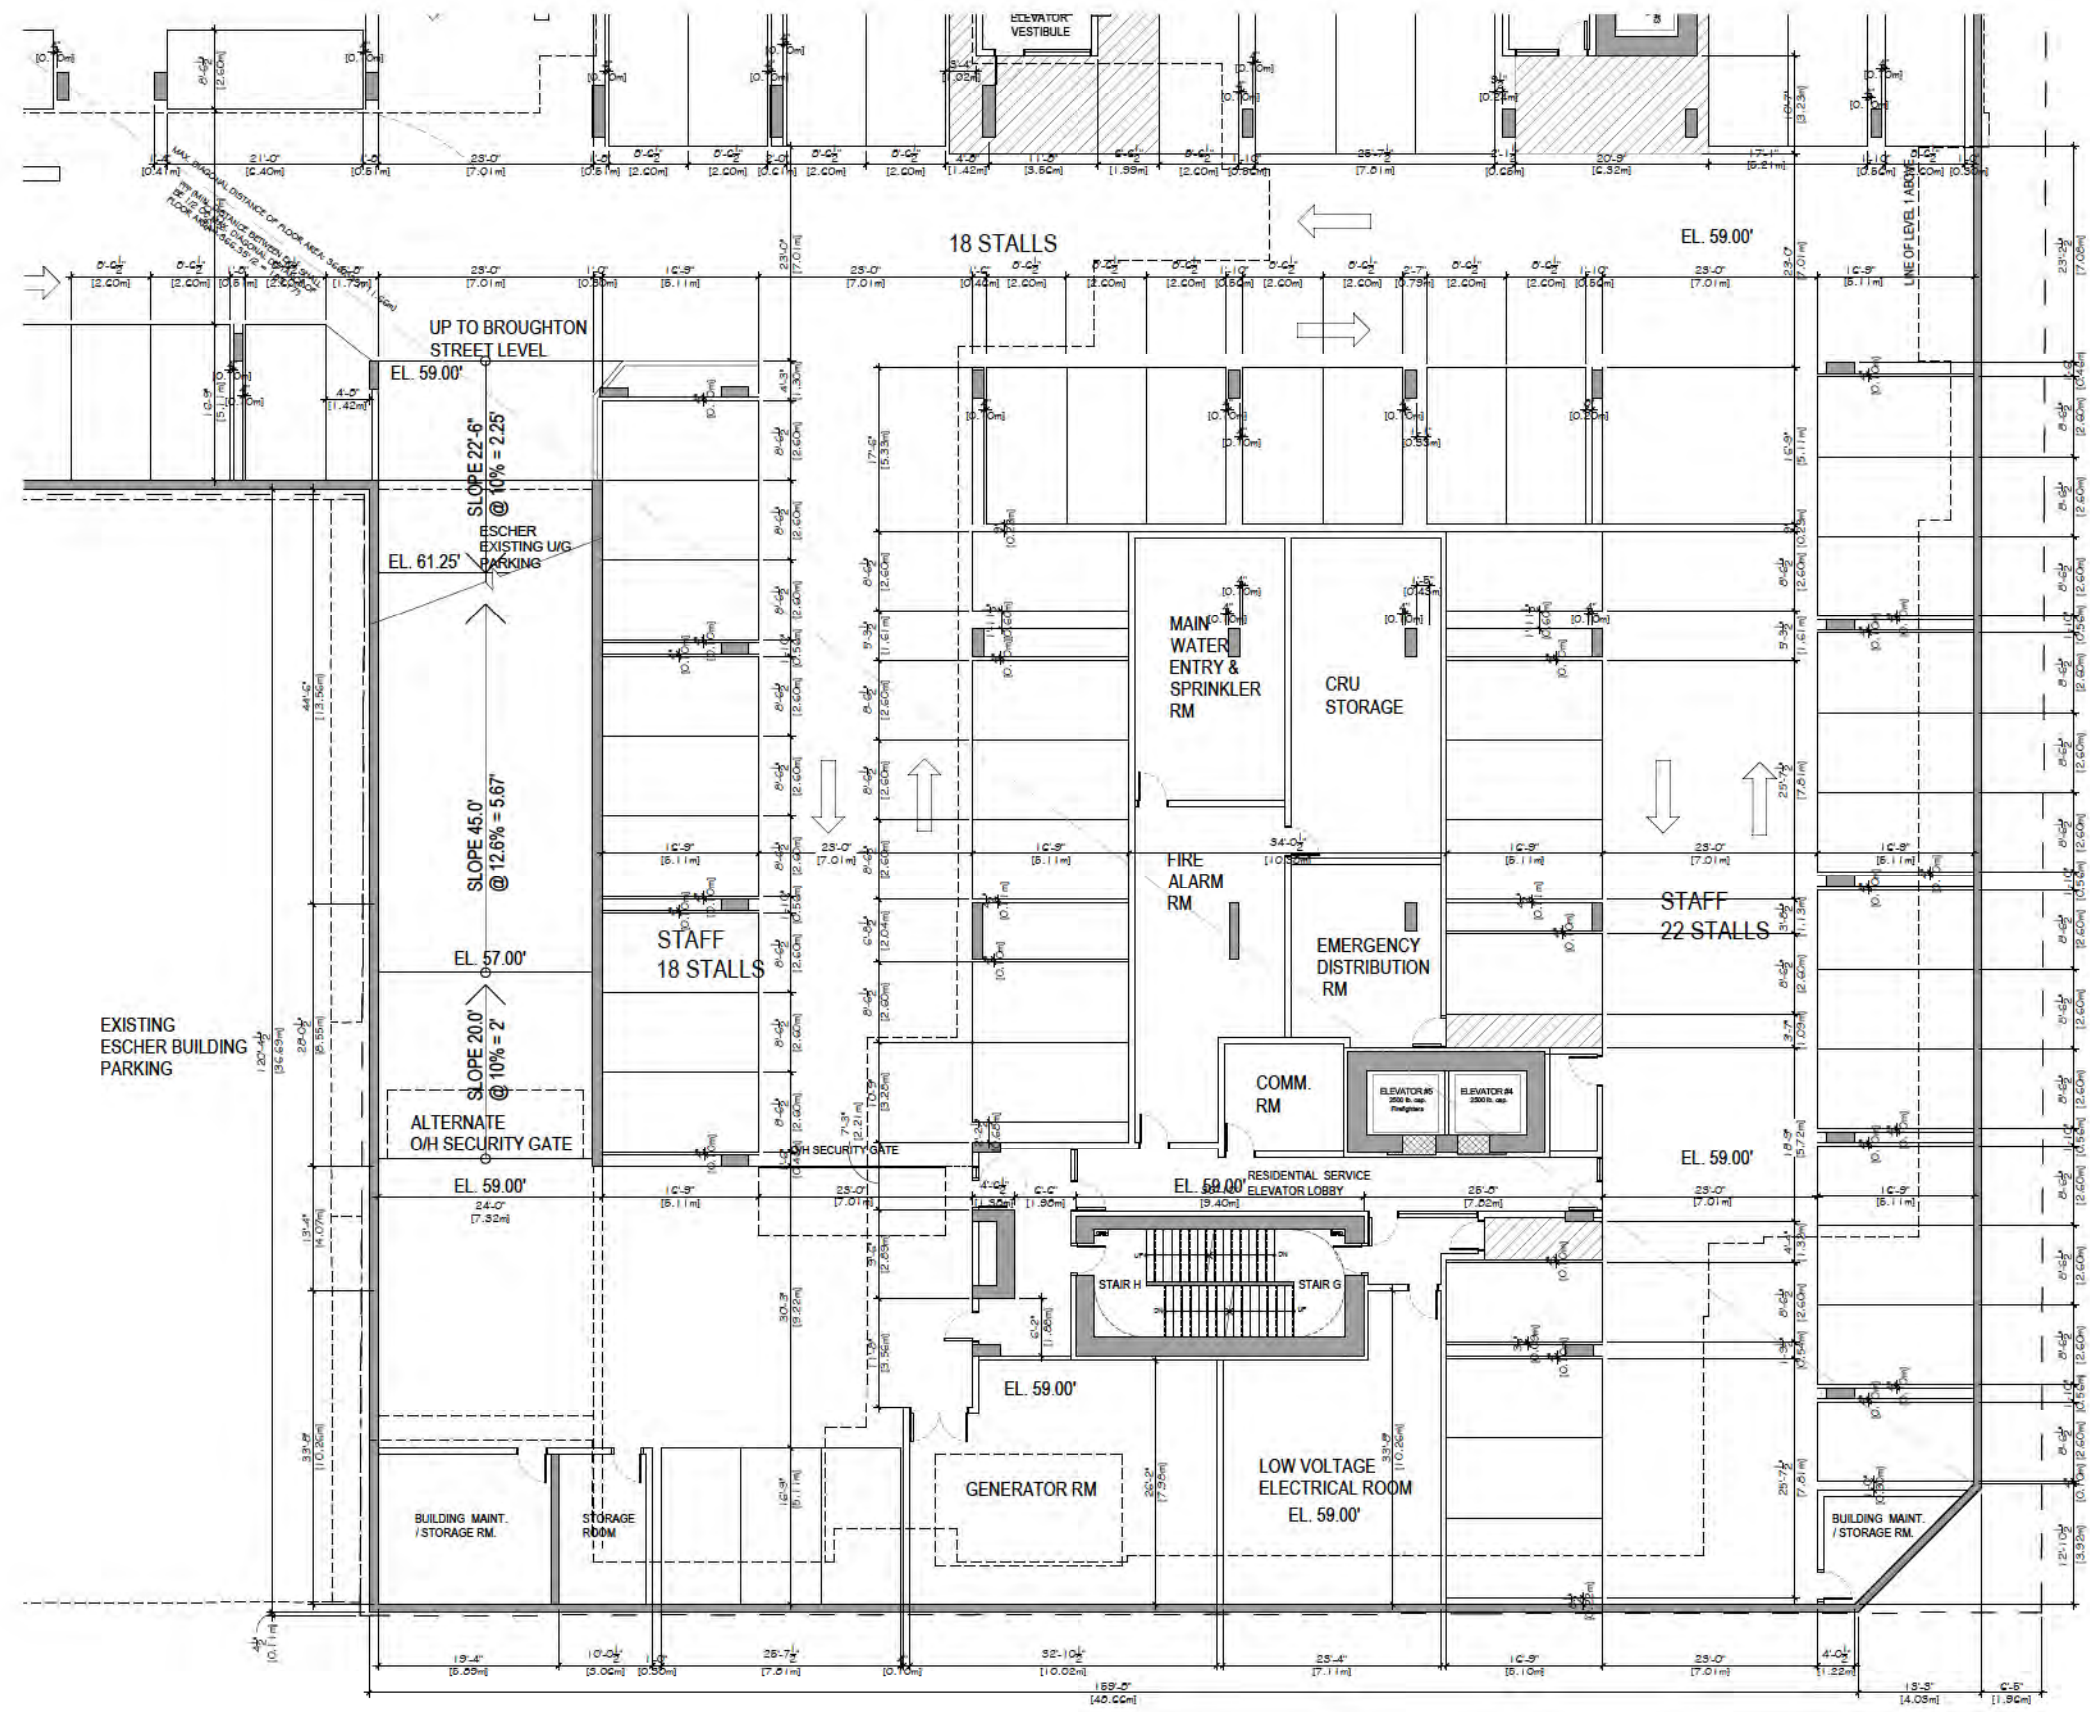

bfa studio
architects

ECO-REGIONAL ARCHITECTURE + INTERIOR DESIGN


www.bfaarchitects.com

REVISIONS

NO.	DESCRIPTION	DATE
1	ISSUED FOR REVISION & DP	18 SEP 2017
2	RE-ISSUED FOR REVISION & DP	20 FEB 2018
3	RE-ISSUED FOR ADP	02 APR 2018
4	RE-ISSUED FOR REVISION & DP	18 JAN 2019
5	RE-ISSUED FOR ADP	24 APR 2019
6	RE-ISSUED FOR REVISION & DP	29 MAY 2019
7	RE-ISSUED FOR REVISION & DP	28 AUG 2020
8	RE-ISSUED FOR REVISION & DP	08 MAY 2021
9	RE-ISSUED FOR REVISION & DP	24 NOV 2021

Copyright Reserved



parc
retirement
living

17420

PARC VICTORIA
Mixed Use Seniors Residential &
Commercial Development

P1 LEVEL
PARTIAL FLOOR PLAN

A301C

APR 2017

1:100



- COLOR LEGEND
- AMENITY
 - COMMERCIAL RETAIL
 - CHILDCARE
 - OFFICE MEDICAL
 - CIRCULATION/STG/SERVICE RM
 - A - STUDIO
 - B - 1 BEDROOM
 - C - 1 BEDROOM + FLEX
 - D - 2 BEDROOM
 - E - 2 BEDROOM + FLEX
 - F - 3 BEDROOM

bfa studio
architects
ECO-REGIONAL ARCHITECTURE + INTERIOR DESIGN

Vancouver, BC V6C 2G8
www.bfaarchitects.com

REVISIONS

NO.	DESCRIPTION	DATE
1	ISSUED FOR REVISION & DP	18 SEP 2017




parc
retirement
living


17420

PARC VICTORIA
Mixed Use Seniors Residential &
Commercial Development

LEVEL 1
PARTIAL FLOOR PLAN

A302B

1:100

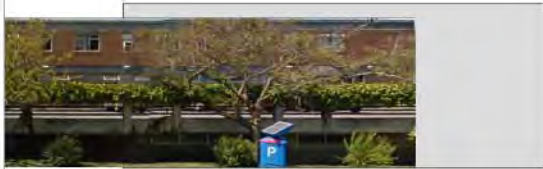

bfa studio
architects

ECO-REGIONAL ARCHITECTURE • INTERIOR DESIGN


www.bfastudioarchitects.com

REVISIONS

NO.	DESCRIPTION	DATE
1	ISSUED FOR REVISION & DP	18 SEP 2017
2	RE-ISSUED FOR REVISION & DP	30 FEB 2018
3	RE-ISSUED FOR ADP	02 APR 2018
4	RE-ISSUED FOR REVISION & DP	18 JAN 2019
5	RE-ISSUED FOR ADP	24 APR 2019
6	RE-ISSUED FOR REVISION & DP	28 MAY 2019
7	RE-ISSUED FOR REVISION & DP	28 AUG 2020
8	RE-ISSUED FOR REVISION & DP	08 MAY 2021
9	RE-ISSUED FOR REVISION & DP	04 NOV 2021

NOTES



0 1 2 3 4 5 10 15m

0 6 10 15 20 30 40 60'

CLIPPING

parc
retirement
living

PROJECT NO.

17420

PROJECT

PARC VICTORIA
Mixed Use Seniors Residential &
Commercial Development

DESCRIPTION

EAST ELEVATION
QUADRA
STREETSCAPE

REVISIONS

REVISION


A402

DATE

APR 2017

SCALE

1:200

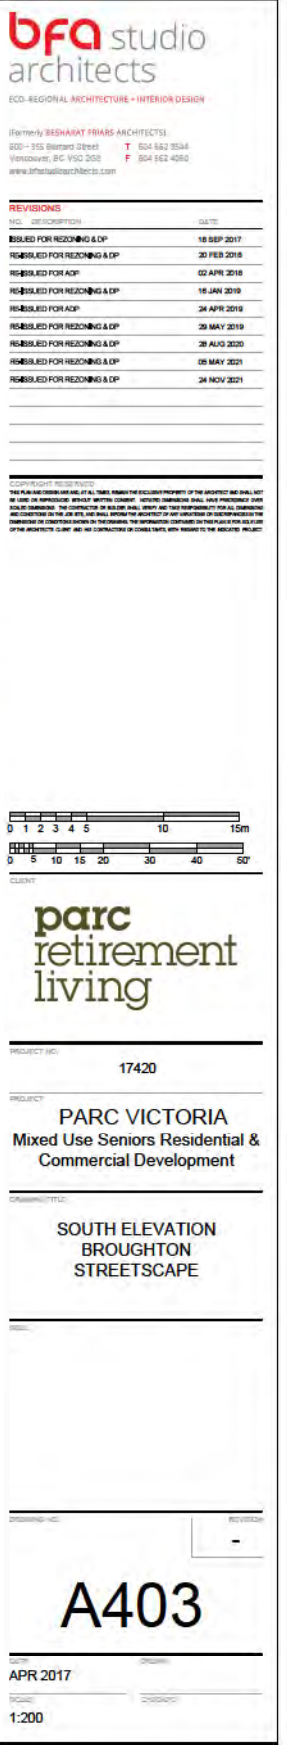




ELEVATION KEYNOTE LEGEND							
ITEM	COLOUR / FINISH	ITEM	COLOUR / FINISH	ITEM	COLOUR / FINISH	ITEM	COLOUR / FINISH
BR-1	STANDARD FACE BRICK-4 1/2" PATTERN: TBO	ALU-2	ALUMINUM CLADDING PANEL SYSTEM	COW-1	ALUMINUM CURTAIN WALL W DOUBLE GLAZING, REFER TO WINDOW SCHEDULE	CAN-1	METAL FRAMED CANOPY W GLASS
BR-2	STANDARD FACE BRICK-4 1/2" PATTERN: TBO	CON-1	ARCHITECTURAL CONCRETE W REVEALS	SPW-1	STOREFRONT WINDOW DOOR, REFER TO WINDOW SCHEDULE	CAN-2	FRAMED FABRIC CANOPY
STO-1	GRANITE STONE CLADDING PATTERN: TBO	CON-2	ARCHITECTURAL CONCRETE COLUMNS	GUA-1	SAFETY GLASS BALCONY GUARD	CHG-1	ALUMINUM OVERHEAD GARAGE DOOR
STO-2	STONE CLADDING PATTERN: TBO	SIL-1	CONCRETE PRECAST SILL/HEADER	GUA-2	METAL BALCONY GUARD	ADR-1	ALUMINUM FRAME DOOR W GLAZING UNIT
TER-1	TERRA COTTA - TR2	WIN-1	VINYL WINDOW FRAME W DOUBLE OR TRIPLE GLAZING, REFER TO WINDOW SCHEDULE	GPS-1	SAFETY GLASS PRIVACY SCREEN	LOU-1	ALUMINUM WALL LOUVERS
TER-2	TERRA COTTA - TH2	WIN-2	ALUMINUM WINDOW FRAME W DOUBLE OR TRIPLE GLAZING, REFER TO WINDOW SCHEDULE	WOD-1	ENGINEERED WOOD	LOU-2	METAL SCREEN SYSTEM - ROOFTOP
MOS-1	EXTERIOR TYPE MOSAIC TILE	WIN-3	ALUMINUM WINDOW FRAME W DOUBLE OR TRIPLE GLAZING, REFER TO WINDOW SCHEDULE	WOD-2	EXTERIOR WOOD PATTERN SOFFIT	SIG-1	SIGNAGE
ALU-1	ALUMINUM CLADDING PANEL SYSTEM						

REVISIONS	DATE

Copyright Reserved


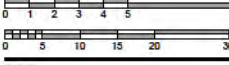


parc retirement living

17420
PARC VICTORIA
Mixed Use Seniors Residential & Commercial Development

NORTH ELEVATION
FORT STREET

A404

APR 2017
1:125

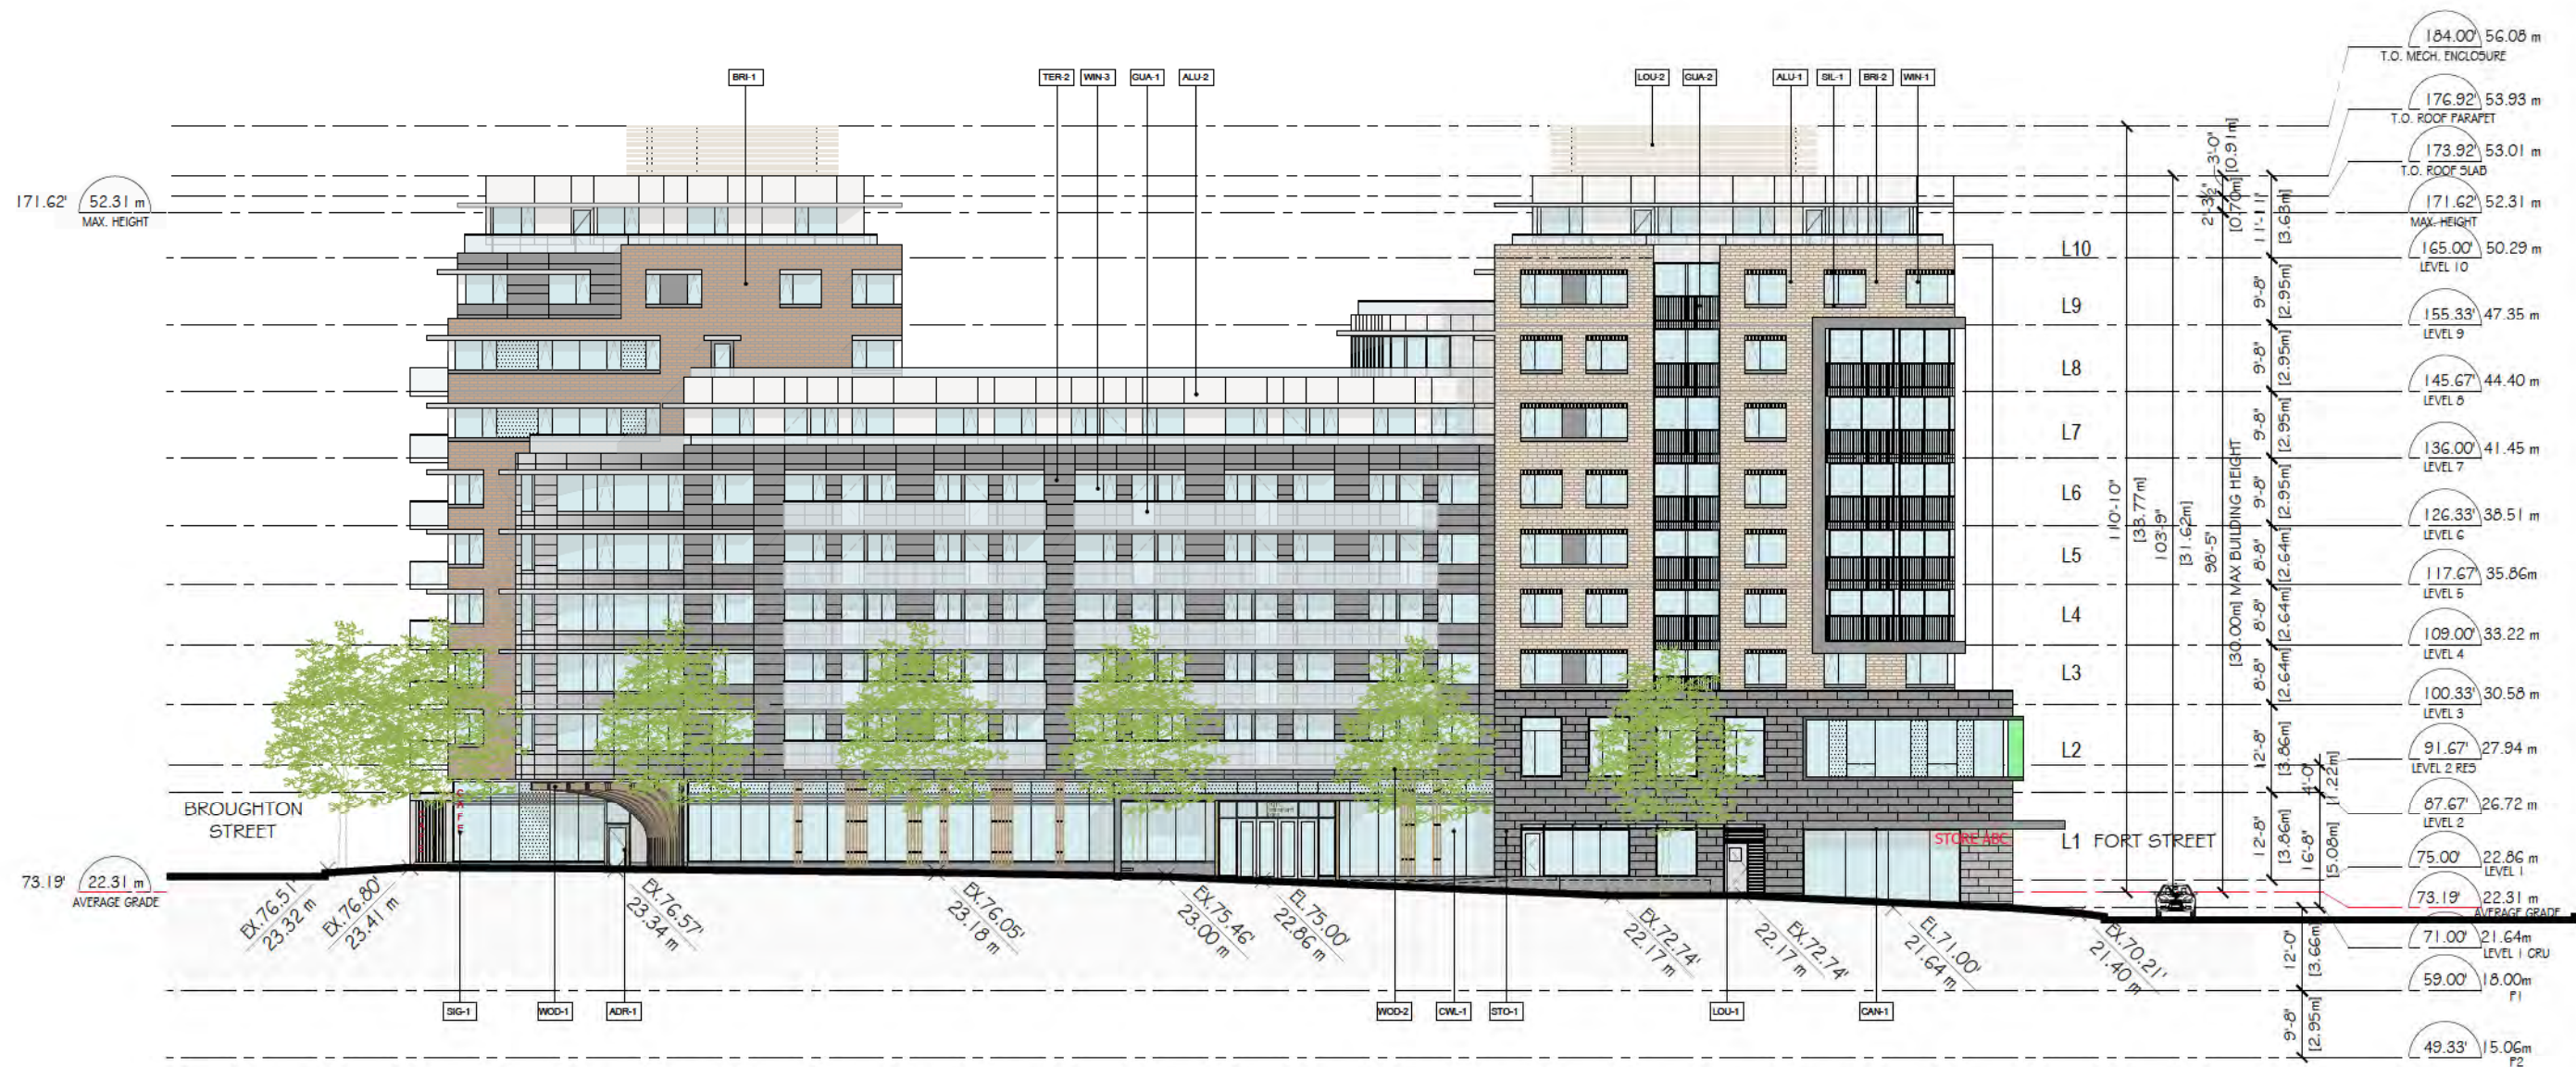

ELEVATION KEYNOTE LEGEND			
ITEM	COLOUR / FINISH	ITEM	COLOUR / FINISH
BR-1	STANDARD FACE BRICK, 4" X 12" PATTERN: TBD	ALU-2	ALUMINUM CLADDING PANEL SYSTEM TO MATCH ALUODOND ALADASTER
BR-2	STANDARD FACE BRICK, 4" X 12" PATTERN: TBD	CON-1	ARCHITECTURAL CONCRETE W/ REVEALS GREY (FARGED FINISH)
STO-1	GRANITE STONE CLADDING PATTERN: TBD	CON-2	ARCHITECTURAL CONCRETE COLUMNS GREY (FARGED FINISH)
STO-2	STONE CLADDING PATTERN: TBD	SIL-1	CONCRETE PRECAST SILL/HEADER GREY
TER-1	TERRA COTTA - TR2 TO MATCH "ROSE" OR SIMILAR MATT FINISH	WIN-1	VINYL WINDOW FRAME W/ DOUBLE OR TRIPLE GLAZING, REFER TO WINDOW SCHEDULE
TER-2	TERRA COTTA - TH2 TO MATCH "TITANIUM GREY" OR SIMILAR MATT FINISH	WIN-2	ALUMINUM WINDOW FRAME W/ DOUBLE OR TRIPLE GLAZING, REFER TO WINDOW SCHEDULE
MOS-1	EXTERIOR TYPE MOSAIC TILE MULTI COLOUR - WHITE, MEDIUM 4 DARK GREY	WIN-3	ALUMINUM WINDOW FRAME W/ DOUBLE OR TRIPLE GLAZING, REFER TO WINDOW SCHEDULE
ALU-1	ALUMINUM CLADDING PANEL SYSTEM TO MATCH ALUODOND NATURAL BRUSHED STAINLESS REVE		
		WIN-4	ALUMINUM WINDOW FRAME W/ DOUBLE OR TRIPLE GLAZING, REFER TO WINDOW SCHEDULE
		WIN-5	ALUMINUM WINDOW FRAME W/ DOUBLE OR TRIPLE GLAZING, REFER TO WINDOW SCHEDULE
bfa studio
architects
ECO-REGIONAL ARCHITECTURE + INTERIOR DESIGN

www.bfaarchitects.com

REVISIONS

NO.	DESCRIPTION	DATE
1	ISSUED FOR REVISION & DP	18 SEP 2017

Copyright Reserved


parc retirement living

PROJECT NO. 17420

PROJECT PARC VICTORIA
Mixed Use Seniors Residential & Commercial Development

DRAWING TITLE EAST ELEVATION
QUADRA STREET

DATE APR 2017
SCALE 1:125



REVISIONS

NO.	DESCRIPTION	DATE




parc
retirement
living

PROJECT NO. 17420

PROJECT
PARC VICTORIA
Mixed Use Seniors Residential &
Commercial Development

SOUTH ELEVATION
BROUGHTON STREET


A406

APR 2017


1:125



1 NORTH/FORT STREET ELEVATION

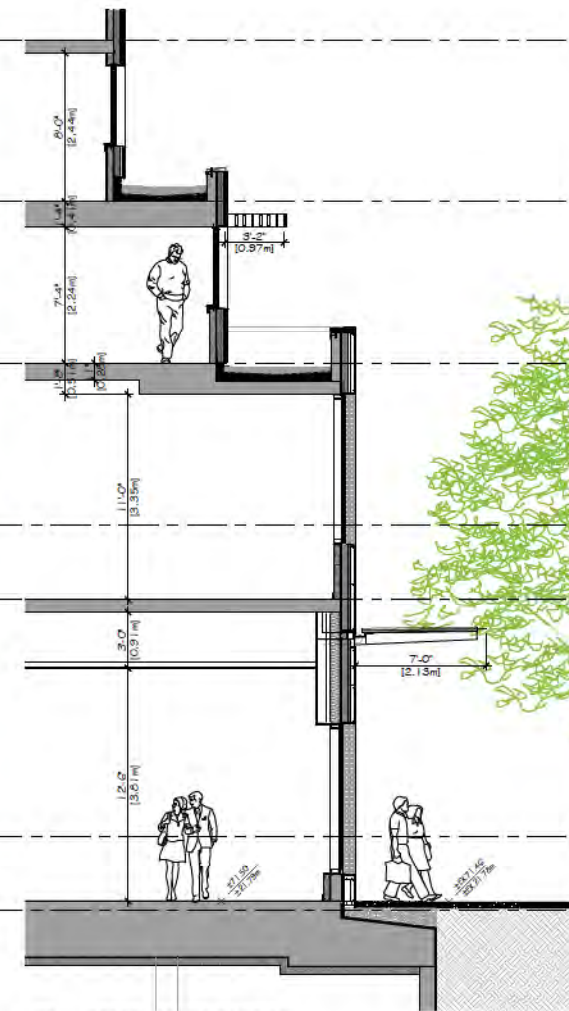

2 STREETScape SECTION

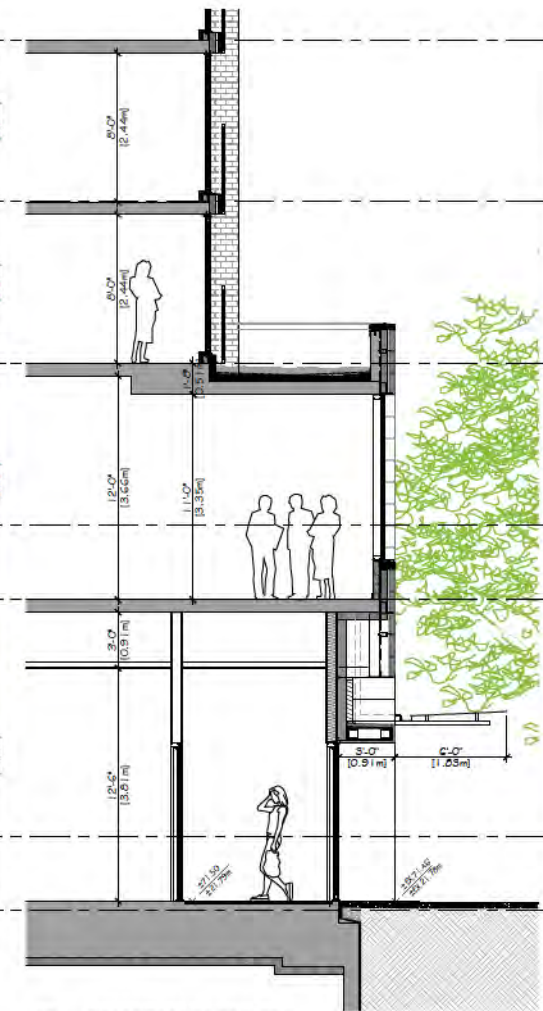

3 STREETScape SECTION

REVISIONS

NO.	DESCRIPTION	DATE
1	ISSUED FOR REVISION & OP	18 SEP 2017
2	RE-ISSUED FOR REVISION & OP	20 FEB 2018
3	RE-ISSUED FOR ADP	02 APR 2018
4	RE-ISSUED FOR REVISION & OP	18 JAN 2019
5	RE-ISSUED FOR ADP	24 APR 2019
6	RE-ISSUED FOR REVISION & OP	29 MAY 2019
7	RE-ISSUED FOR REVISION & OP	29 MAY 2020
8	RE-ISSUED FOR REVISION & OP	08 MAY 2021
9	RE-ISSUED FOR REVISION & OP	24 NOV 2021

Copyright Reserved



parc
retirement
living


17420

PARC VICTORIA
Mixed Use Seniors Residential &
Commercial Development

FORT (NORTH) STREETSCAPE
/ PARTIAL SECTION

A407

1:50

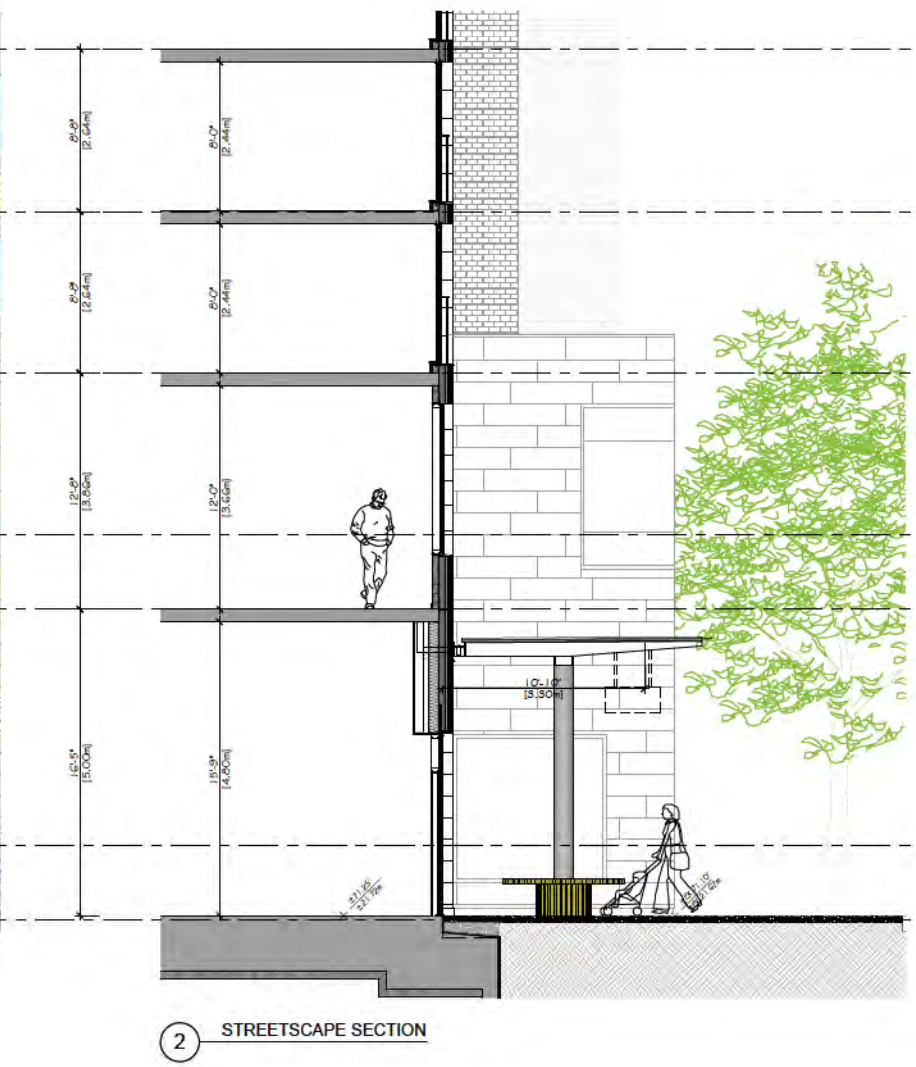

bfa studio
 architects
ECO-REGIONAL ARCHITECTURE + INTERIOR DESIGN

(Formerly BESHABAT FRANK ARCHITECTS)
 500 - 355 Blanford Street
 (Victoria, BC V6C 2B8)
 www.bfaarchitects.com

T 604 682 2543
 F 604 682 4060

NO.	DESCRIPTION	DATE
1	ISSUED FOR REZONING & DP	18 SEP 2017
2	RE-ISSUED FOR REZONING & DP	20 FEB 2018
3	RE-ISSUED FOR ADP	02 APR 2018
4	RE-ISSUED FOR REZONING & DP	18 JAN 2019
5	RE-ISSUED FOR ADP	24 APR 2019
6	RE-ISSUED FOR REZONING & DP	26 MAY 2019
7	RE-ISSUED FOR REZONING & DP	26 AUG 2020
8	RE-ISSUED FOR REZONING & DP	05 MAY 2021
9	RE-ISSUED FOR REZONING & DP	24 NOV 2021



parc
 retirement
 living

PROJECT NO. 17420
 PROJECT PARC VICTORIA
 Mixed Use Seniors Residential & Commercial Development

FORT (NORTH) STREETScape / PARTIAL SECTION

A408

1:50



REVISIONS

NO.	DESCRIPTION	DATE
1	ISSUED FOR REZONING & DP	18 SEP 2017
2	RE-ISSUED FOR REZONING & DP	20 FEB 2018
3	RE-ISSUED FOR ADP	02 APR 2018
4	RE-ISSUED FOR REZONING & DP	18 JAN 2019
5	RE-ISSUED FOR ADP	24 APR 2019
6	RE-ISSUED FOR REZONING & DP	29 MAY 2019
7	RE-ISSUED FOR REZONING & DP	26 AUG 2020
8	RE-ISSUED FOR REZONING & DP	08 MAY 2021
9	RE-ISSUED FOR REZONING & DP	24 NOV 2021

COPYRIGHT RESERVATIONS




parc
retirement
living

17420

PROJECT
PARC VICTORIA
Mixed Use Seniors Residential &
Commercial Development

LOCATION
FORT (NORTH) STREETSCAPE
/ PARTIAL SECTION

A409


DATE

SCALE

1:50



1 NORTH/FORT STREET ELEVATION

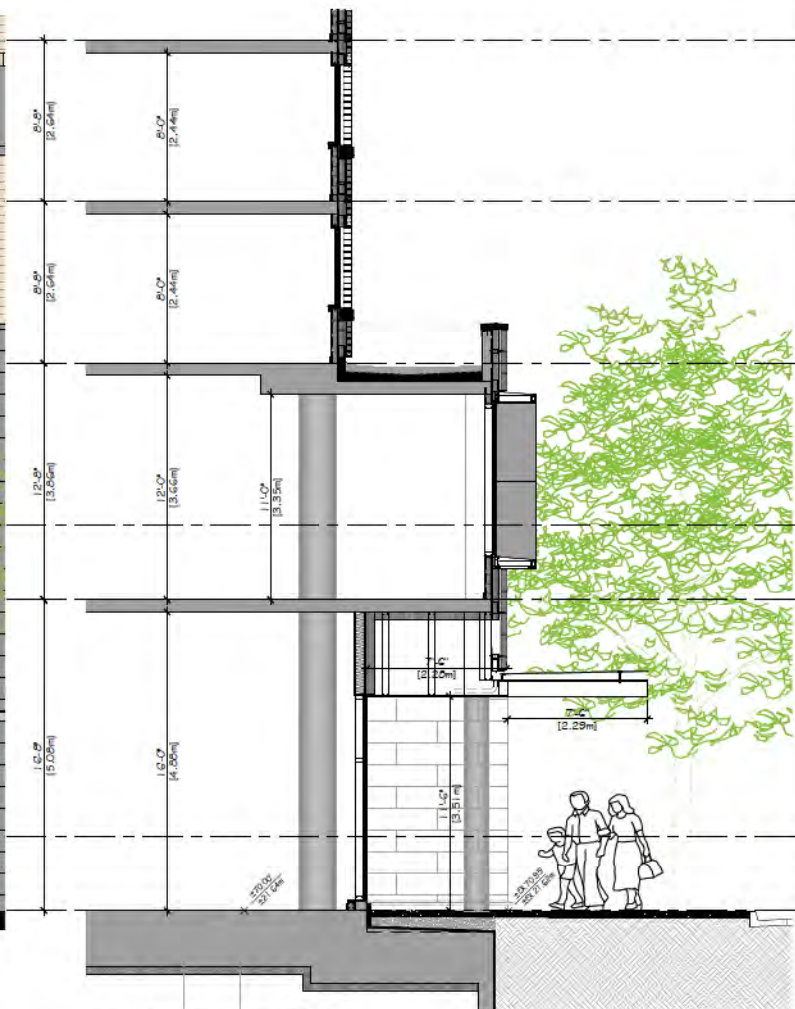

2 STREETSCAPE SECTION

REVISIONS

NO.	DESCRIPTION	DATE
1	ISSUED FOR REZONING & DP	18 SEP 2017
2	RE-ISSUED FOR REZONING & DP	20 FEB 2018
3	RE-ISSUED FOR ADP	02 APR 2018
4	RE-ISSUED FOR REZONING & DP	18 JAN 2019
5	RE-ISSUED FOR ADP	24 APR 2019
6	RE-ISSUED FOR REZONING & DP	30 MAY 2019
7	RE-ISSUED FOR REZONING & DP	30 AUG 2020
8	RE-ISSUED FOR REZONING & DP	08 MAY 2021
9	RE-ISSUED FOR REZONING & DP	24 NOV 2021

COPYRIGHT RESERVES




parc
retirement
living

17420

PROJECT
PARC VICTORIA
Mixed Use Seniors Residential & Commercial Development

LOCATION
FORT (NORTH) STREETSCAPE / PARTIAL SECTION

A410

1:50



REVISIONS

NO.	DESCRIPTION	DATE
1	ISSUED FOR REZONING & DP	18 SEP 2017
2	RE-ISSUED FOR REZONING & DP	20 FEB 2018
3	RE-ISSUED FOR ADP	02 APR 2018
4	RE-ISSUED FOR REZONING & DP	18 JAN 2019
5	RE-ISSUED FOR ADP	24 APR 2019
6	RE-ISSUED FOR REZONING & DP	29 MAY 2019
7	RE-ISSUED FOR REZONING & DP	28 AUG 2020
8	RE-ISSUED FOR REZONING & DP	08 MAY 2021
9	RE-ISSUED FOR REZONING & DP	24 NOV 2021

Copyright Reserved




parc
retirement
living

17420

PARC VICTORIA
Mixed Use Seniors Residential &
Commercial Development

QUADRA (EAST)
STREETSCAPE / PARTIAL
SECTION

A411

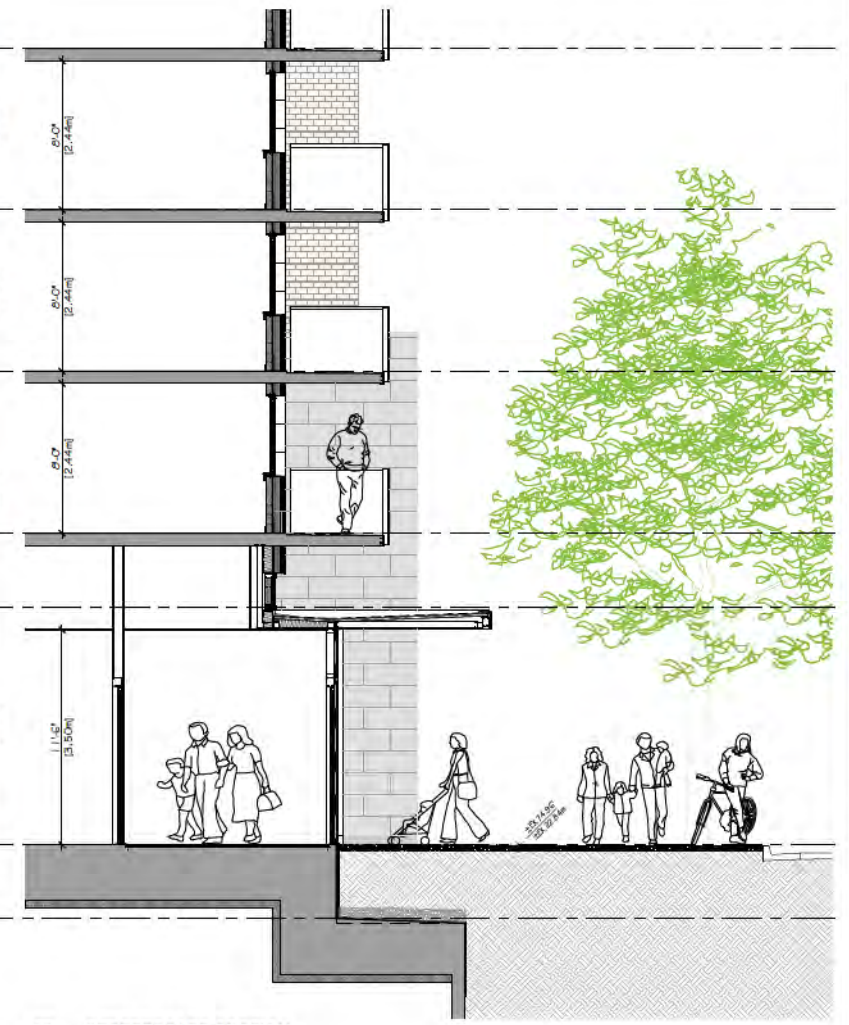

1 EAST/QUADRA STREET ELEVATION

2 STREETScape SECTION

bfa studio architects
ECO-REGIONAL ARCHITECTURE + INTERIOR DESIGN

(Formerly BESHABAT FRANKS ARCHITECTS)
500 - 315 Blenheim Street | Vancouver, BC V6C 2B6 | Tel: 604 682 3543 | Fax: 604 682 4880 | www.bfaarchitects.com

NO.	DESCRIPTION	DATE
1	ISSUED FOR REZONING & DP	18 SEP 2017
2	RE-ISSUED FOR REZONING & DP	20 FEB 2018
3	RE-ISSUED FOR ADP	02 APR 2018
4	RE-ISSUED FOR REZONING & DP	18 JAN 2019
5	RE-ISSUED FOR ADP	24 APR 2019
6	RE-ISSUED FOR REZONING & DP	29 MAY 2019
7	RE-ISSUED FOR REZONING & DP	28 AUG 2020
8	RE-ISSUED FOR REZONING & DP	08 MAY 2021
9	RE-ISSUED FOR REZONING & DP	24 NOV 2021

Copyright Reserved


0 1 2 3m
0 1 2 3 4 5 10'

parc retirement living


17420

PARC VICTORIA
Mixed Use Seniors Residential & Commercial Development


QUADRA (EAST)
STREETSCAPE / PARTIAL SECTION

A412

1:50

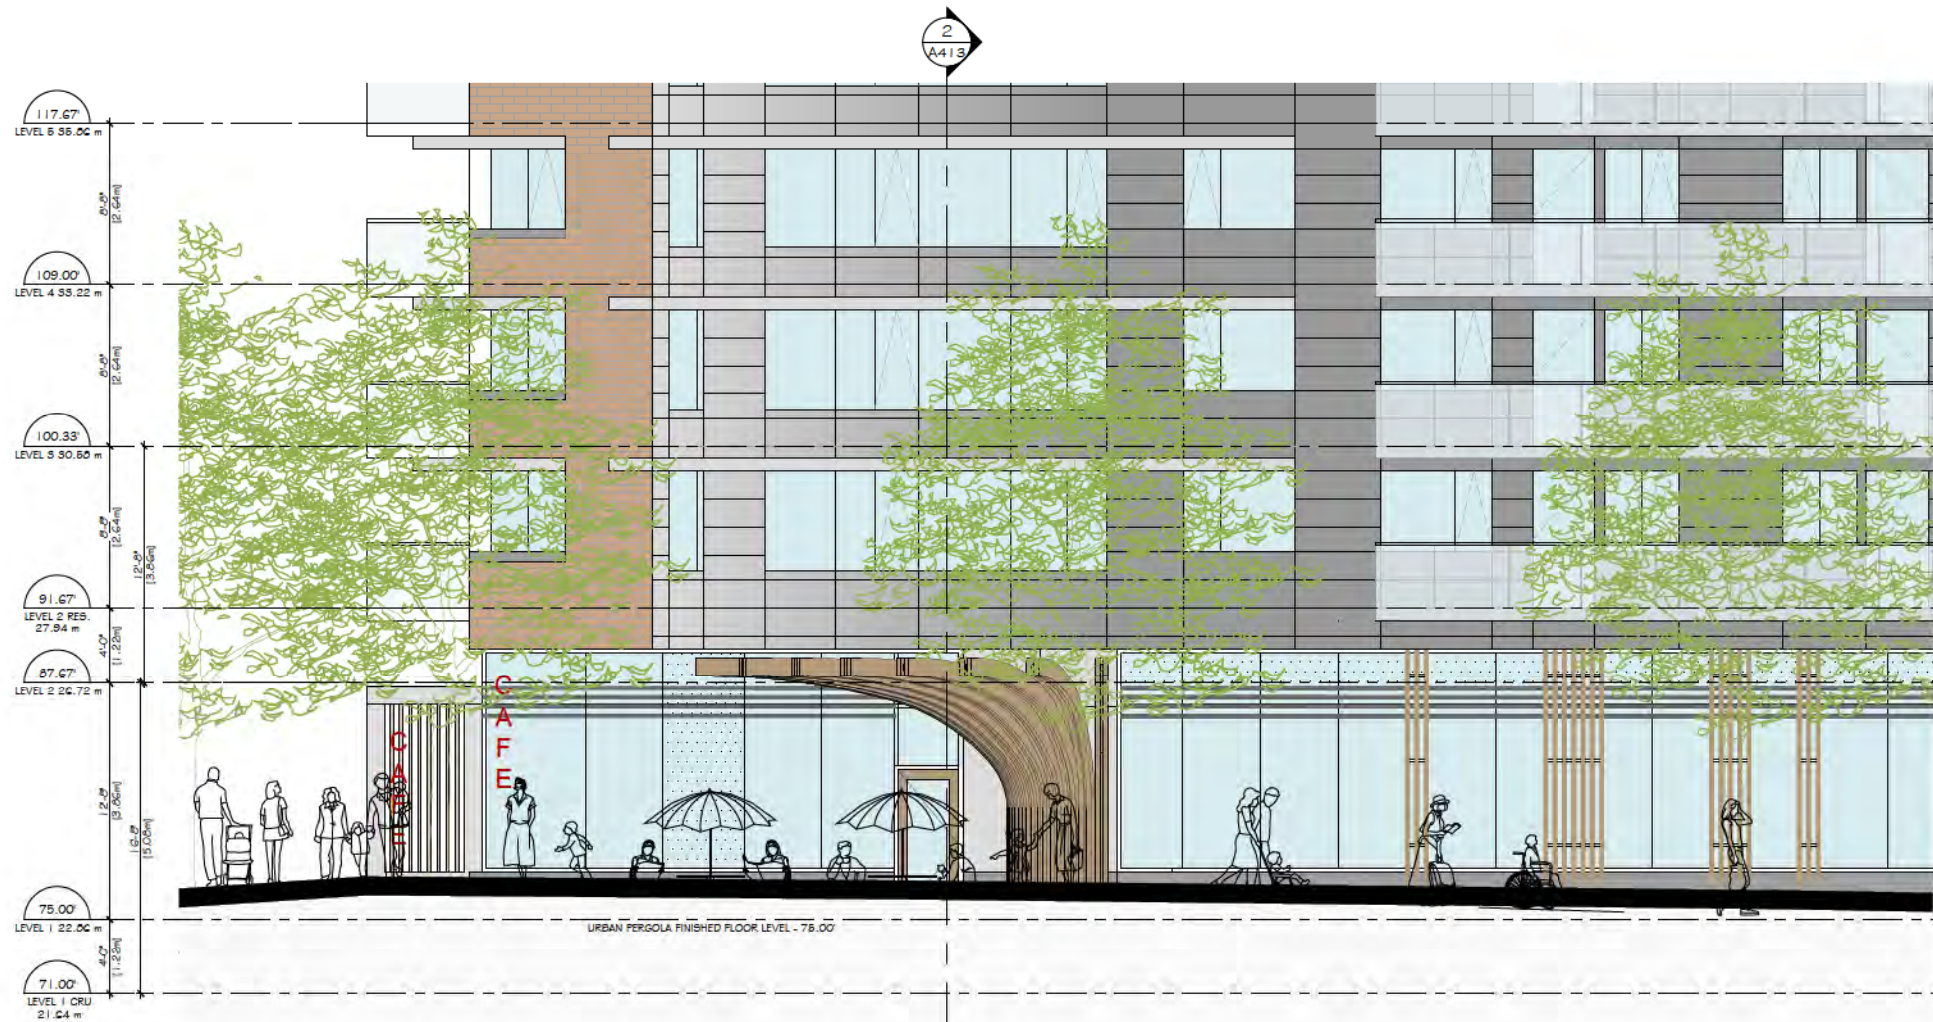

1 EAST/ QUADRA STREET ELEVATION

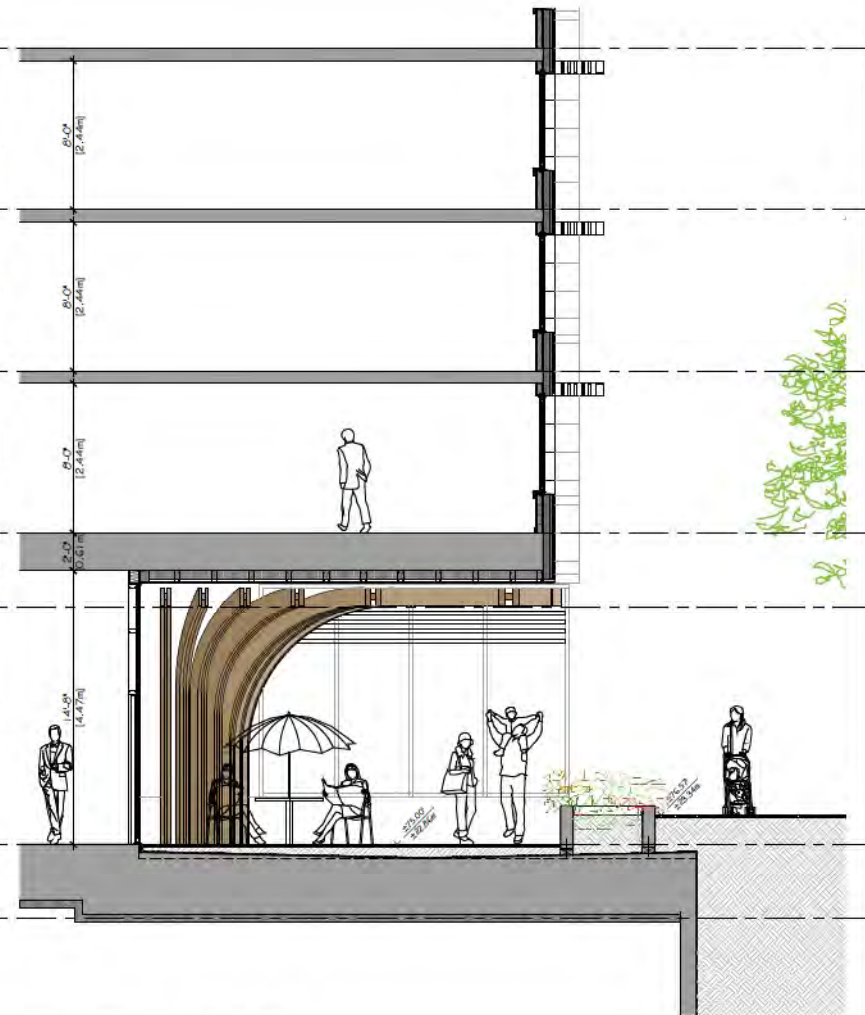

2 STREETScape SECTION

bfa studio architects
ECO-REGIONAL ARCHITECTURE + INTERIOR DESIGN

Formerly BESHAY PHARO ARCHITECTS
301 - 305 Blenheim Street T 604 932 3543
PO Box 100 YV 208 F 604 932 4000
www.bfa-studio.com

NO.	DESCRIPTION	DATE
1	ISSUED FOR REVISION & DP	18 SEP 2017
2	RE-DESIGNED FOR REVISION & DP	20 FEB 2018
3	RE-DESIGNED FOR REVISION & DP	02 APR 2018
4	RE-DESIGNED FOR REVISION & DP	18 JAN 2019
5	RE-DESIGNED FOR REVISION & DP	24 APR 2019
6	RE-DESIGNED FOR REVISION & DP	29 MAY 2019
7	RE-DESIGNED FOR REVISION & DP	28 AUG 2020
8	RE-DESIGNED FOR REVISION & DP	08 MAY 2021
9	RE-DESIGNED FOR REVISION & DP	24 NOV 2021

parc retirement living

17420

PARC VICTORIA
Mixed Use Seniors Residential & Commercial Development

QUADRA (EAST)
STREETSCAPE / PARTIAL SECTION

A413

1:50



bfa studio architects
ECO-REGIONAL ARCHITECTURE + INTERIOR DESIGN

(Formerly BESHAY FINAIS ARCHITECTS)
301 - 305 Broughton Street T 854 562 3543
PO Box 100 YVD 208 F 854 562 4000
www.bfaarchitects.com

NO.	DESCRIPTION	DATE
1	ISSUED FOR REZONING & DP	18 SEP 2017
2	RE-DESIGNED FOR REZONING & DP	20 FEB 2018
3	RE-DESIGNED FOR ADP	02 APR 2018
4	RE-DESIGNED FOR REZONING & DP	18 JAN 2019
5	RE-DESIGNED FOR ADP	24 APR 2019
6	RE-DESIGNED FOR REZONING & DP	29 MAY 2019
7	RE-DESIGNED FOR REZONING & DP	28 AUG 2020
8	RE-DESIGNED FOR REZONING & DP	08 MAY 2021
9	RE-DESIGNED FOR REZONING & DP	24 NOV 2021

Copyright Reserved
This plan and section are used at all times under the copyright of the architect and shall not be used in any other way without the written consent of the architect. The architect is not responsible for any errors or omissions in this plan and section. 

0 1 2 3m
0 1 2 3 4 5 10'

parc retirement living

17420

PARC VICTORIA
Mixed Use Seniors Residential & Commercial Development

BROUGHTON (SOUTH) STREETScape / PARTIAL SECTION

A414

1:50



bfa studio architects
ECO-REGIONAL ARCHITECTURE • INTERIOR DESIGN

Formerly BESHABY PHARS ARCHITECTS
301 - 305 Broughton Street T 604 922 1543
/bfa.studio P 604 942 4060
www.bfa.studio.com

NO.	DESCRIPTION	DATE
1	ISSUED FOR REVISION & OP	18 SEP 2017
2	RE-DESIGNED FOR REVISION & OP	20 FEB 2018
3	RE-DESIGNED FOR REVISION & OP	02 APR 2018
4	RE-DESIGNED FOR REVISION & OP	18 JAN 2019
5	RE-DESIGNED FOR REVISION & OP	24 APR 2019
6	RE-DESIGNED FOR REVISION & OP	29 MAY 2019
7	RE-DESIGNED FOR REVISION & OP	28 AUG 2020
8	RE-DESIGNED FOR REVISION & OP	08 MAY 2021
9	RE-DESIGNED FOR REVISION & OP	24 NOV 2021

parc retirement living


PROJECT NO. 17420

PROJECT NAME: PARC VICTORIA
Mixed Use Seniors Residential & Commercial Development

LOCATION: BROUGHTON (SOUTH) STREETScape / PARTIAL SECTION

A415


SCALE: 1:50

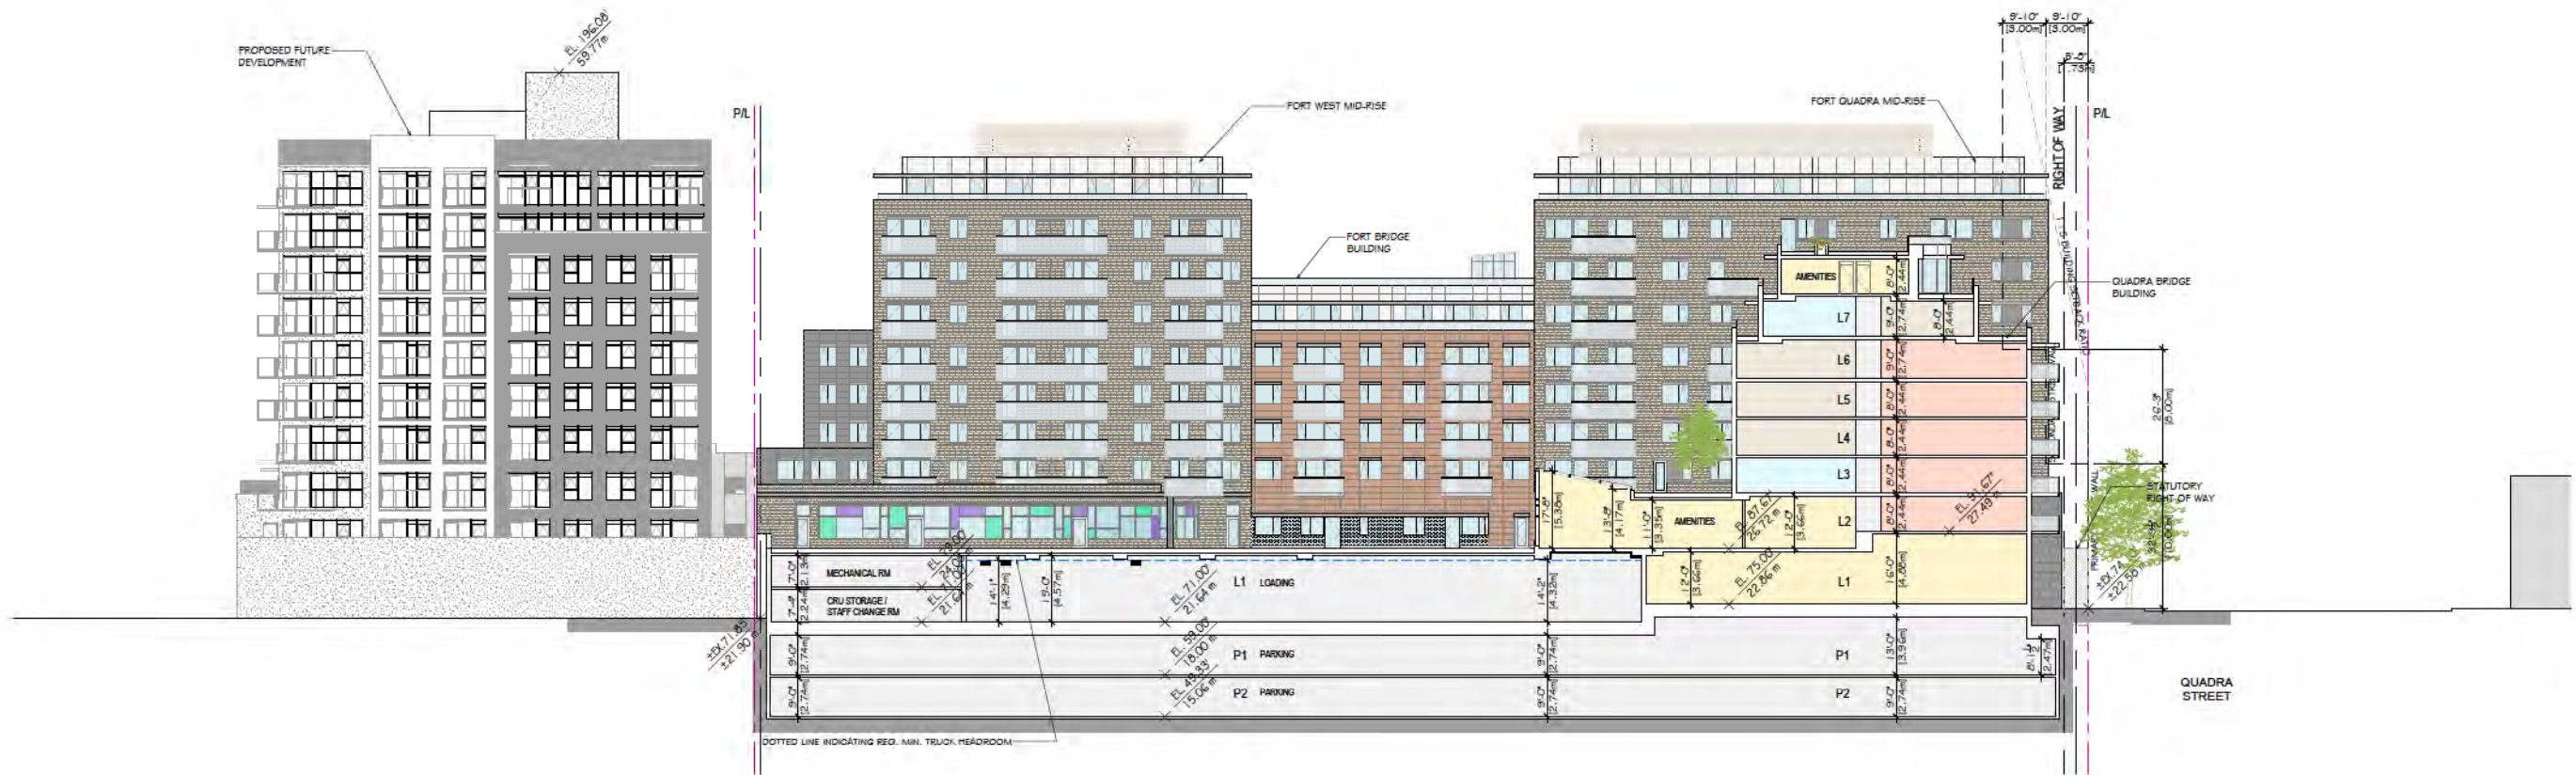

REVISIONS

REV.	DESCRIPTION	DATE

Copyright Reserved
This drawing is the property of BFA Studio Architects. It is not to be used, copied, or reproduced in any form without the written consent of BFA Studio Architects. The information on this drawing is for informational purposes only and does not constitute a contract. 

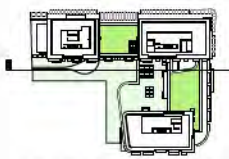

parc
retirement
living

PROJECT NO. 17420

PROJECT
PARC VICTORIA
Mixed Use Seniors Residential &
Commercial Development

DESIGNER
BUILDING SECTION B/
INTERNAL SOUTH
ELEVATION

A502

DATE
APR 2017

SCALE
1:200

REVISIONS		
NO.	DESCRIPTION	DATE
ISSUED FOR REZONING & DP		18 SEP 2017
RE-ISSUED FOR REZONING & DP		20 FEB 2018
RE-ISSUED FOR ADP		02 APR 2018
RE-ISSUED FOR REZONING & DP		16 JAN 2019
RE-ISSUED FOR ADP		24 APR 2019
RE-ISSUED FOR REZONING & DP		29 MAY 2019
RE-ISSUED FOR REZONING & DP		28 AUG 2020
RE-ISSUED FOR REZONING & DP		08 MAY 2021
RE-ISSUED FOR REZONING & DP		24 NOV 2021

THIS PLAN AND ORDERS ARE AND AT ALL TIMES REMAIN THE SOLE AND EXCLUSIVE PROPERTY OF THE ARCHITECT AND SHALL NOT BE LOANED OR REPRODUCED WITHOUT WRITTEN CONSENT. SECTIONS DRAWINGS SHALL HAVE PRECEDENCE OVER SEALS OR ENDORSEMENTS. 



parc
retirement
living

420

PARC VICTORIA
Mixed Use Seniors Residential &
Commercial Development




BUILDING SECTION D

A504

NOV 2017

1:200



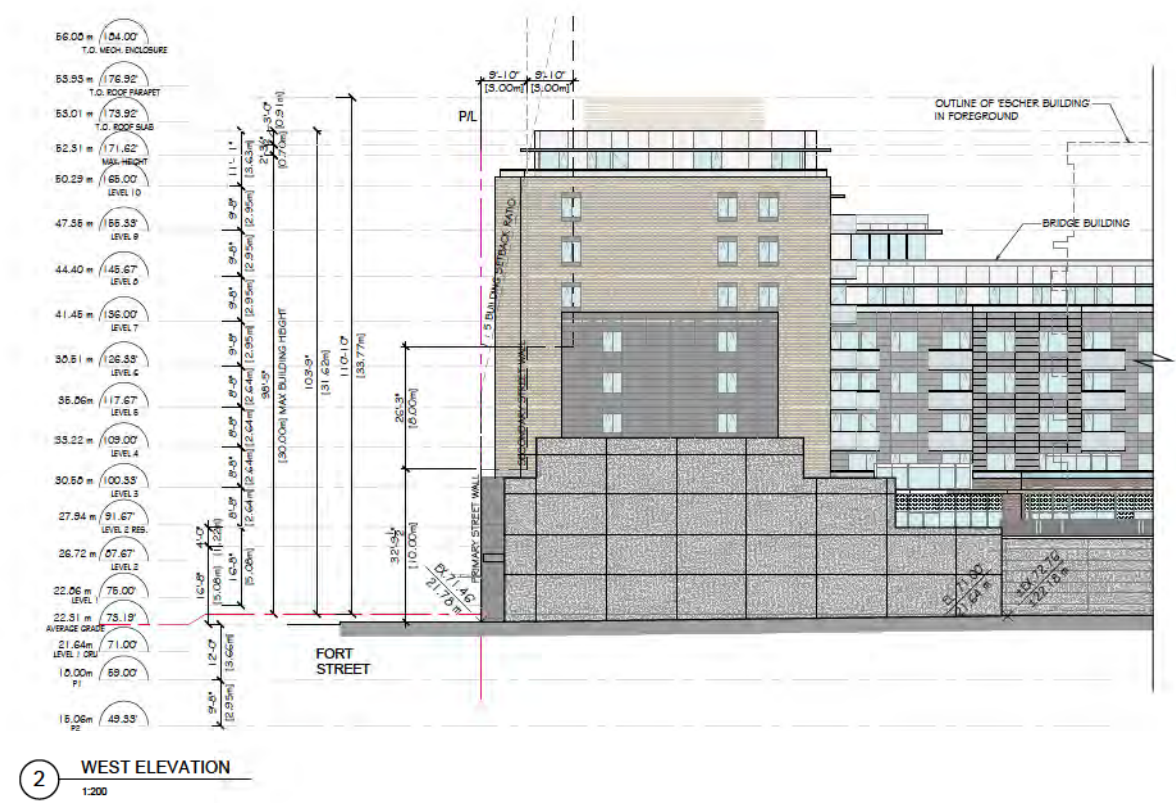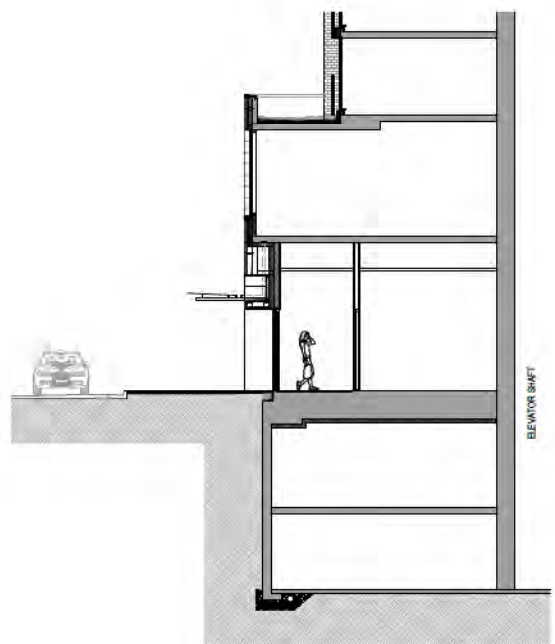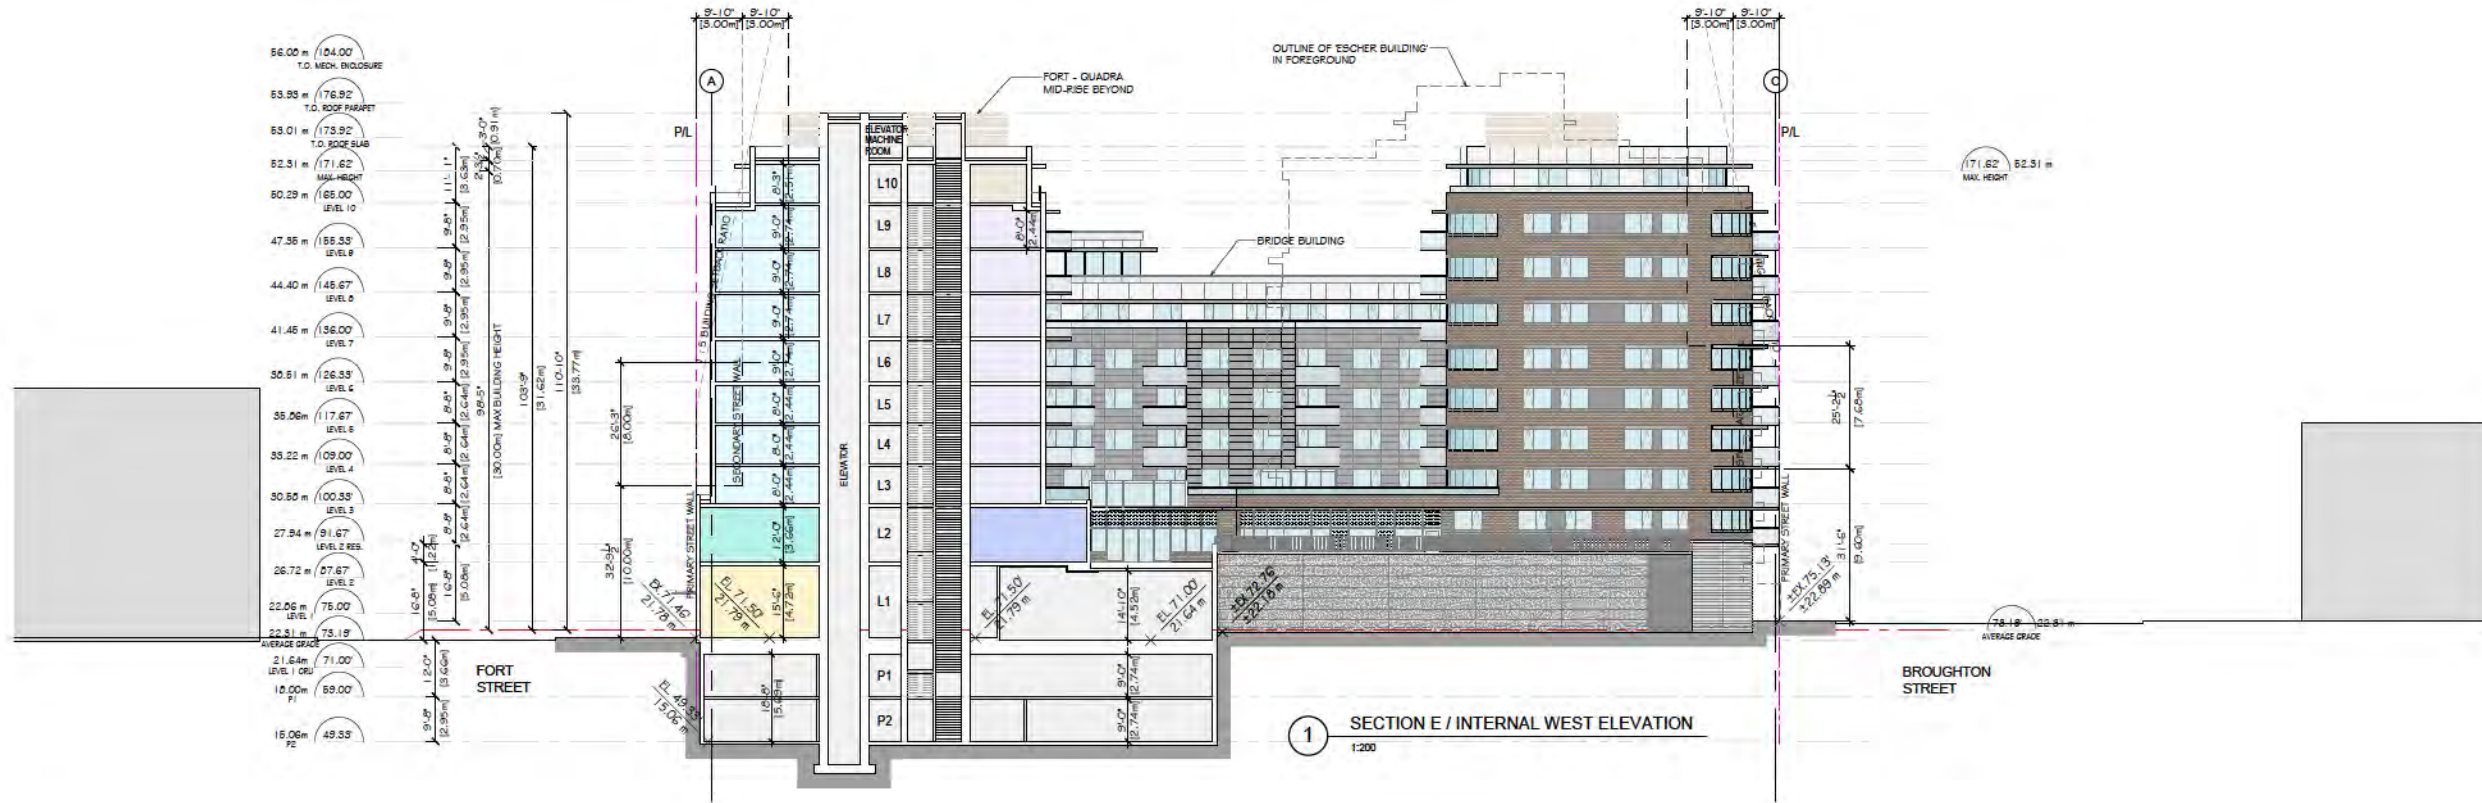

bfa studio architects
ECO-REGIONAL ARCHITECTURE + INTERIOR DESIGN

Formerly **RESHABAT FRIARS ARCHITECTS**
www.bfa.studioarchitects.com


parc retirement living


PROJECT NO. 17420


PROJECT **PARC VICTORIA**
Mixed Use Seniors Residential & Commercial Development

DRAWING TITLE **BUILDING SECTION E / INTERNAL WEST ELEVATION / WEST ELEVATION**


A505

DATE APR 2017
SCALE 1:200

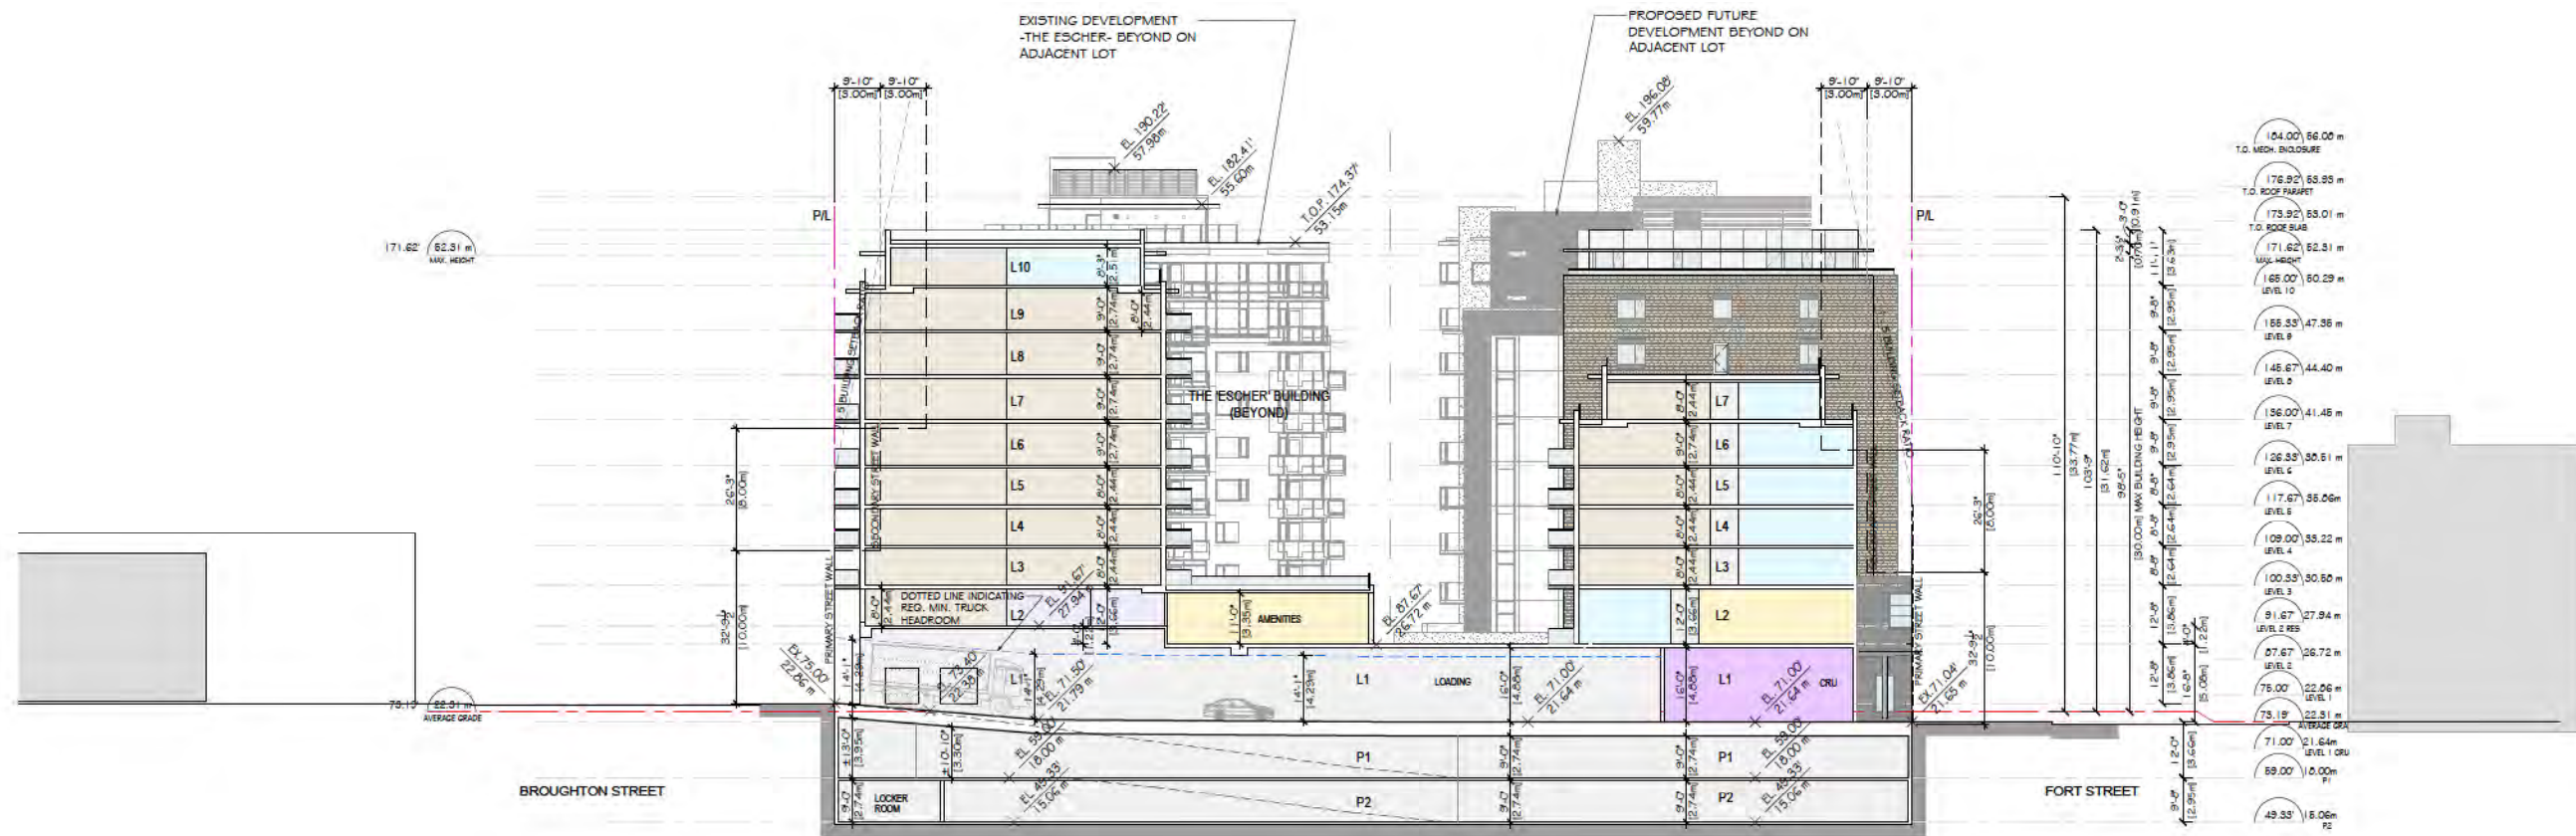

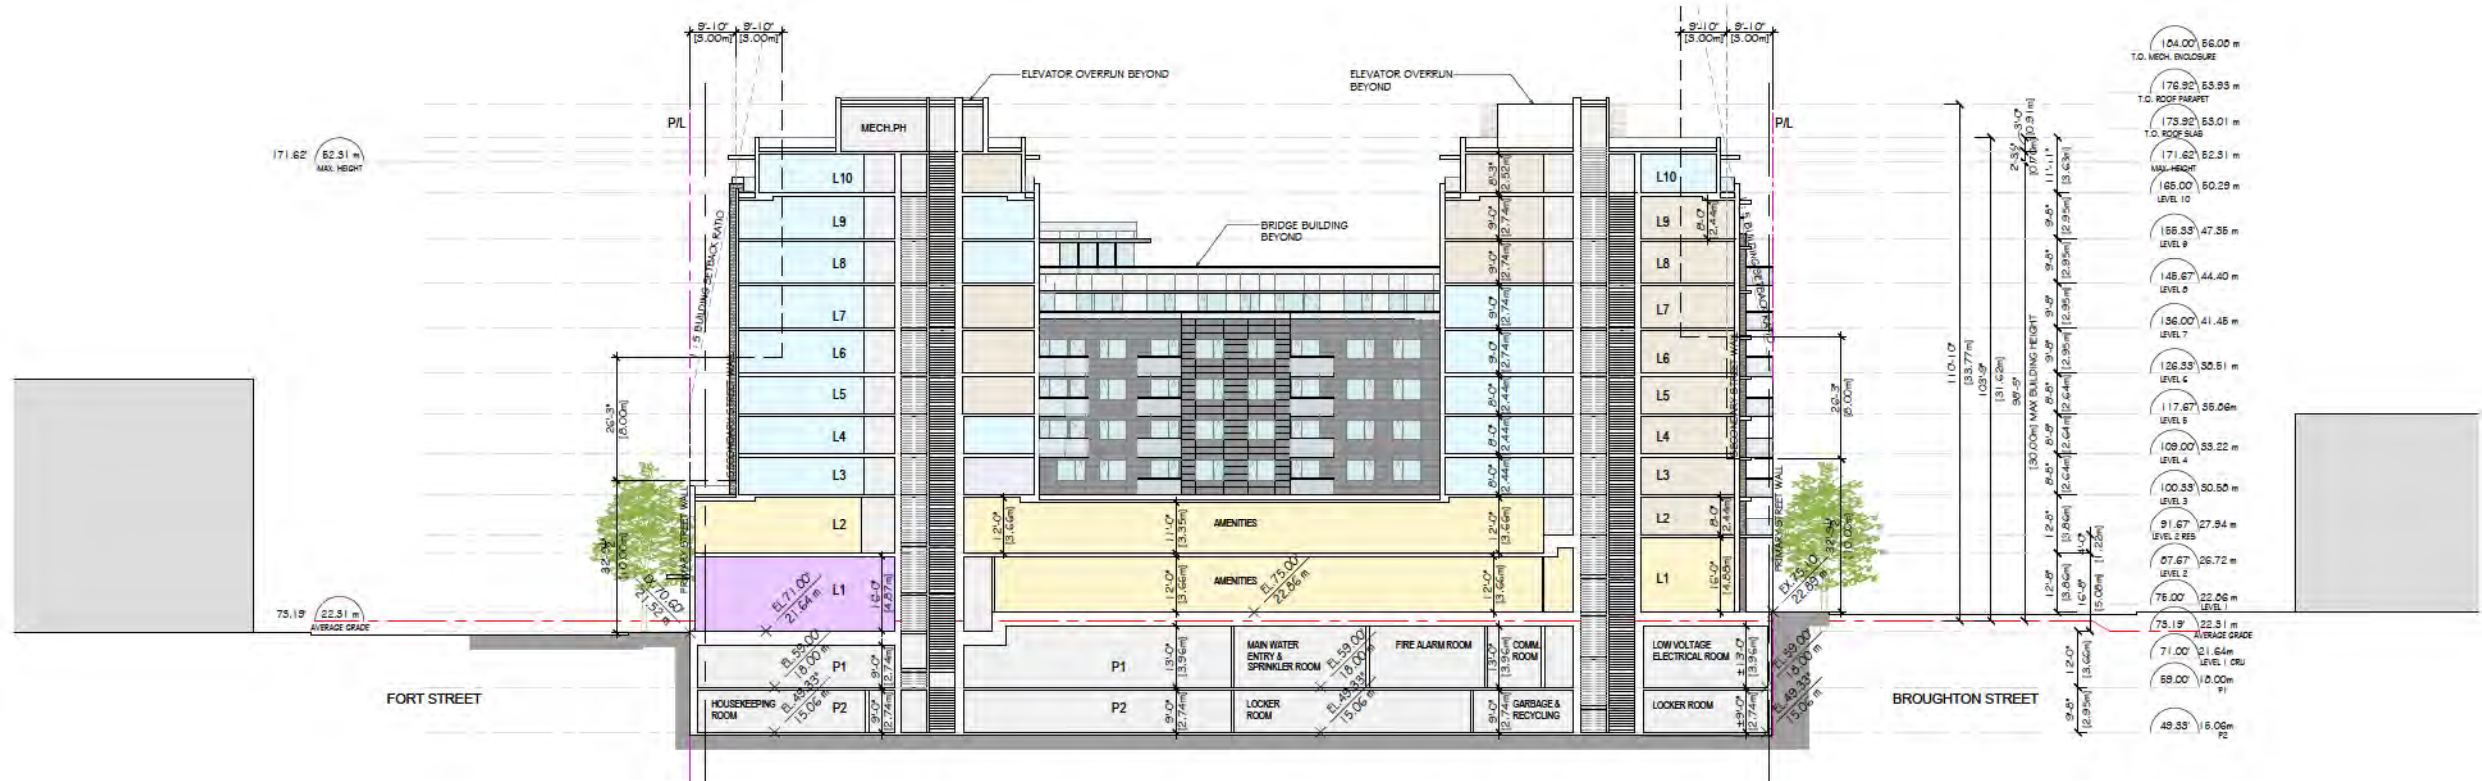

1 SECTION H / INTERNAL WEST ELEVATION
1:200

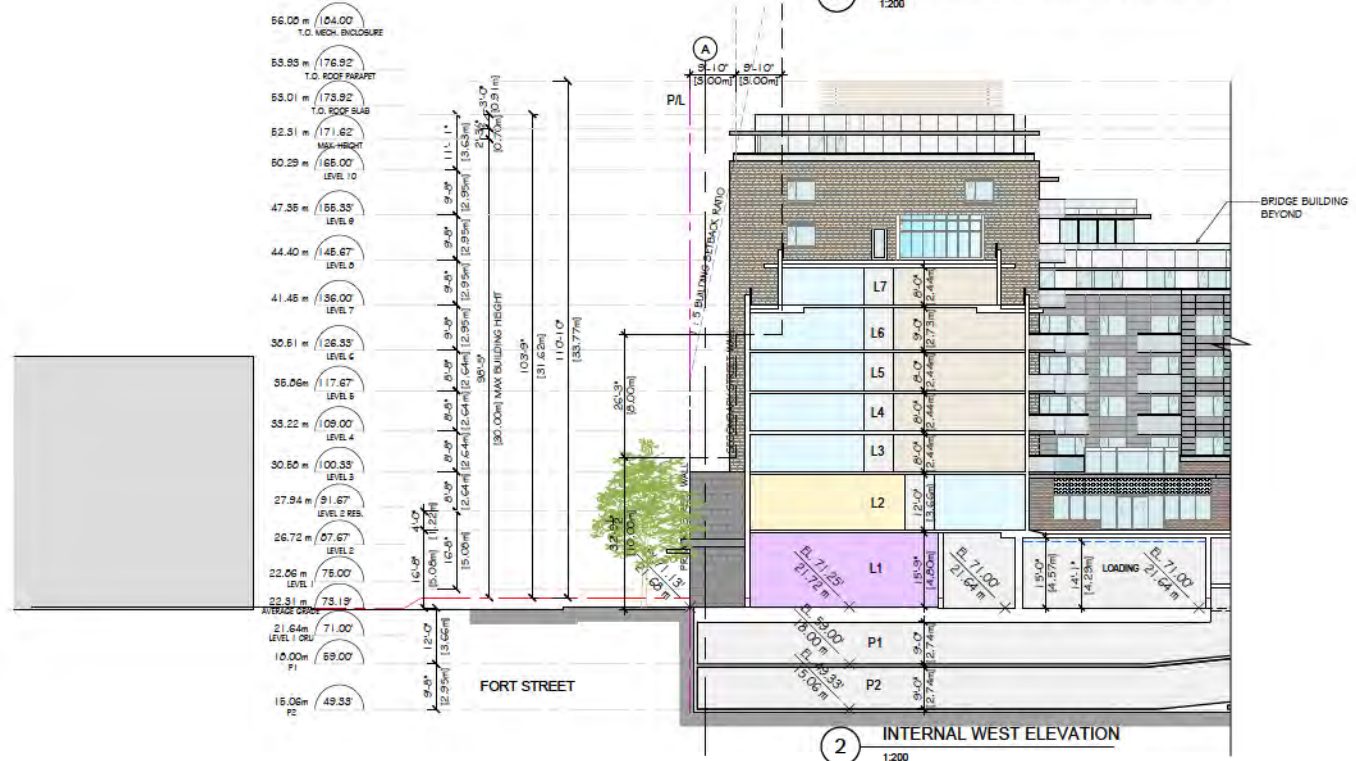

2 INTERNAL WEST ELEVATION
1:200

bfa studio
 architects
ECO-REGIONAL ARCHITECTURE • INTERIOR DESIGN

(Formerly) REHABIT FIARS ARCHITECTS
310 - 315 Summit Street Vancouver, BC V6C 2S6
T 604 682 1543 F 604 682 4502
www.bfaarchitects.com

NO.	DESCRIPTION	DATE


parc
 retirement
 living

PROJECT NO. 17420
 PROJECT PARC VICTORIA
 Mixed Use Seniors Residential & Commercial Development

DRAWING NO. BUILDING SECTION H / INTERNAL WEST ELEVATION

DATE APR 2017
 SCALE 1:200


A508

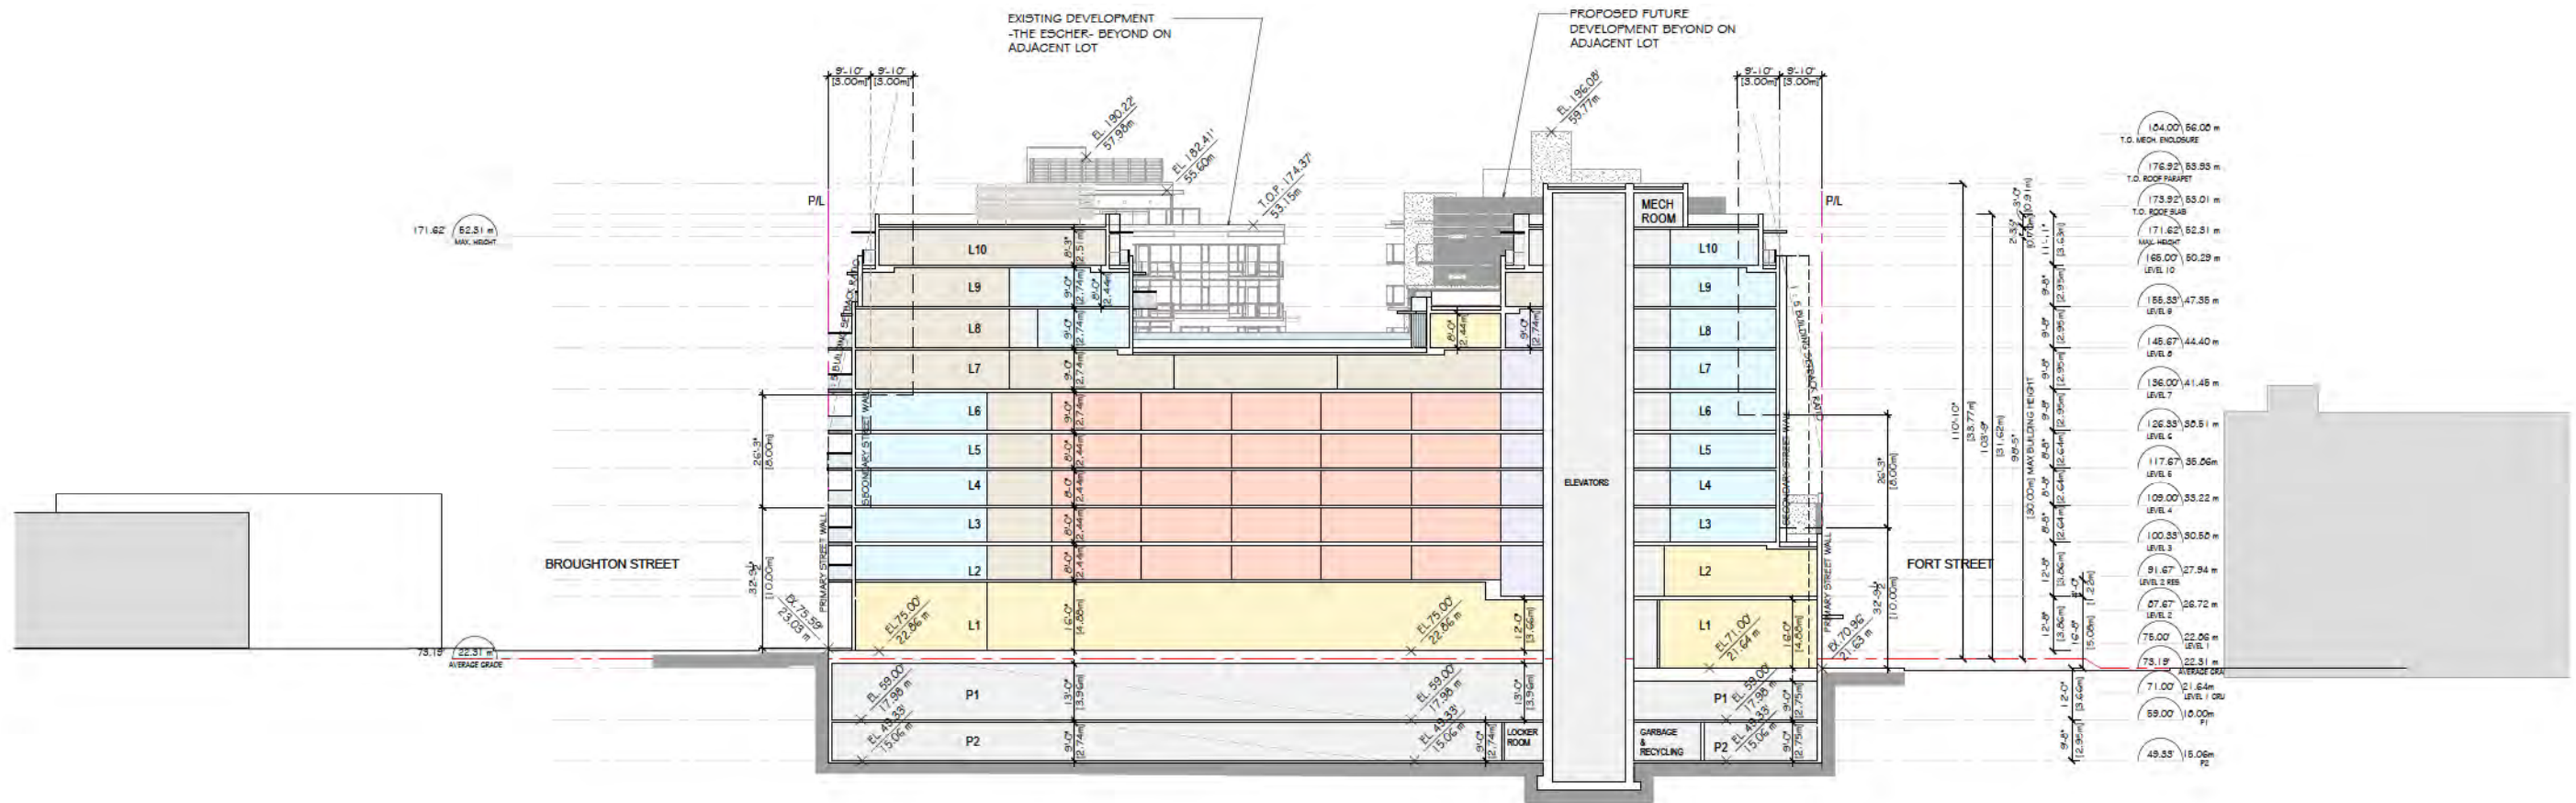

REVISIONS

NO.	DESCRIPTION	DATE
1	ISSUED FOR REVISION & DP	18 SEP 2017
2	RE-ISSUED FOR REVISION & DP	20 FEB 2018
3	RE-ISSUED FOR ADP	02 APR 2018
4	RE-ISSUED FOR REVISION & DP	18 JAN 2019
5	RE-ISSUED FOR ADP	24 APR 2019
6	RE-ISSUED FOR REVISION & DP	29 MAY 2019
7	RE-ISSUED FOR REVISION & DP	29 AUG 2020
8	RE-ISSUED FOR REVISION & DP	08 MAY 2021
9	RE-ISSUED FOR REVISION & DP	24 NOV 2021

Copyright Reserved


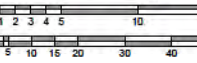

parc
retirement
living


17420

PARC VICTORIA
Mixed Use Seniors Residential & Commercial Development

BUILDING SECTION J

A509

DATE: APR 2017
SCALE: 1:200

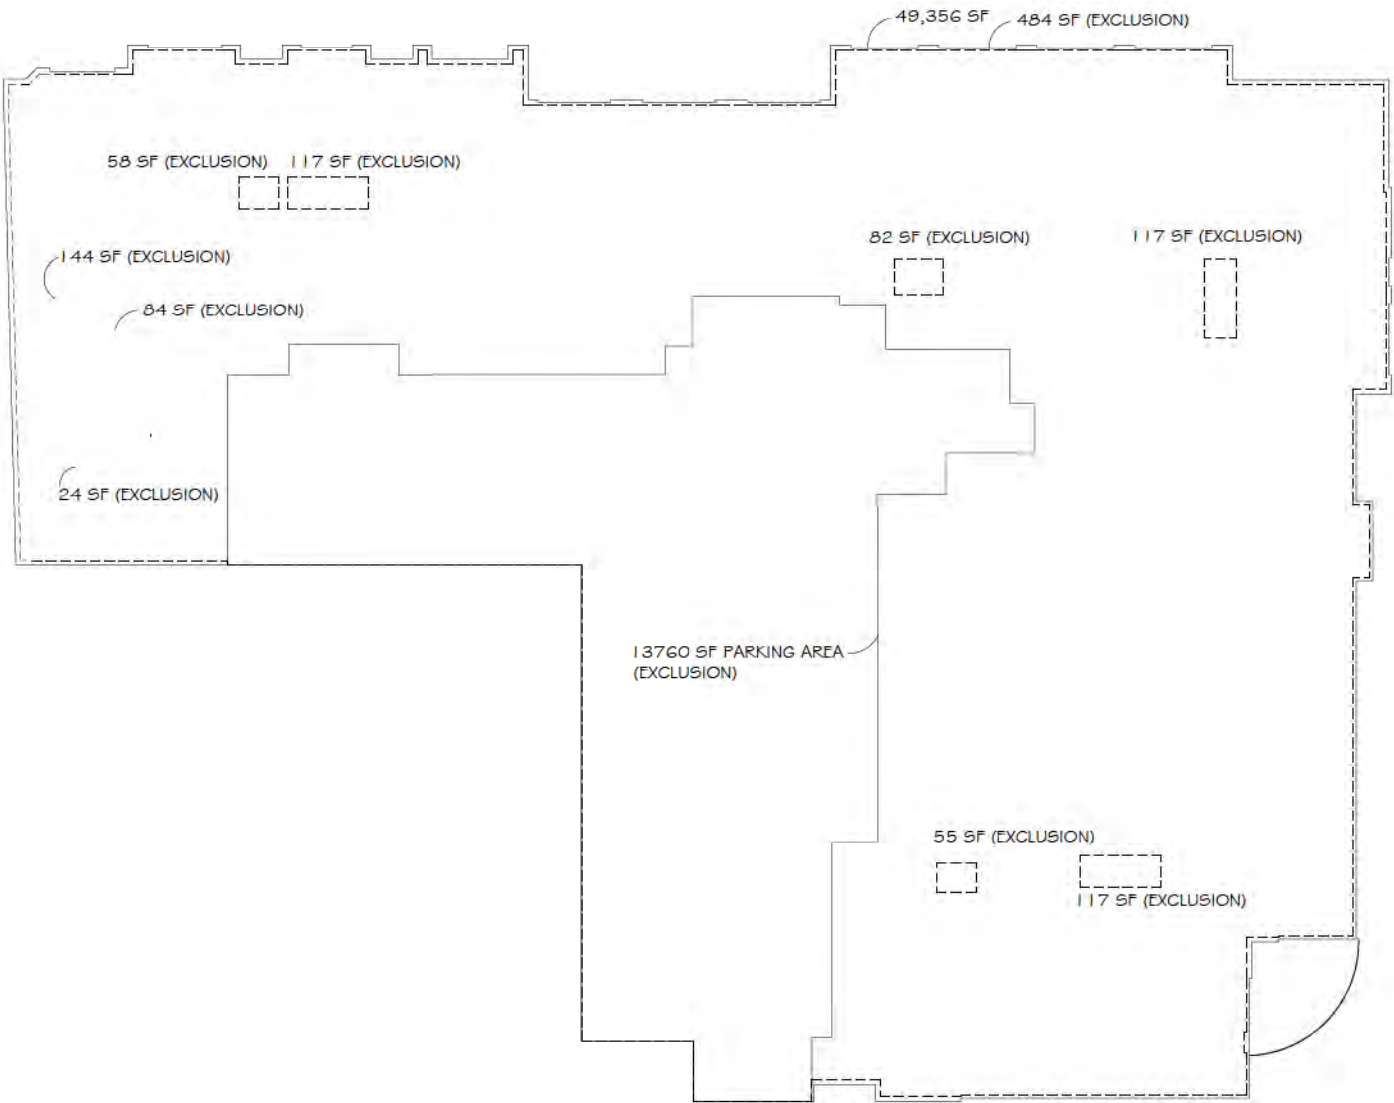


LEVEL 1 AREA CALCULATION:

TOTAL GROSS FLOOR AREA = 49,356 SF
TOTAL EXCLUDED AREA = 15,042 SF
TOTAL FSR = 34,314 SF

REVISIONS

NO.	DESCRIPTION	DATE
1	ISSUED FOR REZONING & DP	18 SEP 2017
2	RE-ISSUED FOR REZONING & DP	20 FEB 2018
3	RE-ISSUED FOR ADP	02 APR 2018
4	RE-ISSUED FOR REZONING & DP	18 JAN 2019
5	RE-ISSUED FOR ADP	24 APR 2019
6	RE-ISSUED FOR REZONING & DP	29 MAY 2019
7	RE-ISSUED FOR REZONING & DP	26 AUG 2020
8	RE-ISSUED FOR REZONING & DP	08 MAY 2021
9	RE-ISSUED FOR REZONING & DP	24 NOV 2021

Copyright Reserved


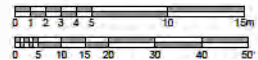

parc
retirement
living

17420



PARC VICTORIA
Mixed Use Seniors Residential &
Commercial Development

LEVEL 1
AREA OVERLAY

001

SCALE

1:200

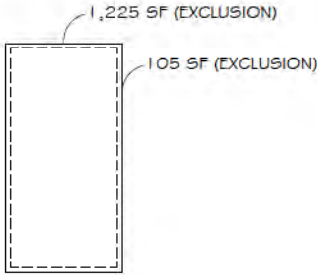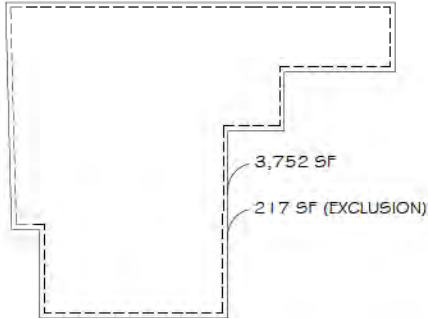


MECHANICAL LEVEL AREA CALCULATION:

TOTAL GROSS FLOOR AREA = 4,977 SF
TOTAL EXCLUDED AREA = 322 SF
TOTAL FSR = 4,655 SF

REVISIONS

NO.	DESCRIPTION	DATE
1	ISSUED FOR REZONING & DP	18 SEP 2017
2	RE-ISSUED FOR REZONING & DP	20 FEB 2018
3	RE-ISSUED FOR ADP	02 APR 2018
4	RE-ISSUED FOR REZONING & DP	18 JAN 2019
5	RE-ISSUED FOR ADP	24 APR 2019
6	RE-ISSUED FOR REZONING & DP	28 MAY 2019
7	RE-ISSUED FOR REZONING & DP	28 AUG 2020
8	RE-ISSUED FOR REZONING & DP	08 MAY 2021
9	RE-ISSUED FOR REZONING & DP	24 NOV 2021

Copyright Reserved
This plan and design are used at all times, remain the exclusive property of the architect and shall not be used in any other way without written consent. Architect's drawings and design documents are for the use of the client and are not to be used for any other purpose without the written consent of the architect. 

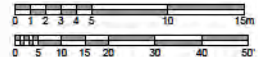

parc
retirement
living


17420

PARC VICTORIA
Mixed Use Seniors Residential &
Commercial Development

MECHANICAL LEVEL
AREA OVERLAY

002

SCALE
1:200

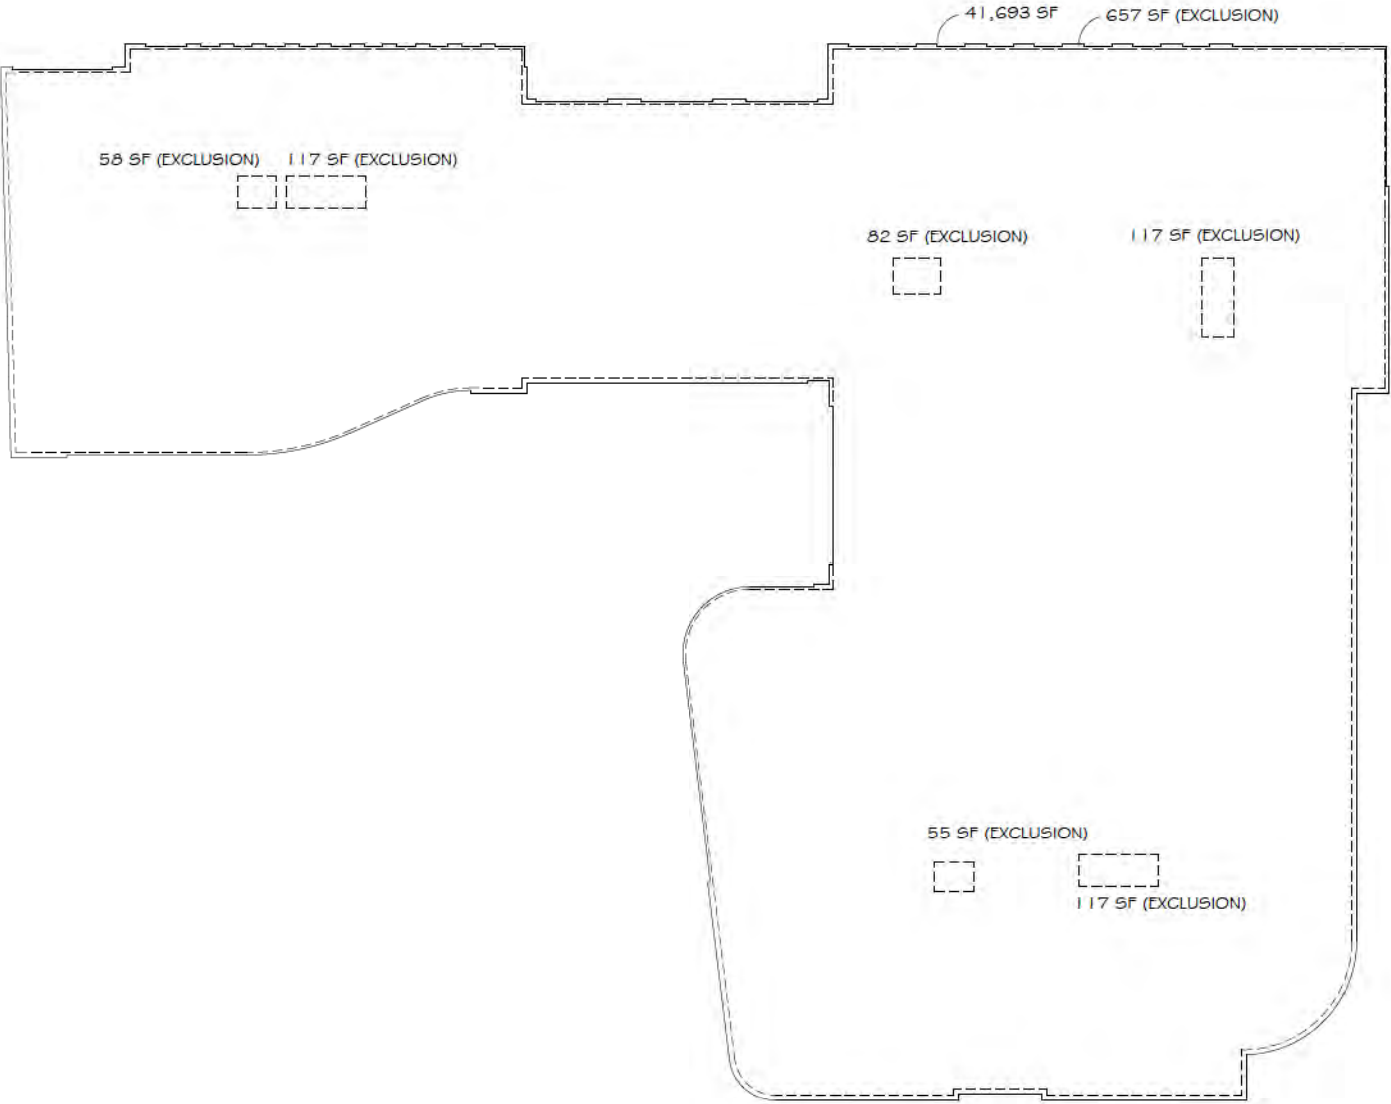


LEVEL 2 AREA CALCULATION:

TOTAL GROSS FLOOR AREA = 41,693 SF
TOTAL EXCLUDED AREA = 1,203 SF
TOTAL FSR = 40,490 SF

REVISIONS		
NO.	DESCRIPTION	DATE
1	ISSUED FOR REZONING & DP	18 SEP 2017
2	RE-ISSUED FOR REZONING & DP	30 FEB 2018
3	RE-ISSUED FOR ADP	02 APR 2018
4	RE-ISSUED FOR REZONING & DP	18 JAN 2019
5	RE-ISSUED FOR ADP	24 APR 2019
6	RE-ISSUED FOR REZONING & DP	28 MAY 2019
7	RE-ISSUED FOR REZONING & DP	28 MAY 2020
8	RE-ISSUED FOR REZONING & DP	08 MAY 2021
9	RE-ISSUED FOR REZONING & DP	24 NOV 2021

Copyright Reserved


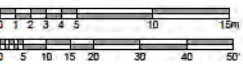

parc
retirement
living


17420

PARC VICTORIA
Mixed Use Seniors Residential &
Commercial Development

LEVEL 2
AREA OVERLAY

003

1:200

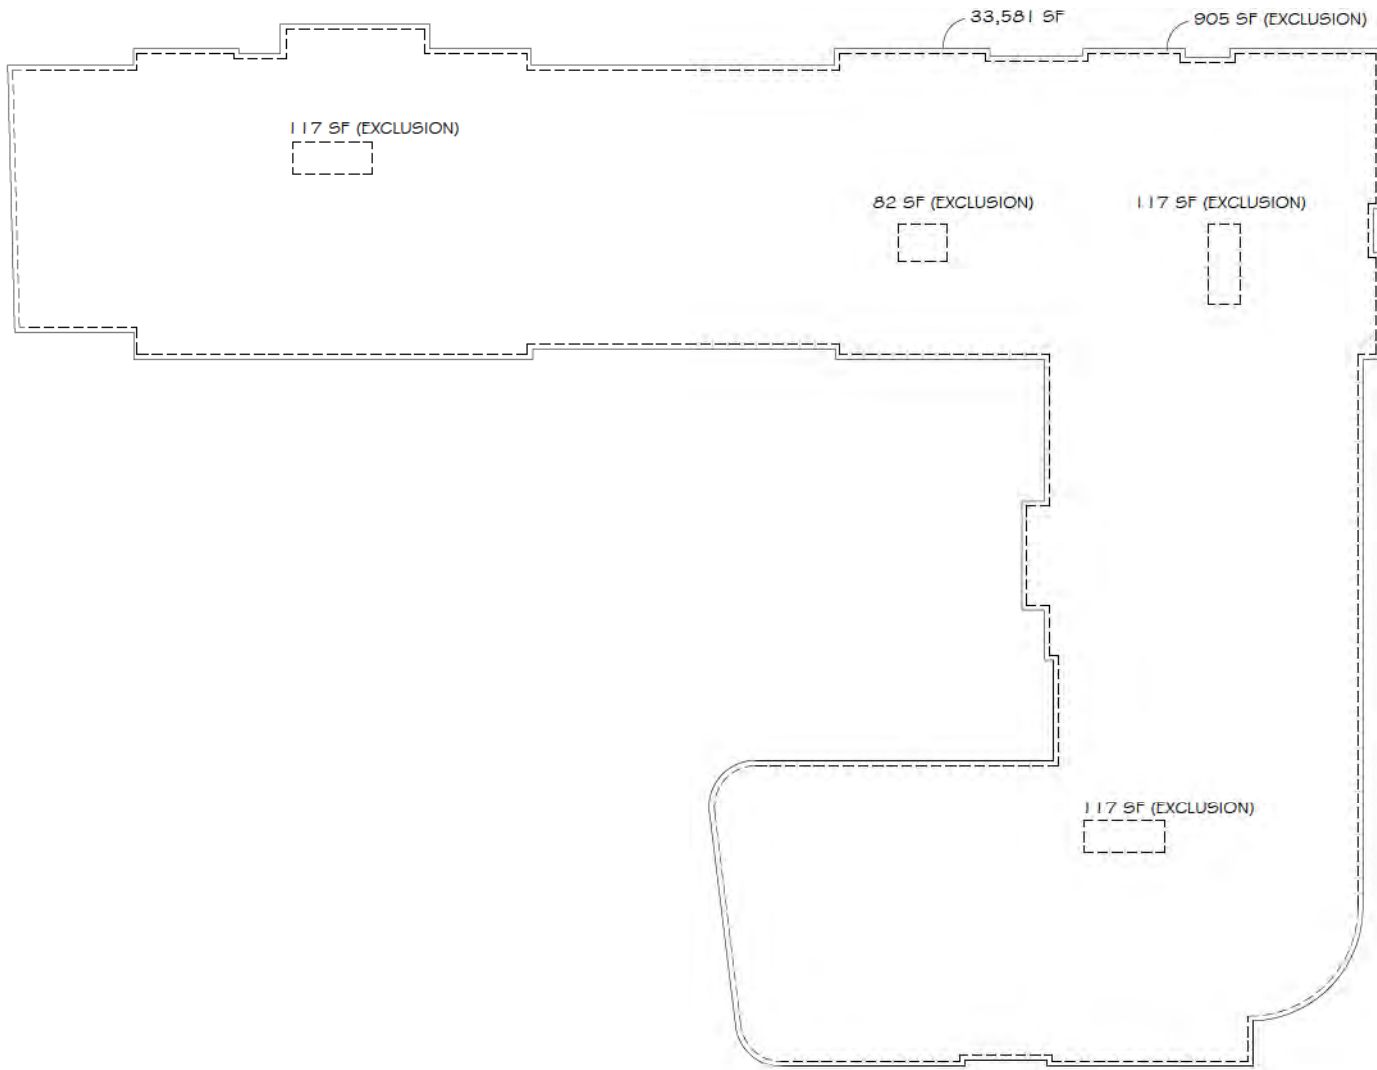


LEVEL 3 AREA CALCULATION:

TOTAL GROSS FLOOR AREA = 33,581 SF
TOTAL EXCLUDED AREA = 338 SF
TOTAL FSR = 32,243 SF

REVISIONS

NO.	DESCRIPTION	DATE
1	ISSUED FOR REZONING & DP	18 SEP 2017
2	RE-ISSUED FOR REZONING & DP	20 FEB 2018
3	RE-ISSUED FOR ADP	02 APR 2018
4	RE-ISSUED FOR REZONING & DP	18 JAN 2019
5	RE-ISSUED FOR ADP	24 APR 2019
6	RE-ISSUED FOR REZONING & DP	29 MAY 2019
7	RE-ISSUED FOR REZONING & DP	28 AUG 2020
8	RE-ISSUED FOR REZONING & DP	08 MAY 2021
9	RE-ISSUED FOR REZONING & DP	24 NOV 2021



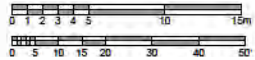


parc
retirement
living

17420

PARC VICTORIA
Mixed Use Seniors Residential &
Commercial Development

LEVEL 3
AREA OVERLAY

004

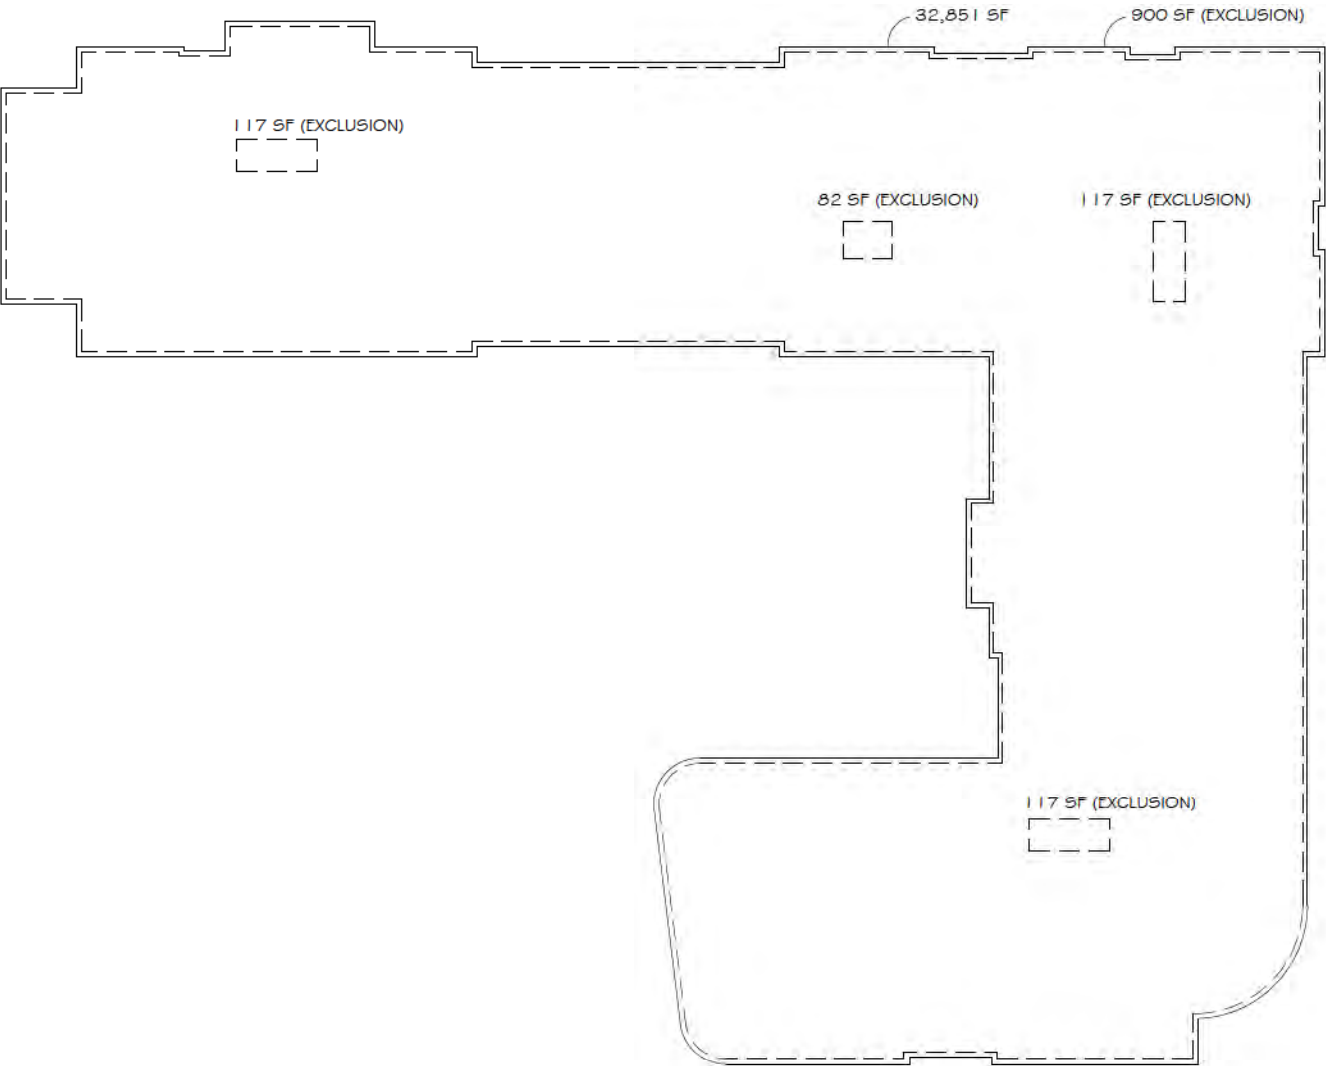


LEVEL 4 AREA CALCULATION:

TOTAL GROSS FLOOR AREA = 32,851 SF
TOTAL EXCLUDED AREA = 1,333 SF
TOTAL FSR = 31,518 SF

REVISIONS

REV.	DESCRIPTION	DATE
1	ISSUED FOR REZONING & DP	19 SEP 2017
2	RE-ISSUED FOR REZONING & DP	20 FEB 2018
3	RE-ISSUED FOR ADP	02 APR 2018
4	RE-ISSUED FOR REZONING & DP	16 JAN 2019
5	RE-ISSUED FOR ADP	24 APR 2019
6	RE-ISSUED FOR REZONING & DP	28 MAY 2019
7	RE-ISSUED FOR REZONING & DP	26 AUG 2020
8	RE-ISSUED FOR REZONING & DP	05 MAY 2021
9	RE-ISSUED FOR REZONING & DP	24 NOV 2021

NOT TO SCALE


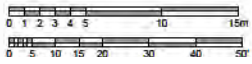

parc
retirement
living

17420


PARC VICTORIA
Mixed Use Seniors Residential &
Commercial Development

LEVEL 4
AREA OVERLAY

005

DWG: 005

SCALE: 1:200

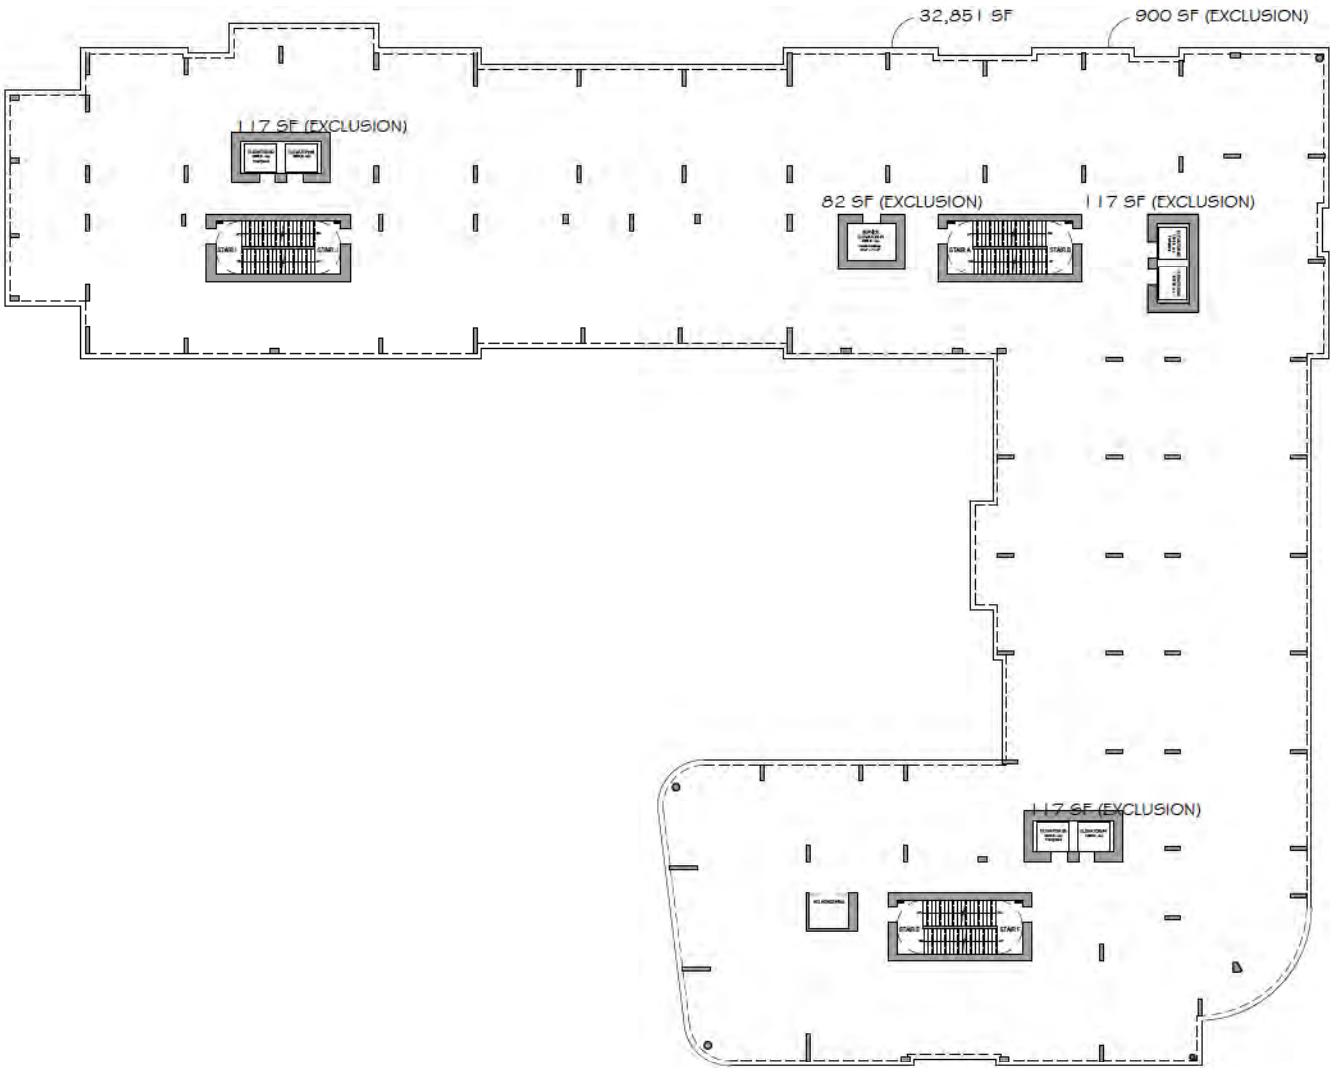


LEVEL 5 AREA CALCULATION:

TOTAL GROSS FLOOR AREA = 32,851 SF
TOTAL EXCLUDED AREA = 1,333 SF
TOTAL FSR = 31,518 SF

REV.	DESCRIPTION	DATE
1	ISSUED FOR REZONING & DP	18 SEP 2017
2	RE-REVISED FOR REZONING & DP	20 FEB 2018
3	RE-REVISED FOR ADP	02 APR 2018
4	RE-REVISED FOR REZONING & DP	18 JAN 2019
5	RE-REVISED FOR ADP	24 APR 2019
6	RE-REVISED FOR REZONING & DP	26 MAY 2019
7	RE-REVISED FOR REZONING & DP	26 AUG 2020
8	RE-REVISED FOR REZONING & DP	05 MAY 2021
9	RE-REVISED FOR REZONING & DP	24 NOV 2021

NOTES:


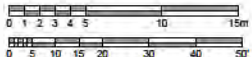

parc
retirement
living


17420

PARC VICTORIA
Mixed Use Seniors Residential &
Commercial Development

LEVEL 5
AREA OVERLAY

006

DATE: 24 NOV 2021
SCALE: 1:200
DRAWN BY: [Signature]

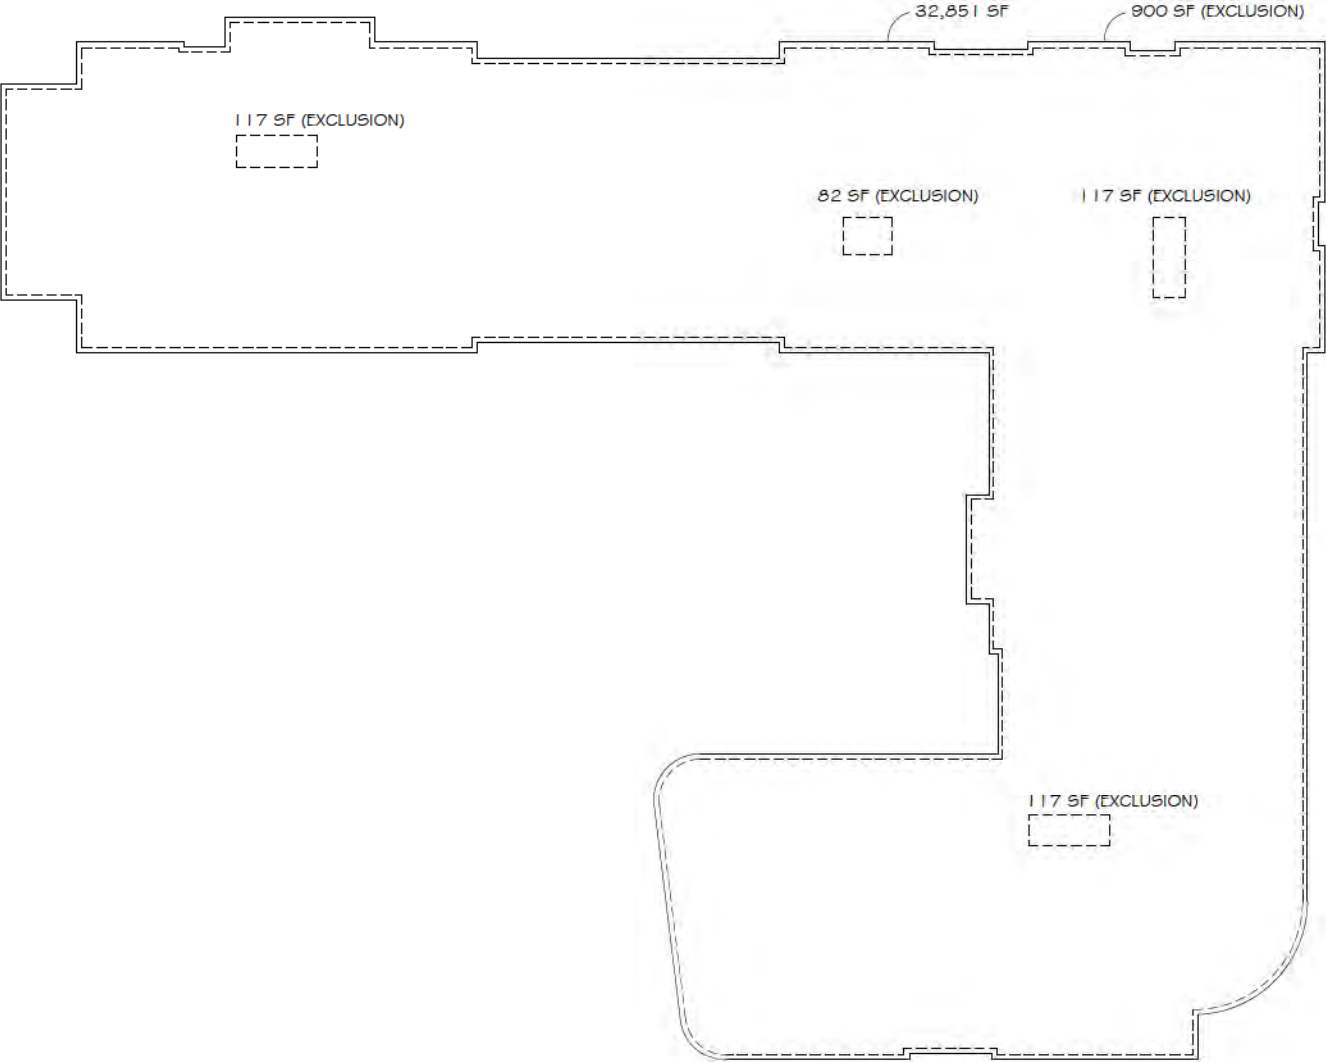


LEVEL 6 AREA CALCULATION:

TOTAL GROSS FLOOR AREA = 32,851 SF
TOTAL EXCLUDED AREA = 1,333 SF
TOTAL FSR = 31,518 SF

REV.	DESCRIPTION	DATE

NOT TO SCALE


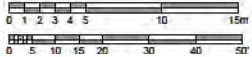

parc
retirement
living


17420

PARC VICTORIA
Mixed Use Seniors Residential &
Commercial Development

LEVEL 6
AREA OVERLAY

007

DATE: 24 NOV 2021
SCALE: 1:200
DESIGNER: BFA

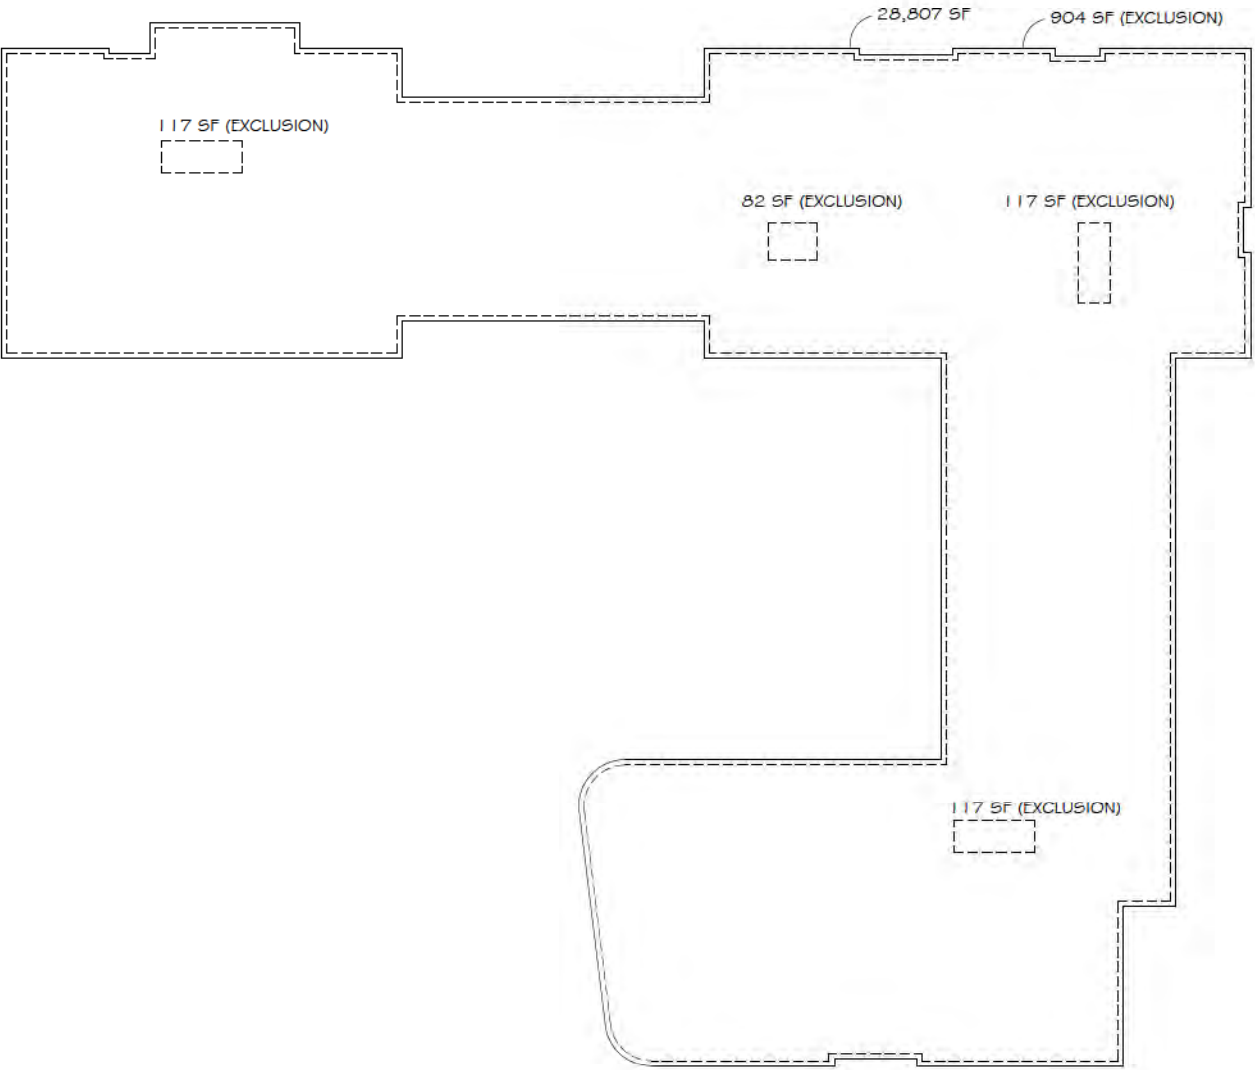


LEVEL 7 AREA CALCULATION:

TOTAL GROSS FLOOR AREA = 28,807 SF
TOTAL EXCLUDED AREA = 1,337 SF
TOTAL FSR = 27,470 SF

REVISIONS		
NO.	DESCRIPTION	DATE
1	ISSUED FOR REZONING & DP	18 SEP 2017
2	RE-ISSUED FOR REZONING & DP	20 FEB 2018
3	RE-ISSUED FOR ADP	02 APR 2018
4	RE-ISSUED FOR REZONING & DP	18 JAN 2019
5	RE-ISSUED FOR ADP	24 APR 2019
6	RE-ISSUED FOR REZONING & DP	26 MAY 2019
7	RE-ISSUED FOR REZONING & DP	26 AUG 2020
8	RE-ISSUED FOR REZONING & DP	05 MAY 2021
9	RE-ISSUED FOR REZONING & DP	24 NOV 2021

Copyright Reserved
This plan and design are the property of the architect and shall not be used in any way without the written consent of the architect. The architect shall not be responsible for any errors or omissions in the plan and design. 

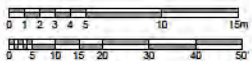

parc
retirement
living


17420

PARC VICTORIA
Mixed Use Seniors Residential &
Commercial Development

LEVEL 7
AREA OVERLAY

008

1:200

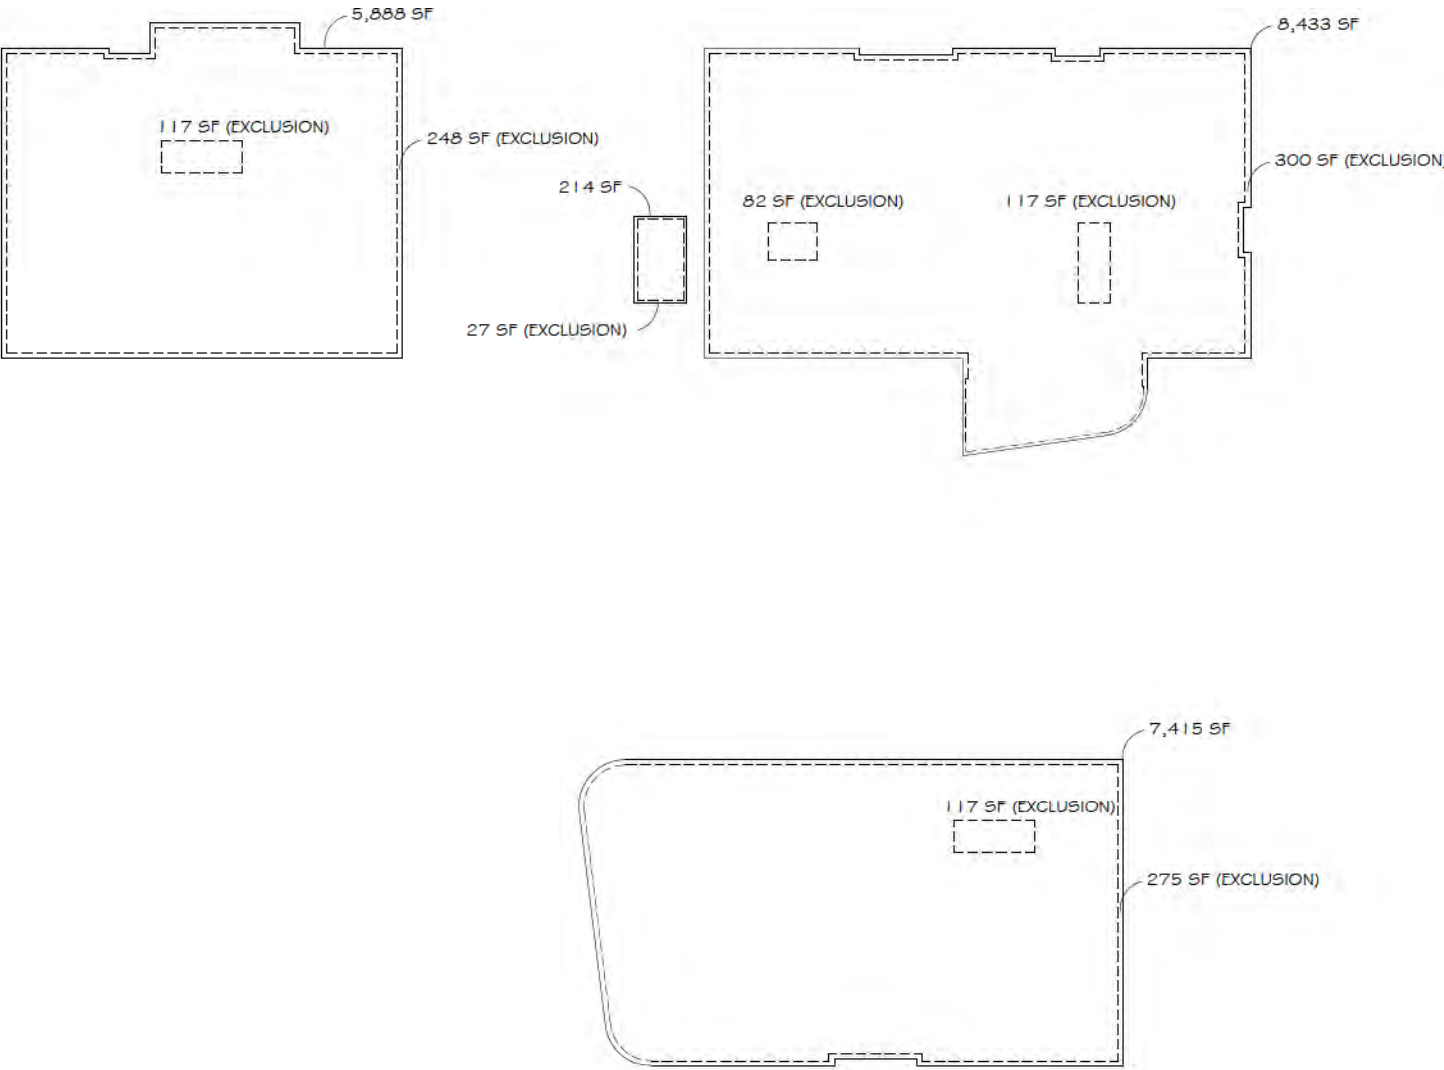


LEVEL 8 AREA CALCULATION:

TOTAL GROSS FLOOR AREA = 21,950 SF
TOTAL EXCLUDED AREA = 1,283 SF
TOTAL FSR = 20,667 SF

REVISIONS

NO.	DESCRIPTION	DATE
1	ISSUED FOR REZONING & DP	18 SEP 2017
2	RE-ISSUED FOR REZONING & DP	20 FEB 2018
3	RE-ISSUED FOR ADP	02 APR 2018
4	RE-ISSUED FOR REZONING & DP	18 JAN 2019
5	RE-ISSUED FOR ADP	24 APR 2019
6	RE-ISSUED FOR REZONING & DP	26 MAY 2019
7	RE-ISSUED FOR REZONING & DP	26 AUG 2020
8	RE-ISSUED FOR REZONING & DP	05 MAY 2021
9	RE-ISSUED FOR REZONING & DP	24 NOV 2021

Copyright Reserved


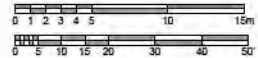

parc
retirement
living


17420

PARC VICTORIA
Mixed Use Seniors Residential &
Commercial Development

LEVEL 8
AREA OVERLAY

009

1:200

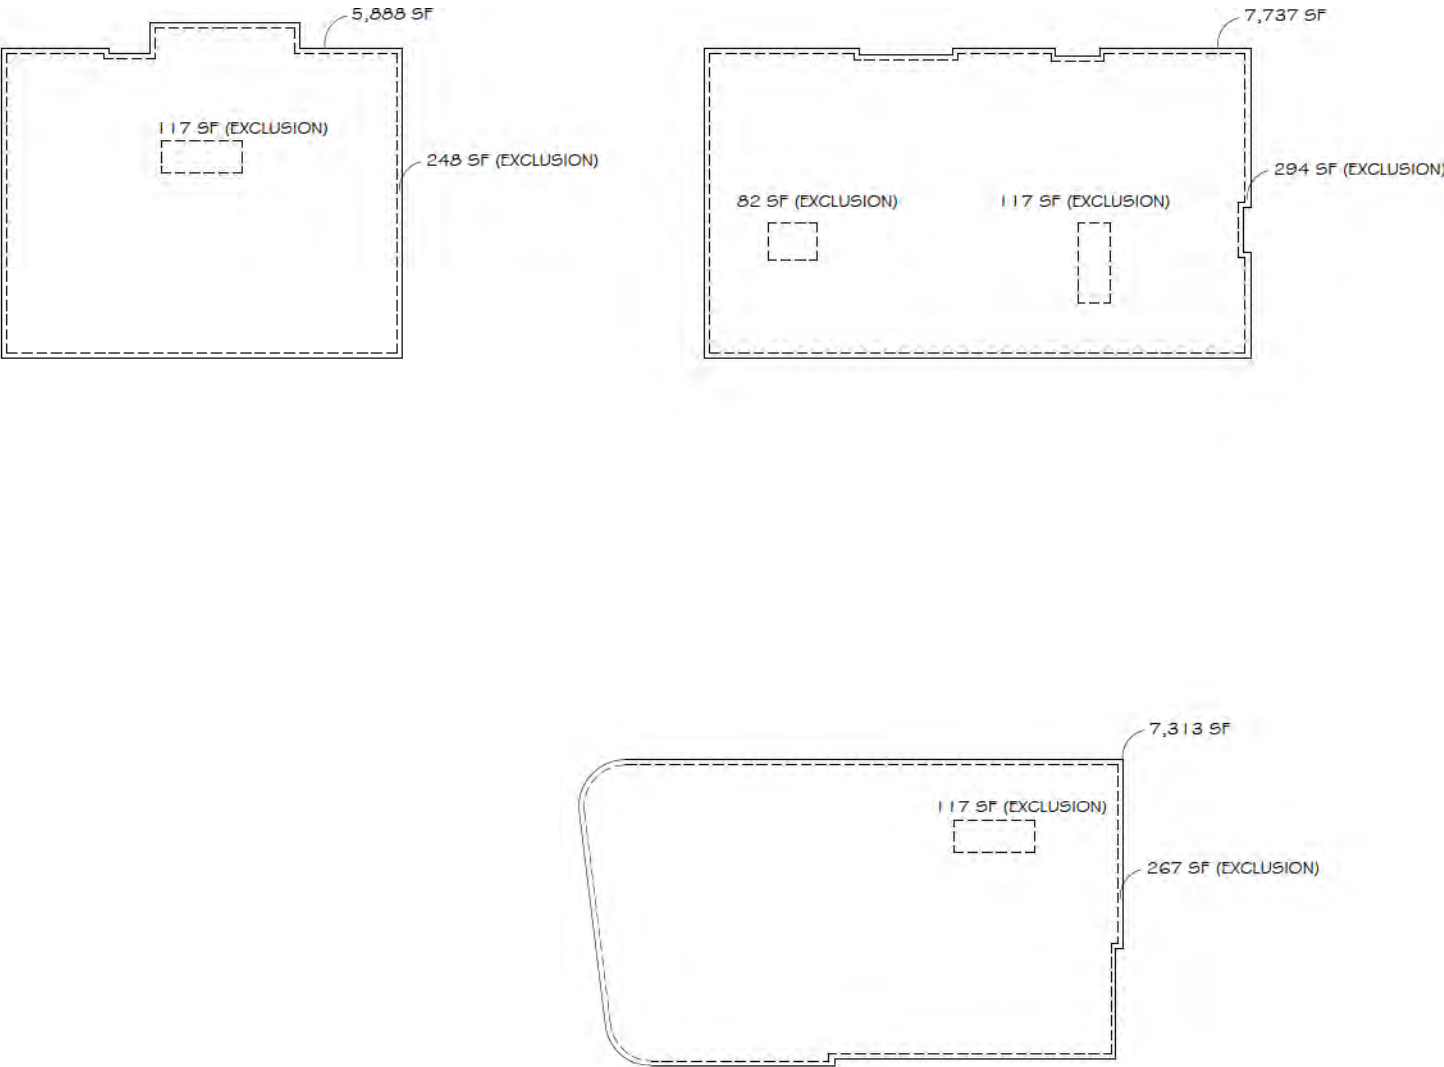


LEVEL 9 AREA CALCULATION:

TOTAL GROSS FLOOR AREA = 20,938 SF
TOTAL EXCLUDED AREA = 1,242 SF
TOTAL FSR = 19,696 SF

REVISIONS		
NO.	DESCRIPTION	DATE
1	ISSUED FOR REZONING & DP	18 SEP 2017
2	RE-ISSUED FOR REZONING & DP	20 FEB 2018
3	RE-ISSUED FOR ADP	02 APR 2018
4	RE-ISSUED FOR REZONING & DP	18 JAN 2019
5	RE-ISSUED FOR ADP	24 APR 2019
6	RE-ISSUED FOR REZONING & DP	26 MAY 2019
7	RE-ISSUED FOR REZONING & DP	26 AUG 2020
8	RE-ISSUED FOR REZONING & DP	05 MAY 2021
9	RE-ISSUED FOR REZONING & DP	24 NOV 2021

COPYRIGHT RESERVES


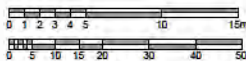

parc retirement living


17420

PARC VICTORIA
Mixed Use Seniors Residential & Commercial Development

LEVEL 9
AREA OVERLAY

O10

1:200

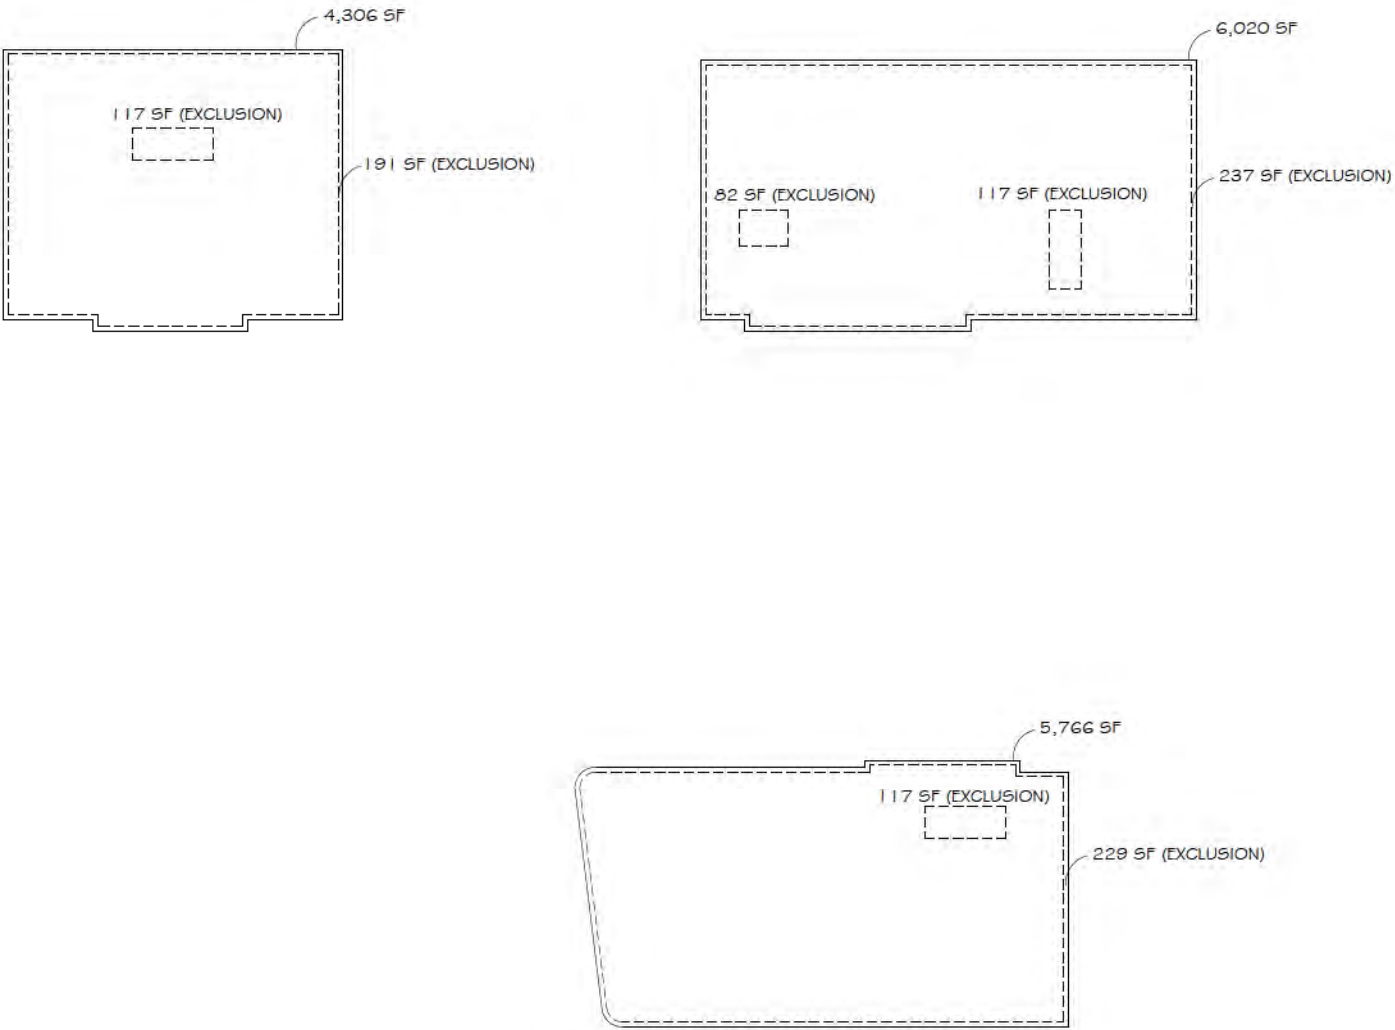


LEVEL 10 AREA CALCULATION:

TOTAL GROSS FLOOR AREA	=	16,092 SF
TOTAL EXCLUDED AREA	=	1,090 SF
TOTAL FSR	=	15,002 SF

REVISIONS		
NO.	DESCRIPTION	DATE
1	ISSUED FOR REZONING & DP	18 SEP 2017
2	RE-ISSUED FOR REZONING & DP	20 FEB 2018
3	RE-ISSUED FOR ADP	02 APR 2018
4	RE-ISSUED FOR REZONING & DP	18 JAN 2019
5	RE-ISSUED FOR ADP	24 APR 2019
6	RE-ISSUED FOR REZONING & DP	29 MAY 2019
7	RE-ISSUED FOR REZONING & DP	26 AUG 2020
8	RE-ISSUED FOR REZONING & DP	08 MAY 2021
9	RE-ISSUED FOR REZONING & DP	24 NOV 2021

Copyright Reserved


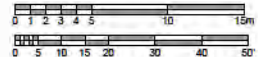

parc retirement living


17420

PARC VICTORIA
Mixed Use Seniors Residential & Commercial Development

LEVEL 10
AREA OVERLAY

O11

1:200

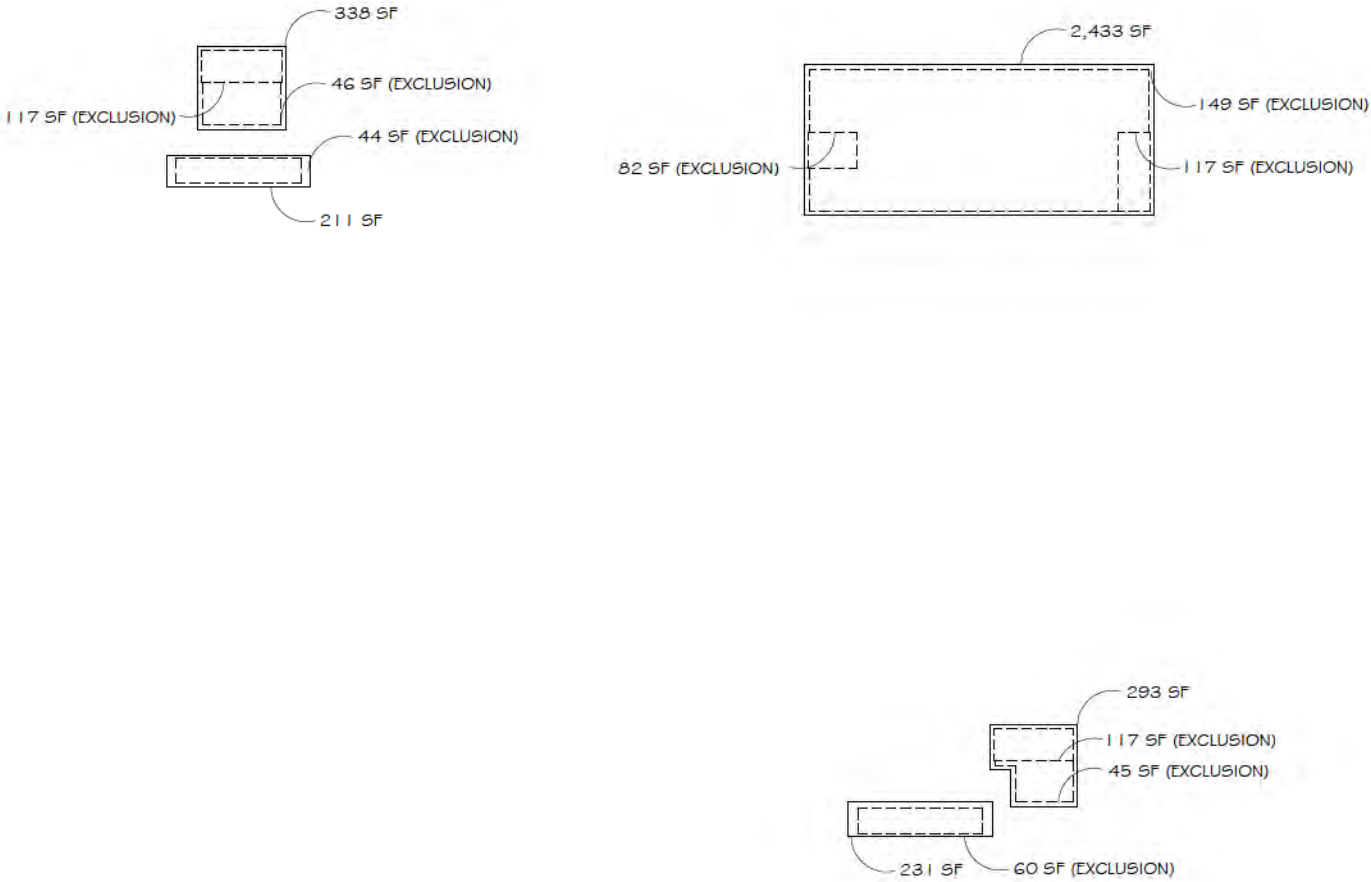


ROOF AREA CALCULATION:

TOTAL GROSS FLOOR AREA	=	3,506 SF
TOTAL EXCLUDED AREA	=	777 SF
TOTAL FSR	=	2,729 SF

REVISIONS		
NO.	DESCRIPTION	DATE
1	ISSUED FOR REZONING & DP	18 SEP 2017
2	RE-REVISED FOR REZONING & DP	20 FEB 2018
3	RE-REVISED FOR ADP	02 APR 2018
4	RE-REVISED FOR REZONING & DP	18 JAN 2019
5	RE-REVISED FOR ADP	24 APR 2019
6	RE-REVISED FOR REZONING & DP	28 MAY 2019
7	RE-REVISED FOR REZONING & DP	28 AUG 2020
8	RE-REVISED FOR REZONING & DP	05 MAY 2021
9	RE-REVISED FOR REZONING & DP	24 NOV 2021



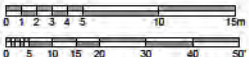


parc retirement living

PROJECT NO. 17420
PROJECT PARC VICTORIA
Mixed Use Seniors Residential & Commercial Development


ROOF AREA OVERLAY

012

SCALE 1:200

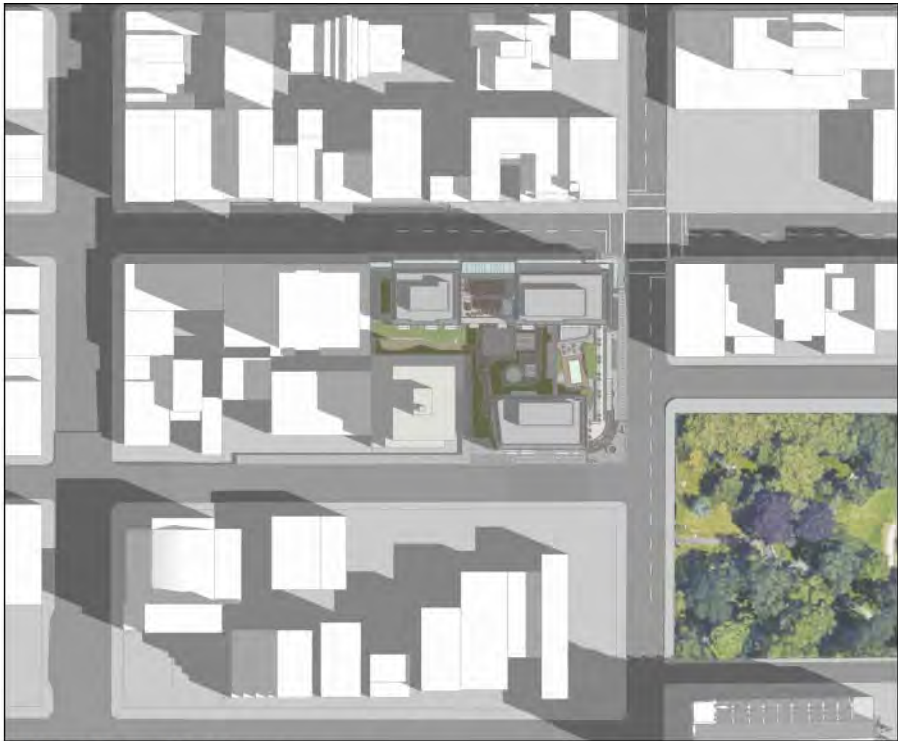


MARCH 21 (10:00 am)

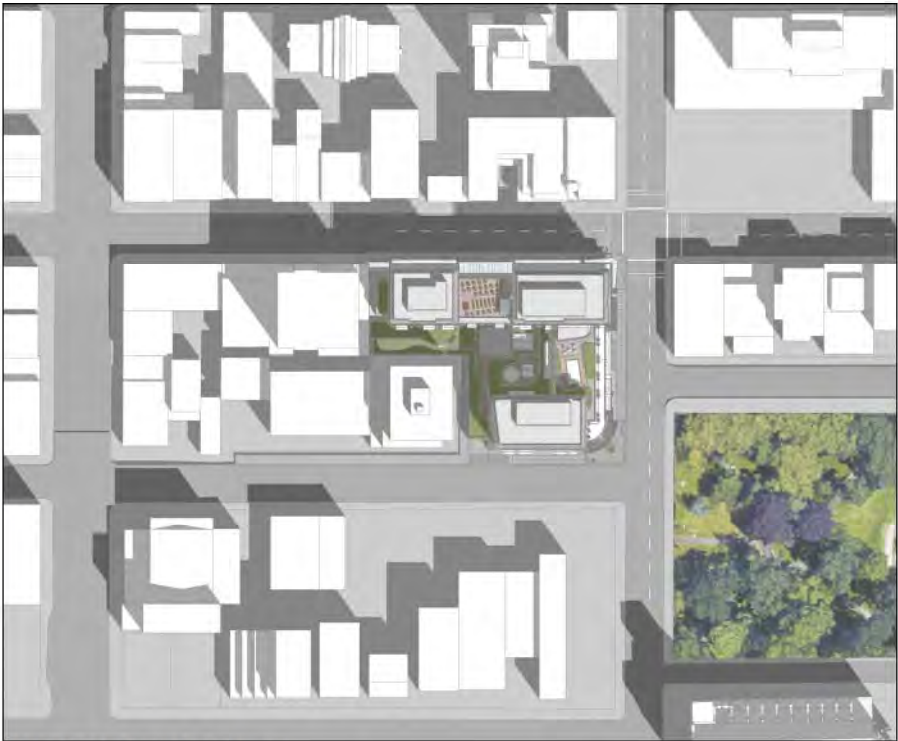

MARCH 21 (12:00 pm)



MARCH 21 (02:00 pm)

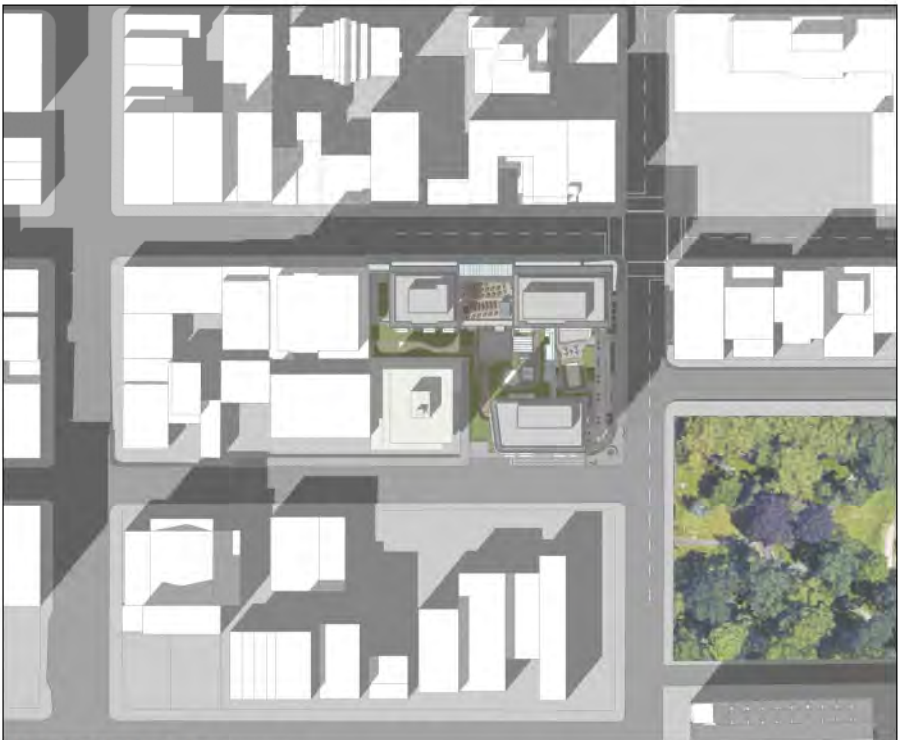

MARCH 21 (04:00 pm)

bfa studio
architects

ECO-REGIONAL ARCHITECTURE + INTERIOR DESIGN

(Formerly BEH-BAAT PHARR ARCHITECTS)
335 - 135 Stuart Street T 504 542 7544
Vancouver, BC V6C 2B8 F 504 542 4880
www.bfaarchitects.com

REVISIONS

NO.	DESCRIPTION	DATE
1	ISSUED FOR REZONING & DP	18 SEP 2017
2	RE-ISSUED FOR REZONING & DP	20 FEB 2018
3	RE-ISSUED FOR ADP	02 APR 2018
4	RE-ISSUED FOR ADP	24 APR 2018





parc
retirement
living


17420

PROJECT
PARC VICTORIA
Mixed Use Seniors Residential &
Commercial Development

SHADOW ANALYSIS

SH01

NTS

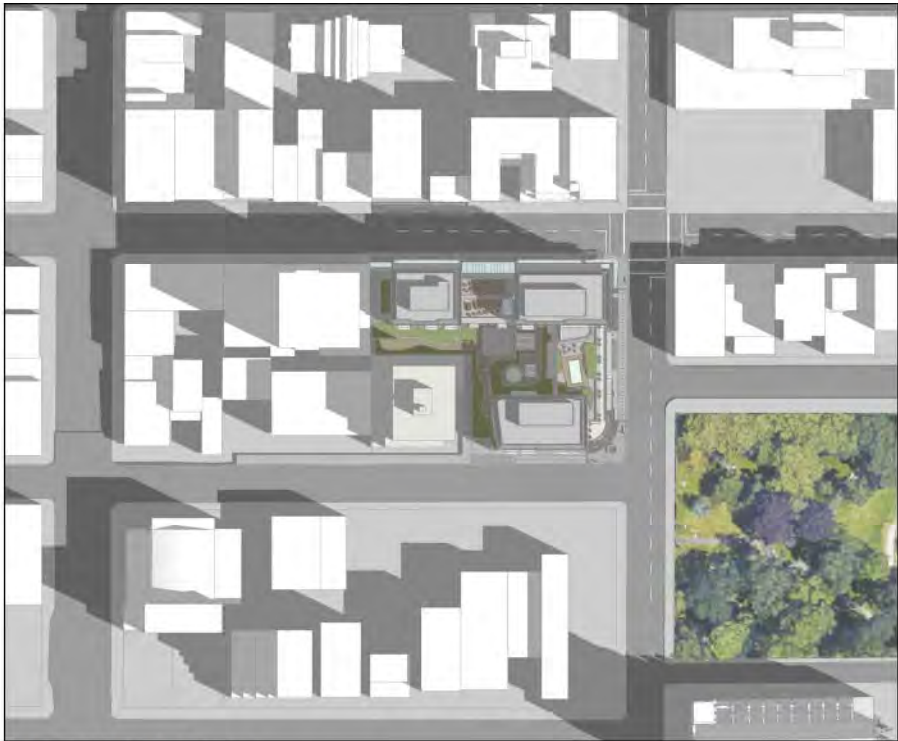

SEPT 21 (10:00 am)



SEPT 21 (12:00 pm)



SEPT 21 (02:00 pm)



SEPT 21 (04:00 pm)

bfa studio
architects

ECO-REGIONAL ARCHITECTURE + INTERIOR DESIGN

(Formerly BESHABAT FRANKS ARCHITECTS)

500 - 3755 Blenheim Street T 604 682 3544

Vancouver, BC V6C 2B8 F 604 682 4060

www.bfaarchitects.com

REVISIONS

NO.	DESCRIPTION	DATE
1	ISSUED FOR REVISION & OP	18 SEP 2017
2	RE-ISSUED FOR REVISION & OP	20 FEB 2018
3	RE-ISSUED FOR ADP	02 APR 2018
4	RE-ISSUED FOR ADP	24 APR 2018





parc
retirement
living

PROJECT NO. 17420

PROJECT: PARC VICTORIA
Mixed Use Seniors Residential &
Commercial Development

DRAWING TITLE: SHADOW ANALYSIS

DRAWING NO. SH02

DATE: 09/21/2018

SCALE: NTS