ARCHITECTURAL DRAWING LIST

No.	Sheet Name
A0.00	COVER PAGE
A0.01	PROJECT GENERAL STATISTICS
A0.02	BUILDING STATISTICS
A0.03	PARKING STATISTICS
A0.04	CONTEXT PLAN
A0.05	CONTEXT PHOTOS
A0.06	STREET SCAPE ELEVATION
A0.07	SETBACK DIAGRAM
A0.08	SITE COVERAGE DIAGRAM
A0.09	OPEN SITE SPACE DIAGRAM
A0.10	AVERAGE GRADE CALCULATION
A0.11	STREET SECTION
A0.12	SHADOW STUDY - VERNAL EQUINOX
A0.13	SHADOW STUDY - SUMMER SOLSTICE
A0.14	SHADOW STUDY - AUTOMNAL EQUINOX
A0.15	SHADOW STUDY - WINTER SOLSTICE
A0.16	SURVEY
A0.17	AERIAL VIEW
A0.18	PRESPECTIVE VIEW FROM YATES STREET
A0.19	PRESPECTIVE VIEW FROM COOK STREET
A0.20	PRESPECTIVE VIEW FROM VIEW STREET
A0.21	CPTED STRATEGY
A0.22	MATERIALS
A1.00	SITE PLAN
A1.01	OVERALL LEVEL P3 PLAN
A1.02	OVERALL LEVEL P2 PLAN
A1.03	OVERALL LEVEL P1 PLAN
A1.04	OVERALL LEVEL 1 PLAN
A1.05	OVERALL LEVEL MEZZANINE PLAN
A1.06	OVERALL LEVEL 2 PLAN
A1.07	OVERALL LEVEL 3 PLAN
A1.08	OVERALL LEVEL 04 PLAN
A1.09	OVERALL LEVEL 05 PLAN
A1.10	OVERALL LEVEL 06 PLAN
A1.11	OVERALL TYPICAL TOWER FLOOR PLAN
A1.12	OVERALL LEVEL 21 (TOWER B ROOF)
A1.13	OVERALL LEVEL 22 (ROOF TWR (A) & TWR (B) MECH. ROOF)
A1.14	OVERALL LEVEL 23 (TWR (A) MECH. ROOF & TWR (B) UPPER ROOF)
A1.15	OVERALL LEVEL 24 (TWR (A) UPPER ROOF)
A2.01	COLOR NORTH ELEVATION
A2.02	COLOR EAST ELEVATION
A2.03	COLOR SOUTH ELEVATION
A2.04	COLOR WEST ELEVATION
A2.05	NORTH ELEVATIONS
A2.06	EAST ELEVATION
A2.07	SOUTH ELEVATIONS
A2.08	WEST ELEVATION
A2.09	COURTYARD KEY PLAN
A2.10	COURTYARD ELEVATION
A2.11	COURTYARD ELEVATION
A2.12	COURTYARD ELEVATION
A3.01	SECTION A Tower A & Podium
A3.02	SECTION B Tower B & Podium
A3.03	SECTION C Tower A & Podium
A3.04	SECTION D Tower B & Podium
A7.00	FSR CALCULATION SUMMARY
A7.01	FSR OVERLAY- Level 01
A7.02	FSR OVERLAY- Level 01- Mezz
A7.03	FSR OVERLAY- Level 02
A7.04	FSR OVERLAY- Level 03
A7.05	FSR OVERLAY- Level 04
A7.06	FSR OVERLAY- Level 05
A7.07	FSR OVERLAY- Level 06
A7.08	FSR OVERLAY- Typical Levels
A7.09	FSR OVERLAY- LEVEL 21 (Tower B Roof)
A7.10	FSR OVERLAY- LEVEL 22 - ROOF TWR (A) - TWR (B) MECH. ROOF
A7.11	FSR OVERLAY- LEVEL 23 - TWR (A) MECH. ROOF - TRW (B) UPPER ROOF

CITY OF VICTORIA
Revisions
Received Date: March 10, 2021

REGISTERED ARCHITECT JOHN GWYN MCCOY BRITISH COLUMBIA

IBI

IBI GROUP
ARCHITECTS (CANADA) INC.
700-1285 West Pender Street,
Vancouver, BC V6E 4B1, Canada
tel 604 683 8797 fax 604 683 0492
ibigroup.com

Starlight™ Developments

Harris Green Village - Phase 01

1045 Yates Street

Victoria, BC

DP & Rezoning Submission

2021/ 03 / 05

bubbled set

Harris Green Village - Phase 1

Site & Project Description

Project Description:
2 Towers on Residential/Amenity/Commercial Podium

Civic Address: Lot A (DD 60683W) Of Lots 979 And 989. Plan 20163. And
Lot 1 Of Lots 986 And 987. Plan 26779. And
Lots 976. 977. 978. 980. 988. Victoria City.

City Plan: Downtown Core Area Plan

Residential floor

Current Use: Automobile Dealership and Surface Parking

Adjacent Zoning: R3-C

Rezoned to: CD

Overall Area remains same but some re-shuffling of locations

SITE AREA CALCULATIONS

	Gross Site Area	
	Metric ($m^{2)}$	Imperial (sq.ft.)
1045 Yate Street	6,337.0	68,210.9
Dedications	-	-
Net Site Area (Gross Minus Dedications)	6,337.0	68,210.9
Site Area for calculation of Density (Gross)	6,337.0	**68,210.9**

SITE COVERAGE CALCULATIONS

	Metric (m2)	Imperial (sq.ft.)
Gross Site Area	6,337	68,210.9
Building Footprint (podium)	5,304	57,092.1
Site Coverage %		**84%**

OPEN SITE SPACE CALCULATIONS

	Metric (m2)	Imperial (sq.ft.)
Gross Site Area	6,337	68,210.9
Open Site Space Area	761	8,186.0
Open Site Space %		**12%**

height revised
1. Tower B added one floor
2. Tower A added roof terrace and elevator stop

HEIGHT OF BUILDING (MEASURED FROM AVERAGE GRADE)

Height Provided	Tower A (North)		Tower B (South)	
	metric (m)	imperial (ft)	metric (m)	imperial (ft)
NUMBER OF FLOORS		**21**		**20**
TOP OF LAST OCCUPIED FLOOR				214.63
TOP OF APPURTENANCE				235.10
TOP OF Podium Height				71.69
Average Grade				66.27

UNIT COUNT

Type	Rental							
	Bachelor	1 BR	1 BR+D	2 BR	2 BR+D	3 BR	TH (3BR)	TOTAL
	(340-400 sf)	(450-650 sf)		(700-800 sf)	(850-900 sf.)	(950-1050 sf)	(1100-1400 sf.)	
Tower A	-	96	-	32	31	-	-	159
Tower B	-	90	-	30	30	-	-	150
Podium	43	37	80	20	3	12	6	201
Total	**43**	**223**	**80**	**82**	**64**	**12**	**6**	**510**
By Type	**43**		**303**		**146**	**12**	**6**	**510**
Distribution	8.4%	59.4%		16.1%	12.5%	2.4%	1.2%	100%
Family Unts							164	
							32%	

Same overall number of units but changed mix. Decreased Bachelor (studio); in crease in 2bd units

PROPOSED FLOOR AREA (FSR)

	Provided FSR	Gross Floor Area		Exclusions (see A0.02)		Total Floor Area	
		Metric (m^2)	Imperial (sq.ft.)	Metric (m^2)	Imperial (sq.ft.)	Metric (m^2)	Imperial (sq.ft.)
Tower A	1.55	**10,637.3**	114,499.1	**785.4**	8,454.0	**9,851.9**	106,045.1
Tower B	1.45	**9,955.9**	107,164.8	**741.0**	7,975.6	**9,215.0**	99,189.2
Podium	2.99	**21,014.9**	226,202.0	**2,059.7**	22,170.9	**18,955.1**	204,031.1
Total	**6.00**	**41,608.1**	447,865.9	**3,586.1**	38,600.5	**38,022.0**	409,265.4

FLOOR AREA BREAKDOWN

Residential		Residential Amenity		Commercial		Daycare		Total	
Metric (m^2)	Imperial (sq.ft.)	Metric (m^2)	Imperial (sq.ft.)	Metric (m^2)	Imperial (sq.ft.)	Metric (m^2)	Imperial (sq.ft.)	Metric (m^2)	Imperial (sq.ft.)
33,835.9	364,206.4	664.3	7,150.6	3,029.7	32,611.3	492.1	5,297.1	38,022.0	409,265.4

BUILDING SETBACKS

Property Line	Required (m)			Proposed (m)		
	Street Level	Residential Podium	Tower	Street Level	Residential Podium	Tower
Front yard (Yates Street)	3.0	2.0	6.0	3.0	4.5	9.0
Rear yard (View Street)	4.0	3.0	6.0	4.0	5.5	9.0
East Side yard (Cook Street)	3.0	2.0	6.0	3.0	4.5	6.0
West Side Yard (North)	3.0	3.0	16.8	3.0	3.0	16.8
West Side Yard (South)	-	4.6	4.6	-	4.6	7.0

updated to match design guidelines

FLOOR PLATE SIZES

	Metric (m^2)	Imperial (sq.ft.)
Max. Permitted Floor Plate Size	650.3	7,000
Provided Floor Plate size	648.4	6,979

PROJECT INFORMATION TABLE

Zone (existing)	S-1
Proposed zone	CD
Proposed uses	Residential/Commercial/Childcare
Site area (m^2)	6337.0
Total floor area (m^2)	**38022**
Commercial floor area (m^2)	32,611.3 sm
Childcare floor area (m^2)	492.12
Residential floor area (m^2) (including amenities)	34500.19
Floor space ratio	**6.00**
Site coverage %	**84%**
Open site space %	**12%**
Height of buildings (m) From Avg. Grade to top of last floor	**71.21m & 65.42m**
Number of storeys	20 and 21
Parking stalls (number) on site	346
Commercial , Childcare and Visitor	79
Residential	268
Bicycle parking number (storage and rack)	658
Building Setbacks (m)	
Yates street	2.0
Cook street	2.0
View street	3.0
Side yard (west side south)	0.0
Side yard (west side north)	3.0
Residential Use Detail	
Total number of units	**510**
Bachelor	43
1 Bedroom	223
1 Bedroom+Den	80
2 Bedroom	82
2 Bedroom+Den	64
3 Bedroom	12
Ground-orientated Townhomes	6

area changed height changed parking revised

updated to match design Guidelines

mix changed

CLIENT
Starlight Developments
Starlight Developments
P.O. Box 1690 Station B Mississauga, Ontario, Canada L4Y 3W8

COPYRIGHT:
This drawing has been prepared solely for the intended use, thus any reproduction or distribution for any purpose other than authorized by IBI Group is forbidden. Written dimensions shall have precedence over scaled dimensions. Contractors shall verify and be responsible for all dimensions and conditions on the job, and IBI Group shall be informed of any variations from the dimensions and conditions shown on the drawing. Shop drawings shall be submitted to IBI Group for general conformance before proceeding with fabrication.
IBI Group Architects (Canada) Inc.
is a member of the IBI Group of companies

NO.	DATE	DESCRIPTION
1	YYYY-MM-DD	

ISSUES

NO.	DATE	DESCRIPTION

REVISIONS

Issued For: Project Status
Date: 2021-03-05

SEAL
REGISTERED ARCHITECT
COLIN GIN
PROVINCE OF BRITISH COLUMBIA
2021-03-06

SUB-CONSULTANT

PRIME CONSULTANT
IBI GROUP
ARCHITECTS (CANADA) INC.
700-1285 West Pender Street
Vancouver, BC V6E 4B1 Canada
tel 604 683 8797 fax 604 683 0492
ibigroup.com

PROJECT TITLE
Harris Green Village Phase 01
1045 Yates Street
Victoria, BC

PROJECT NO:	121123
DRAWN BY:	Author
CHK'D BY:	Checker
SCALE:	1 : 1
DATE:	2021-03-05

SHEET TITLE
PROJECT GENERAL STATISTICS

SHEET NUMBER
A0.01

REV

Last Saved: 2021-03-05 10:13:07 PM File Location: E:\M3_MDC\121123_Yates Street – Harris Green Village Ph 1 (R2020)\121123_YatesStA-Podium-2020.rvt

TOWER A (21-Storey)

Level (s)	Gross Floor Area		Exclusions								Total Floor Area	
			Exterior Wall		Elevator Shafts		Parking/Loading/Bike Parking		Sub Total			
	Metric (m^2)	Imperial (ft^2)	Metric (m^2)	Imperial (ft^2)	Metric (m^2)	Imperial (ft^2)	Metric (m^2)	Imperial (ft^2)	Metric (m^2)	Imperial (ft^2)	Metric (m^2)	Imperial (ft^2)
Mech	**73.0**	785	13.1	141	-	-	-	-	**13.1**	141	**59.9**	644
Residential flo	**174.3**	1,877	18.0	194	16.6	179	-	-	**34.6**	372	**139.8**	1,504
21	**648.4**	6,979	29.3	315	16.6	179	-	-	**45.9**	494	**602.5**	6,485
20	**648.4**	6,979	29.3	315	16.6	179	-	-	**45.9**	494	**602.5**	6,485
19	**648.4**	6,979	29.3	315	16.6	179	-	-	**45.9**	494	**602.5**	6,485
18	**648.4**	6,979	29.3	315	16.6	179	-	-	**45.9**	494	**602.5**	6,485
17	**648.4**	6,979	29.3	315	16.6	179	-	-	**45.9**	494	**602.5**	6,485
16	**648.4**	6,979	29.3	315	16.6	179	-	-	**45.9**	494	**602.5**	6,485
15	**648.4**	6,979	29.3	315	16.6	179	-	-	**45.9**	494	**602.5**	6,485
14	**648.4**	6,979	29.3	315	16.6	179	-	-	**45.9**	494	**602.5**	6,485
13	**648.4**	6,979	29.3	315	16.6	179	-	-	**45.9**	494	**602.5**	6,485
12	**648.4**	6,979	29.3	315	16.6	179	-	-	**45.9**	494	**602.5**	6,485
11	**648.4**	6,979	29.3	315	16.6	179	-	-	**45.9**	494	**602.5**	6,485
10	**648.4**	6,979	29.3	315	16.6	179	-	-	**45.9**	494	**602.5**	6,485
9	**648.4**	6,979	29.3	315	16.6	179	-	-	**45.9**	494	**602.5**	6,485
8	**648.4**	6,979	29.3	315	16.6	179	-	-	**45.9**	494	**602.5**	6,485
7	**648.4**	6,979	29.3	315	16.6	179	-	-	**45.9**	494	**602.5**	6,485
6	**664.3**	7,151	33.2	357	16.5	177	-	-	**49.7**	535	**614.6**	6,616
Total	**10,637.3**	114,499	**503.5**	5,420	**281.9**	3,034	**-**	-	**785.4**	8,454	**9,851.9**	106,045

Floor Area Breakdown							
Residential		Residential Amenity		Commercial		Daycare	
Metric (m^2)	Imperial (ft^2)	Metric (m^2)	Imperial (ft^2)	Metric (m^2)	Imperial (ft^2)	Metric (m^2)	Imperial (ft^2)
59.9	644	-	-	-	-	-	-
139.8	1,504	-	-	-	-	-	-
602.5	6,485	-	-	-	-	-	-
602.5	6,485	-	-	-	-	-	-
602.5	6,485	-	-	-	-	-	-
602.5	6,485	-	-	-	-	-	-
602.5	6,485	-	-	-	-	-	-
602.5	6,485	-	-	-	-	-	-
602.5	6,485	-	-	-	-	-	-
602.5	6,485	-	-	-	-	-	-
602.5	6,485	-	-	-	-	-	-
602.5	6,485	-	-	-	-	-	-
602.5	6,485	-	-	-	-	-	-
602.5	6,485	-	-	-	-	-	-
602.5	6,485	-	-	-	-	-	-
602.5	6,485	-	-	-	-	-	-
614.6	6,616	-	-	-	-	-	-
9,851.9	106,045	**-**	-	**-**	-	**-**	-

Rental									
Bachelor (<45 sm)	1 Br (<45 sm)	1 Br (45-70 sm)	1Br+D (45-70 sm)	2Br (<70 sm)	2Br (>70 sm)	2Br+D (>70 sm)	3Br (>70 sm)	TH	Total
-	-	-	-	-	-	-	-	-	-
-	-	-	-	-	-	-	-	-	-
-	6	-	-	2	-	2	-	-	10
-	6	-	-	2	-	2	-	-	10
-	6	-	-	2	-	2	-	-	10
-	6	-	-	2	-	2	-	-	10
-	6	-	-	2	-	2	-	-	10
-	6	-	-	2	-	2	-	-	10
-	6	-	-	2	-	2	-	-	10
-	6	-	-	2	-	2	-	-	10
-	6	-	-	2	-	2	-	-	10
-	6	-	-	2	-	2	-	-	10
-	6	-	-	2	-	2	-	-	10
-	6	-	-	2	-	2	-	-	10
-	6	-	-	2	-	2	-	-	10
-	6	-	-	2	-	2	-	-	10
1	6	-	-	2	-	1	-	-	10
1	**96**	**-**	**-**	**32**	**-**	**31**	**-**	**-**	**160**

TOWER B (20-Storey)

Level (s)	Gross Floor Area		Exclusions								Total Floor Area	
			Exterior Wall		Elevator Shafts		Parking/Loading/Bike Parking		Sub Total			
	Metric (m^2)	Imperial (ft^2)	Metric (m^2)	Imperial (ft^2)	Metric (m^2)	Imperial (ft^2)	Metric (m^2)	Imperial (ft^2)	Metric (m^2)	Imperial (ft^2)	Metric (m^2)	Imperial (ft^2)
Mech	**59.9**	644	13.1	141	-	-	-	-	**13.1**	141	**46.8**	504
Mech	**154.4**	1,662	19.4	209	16.6	179	-	-	**36.0**	388	**118.4**	1,275
20	**648.4**	6,979	29.3	315	16.6	179	-	-	**45.9**	494	**602.5**	6,485
19	**648.4**	6,979	29.3	315	16.6	179	-	-	**45.9**	494	**602.5**	6,485
18	**648.4**	6,979	29.3	315	16.6	179	-	-	**45.9**	494	**602.5**	6,485
17	**648.4**	6,979	29.3	315	16.6	179	-	-	**45.9**	494	**602.5**	6,485
16	**648.4**	6,979	29.3	315	16.6	179	-	-	**45.9**	494	**602.5**	6,485
15	**648.4**	6,979	29.3	315	16.6	179	-	-	**45.9**	494	**602.5**	6,485
14	**648.4**	6,979	29.3	315	16.6	179	-	-	**45.9**	494	**602.5**	6,485
13	**648.4**	6,979	29.3	315	16.6	179	-	-	**45.9**	494	**602.5**	6,485
12	**648.4**	6,979	29.3	315	16.6	179	-	-	**45.9**	494	**602.5**	6,485
11	**648.4**	6,979	29.3	315	16.6	179	-	-	**45.9**	494	**602.5**	6,485
10	**648.4**	6,979	29.3	315	16.6	179	-	-	**45.9**	494	**602.5**	6,485
9	**648.4**	6,979	29.3	315	16.6	179	-	-	**45.9**	494	**602.5**	6,485
8	**648.4**	6,979	29.3	315	16.6	179	-	-	**45.9**	494	**602.5**	6,485
7	**648.4**	6,979	29.3	315	16.6	179	-	-	**45.9**	494	**602.5**	6,485
6	**664.3**	7,151	33.2	357	16.5	177	-	-	**49.7**	535	**614.6**	6,616
Total	**9,955.9**	107,165	**475.6**	5,120	**265.3**	2,856	**-**	-	**741.0**	7,976	**9,215.0**	99,189

Floor Area Breakdown							
Residential		Residential Amenity		Commercial		Daycare	
Metric (m^2)	Imperial (ft^2)	Metric (m^2)	Imperial (ft^2)	Metric (m^2)	Imperial (ft^2)	Metric (m^2)	Imperial (ft^2)
46.8	504	-	-	-	-	-	-
118.4	1,275	-	-	-	-	-	-
602.5	6,485	-	-	-	-	-	-
602.5	6,485	-	-	-	-	-	-
602.5	6,485	-	-	-	-	-	-
602.5	6,485	-	-	-	-	-	-
602.5	6,485	-	-	-	-	-	-
602.5	6,485	-	-	-	-	-	-
602.5	6,485	-	-	-	-	-	-
602.5	6,485	-	-	-	-	-	-
602.5	6,485	-	-	-	-	-	-
602.5	6,485	-	-	-	-	-	-
602.5	6,485	-	-	-	-	-	-
602.5	6,485	-	-	-	-	-	-
602.5	6,485	-	-	-	-	-	-
602.5	6,485	-	-	-	-	-	-
614.6	6,616	-	-	-	-	-	-
9,215.0	99,189	**-**	-	**-**	-	**-**	-

Rental									
Bachelor (<45 sm)	1 Br (<45 sm)	1 Br (45-70 sm)	1Br+D (45-70 sm)	2Br (<70 sm)	2Br (>70 sm)	2Br+D (>70 sm)	3Br (>70 sm)	TH	Total
-	-	-	-	-	-	-	-	-	-
-	-	-	-	-	-	-	-	-	-
-	6	-	-	2	-	2	-	-	10
-	6	-	-	2	-	2	-	-	10
-	6	-	-	2	-	2	-	-	10
-	6	-	-	2	-	2	-	-	10
-	6	-	-	2	-	2	-	-	10
-	6	-	-	2	-	2	-	-	10
-	6	-	-	2	-	2	-	-	10
-	6	-	-	2	-	2	-	-	10
-	6	-	-	2	-	2	-	-	10
-	6	-	-	2	-	2	-	-	10
-	6	-	-	2	-	2	-	-	10
-	6	-	-	2	-	2	-	-	10
-	6	-	-	2	-	2	-	-	10
-	6	-	-	2	-	2	-	-	10
-	6	-	-	2	-	2	-	-	10
-	**90**	**-**	**-**	**30**	**-**	**30**	**-**	**-**	**150**

Podium

Level (s)	Gross Floor Area		Exclusions								Total Floor Area	
			Exterior Wall		Elevator Shafts		Parking/Loading/Bike Parking		Sub Total			
	Metric (m2)	Imperial (ft2)	Metric (m2)	Imperial (ft2)	Metric (m2)	Imperial (ft2)	Metric (m2)	Imperial (ft2)	Metric (m2)	Imperial (ft2)	Metric (m2)	Imperial (ft2)
5	**2,905.2**	31,272	105.5	1,136	32.9	355	-	-	**138.4**	1,490	**2,766.8**	29,781
4	**3,519.6**	37,885	128.8	1,386	32.9	355	-	-	**161.7**	1,741	**3,357.9**	36,144
3	**3,968.0**	42,711	130.9	1,409	42.3	455	-	-	**173.2**	1,864	**3,794.8**	40,847
2	**4,002.8**	43,086	124.6	1,342	42.3	455	-	-	**166.9**	1,796	**3,835.9**	41,289
1 M	**1,315.2**	14,157	19.2	207	16.5	177	-	-	**35.7**	384	**1,279.6**	13,773
1	**5,304.0**	57,092	82.3	886	50.5	543	1,251.1	13,467	**1,383.9**	14,896	**3,920.1**	42,196
Total	**21,014.9**	226,203	**591.4**	6,365	**217.4**	2,340	**1,251.1**	13,467	**2,059.8**	22,172	**18,955.1**	204,031

Floor Area Breakdown							
Residential		Residential Amenity		Commercial		Daycare	
Metric (m^2)	Imperial (ft^2)	Metric (m^2)	Imperial (ft^2)	Metric (m^2)	Imperial (ft^2)	Metric (m^2)	Imperial (ft^2)
2,766.8	29,781	-	-	-	-	-	-
3,357.9	36,144	-	-	-	-	-	-
3,794.8	40,847	-	-	-	-	-	-
2,750	29,602	664.3	7,151	-	-	421.5	4,537
998	10,743	-	-	261.0	2,809	20.6	221
1,101.3	11,854	-	-	2,768.7	29,802	50.1	539
14,769.0	158,972	**664.3**	7,151	**3,029.7**	32,611	**492.1**	5,297

Rental									
Bachelor (<45 sm)	1 Br (<45 sm)	1 Br (45-70 sm)	1Br+D (45-70 sm)	2Br (<70 sm)	2Br (>70 sm)	2Br+D (>70 sm)	3Br (>70 sm)	TH	Total
1	-	13	16	1	3	3	3	-	40
13	-	10	19	4	3	-	3	-	52
14	-	10	27	3	2	-	4	-	60
14	-	4	18	3	1	-	2	-	42
-	-	-	-	-	-	-	-	-	-
-	-	-	-	-	-	-	-	6	6
42	**37**	**-**	**80**	**11**	**9**	**3**	**12**	**6**	**200**

Phase 1 Total Tabulation

Level (s)	Gross Floor Area		Exclusions								Total Floor Area	
			Exterior Wall		Elevator Shafts		Parking/Loading/Bike Parking		Sub Total			
	Metric (m^2)	Imperial (ft^2)	Metric (m^2)	Imperial (ft^2)	Metric (m^2)	Imperial (ft^2)	Metric (m^2)	Imperial (ft^2)	Metric (m^2)	Imperial (ft^2)	Metric (m^2)	Imperial (ft^2)
Tower A	**10,637.3**	114,499	503.5	5,420	281.9	3,034	-	-	**785.4**	8,454	**9,851.9**	106,045
Tower B	**9,955.9**	107,165	475.6	5,120	265.3	2,856	-	-	**741.0**	7,976	**9,215.0**	99,189
Podium	**21,014.9**	226,203	591.4	6,365	217.4	2,340	1,251.1	13,467	**2,059.8**	22,172	**18,955.1**	204,031
Total	**41,608.2**	447,867	**1,570.5**	16,905	**764.6**	8,230	**1,251.1**	13,467	**3,586.2**	38,601	**38,022.0**	409,265

Floor Area Breakdown							
Residential		Residential Amenity		Commercial		Daycare	
Metric (m^2)	Imperial (ft^2)	Metric (m^2)	Imperial (ft^2)	Metric (m^2)	Imperial (ft^2)	Metric (m^2)	Imperial (ft^2)
9,851.9	106,045	-	-	-	-	-	-
9,215.0	99,189	-	-	-	-	-	-
14,769.0	158,972	664.3	7,151	3,029.7	32,611	492.1	5,297
33,835.9	364,206	**664.3**	7,151	**3,029.7**	32,611	**492.1**	5,297

Rental									
Bachelor (<45 sm)	1 Br (<45 sm)	1 Br (45-70 sm)	1Br+D (45-70 sm)	2Br (<70 sm)	2Br (>70 sm)	2Br+D (>70 sm)	3Br (>70 sm)	TH (3Br)	Total
1	96	-	-	32	-	31	-	-	160
-	90	-	-	30	-	30	-	-	150
42	37	-	80	11	9	3	12	6	200
43	**223**	**-**	**80**	**73**	**9**	**64**	**12**	**6**	**510**
8.4%		59.4%		16.1%		12.5%	2.4%	1.2%	100.0%

updated to new plans

CLIENT

Starlight Developments

Starlight Developments
P.O. Box 1690 Station B Mississauga, Ontario, Canada L4Y 3W8

COPYRIGHT:
This drawing has been prepared solely for the intended use, thus any reproduction or distribution for any purpose other than authorized by IBI Group is forbidden. Written dimensions shall have precedence over scaled dimensions. Contractors shall verify and be responsible for all dimensions and conditions on the job, and IBI Group shall be informed of any variations from the dimensions and conditions shown on the drawing. Shop drawings shall be submitted to IBI Group for general conformance before proceeding with fabrication.
IBI Group Architects (Canada) Inc.
is a member of the IBI Group of companies

NO.	DATE	DESCRIPTION
1	YYYY-MM-DD	

ISSUES

NO.	DATE	DESCRIPTION

REVISIONS

Issued For: Project Status
Date: 2021-03-05

SEAL

REGISTERED ARCHITECTS JOHN GIWA-AMU BRITISH COLUMBIA
2021-03-06

SUB-CONSULTANT

PRIME CONSULTANT

IBI GROUP
ARCHITECTS (CANADA) INC.
700-1285 West Pender Street,
Vancouver, BC V6E 4B1, Canada
tel 604 683 8797 fax 604 683 0492
ibigroup.com

PROJECT TITLE
Harris Green Village
Phase 01
1045 Yates Street
Victoria, BC

PROJECT NO:	121123
DRAWN BY:	Author
CHK'D BY:	Checker
SCALE:	1 : 1
DATE:	2021-03-05

SHEET TITLE
BUILDING STATISTICS

SHEET NUMBER **A0.02**

REV

Last Saved: 2021-03-05 10:14:04 PM File Location: BIM 360://121123 - Yates Street – Harris Green Village Ph 1 R20/0121123_YatesStA-Podium-2020.rvt

VEHICLE TABULATIONS

5.1.1A Off-Street Parking Regulations

Residential:

Apartment (Dwelling Unit secured as rental in perpetuity through a legal aggreement)

0.50 spaces per Dwelling Unit that is less than 45m^2

0.60 spaces per Dwelling Unit that is equal to 45m^2 and up to 70m^2

1 spaces per Dwelling Unit that is more than 70m^2

Visitor Parking: 0.10 space per Dwelling Unit

Residential floor area (m^2) (including 1 space per 80m^2 floor area

Daycare 1 space per 100m^2 floor area

VALUES FOR TABULATING PARKING & LOADING COUNTS

Residential Units	< 45 m2	45 m2-70 m2	>70 m2	Total
Tower A	97	32	31	160
Tower B	90	30	30	150
Podium	79	91	30	200
Total	266	153	91	510

Commercial Floor Area	3,030 m^2
Daycare Floor Area	492.12 m^2

REQUIRED / PROVIDED TOTAL PARKING

	Residential		Commercial				
	Resident	Visitor	Grocery	Grocery Office (mezzanine)	CRU (assumes restaurant)	Daycare	Total
Area (m2)	See separate calculation table.		2,136.80	263.60	548.80	492.12	
Rate (1 per x m2)			50	70	40	100	
Required	315.80	51.00	42.74	3.77	13.72	4.92	
Required (rounded)	316	51	43	4	14	5	433
TDM Adjustments							
Captive Market			-10%	-10%	-10%	-10%	
Shared Parking		-6%	-6%	-6%	-6%	-6%	
Cycling end-of-trip facilities				-3%	-3%	-3%	
E-Bike plugs	-2.5%						
Carshare	-10%						
Priced Parking		-20%	-20%	-20%	-20%	-20%	
Multimodal wayfinding signage	-3%		-3%	-3%	-3%	-3%	
Unbundled parking							
Marketing and promotion							
Total TDM Adjustments							
Total TDM Adjustments (%)	-15.5%	-26.0%	-39.0%	-42.0%	-42.0%	-42.0%	
Total TDM Adjustments (stalls)	(49.0)	(13.3)	(16.8)	(1.7)	(5.9)	(2.1)	(89)
Required (TDM Adjusted)	268	38	26	2	8	3	345
Proposed parking stalls	268	38	26	2	8	3	345

Note:

1. Commercial / daycare / visitor parking will be shared

2. 2 public (level 2) - EV chargers will be provided in the commercial parking & the three Car share will be made EV Ready.

3. EV Load sharing to support up to 90 residential stalls (subject to consultation with bc hydro)

REQUIRED / PROVIDED LOADING

Required

Type	Residential	Commercial	Total
Medium	N/A	N/A	N/A
Large	N/A	N/A	N/A

Provided

Type	Residential	Commercial	Total
Medium	2	-	2
Large	-	1	1

REQUIRED / PROVIDED BICYCLE PARKING

5.1.1B Off-Street Parking Regulations

	Long Term	Short Term
Residential	1.0 space for unit under 45 m^2 ; 1.25 space for unit more than 45 m^2	0.1 space per dwelling unit
Commercial	1.0 space per 200m^2 floor area	1.0 space per 200 m^2 floor area
Daycare	1.0 space per 700m^2 floor area	1.0 space per 200 m^2 floor area

Required

Type	Residential	Commercial	Daycare	Total
Long Term Bikes	571	16	-	587
Short Term Bikes	51	16	3	70

Provided

Type	Residential			Commercial	Daycare	Total
	Ground Anchored	Wall Mounted	Cargo	Ground Anchored		
Long Term Bikes	495	72	6	16	-	588
Short Term Bikes	* 51			* 16	* 3	70
	*31 @ p1 & 20 @ grade			*12 @ p1 & 4 @	@ P1	

parking reduced

Floor By Floor Breakdown of Provided Cars & Bikes

	Cars						Bikes	
	Commercial	Daycare	Car Share	Visitor	Residential	Sub Total	Short Term	Long Term
Gound	-	-	-	-	-	-	24	-
P1	33	3	3	40	17	96	46	588
P2	-	-	-	-	171	171	-	
P3	-	-	-	-	79	79	-	
TOTAL	33	3	3	40	267	346	70	588

Note:

1. Not more than 30 percent of the required long-term bicycle parking spaces may be vertical.

CLIENT

Starlight Developments

Starlight Developments

P.O. Box 1890 Station B Mississauga, Ontario, Canada L4Y 3W8

COPYRIGHT:

This drawing has been prepared solely for the intended use, thus any reproduction or distribution for any purpose other than authorized by IBI Group is forbidden. Written dimensions shall have precedence over scaled dimensions. Contractors shall verify and be responsible for all dimensions and conditions on the job, and IBI Group shall be informed of any variations from the dimensions and conditions shown on the drawing. Shop drawings shall be submitted to IBI Group for general conformance before proceeding with fabrication.

IBI Group Architects (Canada) Inc.
is a member of the IBI Group of companies

NO.	DATE	DESCRIPTION
1	YYYY-MM-DD	

ISSUES

NO.	DATE	DESCRIPTION

REVISIONS

Issued For: Project Status

Date: 2021-03-05

SEAL

REGISTERED ARCHITECT JOHN GIMPEL BRITISH COLUMBIA

2021-03-06

SUB-CONSULTANT

PRIME CONSULTANT

IBI GROUP ARCHITECTS (CANADA) INC.
700-1285 West Pender Street,
Vancouver, BC V6E 4B1, Canada
tel 604 683 8797 fax 604 683 0402
ibigroup.com

PROJECT TITLE

Harris Green Village Phase 01

1045 Yates Street
Victoria, BC

PROJECT NO:	121123
DRAWN BY:	Author
CHK'D BY:	Checker
SCALE:	1 : 1
DATE:	2021-03-05

SHEET TITLE

PARKING STATISTICS

SHEET NUMBER

A0.03

REV

Last Saved: 2021-03-05 10:14:17 PM File Location: I:\Bld-360\121123 - Yates Street - Harris Green Village Ph 1 R2020\121123_YatesStA-Podium-2020.vwt

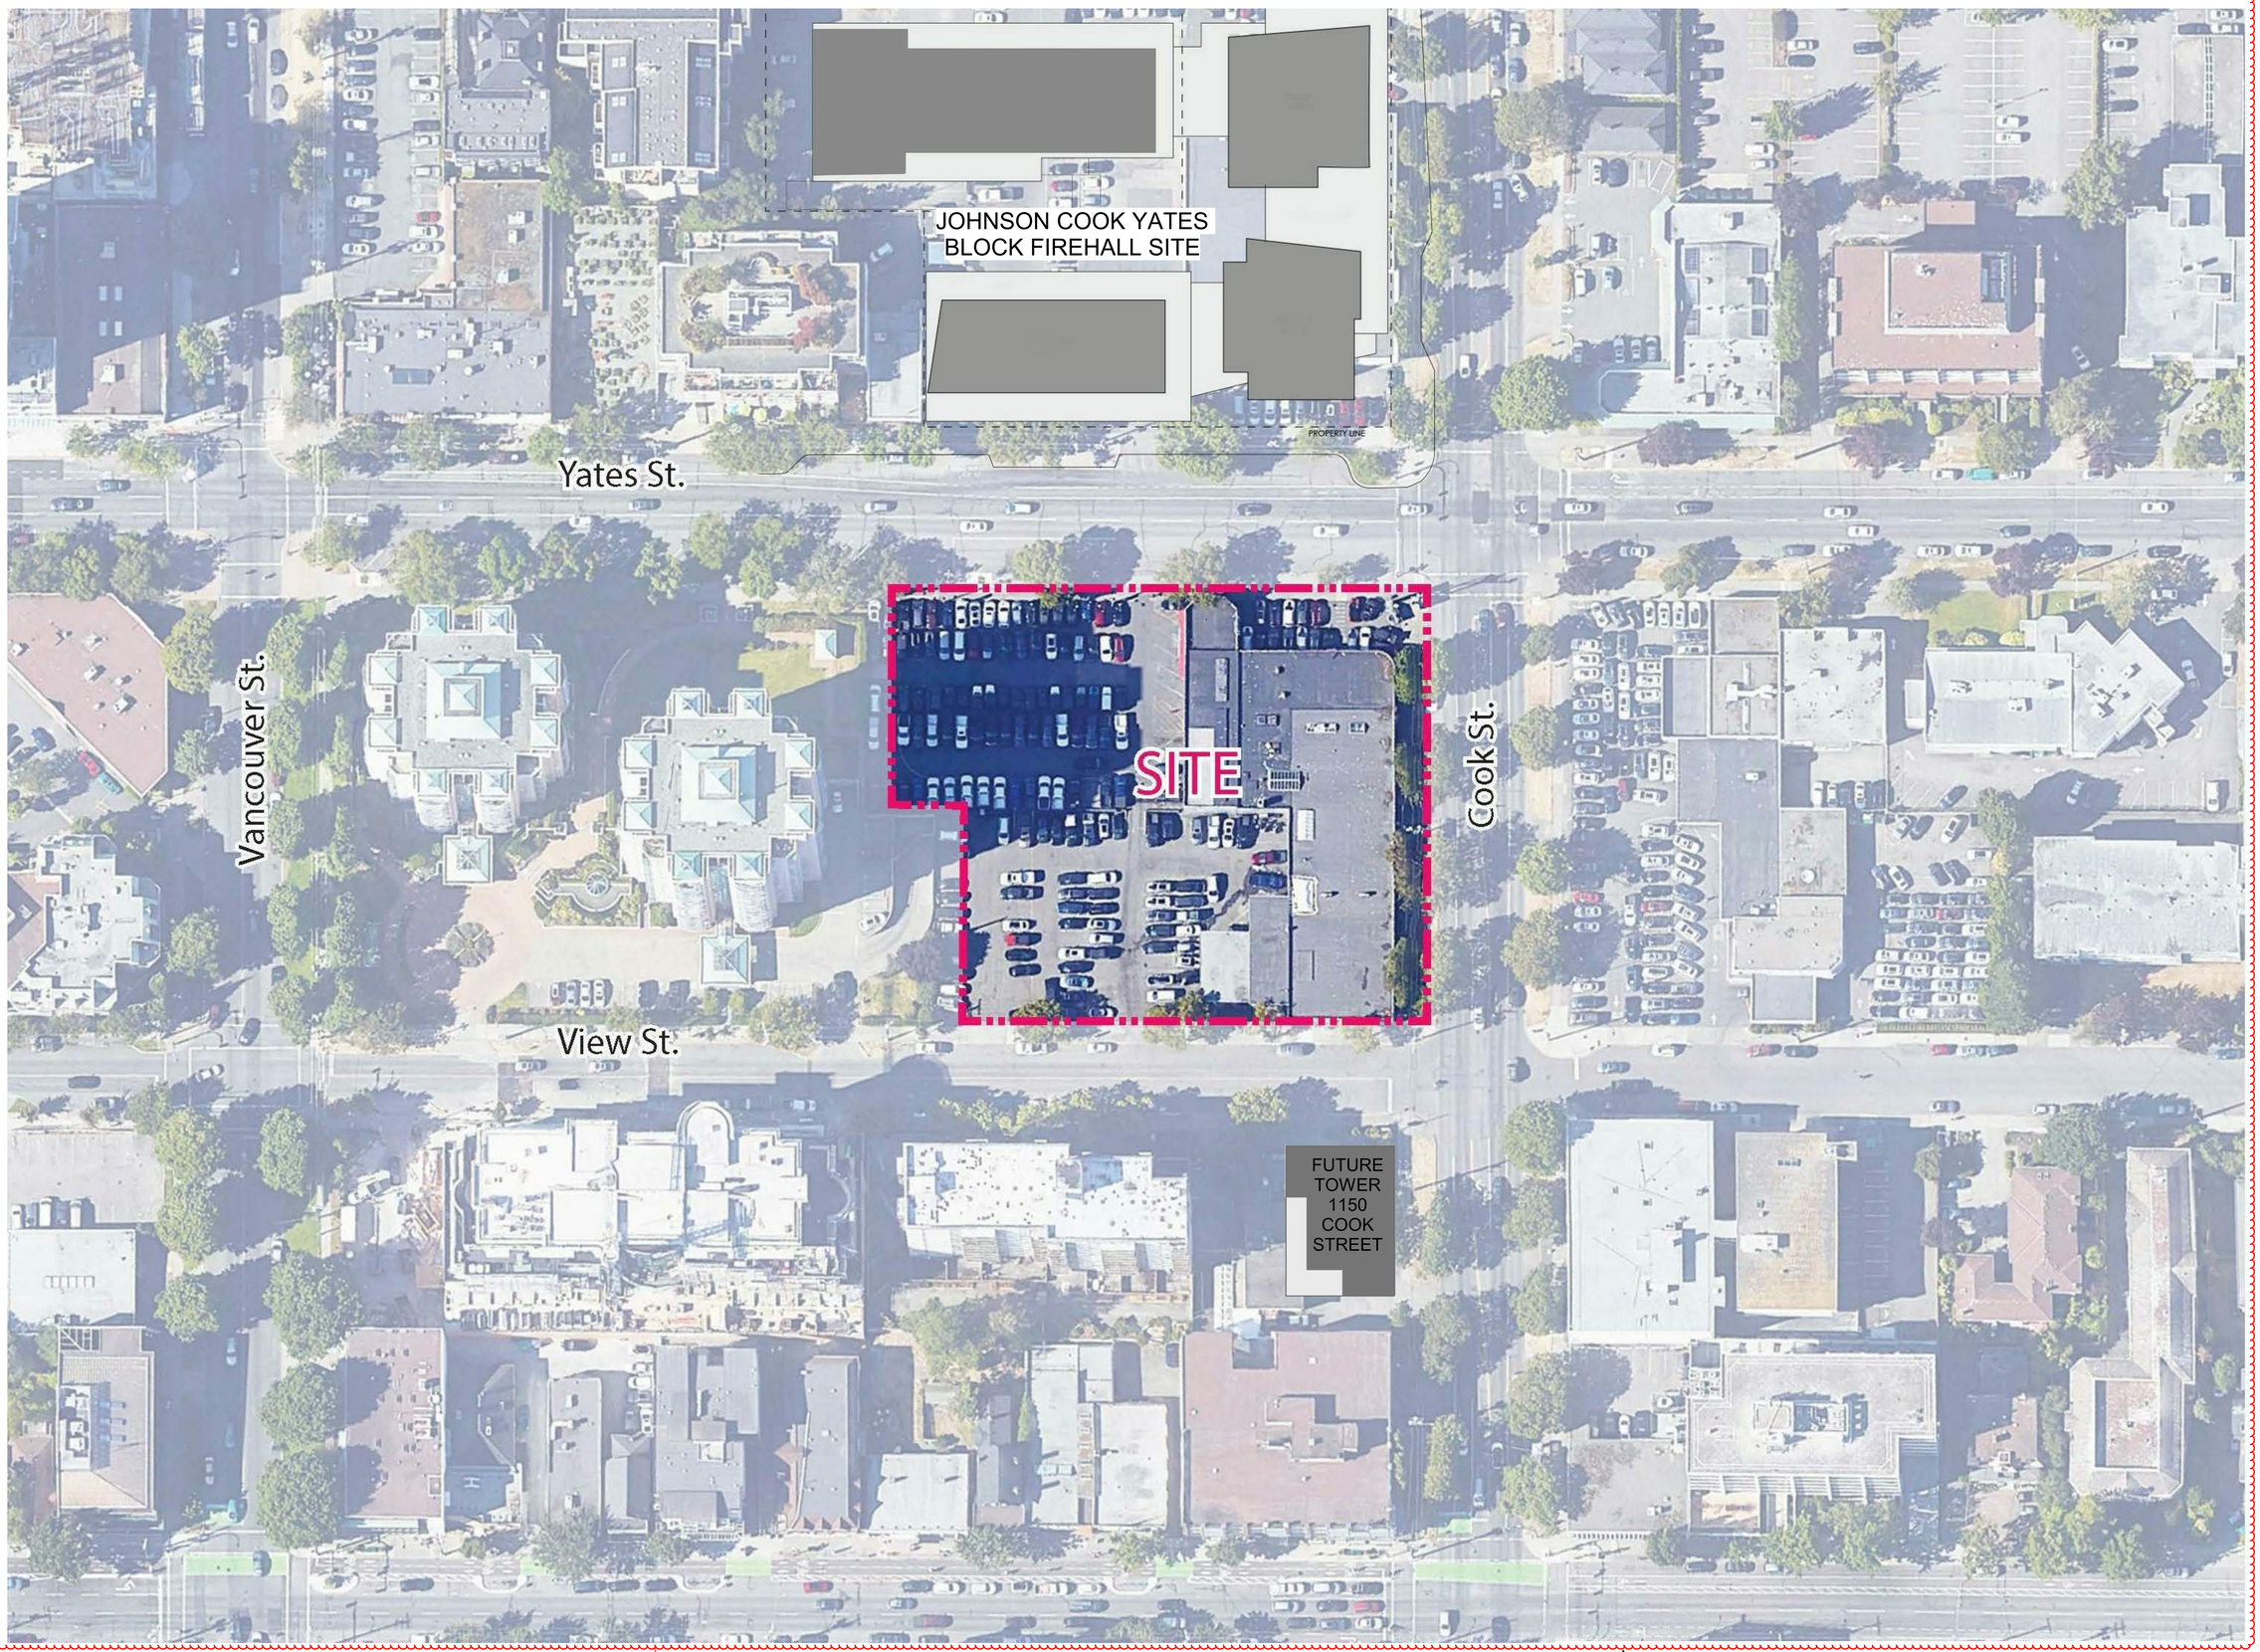

CLIENT

Starlight Developments

Starlight Developments
P.O. Box 1690 Station B Mississauga, Ontario, Canada
L4Y 3W8

COPYRIGHT:
This drawing has been prepared solely for the intended use, thus any reproduction or distribution for any purpose other than authorized by IBI Group is forbidden. Written dimensions shall have precedence over scaled dimensions. Contractors shall verify and be responsible for all dimensions and conditions on the job, and IBI Group shall be informed of any variations from the dimensions and conditions shown on the drawing. Shop drawings shall be submitted to IBI Group for general conformance before proceeding with fabrication.

IBI Group Architects (Canada) Inc.
is a member of the IBI Group of companies

NO.	DATE	DESCRIPTION
1	YYYY-MM-DD	

ISSUES

NO.	DATE	DESCRIPTION

REVISIONS

Issued For: Project Status
Date: 2021-03-05

SEAL

REGISTERED ARCHITECT
JOHN GWYN
BRITISH COLUMBIA
2021-03-06

SUB-CONSULTANT

PRIME CONSULTANT

IBI GROUP
ARCHITECTS (CANADA) INC.
700-1285 West Pender Street
Vancouver, BC V6E 4B1, Canada
tel 604 683 8797 fax 604 683 0492
ibigroup.com

PROJECT TITLE
Harris Green Village
Phase 01
1045 Yates Street
Victoria, BC

PROJECT NO:	121123
DRAWN BY:	Author
CHK'D BY:	Checker
SCALE:	1 : 5
DATE:	2021-03-05

SHEET TITLE
CONTEXT PLAN

SHEET NUMBER
A0.04

REV

Last Saved: 2021-03-05 10:14:19 PM File Location: BIM 360://121123 - Yates Street – Harris Green Village Ph I 82020/121123_YatesStA-Podium-2020.rvt

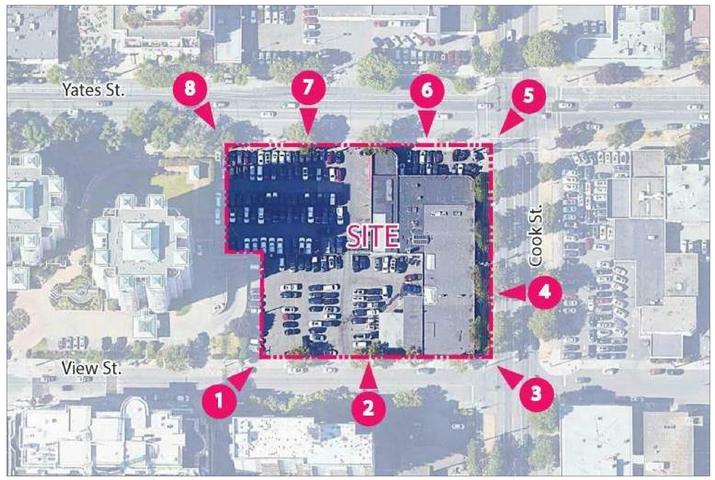

1

2

3

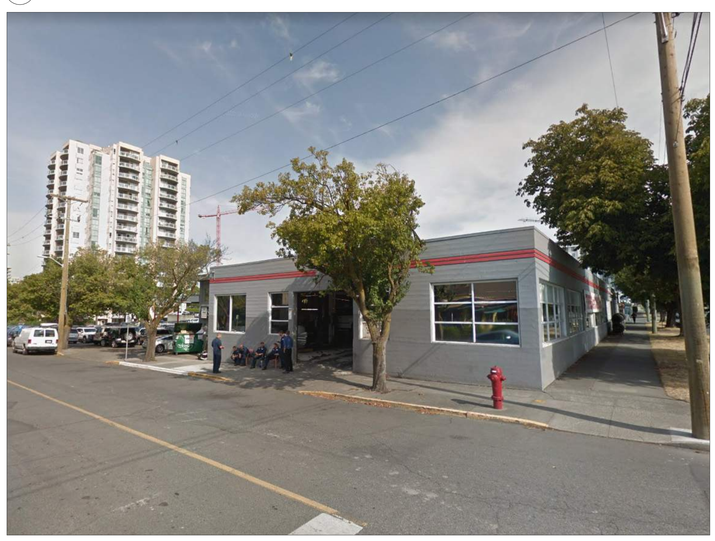

4

5

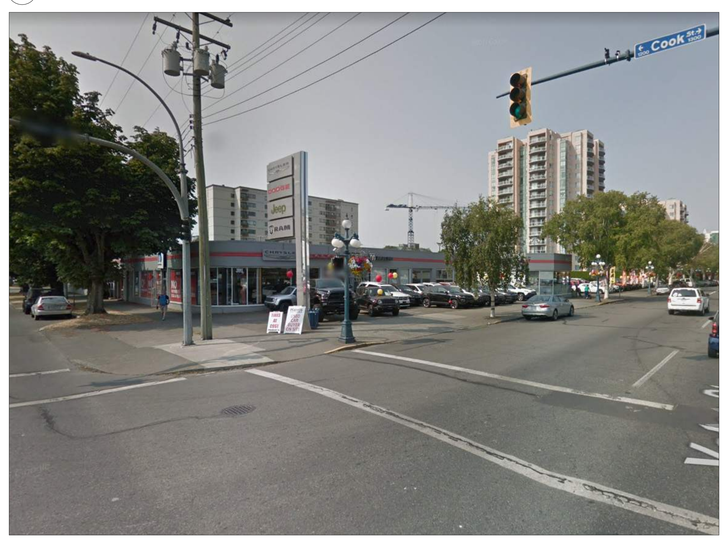

6

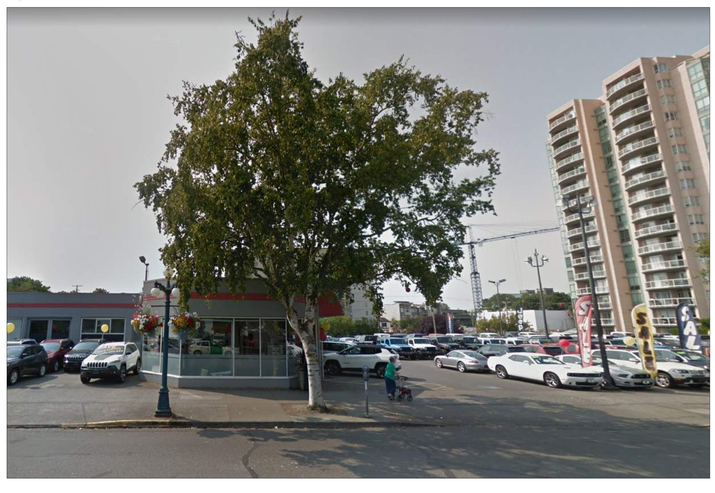

7

8

CLIENT

Starlight Developments

Starlight Developments

P.O. Box 1890 Station B Mississauga, Ontario, Canada
L4Y 3W8

COPYRIGHT:
This drawing has been prepared solely for the intended use, thus any reproduction or distribution for any purpose other than authorized by IBI Group is forbidden. Written dimensions shall have precedence over scaled dimensions. Contractors shall verify and be responsible for all dimensions and conditions on the job, and IBI Group shall be informed of any variations from the dimensions and conditions shown on the drawing. Shop drawings shall be submitted to IBI Group for general conformance before proceeding with fabrication.

IBI Group Architects (Canada) Inc.
is a member of the IBI Group of companies

NO.	DATE	DESCRIPTION
1	YYYY-MM-DD	

ISSUES

NO.	DATE	DESCRIPTION

REVISIONS

Issued For: Project Status
Date: 2021-03-05

SEAL

REGISTERED ARCHITECT JOHN GWYN MACDONALD BRITISH COLUMBIA
2021-03-06

SUB-CONSULTANT

PRIME CONSULTANT

IBI GROUP
ARCHITECTS (CANADA) INC.
700-1285 West Pender Street,
Vancouver, BC V6E 4B1, Canada
tel 604 683 8797 fax 604 683 0492
ibigroup.com

PROJECT TITLE
Harris Green Village
Phase 01
1045 Yates Street
Victoria, BC

PROJECT NO:	121123
DRAWN BY:	Author
CHK'D BY:	Checker
SCALE:	1 : 5
DATE:	2021-03-05

SHEET TITLE
CONTEXT PHOTOS

SHEET NUMBER
A0.05

REV

Last Saved: 2021-03-05 10:14:22 PM File Location: IBM 360 //121123 - Yates Street – Harris Green Village Ph 1 (52000)/121123_Yates50-A-Podium-2020.rvt

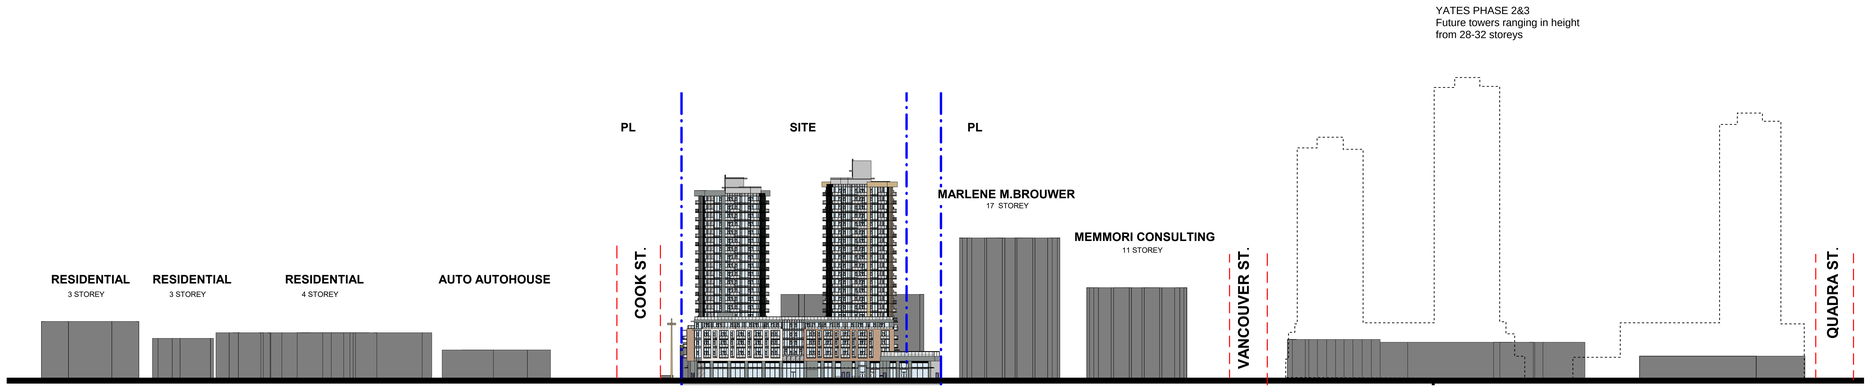

1 A0.06 STREET SCAPE ELEVATION FROM YATES STREET
SCALE: 1 : 750

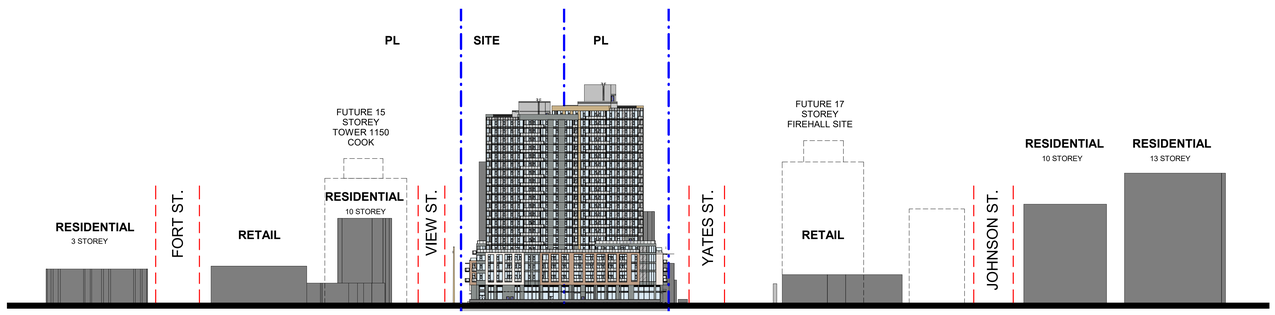

2 A0.06 STREET SCAPE ELEVATION FROM COOK STREET
SCALE: 1 : 750

added future buildings around site

CLIENT

Starlight Developments

Starlight Developments
P.O. Box 1690 Station B Mississauga, Ontario, Canada
L4Y 3W8

COPYRIGHT:
This drawing has been prepared solely for the intended use, thus any reproduction or distribution for any purpose other than authorized by IBI Group is forbidden. Written dimensions shall have precedence over scaled dimensions. Contractors shall verify and be responsible for all dimensions and conditions on the job, and IBI Group shall be informed of any variations from the dimensions and conditions shown on the drawing. Shop drawings shall be submitted to IBI Group for general conformance before proceeding with fabrication.
IBI Group Architects (Canada) Inc.
is a member of the IBI Group of companies

NO.	DATE	DESCRIPTION
1	YYYY-MM-DD	

ISSUES

NO.	DATE	DESCRIPTION

REVISIONS

Issued For: Project Status
Date: 2021-03-05

SEAL

REGISTERED ARCHITECT JOHN GWYN HUGHES BRITISH COLUMBIA
2021-03-06

SUB-CONSULTANT

PRIME CONSULTANT

IBI GROUP
ARCHITECTS (CANADA) INC.
700-1285 West Pender Street,
Vancouver, BC V6E 4B1, Canada
tel 604 683 8797 fax 604 683 0492
ibigroup.com

PROJECT TITLE
Harris Green Village
Phase 01
1045 Yates Street
Victoria, BC

PROJECT NO:	121123
DRAWN BY:	Author
CHK'D BY:	Checker
SCALE:	1 : 750
DATE:	2021-03-05

SHEET TITLE
STREET SCAPE ELEVATION

SHEET NUMBER
A0.06

REV

Last Saved: 2021-03-05 10:15:09 PM File Location: BIM 360://121123 - Yates Street – Harris Green Village Ph 1/02000/121123_YatesStS-A-Podium-2020.rvt

Revised to match design guidelines

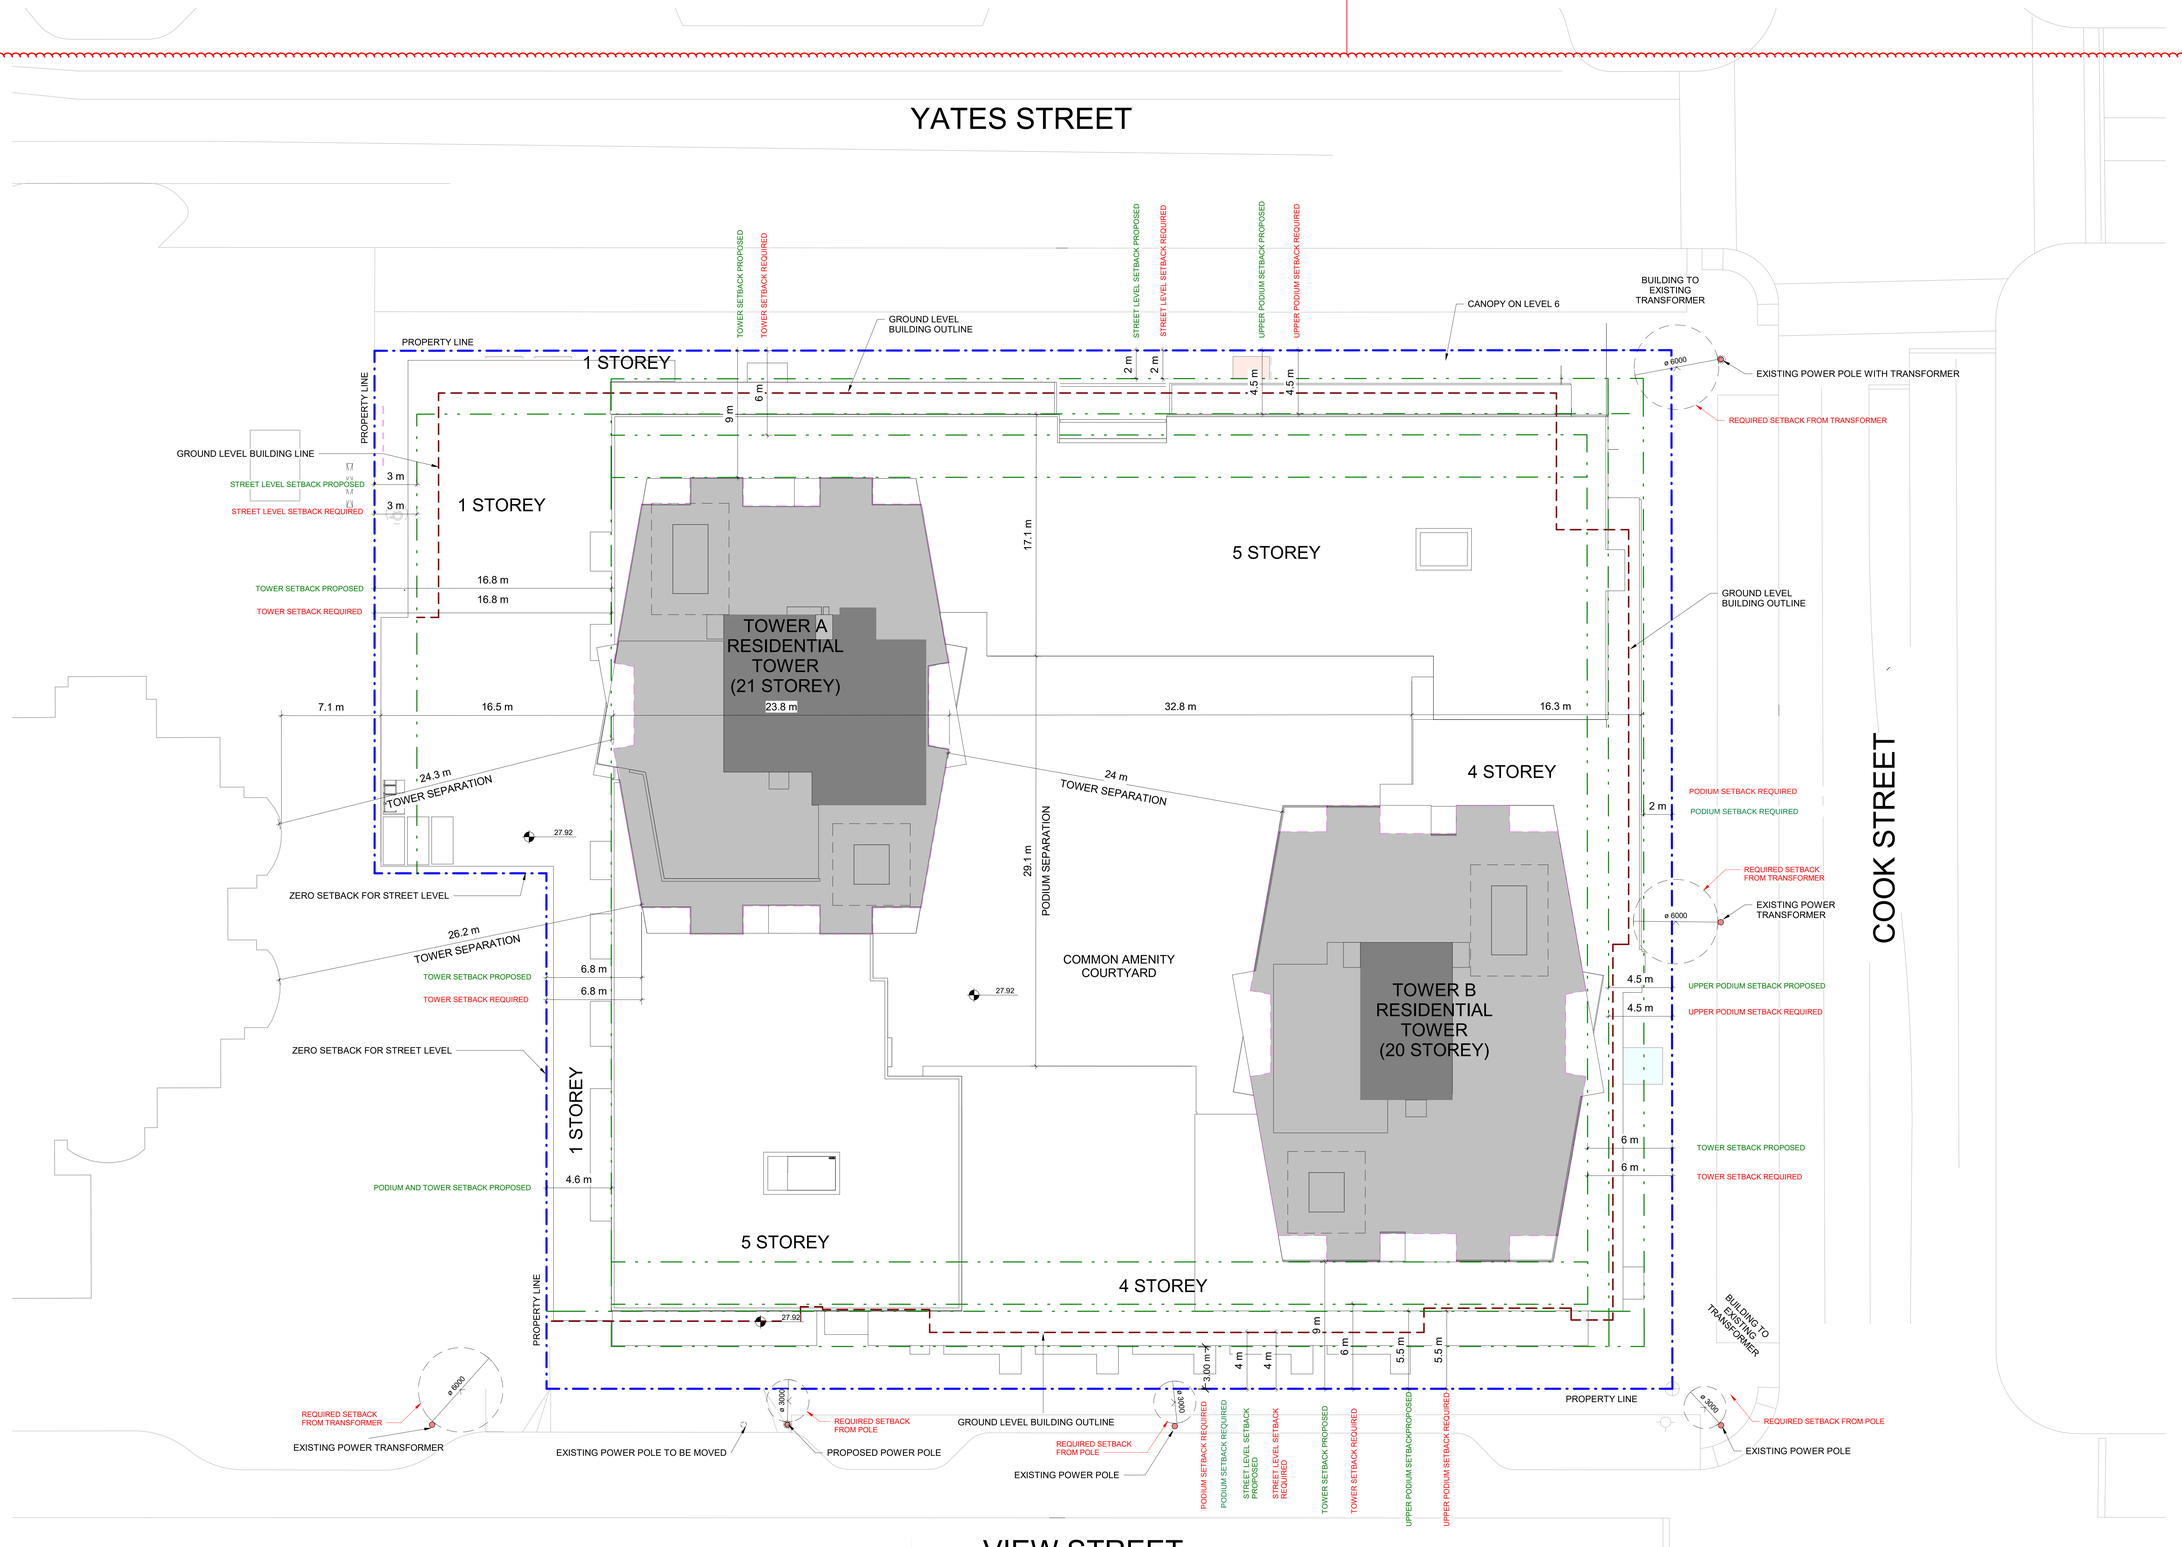

VIEW STREET

BUILDING SETBACKS

Property Line	Required (m)			Proposed (m)		
	Street Level	Residential Podium	Tower	Street Level	Residential Podium	Tower
Front yard (Yates Street)	3.0	2.0	6.0	3.0	4.5	9.0
Rear yard (View Street)	4.0	3.0	6.0	4.0	5.5	9.0
East Side yard (Cook Street)	3.0	2.0	6.0	3.0	4.5	6.0
West Side Yard (North)	3.0	3.0	16.8	3.0	3.0	16.8
West Side Yard (South)	-	4.6	4.6	-	4.6	7.0

CLIENT

Starlight Developments

Starlight Developments
P.O. Box 1690 Station B Mississauga, Ontario, Canada
L4Y 3W8

COPYRIGHT:
This drawing has been prepared solely for the intended use, thus any reproduction or distribution for any purpose other than authorized by IBI Group is forbidden. Written dimensions shall have precedence over scaled dimensions. Contractors shall verify and be responsible for all dimensions and conditions on the job, and IBI Group shall be informed of any variations from the dimensions and conditions shown on the drawing. Shop drawings shall be submitted to IBI Group for general conformance before proceeding with fabrication.
IBI Group Architects (Canada) Inc.
is a member of the IBI Group of companies

NO.	DATE	DESCRIPTION
1	YYYY-MM-DD	

ISSUES

NO.	DATE	DESCRIPTION

REVISIONS

Issued For: Project Status
Date: 2021-03-05

SEAL

REGISTERED ARCHITECT JOHN GIWA-AMU BRITISH COLUMBIA
2021-03-06

SUB-CONSULTANT

PRIME CONSULTANT

IBI GROUP
ARCHITECTS (CANADA) INC.
700-1285 West Pender Street,
Vancouver, BC V6E 4B1, Canada
tel 604 683 8797 fax 604 683 0492
ibigroup.com

PROJECT TITLE
Harris Green Village Phase 01
1045 Yates Street
Victoria, BC

PROJECT NO:	121123
DRAWN BY:	Author
CHK'D BY:	Checker
SCALE:	1 : 150
DATE:	2021-03-05

SHEET TITLE
SETBACK DIAGRAM

SHEET NUMBER
A0.07

REV

File Location: I:\BM 360\121123 - Yates Street - Harris Green Village Ph 1 R2020\121123_YatesSt-A-Podium-2020.rvt
Last Saved: 2021-03-05 10:15:15 PM

SITE COVERAGE CALCULATIONS

	Metric (m2)	Imperial (sq.ft.)
Gross Site Area	6,337	68,210.9
Building Footprint (podium)	5,297	57,018.6
Site Coverage %		**84%**

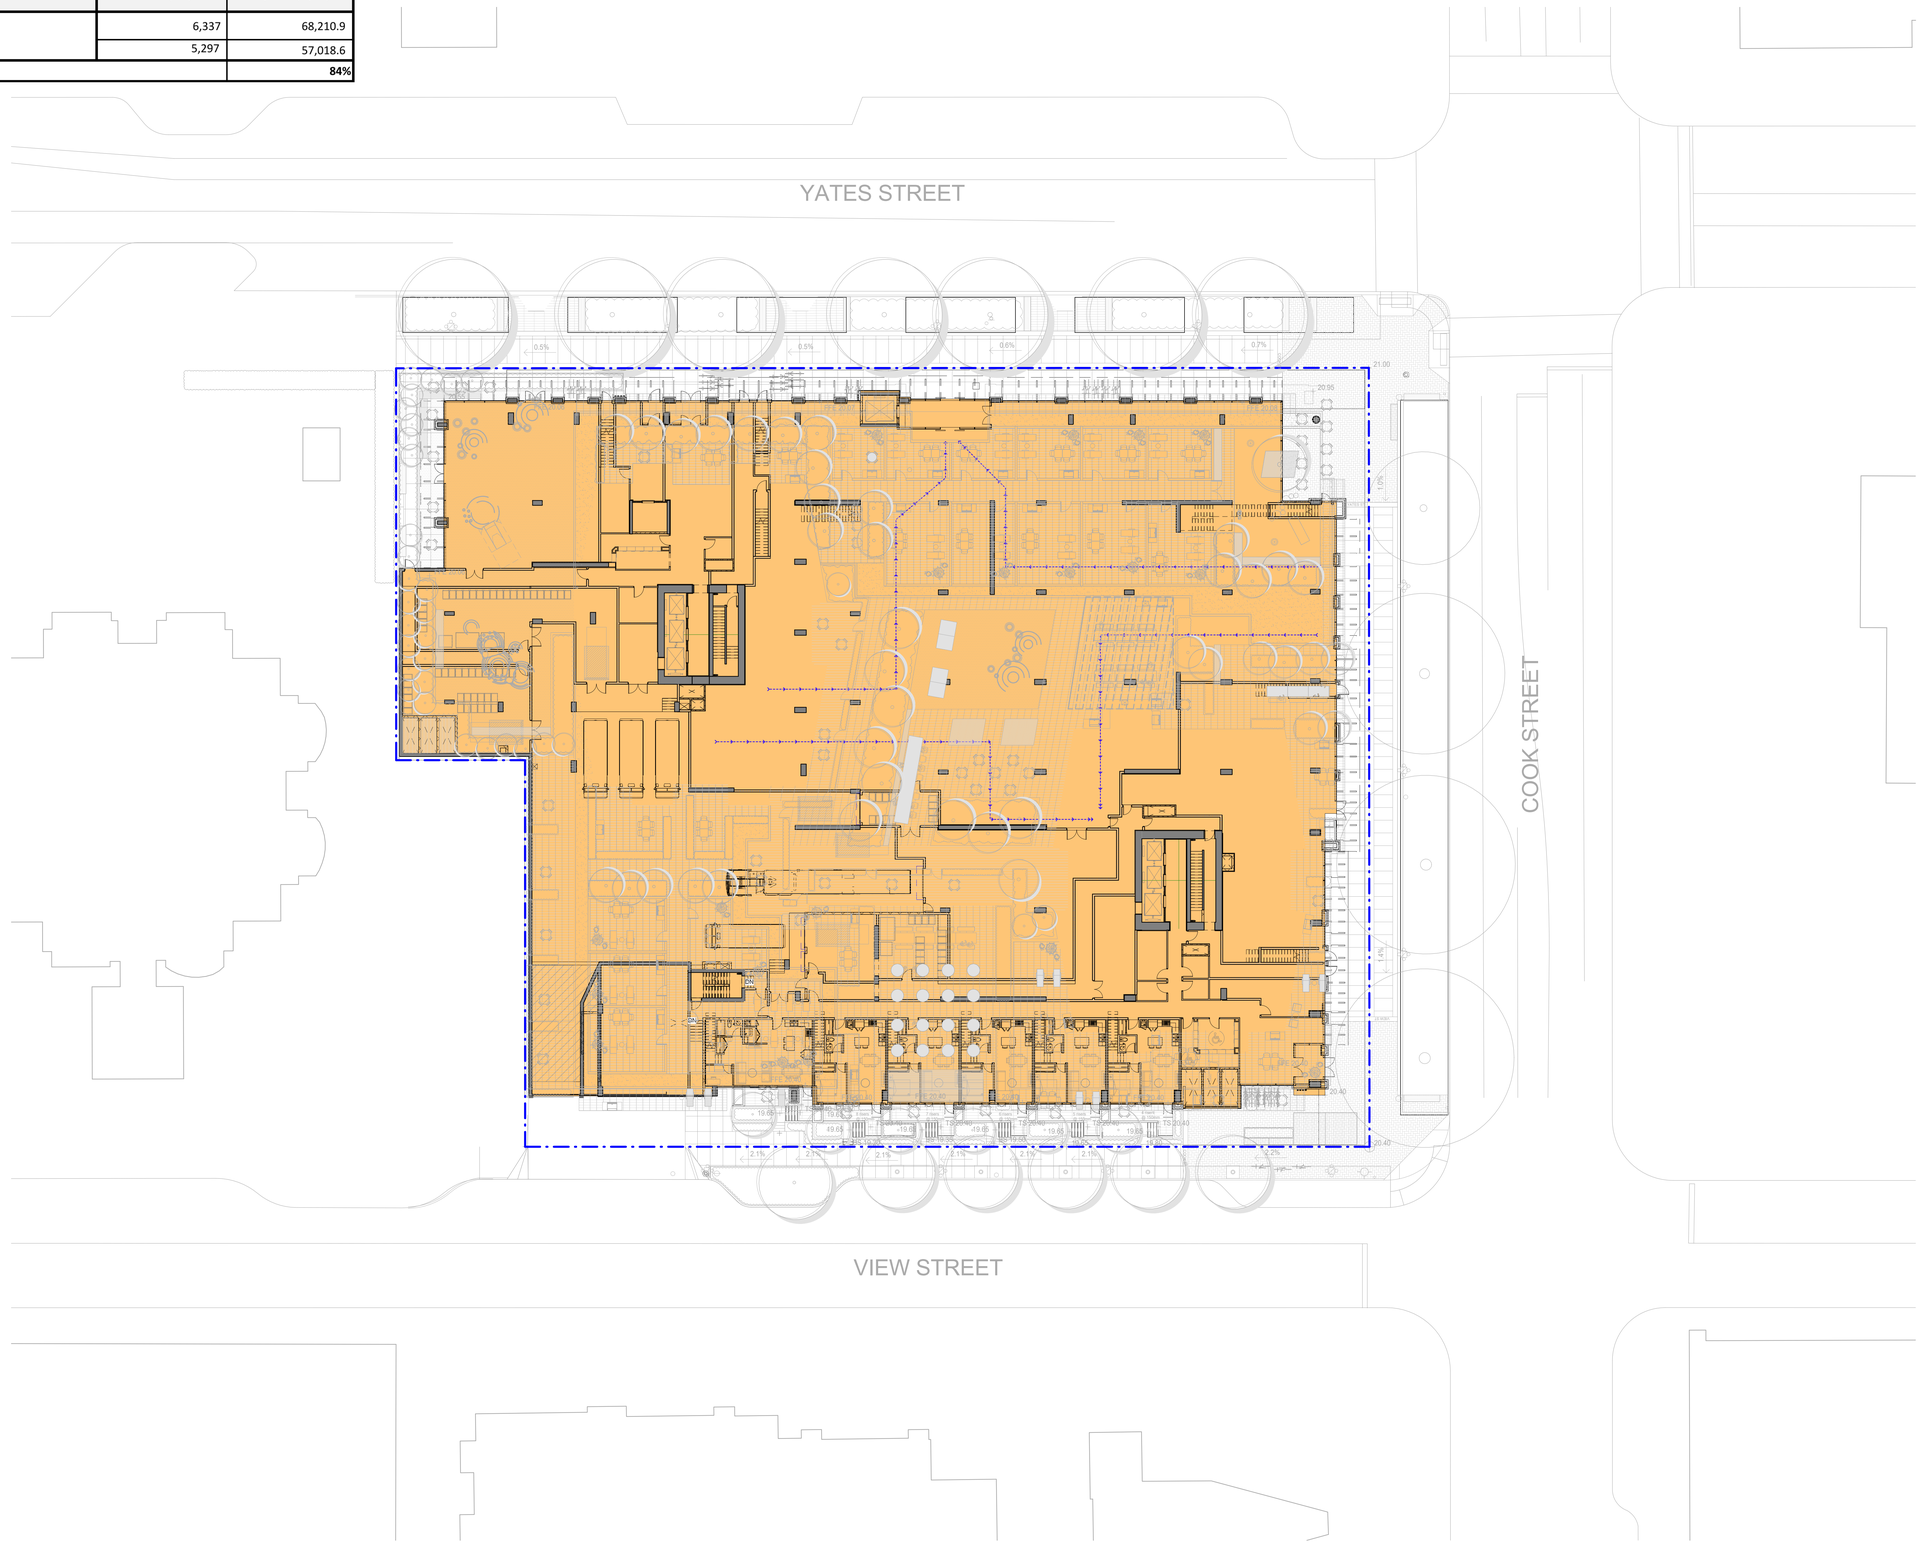

CLIENT

Starlight Developments

Starlight Developments
P.O. Box 1690 Station B Mississauga, Ontario, Canada
L4Y 3W8

COPYRIGHT:
This drawing has been prepared solely for the intended use, thus any reproduction or distribution for any purpose other than authorized by IBI Group is forbidden. Written dimensions shall have precedence over scaled dimensions. Contractors shall verify and be responsible for all dimensions and conditions on the job, and IBI Group shall be informed of any variations from the dimensions and conditions shown on the drawing. Shop drawings shall be submitted to IBI Group for general conformance before proceeding with fabrication.
IBI Group Architects (Canada) Inc.
is a member of the IBI Group of companies

NO.	DATE	DESCRIPTION
1	YYYY-MM-DD	

ISSUES

NO.	DATE	DESCRIPTION

REVISIONS

Issued For: Project Status
Date: 2021-03-05

SEAL

REGISTERED ARCHITECT JOHN GIWIS BRITISH COLUMBIA
2021-03-06

SUB-CONSULTANT

PRIME CONSULTANT

IBI GROUP ARCHITECTS (CANADA) INC.
700-1285 West Pender Street,
Vancouver, BC V6E 4B1, Canada
tel 604 683 8797 fax 604 683 0402
ibigroup.com

PROJECT TITLE
Harris Green Village Phase 01
1045 Yates Street
Victoria, BC

PROJECT NO:	121123
DRAWN BY:	Author
CHK'D BY:	Checker
SCALE:	1 : 200
DATE:	2021-03-05

SHEET TITLE
SITE COVERAGE DIAGRAM

SHEET NUMBER
A0.08

REV

Last Saved: 2021-03-05 10:15:43 PM File Location: I:\BM 360\121123 - Yates Street - Harris Green Village Ph 1 R2020\121123_YatesStA-Podium-2020.rvt

OPEN SITE SPACE CALCULATIONS

	Metric (m2)	Imperial (sq.ft.)
Gross Site Area	6,337	68,210.9
Open Site Space Area	761	8,186.0
Open Site Space %		12%

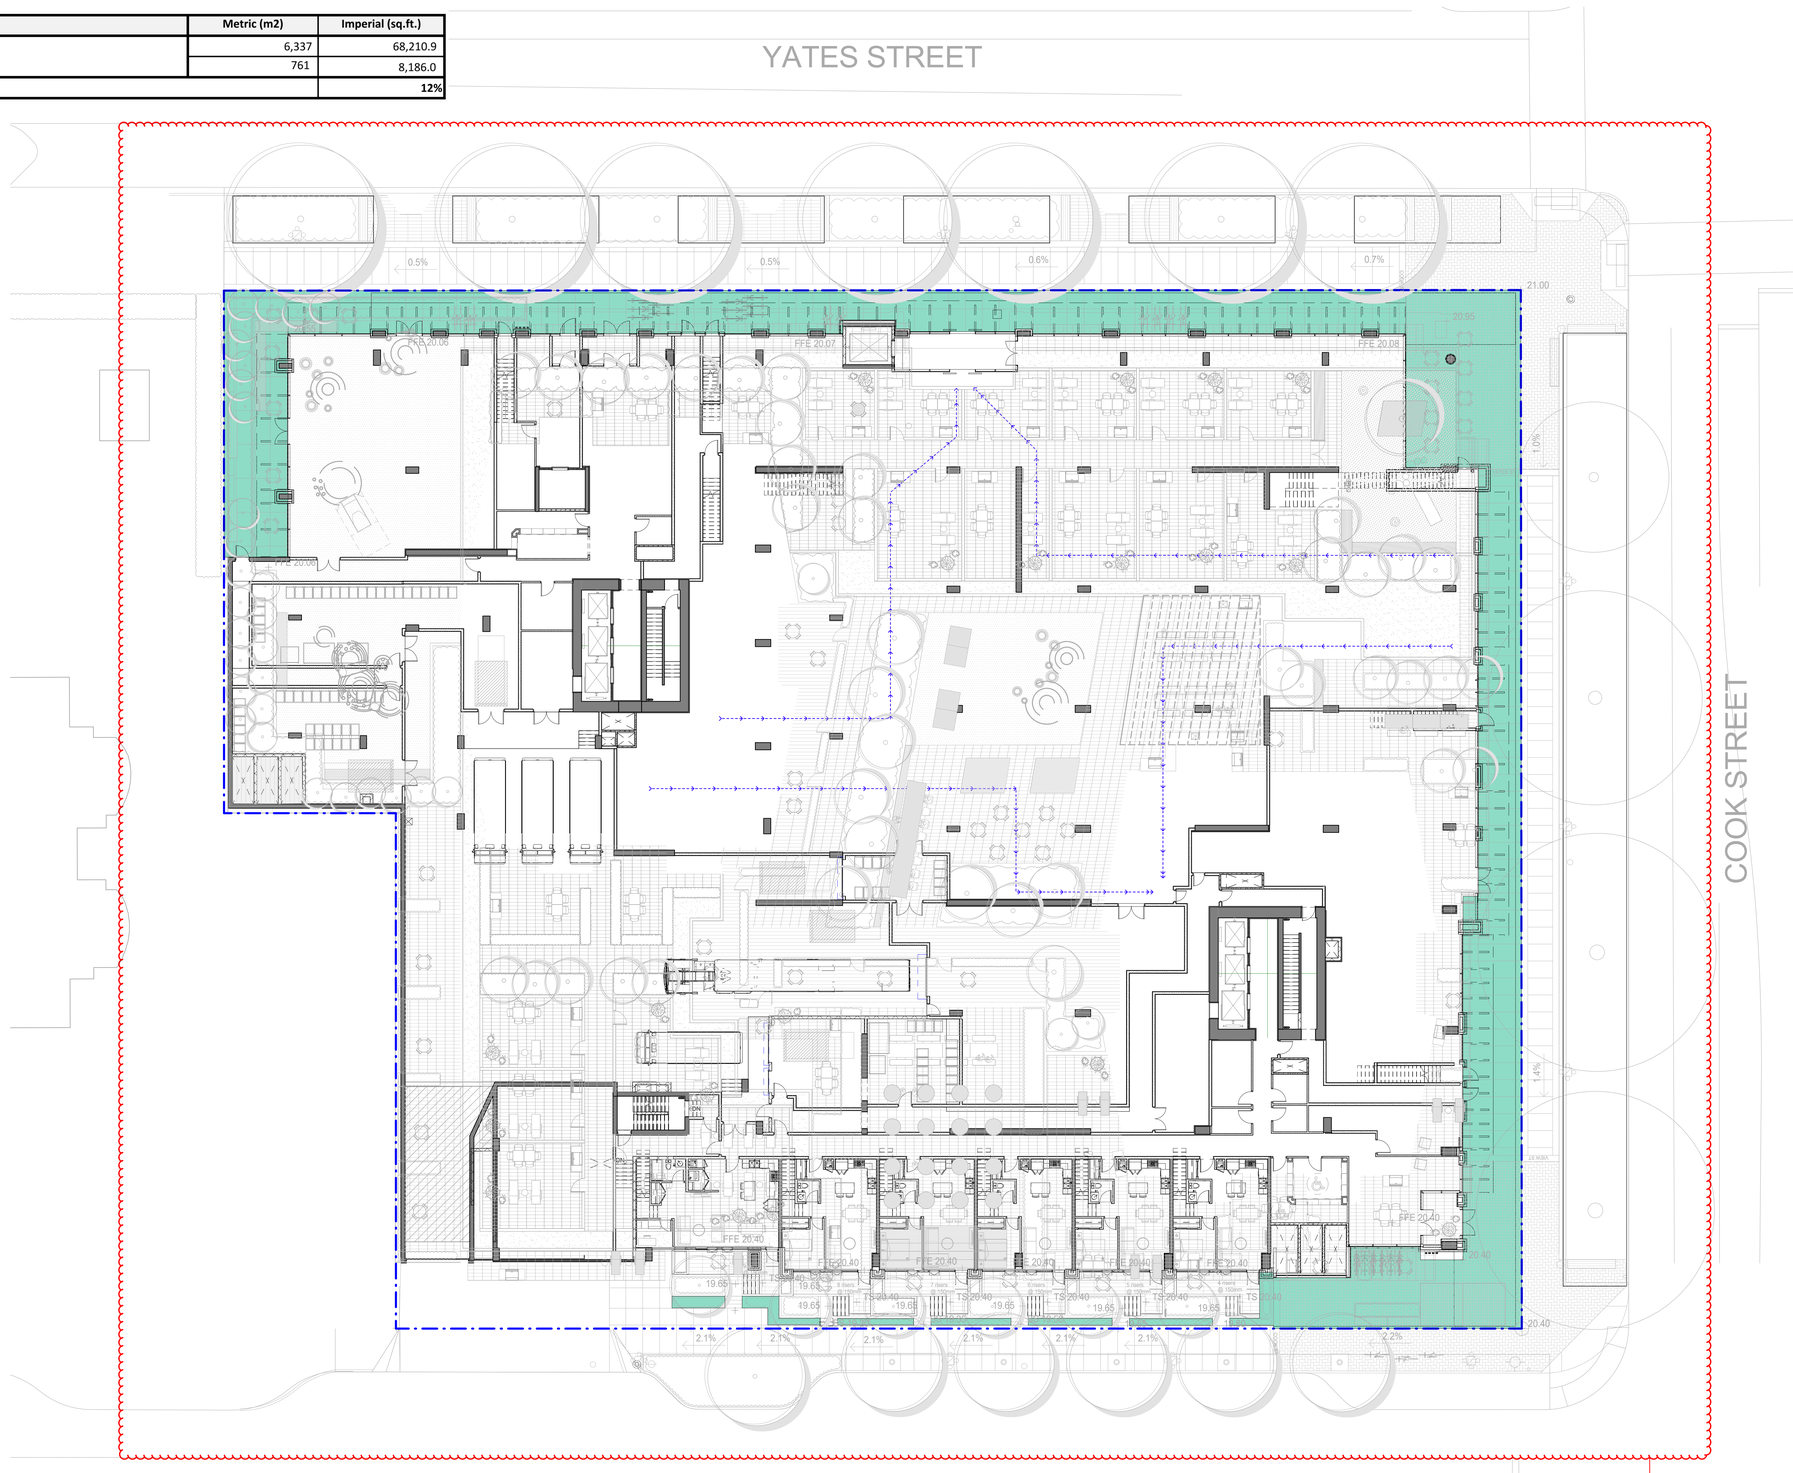

revised to new plan

CLIENT

Starlight Developments

Starlight Developments

P.O. Box 1690 Station B Mississauga, Ontario, Canada
L4Y 3W8

COPYRIGHT:

This drawing has been prepared solely for the intended use, thus any reproduction or distribution for any purpose other than authorized by IBI Group is forbidden. Written dimensions shall have precedence over scaled dimensions. Contractors shall verify and be responsible for all dimensions and conditions on the job, and IBI Group shall be informed of any variations from the dimensions and conditions shown on the drawing. Shop drawings shall be submitted to IBI Group for general conformance before proceeding with fabrication.

IBI Group Architects (Canada) Inc.
is a member of the IBI Group of companies

NO.	DATE	DESCRIPTION
1	YYYY-MM-DD	

ISSUES

NO.	DATE	DESCRIPTION

REVISIONS

Issued For: Project Status

Date: 2021-03-05

SEAL

REGISTERED ARCHITECT JOHN GIWA-AMU PROVINCE OF BRITISH COLUMBIA
2021-03-06

SUB-CONSULTANT

PRIME CONSULTANT

IBI GROUP
ARCHITECTS (CANADA) INC.
700-1285 West Pender Street
Vancouver, BC V6E 4B1, Canada
tel 604 683 8797 fax 604 683 0492
ibigroup.com

PROJECT TITLE

Harris Green Village
Phase 01
1045 Yates Street
Victoria, BC

PROJECT NO:	121123
DRAWN BY:	Author
CHK'D BY:	Checker
SCALE:	1 : 150
DATE:	2021-03-05

SHEET TITLE

OPEN SITE SPACE DIAGRAM

SHEET NUMBER **A0.09**

REV

File Location: BIM 360://121123 - Yates Street – Harris Green Village Ph 1 FD2020//121123_YatesStA-Podium-2020.rvt
Last Saved: 2021-03-05 10:16:05 PM

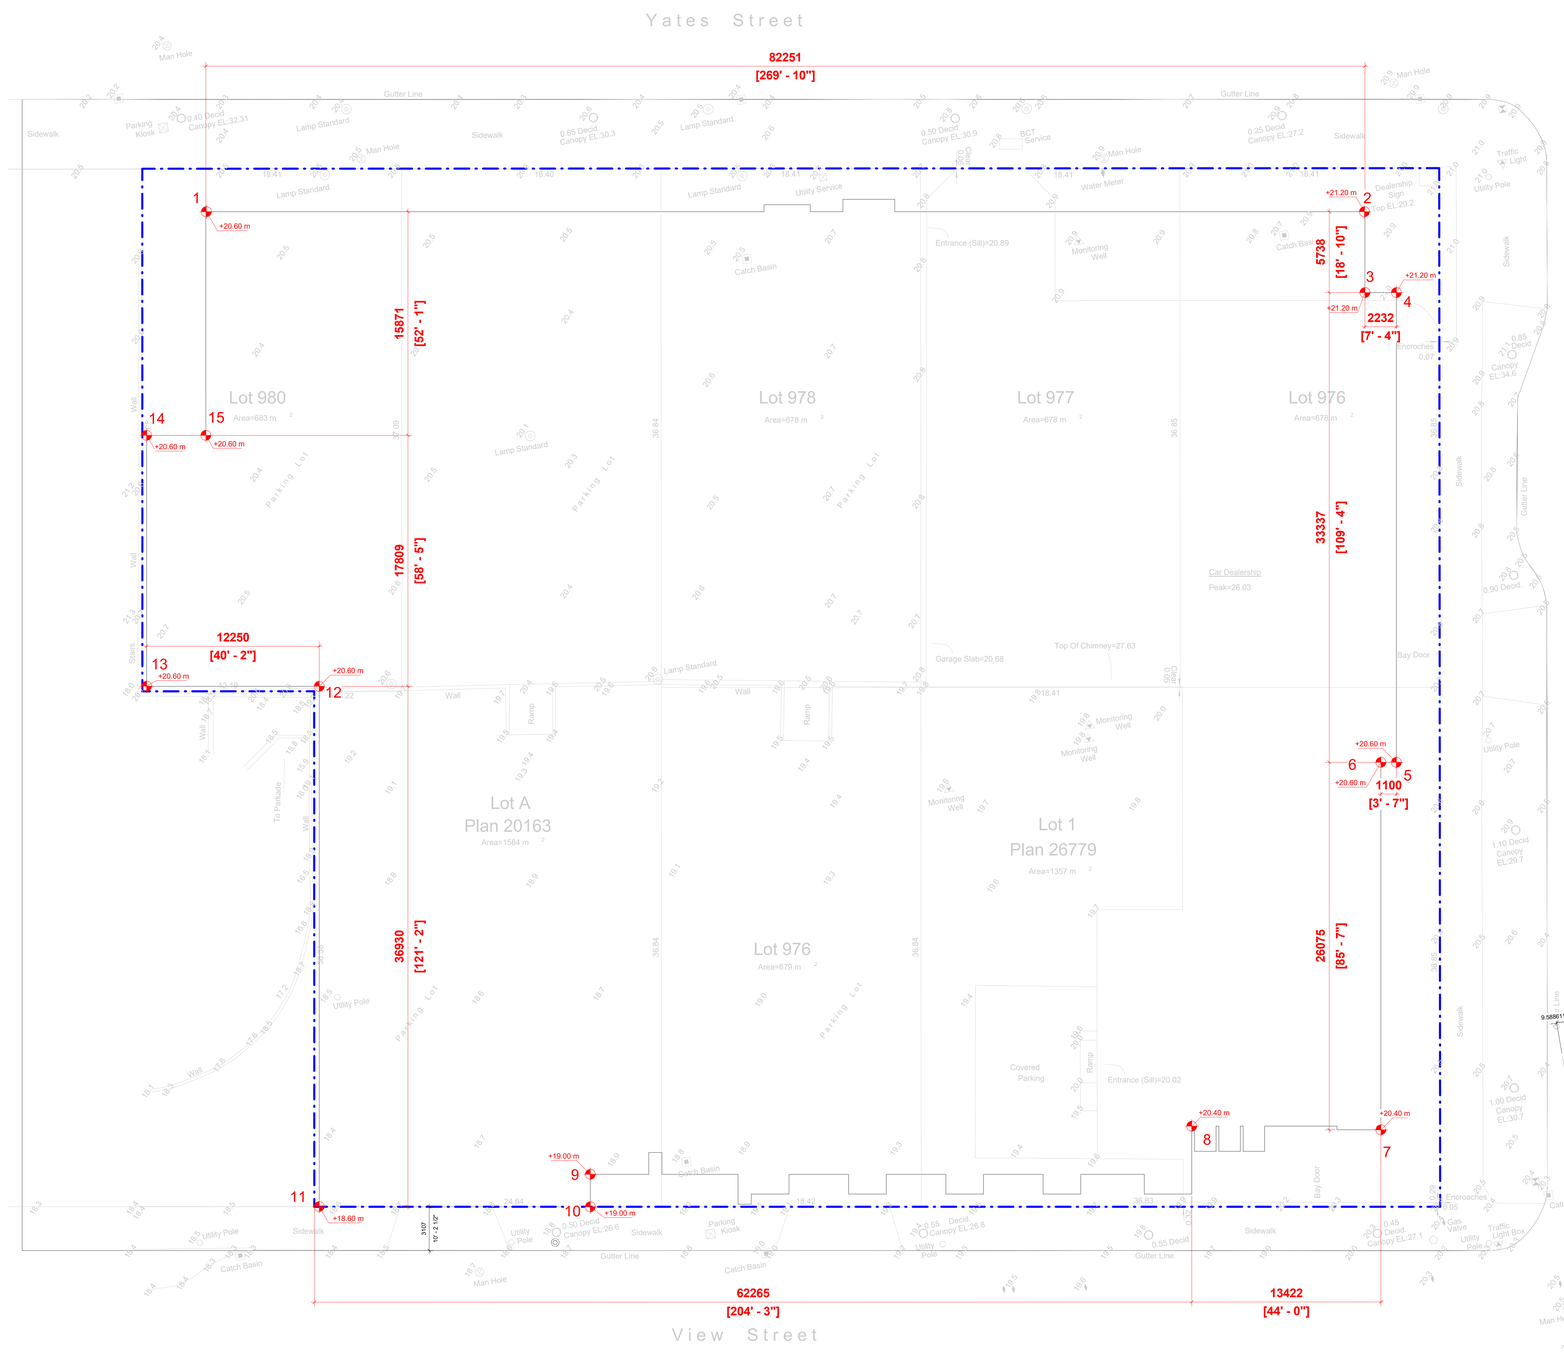

PT	HP (M)	LP (M)	HP/LP Average (M)	Distance Between Grade Points	Total
1	20.6	20.5	20.55	81529	1695803.2
2	21.2	20.9	21.05	6000	126450
3	21.2	21	21.1	2999	63278.9
4	21.2	21	21.1	45741	952556.325
5	20.6	20.5	20.55	2994	61526.7
6	20.6	20.5	20.55	13420	274439
7	20.4	20.3	20.35	17513	353324.775
8	20.4	19.6	20	41157	800503.65
9	19	18.8	18.9	4026	75890.1
10	19	18.6	18.8	15166	283604.2
11	18.6	18.6	18.6	36708	719476.8
12	20.6	20.6	20.6	9132	188347.5
13	20.6	20.7	20.65	18237	375226.275
14	20.6	20.4	20.5	15845	324822.5
15	20.6	20.4	20.5	15845	325218.625
			SUM=	326312	6620468.55

Perimeter of building =	326312

Grade Calculation =	20.28876826	20.2

CLIENT

Starlight Developments

Starlight Developments
P.O. Box 1690 Station B Mississauga, Ontario, Canada
L4Y 3W8

COPYRIGHT:
This drawing has been prepared solely for the intended use, thus any reproduction or distribution for any purpose other than authorized by IBI Group is forbidden. Written dimensions shall have precedence over scaled dimensions. Contractors shall verify and be responsible for all dimensions and conditions on the job, and IBI Group shall be informed of any variations from the dimensions and conditions shown on the drawing. Shop drawings shall be submitted to IBI Group for general conformance before proceeding with fabrication.
IBI Group Architects (Canada) Inc.
is a member of the IBI Group of companies

NO.	DATE	DESCRIPTION
1	YYYY-MM-DD	

ISSUES

NO.	DATE	DESCRIPTION

REVISIONS

Issued For: Project Status
Date: 2021-03-05

SEAL

REGISTERED ARCHITECT JOHN GWYN PROVINCE OF BRITISH COLUMBIA
2021-03-06

SUB-CONSULTANT

PRIME CONSULTANT

IBI GROUP
ARCHITECTS (CANADA) INC.
700-1285 West Pender Street,
Vancouver, BC V6E 4B1, Canada
tel 604 683 8797 fax 604 683 0492
ibigroup.com

PROJECT TITLE
Harris Green Village
Phase 01
1045 Yates Street
Victoria, BC

PROJECT NO:	121123
DRAWN BY:	Author
CHK'D BY:	Checker
SCALE:	1 : 150
DATE:	2021-03-05

SHEET TITLE
AVERAGE GRADE CALCULATION

SHEET NUMBER
A0.10

REV

Last Saved: 2021-03-05 10:16:11 PM File Location: BIM 360://121123 - Yates Street – Harris Green Village Ph I 620/20121123_YatesStA-Podium-2020.rvt

updated to match design guidelines

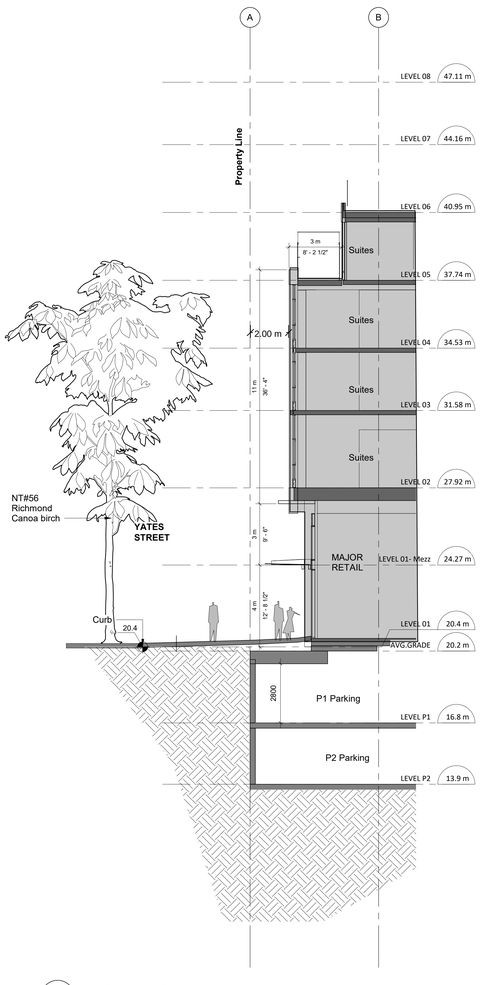

1 A0.11 A0-11_ Yates St.
SCALE: 1 : 100

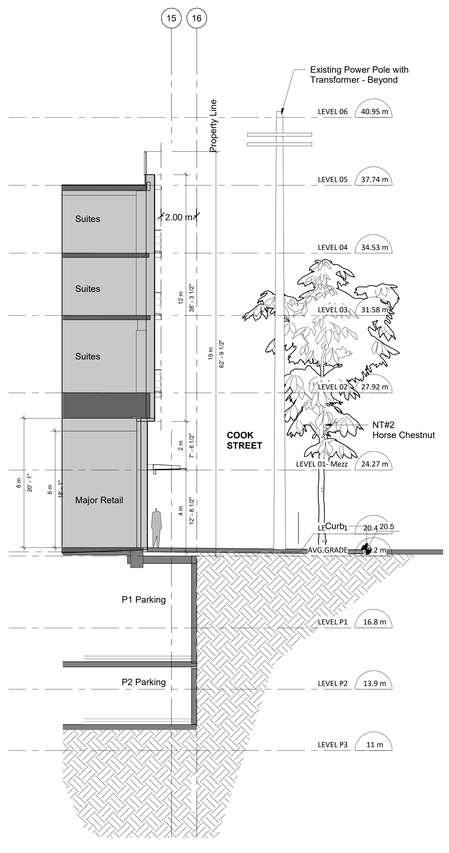

2 A0.11 A0-11_ Cook St.
SCALE: 1 : 100

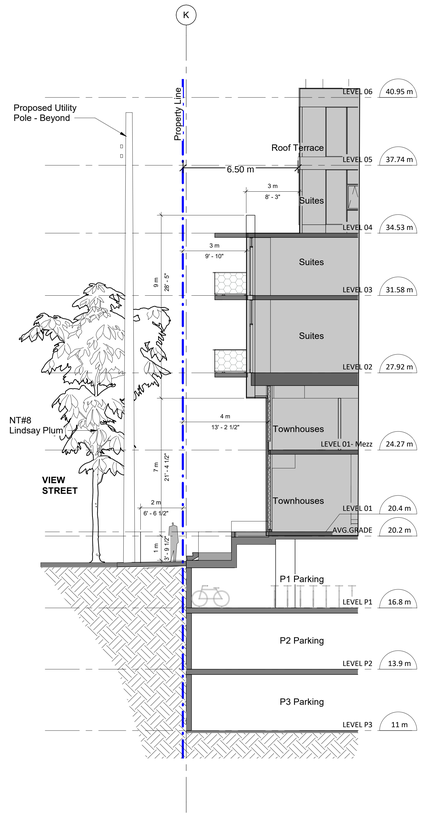

3 A0.11 A0-11_ View St
SCALE: 1 : 100

CLIENT

Starlight Developments

Starlight Developments
P.O. Box 1690 Station B Mississauga, Ontario, Canada
L4Y 3W8

COPYRIGHT:
This drawing has been prepared solely for the intended use, thus any reproduction or distribution for any purpose other than authorized by IBI Group is forbidden. Written dimensions shall have precedence over scaled dimensions. Contractors shall verify and be responsible for all dimensions and conditions on the job, and IBI Group shall be informed of any variations from the dimensions and conditions shown on the drawing. Shop drawings shall be submitted to IBI Group for general conformance before proceeding with fabrication.
IBI Group Architects (Canada) Inc.
is a member of the IBI Group of companies

NO.	DATE	DESCRIPTION
1	YYYY-MM-DD	

ISSUES

NO.	DATE	DESCRIPTION

REVISIONS

Issued For: Project Status
Date: 2021-03-05

SEAL
REGISTERED ARCHITECT JOHN GIWA BRITISH COLUMBIA
2021-03-06

SUB-CONSULTANT

PRIME CONSULTANT
IBI
IBI GROUP
ARCHITECTS (CANADA) INC.
700-1285 West Pender Street
Vancouver, BC V6E 4B1, Canada
tel 604 683 8797 fax 604 683 0492
ibigroup.com

PROJECT TITLE
Harris Green Village
Phase 01
1045 Yates Street
Victoria, BC

PROJECT NO:	121123
DRAWN BY:	Author
CHK'D BY:	Checker
SCALE:	1 : 100
DATE:	2021-03-05

SHEET TITLE
STREET SECTION

SHEET NUMBER
A0.11

REV

Last Saved: 2021-03-05 10:18:20 PM File Location: [BIM 360 / 121123 - Yates Street – Harris Green Village Ph 1 &2\20 / 21123_YatesStA-Portion-2020.rvt]

VERNAL EQUINOX - MARCH 20TH (DST)

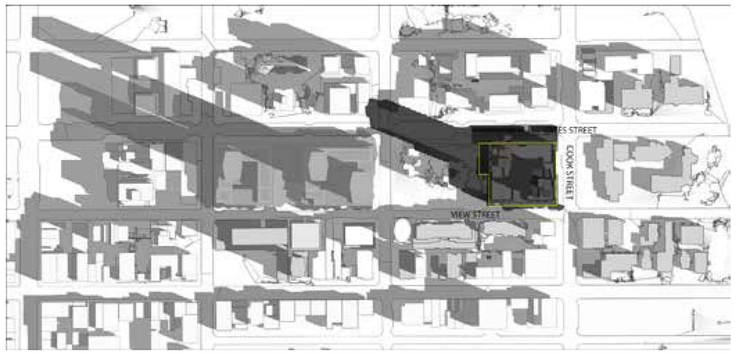

10 AM

12 PM

2 PM

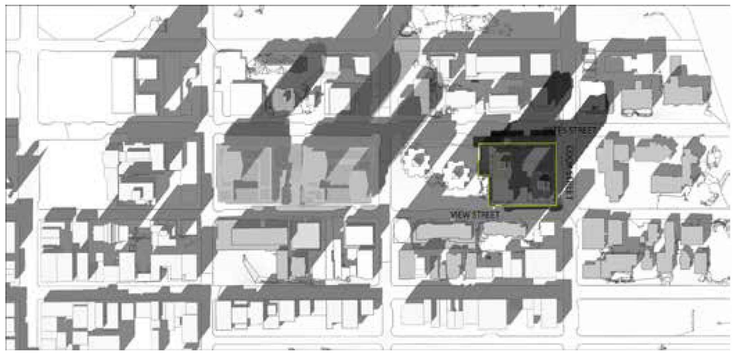

4 PM

5 PM

updated to new massing

CLIENT

Starlight Developments

Starlight Developments

P.O. Box 1690 Station B Mississauga, Ontario, Canada L4Y 3W8

COPYRIGHT:
This drawing has been prepared solely for the intended use, thus any reproduction or distribution for any purpose other than authorized by IBI Group is forbidden. Written dimensions shall have precedence over scaled dimensions. Contractors shall verify and be responsible for all dimensions and conditions on the job, and IBI Group shall be informed of any variations from the dimensions and conditions shown on the drawing. Shop drawings shall be submitted to IBI Group for general conformance before proceeding with fabrication.
IBI Group Architects (Canada) Inc.
is a member of the IBI Group of companies

NO.	DATE	DESCRIPTION
1	YYYY-MM-DD	

ISSUES

NO.	DATE	DESCRIPTION

REVISIONS

Issued For: Project Status
Date: 2021-03-05

SEAL

REGISTERED ARCHITECT JOHN GWYN BRITISH COLUMBIA
2021-03-05

SUB-CONSULTANT

PRIME CONSULTANT

IBI GROUP
ARCHITECTS (CANADA) INC.
700-1285 West Pender Street,
Vancouver, BC V6E 4B1, Canada
tel 604 683 8797 fax 604 683 0492
ibigroup.com

PROJECT TITLE
Harris Green Village Phase 01
1045 Yates Street
Victoria, BC

PROJECT NO:	121123
DRAWN BY:	Author
CHK'D BY:	Checker
SCALE:	1 : 5
DATE:	2021-03-05

SHEET TITLE
SHADOW STUDY - VERNAL EQUINOX

SHEET NUMBER
A0.12

REV

Last Saved: 2021-03-05 10:16:38 PM File Location: BIM 360://121123 - Yates Street – Harris Green Village Ph 1\2020\121123_Yates50-A-Podium-2020.rvt

SUMMER SOLSTICE - JUNE 20TH (DST)

10 AM

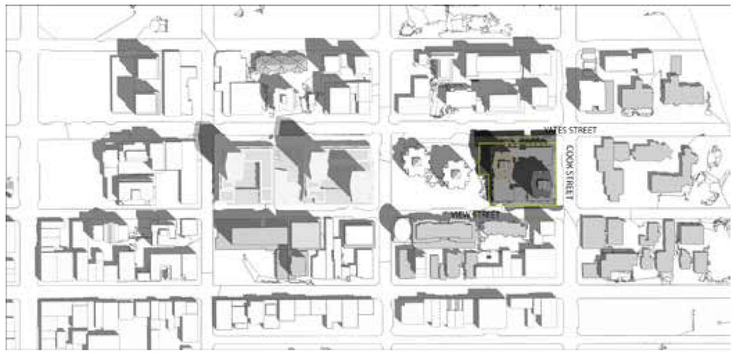

12 PM

2 PM

4 PM

5 PM

updated to new massing

CLIENT

Starlight Developments

Starlight Developments

P.O. Box 1690 Station B Mississauga, Ontario, Canada L4Y 3W8

COPYRIGHT:
This drawing has been prepared solely for the intended use, thus any reproduction or distribution for any purpose other than authorized by IBI Group is forbidden. Written dimensions shall have precedence over scaled dimensions. Contractors shall verify and be responsible for all dimensions and conditions on the job, and IBI Group shall be informed of any variations from the dimensions and conditions shown on the drawing. Shop drawings shall be submitted to IBI Group for general conformance before proceeding with fabrication.
IBI Group Architects (Canada) Inc.
is a member of the IBI Group of companies

NO.	DATE	DESCRIPTION
1	YYYY-MM-DD	

ISSUES

NO.	DATE	DESCRIPTION

REVISIONS

Issued For: Project Status

Date: 2021-03-05

SEAL

REGISTERED ARCHITECT JOHN CHRISTOPHER GNEWUCH BRITISH COLUMBIA
2021-03-06

SUB-CONSULTANT

PRIME CONSULTANT

IBI GROUP
ARCHITECTS (CANADA) INC.
700-1285 West Pender Street,
Vancouver, BC V6E 4B1, Canada
tel 604 683 8797 fax 604 683 0492
ibigroup.com

PROJECT TITLE
Harris Green Village Phase 01
1045 Yates Street
Victoria, BC

PROJECT NO:	121123
DRAWN BY:	Author
CHK'D BY:	Checker
SCALE:	1 : 5
DATE:	2021-03-05

SHEET TITLE
SHADOW STUDY - SUMMER SOLSTICE

SHEET NUMBER
A0.13

REV

Last Saved: 2021-03-05 10:15:56 PM File Location: IBM-360\121123 - Yates Street - Harris Green Village Ph 1 R2020\121123_YatesStA-Podium-2020.rvt

AUTOMNAL EQUINOX - SEPTEMBER 22ND (DST)

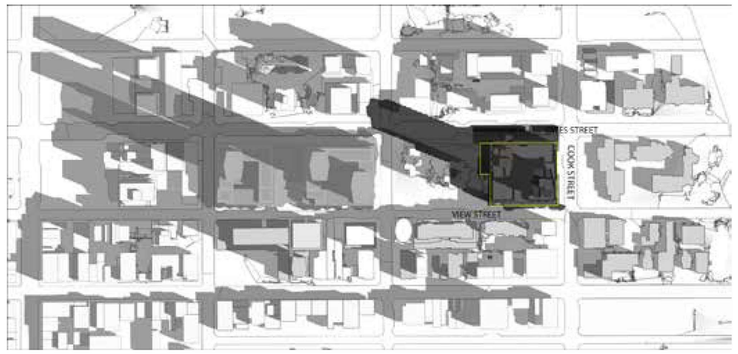

10 AM

12 PM

2 PM

4 PM

5 PM

updated to new massing

CLIENT

Starlight Developments

Starlight Developments
P.O. Box 1690 Station B Mississauga, Ontario, Canada L4Y 3W8

COPYRIGHT:
This drawing has been prepared solely for the intended use, thus any reproduction or distribution for any purpose other than authorized by IBI Group is forbidden. Written dimensions shall have precedence over scaled dimensions. Contractors shall verify and be responsible for all dimensions and conditions on the job, and IBI Group shall be informed of any variations from the dimensions and conditions shown on the drawing. Shop drawings shall be submitted to IBI Group for general conformance before proceeding with fabrication.
IBI Group Architects (Canada) Inc.
is a member of the IBI Group of companies

NO.	DATE	DESCRIPTION
1	YYYY-MM-DD	

ISSUES

NO.	DATE	DESCRIPTION

REVISIONS

Issued For: Project Status
Date: 2021-03-05

SEAL

REGISTERED ARCHITECT JOHN GIMPEL BRITISH COLUMBIA
2021-03-06

SUB-CONSULTANT

PRIME CONSULTANT

IBI GROUP
ARCHITECTS (CANADA) INC.
700-1285 West Pender Street
Vancouver, BC V6E 4B1, Canada
tel 604 683 8797 fax 604 683 0402
ibigroup.com

PROJECT TITLE
Harris Green Village Phase 01
1045 Yates Street
Victoria, BC

PROJECT NO:	121123
DRAWN BY:	Author
CHK'D BY:	Checker
SCALE:	1 : 5
DATE:	2021-03-05

SHEET TITLE
SHADOW STUDY - AUTOMNAL EQUINOX

SHEET NUMBER
A0.14

REV

Last Saved: 2021-03-05 10:17:14 PM File Location: I:\BIM-360\121123 - Yates Street - Harris Green Village Ph 1 R20\20\121123_YatesStA-Podium-2020.rvt

WINTER SOLSTICE - DECEMBER 21ST (DST)

10 AM

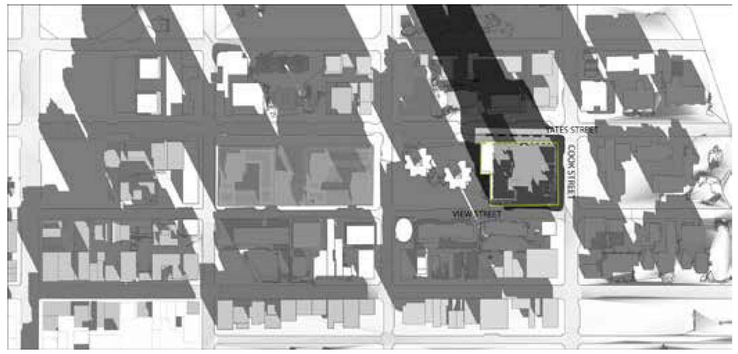

12 PM

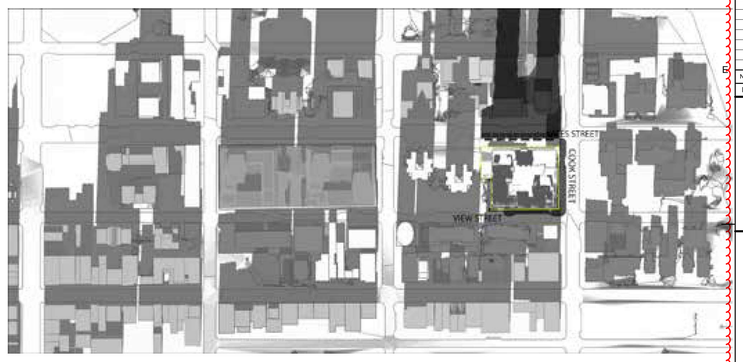

2 PM

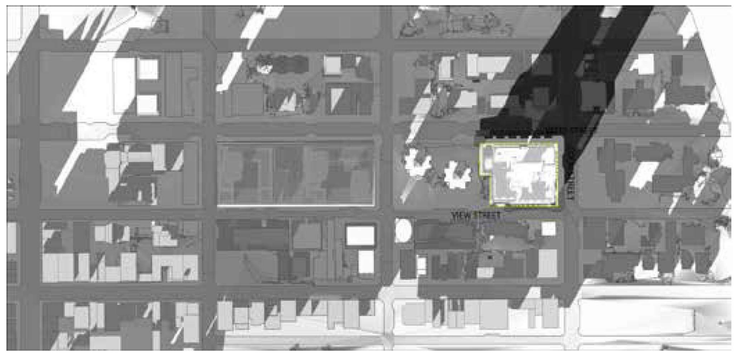

4 PM

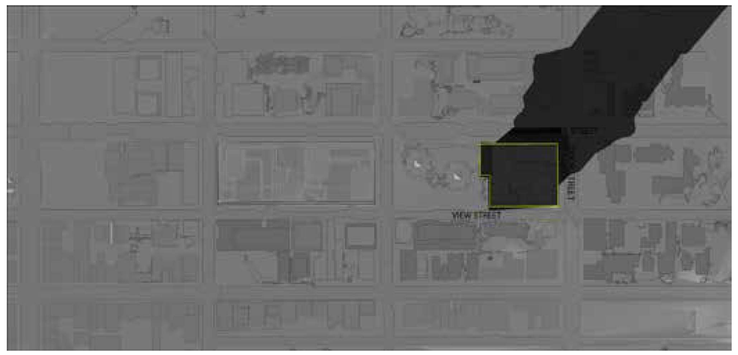

5 PM

updated to new massing

CLIENT

Starlight Developments

Starlight Developments
P.O. Box 1690 Station B Mississauga, Ontario, Canada
L4Y 3W8

COPYRIGHT:
This drawing has been prepared solely for the intended use, thus any reproduction or distribution for any purpose other than authorized by IBI Group is forbidden. Written dimensions shall have precedence over scaled dimensions. Contractors shall verify and be responsible for all dimensions and conditions on the job, and IBI Group shall be informed of any variations from the dimensions and conditions shown on the drawing. Shop drawings shall be submitted to IBI Group for general conformance before proceeding with fabrication.
IBI Group Architects (Canada) Inc.
is a member of the IBI Group of companies

NO.	DATE	DESCRIPTION
1	YYYY-MM-DD	

ISSUES

NO.	DATE	DESCRIPTION

REVISIONS

Issued For: Project Status
Date: 2021-03-05

SEAL

REGISTERED ARCHITECT
JOHN GWYN HUGHES
BRITISH COLUMBIA
2021-03-05

SUB-CONSULTANT

PRIME CONSULTANT

IBI GROUP
ARCHITECTS (CANADA) INC.
700-1285 West Pender Street
Vancouver, BC V6E 4B1, Canada
tel 604 683 8797 fax 604 683 0492
ibigroup.com

PROJECT TITLE
Harris Green Village
Phase 01
1045 Yates Street
Victoria, BC

PROJECT NO:	121123
DRAWN BY:	Author
CHK'D BY:	Checker
SCALE:	1 : 5
DATE:	2021-03-05

SHEET TITLE
SHADOW STUDY - WINTER SOLSTICE

SHEET NUMBER
A0.15

REV

Last Saved: 2021-03-05 10:17:33 PM File Location: BIM 360://121123 - Yates Street – Harris Green Village Ph 1/02000/121123_YatesStS-A-Podium-2020.rvt

Site Plan Of:
Lot A (DD 60683W) Of Lots 979 And 989, Plan 20163, And
Lot 1 Of Lots 986 And 987, Plan 26779, And
Lots 976, 977, 978, 980, 988, Victoria City.

P.I.D.'s: 003-697-983, 002-428-679,
009-387-901, 009-387-927,
009-387-943, 009-387-994,
And 009-388-036

5 4 3 2 1 0 5 10 15

Scale = 1:200

Dated this 29th day of July, 2019.

Distances and elevations shown are in metres.

Elevations are based on geodetic datum CVD28BC and derived from OCM 16-147.

This site plan is for building and design purposes and is for the exclusive use of our client.

This document shows the relative location of the surveyed structures and features with respect to the boundaries of the parcel described above. This document shall not be used to define property lines or property corners.

Legend:

- Utility Pole
- Catch Basin
- Man Hole
- Service As Noted
- Water Valve (Unless Otherwise Noted)
- Fire Hydrant
- Traffic Light Pole
- City Light Access
- Monitoring Well

Drop curbs along gutter lines are indicated as:

Strata Plan VIS2133

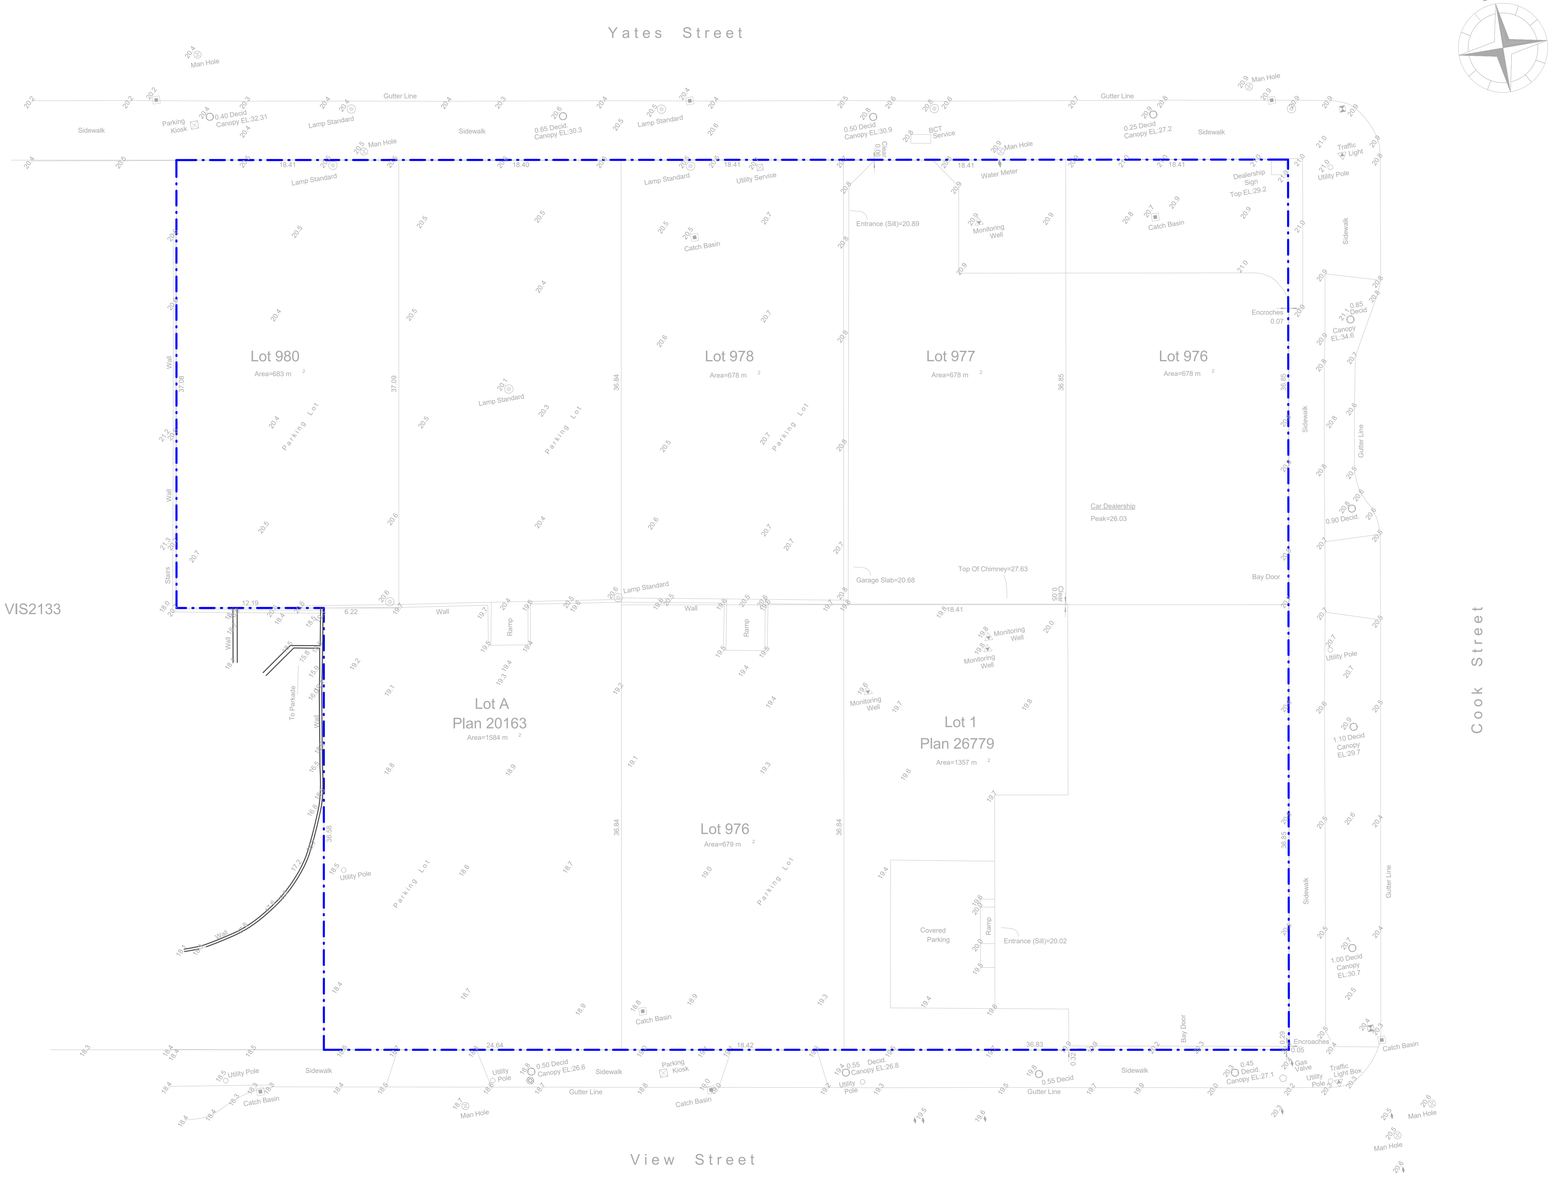

Brent Mayenburg, BCLS 910

Wey Mayenburg Land Surveying Inc.
www.weysurveys.com
#4-2227 James White Boulevard
Sidney, BC V8L 1Z5
Telephone (250) 656-5155
File: 190221\SIT\GH

CLIENT

Starlight Developments

Starlight Developments
P.O. Box 1690 Station B Mississauga, Ontario, Canada
L4Y 3W8

COPYRIGHT:
This drawing has been prepared solely for the intended use, thus any reproduction or distribution for any purpose other than authorized by IBI Group is forbidden. Written dimensions shall have precedence over scaled dimensions. Contractors shall verify and be responsible for all dimensions and conditions on the job, and IBI Group shall be informed of any variations from the dimensions and conditions shown on the drawing. Shop drawings shall be submitted to IBI Group for general conformance before proceeding with fabrication.
IBI Group Architects (Canada) Inc.
is a member of the IBI Group of companies

NO.	DATE	DESCRIPTION
1	YYYY-MM-DD	

ISSUES

NO.	DATE	DESCRIPTION

REVISIONS

Issued For: Project Status
Date: 2021-03-05

SEAL

SUB-CONSULTANT

PRIME CONSULTANT

IBI GROUP
ARCHITECTS (CANADA) INC.
700-1285 West Pender Street
Vancouver, BC V6E 4B1, Canada
tel 604 683 8797 fax 604 683 0402
ibigroup.com

PROJECT TITLE
Harris Green Village
Phase 01
1045 Yates Street
Victoria, BC

PROJECT NO:	121123
DRAWN BY:	Author
CHK'D BY:	Checker
SCALE:	1 : 175
DATE:	2021-03-05

SHEET TITLE
SURVEY

SHEET NUMBER
A0.16

REV

Last Saved: 2021-03-05 10:17:35 PM File Location: I:\BIM 360\121123 - Yates Street - Harris Green Village Ph 1 R20\20121123_Yates53-A-Podium-2020.rvt

AL-01
Wood Toned Aluminum Soffit

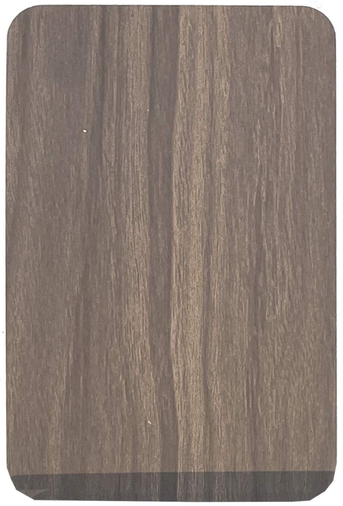

AL-02,04,G-01,02,03, GR-01,02, P-201
Aluminum - SL. Iron Mountain Grey

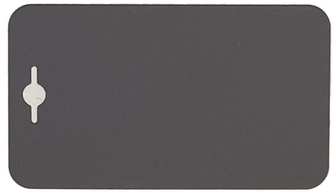

AL-03
Aluminum - SL.Light Bronze

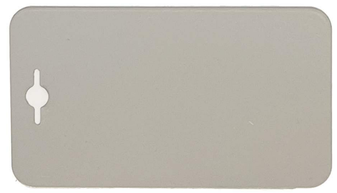

BR-01
Dark Gray Brick (Coal Creek)

BR-02
White Brick (Ivory)

BR-03
Warm Gray Brick (Pewter)

G-1
Clear Glass

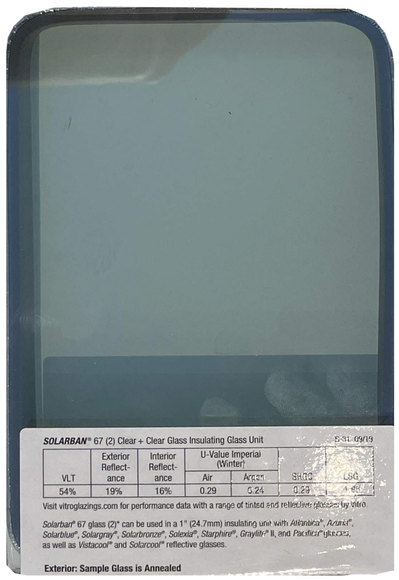

G-1
Spandrel Glass

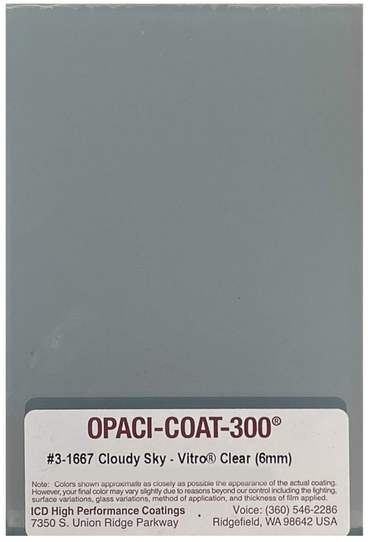

CO-01
Painted Concrete LIght Gray (BM 2120-40)

CO-02
Painted Concrete Dark Gray (BM-212010)

CLIENT

Starlight Developments

Starlight Developments
P.O. Box 1690 Station B Mississauga, Ontario, Canada
L4Y 3W8

COPYRIGHT:
This drawing has been prepared solely for the intended use, thus any reproduction or distribution for any purpose other than authorized by IBI Group is forbidden. Written dimensions shall have precedence over scaled dimensions. Contractors shall verify and be responsible for all dimensions and conditions on the job, and IBI Group shall be informed of any variations from the dimensions and conditions shown on the drawing. Shop drawings shall be submitted to IBI Group for general conformance before proceeding with fabrication.
IBI Group Architects (Canada) Inc.
is a member of the IBI Group of companies

NO.	DATE	DESCRIPTION
1	YYYY-MM-DD	

ISSUES

NO.	DATE	DESCRIPTION

REVISIONS

Issued For: Project Status
Date: 2021-03-05

SEAL

REGISTERED ARCHITECT JOHN GWYN HUGHES BRITISH COLUMBIA
2021-03-05

SUB-CONSULTANT

PRIME CONSULTANT

IBI GROUP
ARCHITECTS (CANADA) INC.
700-1285 West Pender Street,
Vancouver, BC V6E 4B1, Canada
tel 604 683 8797 fax 604 683 0492
ibigroup.com

PROJECT TITLE
Harris Green Village
Phase 01
1045 Yates Street
Victoria, BC

PROJECT NO:	121123
DRAWN BY:	Author
CHK'D BY:	Checker
SCALE:	1 : 5
DATE:	2021-03-05

SHEET TITLE
AERIAL VIEW

SHEET NUMBER
A0.17

REV

Last Saved: 2021-03-05 10:17:39 PM File Location: BIM 360://121123 - Yates Street – Harris Green Village Ph 1\2020\121123_YatesStA-Podium-2020.rvt

updated to
new massing

CLIENT

Starlight Developments

Starlight Developments

P.O. Box 1890 Station B Mississauga, Ontario, Canada
L4Y 3W8

COPYRIGHT:
This drawing has been prepared solely for the intended use, thus any reproduction or distribution for any purpose other than authorized by IBI Group is forbidden. Written dimensions shall have precedence over scaled dimensions. Contractors shall verify and be responsible for all dimensions and conditions on the job, and IBI Group shall be informed of any variations from the dimensions and conditions shown on the drawing. Shop drawings shall be submitted to IBI Group for general conformance before proceeding with fabrication.

IBI Group Architects (Canada) Inc.
is a member of the IBI Group of companies

NO.	DATE	DESCRIPTION
1	YYYY-MM-DD	

ISSUES

NO.	DATE	DESCRIPTION

REVISIONS

Issued For: Project Status

Date: 2021-03-05

SEAL

REGISTERED ARCHITECT
JOHN GIWA-AMU
PROVINCE OF BRITISH COLUMBIA
2021-03-06

SUB-CONSULTANT

PRIME CONSULTANT

IBI GROUP ARCHITECTS (CANADA) INC.
700-1285 West Pender Street,
Vancouver, BC V6E 4B1, Canada
tel 604 683 8797 fax 604 683 0402
ibigroup.com

PROJECT TITLE

Harris Green Village Phase 01

1045 Yates Street
Victoria, BC

PROJECT NO:	121123
DRAWN BY:	Author
CHK'D BY:	Checker
SCALE:	
DATE:	2021-03-05

SHEET TITLE

PRESPECTIVE VIEW FROM YATES STREET

SHEET NUMBER

A0.18

REV

File Location: IBM 360://121123 - Yates Street - Harris Green Village Ph 1 P2020/121123_YatesStA-Podium-2020.rvt

Last Saved: 2021-03-05 10:17:40 PM

updated to new massing

CLIENT

Starlight Developments

Starlight Developments
P.O. Box 1890 Station B Mississauga, Ontario, Canada
L4Y 3W8

COPYRIGHT:
This drawing has been prepared solely for the intended use, thus any reproduction or distribution for any purpose other than authorized by IBI Group is forbidden. Written dimensions shall have precedence over scaled dimensions. Contractors shall verify and be responsible for all dimensions and conditions on the job, and IBI Group shall be informed of any variations from the dimensions and conditions shown on the drawing. Shop drawings shall be submitted to IBI Group for general conformance before proceeding with fabrication.
IBI Group Architects (Canada) Inc.
is a member of the IBI Group of companies

NO.	DATE	DESCRIPTION
1	YYYY-MM-DD	

ISSUES

NO.	DATE	DESCRIPTION

REVISIONS

Issued For: Project Status
Date: 2021-03-05

SEAL

REGISTERED ARCHITECT JOHN GIWA BRITISH COLUMBIA
2021-03-06

SUB-CONSULTANT

PRIME CONSULTANT

IBI GROUP
ARCHITECTS (CANADA) INC.
700-1285 West Pender Street,
Vancouver, BC V6E 4B1, Canada
tel 604 683 8797 fax 604 683 0492
ibigroup.com

PROJECT TITLE
Harris Green Village
Phase 01
1045 Yates Street
Victoria, BC

PROJECT NO:	121123
DRAWN BY:	Author
CHKD BY:	Checker
SCALE:	
DATE:	2021-03-05

SHEET TITLE
PRESPECTIVE VIEW FROM COOK STREET

SHEET NUMBER
A0.19

REV

Last Saved: 2021-03-05 10:17:56 PM File Location: BIM 360://121123 - Yates Street – Harris Green Village Ph 1 R20/00121123_YatesStA-Podium-2020.rvt

updated to
new massing

CLIENT

Starlight Developments

Starlight Developments

P.O. Box 1890 Station B Mississauga, Ontario, Canada
L4Y 3W8

COPYRIGHT:
This drawing has been prepared solely for the intended use, thus any reproduction or distribution for any purpose other than authorized by IBI Group is forbidden. Written dimensions shall have precedence over scaled dimensions. Contractors shall verify and be responsible for all dimensions and conditions on the job, and IBI Group shall be informed of any variations from the dimensions and conditions shown on the drawing. Shop drawings shall be submitted to IBI Group for general conformance before proceeding with fabrication.

IBI Group Architects (Canada) Inc.
is a member of the IBI Group of companies

NO.	DATE	DESCRIPTION
1	YYYY-MM-DD	

ISSUES

NO.	DATE	DESCRIPTION

REVISIONS

Issued For: Project Status

Date: 2021-03-05

SEAL

REGISTERED ARCHITECT JOHN GWYN MCCOLUMBIA
2021-03-06

SUB-CONSULTANT

PRIME CONSULTANT

IBI GROUP
ARCHITECTS (CANADA) INC.
700-1285 West Pender Street
Vancouver, BC V6E 4B1, Canada
tel 604 683 8797 fax 604 683 0492
ibigroup.com

PROJECT TITLE
Harris Green Village
Phase 01
1045 Yates Street
Victoria, BC

PROJECT NO:	121123
DRAWN BY:	Author
CHK'D BY:	Checker
SCALE:	
DATE:	2021-03-05

SHEET TITLE
PRESPECTIVE VIEW FROM VIEW STREET

SHEET NUMBER
A0.20

REV

Last Saved: 2021-03-05 10:16:03 PM File Location: IBM 360 /121123 - Yates Street - Harris Green Village Ph 1 R20/01121123_Yates00-A-Podium-2020.rvt

CPTED Strategy

Following the four main principles of Crime Prevention Through Environmental Design (CPTED) the following strategies will be utilized to decrease the potential for crime in Harris Green Village. More specifc CPTED strategies will be outlined in subsequent Development Permit Applications.

1. Natural Surveillance:
Elements of site and building design can maximize opportunities for natural surveillance. This involves achieving the right mix of land uses and activity generators and designing buildings and open spaces to allow people to casually observe activities in their environment. This principle involves putting “eyes on the street” by encouraging pedestrian passage through a space or providing the opportunity for overlook from adjacent buildings and spaces.

- Provide a mix of uses at grade to ensure the presence of people at all times e.g. shops, restaurants, residential entrances, offce entrances, etc.
- Locate activity generators and/or seating options around edges to create opportunities for natural surveillance of open spaces, plazas, parks and important pedestrian thoroughfares.
- Confgure residential lobbies to provide clear sightlines from within buildings to the street so occupants can clearly see outside before leaving the building.
- Use transparent building materials such as glazing around residential entries and avoid recessed doorways without windows to eliminate entrapment spots.
- Locate visitor bicycle storage facilities near commercial and residential entrances for visibility and ease of access.
- Prepare landscape designs and follow-up maintenance plans to allow clear, unobstructed views of public areas. Landscape elements such as low ground cover and high-canopied trees with no branches below 6 feet should be considered.
- Ensure public walkways and entries are well-lit and overlooked by windows.
- Consider adding a mix of activity generators such as playgrounds, walkways, coffee kiosks and sitting areas to add ‘eyes’ on the plaza and View Street Green.
- Use glazed doors in stairwells and parkade lobbies to reduce hiding places, open up views of the parking areas and use a white or a light colour paint scheme and elimination of sharp corners to reduce concealment opportunities
- Avoid creating “dead zones” where there is little activity or signs of human presence.

2. Legibility/Access Control:
Legibility and access control work together to allow people to move with confdence and ease through the urban environment. Legibility means that people know where they are and how to get where they are going. Access control reinforces legibility by creating clear design cues about what is the public realm and what is not.

- Ensure important services and signs are strategically located and clearly visible.
- Create local landmarks by drawing attention to features such as public art, public squares, or important buildings.
- Use elements such as paving, lighting and landscaping to clearly guide the public to and from entrances and exits.
- Provide adequate lighting around the perimeter of buildings, in plaza spaces and in parkades and common areas.
- Secure all residential entrances including bicycle storage rooms with FOB doors.
- Install gates at parkade entrances, with secondary gates separating commercial from residential parking areas.
- Provide mirrors in parkades to help users “see around corners”.
- Provide adequate lighting and sightlines to loading areas, parkade entrances and other areas where natural surveillance is reduced.
- Effective lighting should illuminate points of entry, be vandal resistant, give off limited glare, and be automatic such as motion-sensitive lighting fxtures.

3. Image/Maintenance:
If an environment shows signs of neglect or vandalism people are more inclined to engage in unwelcome or criminal behaviour. By enhancing and maintaining the physical appearance of the urban environment it is possible to encourage users of the area to respect their surroundings. Well used and cared-for public spaces encourage ownership and support community pride.

- Design the built environment with materials and fttings that will hold up to heavy use by the public.
- Use fnishes that are resistant to vandalism and are easy to clean, repair or replace.
- Avoid long expanses of light coloured walls that may attract graffti artists.
- Source tamper-proof lighting fxtures.

4. Territoriality/Ownership:
Clearly differentiating and demarcating public space from private space reduces the risk of unintentionally trespassing or being trespassed upon.

- Design symbolic barriers through landscaping e.g. changes in paving stone patterns and colour, changes in types of planting, changes in grades and use of transparent fences around residential entrances.
- Provide spaces around buildings so residents can meet and develop a sense of ownership of their common spaces, e.g. fountains, benches, playgrounds, arches, seating walls.

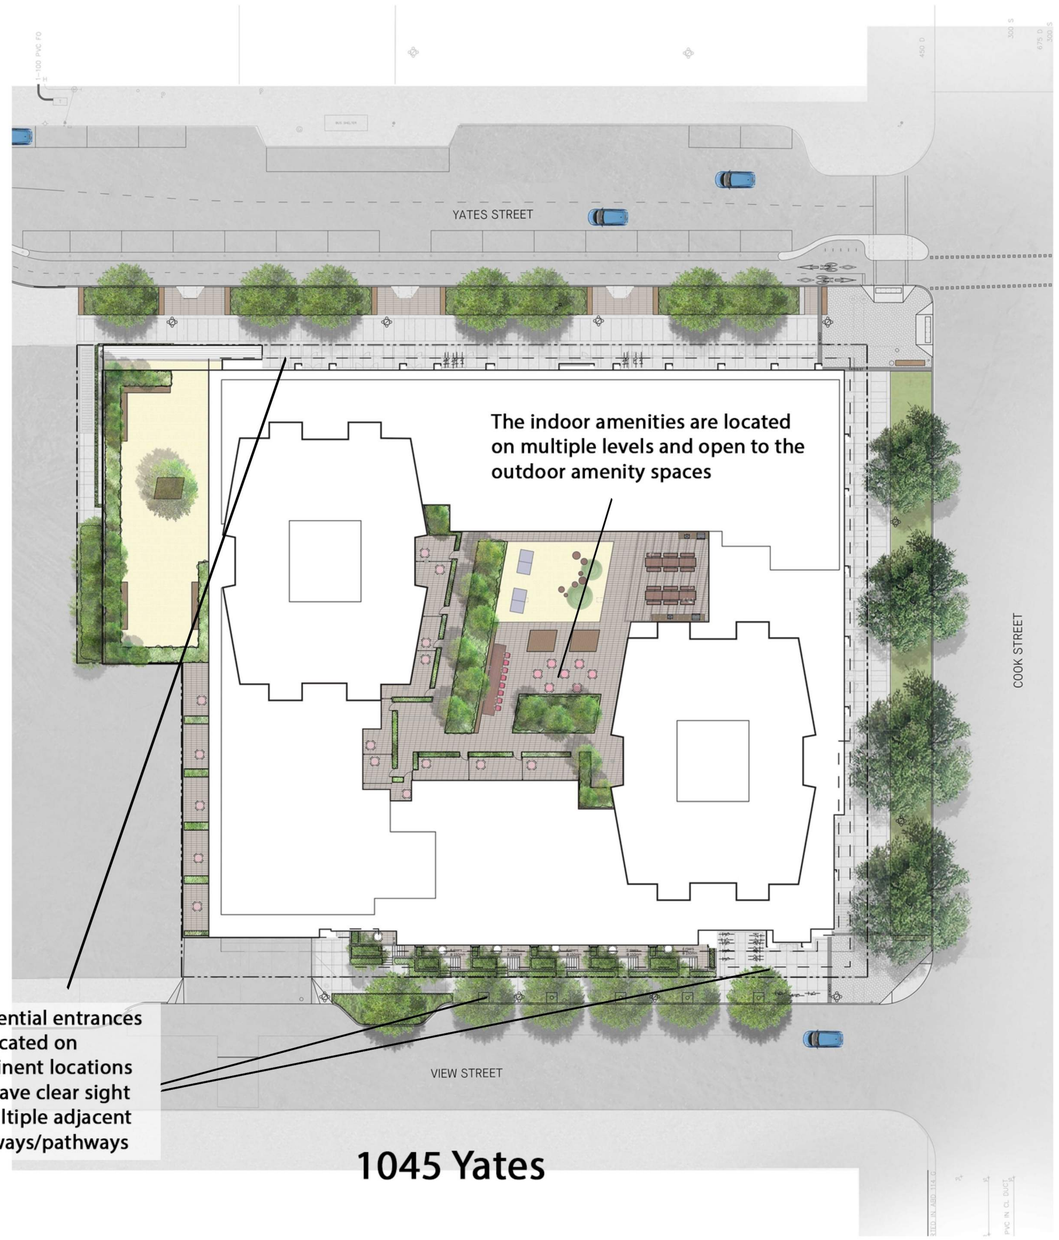

CLIENT
Starlight Developments

Starlight Developments
P.O. Box 1890 Station B Mississauga, Ontario, Canada L4Y 3W9

COPYRIGHT:
This drawing has been prepared solely for the intended use, thus any reproduction or distribution for any purpose other than authorized by IBI Group is forbidden. Written dimensions shall have precedence over scaled dimensions. Contractors shall verify and be responsible for all dimensions and conditions on the job, and IBI Group shall be informed of any variations from the dimensions and conditions shown on the drawing. Shop drawings shall be submitted to IBI Group for general conformance before proceeding with fabrication.
IBI Group Architects (Canada) Inc.
is a member of the IBI Group of companies

NO.	DATE	DESCRIPTION
1	YYYY-MM-DD	

ISSUES

NO.	DATE	DESCRIPTION

REVISIONS

Issued For: Project Status
Date: 2021-03-05

SEAL
REGISTERED ARCHITECT JOHN GIWA-AMU BRITISH COLUMBIA
2021-03-06

SUB-CONSULTANT

PRIME CONSULTANT
IBI GROUP
ARCHITECTS (CANADA) INC.
700-1285 West Pender Street
Vancouver, BC V6E 4B1, Canada
tel 604 683 8797 fax 604 683 0492
ibigroup.com

PROJECT TITLE
Harris Green Village Phase 01
1045 Yates Street
Victoria, BC

PROJECT NO:	121123
DRAWN BY:	Author
CHK'D BY:	Checker
SCALE:	
DATE:	2021-03-05

SHEET TITLE
CPTED STRATEGY

SHEET NUMBER
A0.21

REV

File Location: BIM 360://121123 - Yates Street - Harris Green Village Ph 1 R22021/121123_YatesSt-A-Perkins-2020.rvt
Last Saved: 2021-03-05 10:18:23 PM

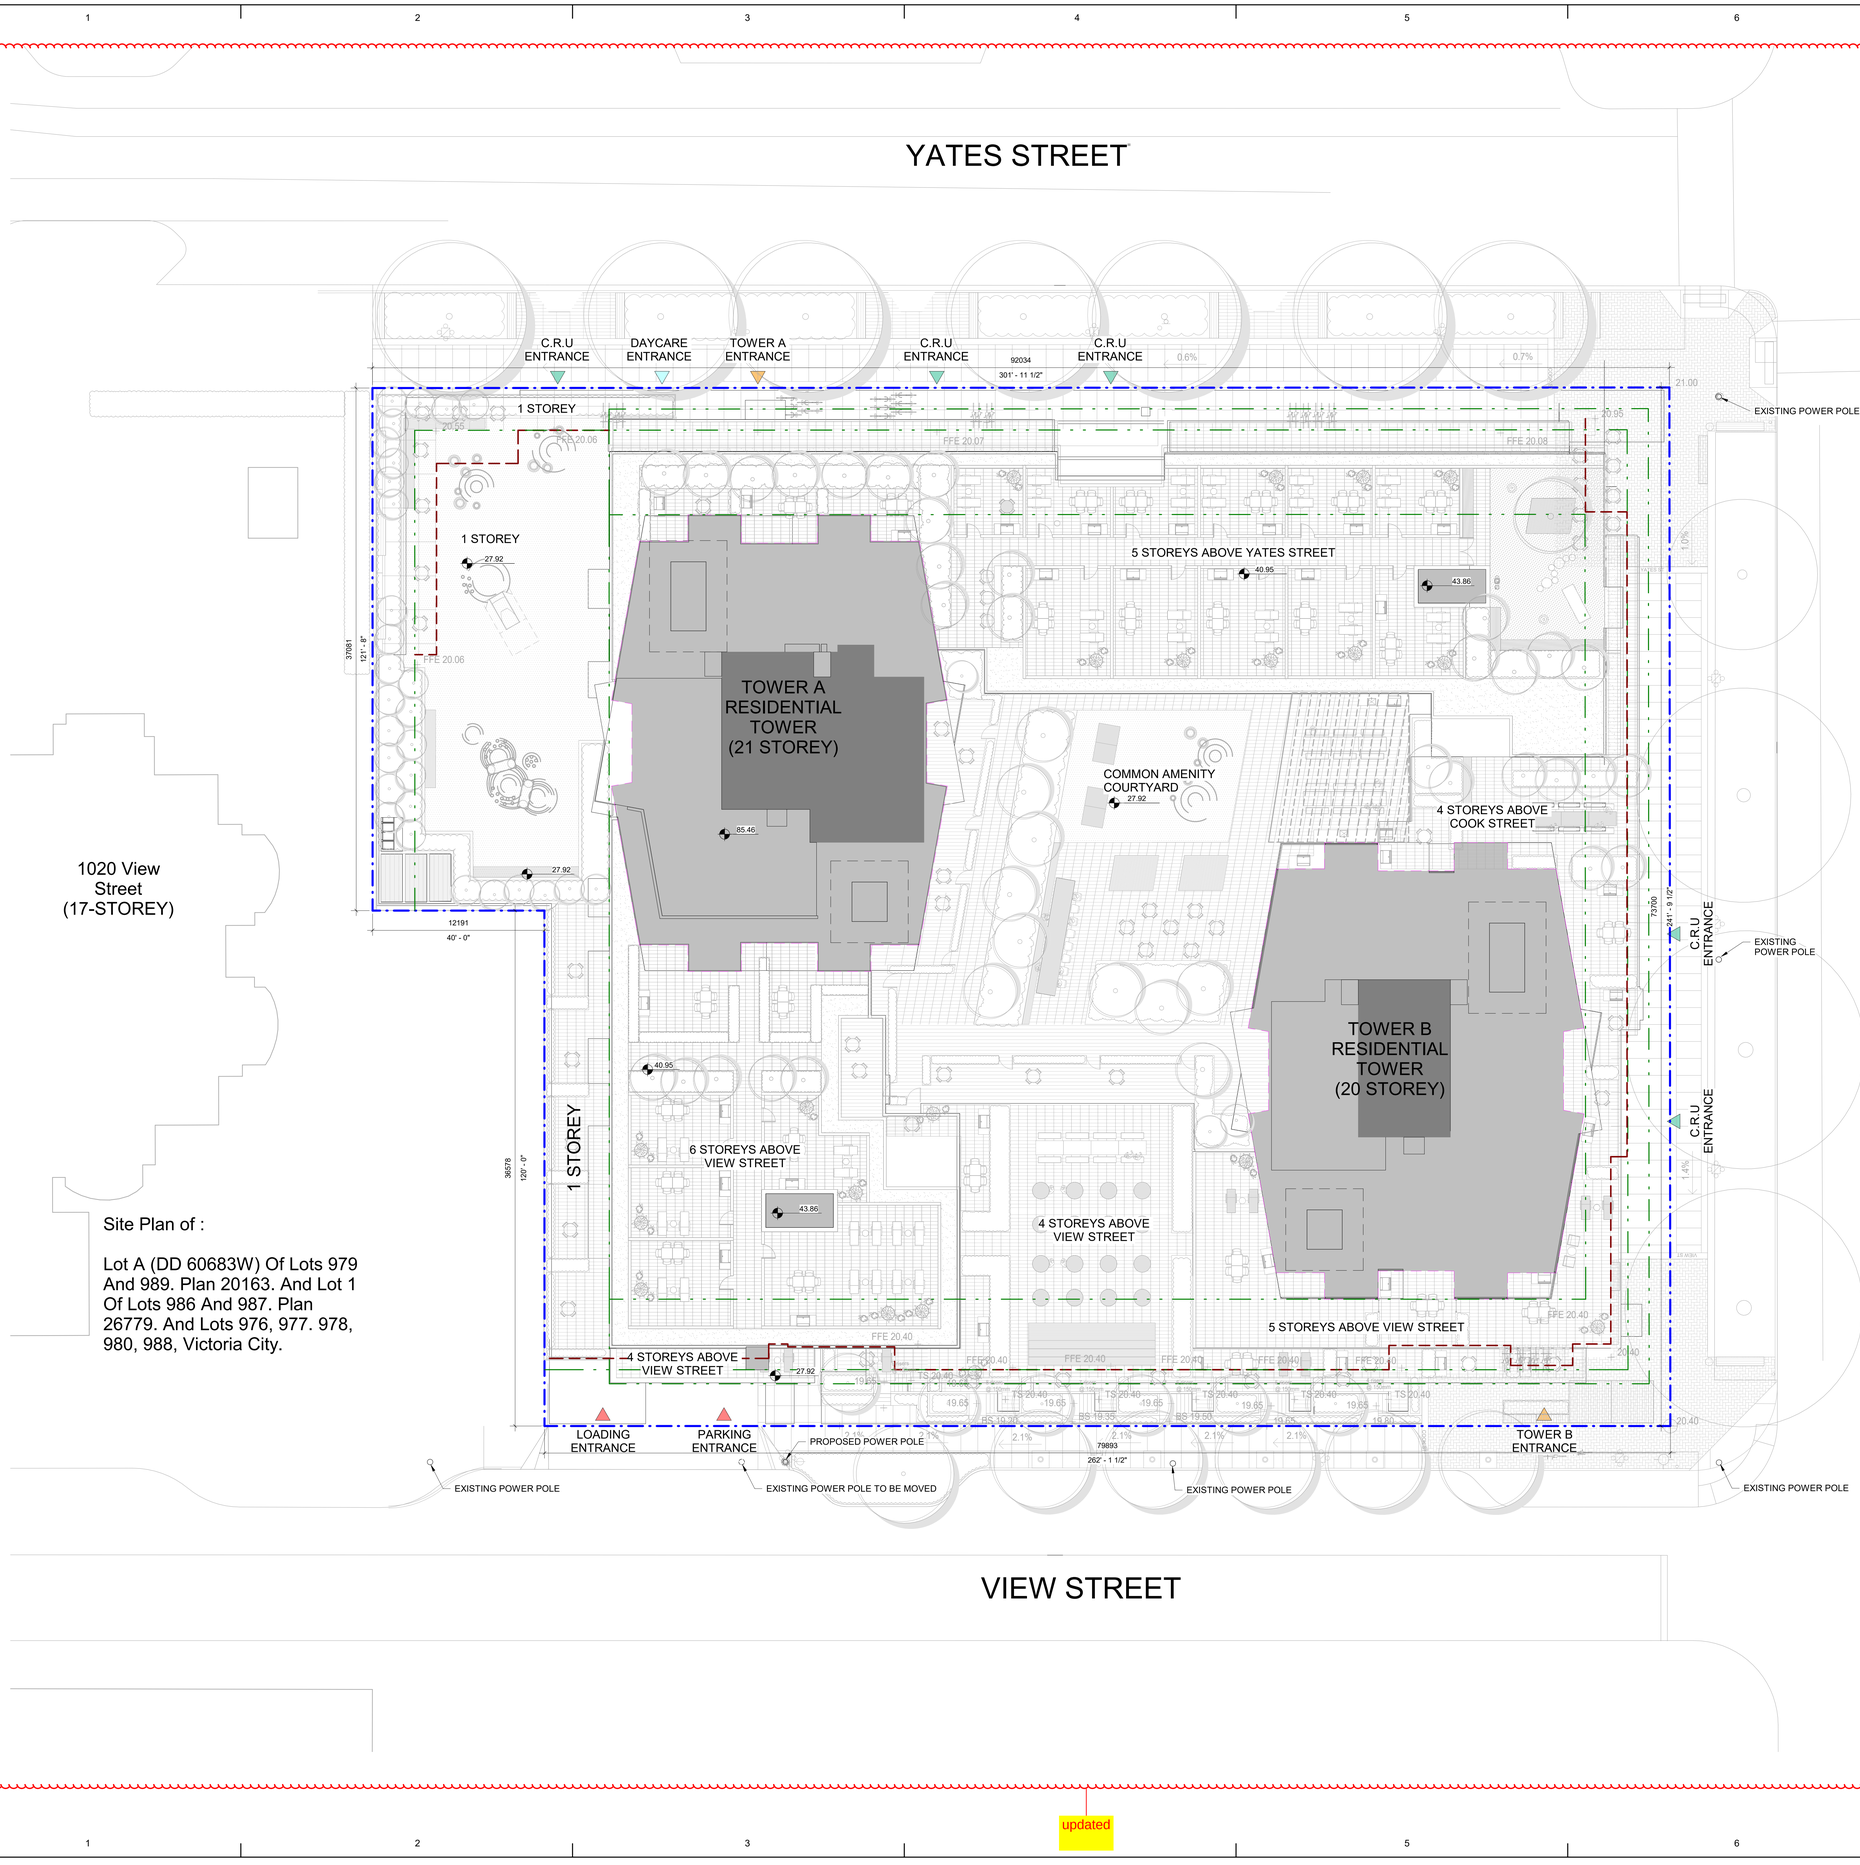

Site Plan of :

Lot A (DD 60683W) Of Lots 979 And 989. Plan 20163. And Lot 1 Of Lots 986 And 987. Plan 26779. And Lots 976, 977. 978, 980, 988, Victoria City.

updated

CLIENT

Starlight Developments

Starlight Developments
P.O. Box 1690 Station B Mississauga, Ontario, Canada
L4Y 3W8

COPYRIGHT:
This drawing has been prepared solely for the intended use, thus any reproduction or distribution for any purpose other than authorized by IBI Group is forbidden. Written dimensions shall have precedence over scaled dimensions. Contractors shall verify and be responsible for all dimensions and conditions on the job, and IBI Group shall be informed of any variations from the dimensions and conditions shown on the drawing. Shop drawings shall be submitted to IBI Group for general conformance before proceeding with fabrication.
IBI Group Architects (Canada) Inc.
is a member of the IBI Group of companies

NO.	DATE	DESCRIPTION
1	YYYY-MM-DD	

ISSUES

NO.	DATE	DESCRIPTION

REVISIONS

PROJECT NORTH
N

Issued For: Project Status
Date: 2021-03-05

SEAL

REGISTERED ARCHITECT JOHN GIWA-AMU BRITISH COLUMBIA
2021-03-06

SUB-CONSULTANT

PRIME CONSULTANT

IBI GROUP ARCHITECTS (CANADA) INC.
700-1285 West Pender Street,
Vancouver, BC V6E 4B1, Canada
tel 604 683 8797 fax 604 683 0492
ibigroup.com

PROJECT TITLE
Harris Green Village Phase 01
1045 Yates Street
Victoria, BC

PROJECT NO:	121123
DRAWN BY:	Author
CHK'D BY:	Checker
SCALE:	1 : 150
DATE:	2021-03-05

SHEET TITLE
SITE PLAN

SHEET NUMBER
A1.00

REV

Last Saved: 2021-03-05 10:18:44 PM File Location: BIM 360://121123 - Yates Street – Harris Green Village Ph 1 f3D200//121123_YatesStA-Podium-2020.rvt

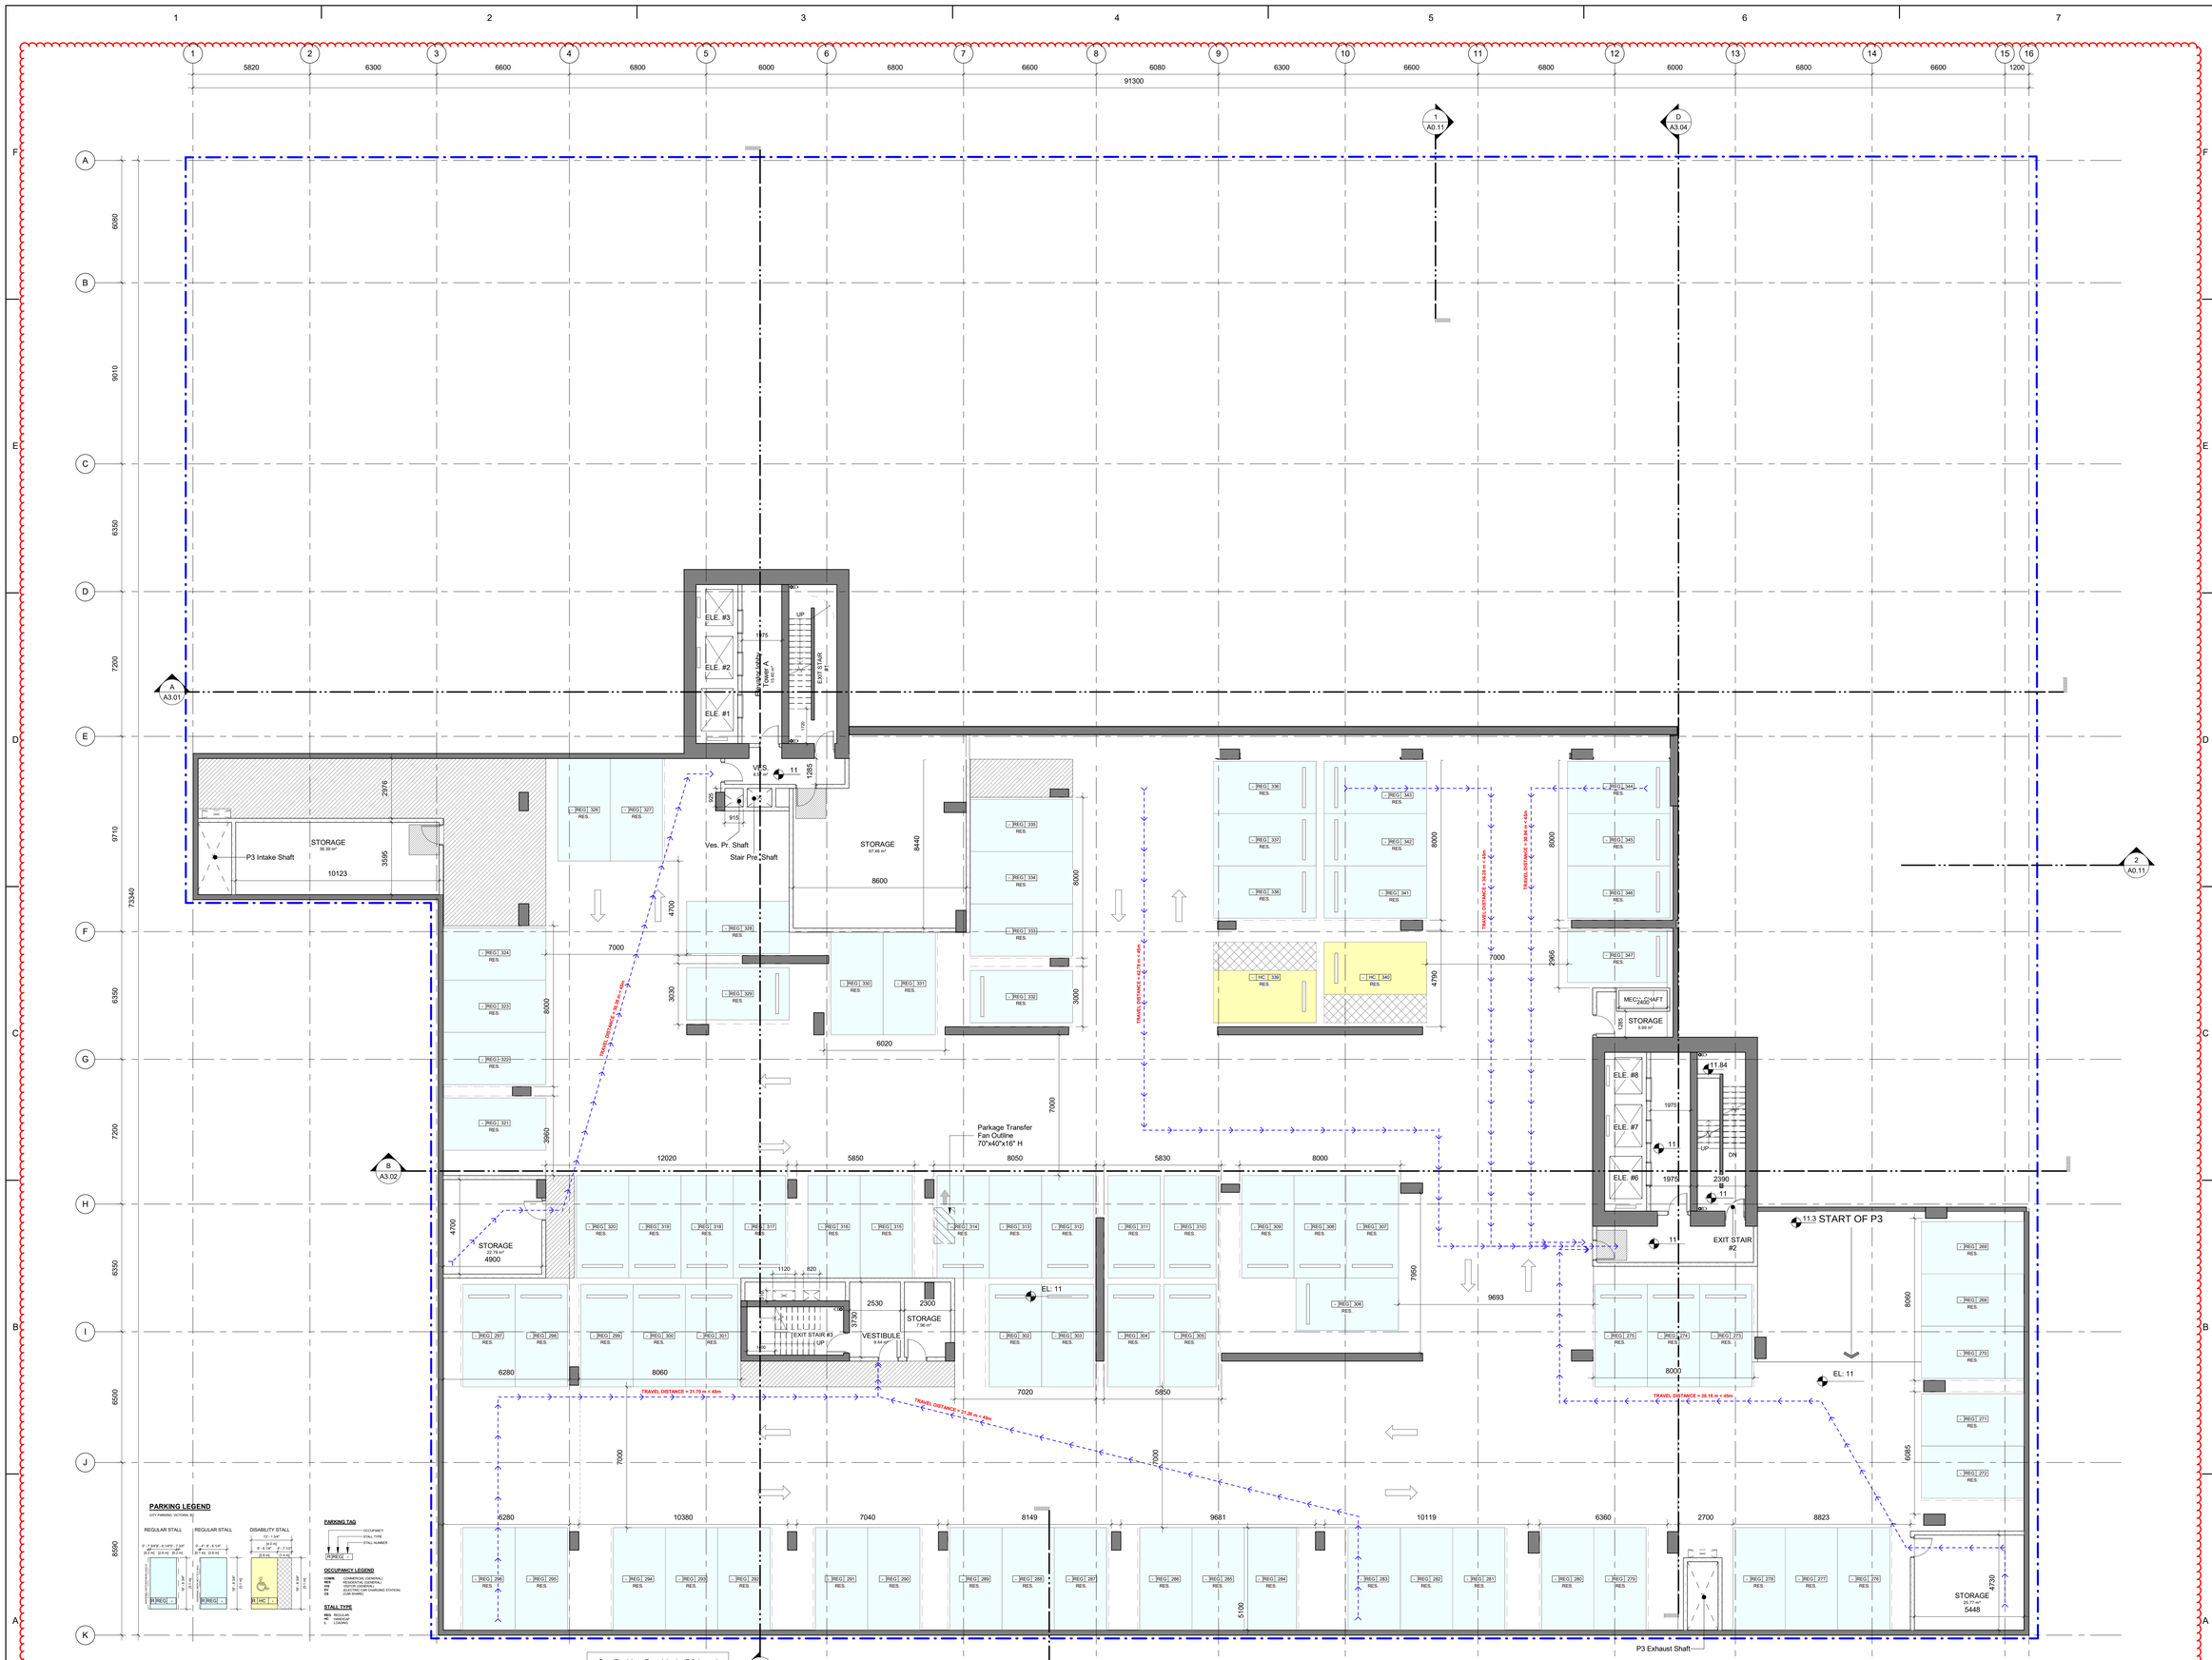

PARKING LEGEND

CITY PARKING: VICTORIA, BC

REGULAR STALL | REGULAR STALL | DISABILITY STALL

PARKING TAG

OCCUPANCY
STALL TYPE
STALL NUMBER

OCCUPANCY LEGEND

COMM	COMMERCIAL (GENERAL)
RES	RESIDENTIAL (GENERAL)
VIS	VISITOR (GENERAL)
EV	ELECTRIC CAR CHARGING STATION)
CS	CAR SHARE)

STALL TYPE

REG	REGULAR
HC	HANDICAP
L	LOADING

Car Parking Provided - P3 Level	
Count	Type
2	Handicap - Res.
77	Regular Stall - Res.

79 parking on P3

CLIENT

Starlight Developments

Starlight Developments

P.O. Box 1690 Station B Mississauga, Ontario, Canada L4Y 3W8

COPYRIGHT:
This drawing has been prepared solely for the intended use, thus any reproduction or distribution for any purpose other than authorized by IBI Group is forbidden. Written dimensions shall have precedence over scaled dimensions. Contractors shall verify and be responsible for all dimensions and conditions on the job, and IBI Group shall be informed of any variations from the dimensions and conditions shown on the drawing. Shop drawings shall be submitted to IBI Group for general conformance before proceeding with fabrication.

IBI Group Architects (Canada) Inc.
is a member of the IBI Group of companies

NO.	DATE	DESCRIPTION
1	YYYY-MM-DD	

ISSUES

NO.	DATE	DESCRIPTION

REVISIONS

PROJECT NORTH

N

Issued For: Project Status
Date: 2021-03-05

SEAL

REGISTERED ARCHITECT JOHN GWYN VOLLETT BRITISH COLUMBIA
2021.03.06

SUB-CONSULTANT

PRIME CONSULTANT

IBI GROUP
ARCHITECTS (CANADA) INC.
700-1285 West Pender Street
Vancouver, BC V6E 4B1, Canada
tel 604 683 8797 fax 604 683 0492
ibigroup.com

PROJECT TITLE
Harris Green Village
Phase 01
1045 Yates Street
Victoria, BC

PROJECT NO:	121123
DRAWN BY:	NV
CHK'D BY:	GV
SCALE:	As indicated
DATE:	2021-03-05

SHEET TITLE
OVERALL LEVEL P3 PLAN

SHEET NUMBER
A1.01

REV

Last Saved: 2021-03-05 10:15:52 PM File Location: I:\BIM 360\121123 - Yates Street - Harris Green Village Ph 1 B2020\121123_Yates53-A-Podium-2020.rvt

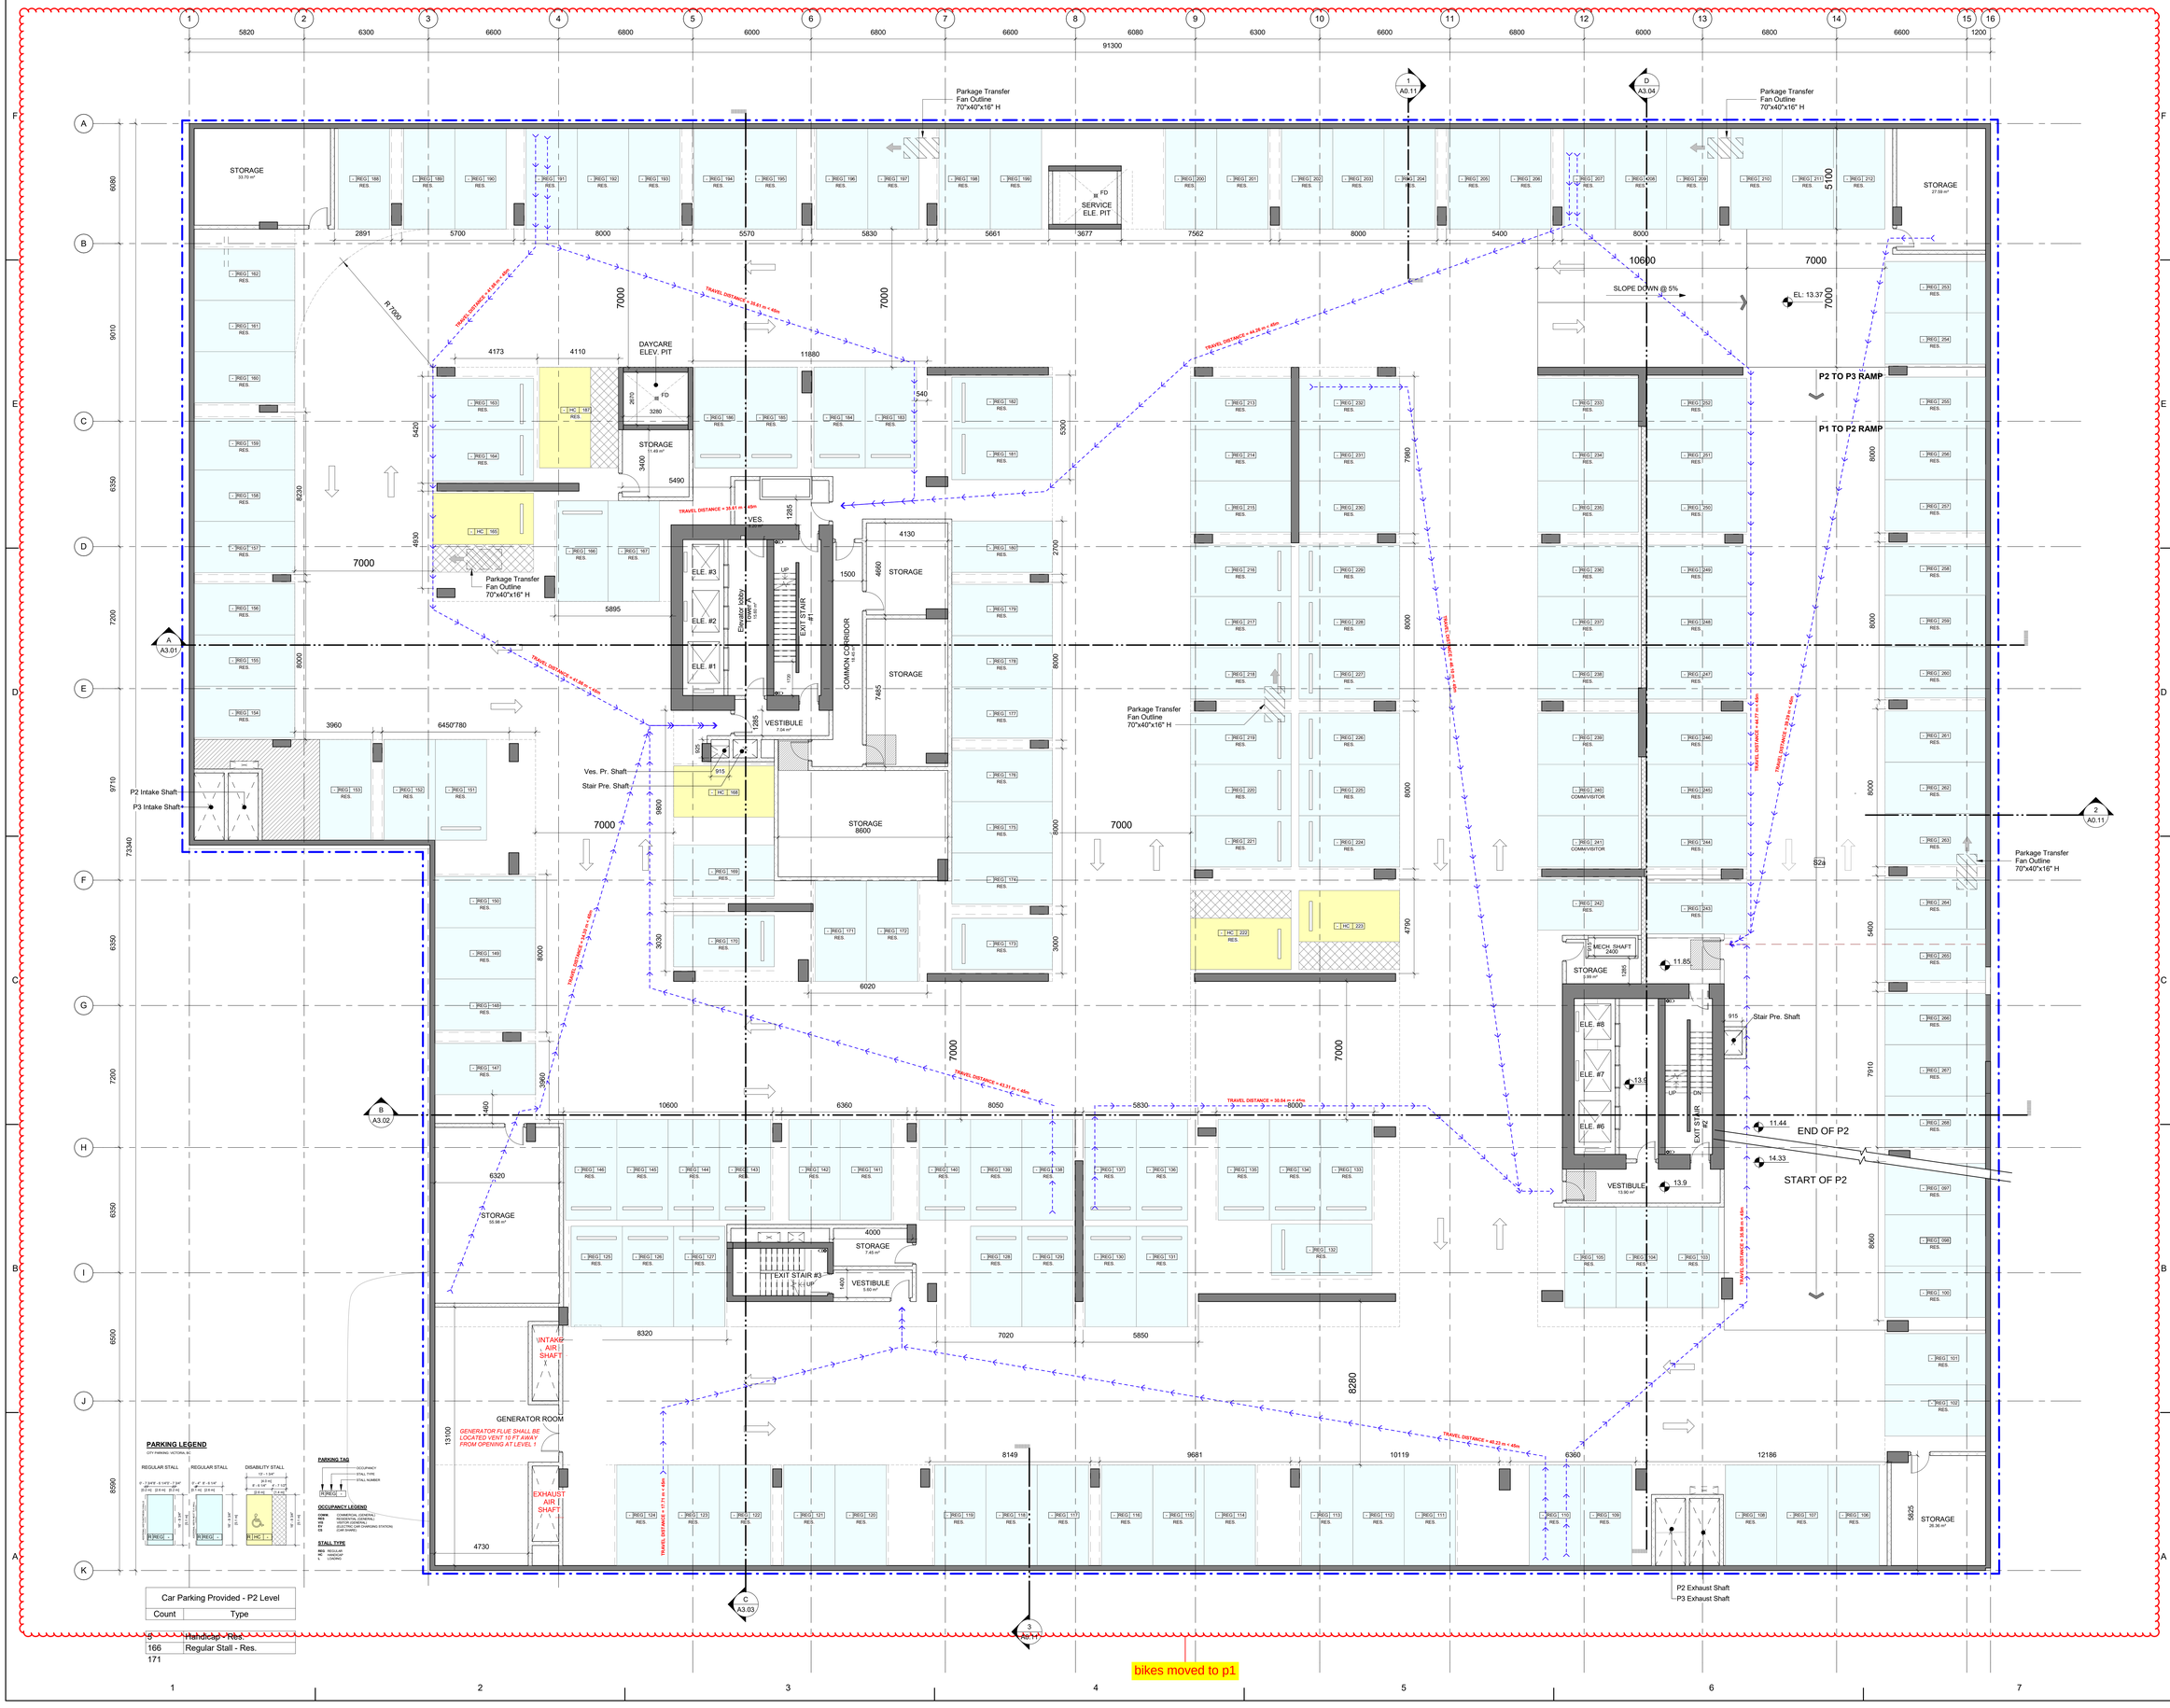

PARKING LEGEND

CITY PARKING: VICTORIA, BC

REGULAR STALL — 2.7 - 3.9 m/9' - 6 1/2" - 7'-3/4" (2.7 m) (2.8 m) (3.7 m)

REGULAR STALL — 5'-4" (2.6 m) 8' - 6 1/4" (2.6 m) (2.8 m)

DISABILITY STALL — 13' - 1 3/4" (4.0 m) 8' - 6 1/4" (2.6 m) 8' - 2 1/2" (2.5 m)

PARKING TAG

OCCUPANCY
STALL TYPE
STALL NUMBER

OCCUPANCY LEGEND

COMM. — COMMERCIAL (GENERAL)
RES. — RESIDENTIAL (GENERAL)
VIS — VISITOR (GENERAL)
EV — ELECTRIC CAR CHARGING STATION)
CAR SHARE

STALL TYPE

REG — REGULAR
HC — HANDICAP
L — LOADING

Car Parking Provided - P2 Level	
Count	Type
166	Regular Stall - Res.
171	

CLIENT

Starlight Developments

Starlight Developments
P.O. Box 1690 Station B Mississauga, Ontario, Canada L4Y 3W8

COPYRIGHT:
This drawing has been prepared solely for the intended use, thus any reproduction or distribution for any purpose other than authorized by IBI Group is forbidden. Written dimensions shall have precedence over scaled dimensions. Contractors shall verify and be responsible for all dimensions and conditions on the job, and IBI Group shall be informed of any variations from the dimensions and conditions shown on the drawing. Shop drawings shall be submitted to IBI Group for general conformance before proceeding with fabrication.

IBI Group Architects (Canada) Inc.
is a member of the IBI Group of companies

NO.	DATE	DESCRIPTION
1	YYYY-MM-DD	

ISSUES

NO.	DATE	DESCRIPTION

REVISIONS

PROJECT NORTH

Issued For: Project Status
Date: 2021-03-05

SEAL

REGISTERED ARCHITECT JOHN GWYN WILLIAMS BRITISH COLUMBIA
2021.03.06

SUB-CONSULTANT

PRIME CONSULTANT

IBI GROUP
ARCHITECTS (CANADA) INC.
700-1285 West Pender Street
Vancouver, BC V6E 4B1, Canada
tel 604 683 8797 fax 604 683 0402
ibigroup.com

PROJECT TITLE
Harris Green Village Phase 01
1045 Yates Street
Victoria, BC

PROJECT NO:	121123
DRAWN BY:	
CHK'D BY:	
SCALE:	As indicated
DATE:	2021-03-05

SHEET TITLE
OVERALL LEVEL P2 PLAN

SHEET NUMBER
A1.02

REV

Last Saved: 2021-03-05 10:19:01 PM File Location: I:\BIM-360\121123 - Yates Street - Harris Green Village Ph 1 B2020\121123_Yates\3A-Podium-2020.rvt

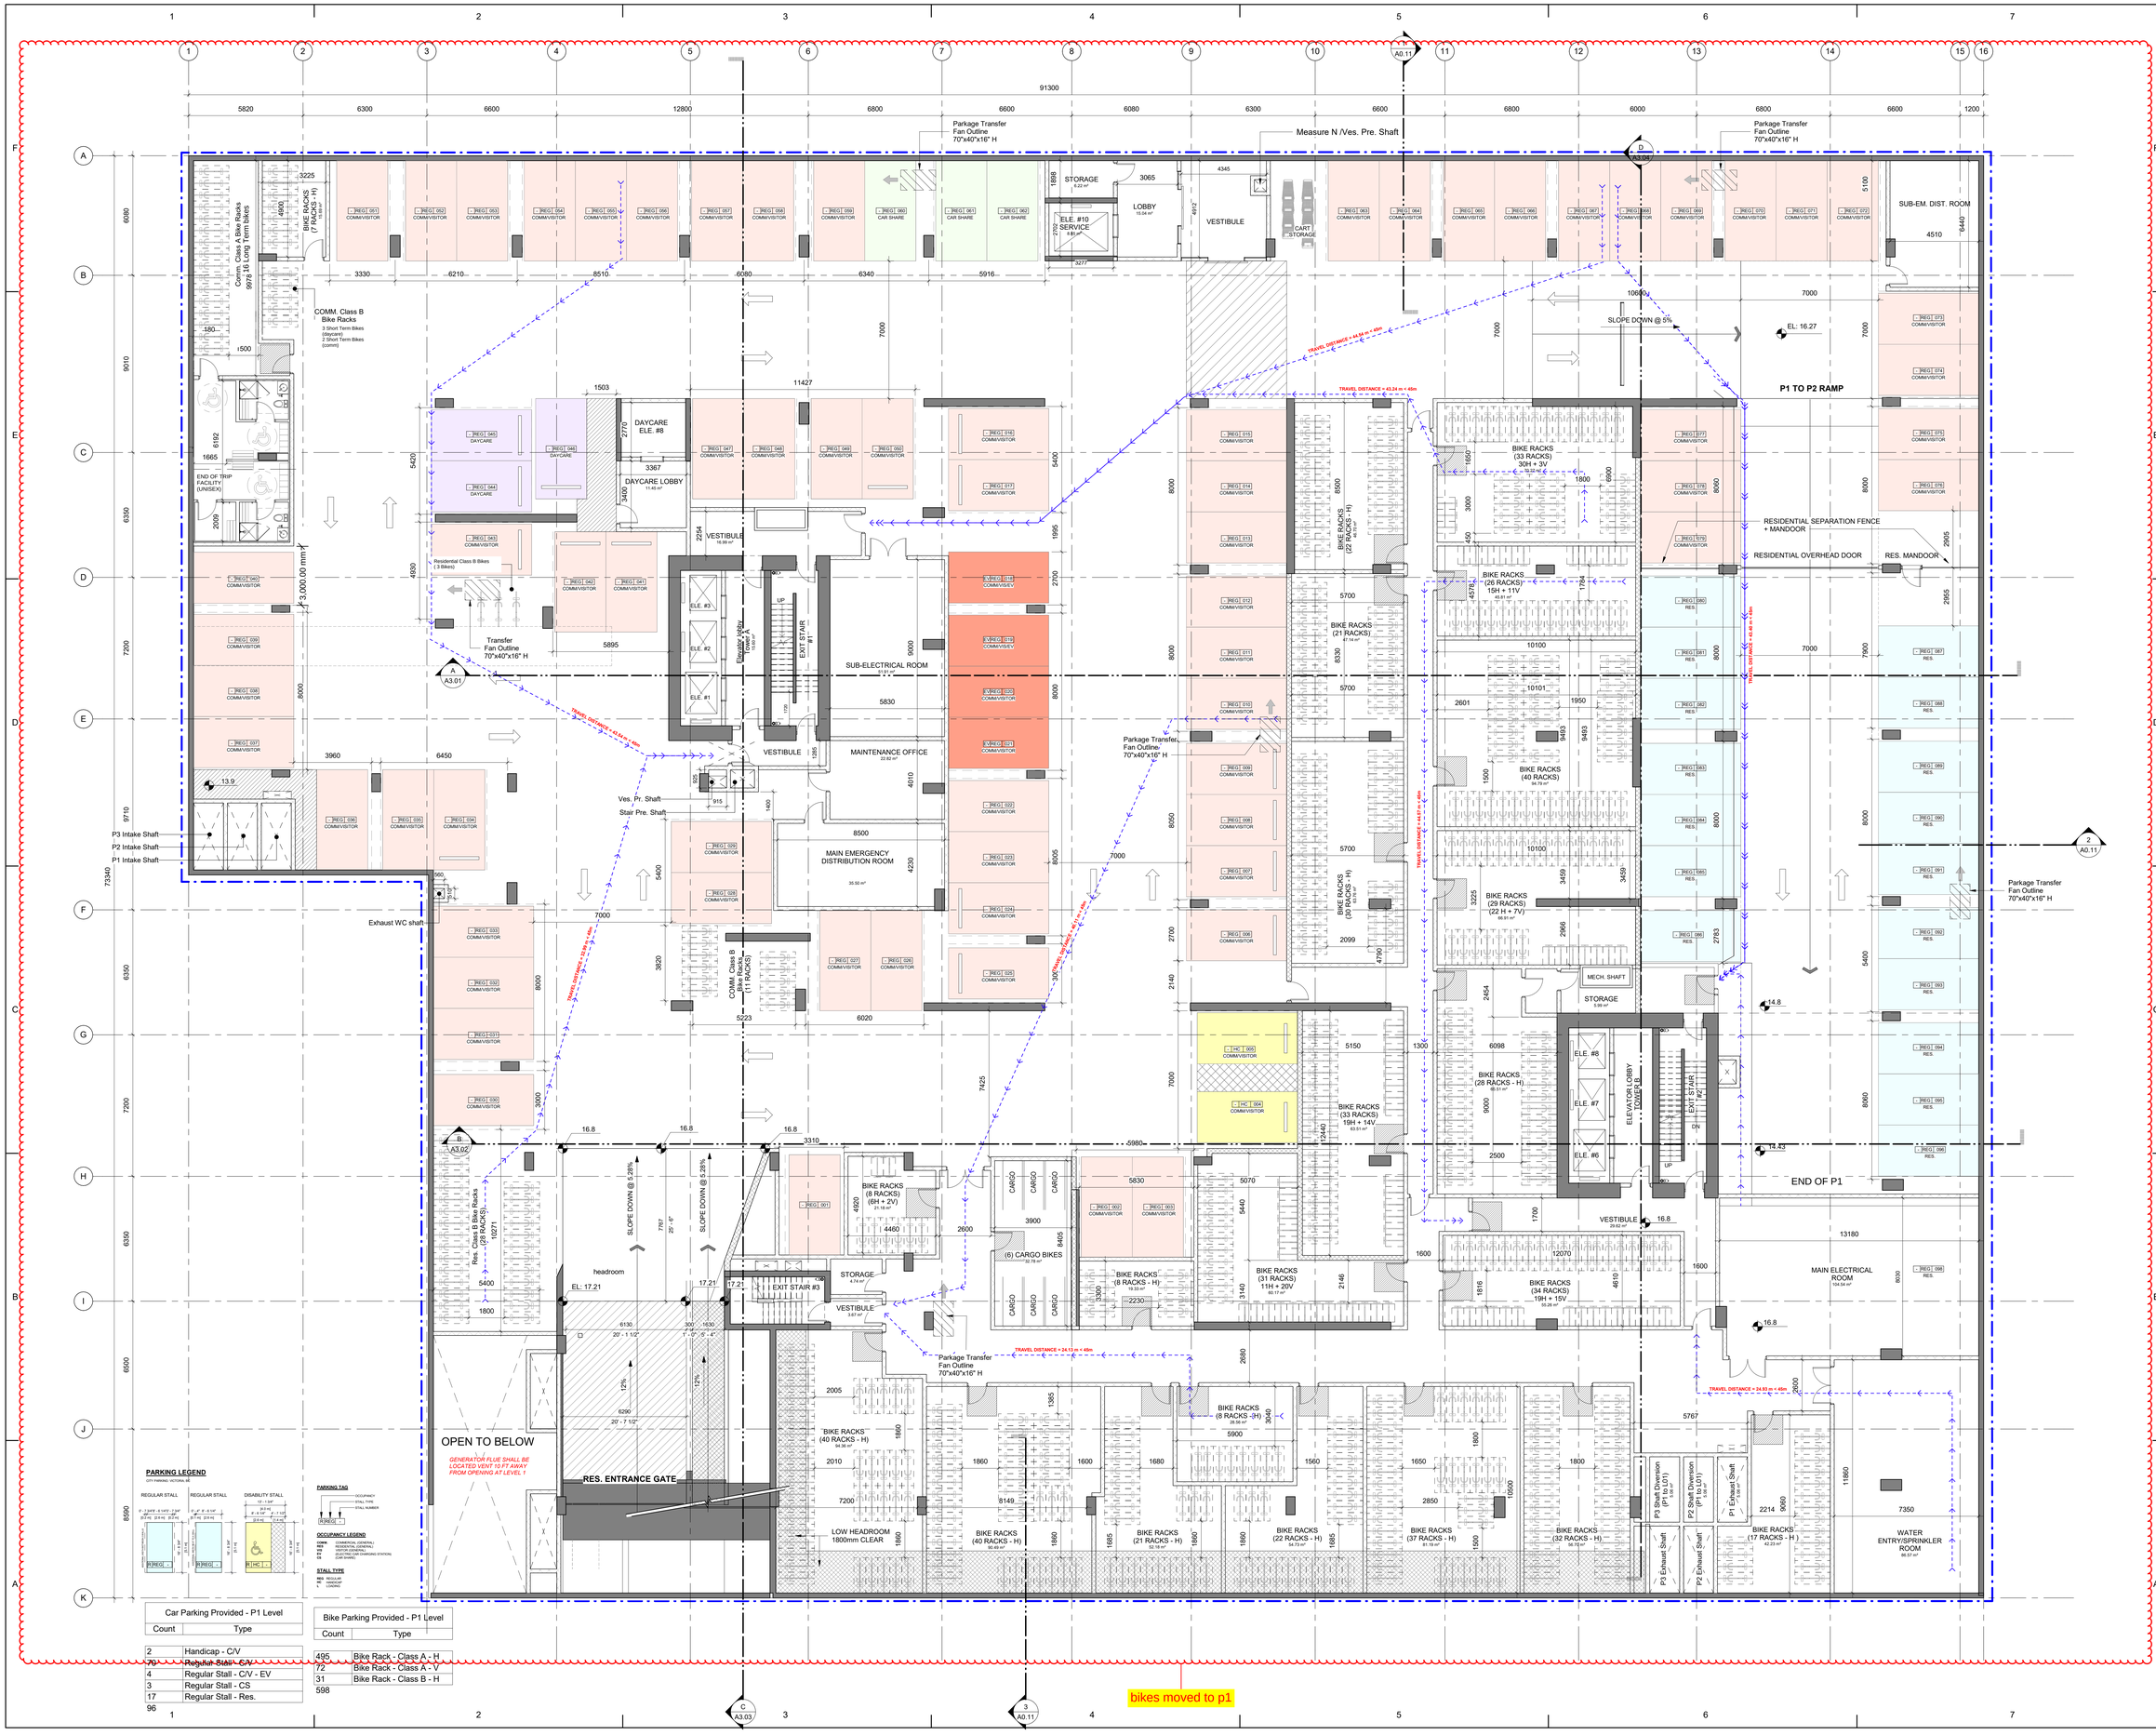

PARKING LEGEND

CITY PARKING: VICTORIA, BC

REGULAR STALL | REGULAR STALL | DISABILITY STALL

PARKING TAG

[PREG] — OCCUPANCY; STALL TYPE; STALL NUMBER

OCCUPANCY LEGEND

COMM. — COMMERCIAL (GENERAL)
RES. — RESIDENTIAL (GENERAL)
VIS — VISITOR (GENERAL)
EV — ELECTRIC CAR CHARGING STATION)
CS — CAR SHARE)

STALL TYPE

REG. REGULAR
HC. HANDICAP
L. LOADING

Car Parking Provided - P1 Level	
Count	Type
2	Handicap - C/V
70	Regular Stall - C/V
4	Regular Stall - C/V - EV
3	Regular Stall - CS
17	Regular Stall - Res.
96	

Bike Parking Provided - P1 Level	
Count	Type
495	Bike Rack - Class A - H
72	Bike Rack - Class A - V
31	Bike Rack - Class B - H
598	

CLIENT

Starlight Developments

P.O. Box 1690 Station B Mississauga, Ontario, Canada L4Y 3W8

COPYRIGHT:
This drawing has been prepared solely for the intended use, thus any reproduction or distribution for any purpose other than authorized by IBI Group is forbidden. Written dimensions shall have precedence over scaled dimensions. Contractors shall verify and be responsible for all dimensions and conditions on the job, and IBI Group shall be informed of any variations from the dimensions and conditions shown on the drawing. Shop drawings shall be submitted to IBI Group for general conformance before proceeding with fabrication.

IBI Group Architects (Canada) Inc.
is a member of the IBI Group of companies

NO.	DATE	DESCRIPTION
1	YYYY-MM-DD	

ISSUES

NO.	DATE	DESCRIPTION

REVISIONS

PROJECT NORTH

Issued For: Project Status
Date: 2021-03-05

SEAL

REGISTERED ARCHITECT JOHN GWYN WILLIS BRITISH COLUMBIA
2021-03-06

SUB-CONSULTANT

PRIME CONSULTANT

IBI GROUP ARCHITECTS (CANADA) INC.
700-1285 West Pender Street
Vancouver, BC V6E 4B1, Canada
tel 604 683 8797 fax 604 683 0492
ibigroup.com

PROJECT TITLE
Harris Green Village Phase 01
1045 Yates Street
Victoria, BC

PROJECT NO:	121123
DRAWN BY:	
CHK'D BY:	
SCALE:	As indicated
DATE:	2021-03-05

SHEET TITLE
OVERALL LEVEL P1 PLAN

SHEET NUMBER
A1.03

REV

Last Saved: 2021-03-05 10:19:33 PM File Location: I:\Jobs\121123_Yates\Phase 01\Harris Green Village Ph 1 B2020\121123_ Yates\Sub-Projects\Phase 01\Harris Green Village Ph 1 B2020 Yates\Sub-Projects-2020.rvt

YATES STREET

COOK STREET

VIEW STREET

FDC (FIRE DEPARTMENT CONNECTION)
DAYCARE & TWE EXIT
RES. Class B Bike Racks (4 RACKS)
DAYCARE EXIT
COMM. Class B Bike Racks (4 RACKS)
RES. Class B Bike Racks (8 RACKS)
VESTIBULE
C.R.U #1
223.6 m² (2407 SF)
DAYCARE LOBBY
50.11 m² (539 SF)
RESIDENTIAL LOBBY
119.19 m² (1283 SF)
DC VES.
RES. VES.
STROLLER STORAGE
DAYCARE ELE. #8
MAIL ROOM
MAIL ROOM
22.17 m² (239 SF)
JANITOR
TWR EXIT
P.K. EXIT
COMM. COMMON CORRIDOR
RESIDENTIAL GARBAGE ROOM
48.62 m² (523 SF)
PARCEL
ELE. #3
ELE. #2
ELE. #1
MOVING ROOM
EXIT STAIR #1
COMMERCIAL GARBAGE ROOM
81.07 m² (873 SF)
LOADING
Stair Pre. Shaft
Ves. Pr. Shaft
Mezzanine Above
2240.77 m² (24119 SF)
MAJOR RETAIL
2240.77 m² (24119 SF)
9.3 m
8 m
PODIUM EXIT
TWR EXIT
MARKET'S GARBAGE ROOM
LOADING AREA
LOADING
B.O.H
MECH. SHAFT
C.R.U #3
328.62 m² (3537 SF)
ELE. #8
ELE. #7
ELE. #6
EXIT STAIR #2
MOVING ROOM
PARCEL
STORAGE
JANITOR
LEASING OFFICE/ PROPERTY MANAGEMENT
256.52 m² (2783 SF)
RESIDENTIAL LOBBY
MAIL ROOM
RES. VES B
ENTERPHONE
PARKING EXHAUST SHAFT GRILL
RES. Class B Bike Racks (8 RACKS)
FDC (FIRE DEPARTMENT CONNECTION)
NEIGHBOUR'S PARKING RAMP
OVERHEAD DOOR
RESIDENTIAL GARBAGE ROOM
WB-17 IBI
HEADROOM (16'-0")
HEADROOM (8'-0")
MECHANICAL
RAMP TO LOADING
PLANTER
UNIT TH 06
75.64 m² (814 SF)
UNIT TH 05
54.64 m² (588 SF)
UNIT TH 04
54.64 m² (588 SF)
UNIT TH 03
54.64 m² (588 SF)
UNIT TH 02
54.64 m² (588 SF)
UNIT TH 01
54.64 m² (588 SF)
TH1
TH2
2BD
3BD
FFE 20.06
FFE 20.07
FFE 20.08
FFE 20.40
TRAVEL DISTANCE = 23.80 m < 45m
TRAVEL DISTANCE = 17.83 m < 45m
TRAVEL DISTANCE = 42.99 m < 45m
TRAVEL DISTANCE = 37.66 m < 45m
TRAVEL DISTANCE = 34.90 m < 45m
TRAVEL DISTANCE = 21.40 m < 45m
RAMP TO BIKE PARKING
4.60 m
6.30 m

Bike Parking Provided - Level 1

Count	Type
24	Bike Rack - Class B - H

Legend
- COMMERCIAL
- DAYCARE
- EXCLUDE
- RESIDENTIAL

Area by Usage- Level 01

Usage Type	Area	Description
COMMERCIAL	328.62 m²	C.R.U # 4
COMMERCIAL	2240.77 m²	MAJOR RETAIL
COMMERCIAL	223.6 m²	C.R.U # 1
Total Commercial Area: 3	2792.99 m²	

ramp revised to reduce width of curb cut
garbage rooms revised
retailer re-configured

CLIENT
Starlight Developments

Starlight Developments
P.O. Box 1690 Station B Mississauga, Ontario, Canada L4Y 3W8

COPYRIGHT:
This drawing has been prepared solely for the intended use, thus any reproduction or distribution for any purpose other than authorized by IBI Group is forbidden. Written dimensions shall have precedence over scaled dimensions. Contractors shall verify and be responsible for all dimensions and conditions on the job, and IBI Group shall be informed of any variations from the dimensions and conditions shown on the drawing. Shop drawings shall be submitted to IBI Group for general conformance before proceeding with fabrication.

IBI Group Architects (Canada) Inc.
is a member of the IBI Group of companies

NO.	DATE	DESCRIPTION
1	YYYY-MM-DD	

ISSUES

NO.	DATE	DESCRIPTION

REVISIONS

PROJECT NORTH
N

Issued For: Project Status
Date: 2021-03-05

SEAL
REGISTERED ARCHITECT JOHN GWYN PROVINCE OF BRITISH COLUMBIA
2021-03-06

SUB-CONSULTANT

PRIME CONSULTANT
IBI GROUP ARCHITECTS (CANADA) INC.
700-1285 West Pender Street, Vancouver, BC V6E 4B1, Canada
tel 604 683 8797 fax 604 683 0492
ibigroup.com

PROJECT TITLE
Harris Green Village Phase 01
1045 Yates Street
Victoria, BC

PROJECT NO:	121123
DRAWN BY:	Author
CHK'D BY:	Checker
SCALE:	1 : 100
DATE:	2021-03-05

SHEET TITLE
OVERALL LEVEL 1 PLAN

SHEET NUMBER
A1.04

REV

Last Saved: 2021-03-05 10:19:50 PM File Location: I:\84 300+\121123 - Yates Street - Harris Green Village Ph 1 P2\200\121123_YatesStA-Podium-2020.rvt

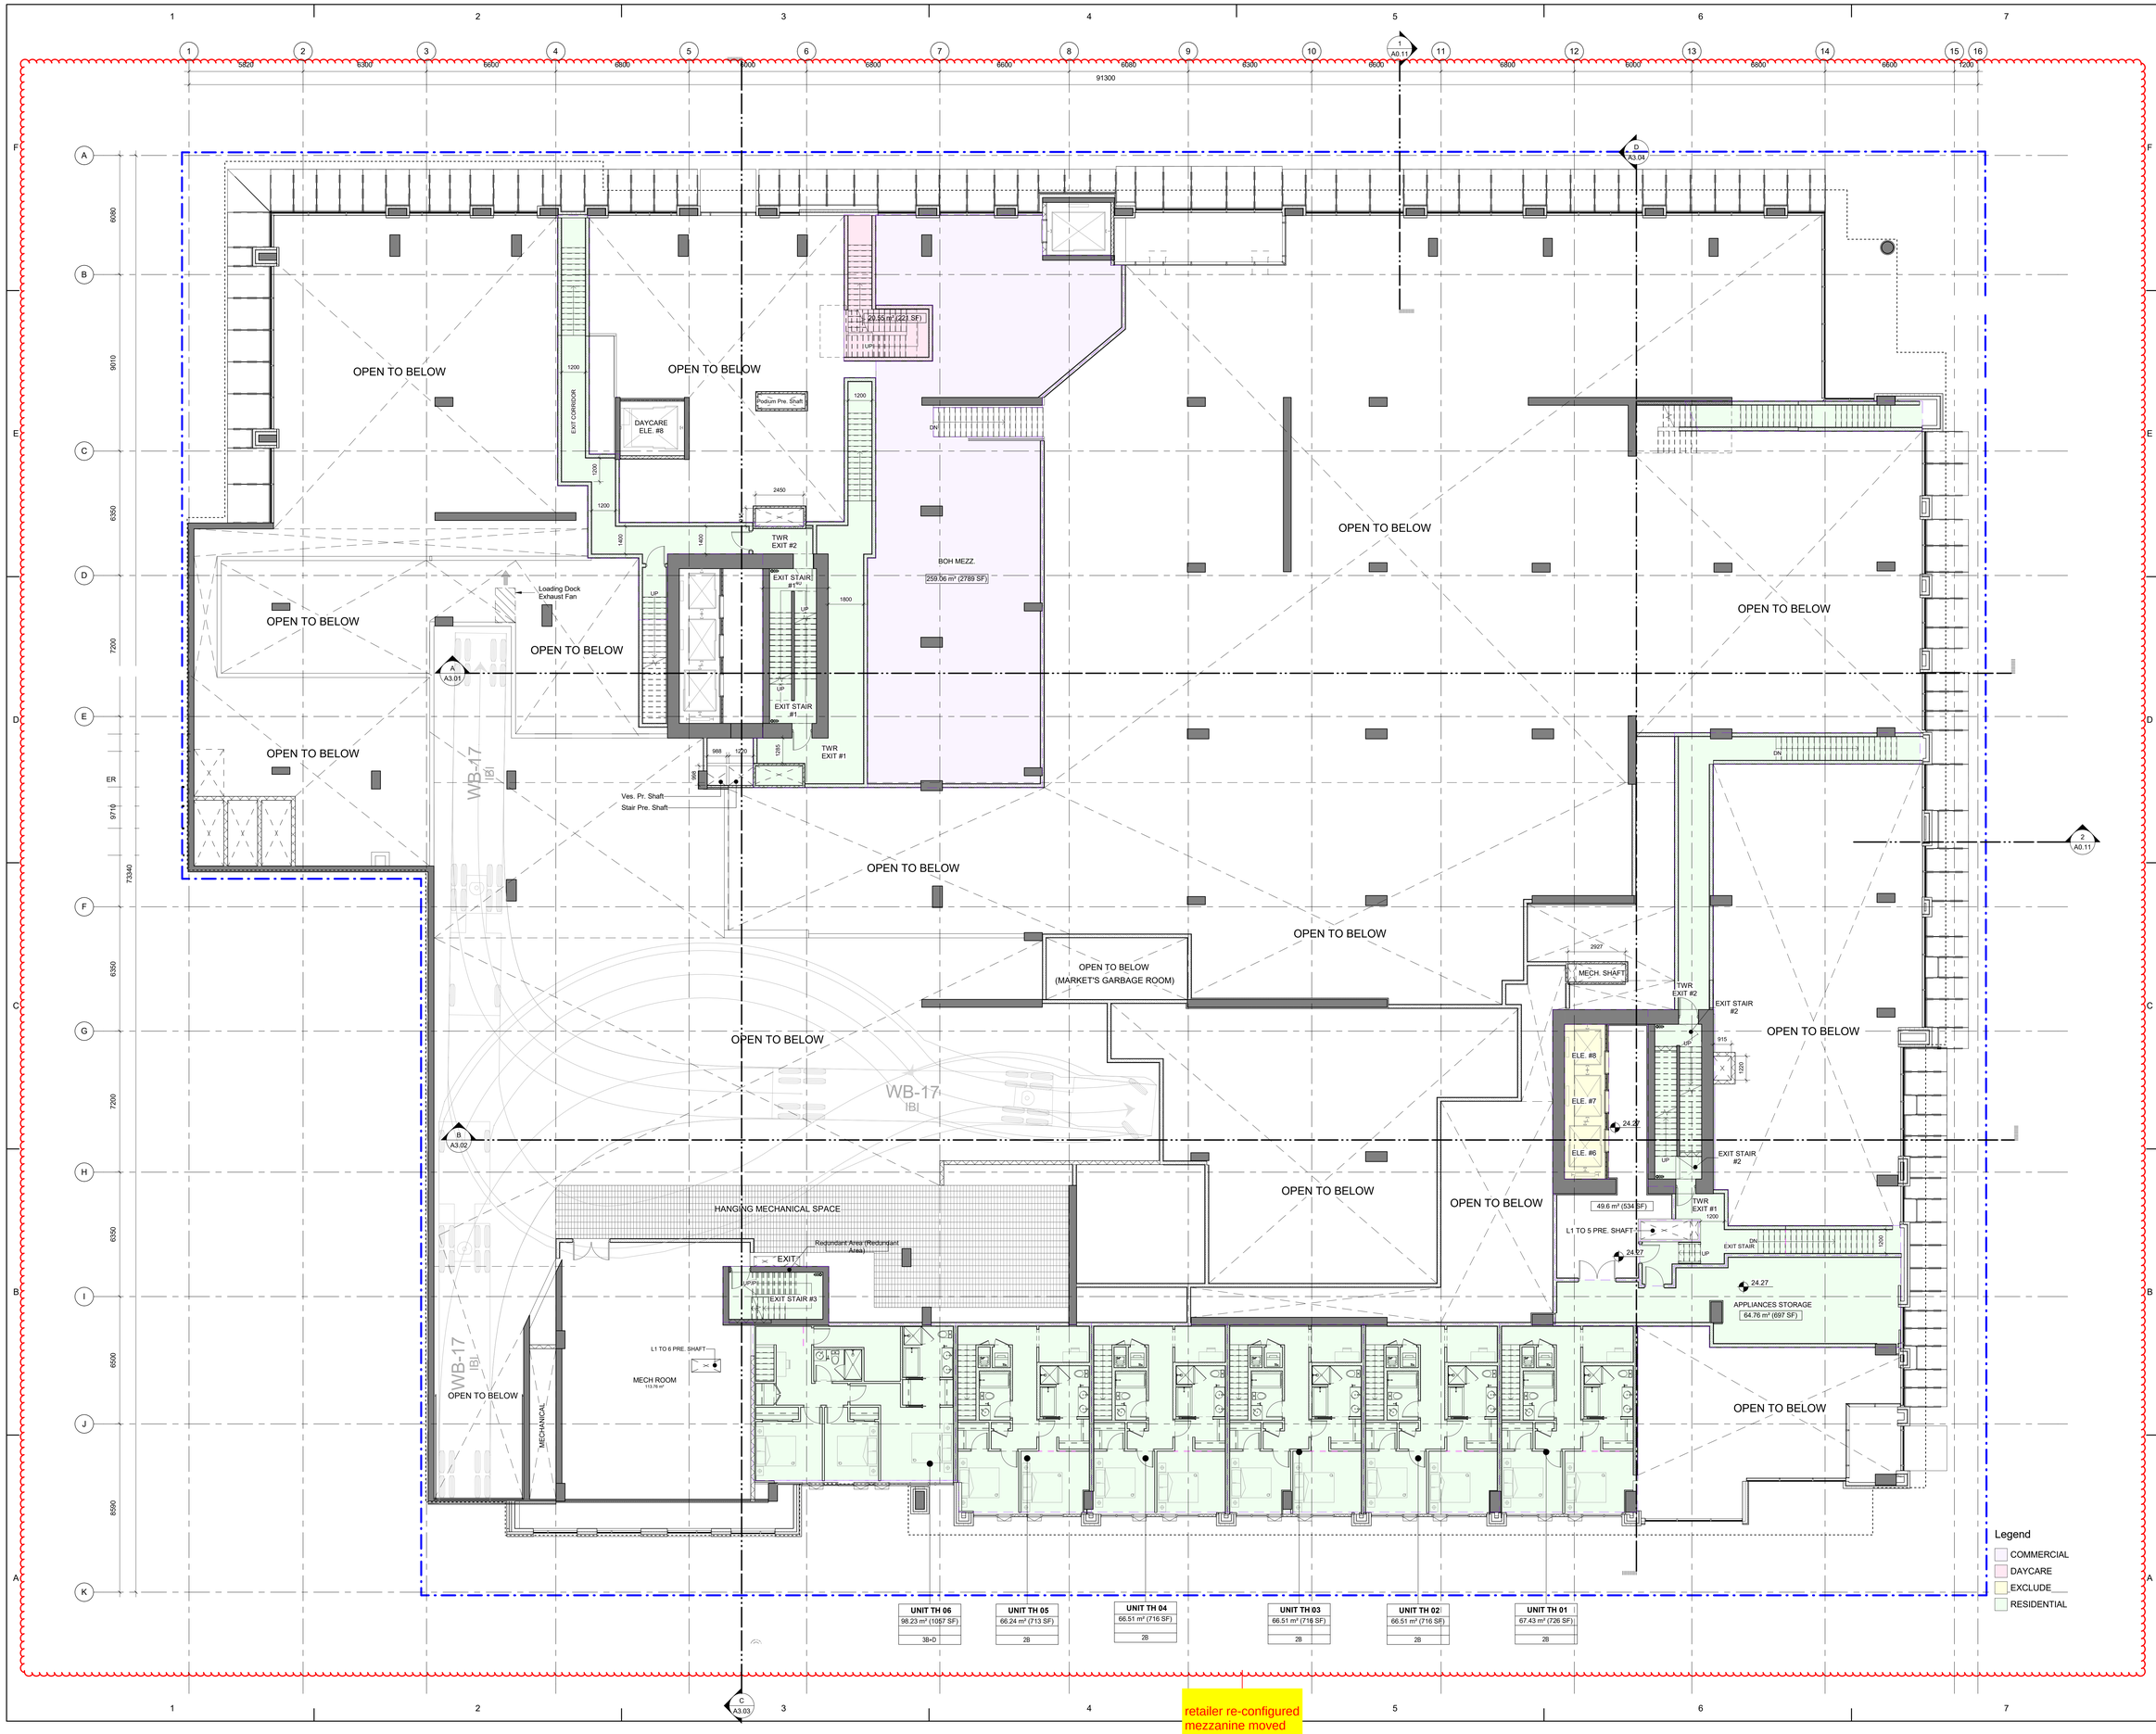

CLIENT

Starlight Developments

P.O. Box 1690 Station B Mississauga, Ontario, Canada L4Y 3W8

COPYRIGHT:
This drawing has been prepared solely for the intended use, thus any reproduction or distribution for any purpose other than authorized by IBI Group is forbidden. Written dimensions shall have precedence over scaled dimensions. Contractors shall verify and be responsible for all dimensions and conditions on the job, and IBI Group shall be informed of any variations from the dimensions and conditions shown on the drawing. Shop drawings shall be submitted to IBI Group for general conformance before proceeding with fabrication.

IBI Group Architects (Canada) Inc.
is a member of the IBI Group of companies

NO.	DATE	DESCRIPTION
1	YYYY-MM-DD	

ISSUES

NO.	DATE	DESCRIPTION

REVISIONS

PROJECT NORTH

Issued For: Project Status
Date: 2021-03-05

SEAL

REGISTERED ARCHITECT JOHN GWYN KOTYK BRITISH COLUMBIA 21211 2021-03-06

SUB-CONSULTANT

PRIME CONSULTANT

IBI GROUP ARCHITECTS (CANADA) INC.
700-1285 West Pender Street
Vancouver, BC V6E 4B1, Canada
tel 604 683 8797 fax 604 683 0492
ibigroup.com

PROJECT TITLE
Harris Green Village
Phase 01
1045 Yates Street
Victoria, BC

PROJECT NO:	121123
DRAWN BY:	Author
CHK'D BY:	Checker
SCALE:	1 : 100
DATE:	2021-03-05

SHEET TITLE
OVERALL LEVEL MEZZANINE PLAN

SHEET NUMBER **A1.05** REV

Last Saved: 2021-03-05 10:19:57 PM File Location: BIM 360://121123 - Yates Street – Harris Green Village Ph 1\2020\121123_YatesStA-Podium2020.rvt

AREA BY USAGE TYPE

- Studio
- 1 Bedroom
- 1 Bedroom+ Den
- 2 Bedroom
- 3 Bedroom
- AMENITY
- DAYCARE

Area by Usage- Level 02

Usage Type	Area
AMENITY	584.82 m²
DAYCARE	411.01 m²

UNIT MIX - Level 2

	STUDIO	1 BEDROOM	1 BEDROOM + DEN	2 BEDROOM	2 BEDROOM + DEN	3 BEDROOM	3 BEDROOM + DEN	UNITS PER FLOOR
LEVEL 02	32	8	39	0	0	6	0	85

CLIENT

Starlight Developments

Starlight Developments
P.O. Box 1690 Station B Mississauga, Ontario, Canada
L4Y 3W6

COPYRIGHT:
This drawing has been prepared solely for the intended use, thus any reproduction or distribution for any purpose other than authorized by IBI Group is forbidden. Written dimensions shall have precedence over scaled dimensions. Contractors shall verify and be responsible for all dimensions and conditions on the job, and IBI Group shall be informed of any variations from the dimensions and conditions shown on the drawing. Shop drawings shall be submitted to IBI Group for general conformance before proceeding with fabrication.
IBI Group Architects (Canada) Inc.
is a member of the IBI Group of companies

NO.	DATE	DESCRIPTION
1	YYYY-MM-DD	

ISSUES

NO.	DATE	DESCRIPTION

REVISIONS

PROJECT NORTH

Issued For: Project Status
Date: 2021-03-05

SEAL

REGISTERED ARCHITECT JOHN GWYN HALL BRITISH COLUMBIA
2021-03-05

SUB-CONSULTANT

PRIME CONSULTANT

IBI GROUP
ARCHITECTS (CANADA) INC.
700-1285 West Pender Street,
Vancouver, BC V6E 4B1, Canada
tel 604 683 8797 fax 604 683 0492
ibigroup.com

PROJECT TITLE
Harris Green Village Phase 01
1045 Yates Street
Victoria, BC

PROJECT NO:	121123
DRAWN BY:	
CHK'D BY:	
SCALE:	1 : 100
DATE:	2021-03-05

SHEET TITLE
OVERALL LEVEL 2 PLAN

SHEET NUMBER
A1.06

REV

Last Saved: 2021-03-05 10:20:16 PM File Location: BIM 360/121123 - Yates Street - Harris Green Village Ph 1 (2020)/121123_Yates&Is-A-Podium-2020.rvt

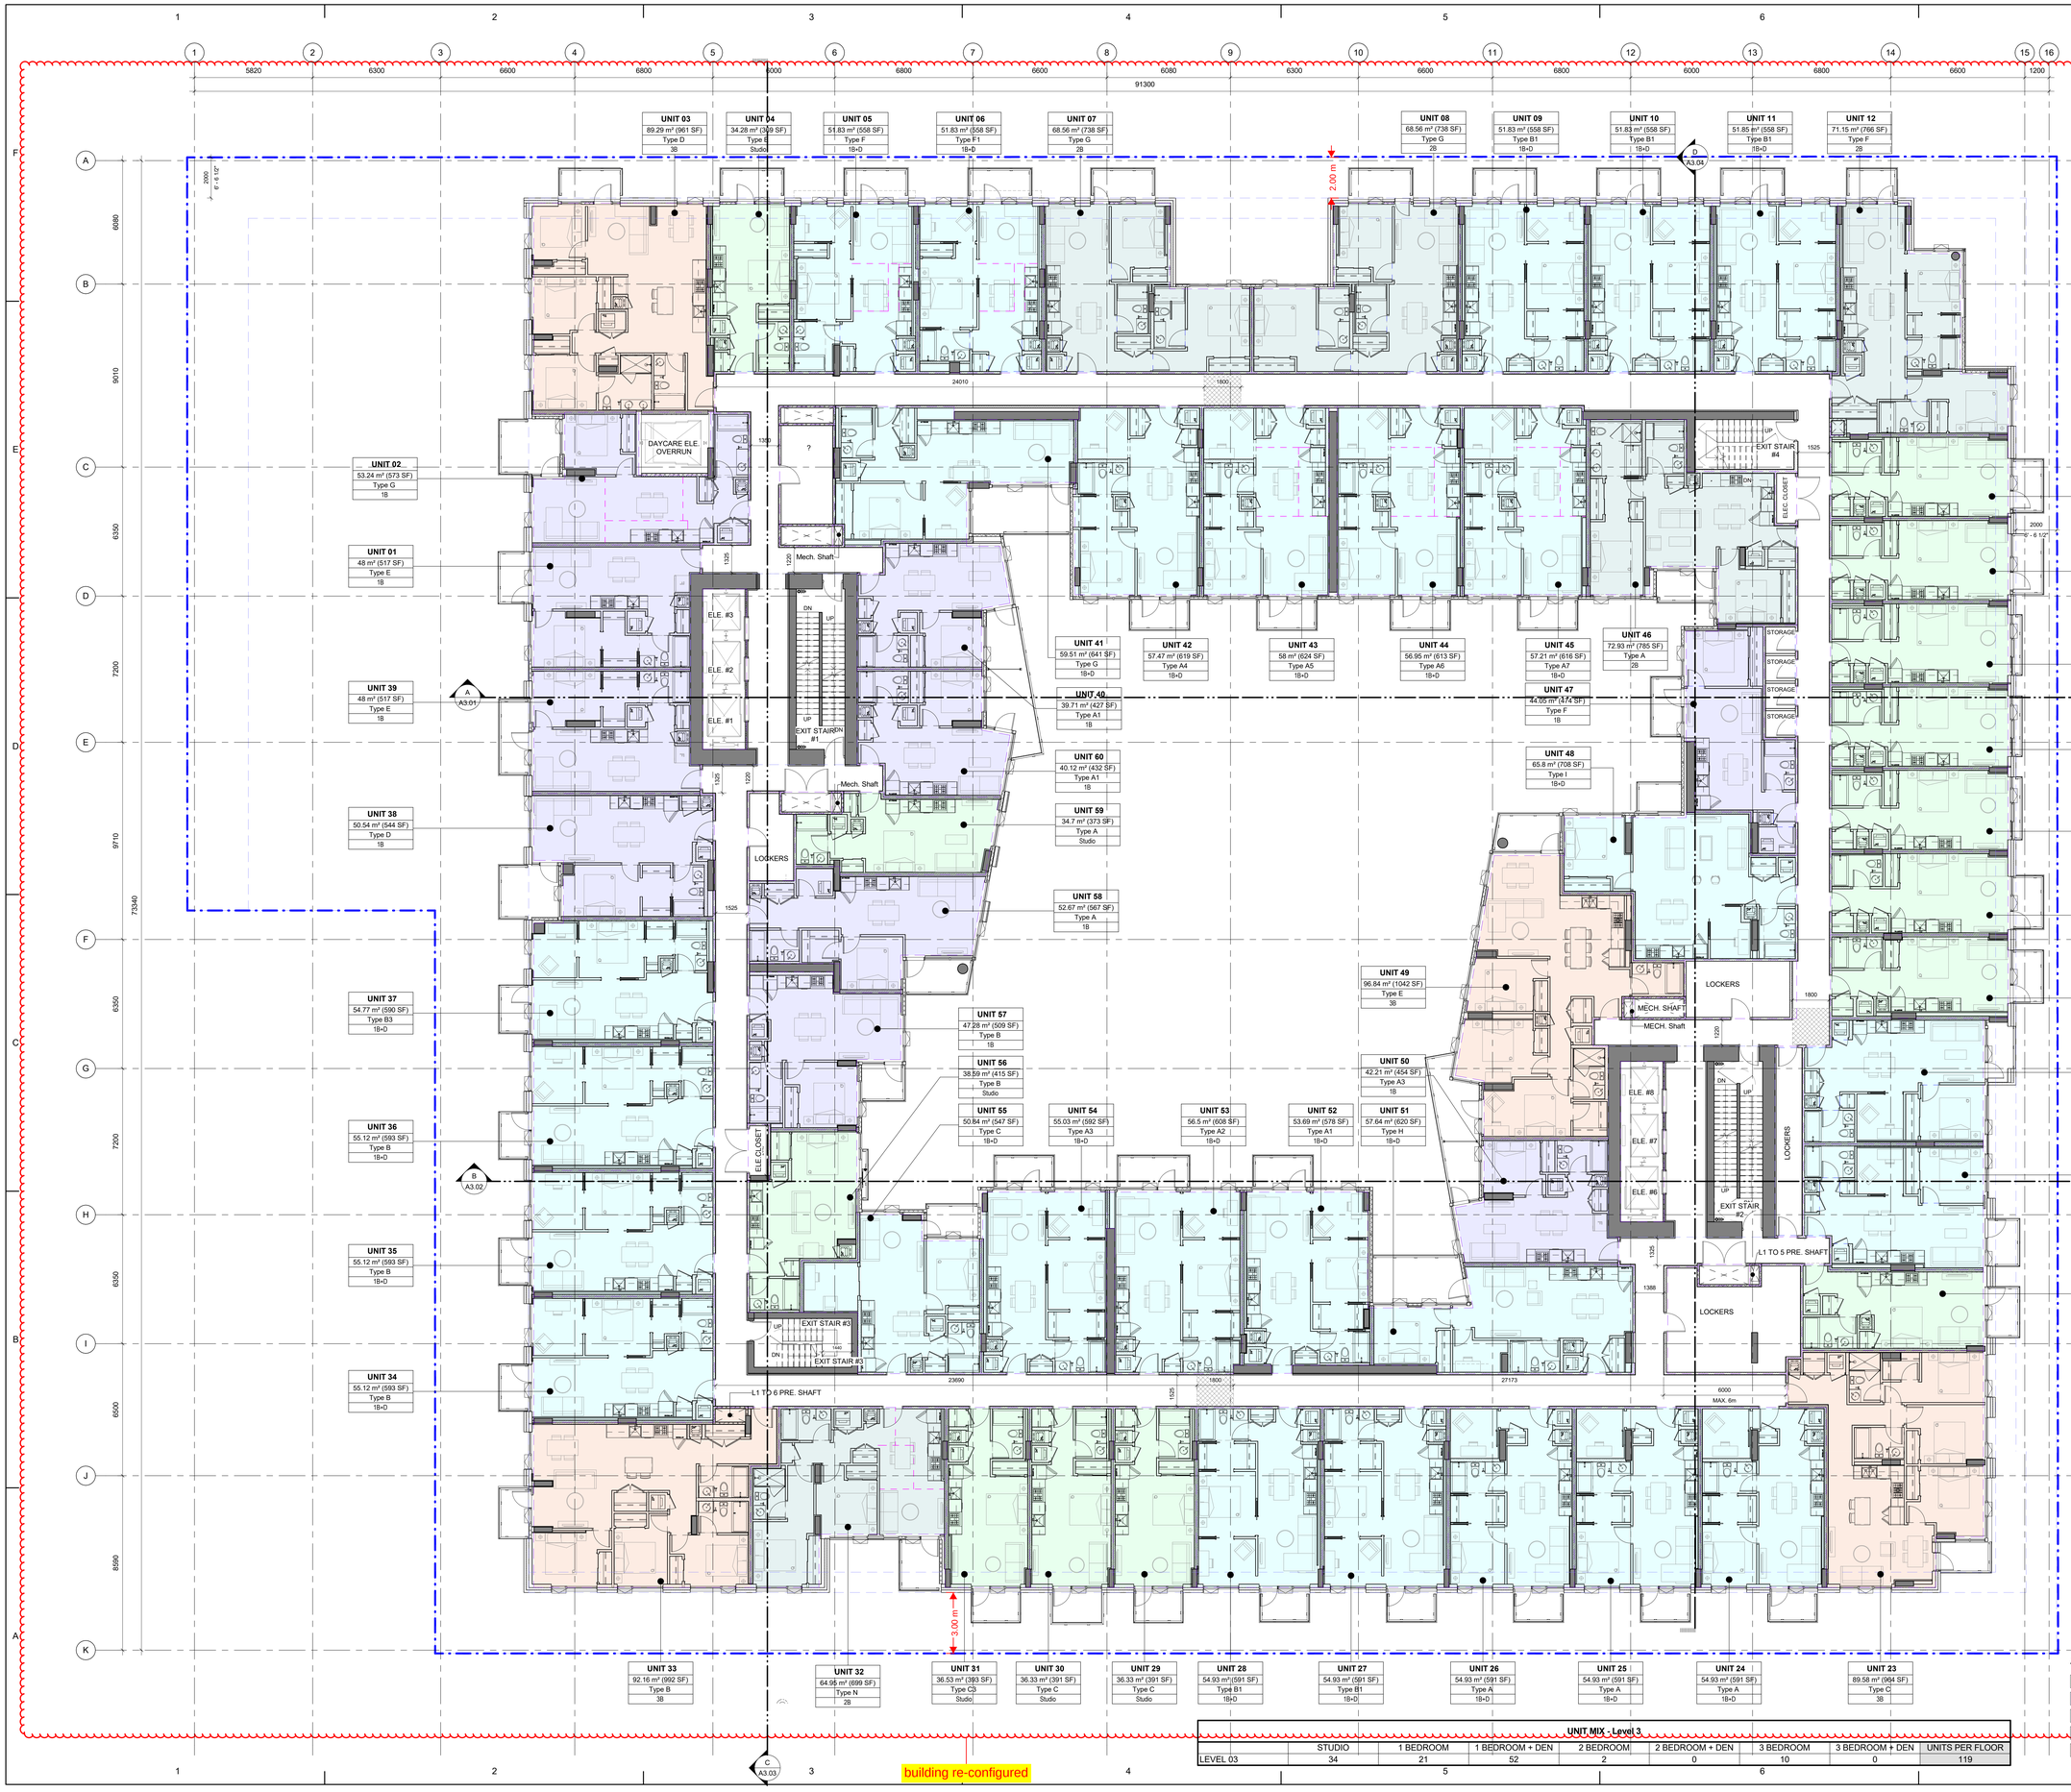

UNIT MIX - Level 3

	STUDIO	1 BEDROOM	1 BEDROOM + DEN	2 BEDROOM	2 BEDROOM + DEN	3 BEDROOM	3 BEDROOM + DEN	UNITS PER FLOOR
LEVEL 03	34	21	52	2	0	10	0	119

AREA BY USAGE TYPE

- Studio
- 1 Bedroom
- 1 Bedroom+ Den
- 2 Bedroom
- 3 Bedroom

CLIENT

Starlight Developments

Starlight Developments
P.O. Box 1690 Station B Mississauga, Ontario, Canada
L4Y 3W8

COPYRIGHT:
This drawing has been prepared solely for the intended use, thus any reproduction or distribution for any purpose other than authorized by IBI Group is forbidden. Written dimensions shall have precedence over scaled dimensions. Contractors shall verify and be responsible for all dimensions and conditions on the job, and IBI Group shall be informed of any variations from the dimensions and conditions shown on the drawing. Shop drawings shall be submitted to IBI Group for general conformance before proceeding with fabrication.
IBI Group Architects (Canada) Inc.
is a member of the IBI Group of companies.

NO.	DATE	DESCRIPTION
1	YYYY-MM-DD	

ISSUES

NO.	DATE	DESCRIPTION

REVISIONS

PROJECT NORTH

Issued For: Project Status
Date: 2021-03-05

SEAL

REGISTERED ARCHITECT JOHN GWYN BRITISH COLUMBIA
2021-03-05

SUB-CONSULTANT

PRIME CONSULTANT

IBI GROUP ARCHITECTS (CANADA) INC.
700-1285 West Pender Street
Vancouver, BC V6E 4B1, Canada
tel 604 683 8797 fax 604 683 0492
ibigroup.com

PROJECT TITLE
Harris Green Village Phase 01
1045 Yates Street
Victoria, BC

PROJECT NO:	121123
DRAWN BY:	
CHK'D BY:	
SCALE:	1 : 100
DATE:	2021-03-05

SHEET TITLE
OVERALL LEVEL 3 PLAN

SHEET NUMBER
A1.07

REV

Last Saved: 2021-03-05 10:20:31 PM File Location: BIM 360://121123 - Yates Street – Harris Green Village Ph 1 62020/121123_YatesStA-Portion-2020.rvt

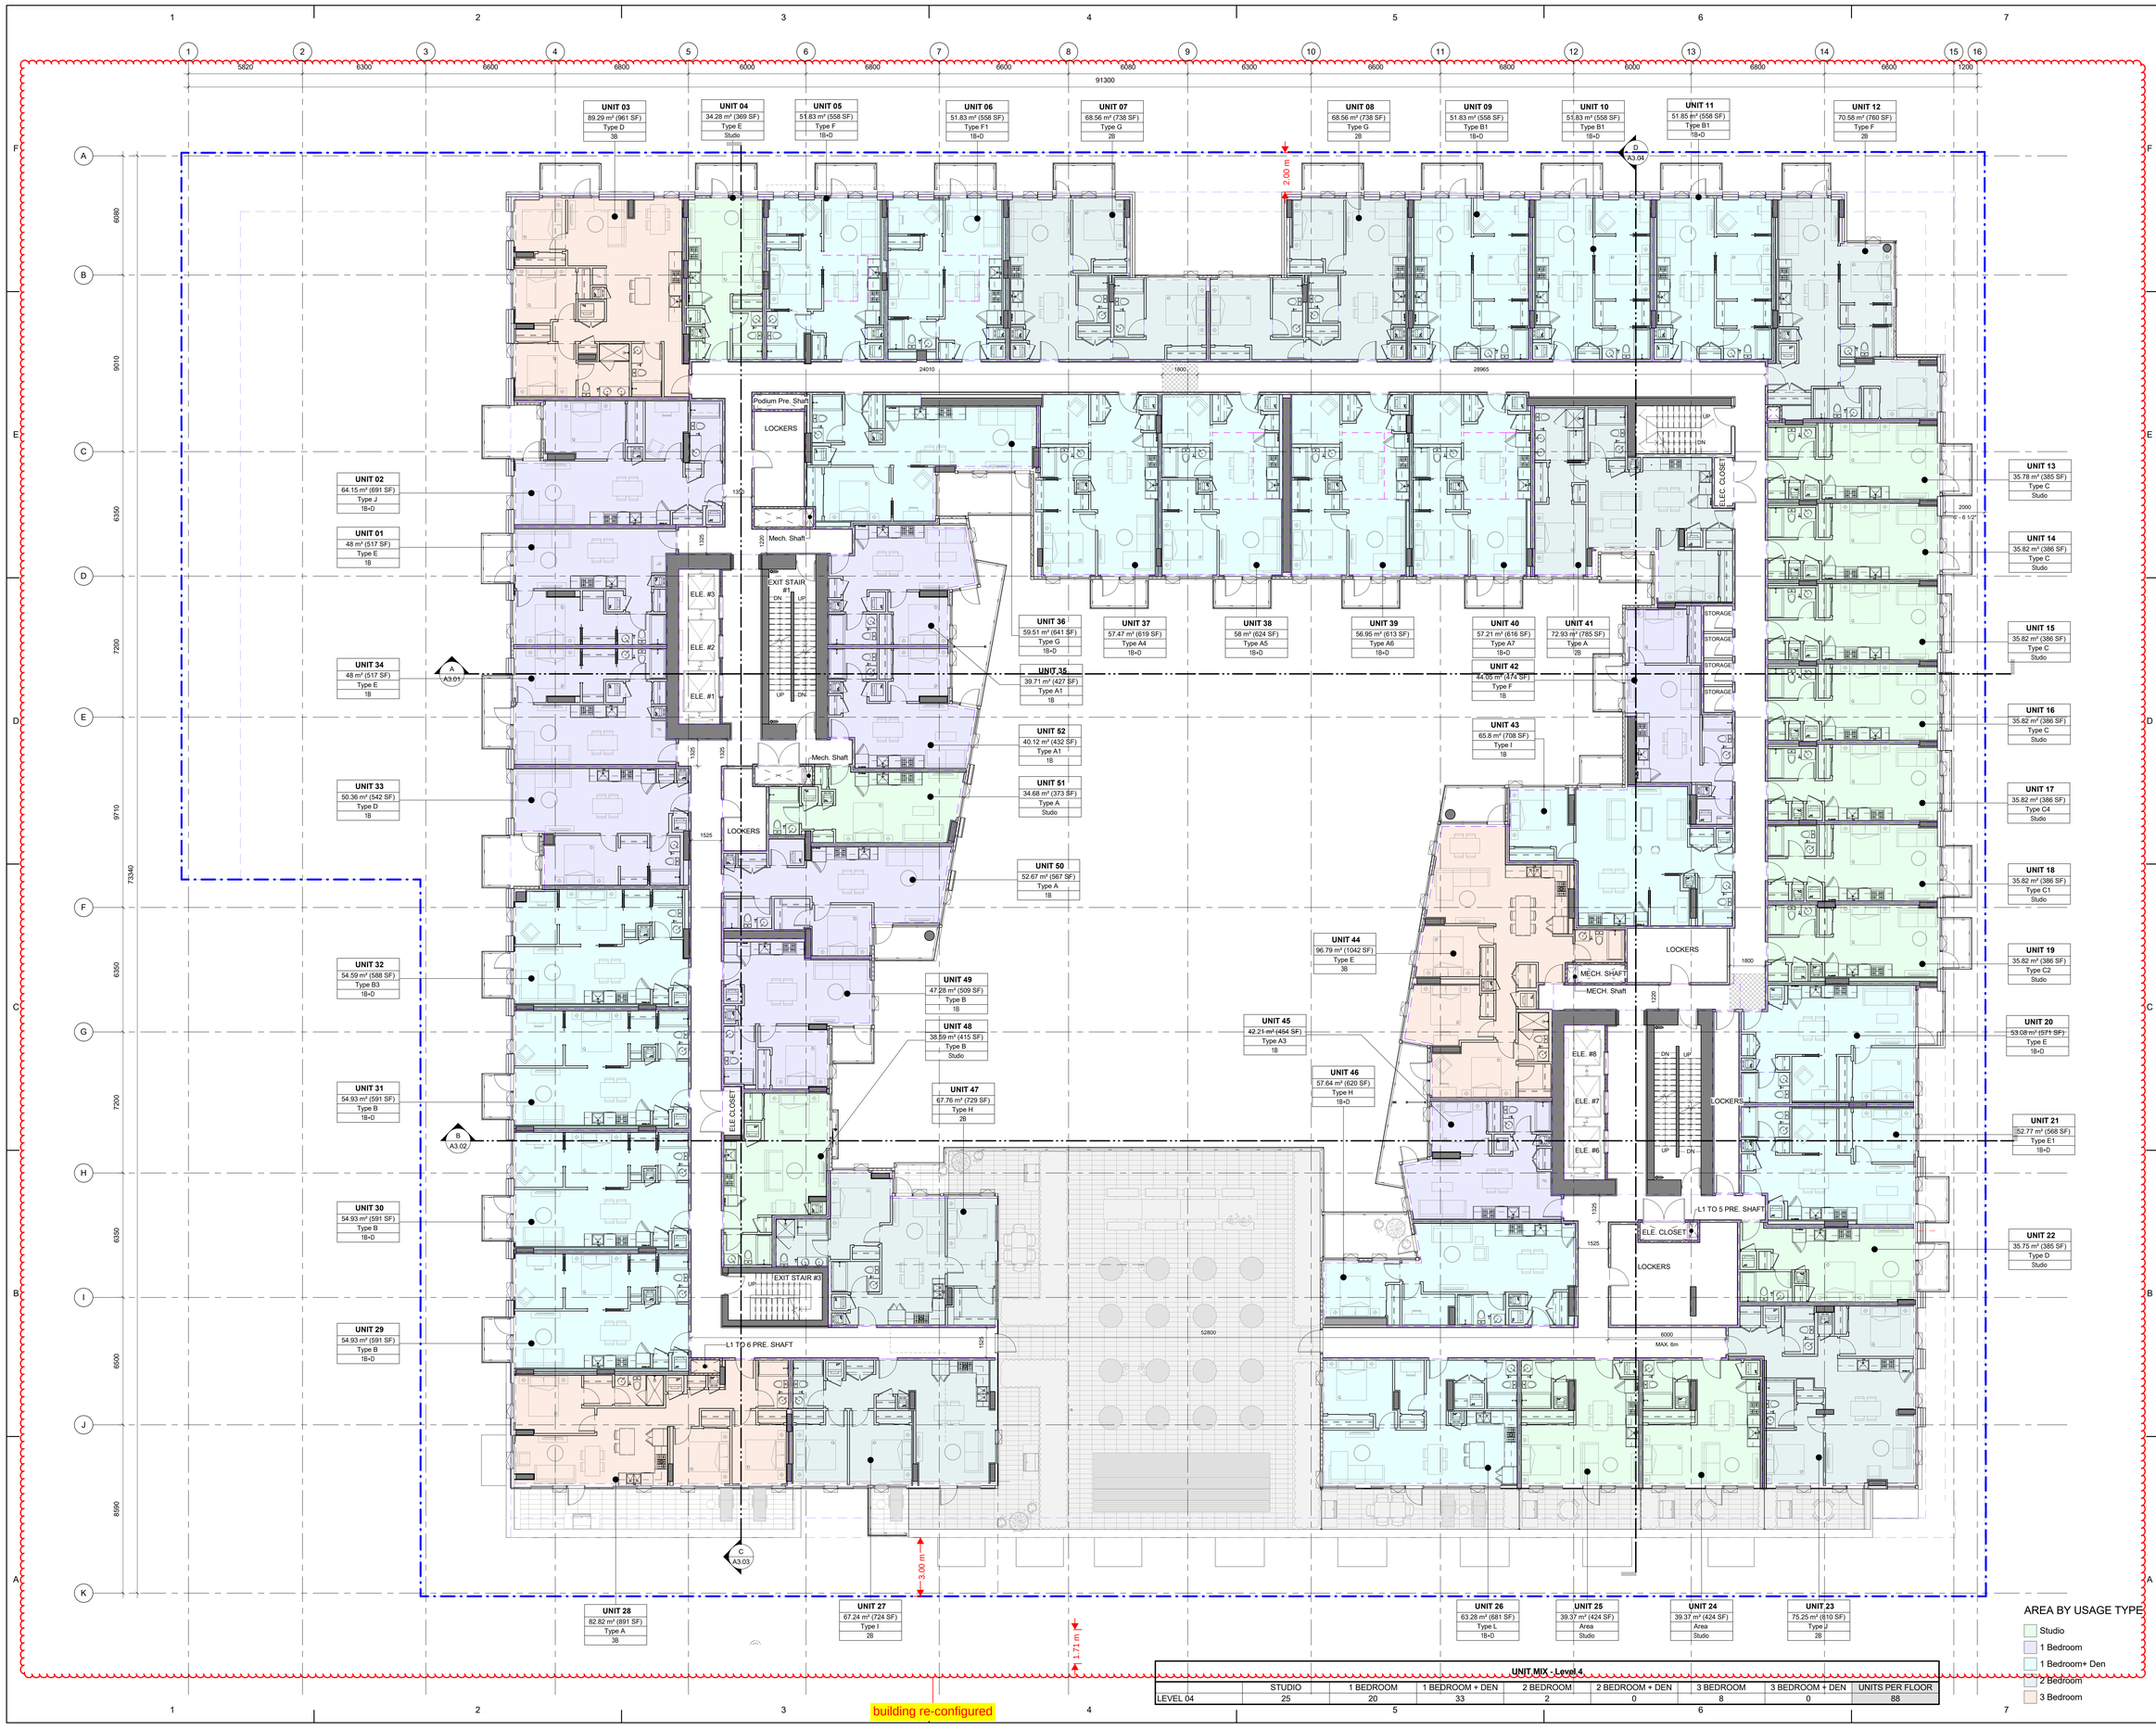

AREA BY USAGE TYPE

- Studio
- 1 Bedroom
- 1 Bedroom+ Den
- 2 Bedroom
- 3 Bedroom

UNIT MIX - Level 4

	STUDIO	1 BEDROOM	1 BEDROOM + DEN	2 BEDROOM	2 BEDROOM + DEN	3 BEDROOM	3 BEDROOM + DEN	UNITS PER FLOOR
LEVEL 04	25	20	33	2	0	8	0	88

CLIENT

Starlight Developments

P.O. Box 1690 Station B Mississauga, Ontario, Canada
L4Y 3W8

COPYRIGHT:
This drawing has been prepared solely for the intended use, thus any reproduction or distribution for any purpose other than authorized by IBI Group is forbidden. Written dimensions shall have precedence over scaled dimensions. Contractors shall verify and be responsible for all dimensions and conditions on the job, and IBI Group shall be informed of any variations from the dimensions and conditions shown on the drawing. Shop drawings shall be submitted to IBI Group for general conformance before proceeding with fabrication.
IBI Group Architects (Canada) Inc.
is a member of the IBI Group of companies.

NO.	DATE	DESCRIPTION
1	YYYY-MM-DD	

ISSUES

NO.	DATE	DESCRIPTION

REVISIONS

PROJECT NORTH

Issued For: Project Status
Date: 2021-03-05

SEAL

REGISTERED ARCHITECT JOHN GWYN PROVINCE OF BRITISH COLUMBIA
2021-03-06

SUB-CONSULTANT

PRIME CONSULTANT

IBI GROUP
ARCHITECTS (CANADA) INC.
700-1285 West Pender Street
Vancouver, BC V6E 4B1, Canada
tel 604 683 8797 fax 604 683 0492
ibigroup.com

PROJECT TITLE
Harris Green Village Phase 01
1045 Yates Street
Victoria, BC

PROJECT NO:	121123
DRAWN BY:	Author
CHK'D BY:	Checker
SCALE:	1 : 100
DATE:	2021-03-05

SHEET TITLE
OVERALL LEVEL 04 PLAN

SHEET NUMBER
A1.08

REV

Last Saved: 2021-03-05 10:20:45 PM File Location: BIM 360://121123 - Yates Street - Harris Green Village Ph 1 62020/121123_YatesStA-Podium-2020.rvt

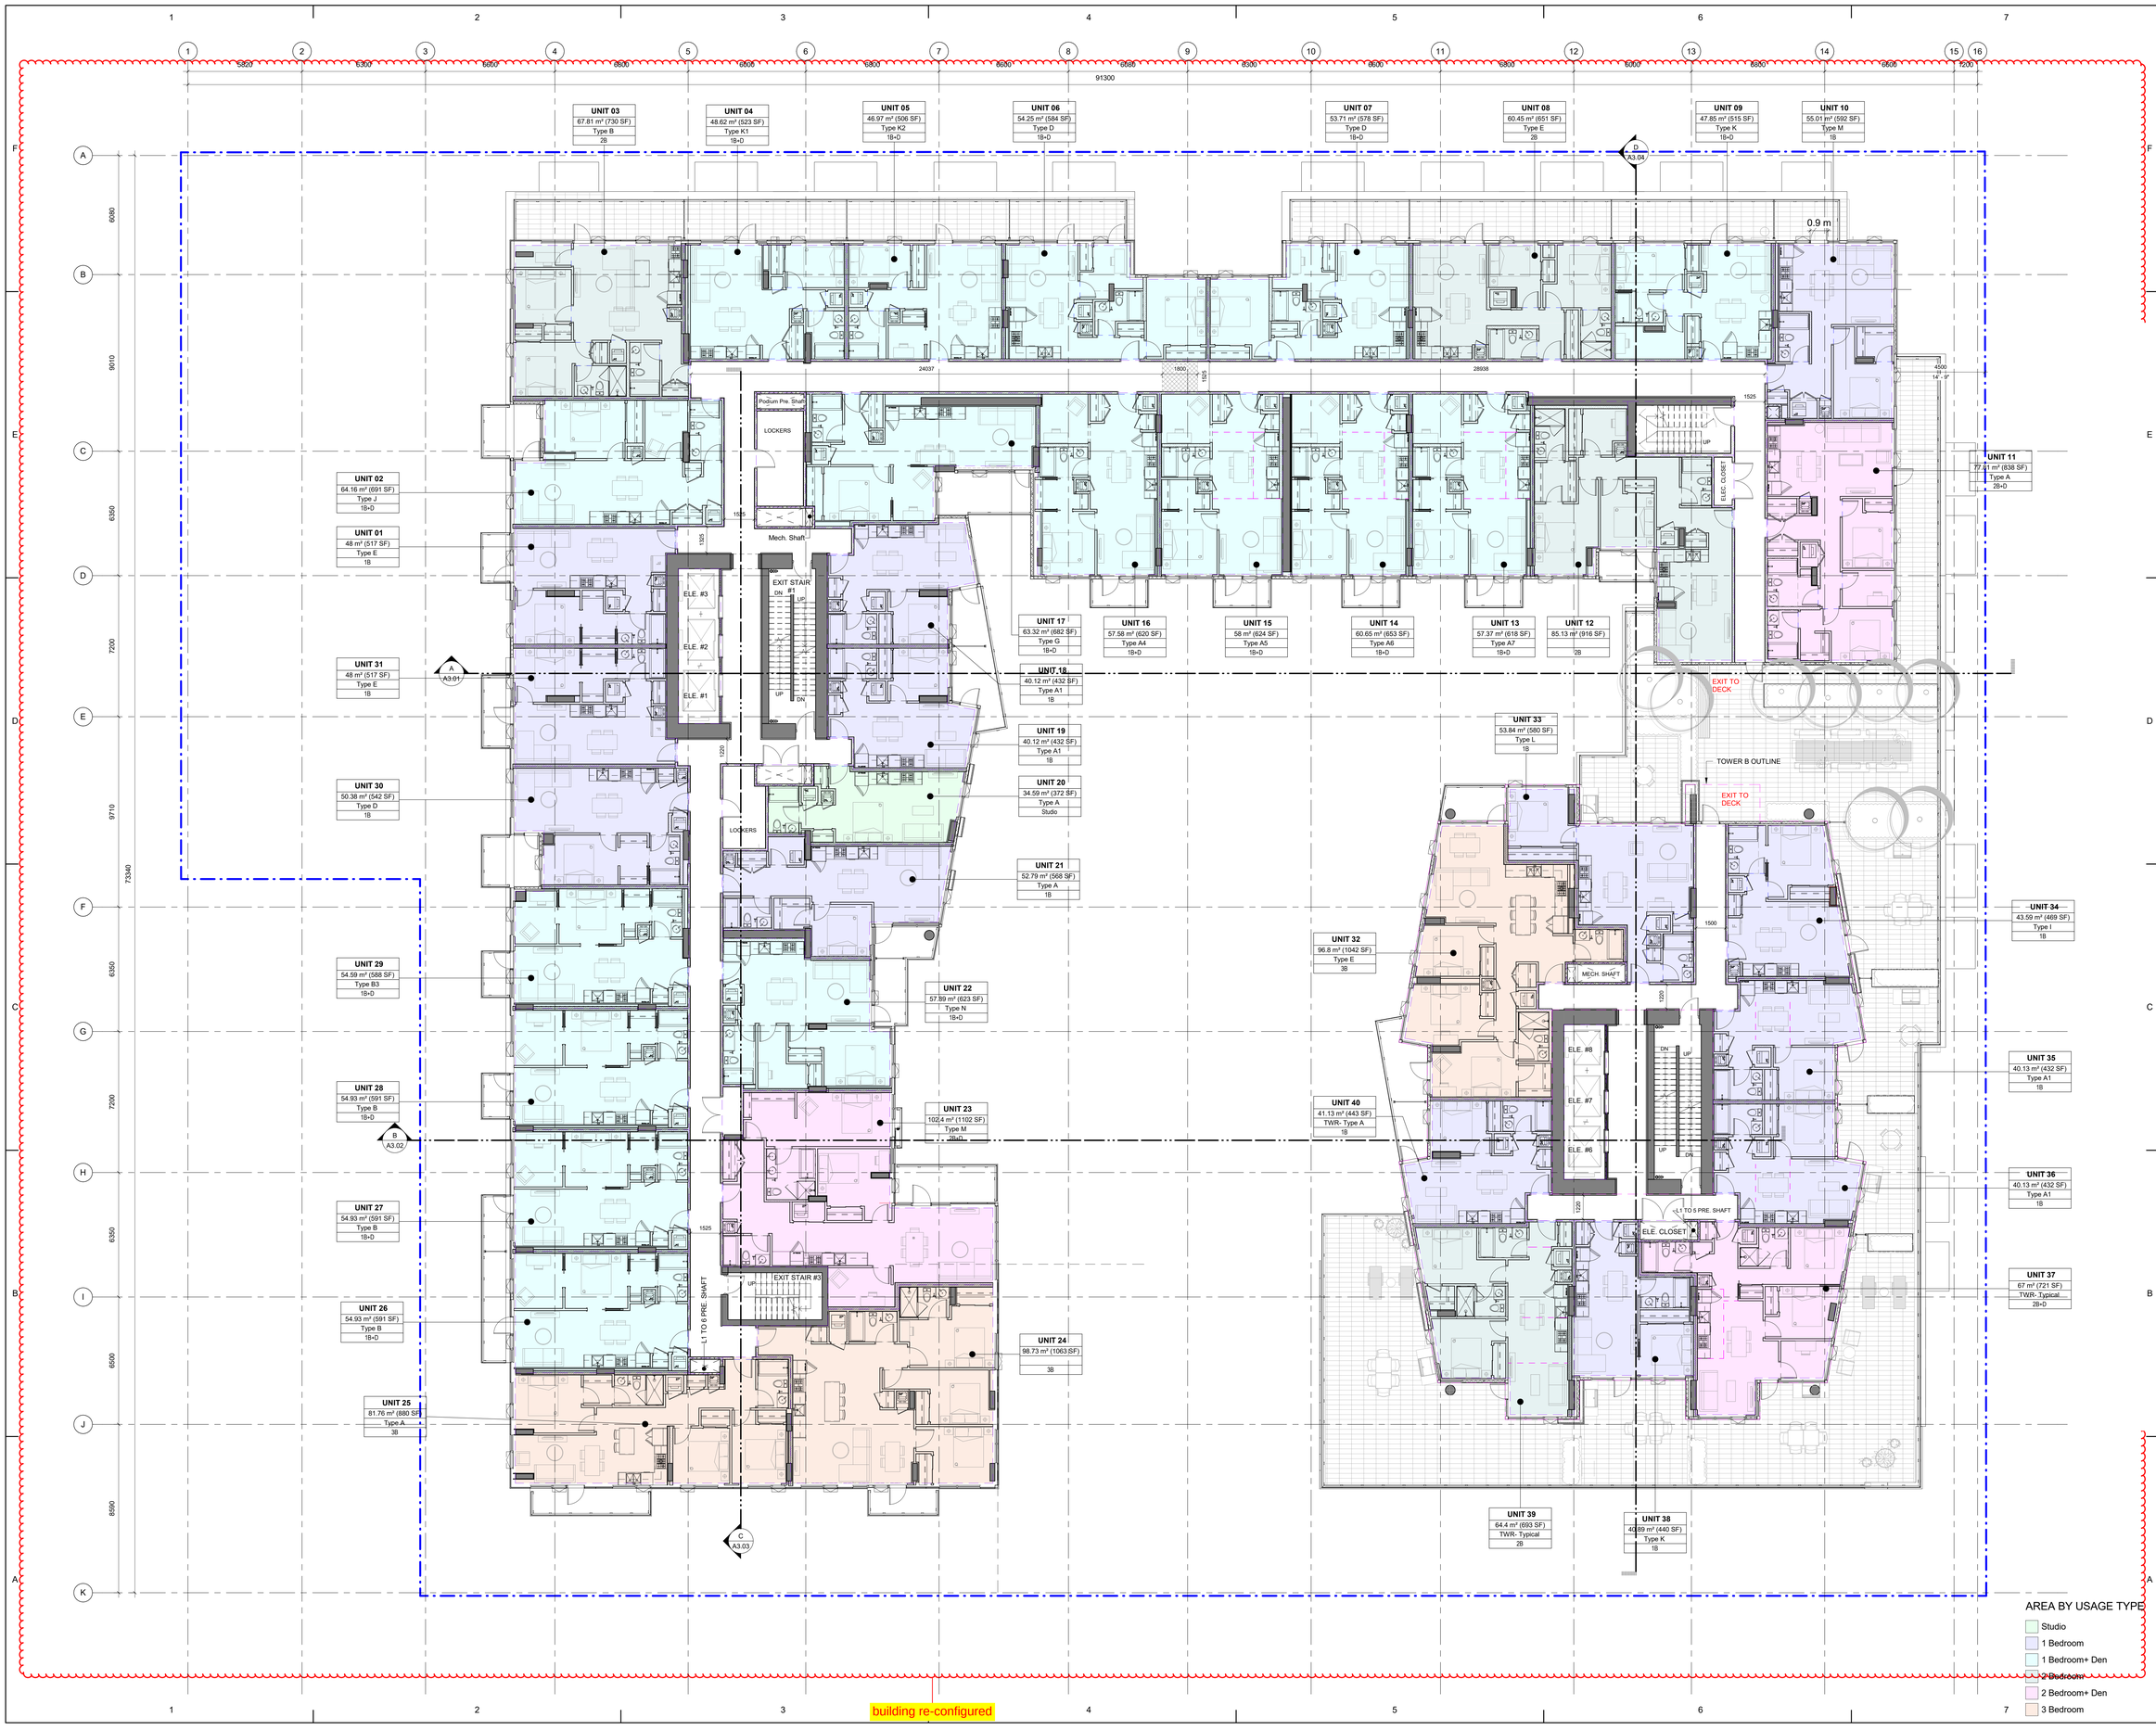

CLIENT

Starlight Developments

Starlight Developments
P.O. Box 1690 Station B Mississauga, Ontario, Canada
L4Y 3W8

COPYRIGHT:
This drawing has been prepared solely for the intended use, thus any reproduction or distribution for any purpose other than authorized by IBI Group is forbidden. Written dimensions shall have precedence over scaled dimensions. Contractors shall verify and be responsible for all dimensions and conditions on the job, and IBI Group shall be informed of any variations from the dimensions and conditions shown on the drawing. Shop drawings shall be submitted to IBI Group for general conformance before proceeding with fabrication.

IBI Group Architects (Canada) Inc.
is a member of the IBI Group of companies

NO.	DATE	DESCRIPTION
1	YYYY-MM-DD	

ISSUES

NO.	DATE	DESCRIPTION

REVISIONS

PROJECT NORTH
N

Issued For: Project Status
Date: 2021-03-05

SEAL
REGISTERED ARCHITECT JOHN GWYN PUGH BRITISH COLUMBIA
2021-03-06

SUB-CONSULTANT

PRIME CONSULTANT
IBI GROUP
ARCHITECTS (CANADA) INC.
700-1285 West Pender Street
Vancouver, BC V6E 4B1, Canada
tel 604 683 8797 fax 604 683 0492
ibigroup.com

PROJECT TITLE
Harris Green Village
Phase 01
1045 Yates Street
Victoria, BC

PROJECT NO:	121123
DRAWN BY:	Author
CHK'D BY:	Checker
SCALE:	1 : 100
DATE:	2021-03-05

SHEET TITLE
OVERALL LEVEL 05 PLAN

SHEET NUMBER
A1.09

REV

File Location: BIM 360://121123 - Yates Street – Harris Green Village Ph 1 MASSING_YatesStA-Podium-2020.rvt
Last Saved: 2021-03-05 10:20:57 PM

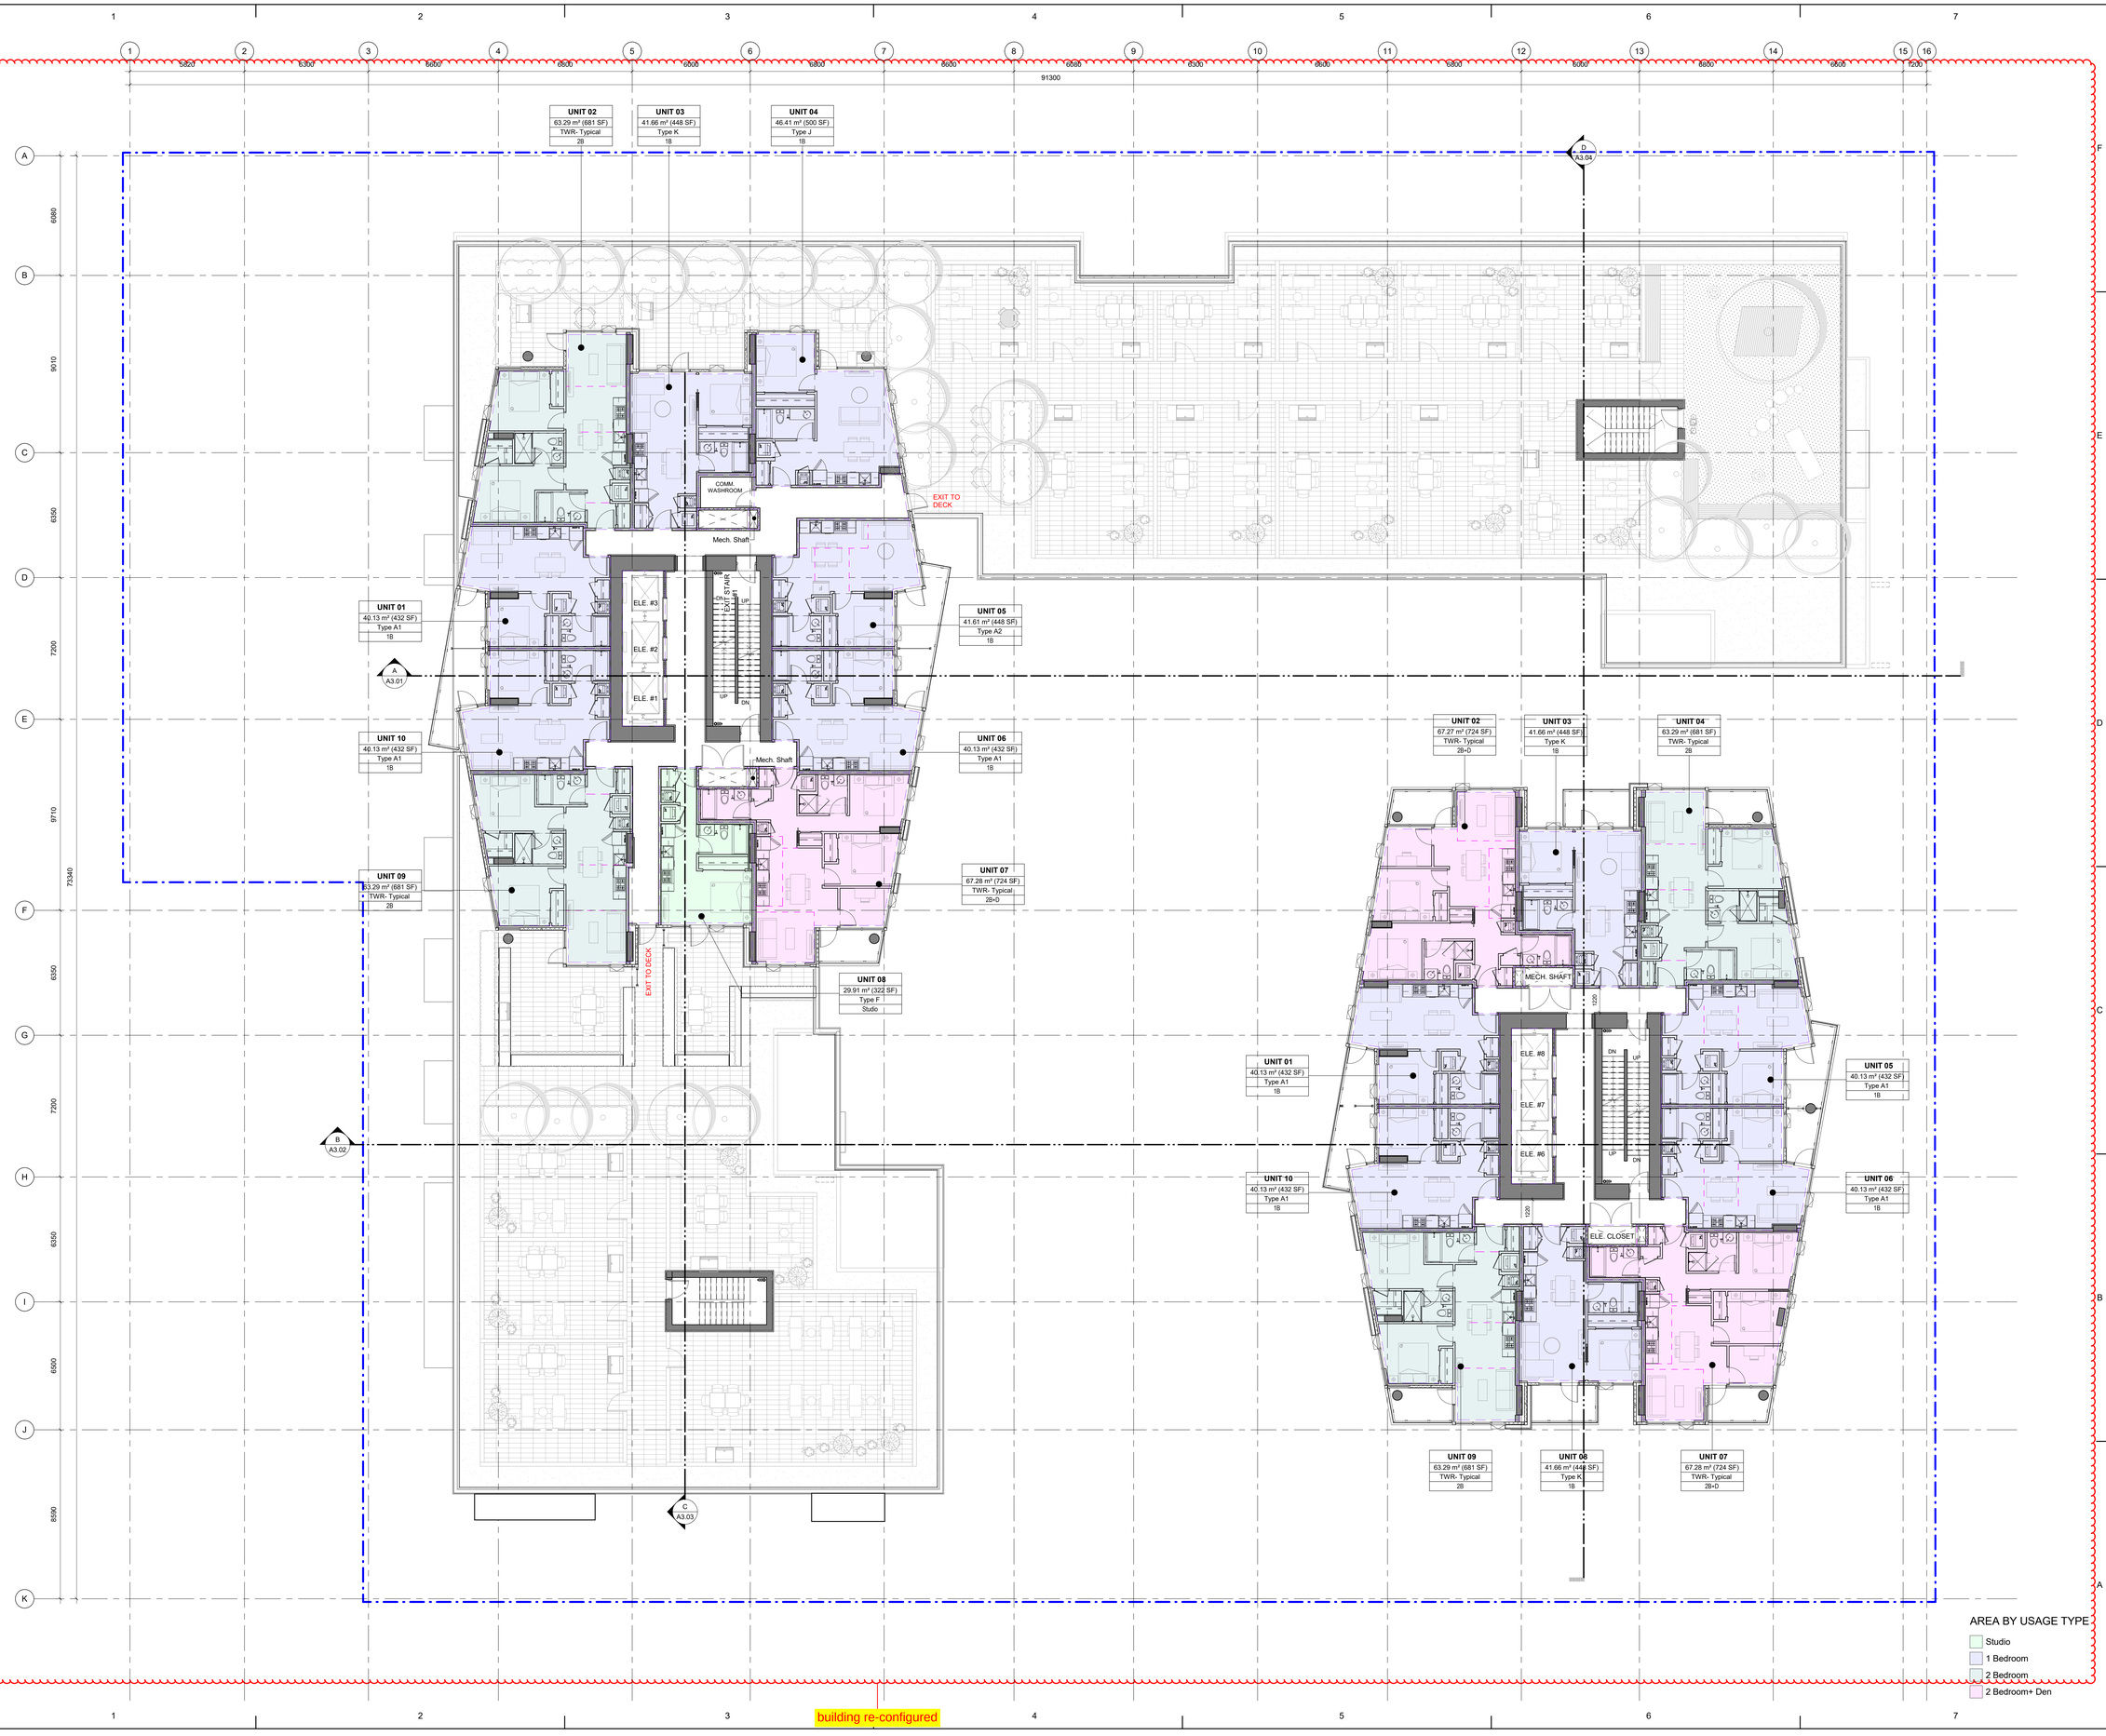

CLIENT

Starlight Developments

Starlight Developments

P.O. Box 1890 Station B Mississauga, Ontario, Canada
L4Y 3W8

COPYRIGHT:
This drawing has been prepared solely for the intended use, thus any reproduction or distribution for any purpose other than authorized by IBI Group is forbidden. Written dimensions shall have precedence over scaled dimensions. Contractors shall verify and be responsible for all dimensions and conditions on the job, and IBI Group shall be informed of any variations from the dimensions and conditions shown on the drawing. Shop drawings shall be submitted to IBI Group for general conformance before proceeding with fabrication.

IBI Group Architects (Canada) Inc.
is a member of the IBI Group of companies

NO.	DATE	DESCRIPTION
1	YYYY-MM-DD	

ISSUES

NO.	DATE	DESCRIPTION

REVISIONS

PROJECT NORTH
N

Issued For: Project Status
Date: 2021-03-05

SEAL

REGISTERED ARCHITECT
JOHN GWYN HOOPER
PROVINCE OF BRITISH COLUMBIA
2021-03-05

SUB-CONSULTANT

PRIME CONSULTANT

IBI GROUP
ARCHITECTS (CANADA) INC.
700-1285 West Pender Street,
Vancouver, BC V6E 4B1, Canada
tel 604 683 8797 fax 604 683 0492
ibigroup.com

PROJECT TITLE
Harris Green Village
Phase 01
1045 Yates Street
Victoria, BC

PROJECT NO:	121123
DRAWN BY:	Author
CHK'D BY:	Checker
SCALE:	1 : 100
DATE:	2021-03-05

SHEET TITLE
OVERALL LEVEL 06 PLAN

SHEET NUMBER
A1.10

REV

Last Saved: 2021-03-05 10:21:08 PM File Location: BIM 360://121123 - Yates Street – Harris Green Village Ph 1\20200121123_YatesStA-Podium2020.rvt

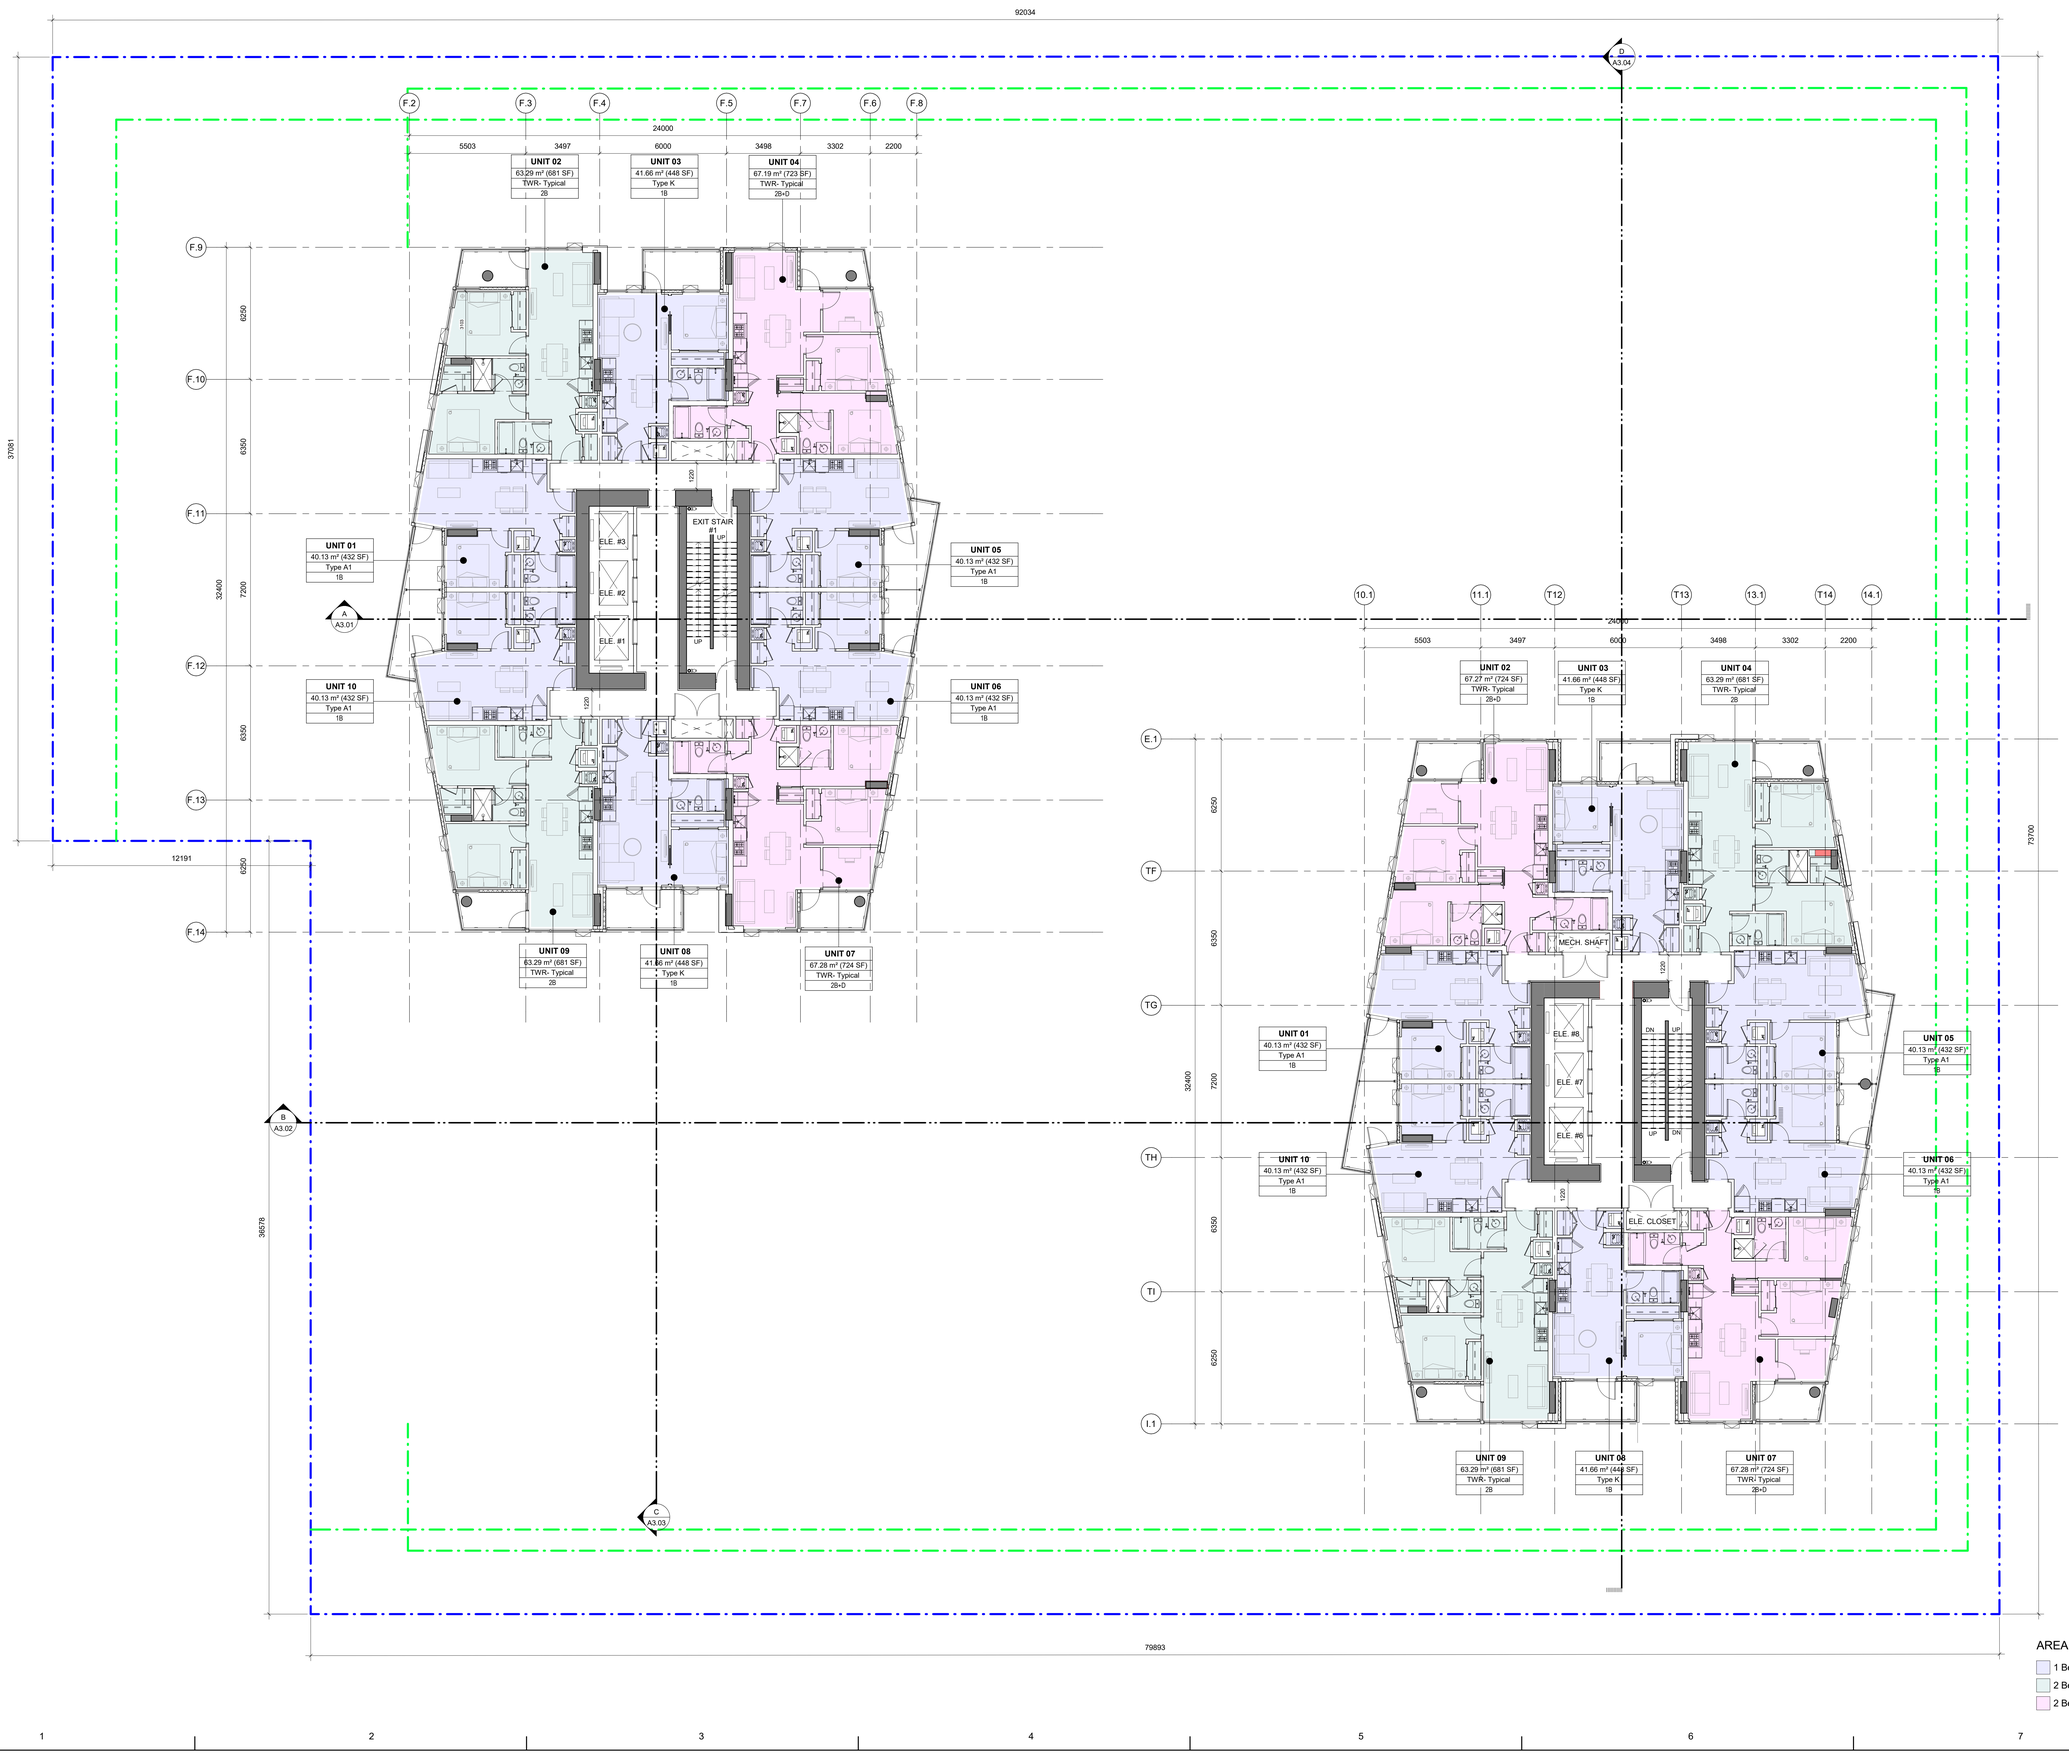

AREA BY USAGE TYPE

- 1 Bedroom
- 2 Bedroom
- 2 Bedroom+ Den

CLIENT

Starlight Developments

Starlight Developments

P.O. Box 1690 Station B Mississauga, Ontario, Canada L4Y 3W8

COPYRIGHT:
This drawing has been prepared solely for the intended use, thus any reproduction or distribution for any purpose other than authorized by IBI Group is forbidden. Written dimensions shall have precedence over scaled dimensions. Contractors shall verify and be responsible for all dimensions and conditions on the job, and IBI Group shall be informed of any variations from the dimensions and conditions shown on the drawing. Shop drawings shall be submitted to IBI Group for general conformance before proceeding with fabrication.

IBI Group Architects (Canada) Inc.
is a member of the IBI Group of companies

NO.	DATE	DESCRIPTION
1	YYYY-MM-DD	

ISSUES

NO.	DATE	DESCRIPTION

REVISIONS

PROJECT NORTH

N

Issued For: Project Status

Date: 2021-03-05

SEAL

REGISTERED ARCHITECT JOHN GWYN HUGHES PROVINCE OF BRITISH COLUMBIA

2021-03-06

SUB-CONSULTANT

PRIME CONSULTANT

IBI GROUP
ARCHITECTS (CANADA) INC.
700-1285 West Pender Street,
Vancouver, BC V6E 4B1, Canada
tel 604 683 8797 fax 604 683 0492
ibigroup.com

PROJECT TITLE

Harris Green Village
Phase 01
1045 Yates Street
Victoria, BC

PROJECT NO:	121123
DRAWN BY:	
CHK'D BY:	
SCALE:	1 : 100
DATE:	2021-03-05

SHEET TITLE

OVERALL TYPICAL TOWER FLOOR PLAN

SHEET NUMBER

A1.11

REV

Last Saved: 2021-03-05 10:21:14 PM File Location: BIM 360://121123 - Yates Street – Harris Green Village Ph 1\20200121123_YatesStA-Podium2020.rvt

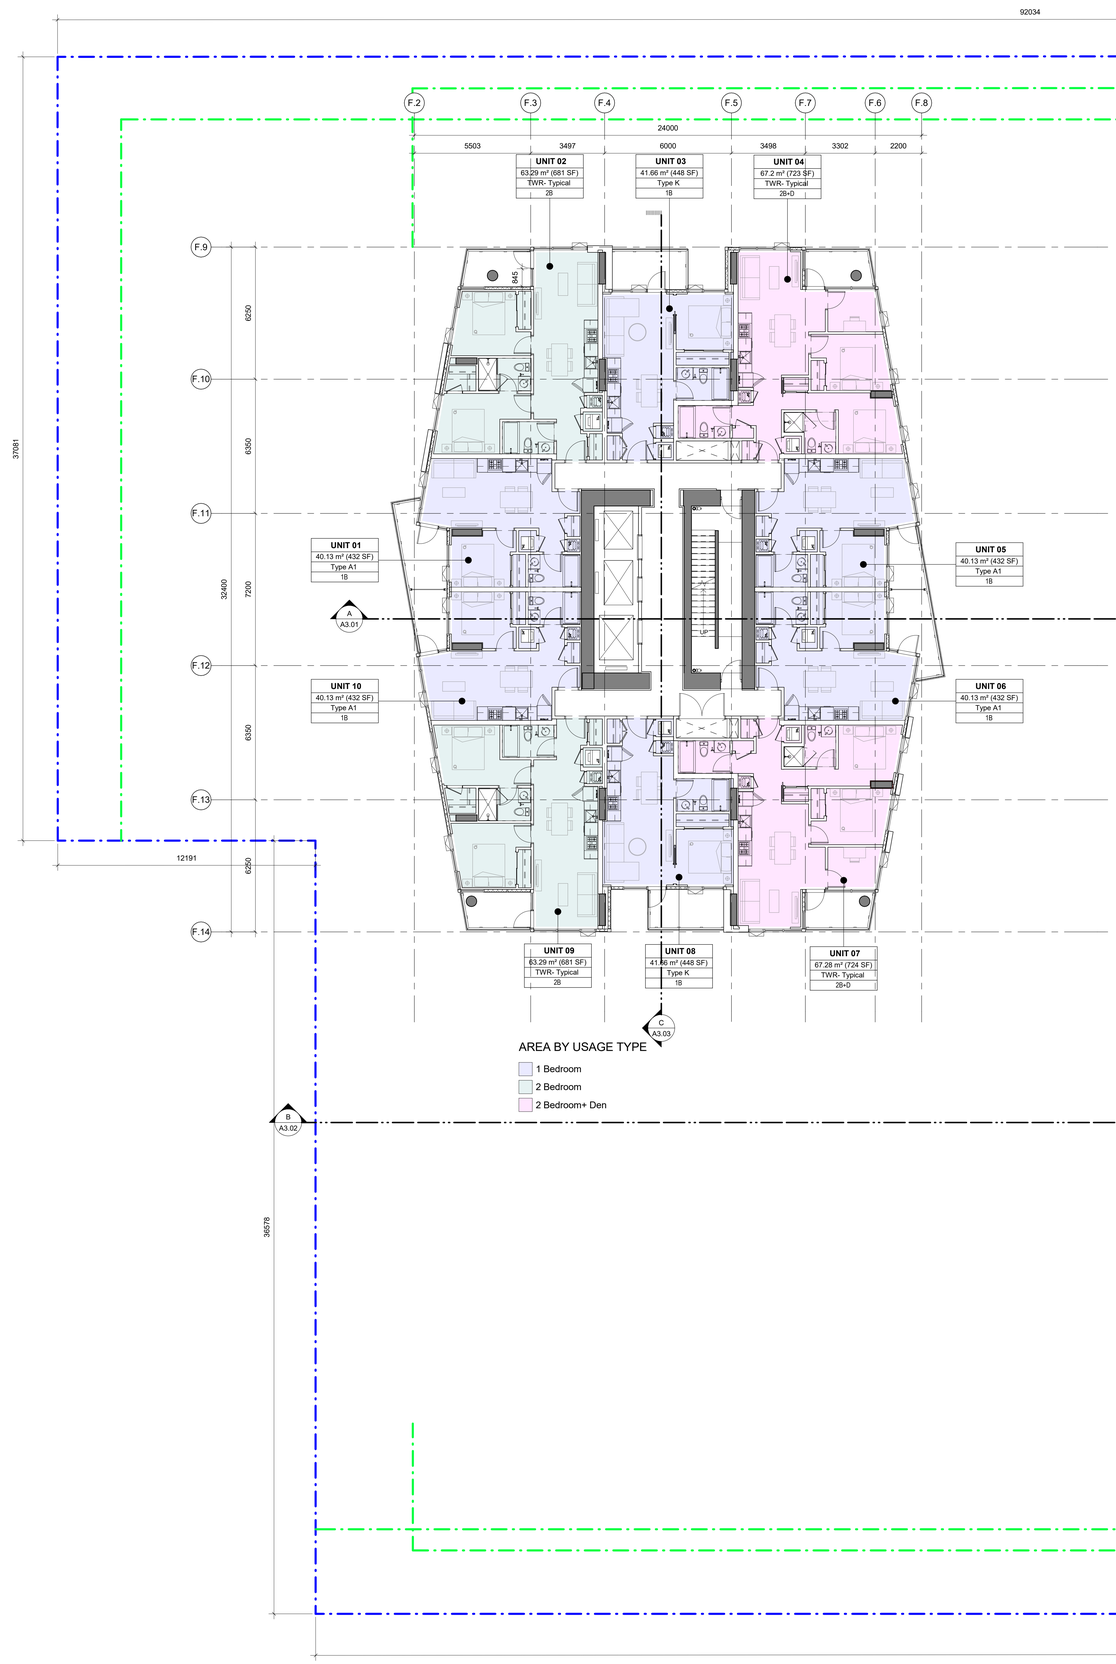

tower b mech shifted to inside to reduce appearance

CLIENT

Starlight Developments

Starlight Developments
P.O. Box 1690 Station B Mississauga, Ontario, Canada
L4Y 3W8

COPYRIGHT:
This drawing has been prepared solely for the intended use, thus any reproduction or distribution for any purpose other than authorized by IBI Group is forbidden. Written dimensions shall have precedence over scaled dimensions. Contractors shall verify and be responsible for all dimensions and conditions on the job, and IBI Group shall be informed of any variations from the dimensions and conditions shown on the drawing. Shop drawings shall be submitted to IBI Group for general conformance before proceeding with fabrication.
IBI Group Architects (Canada) Inc.
is a member of the IBI Group of companies

NO.	DATE	DESCRIPTION
1	YYYY-MM-DD	

ISSUES

NO.	DATE	DESCRIPTION

REVISIONS

PROJECT NORTH
N

Issued For: Project Status
Date: 2021-03-05

SEAL
REGISTERED ARCHITECT JOHN GWYN HUGHES BRITISH COLUMBIA
2021-03-06

SUB-CONSULTANT

PRIME CONSULTANT
IBI GROUP
ARCHITECTS (CANADA) INC.
700-1285 West Pender Street,
Vancouver, BC V6E 4B1, Canada
tel 604 683 8797 fax 604 683 0402
ibigroup.com

PROJECT TITLE
Harris Green Village
Phase 01
1045 Yates Street
Victoria, BC

PROJECT NO:	121123
DRAWN BY:	
CHK'D BY:	
SCALE:	1 : 100
DATE:	2021-03-05

SHEET TITLE
OVERALL LEVEL 21 (TOWER B ROOF)

SHEET NUMBER
A1.12

REV

Last Saved: 2021-03-05 10:21:21 PM File Location: I:\BIM 360\121123 - Yates Street - Harris Green Village Ph 1 R2020\121123_Yates53-A-Podium-2020.rvt

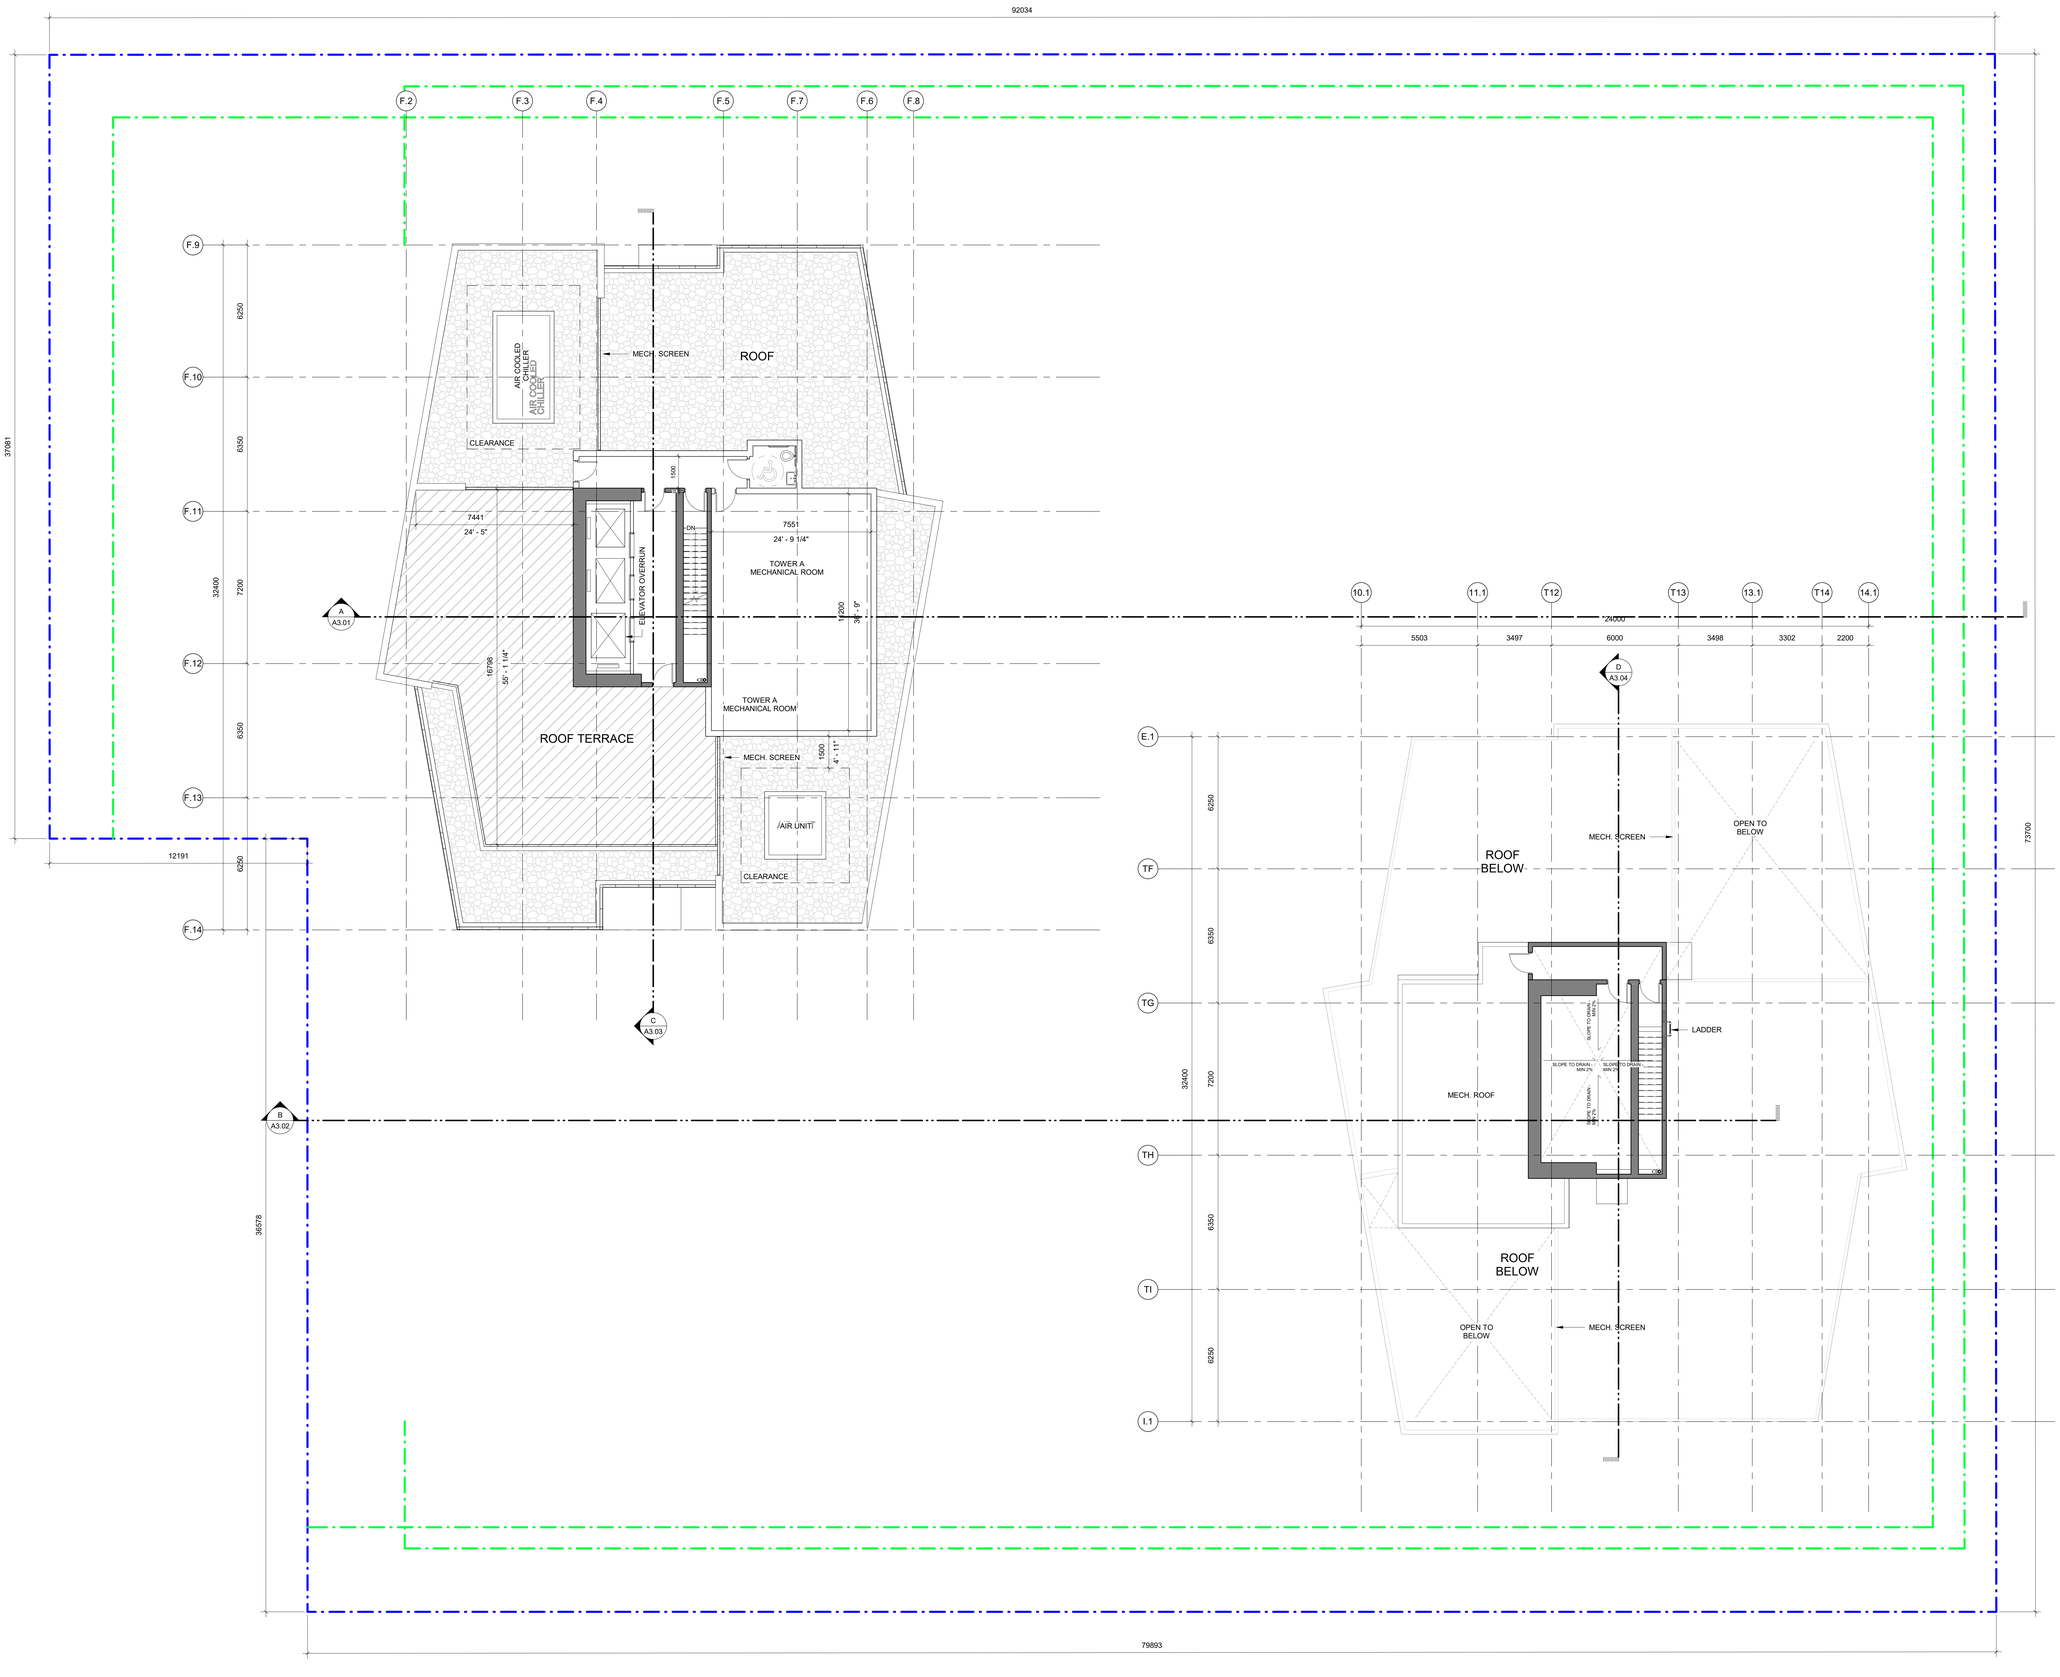

Tower A accessible roof terrace added

CLIENT

Starlight Developments

Starlight Developments
P.O. Box 1690 Station B Mississauga, Ontario, Canada
L4Y 3W8

COPYRIGHT:
This drawing has been prepared solely for the intended use, thus any reproduction or distribution for any purpose other than authorized by IBI Group is forbidden. Written dimensions shall have precedence over scaled dimensions. Contractors shall verify and be responsible for all dimensions and conditions on the job, and IBI Group shall be informed of any variations from the dimensions and conditions shown on the drawing. Shop drawings shall be submitted to IBI Group for general conformance before proceeding with fabrication.
IBI Group Architects (Canada) Inc.
is a member of the IBI Group of companies

NO.	DATE	DESCRIPTION
1	YYYY-MM-DD	

ISSUES

NO.	DATE	DESCRIPTION

REVISIONS

PROJECT NORTH
N

Issued For: Project Status
Date: 2021-03-05

SEAL
REGISTERED ARCHITECT JOHN GIWA BRITISH COLUMBIA
2021-03-05

SUB-CONSULTANT

PRIME CONSULTANT
IBI
IBI GROUP
ARCHITECTS (CANADA) INC.
700-1285 West Pender Street
Vancouver, BC V6E 4B1, Canada
tel 604 683 8797 fax 604 683 0492
ibigroup.com

PROJECT TITLE
Harris Green Village
Phase 01
1045 Yates Street
Victoria, BC

PROJECT NO:	121123
DRAWN BY:	
CHK'D BY:	
SCALE:	1 : 100
DATE:	2021-03-05

SHEET TITLE
OVERALL LEVEL 22
(ROOF TWR (A) & TWR (B) MECH. ROOF)

SHEET NUMBER
A1.13

REV

Last Saved: 2021-03-05 10:21:26 PM File Location: BIM 360://121123 - Yates Street – Harris Green Village Ph 1 MD20//121123_YatesStr-A-Portion-2020.rvt

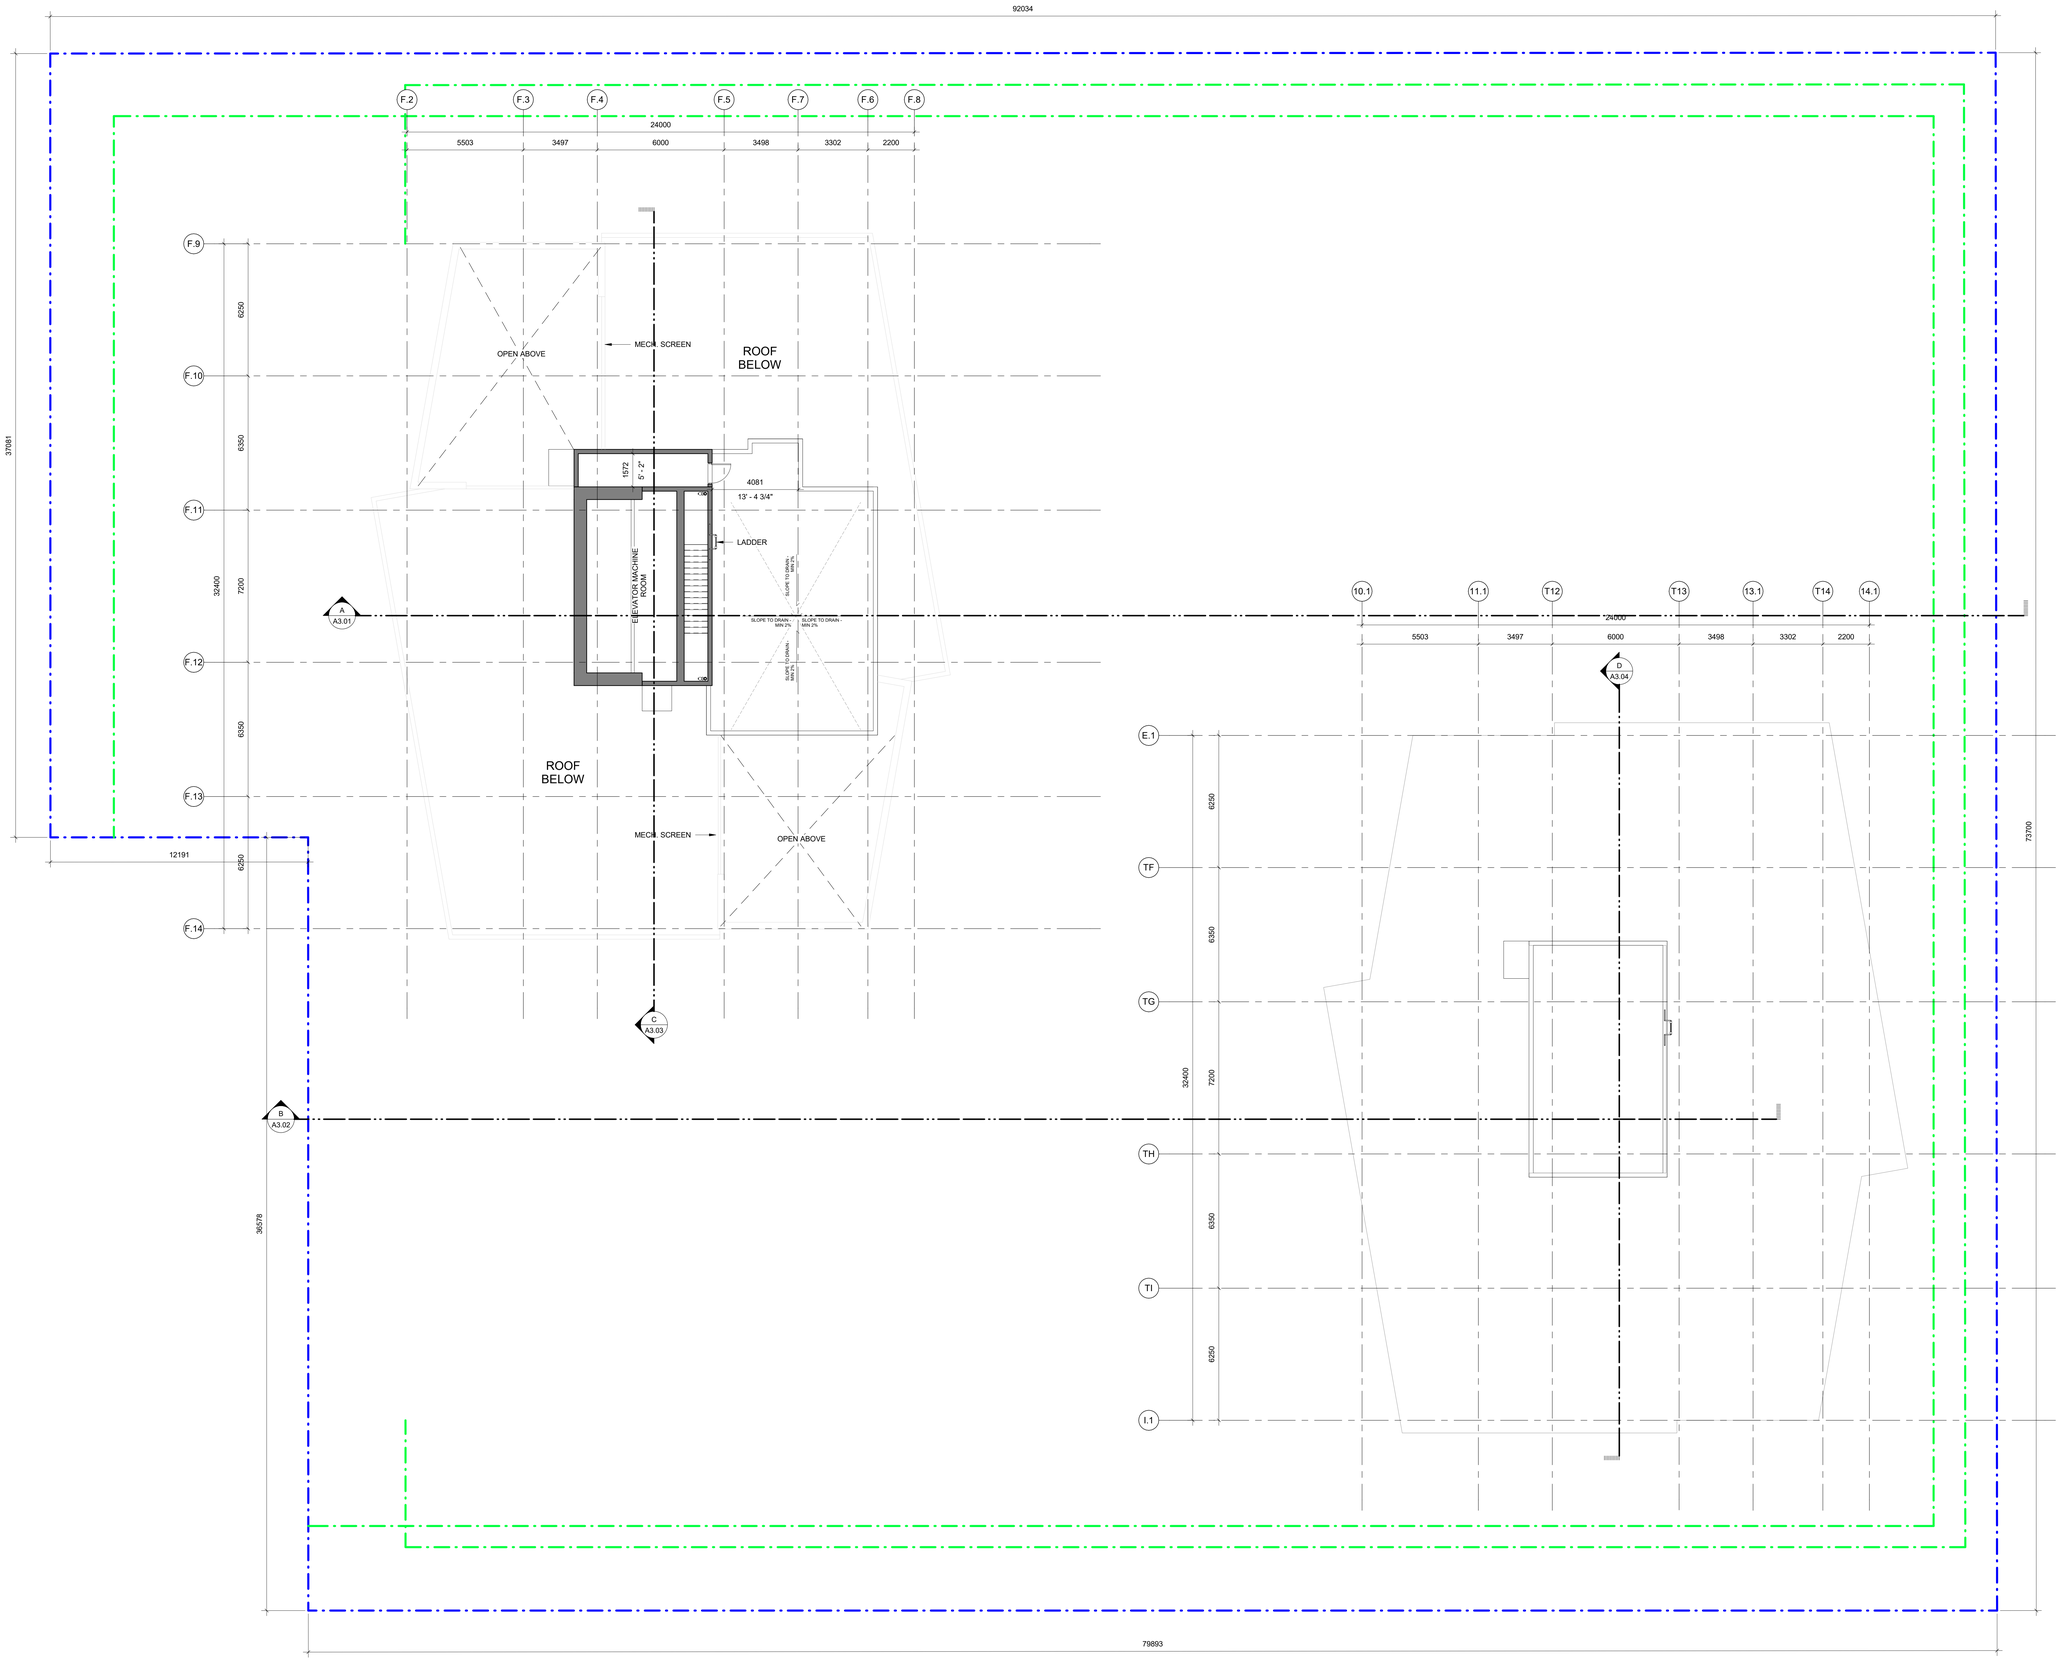

1 2 3 4 5 6 7

F E D C B A

CLIENT

Starlight Developments

Starlight Developments
P.O. Box 1690 Station B Mississauga, Ontario, Canada
L4Y 3W8

COPYRIGHT:
This drawing has been prepared solely for the intended use, thus any reproduction or distribution for any purpose other than authorized by IBI Group is forbidden. Written dimensions shall have precedence over scaled dimensions. Contractors shall verify and be responsible for all dimensions and conditions on the job, and IBI Group shall be informed of any variations from the dimensions and conditions shown on the drawing. Shop drawings shall be submitted to IBI Group for general conformance before proceeding with fabrication.

IBI Group Architects (Canada) Inc.
is a member of the IBI Group of companies

NO.	DATE	DESCRIPTION
1	YYYY-MM-DD	

ISSUES

NO.	DATE	DESCRIPTION

REVISIONS

PROJECT NORTH
N

Issued For: Project Status
Date: 2021-03-05

SEAL

REGISTERED ARCHITECT JOHN GIBBS ARCHITECT BRITISH COLUMBIA
2021-03-06

SUB-CONSULTANT

PRIME CONSULTANT

IBI GROUP
ARCHITECTS (CANADA) INC.
700-1285 West Pender Street,
Vancouver, BC V6E 4B1, Canada
tel 604 683 8797 fax 604 683 0492
ibigroup.com

PROJECT TITLE
Harris Green Village
Phase 01
1045 Yates Street
Victoria, BC

PROJECT NO:	121123
DRAWN BY:	
CHK'D BY:	
SCALE:	1 : 100
DATE:	2021-03-05

SHEET TITLE
OVERALL LEVEL 23 (TWR (A) MECH. ROOF & TWR (B) UPPER ROOF)

SHEET NUMBER
A1.14

REV

Last Saved: 2021-03-05 10:21:09 PM File Location: BIM 360://121123 - Yates Street – Harris Green Village Ph 1 (DO20)/121123_Yates3-A-Podium-2020.rvt

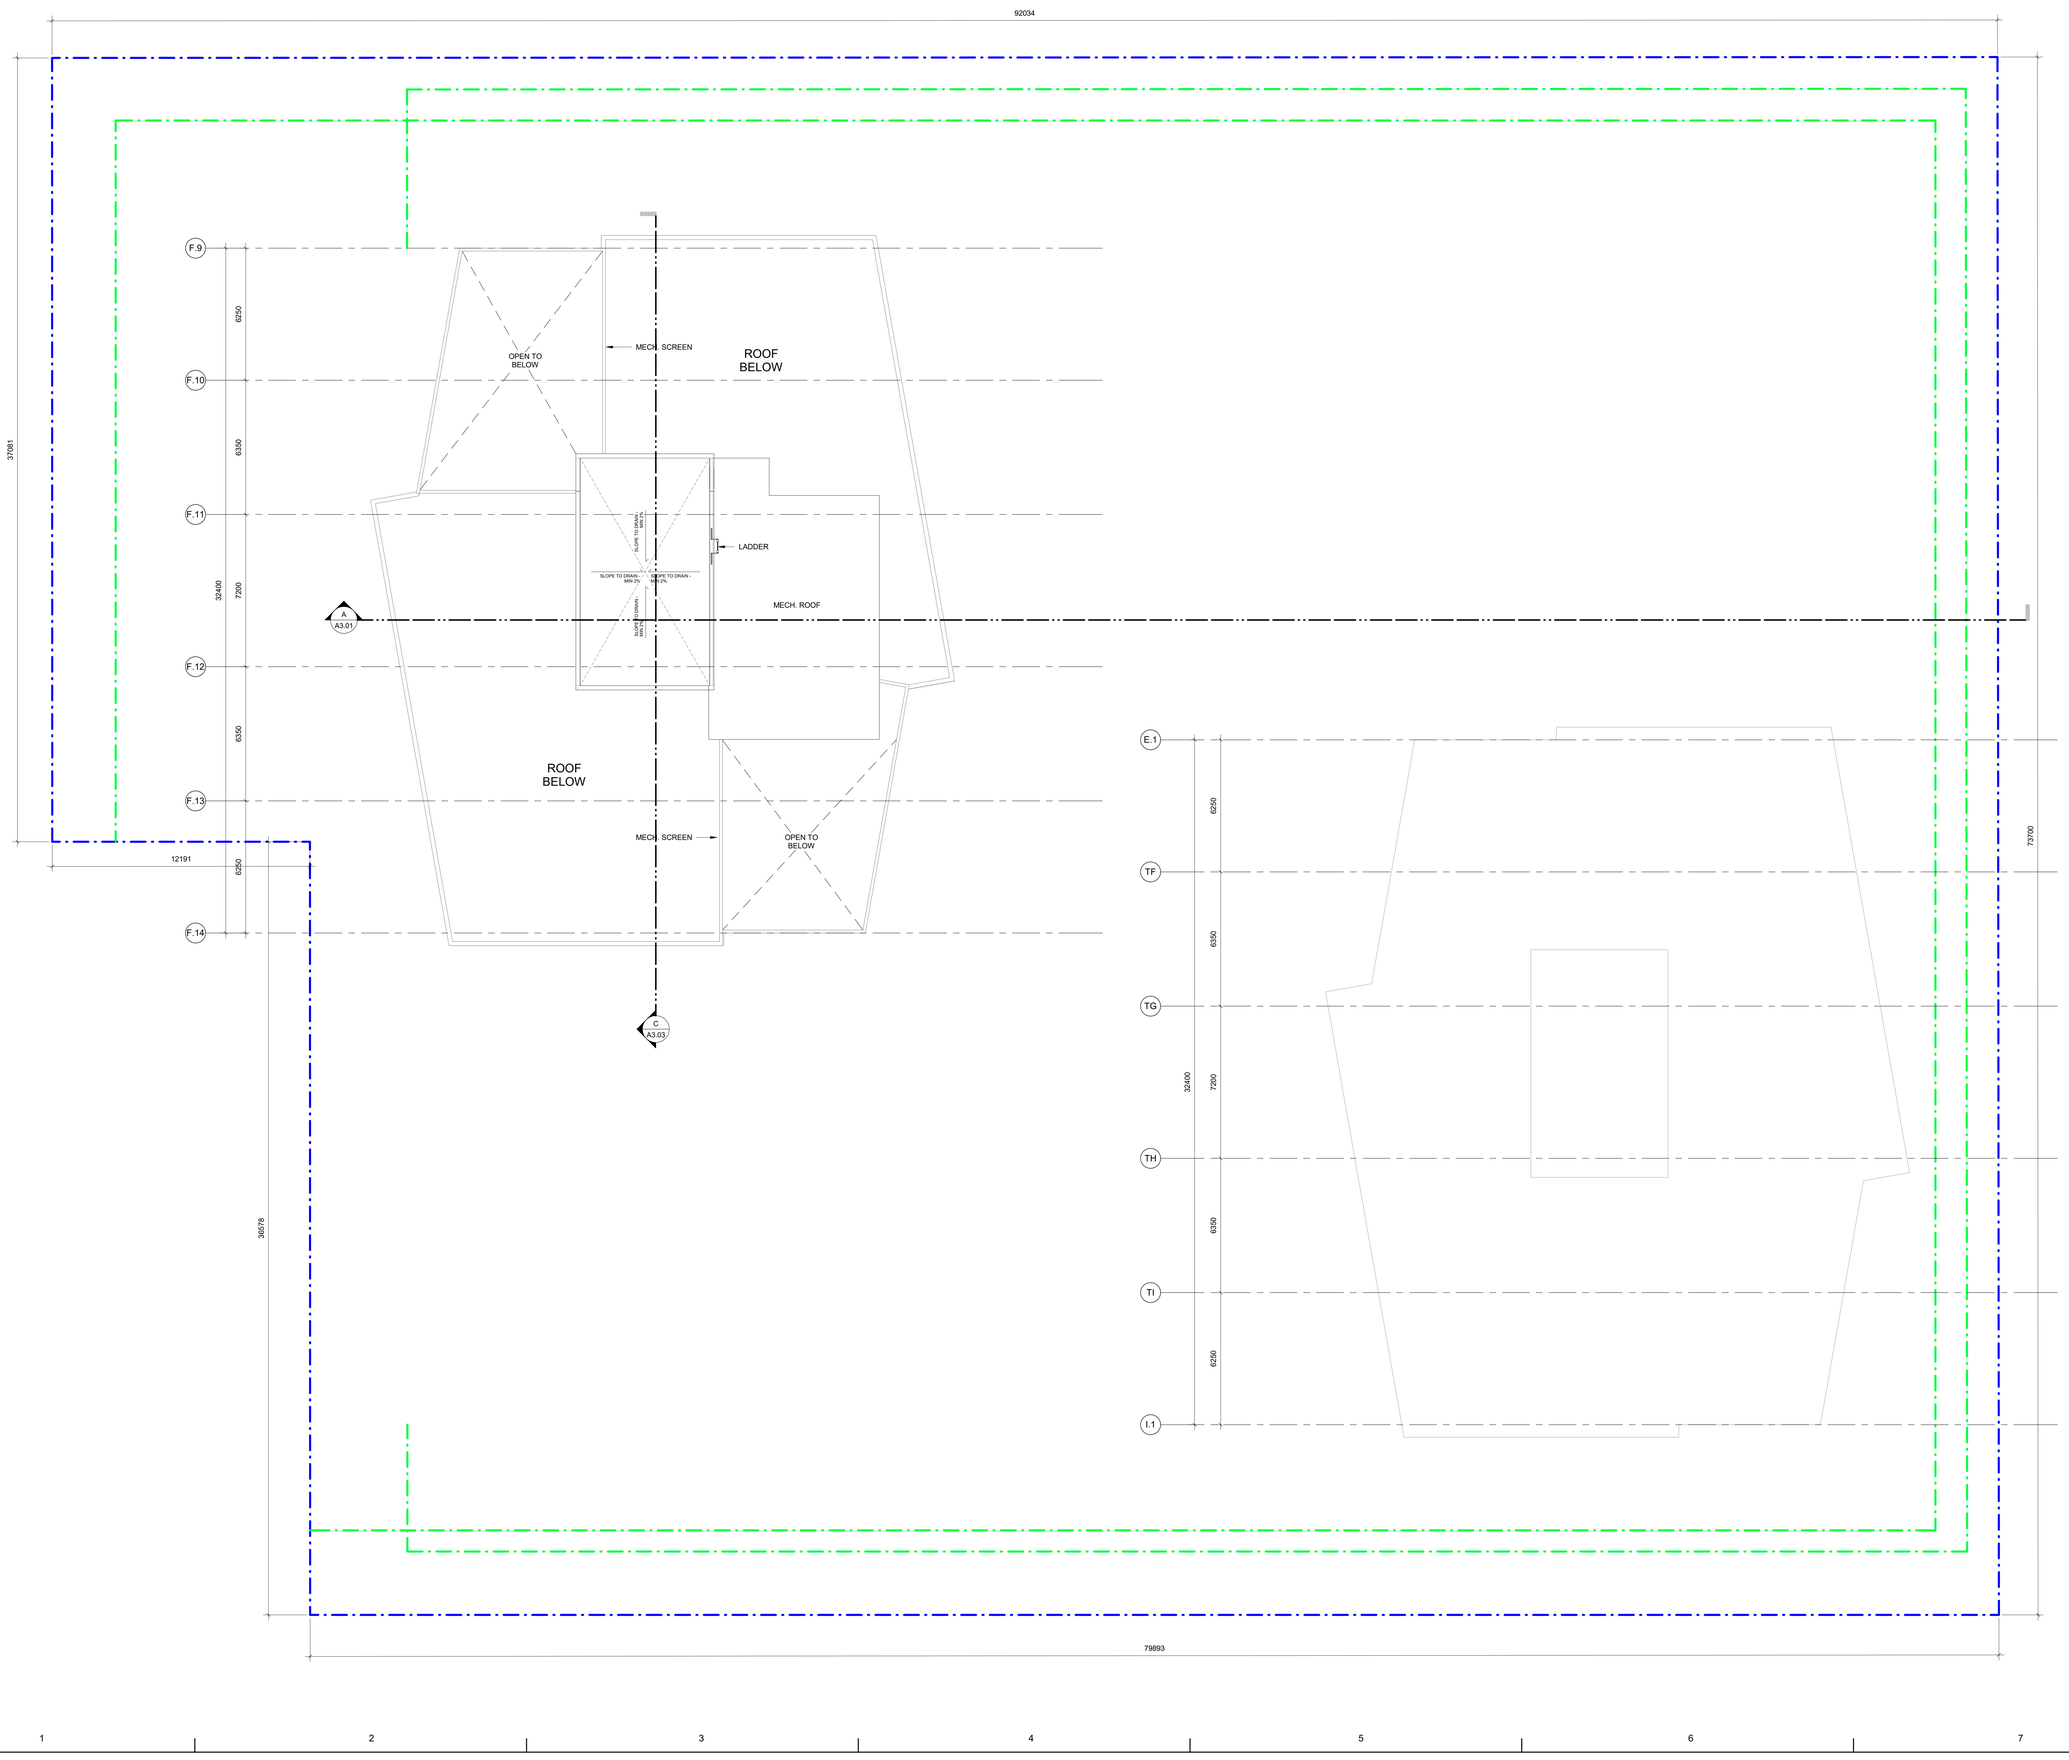

CLIENT

Starlight Developments

P.O. Box 1690 Station B Mississauga, Ontario, Canada
L4Y 3W8

COPYRIGHT:
This drawing has been prepared solely for the intended use, thus any reproduction or distribution for any purpose other than authorized by IBI Group is forbidden. Written dimensions shall have precedence over scaled dimensions. Contractors shall verify and be responsible for all dimensions and conditions on the job, and IBI Group shall be informed of any variations from the dimensions and conditions shown on the drawing. Shop drawings shall be submitted to IBI Group for general conformance before proceeding with fabrication.

IBI Group Architects (Canada) Inc.
is a member of the IBI Group of companies

NO.	DATE	DESCRIPTION
1	YYYY-MM-DD	

ISSUES

NO.	DATE	DESCRIPTION

REVISIONS

PROJECT NORTH

Issued For: Project Status
Date: 2021-03-05

SEAL

REGISTERED ARCHITECT JOHN GIWA BRITISH COLUMBIA
2021-03-06

SUB-CONSULTANT

PRIME CONSULTANT

IBI GROUP
ARCHITECTS (CANADA) INC.
700-1285 West Pender Street,
Vancouver, BC V6E 4B1, Canada
tel 604 683 8797 fax 604 683 0492
ibigroup.com

PROJECT TITLE
Harris Green Village
Phase 01
1045 Yates Street
Victoria, BC

PROJECT NO:	121123
DRAWN BY:	
CHKD BY:	
SCALE:	1 : 100
DATE:	2021-03-05

SHEET TITLE
OVERALL LEVEL 24 (TWR (A) UPPER ROOF)

SHEET NUMBER
A1.15

REV

Last Saved: 2021-03-05 10:21:31 PM File Location: BIM 360://121123 - Yates Street – Harris Green Village Ph 1 R22/001121123_YatesStA-Podium-2020.rvt

TOWER B

TOWER A

65.42m measured from AVG GRADE to top of Last occupied Floor

71.66m measured from AVG GRADE to top of Appurtenance

77.61m measured from AVG GRADE to top of Appurtenance

71.21m measured from AVG GRADE to top of Last occupied Floor

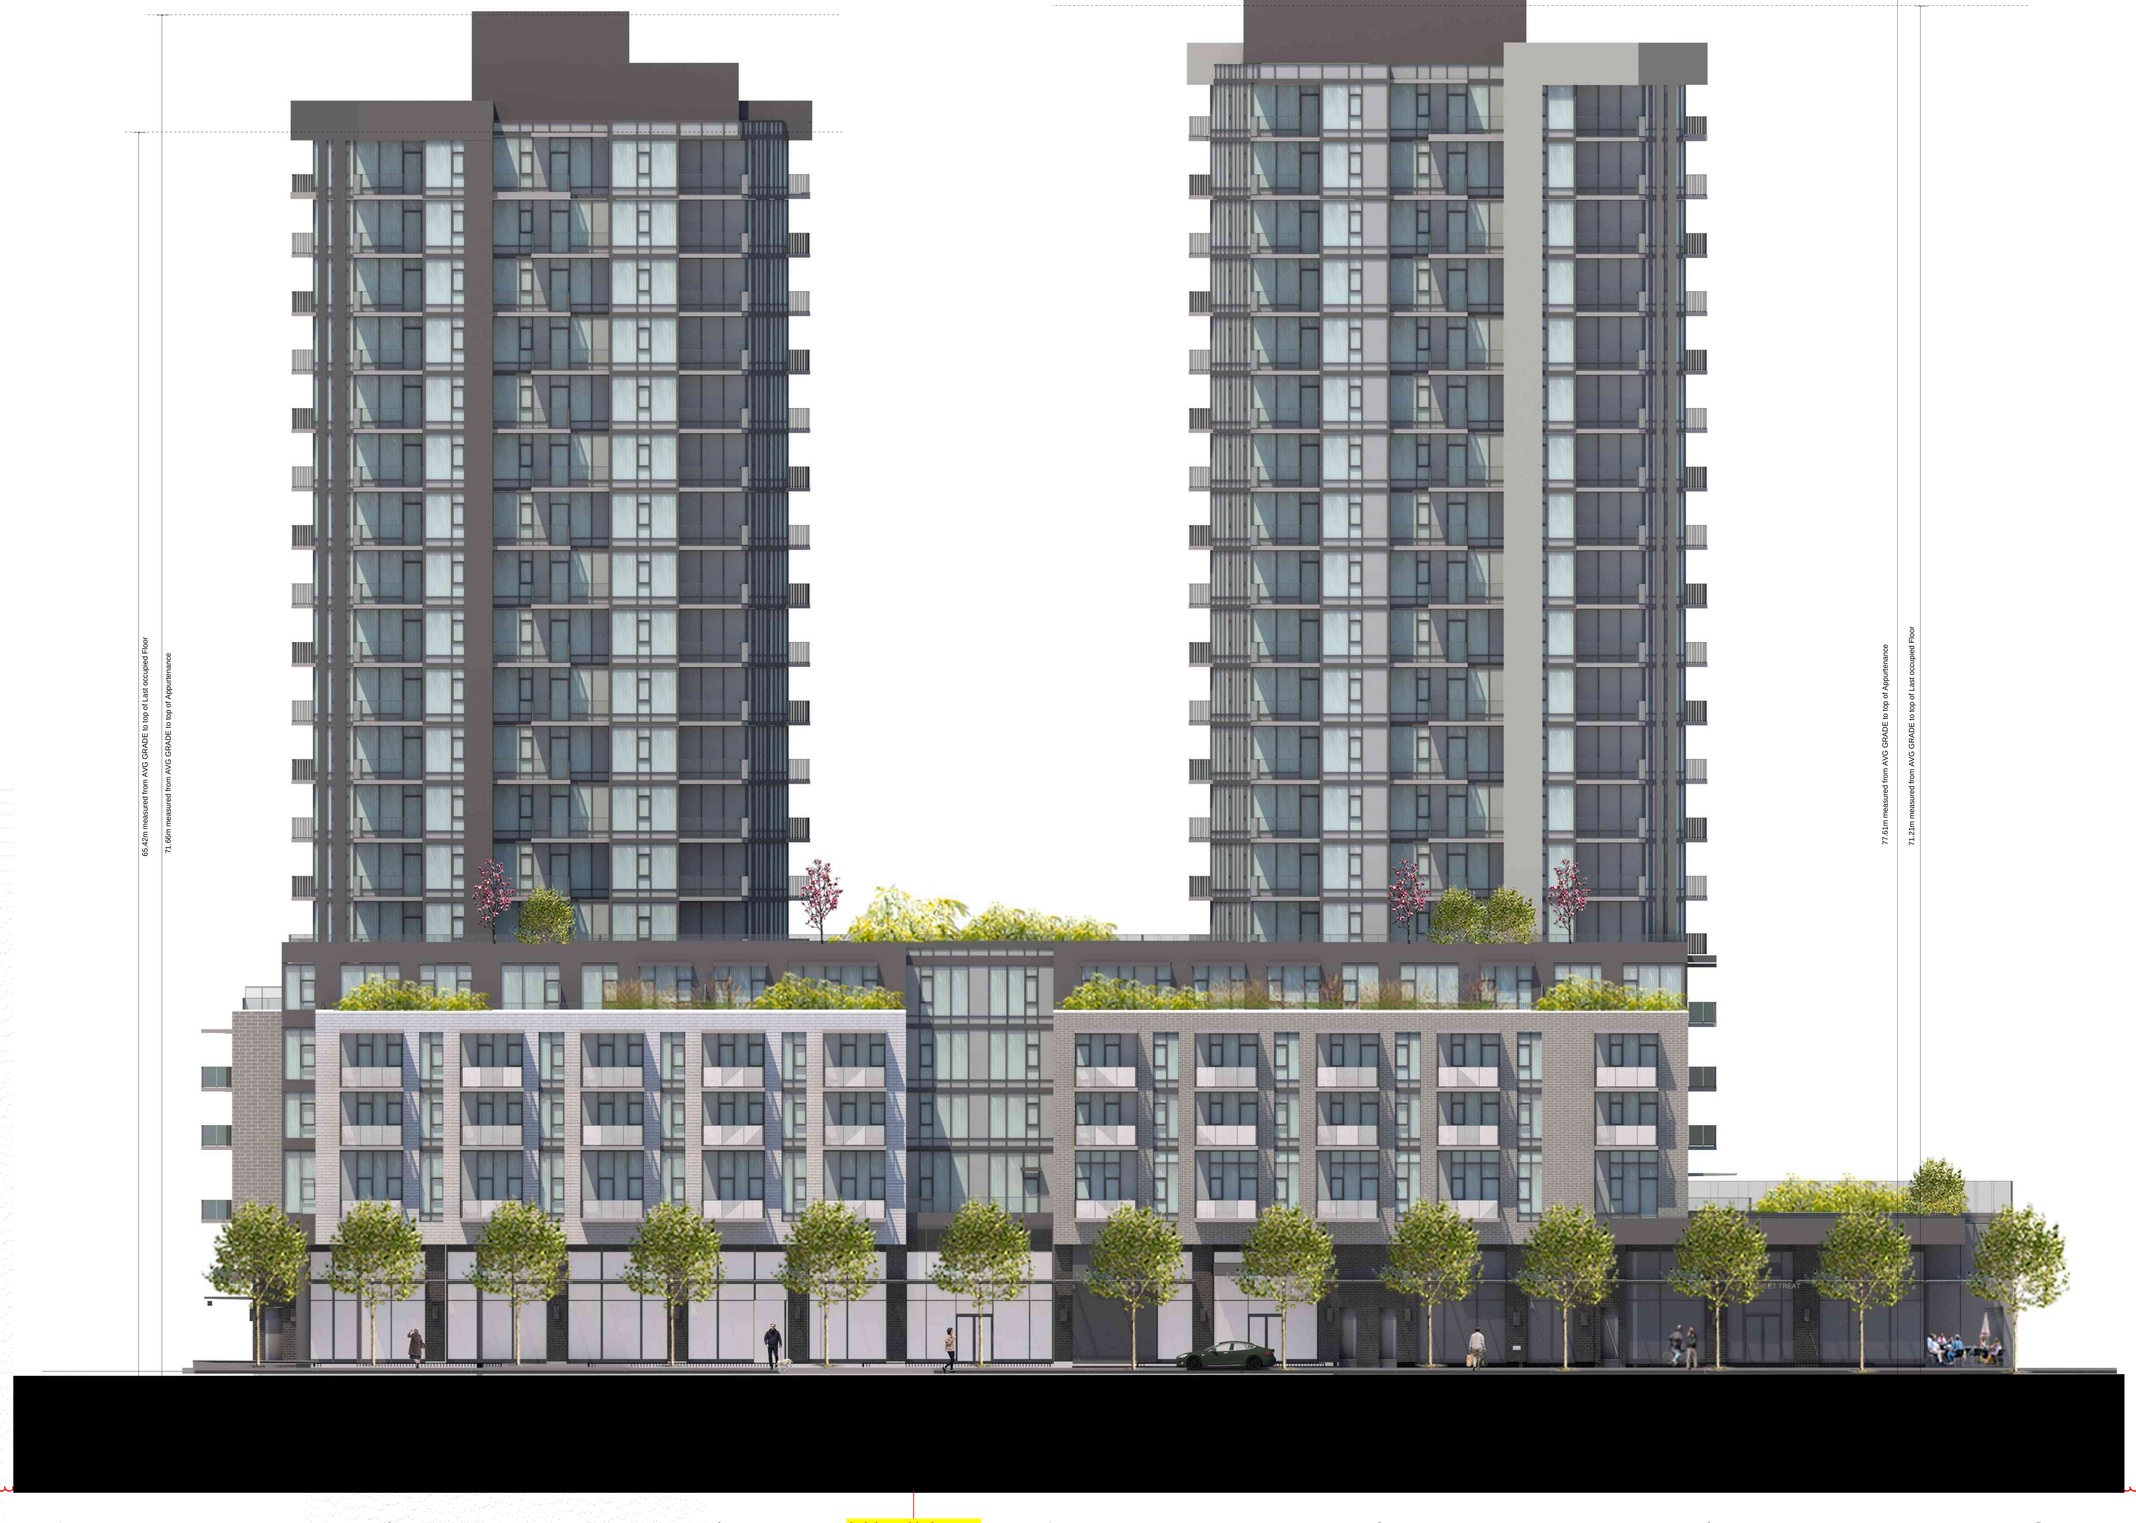

heights added;
spandrel reduced
massing reconfigured

CLIENT

Starlight Developments

Starlight Developments
P.O.Box 1690 Station B Mississauga, Ontario, Canada
L4Y1W6

COPYRIGHT:
This drawing has been prepared solely for the intended use, thus any reproduction or distribution for any purpose other than authorized by IBI Group is forbidden. Written dimensions shall have precedence over scaled dimensions. Contractors shall verify and be responsible for all dimensions and conditions on the job, and IBI Group shall be notified of any variations between actual conditions and the items shown on the drawing. Shop drawings shall be submitted to IBI Group for general conformance before proceeding with fabrication.
IBI Group Architects (Canada) Inc.
is a member of the IBI Group of companies

NO.	DATE	DESCRIPTION
1	YYYY-MM-DD	

ISSUES

NO.	DATE	DESCRIPTION

REVISIONS

Issued For: Project Status
Date: 2021-03-05

SEAL

REGISTERED ARCHITECT JOHN GWYN HOLT BRITISH COLUMBIA
2021-03-06

BCB CONSULTANT

PRIME CONSULTANT

IBI GROUP
ARCHITECTS (CANADA) INC.
700-1285 West Pender Street,
Vancouver, BC V6E 4B1, Canada
tel 604 683 8797 fax 604 683 0492
ibigroup.com

PROJECT TITLE
Harris Green Village
Phase 01
1045 Yates Street
Victoria, BC

PROJECT NO:	121123
DRAWN BY:	Author
CHKD BY:	Checker
SCALE:	
DATE:	2021-03-05

SHEET TITLE
COLOR NORTH ELEVATION

SHEET NUMBER
A2.01

REV

Last Saved: 2021-03-05 10:22:15 PM File Location: BIM 360://121123 - Yates Street – Harris Green Village Ph 1 R20/20191123_YatesStA-A-Podium-2020.rvt

heights added;
spandrel reduced
massing reconfigured

CLIENT

Starlight Developments

Starlight Developments
P.O.Box 1690 Station B Mississauga, Ontario, Canada
L4Y1W8

COPYRIGHT:
This drawing has been prepared solely for the intended use, thus any reproduction or distribution for any purpose other than authorized by IBI Group is forbidden. Written dimensions shall have precedence over scaled dimensions. Contractors shall verify and be responsible for all dimensions and conditions on the job, and IBI Group shall be notified of any variations between the conditions and the information shown on the drawing. Shop drawings shall be submitted to IBI Group for general conformance before proceeding with fabrication.
IBI Group Architects (Canada) Inc.
is a member of the IBI Group of companies

NO.	DATE	DESCRIPTION
1	YYYY-MM-DD	

ISSUES

NO.	DATE	DESCRIPTION

REVISIONS

Issued For: Project Status
Date: 2021-03-05

SEAL

REGISTERED ARCHITECT JOHN GWYN JONES BRITISH COLUMBIA
2021-03-06

SUB-CONSULTANT

PRIME CONSULTANT

IBI GROUP
ARCHITECTS (CANADA) INC.
700-1285 West Pender Street,
Vancouver, BC V6E 4B1, Canada
tel 604 683 8797 fax 604 683 0402
ibigroup.com

PROJECT TITLE
Harris Green Village
Phase 01
1045 Yates Street
Victoria, BC

PROJECT NO:	121123
DRAWN BY:	Author
CHK'D BY:	Checker
SCALE:	
DATE:	2021-03-05

SHEET TITLE
COLOR EAST ELEVATION

SHEET NUMBER
A2.02

REV

Last Saved: 2021-03-05 10:22:44 PM File Location: I:\BIM-360\121123 - Yates Street - Harris Green Village Ph 1 B2020\121123_YatesStA-Podium-2020.rvt

heights added;
spandrel reduced
massing reconfigured

CLIENT

Starlight Developments

light Developments
Box 1890 Station B Mississauga, Ontario, Canada
W8

YRIGHT:
drawing has been prepared solely for the intended use, thus any duction or distribution for any purpose other than authorized by roup is forbidden. Written dimensions shall have precedence scaled dimensions. Contractors shall verify and be responsible dimensions and conditions on the job, and IBI Group shall be ified of any variations from the dimensions and conditions shown this drawing. Shop drawings shall be submitted to IBI Group for ital conformance before proceeding with fabrication.

IBI Group Architects (Canada) Inc.
is a member of the IBI Group of companies

DATE	DESCRIPTION
YYYY-MM-DD	

UES

DATE	DESCRIPTION

VISIONS

Issued For: Project Status
Date: 2021-03-05

L

REGISTERED ARCHITECT JOHN GWYN BRITISH COLUMBIA
2021-03-06

CONSULTANT

ME CONSULTANT

IBI GROUP
ARCHITECTS (CANADA) INC.
700-1285 West Pender Street
Vancouver, BC V6E 4B1, Canada
tel 604 683 8797 fax 604 683 0492
ibigroup.com

JECT TITLE
Harris Green Village
Phase 01
1045 Yates Street
Victoria, BC

OJECT NO:	121123
AWN BY:	Author
CD BY:	Checker
ALE:	
TE:	2021-03-05

ET TITLE
OLOR SOUTH
LEVATION

ET NUMBER
A2.03

REV

Last Saved: 2021-03-05 10:23:29 PM File Location: BIM 360://121123 - Yates Street – Harris Green Village Ph 1 KD/200121123_YatesStA-Portion-2020.rvt

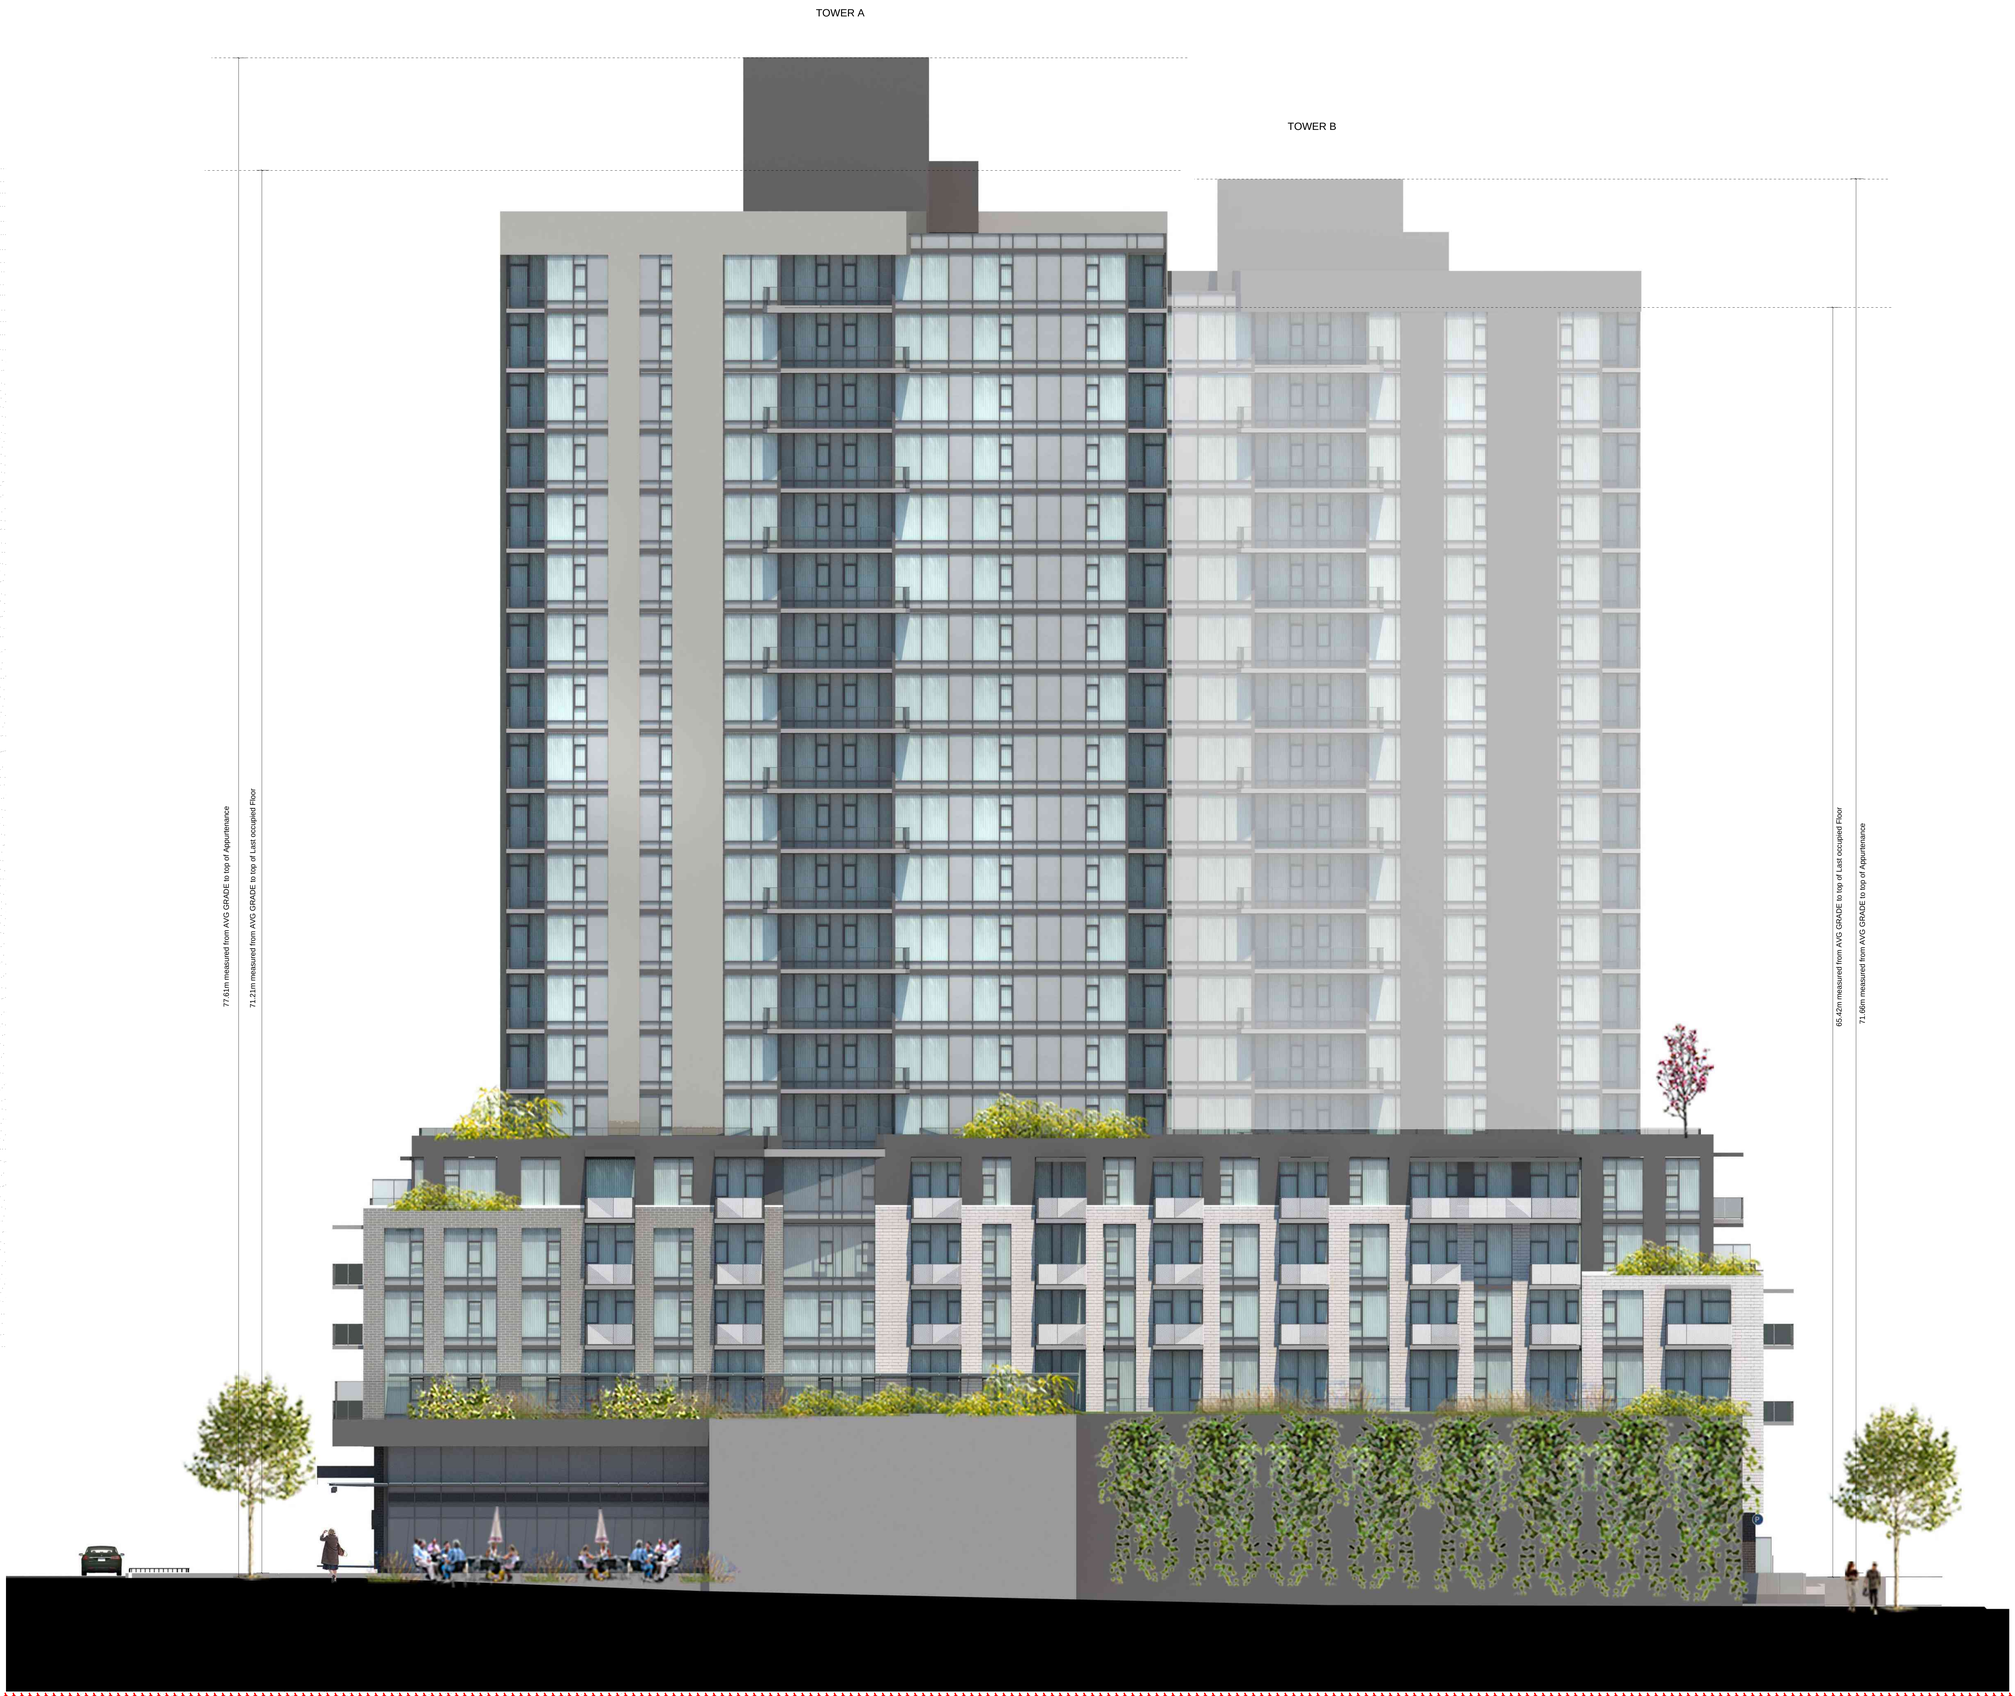

heights added;
spandrel reduced
massing reconfigured

CLIENT

Starlight Developments

Starlight Developments
P.O.Box 1690 Station B Mississauga, Ontario, Canada
L4Y3W8

COPYRIGHT:
This drawing has been prepared solely for the intended use, thus any reproduction or distribution for any purpose other than authorized by IBI Group is forbidden. Written dimensions shall have precedence over scaled dimensions. Contractors shall verify and be responsible for all dimensions and conditions on the job, and IBI Group shall be notified of any variations. Information shown on this drawing shown on any drawing. Shop drawings shall be submitted to IBI Group for general conformance before proceeding with fabrication.
IBI Group Architects (Canada) Inc.
is a member of the IBI Group of companies

NO.	DATE	DESCRIPTION
1	YYYY-MM-DD	

ISSUES

NO.	DATE	DESCRIPTION

REVISIONS

Issued For: Project Status

Date: 2021-03-05

SEAL

REGISTERED ARCHITECT JOHN GIANN KOUTSEY BRITISH COLUMBIA
2021-03-05

SUB-CONSULTANT

PRIME CONSULTANT

IBI GROUP
ARCHITECTS (CANADA) INC.
700-1285 West Pender Street,
Vancouver, BC V6E 4B1, Canada
tel 604 683 8797 fax 604 683 0492
ibigroup.com

PROJECT TITLE

Harris Green Village
Phase 01
1045 Yates Street
Victoria, BC

PROJECT NO:	121123
DRAWN BY:	Author
CHKD BY:	Checker
SCALE:	
DATE:	2021-03-05

SHEET TITLE

COLOR WEST ELEVATION

SHEET NUMBER

A2.04

REV

Last Saved: 2021-03-05 10:24:15 PM File Location: BIM 360/121123 - Yates Street – Harris Green Village Ph 1 (GO2)/121123_Yates-St-A-Podium-2020.rvt

MATERIAL LEGEND	
Key Value	Keynote Text
AL01	WOOD TONED ALUMINUM SOFFIT
AL02	ALUMINUM LOUVER-GRAY
AL03	ALUMINUM PANEL -LIGHT GRAY
AL04	ALUMINUM PANEL -DARK GRAY
B01	BRICK - DARK GRAY
B02	BRICK - WHITE
B03	BRICK - WARM GRAY
C01	PAINTED CONCRETE-WARM GRAY
C02	PAINTED CONCRETE-DARK GRAY
G01	ALUMINUM WINDOW WALL -DARK GRAY -GRAY SPANDREL
G02	ALUMINUM WINDOW WALL -DARK GRAY -CLEAR GLASS
G03	CURTAIN WALL GLAZING -DARK GRAY
GR01	ALUMINUM GUARD RAIL WITH DARK GRAY ALUMINUM & CLEAR GLASS
GR02	ALUMINUM GUARD RAIL WITH DARK GRAY ALUMINUM & CERAMIC FRIT GLASS
PS01	ALUMINUM PRIVACY SCREEN WITH DARK GRAY ALUMINUM & TRANSLUCENT GLASS

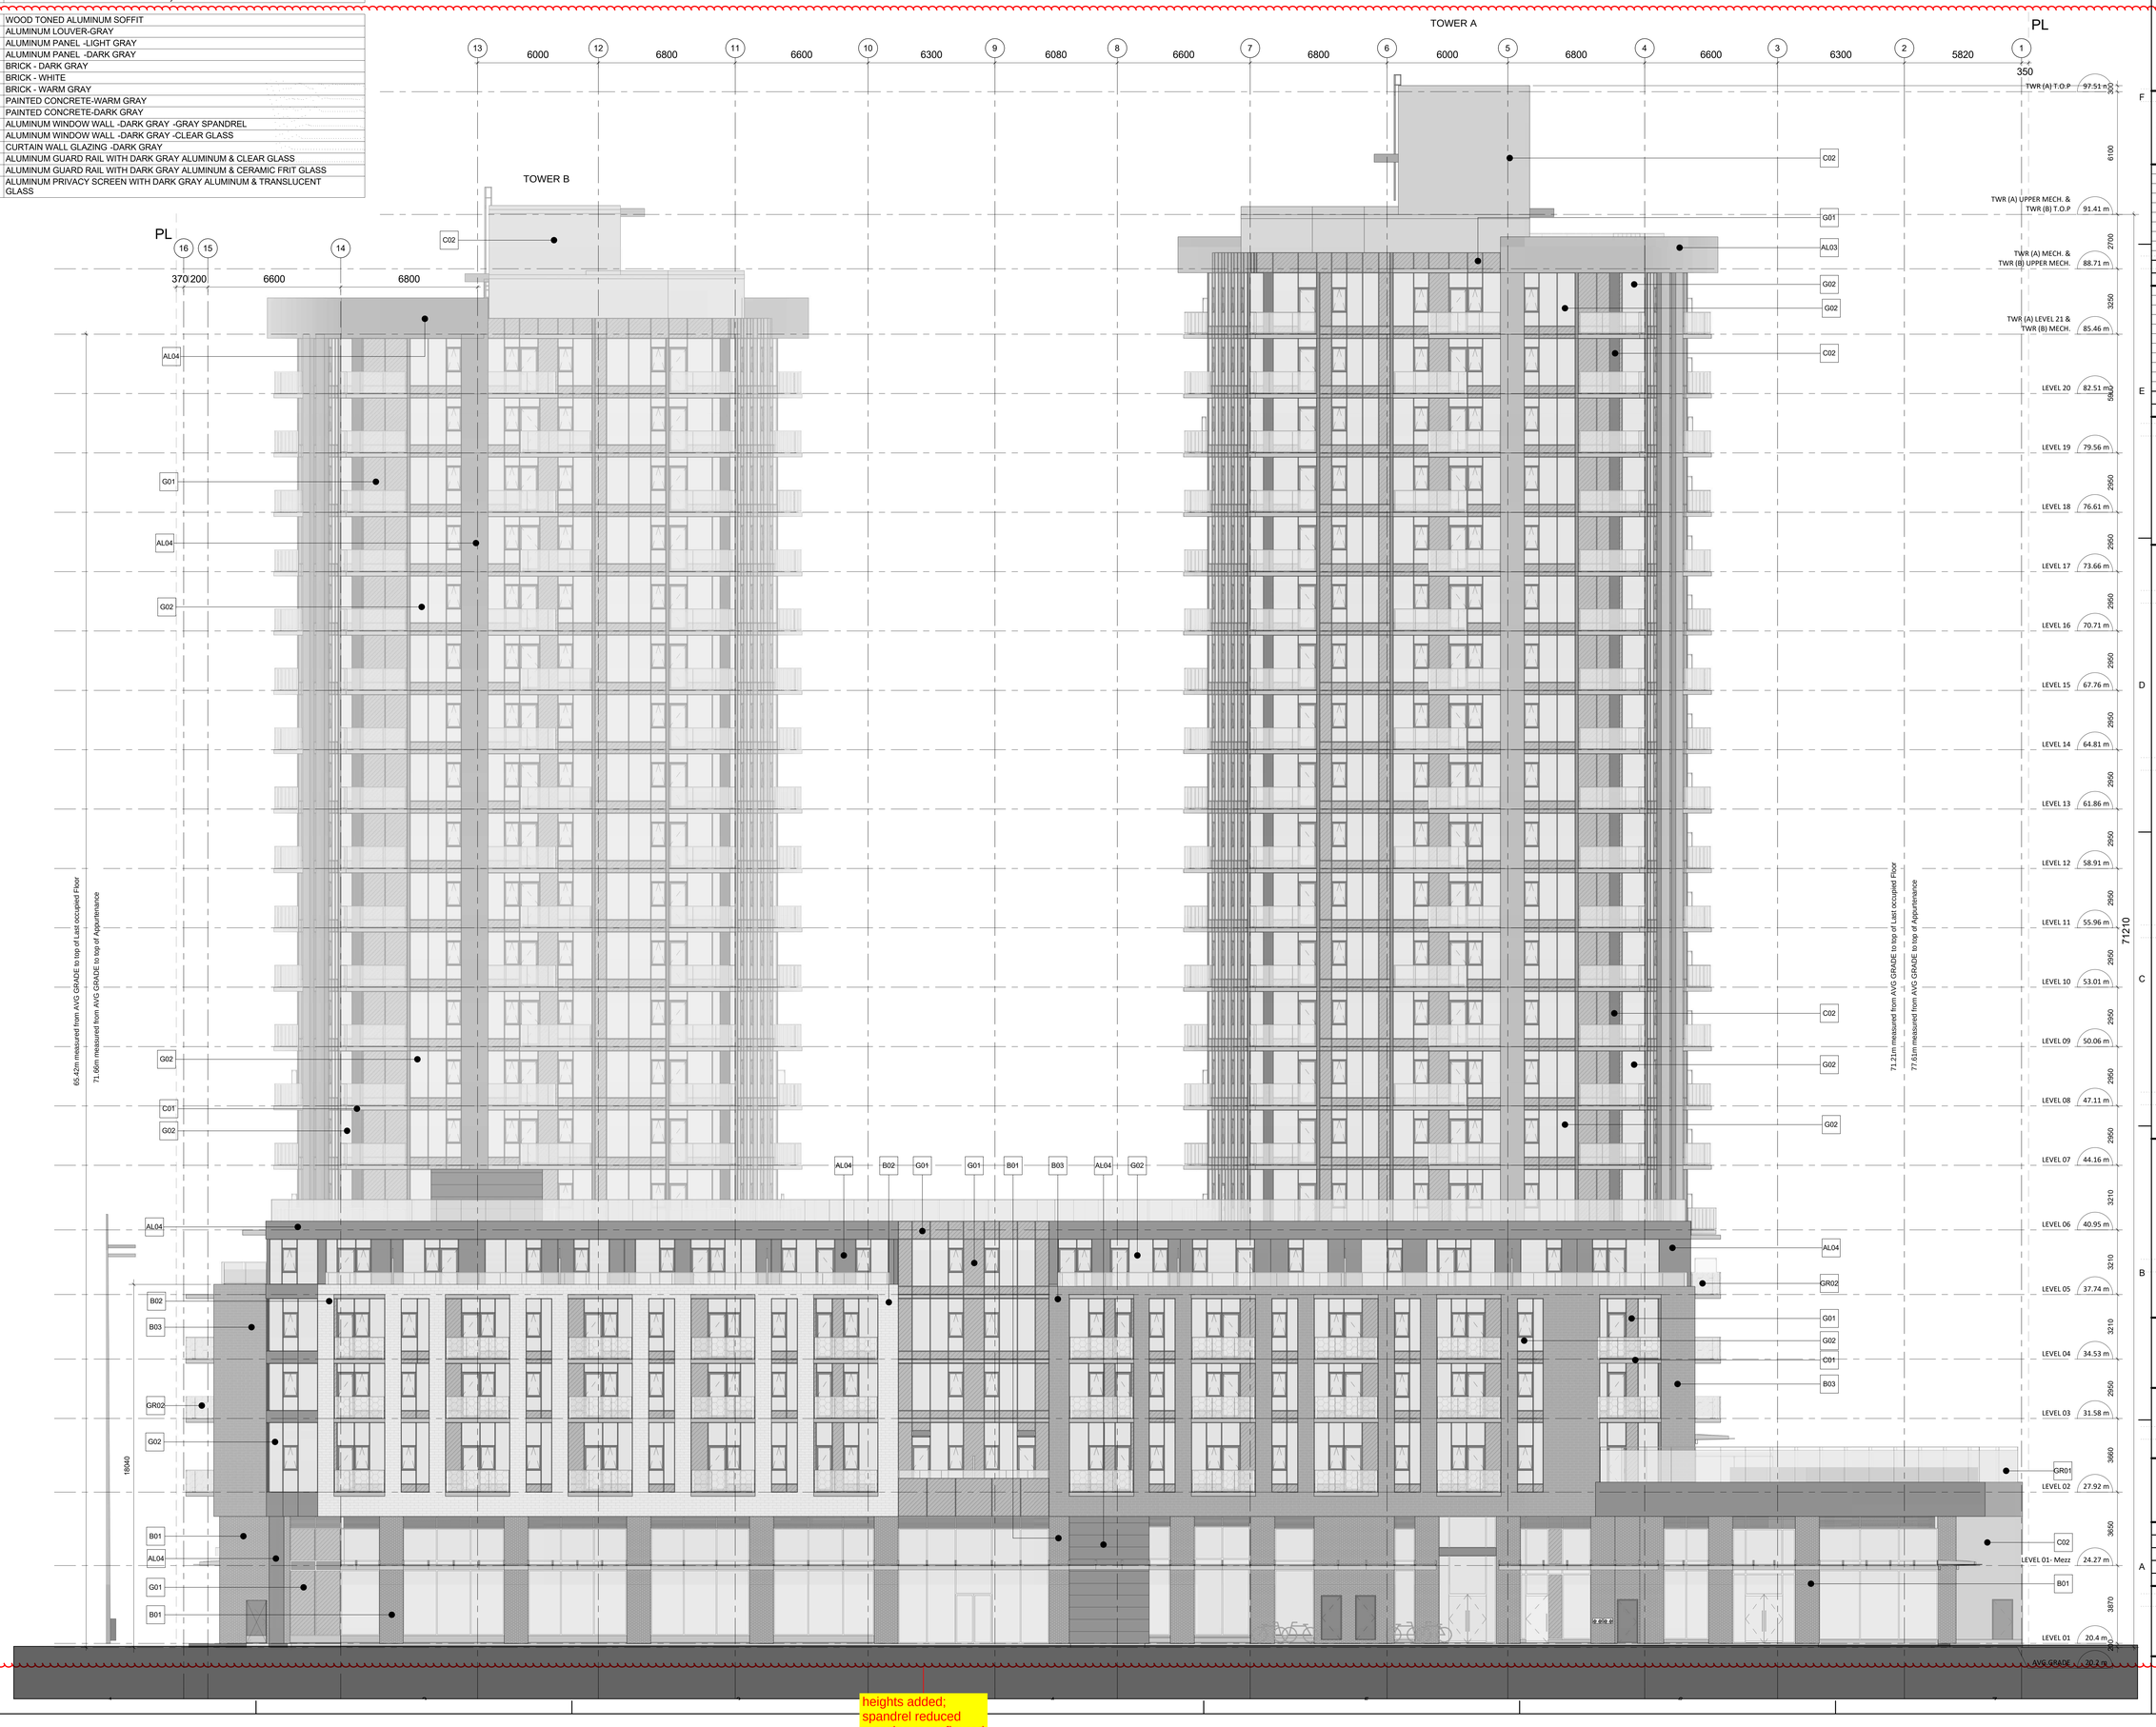

heights added;
spandrel reduced
massing reconfigured

CLIENT

Starlight Developments

Starlight Developments
P.O.Box 1890 Station B Mississauga, Ontario, Canada
L4Y1W8

COPYRIGHT:
This drawing has been prepared solely for the intended use, thus any reproduction or distribution for any purpose other than authorized by IBI Group is forbidden. Written dimensions shall have precedence over scaled dimensions. Contractors shall verify and be responsible for all dimensions and conditions on the job, and IBI Group shall be notified of any variations between the conditions and dimensions shown on the drawing. Shop drawings shall be submitted to IBI Group for general conformance before proceeding with fabrication.

IBI Group Architects (Canada) Inc.
is a member of the IBI Group of companies

NO.	DATE	DESCRIPTION
1	YYYY-MM-DD	

ISSUES

NO.	DATE	DESCRIPTION

REVISIONS

Issued For: Project Status
Date: 2021-03-05

SEAL

REGISTERED ARCHITECT JOHN GIMPEL BRITISH COLUMBIA
2021-03-06

SUB-CONSULTANT

PRIME CONSULTANT

IBI GROUP
ARCHITECTS (CANADA) INC.
700-1285 West Pender Street,
Vancouver, BC V6E 4B1, Canada
tel 604 683 8797 fax 604 683 0402
ibigroup.com

PROJECT TITLE
Harris Green Village Phase 01
1045 Yates Street
Victoria, BC

PROJECT NO:	121123
DRAWN BY:	
CHKD BY:	
SCALE:	1 : 100
DATE:	2021-03-05

SHEET TITLE
NORTH ELEVATIONS

SHEET NUMBER
A2.05

REV

Last Saved: 2021-03-05 10:24:59 PM File Location: I:\BM-360\121123 - Yates Street - Harris Green Village Ph 1 R2020\121123_YatesStA-Podium-2020.rvt

MATERIAL LEGEND	
Key Value	Keynote Text
AL01	WOOD TONED ALUMINUM SOFFIT
AL02	ALUMINUM LOUVER-GRAY
AL03	ALUMINUM PANEL -LIGHT GRAY
AL04	ALUMINUM PANEL -DARK GRAY
B01	BRICK - DARK GRAY
B02	BRICK - WHITE
B03	BRICK - WARM GRAY
C01	PAINTED CONCRETE-WARM GRAY
C02	PAINTED CONCRETE-DARK GRAY
G01	ALUMINUM WINDOW WALL -DARK GRAY -GRAY SPANDREL
G02	ALUMINUM WINDOW WALL -DARK GRAY -CLEAR GLASS
G03	CURTAIN WALL GLAZING -DARK GRAY
GR01	ALUMINUM GUARD RAIL WITH DARK GRAY ALUMINUM & CLEAR GLASS
GR02	ALUMINUM GUARD RAIL WITH DARK GRAY ALUMINUM & CERAMIC FRIT GLASS
PS01	ALUMINUM PRIVACY SCREEN WITH DARK GRAY ALUMINUM & TRANSLUCENT GLASS

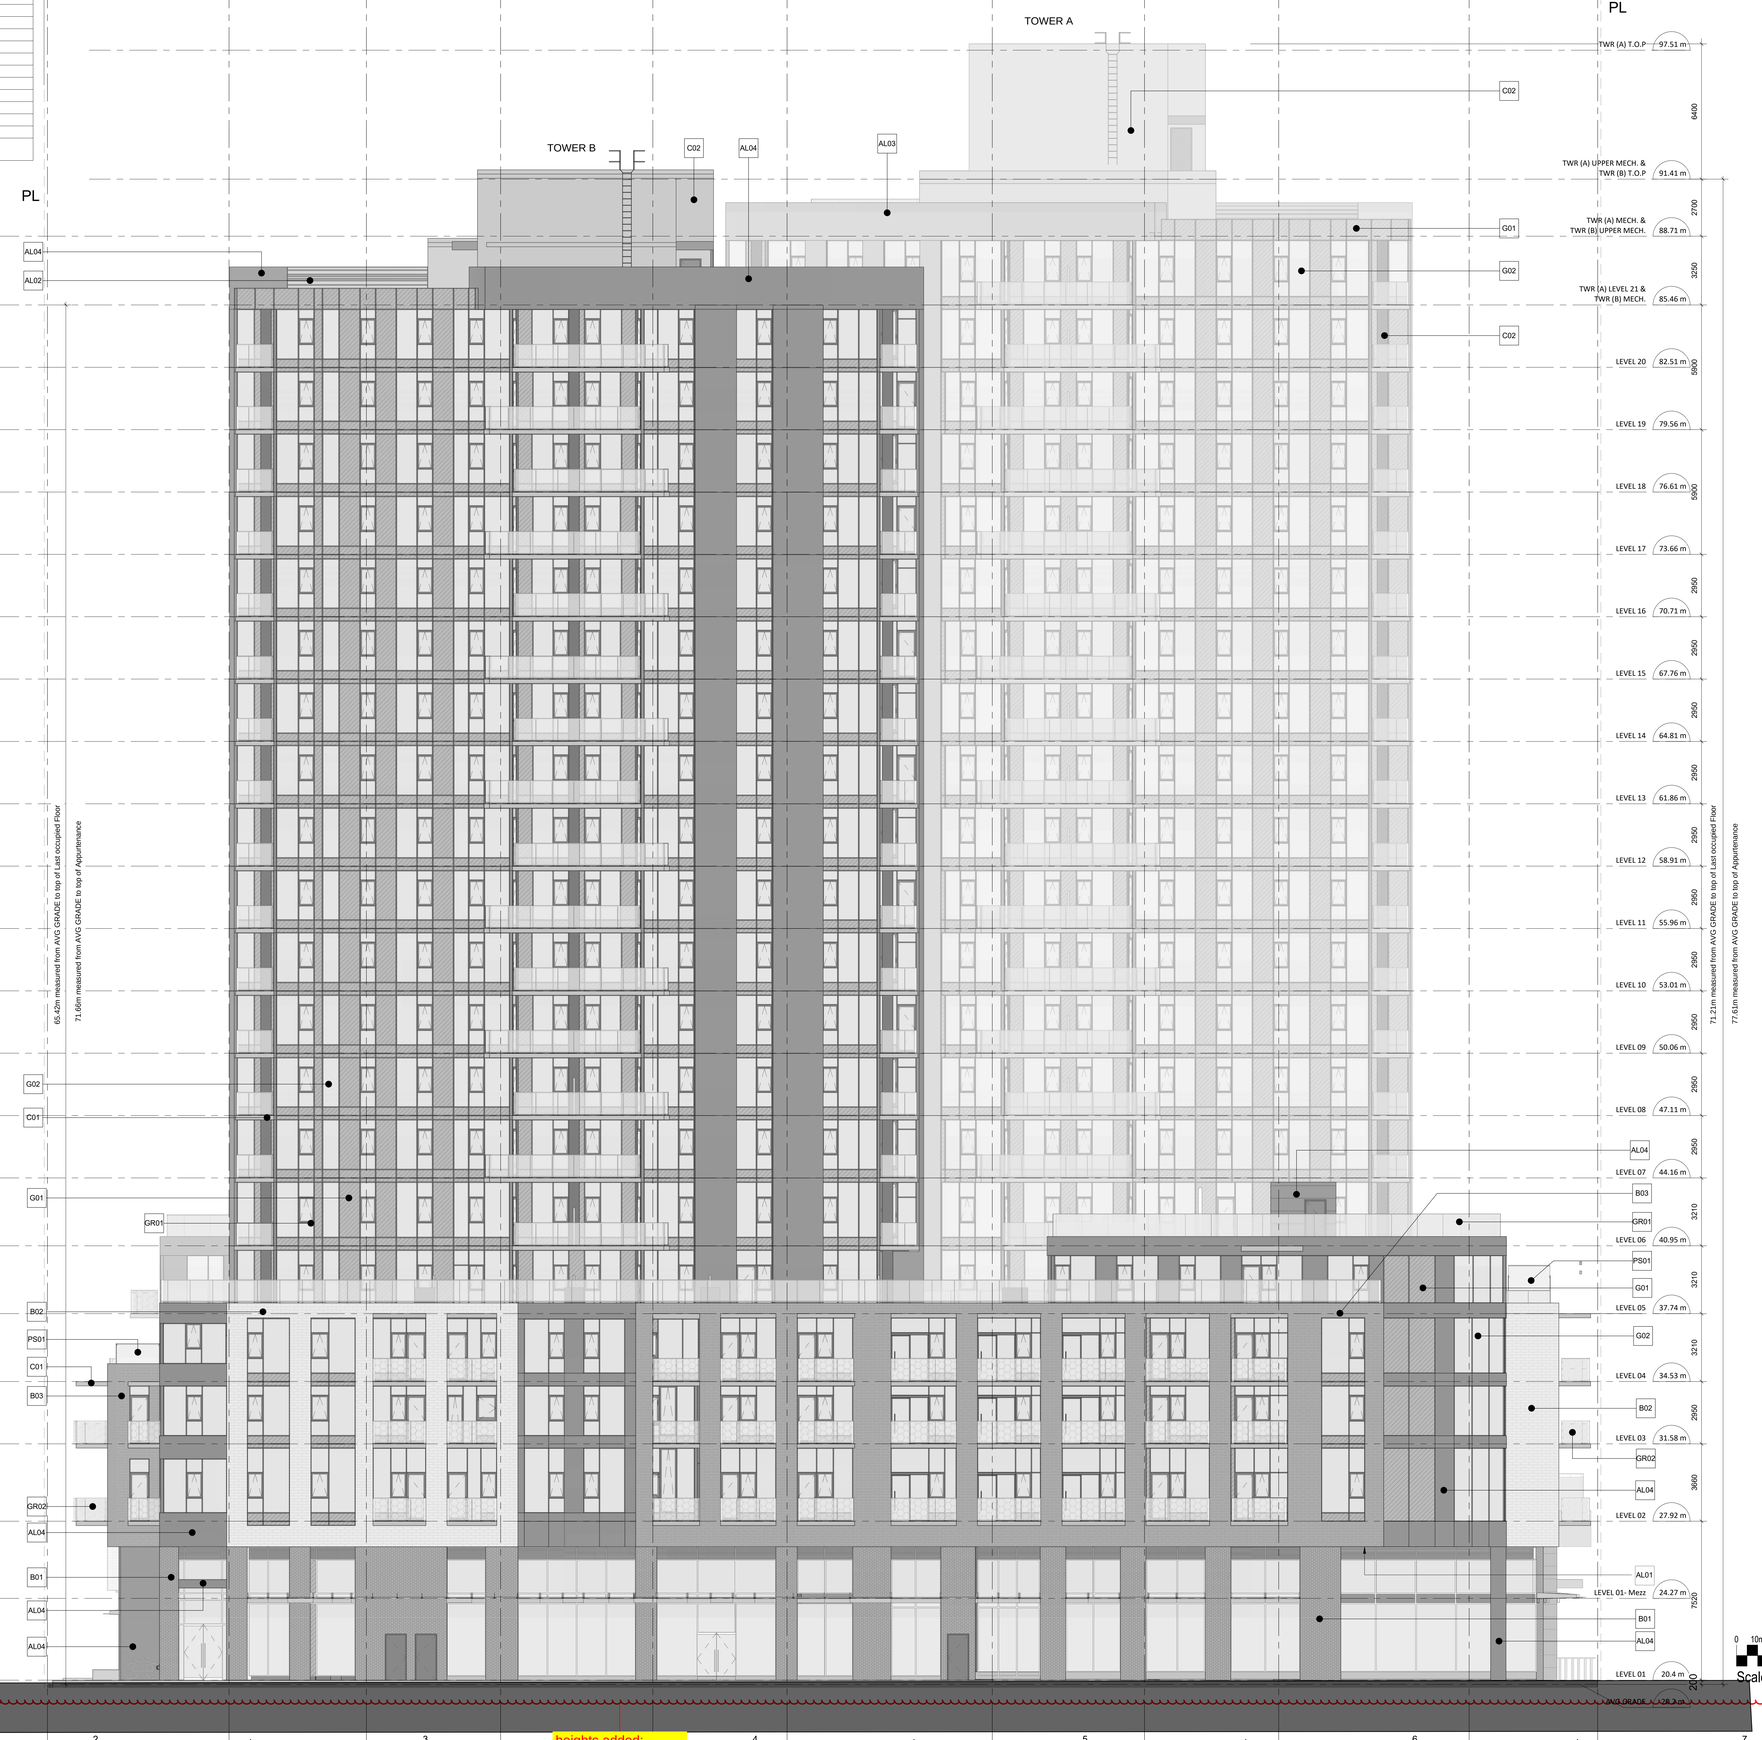

heights added;
spandrel reduced
massing reconfigured

CLIENT

Starlight Developments

Starlight Developments
P.O.Box 1690 Station B Mississauga, Ontario, Canada
L4Y1W8

COPYRIGHT:
This drawing has been prepared solely for the intended use, thus any reproduction or distribution for any purpose other than authorized by IBI Group is forbidden. Written dimensions shall have precedence over scaled dimensions. Contractors shall verify and be responsible for all dimensions and conditions on the job, and IBI Group shall be notified of any variations between these plans and the conditions shown on the drawing. Shop drawings shall be submitted to IBI Group for general conformance before proceeding with fabrication.
IBI Group Architects (Canada) Inc.
is a member of the IBI Group of companies

NO.	DATE	DESCRIPTION
1	YYYY-MM-DD	

ISSUES

NO.	DATE	DESCRIPTION

REVISIONS

Issued For: Project Status
Date: 2021-03-05

SEAL

REGISTERED ARCHITECT JOHN GWYN HUGHES BRITISH COLUMBIA
2021-03-05

BCB CONSULTANT

PRIME CONSULTANT

IBI GROUP
ARCHITECTS (CANADA) INC.
700-1285 West Pender Street,
Vancouver, BC V6E 4B1, Canada
tel 604 683 8797 fax 604 683 0492
ibigroup.com

PROJECT TITLE
Harris Green Village
Phase 01
1045 Yates Street
Victoria, BC

PROJECT NO:	121123
DRAWN BY:	
CHKD BY:	
SCALE:	1 : 100
DATE:	2021-03-05

SHEET TITLE
EAST ELEVATION

SHEET NUMBER
A2.06

REV

Last Saved: 2021-03-05 10:25:37 PM File Location: BIM 360://121123 - Yates Street – Harris Green Village Ph 1/S0020/191123_YatesStA-A-Podium-2020.rvt

MATERIAL LEGEND	
Key Value	Keynote Text
AL01	WOOD TONED ALUMINUM SOFFIT
AL02	ALUMINUM LOUVER-GRAY
AL03	ALUMINUM PANEL -LIGHT GRAY
AL04	ALUMINUM PANEL -DARK GRAY
B01	BRICK - DARK GRAY
B02	BRICK - WHITE
B03	BRICK - WARM GRAY
C01	PAINTED CONCRETE-WARM GRAY
C02	PAINTED CONCRETE-DARK GRAY
G01	ALUMINUM WINDOW WALL -DARK GRAY -GRAY SPANDREL
G02	ALUMINUM WINDOW WALL -DARK GRAY -CLEAR GLASS
G03	CURTAIN WALL GLAZING -DARK GRAY
GR01	ALUMINUM GUARD RAIL WITH DARK GRAY ALUMINUM & CLEAR GLASS
GR02	ALUMINUM GUARD RAIL WITH DARK GRAY ALUMINUM & CERAMIC FRIT GLASS
PS01	ALUMINUM PRIVACY SCREEN WITH DARK GRAY ALUMINUM & TRANSLUCENT GLASS

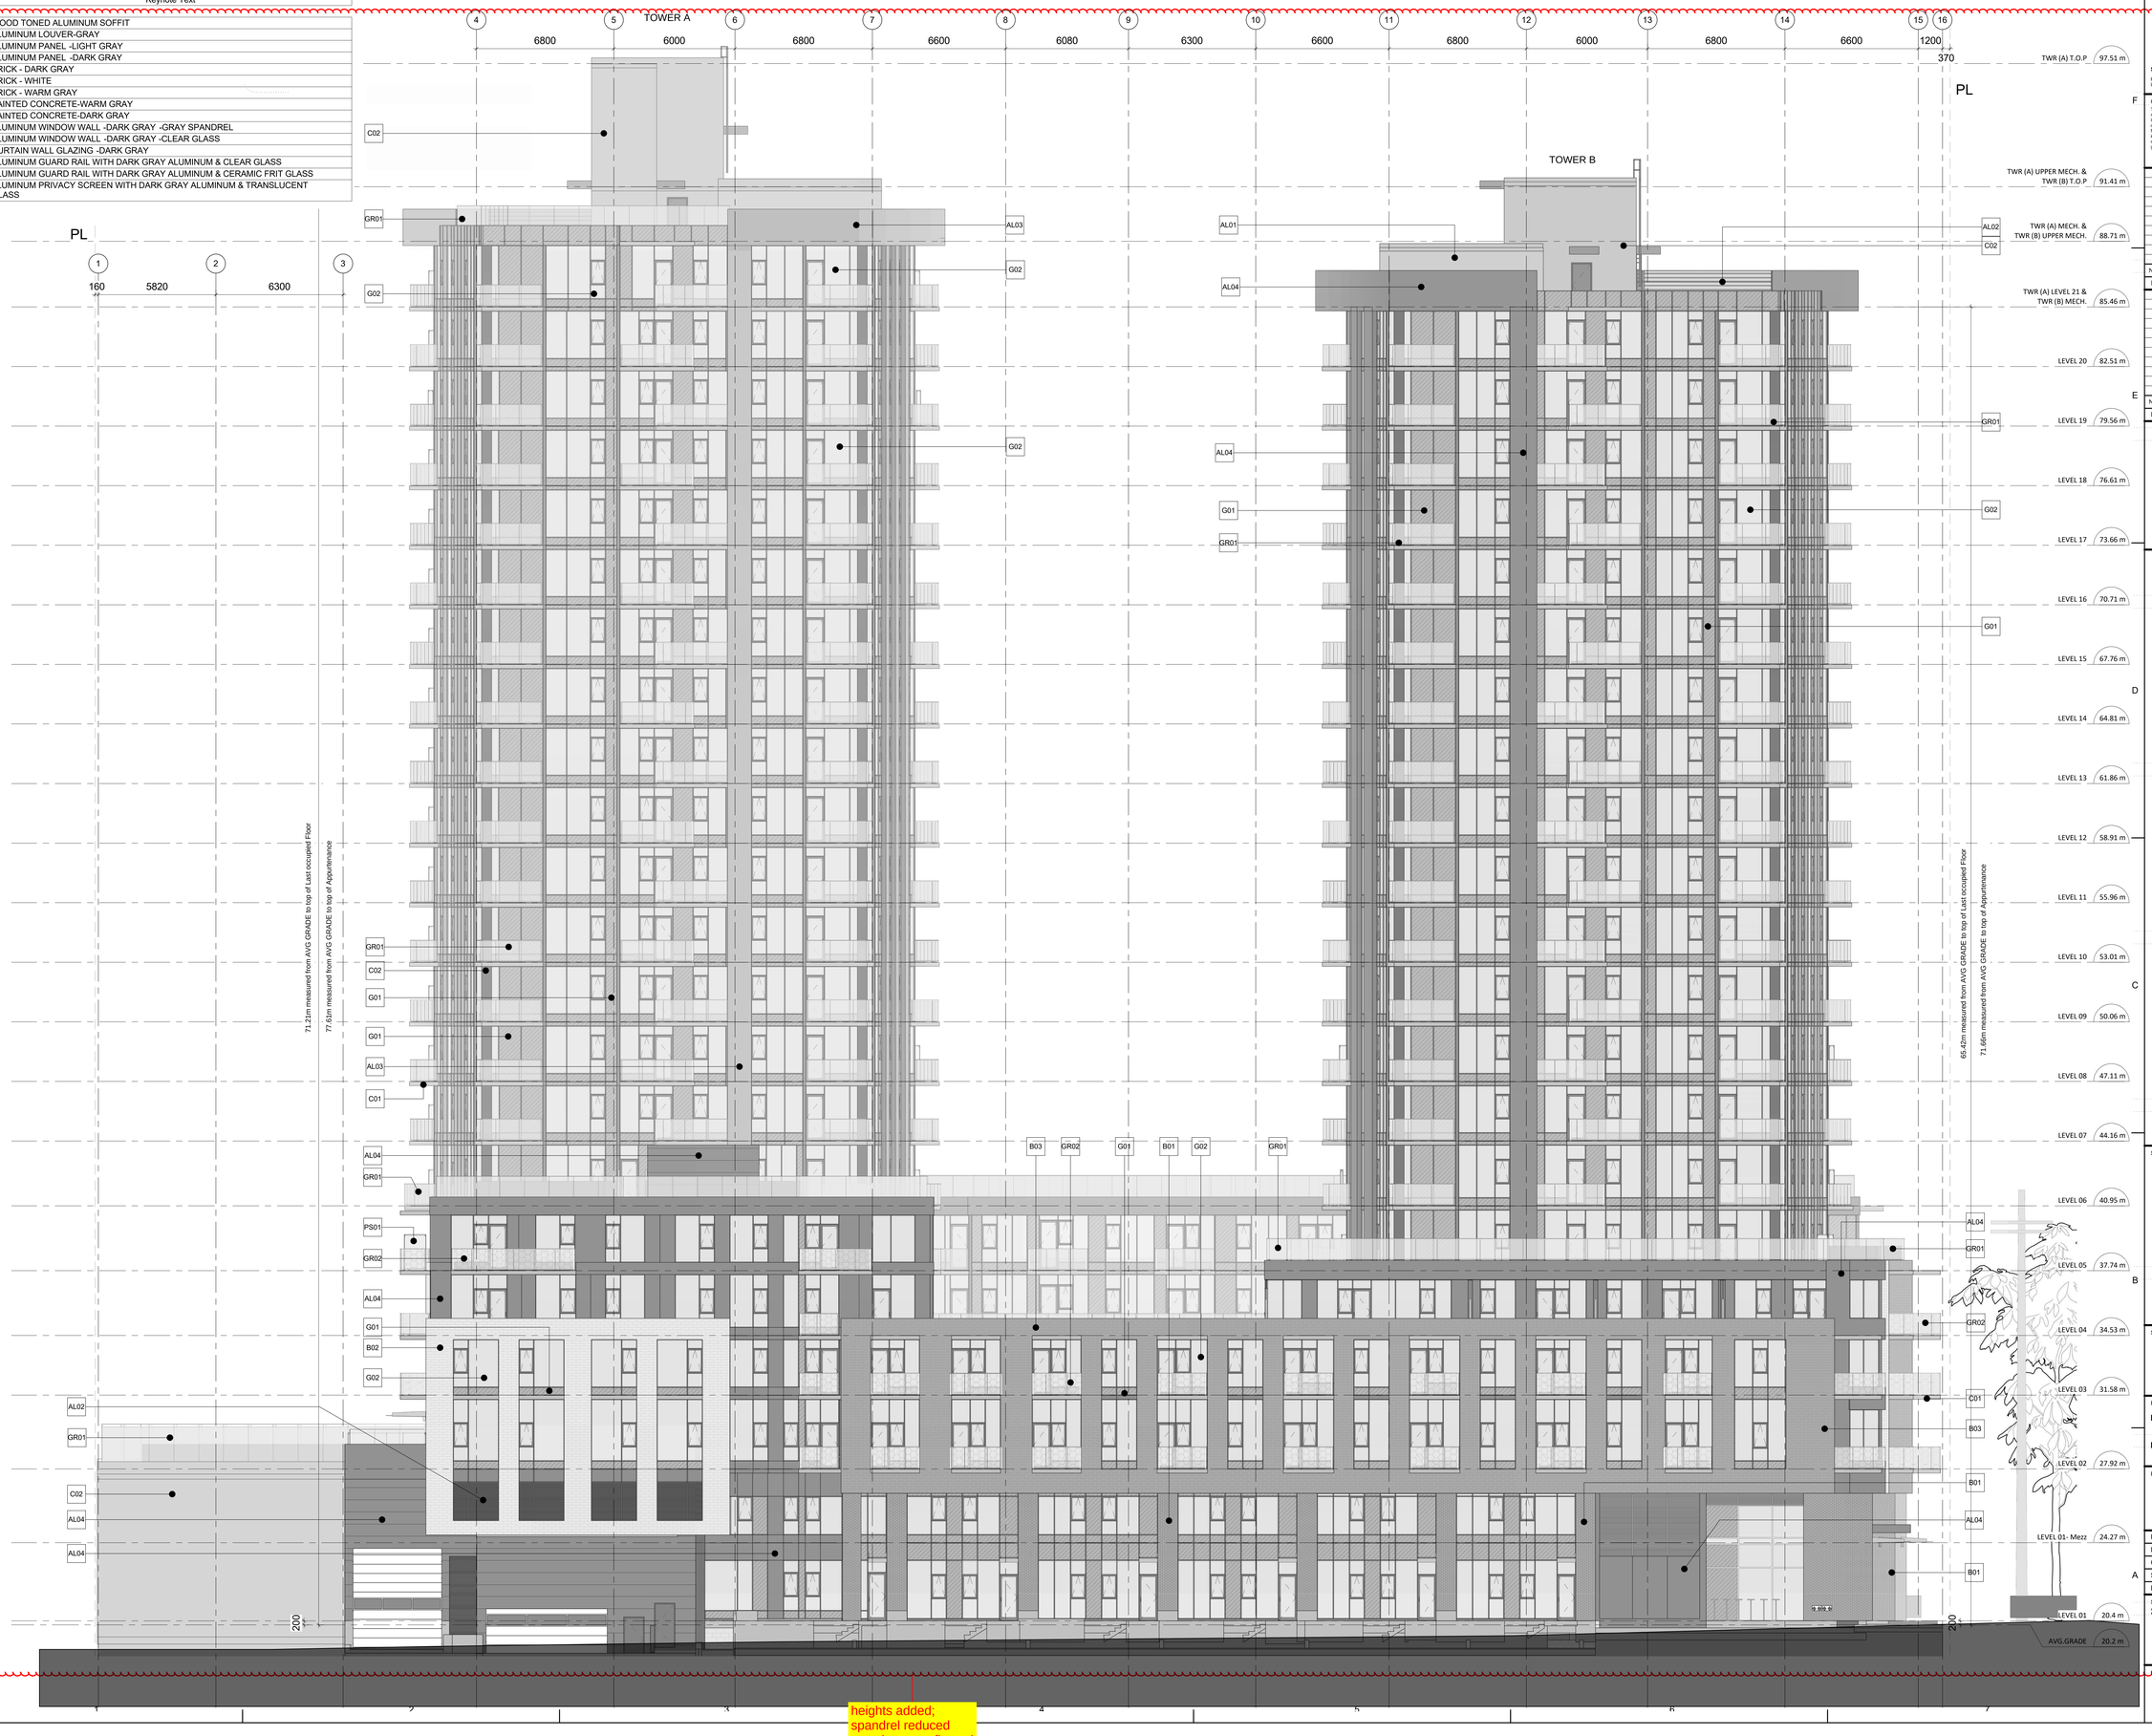

heights added;
spandrel reduced
massing reconfigured

CLIENT

Starlight Developments

Starlight Developments
P.O.Box 1890 Station B Mississauga, Ontario, Canada
L4Y1W6

COPYRIGHT:
This drawing has been prepared solely for the intended use, thus any reproduction or distribution for any purpose other than authorized by IBI Group is forbidden. Written dimensions shall have precedence over scaled dimensions. Contractors shall verify and be responsible for all dimensions and conditions on the job, and IBI Group shall be notified of any variations between the conditions and the information shown on the drawing. Shop drawings shall be submitted to IBI Group for general conformance before proceeding with fabrication.

IBI Group Architects (Canada) Inc.
is a member of the IBI Group of companies

NO.	DATE	DESCRIPTION
1	YYYY-MM-DD	

ISSUES

NO.	DATE	DESCRIPTION

REVISIONS

Issued For: Project Status
Date: 2021-03-05

SEAL

REGISTERED ARCHITECT JONATHAN GRIFFITH BRITISH COLUMBIA
2021-03-05

SUB-CONSULTANT

PRIME CONSULTANT

IBI GROUP
ARCHITECTS (CANADA) INC.
700-1285 West Pender Street,
Vancouver, BC V6E 4B1, Canada
tel 604 683 8797 fax 604 683 0492
ibigroup.com

PROJECT TITLE
Harris Green Village
Phase 01
1045 Yates Street
Victoria, BC

PROJECT NO:	121123
DRAWN BY:	
CHK'D BY:	
SCALE:	1 : 100
DATE:	2021-03-05

SHEET TITLE
SOUTH ELEVATIONS

SHEET NUMBER
A2.07

REV

Last Saved: 2021-03-05 10:26:22 PM File Location: BIM 360/121123 - Yates Street - Harris Green Village Ph 1/20200121123_YatesSt-A-Podium-2020.rvt

MATERIAL LEGEND	
Key Value	Keynote Text
AL01	WOOD TONED ALUMINUM SOFFIT
AL02	ALUMINUM LOUVER-GRAY
AL03	ALUMINUM PANEL -LIGHT GRAY
AL04	ALUMINUM PANEL -DARK GRAY
B01	BRICK - DARK GRAY
B02	BRICK - WHITE
B03	BRICK - WARM GRAY
C01	PAINTED CONCRETE-WARM GRAY
C02	PAINTED CONCRETE-DARK GRAY
G01	ALUMINUM WINDOW WALL -DARK GRAY -GRAY SPANDREL
G02	ALUMINUM WINDOW WALL -DARK GRAY -CLEAR GLASS
G03	CURTAIN WALL GLAZING -DARK GRAY
GR01	ALUMINUM GUARD RAIL WITH DARK GRAY ALUMINUM & CLEAR GLASS
GR02	ALUMINUM GUARD RAIL WITH DARK GRAY ALUMINUM & CERAMIC FRIT GLASS
PS01	ALUMINUM PRIVACY SCREEN WITH DARK GRAY ALUMINUM & TRANSLUCENT GLASS

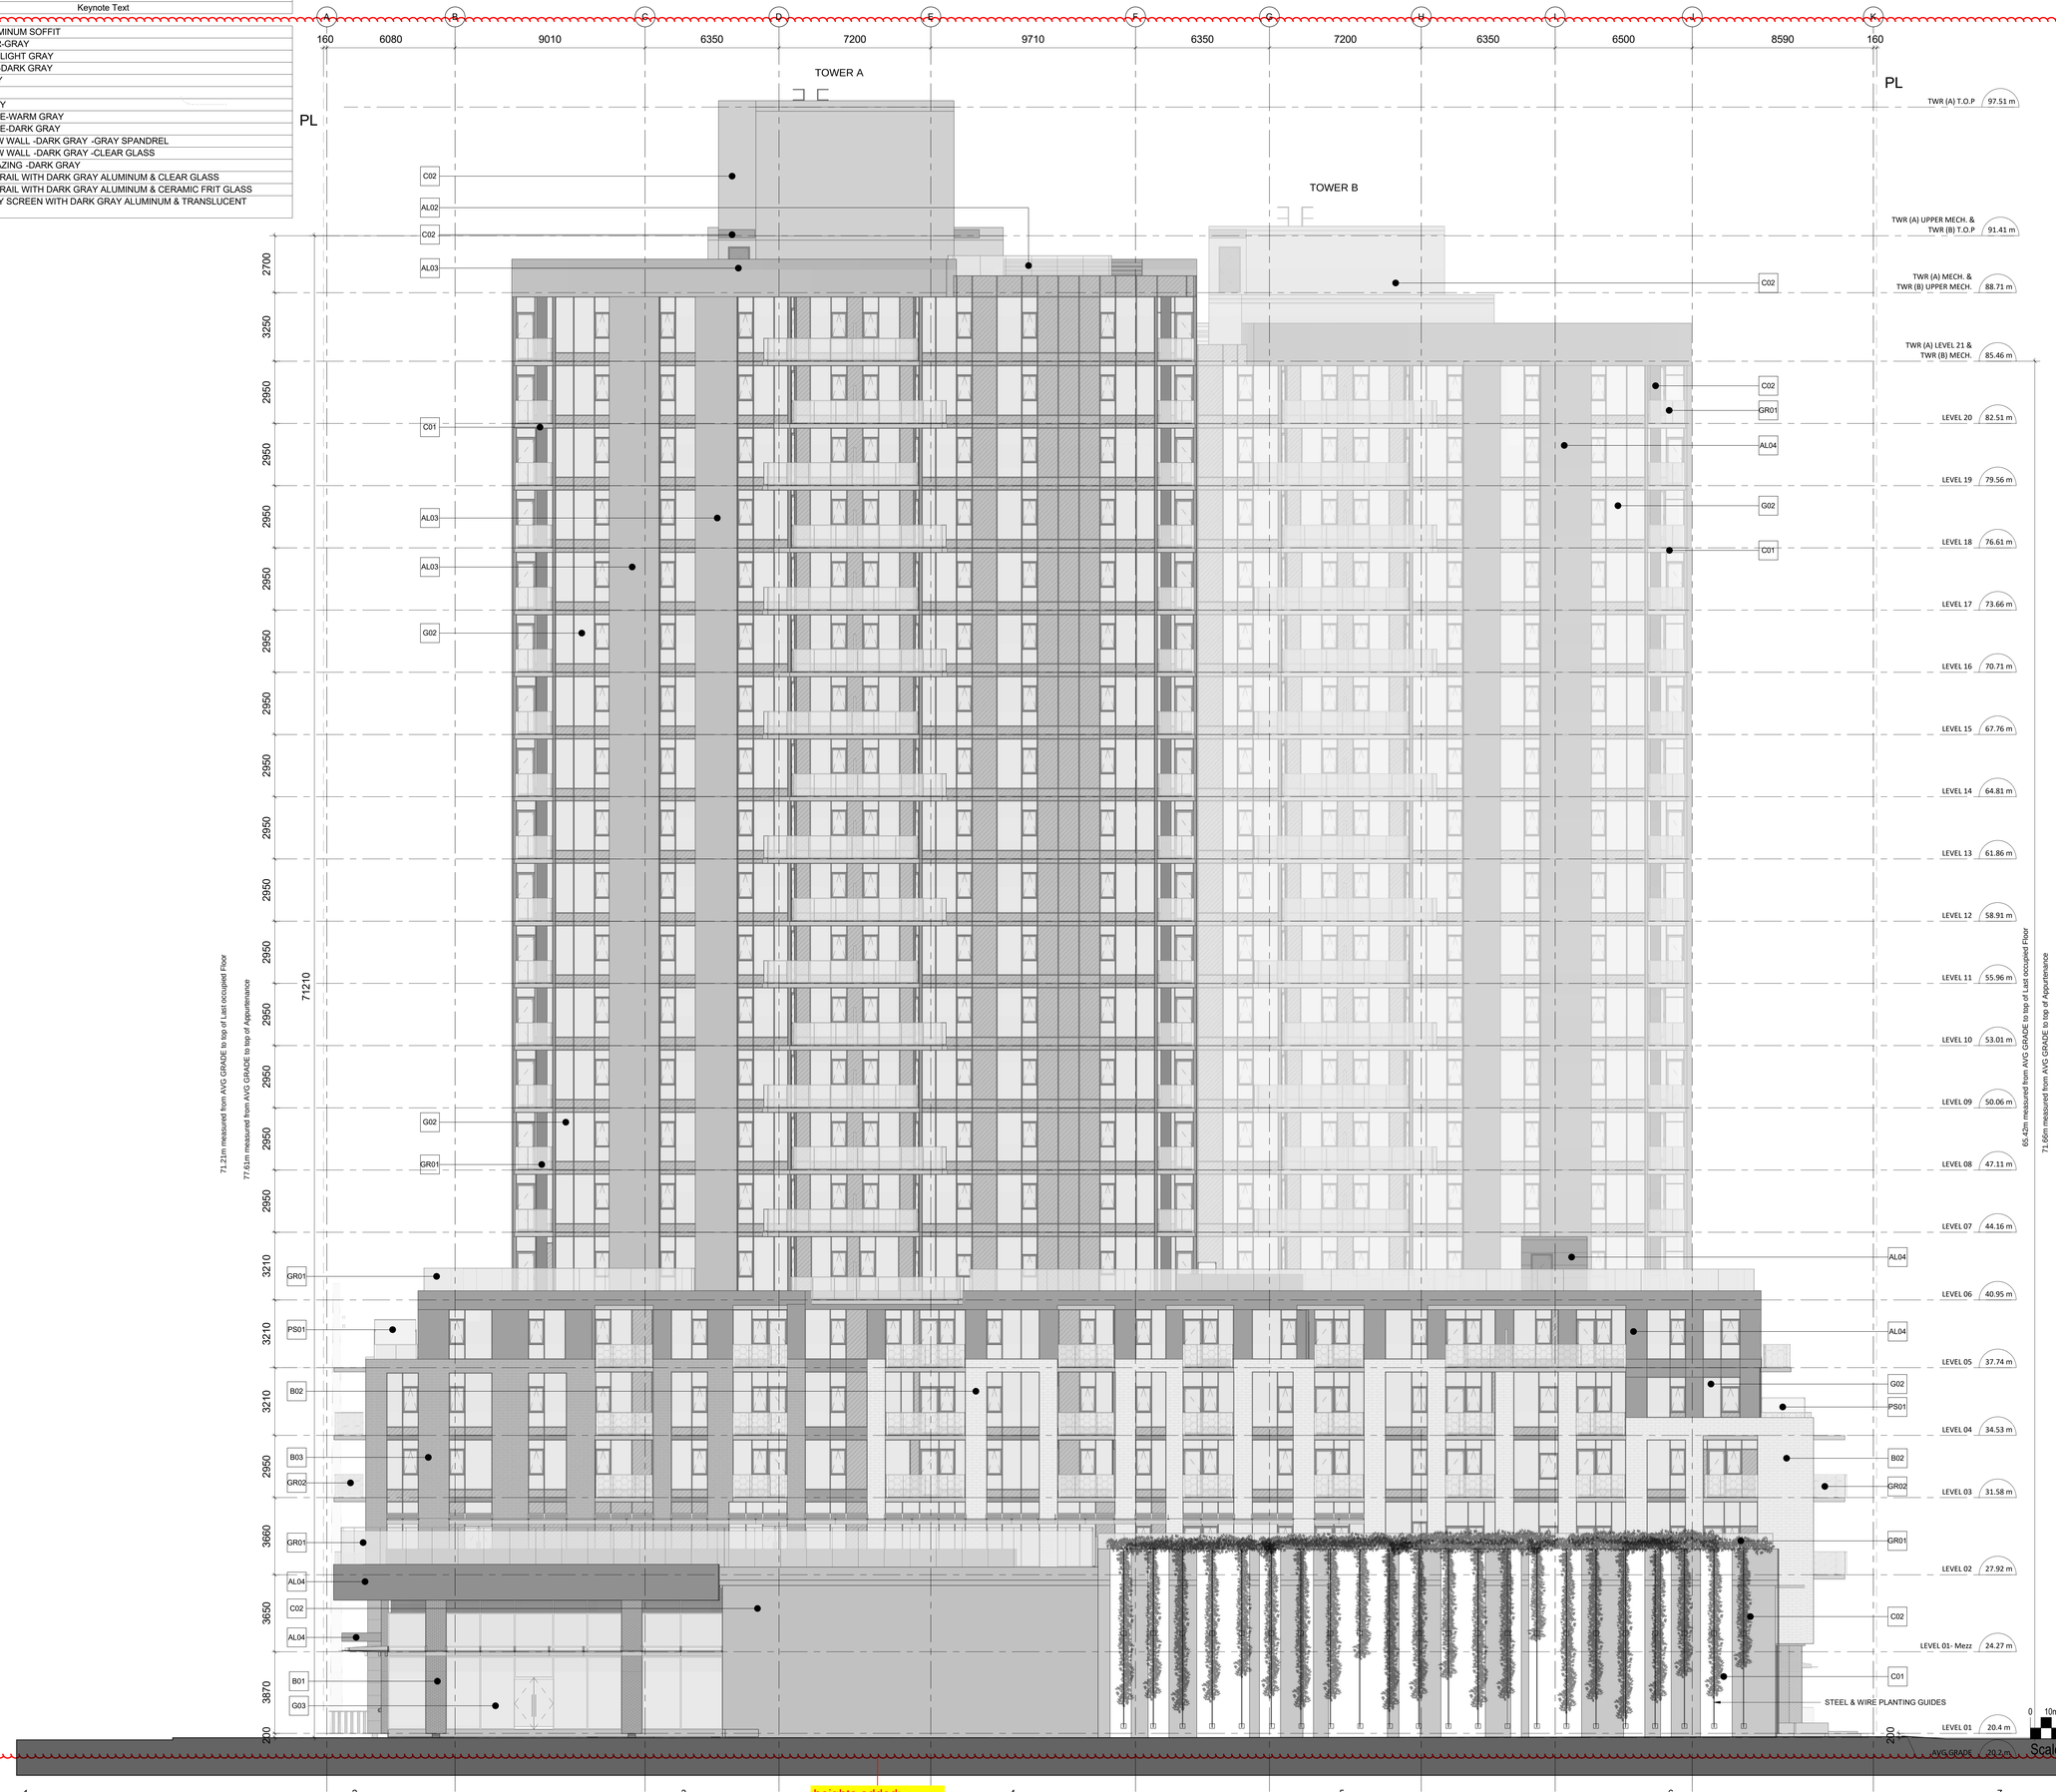

heights added;
spandrel reduced
massing reconfigured

CLIENT

Starlight Developments

Starlight Developments
P.O.Box 1890 Station B Mississauga, Ontario, Canada
L4Y1W8

COPYRIGHT:
This drawing has been prepared solely for the intended use, thus any reproduction or distribution for any purpose other than authorized by IBI Group is forbidden. Written dimensions shall have precedence over scaled dimensions. Contractors shall verify and be responsible for all dimensions and conditions on the job, and IBI Group shall be notified of any variations between the conditions and the plans shown on the drawing. Shop drawings shall be submitted to IBI Group for general conformance before proceeding with fabrication.

IBI Group Architects (Canada) Inc.
is a member of the IBI Group of companies

NO.	DATE	DESCRIPTION
1	YYYY-MM-DD	

ISSUES

NO.	DATE	DESCRIPTION

REVISIONS

Issued For: Project Status
Date: 2021-03-05

SEAL

REGISTERED ARCHITECT JOHN GWYN PROVINCE OF BRITISH COLUMBIA
2021-03-06

SUB-CONSULTANT

PRIME CONSULTANT

IBI GROUP
ARCHITECTS (CANADA) INC.
700-1285 West Pender Street,
Vancouver, BC V6E 4B1, Canada
tel 604 683 8797 fax 604 683 0492
ibigroup.com

PROJECT TITLE
Harris Green Village Phase 01
1045 Yates Street
Victoria, BC

PROJECT NO:	121123
DRAWN BY:	
CHK'D BY:	
SCALE:	1 : 100
DATE:	2021-03-05

SHEET TITLE
WEST ELEVATION

SHEET NUMBER
A2.08

REV

Last Saved: 2021-03-05 10:27:00 PM File Location: IBM 360 \121123 - Yates Street - Harris Green Village Ph 1 R2020\121123_YatesSt-A-Podium-2020.rvt

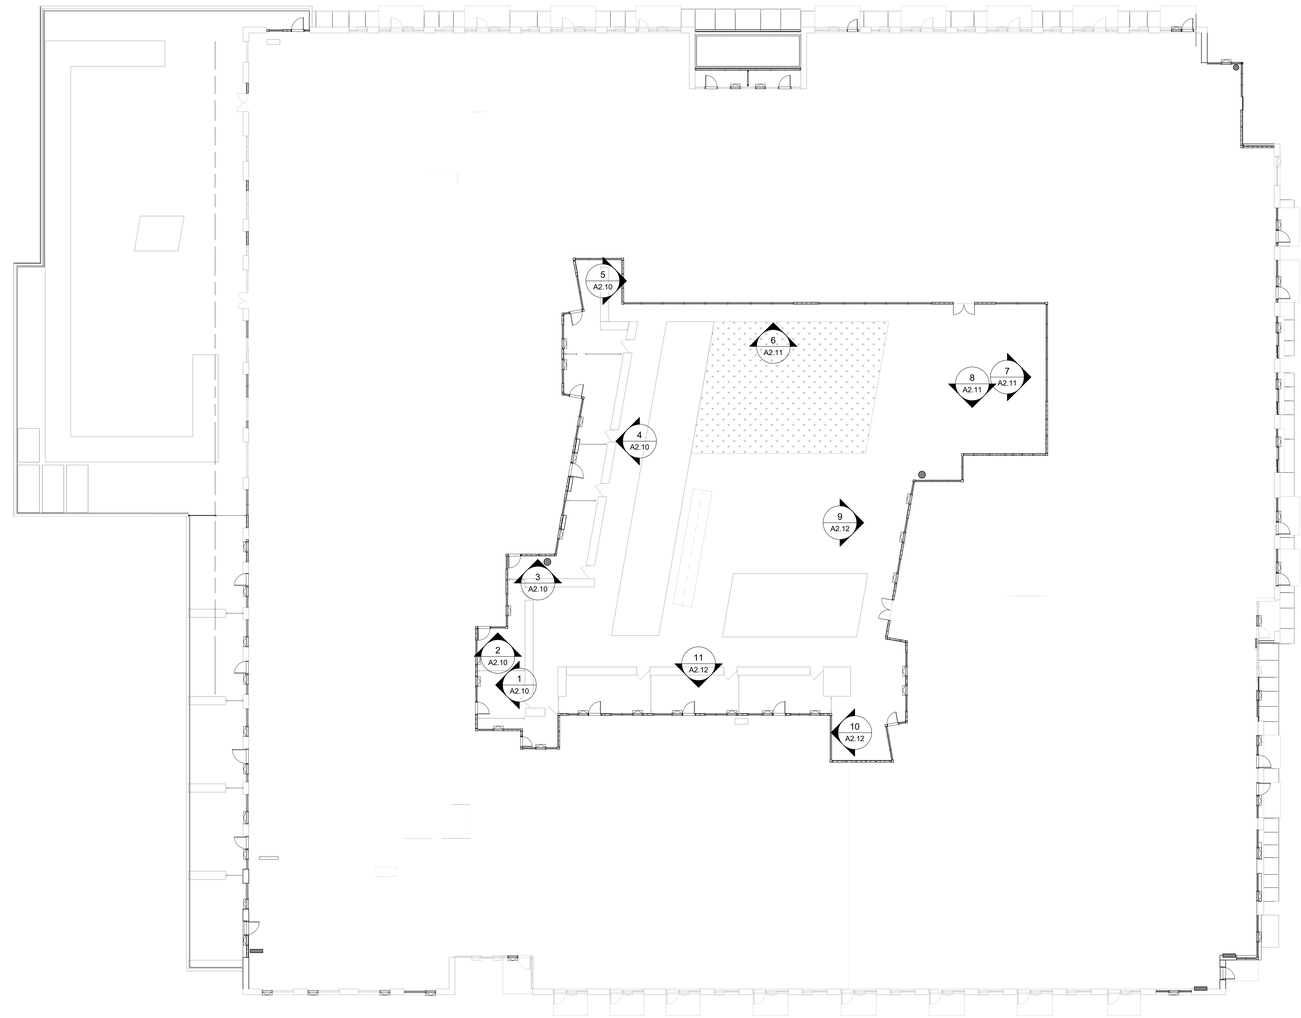

CLIENT

Starlight Developments

Starlight Developments

P.O. Box 1890 Station B Mississauga, Ontario, Canada
L4Y 3W8

COPYRIGHT:
This drawing has been prepared solely for the intended use, thus any reproduction or distribution for any purpose other than authorized by IBI Group is forbidden. Written dimensions shall have precedence over scaled dimensions. Contractors shall verify and be responsible for all dimensions and conditions on the job, and IBI Group shall be informed of any variations from the dimensions and conditions shown on the drawing. Shop drawings shall be submitted to IBI Group for general conformance before proceeding with fabrication.
IBI Group Architects (Canada) Inc.
is a member of the IBI Group of companies

NO.	DATE	DESCRIPTION
1	YYYY-MM-DD	

ISSUES

NO.	DATE	DESCRIPTION

REVISIONS

PROJECT NORTH
N

Issued For: Project Status
Date: 2021-03-05

SEAL

REGISTERED ARCHITECT
JOHN GIBSON
BRITISH COLUMBIA
2021-03-06

SUB-CONSULTANT

PRIME CONSULTANT

IBI GROUP
ARCHITECTS (CANADA) INC.
700-1285 West Pender Street,
Vancouver, BC V6E 4B1, Canada
tel 604 683 8797 fax 604 683 0492
ibigroup.com

PROJECT TITLE
Harris Green Village
Phase 01
1045 Yates Street
Victoria, BC

PROJECT NO:	121123
DRAWN BY:	Author
CHK'D BY:	Checker
SCALE:	1 : 150
DATE:	2021-03-05

SHEET TITLE
COURTYARD KEY PLAN

SHEET NUMBER
A2.09

REV

Last Saved: 2021-03-05 10:27:03 PM File Location: BIM 360://121123 - Yates Street – Harris Green Village Ph 1 R2020/121123_YatesStA-Podium-2020.rvt

MATERIAL LEGEND	
Key Value	Keynote Text
AL01	WOOD TONED ALUMINUM SOFFIT
AL02	ALUMINUM LOUVER-GRAY
AL03	ALUMINUM PANEL CLAD-LIGHT GRAY
AL04	ALUMINUM PANEL CLAD-DARK GRAY
B01	BRICK - DARK GRAY
B02	BRICK - WHITE
B03	BRICK - WARM GRAY
C01	PAINTED CONCRETE-WARM GRAY
C02	PANITED CONCRETE-DARK GRAY
G01	ALUMINUM WINDOW WALL-GRAY SPANDREL
G02	ALUMINUM WINDOW WALL-CLEAR GLASS
G03	CURTAIN WALL GLAZING
GR01	ALUMINUM GUARD RAIL WITH DARK GRAY ALUMINUM & CLEAR GLASS
GR02	ALUMINUM GUARD RAIL WITH DARK GRAY ALUMINUM & CERAMIC FRIT GLASS
PS01	ALUMINUM PRIVACY SCREEN WITH DARK GRAY ALUMINUM & TRANSLUCENT GLASS-WHITE

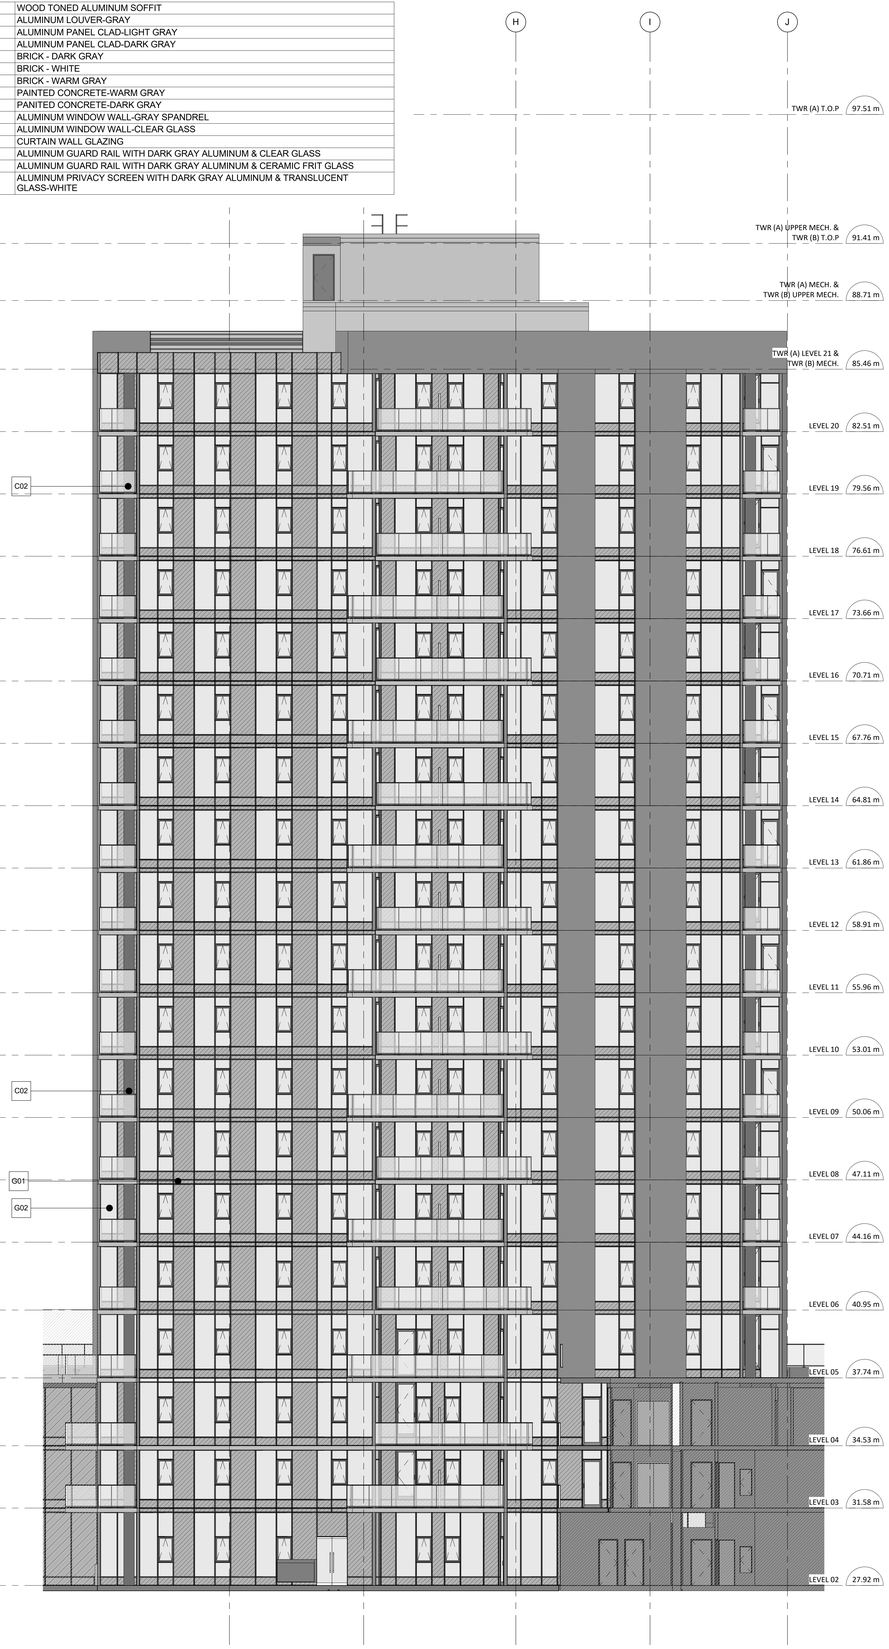

9 A2.12 CY-Elevation 09
SCALE: 1 : 100

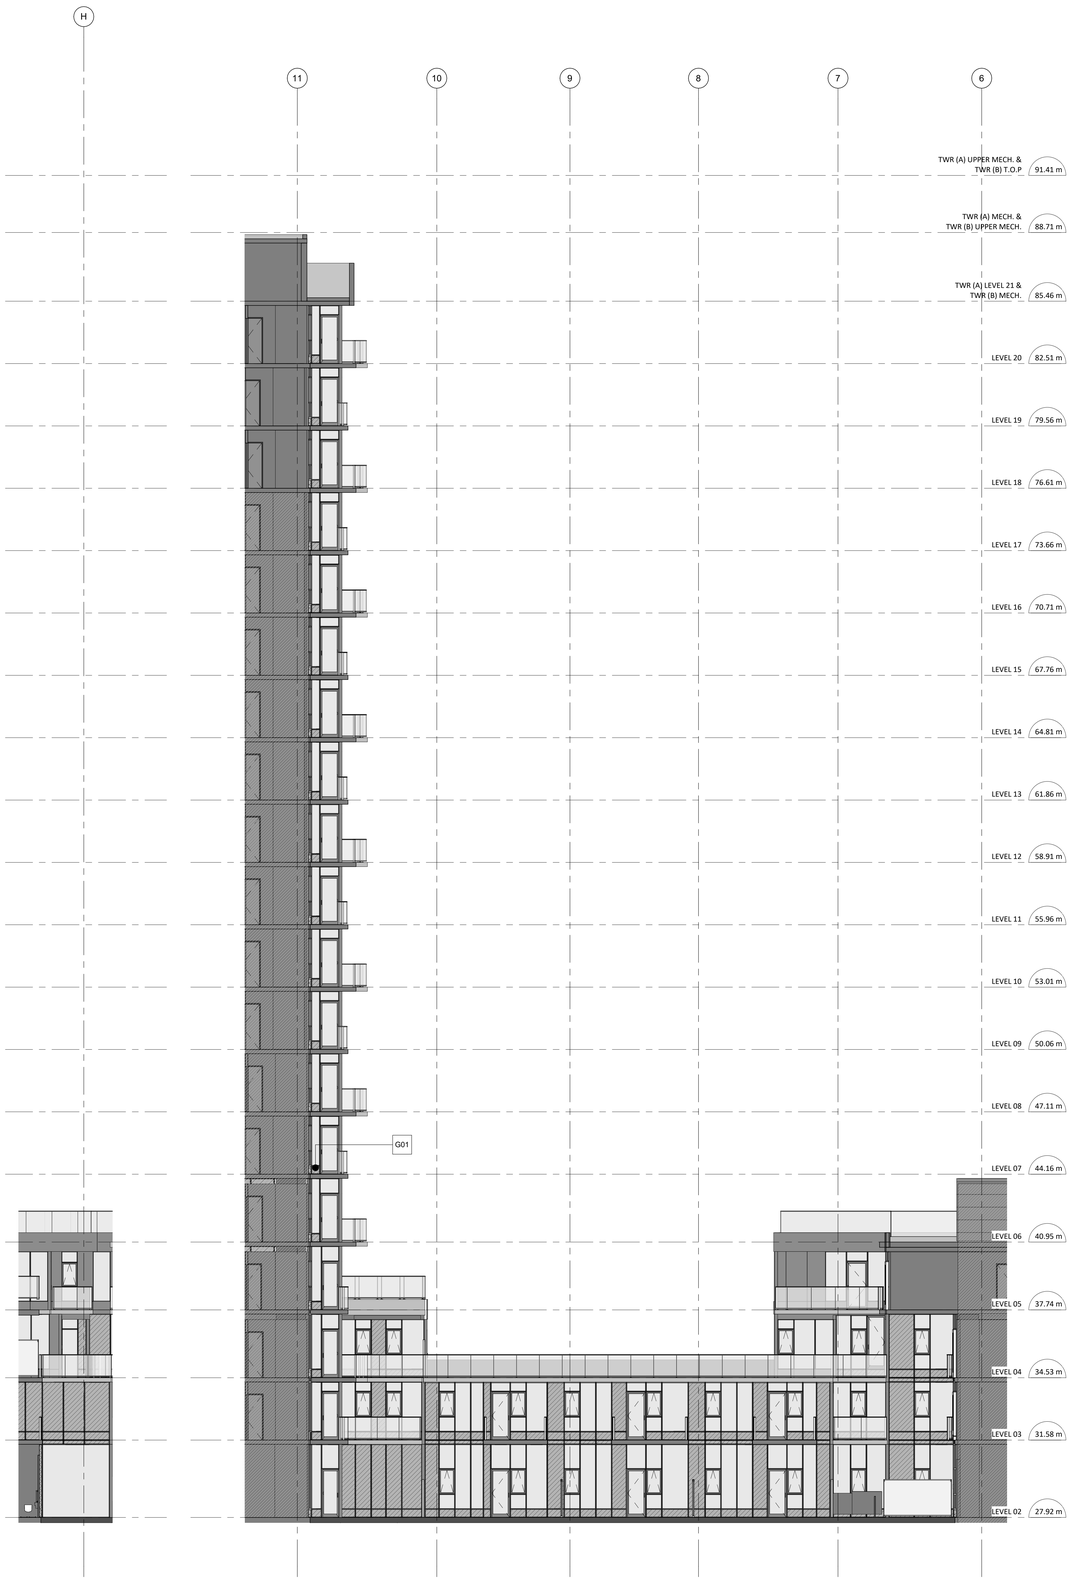

10 A2.12 CY-Elevation 10
SCALE: 1 : 100

11 A2.12 CY-Elevation 11
SCALE: 1 : 100

heights added;
spandrel reduced
massing reconfigured

CLIENT

Starlight Developments

Starlight Developments
P.O.Box 1890 Station B Mississauga, Ontario, Canada
L4Y1W8

COPYRIGHT:
This drawing has been prepared solely for the intended use, thus any reproduction or distribution for any purpose other than authorized by IBI Group is forbidden. Written dimensions shall have precedence over scaled dimensions. Contractors shall verify and be responsible for all dimensions and conditions on the job, and IBI Group shall be notified of any variations from the dimensions and conditions shown on this drawing. Shop drawings shall be submitted to IBI Group for general conformance before proceeding with fabrication.

IBI Group Architects (Canada) Inc.
is a member of the IBI Group of companies

NO.	DATE	DESCRIPTION
1	YYYY-MM-DD	

ISSUES

NO.	DATE	DESCRIPTION

REVISIONS

Issued For: Project Status

Date: 2021-03-05

SEAL

REGISTERED ARCHITECT JOHN GIVEN BRITISH COLUMBIA
2021-03-06

SUB-CONSULTANT

PRIME CONSULTANT

IBI GROUP
ARCHITECTS (CANADA) INC.
700-1285 West Pender Street,
Vancouver BC V6E 4B1 Canada
tel 604 683 8797 fax 604 683 0492
ibigroup.com

PROJECT TITLE
Harris Green Village
Phase 01
1045 Yates Street
Victoria, BC

PROJECT NO:	121123
DRAWN BY:	Author
CHKD BY:	Checker
SCALE:	1 : 100
DATE:	2021-03-05

SHEET TITLE
COURTYARD ELEVATION

SHEET NUMBER
A2.12

REV

File Location: BIM 360://121123 - Yates Street - Harris Green Village Ph 1 R2020/121123_YatesStA-Podium-2020.rvt
Last Saved: 2021-03-05 10:27:56 PM

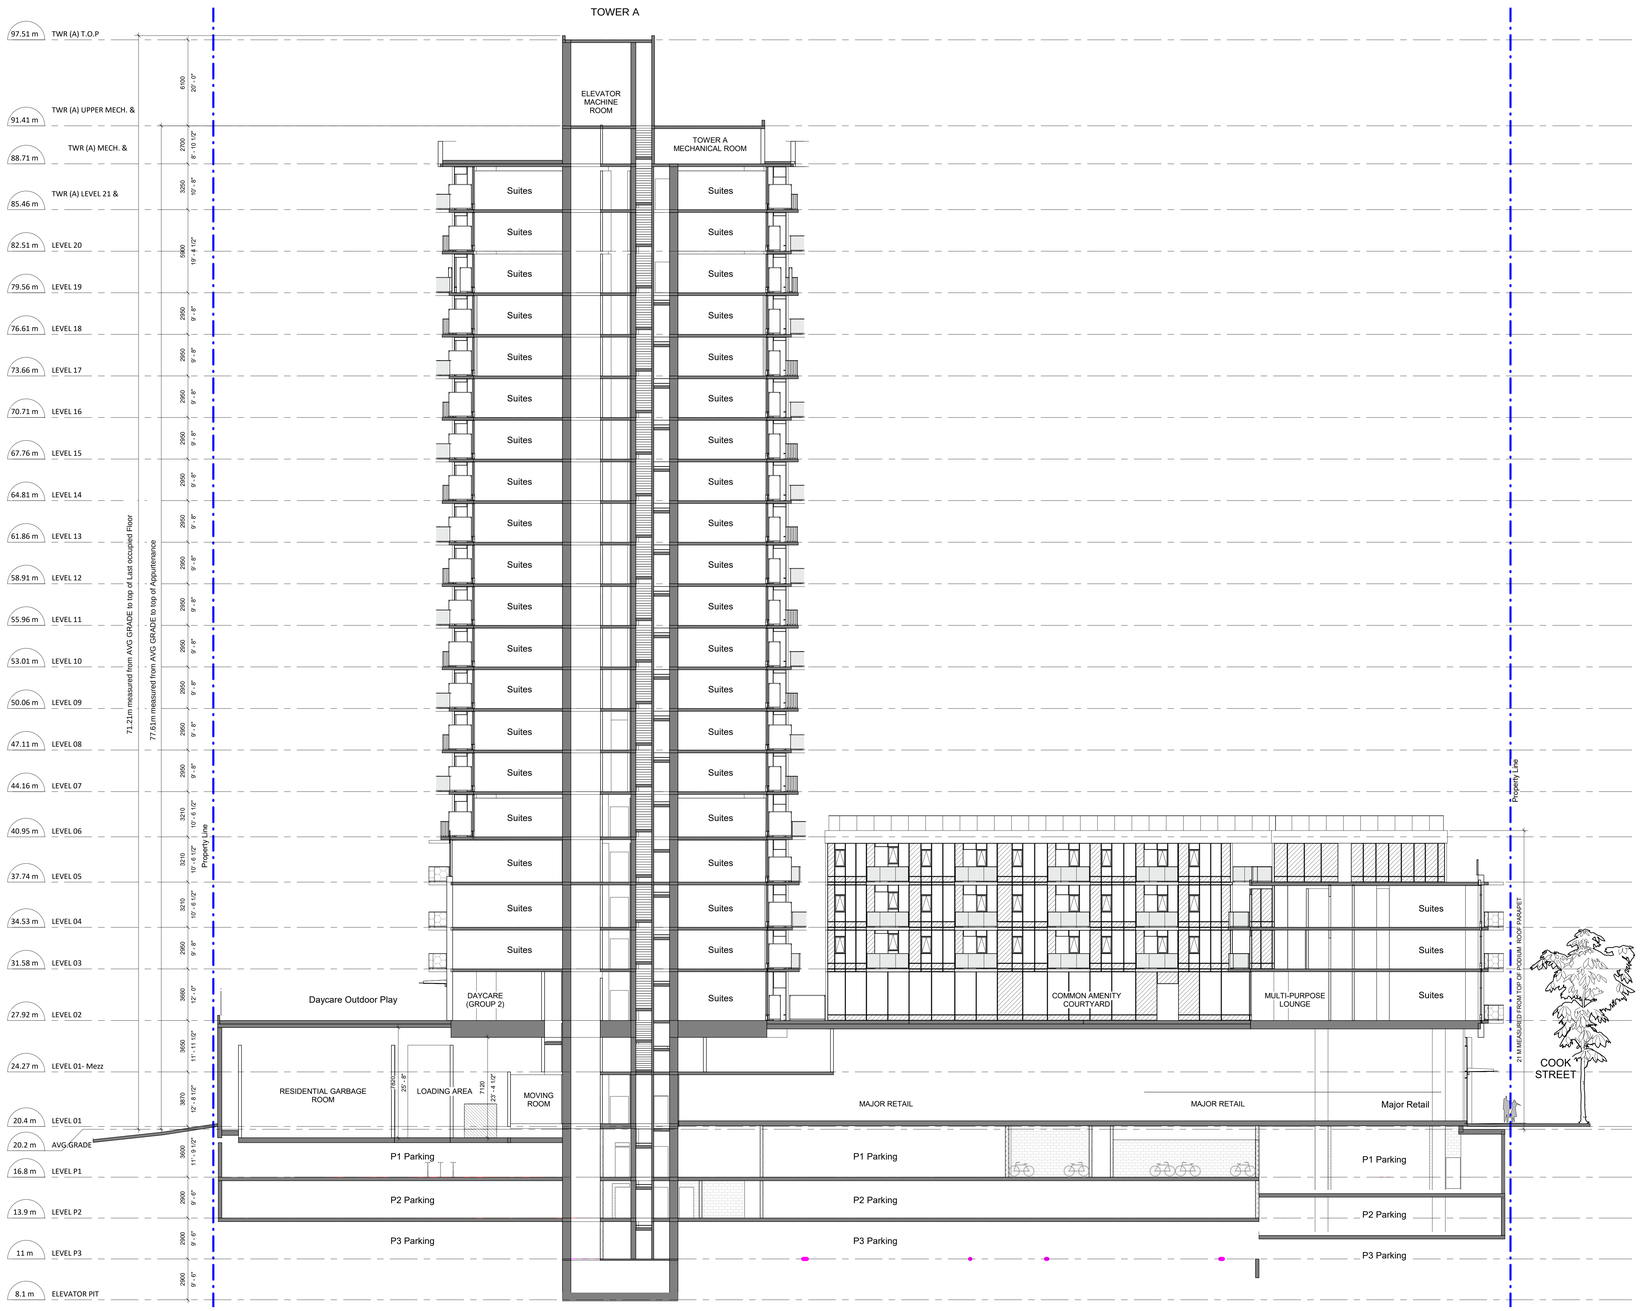

heights revised
massing
revised

CLIENT

Starlight Developments

Starlight Developments
P.O.Box 1690 Station B Mississauga, Ontario, Canada
L4Y1W6

COPYRIGHT:
This drawing has been prepared solely for the intended use, thus any reproduction or distribution for any purpose other than authorized by IBI Group is forbidden. Written dimensions shall have precedence over scaled dimensions. Contractors shall verify and be responsible for all dimensions and conditions on the job, and IBI Group shall be notified of any variations between conditions and information shown on the drawing. Shop drawings shall be submitted to IBI Group for general conformance before proceeding with fabrication.

IBI Group Architects (Canada) Inc.
is a member of the IBI Group of companies

NO.	DATE	DESCRIPTION
1	YYYY-MM-DD	

ISSUES

NO.	DATE	DESCRIPTION

REVISIONS

Issued For: Project Status
Date: 2021-03-05

SEAL

REGISTERED ARCHITECT JOHN GIMA BRITISH COLUMBIA
2021-03-06

BCB CONSULTANT

PRIME CONSULTANT

IBI GROUP
ARCHITECTS (CANADA) INC.
700-1285 West Pender Street,
Vancouver, BC V6E 4B1, Canada
tel 604 683 8797 fax 604 683 0492
ibigroup.com

PROJECT TITLE
Harris Green Village
Phase 01
1045 Yates Street
Victoria, BC

PROJECT NO:	121123
DRAWN BY:	
CHKD BY:	
SCALE:	1 : 150
DATE:	2021-03-05

SHEET TITLE
SECTION A
Tower A & Podium

SHEET NUMBER
A3.01

REV

Last Saved: 2021-03-05 10:28:04 PM File Location: BIM 360://121123 - Yates Street – Harris Green Village Ph 1 (2020)/121123_Yates-St-A-Podium-2020.rvt

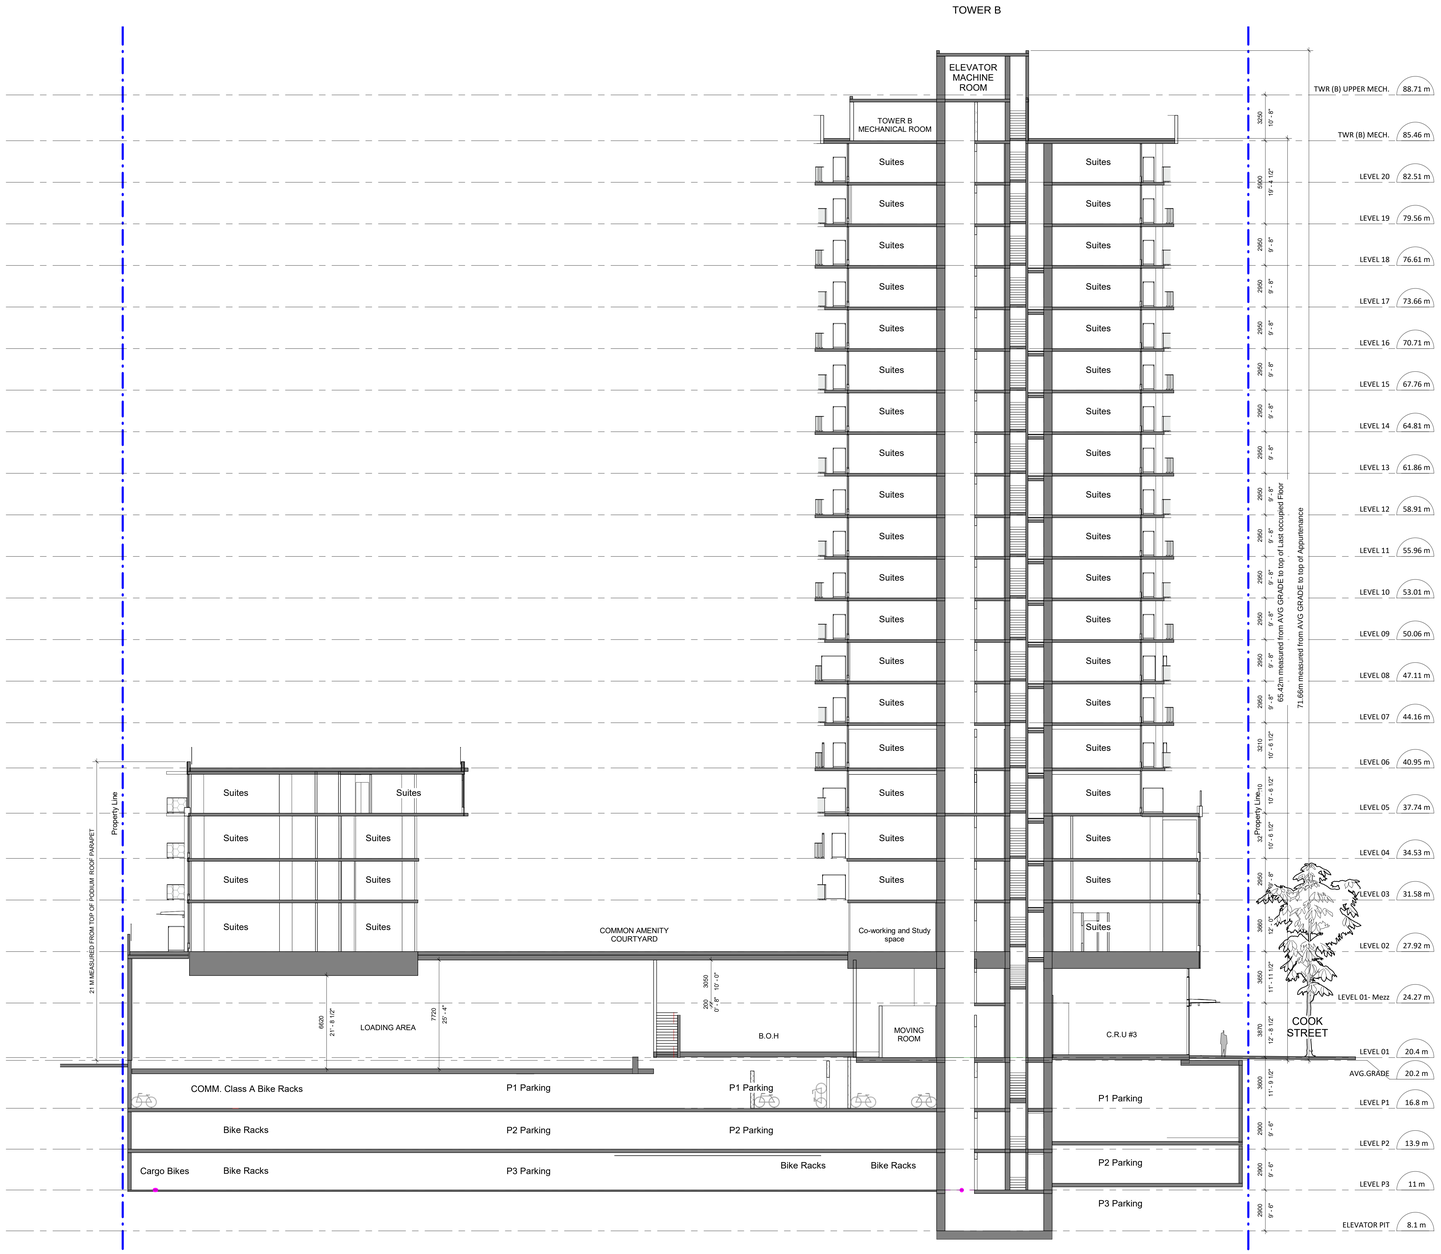

heights added; spandrel reduced massing reconfigured

CLIENT

Starlight Developments

Starlight Developments
P.O.Box 1690 Station B Mississauga, Ontario, Canada
L4Y1W8

COPYRIGHT:
This drawing has been prepared solely for the intended use, thus any reproduction or distribution for any purpose other than authorized by IBI Group is forbidden. Written dimensions shall have precedence over scaled dimensions. Contractors shall verify and be responsible for all dimensions and conditions on the job, and IBI Group shall be notified of any variations between the conditions and dimensions shown on the drawing. Shop drawings shall be submitted to IBI Group for general conformance before proceeding with fabrication.
IBI Group Architects (Canada) Inc.
is a member of the IBI Group of companies

NO.	YYYY-MM-DD	DESCRIPTION

ISSUES

NO.	DATE	DESCRIPTION

REVISIONS

Issued For: Project Status
Date: 2021-03-05

SEAL

REGISTERED ARCHITECT
CHRISTOPHER GAMBLE
PROVINCE OF BRITISH COLUMBIA
2021-03-06

SUB-CONSULTANT

PRIME CONSULTANT

IBI GROUP
ARCHITECTS (CANADA) INC.
700-1285 West Pender Street,
Vancouver, BC V6E 4B1, Canada
tel 604 683 8797 fax 604 683 0492
ibigroup.com

PROJECT TITLE
Harris Green Village
Phase 01
1045 Yates Street
Victoria, BC

PROJECT NO:	121123
DRAWN BY:	
CHKD BY:	
SCALE:	1 : 150
DATE:	2021-03-05

SHEET TITLE
SECTION B
Tower B & Podium

SHEET NUMBER
A3.02

REV

Last Saved: 2021-03-05 10:26:11 PM File Location: IBI#190!!121123 - Yates Street - Harris Green Village Ph 1 R2020!121123_-YatesStA-Podium-2020.vwt

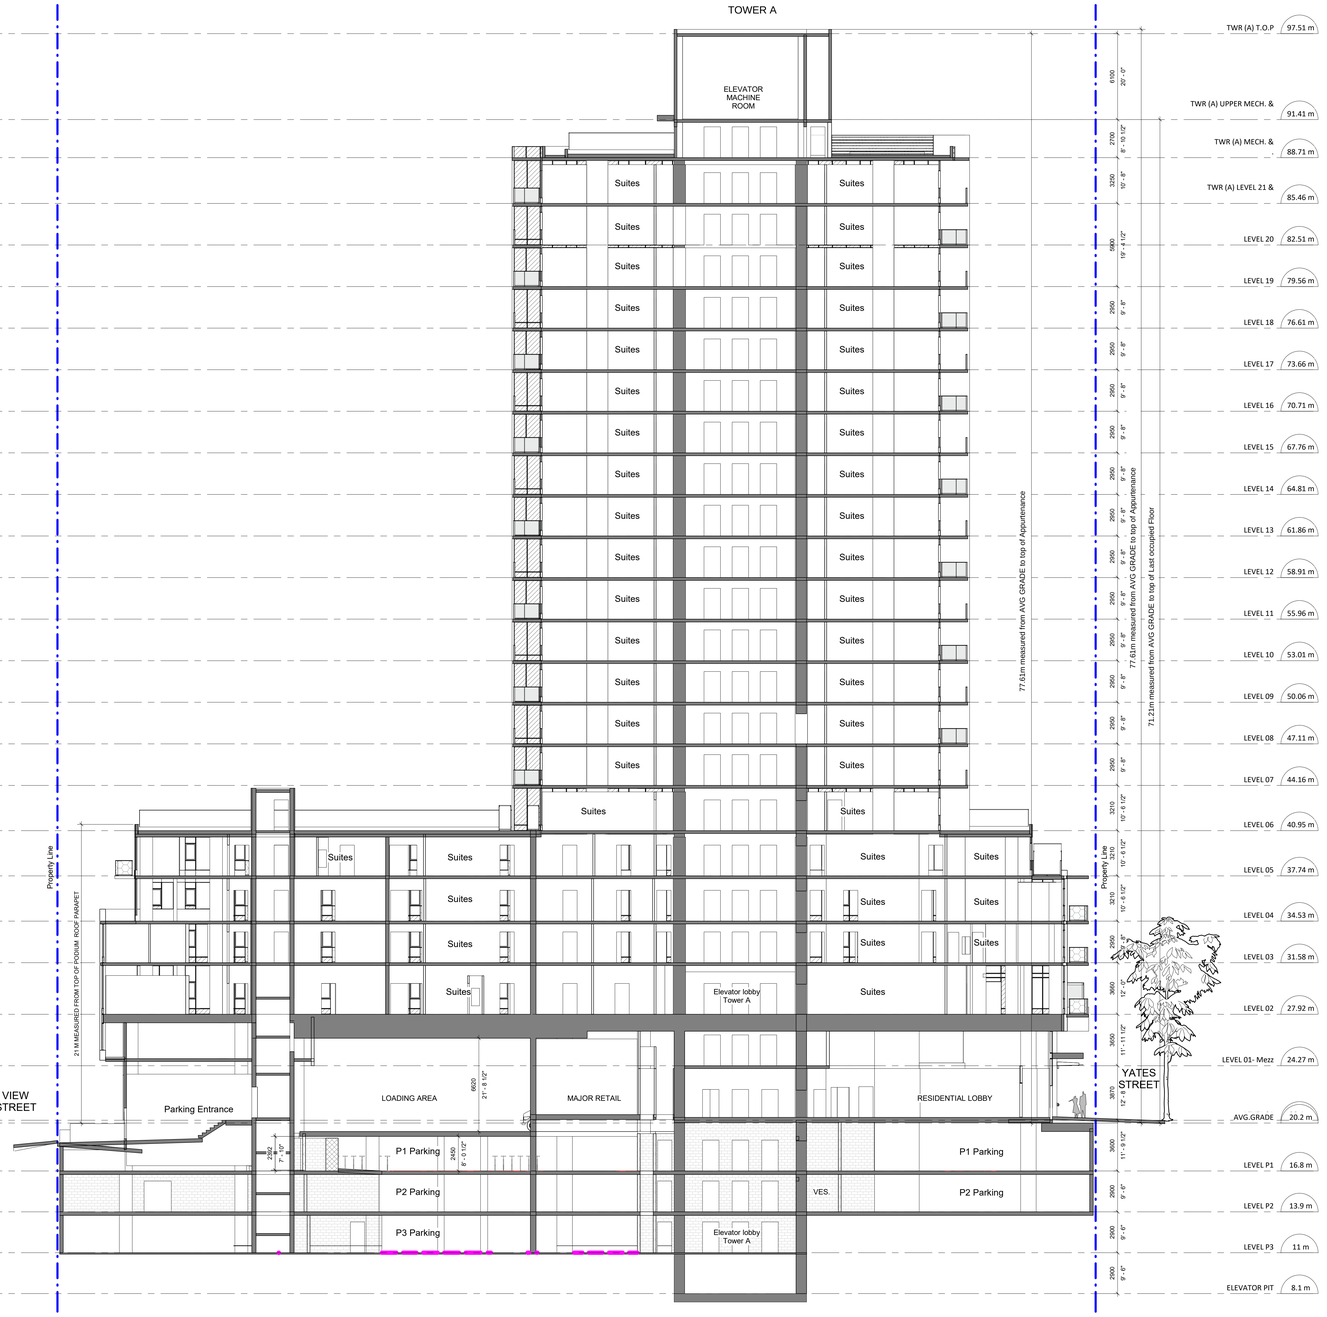

heights added;
spandrel reduced
massing reconfigured

CLIENT

Starlight Developments

Starlight Developments
P.O.Box 1890 Station B Mississauga, Ontario, Canada
L4Y1W6

COPYRIGHT:
This drawing has been prepared solely for the intended use, thus any reproduction or distribution for any purpose other than authorized by IBI Group is forbidden. Written dimensions shall have precedence over scaled dimensions. Contractors shall verify and be responsible for all dimensions and conditions on the job, and IBI Group shall be notified of any variations from the dimensions and conditions shown on this drawing. Shop drawings shall be submitted to IBI Group for general conformance before proceeding with fabrication.
IBI Group Architects (Canada) Inc.
is a member of the IBI Group of companies

NO.	DATE	DESCRIPTION
1	YYYY-MM-DD	

ISSUES

NO.	DATE	DESCRIPTION

REVISIONS

Issued For: Project Status
Date: 2021-03-05

SEAL

REGISTERED ARCHITECT JOHN GIWA BRITISH COLUMBIA
2021-03-06

SUB-CONSULTANT

PRIME CONSULTANT

IBI GROUP
ARCHITECTS (CANADA) INC.
700-1285 West Pender Street
Vancouver, BC V6E 4B1, Canada
tel 604 683 8797 fax 604 683 0492
ibigroup.com

PROJECT TITLE
Harris Green Village
Phase 01
1045 Yates Street
Victoria, BC

PROJECT NO:	121123
DRAWN BY:	Author
CHK'D BY:	Checker
SCALE:	1 : 150
DATE:	2021-03-05

SHEET TITLE
SECTION C
Tower A & Podium

SHEET NUMBER
A3.03

REV

Last Saved: 2021-03-05 10:25:15 PM File Location: BIM 360://121123 - Yates Street – Harris Green Village Ph I 5\2020\121123_YatesStA-Podium-2020.rvt

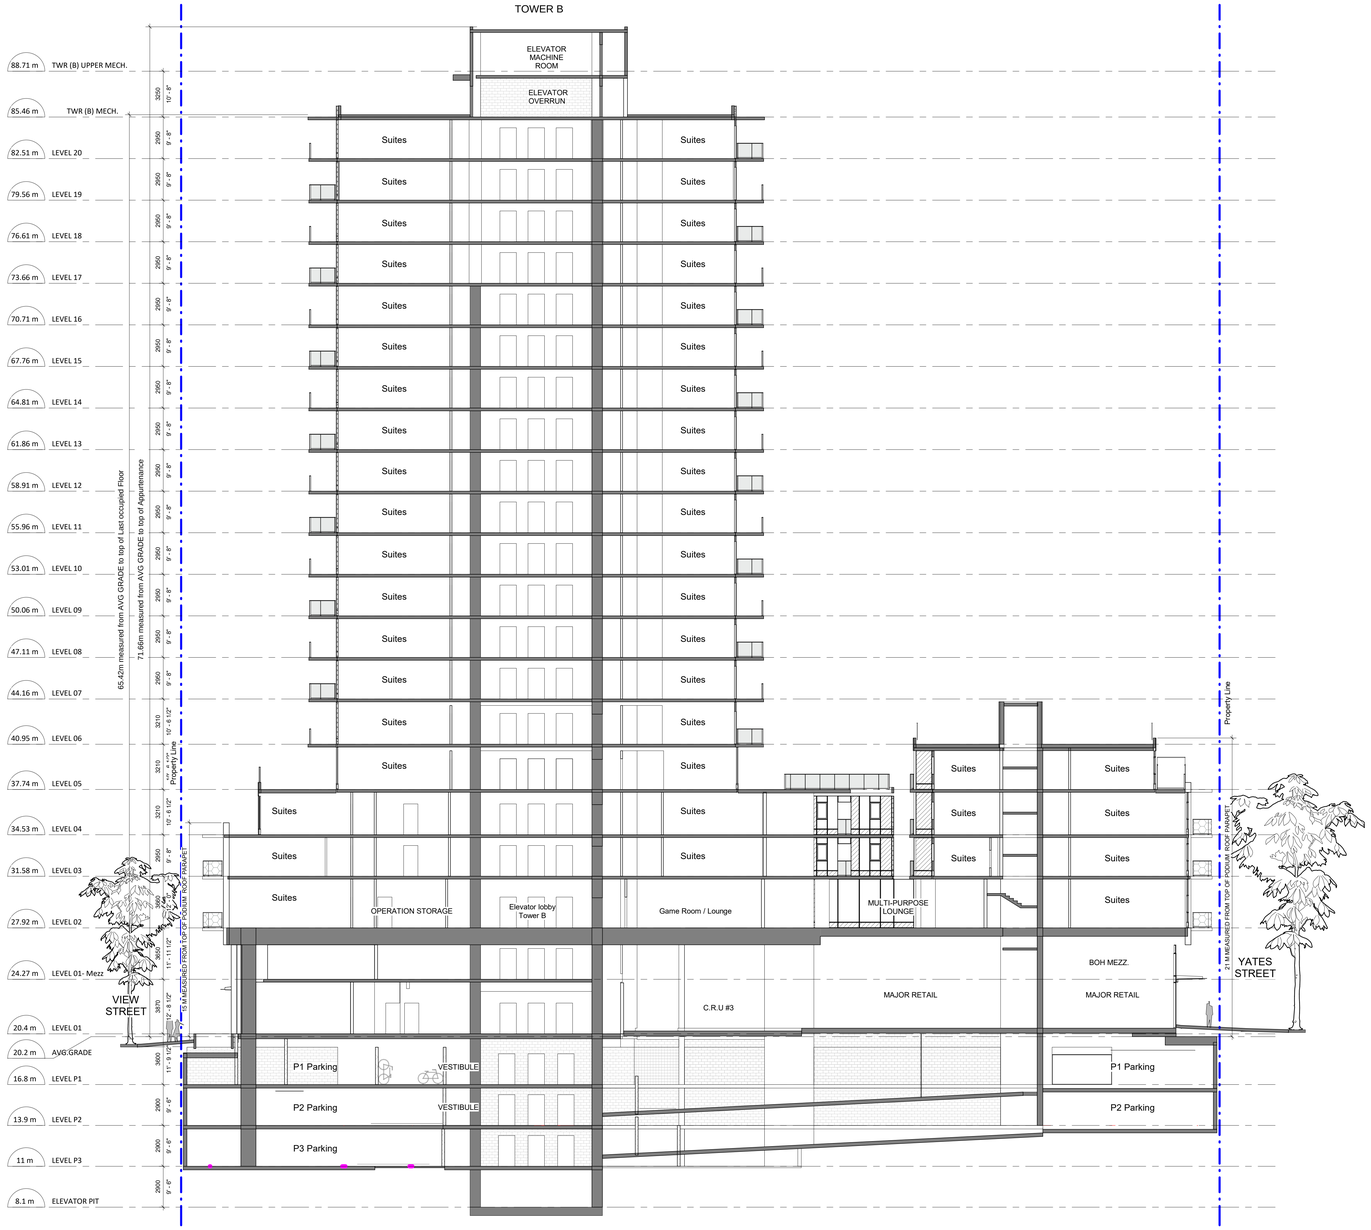

heights added;
spandrel reduced
massing reconfigured

CLIENT

Starlight Developments

Starlight Developments
P.O.Box 1690 Station B Mississauga, Ontario, Canada
L4Y1W6

COPYRIGHT:
This drawing has been prepared solely for the intended use, thus any reproduction or distribution for any purpose other than authorized by IBI Group is forbidden. Written dimensions shall have precedence over scaled dimensions. Contractors shall verify and be responsible for all dimensions and conditions on the job, and IBI Group shall be notified of any variations between the conditions and the plans shown on the drawing. Shop drawings shall be submitted to IBI Group for general conformance before proceeding with fabrication.
IBI Group Architects (Canada) Inc.
is a member of the IBI Group of companies

NO.	DATE	DESCRIPTION
1	YYYY-MM-DD	

ISSUES

NO.	DATE	DESCRIPTION

REVISIONS

Issued For: Project Status
Date: 2021-03-05

SEAL

REGISTERED ARCHITECT JOHN GWYN HUGHES BRITISH COLUMBIA
2021-03-05

SUB-CONSULTANT

PRIME CONSULTANT

IBI GROUP
ARCHITECTS (CANADA) INC.
700-1285 West Pender Street,
Vancouver, BC V6E 4B1, Canada
tel 604 683 8797 fax 604 683 0492
ibigroup.com

PROJECT TITLE
Harris Green Village
Phase 01
1045 Yates Street
Victoria, BC

PROJECT NO:	121123
DRAWN BY:	Author
CHKD BY:	Checker
SCALE:	1 : 150
DATE:	2021-03-05

SHEET TITLE
SECTION D
Tower B & Podium

SHEET NUMBER
A3.04

REV

Last Saved: 2021-03-05 10:28:23 PM File Location: BIM 360://121123 - Yates Street – Harris Green Village Ph 1\20200121123_YatesStA-Podium-2020.rvt

TOWER A (21-Storey)

Level (s)	Gross Floor Area		Exclusions								Total Floor Area	
			Exterior Wall		Elevator Shafts		Parking/Loading/Bike Parking		Sub Total			
	Metric (m2)	Imperial (ft2)	Metric (m2)	Imperial (ft2)	Metric (m2)	Imperial (ft2)	Metric (m2)	Imperial (ft2)	Metric (m2)	Imperial (ft2)	Metric (m2)	Imperial (ft2)
Mech	**73.0**	785	13.1	141	-	-	-	-	**13.1**	141	**59.9**	644
Residential flo	**174.3**	1,877	18.0	194	16.6	179	-	-	**34.6**	372	**139.8**	1,504
21	**648.4**	6,979	29.3	315	16.6	179	-	-	**45.9**	494	**602.5**	6,485
20	**648.4**	6,979	29.3	315	16.6	179	-	-	**45.9**	494	**602.5**	6,485
19	**648.4**	6,979	29.3	315	16.6	179	-	-	**45.9**	494	**602.5**	6,485
18	**648.4**	6,979	29.3	315	16.6	179	-	-	**45.9**	494	**602.5**	6,485
17	**648.4**	6,979	29.3	315	16.6	179	-	-	**45.9**	494	**602.5**	6,485
16	**648.4**	6,979	29.3	315	16.6	179	-	-	**45.9**	494	**602.5**	6,485
15	**648.4**	6,979	29.3	315	16.6	179	-	-	**45.9**	494	**602.5**	6,485
14	**648.4**	6,979	29.3	315	16.6	179	-	-	**45.9**	494	**602.5**	6,485
13	**648.4**	6,979	29.3	315	16.6	179	-	-	**45.9**	494	**602.5**	6,485
12	**648.4**	6,979	29.3	315	16.6	179	-	-	**45.9**	494	**602.5**	6,485
11	**648.4**	6,979	29.3	315	16.6	179	-	-	**45.9**	494	**602.5**	6,485
10	**648.4**	6,979	29.3	315	16.6	179	-	-	**45.9**	494	**602.5**	6,485
9	**648.4**	6,979	29.3	315	16.6	179	-	-	**45.9**	494	**602.5**	6,485
8	**648.4**	6,979	29.3	315	16.6	179	-	-	**45.9**	494	**602.5**	6,485
7	**648.4**	6,979	29.3	315	16.6	179	-	-	**45.9**	494	**602.5**	6,485
6	**664.3**	7,151	33.2	357	16.5	177	-	-	**49.7**	535	**614.6**	6,616
Total	**10,637.3**	114,499	**503.5**	5,420	**281.9**	3,034	**-**	-	**785.4**	8,454	**9,851.9**	106,045

TOWER B (20-Storey)

Level (s)	Gross Floor Area		Exclusions								Total Floor Area	
			Exterior Wall		Elevator Shafts		Parking/Loading/Bike Parking		Sub Total			
	Metric (m2)	Imperial (ft2)	Metric (m2)	Imperial (ft2)	Metric (m2)	Imperial (ft2)	Metric (m2)	Imperial (ft2)	Metric (m2)	Imperial (ft2)	Metric (m2)	Imperial (ft2)
Mech	**59.9**	644	13.1	141	-	-	-	-	**13.1**	141	**46.8**	504
Mech	**154.4**	1,662	19.4	209	16.6	179	-	-	**36.0**	388	**118.4**	1,275
20	**648.4**	6,979	29.3	315	16.6	179	-	-	**45.9**	494	**602.5**	6,485
19	**648.4**	6,979	29.3	315	16.6	179	-	-	**45.9**	494	**602.5**	6,485
18	**648.4**	6,979	29.3	315	16.6	179	-	-	**45.9**	494	**602.5**	6,485
17	**648.4**	6,979	29.3	315	16.6	179	-	-	**45.9**	494	**602.5**	6,485
16	**648.4**	6,979	29.3	315	16.6	179	-	-	**45.9**	494	**602.5**	6,485
15	**648.4**	6,979	29.3	315	16.6	179	-	-	**45.9**	494	**602.5**	6,485
14	**648.4**	6,979	29.3	315	16.6	179	-	-	**45.9**	494	**602.5**	6,485
13	**648.4**	6,979	29.3	315	16.6	179	-	-	**45.9**	494	**602.5**	6,485
12	**648.4**	6,979	29.3	315	16.6	179	-	-	**45.9**	494	**602.5**	6,485
11	**648.4**	6,979	29.3	315	16.6	179	-	-	**45.9**	494	**602.5**	6,485
10	**648.4**	6,979	29.3	315	16.6	179	-	-	**45.9**	494	**602.5**	6,485
9	**648.4**	6,979	29.3	315	16.6	179	-	-	**45.9**	494	**602.5**	6,485
8	**648.4**	6,979	29.3	315	16.6	179	-	-	**45.9**	494	**602.5**	6,485
7	**648.4**	6,979	29.3	315	16.6	179	-	-	**45.9**	494	**602.5**	6,485
6	**664.3**	7,151	33.2	357	16.5	177	-	-	**49.7**	535	**614.6**	6,616
Total	**9,955.9**	107,165	**475.6**	5,120	**265.3**	2,856	**-**	-	**741.0**	7,976	**9,215.0**	99,189

Podium

Level (s)	Gross Floor Area		Exclusions								Total Floor Area	
			Exterior Wall		Elevator Shafts		Parking/Loading/Bike Parking		Sub Total			
	Metric (m2)	Imperial (ft2)	Metric (m2)	Imperial (ft2)	Metric (m2)	Imperial (ft2)	Metric (m2)	Imperial (ft2)	Metric (m2)	Imperial (ft2)	Metric (m2)	Imperial (ft2)
5	**2,905.2**	31,272	105.5	1,136	32.9	355	-	-	**138.4**	1,490	**2,766.8**	29,781
4	**3,519.6**	37,885	128.8	1,386	32.9	355	-	-	**161.7**	1,741	**3,357.9**	36,144
3	**3,968.0**	42,711	130.9	1,409	42.3	455	-	-	**173.2**	1,864	**3,794.8**	40,847
2	**4,002.8**	43,086	124.6	1,342	42.3	455	-	-	**166.9**	1,796	**3,835.9**	41,289
1 M	**1,315.2**	14,157	19.2	207	16.5	177	-	-	**35.7**	384	**1,279.6**	13,773
1	**5,304.0**	57,092	82.3	886	50.5	543	1,251.1	13,467	**1,383.9**	14,896	**3,920.1**	42,196
Total	**21,014.9**	226,203	**591.4**	6,365	**217.4**	2,340	**1,251.1**	13,467	**2,059.8**	22,172	**18,955.1**	204,031

Phase 1 Total Tabulation

Level (s)	Gross Floor Area		Exclusions								Total Floor Area	
			Exterior Wall		Elevator Shafts		Parking/Loading/Bike Parking		Sub Total			
	Metric (m2)	Imperial (ft2)	Metric (m2)	Imperial (ft2)	Metric (m2)	Imperial (ft2)	Metric (m2)	Imperial (ft2)	Metric (m2)	Imperial (ft2)	Metric (m2)	Imperial (ft2)
Tower A	**10,637.3**	114,499	503.5	5,420	281.9	3,034	-	-	**785.4**	8,454	**9,851.9**	106,045
Tower B	**9,955.9**	107,165	475.6	5,120	265.3	2,856	-	-	**741.0**	7,976	**9,215.0**	99,189
Podium	**21,014.9**	226,203	591.4	6,365	217.4	2,340	1,251.1	13,467	**2,059.8**	22,172	**18,955.1**	204,031
Total	**41,608.2**	447,867	**1,570.5**	16,905	**764.6**	8,230	**1,251.1**	13,467	**3,586.2**	38,601	**38,022.0**	409,265

CLIENT

Starlight Developments

Starlight Developments
P.O. Box 1690 Station B Mississauga, Ontario, Canada
L4Y 3W8

COPYRIGHT:
This drawing has been prepared solely for the intended use, thus any reproduction or distribution for any purpose other than authorized by IBI Group is forbidden. Written dimensions shall have precedence over scaled dimensions. Contractors shall verify and be responsible for all dimensions and conditions on the job, and IBI Group shall be informed of any variations from the dimensions and conditions shown on the drawing. Shop drawings shall be submitted to IBI Group for general conformance before proceeding with fabrication.
IBI Group Architects (Canada) Inc.
is a member of the IBI Group of companies

NO.	DATE	DESCRIPTION
1	YYYY-MM-DD	

ISSUES

NO.	DATE	DESCRIPTION

REVISIONS

PROJECT NORTH
N

Issued For: Project Status
Date: 2021-03-05

SEAL

REGISTERED ARCHITECT JOHN GIWA-TYLO BRITISH COLUMBIA
2021-03-06

SUB-CONSULTANT

PRIME CONSULTANT

IBI GROUP
ARCHITECTS (CANADA) INC.
700-1285 West Pender Street,
Vancouver, BC V6E 4B1, Canada
tel 604 683 8797 fax 604 683 0492
ibigroup.com

PROJECT TITLE
Harris Green Village
Phase 01
1045 Yates Street
Victoria, BC

PROJECT NO:	121123
DRAWN BY:	Author
CHKD BY:	Checker
SCALE:	1 : 1
DATE:	2021-03-05

SHEET TITLE
FSR CALCULATION SUMMARY

SHEET NUMBER
A7.00

REV

Last Saved: 2021-03-05 10:28:45 PM File Location: B:\M Jobs\121123 - Yates Street - Harris Green Village Ph 1 R2020\121123_YatesStA-Podium-2020.rvt

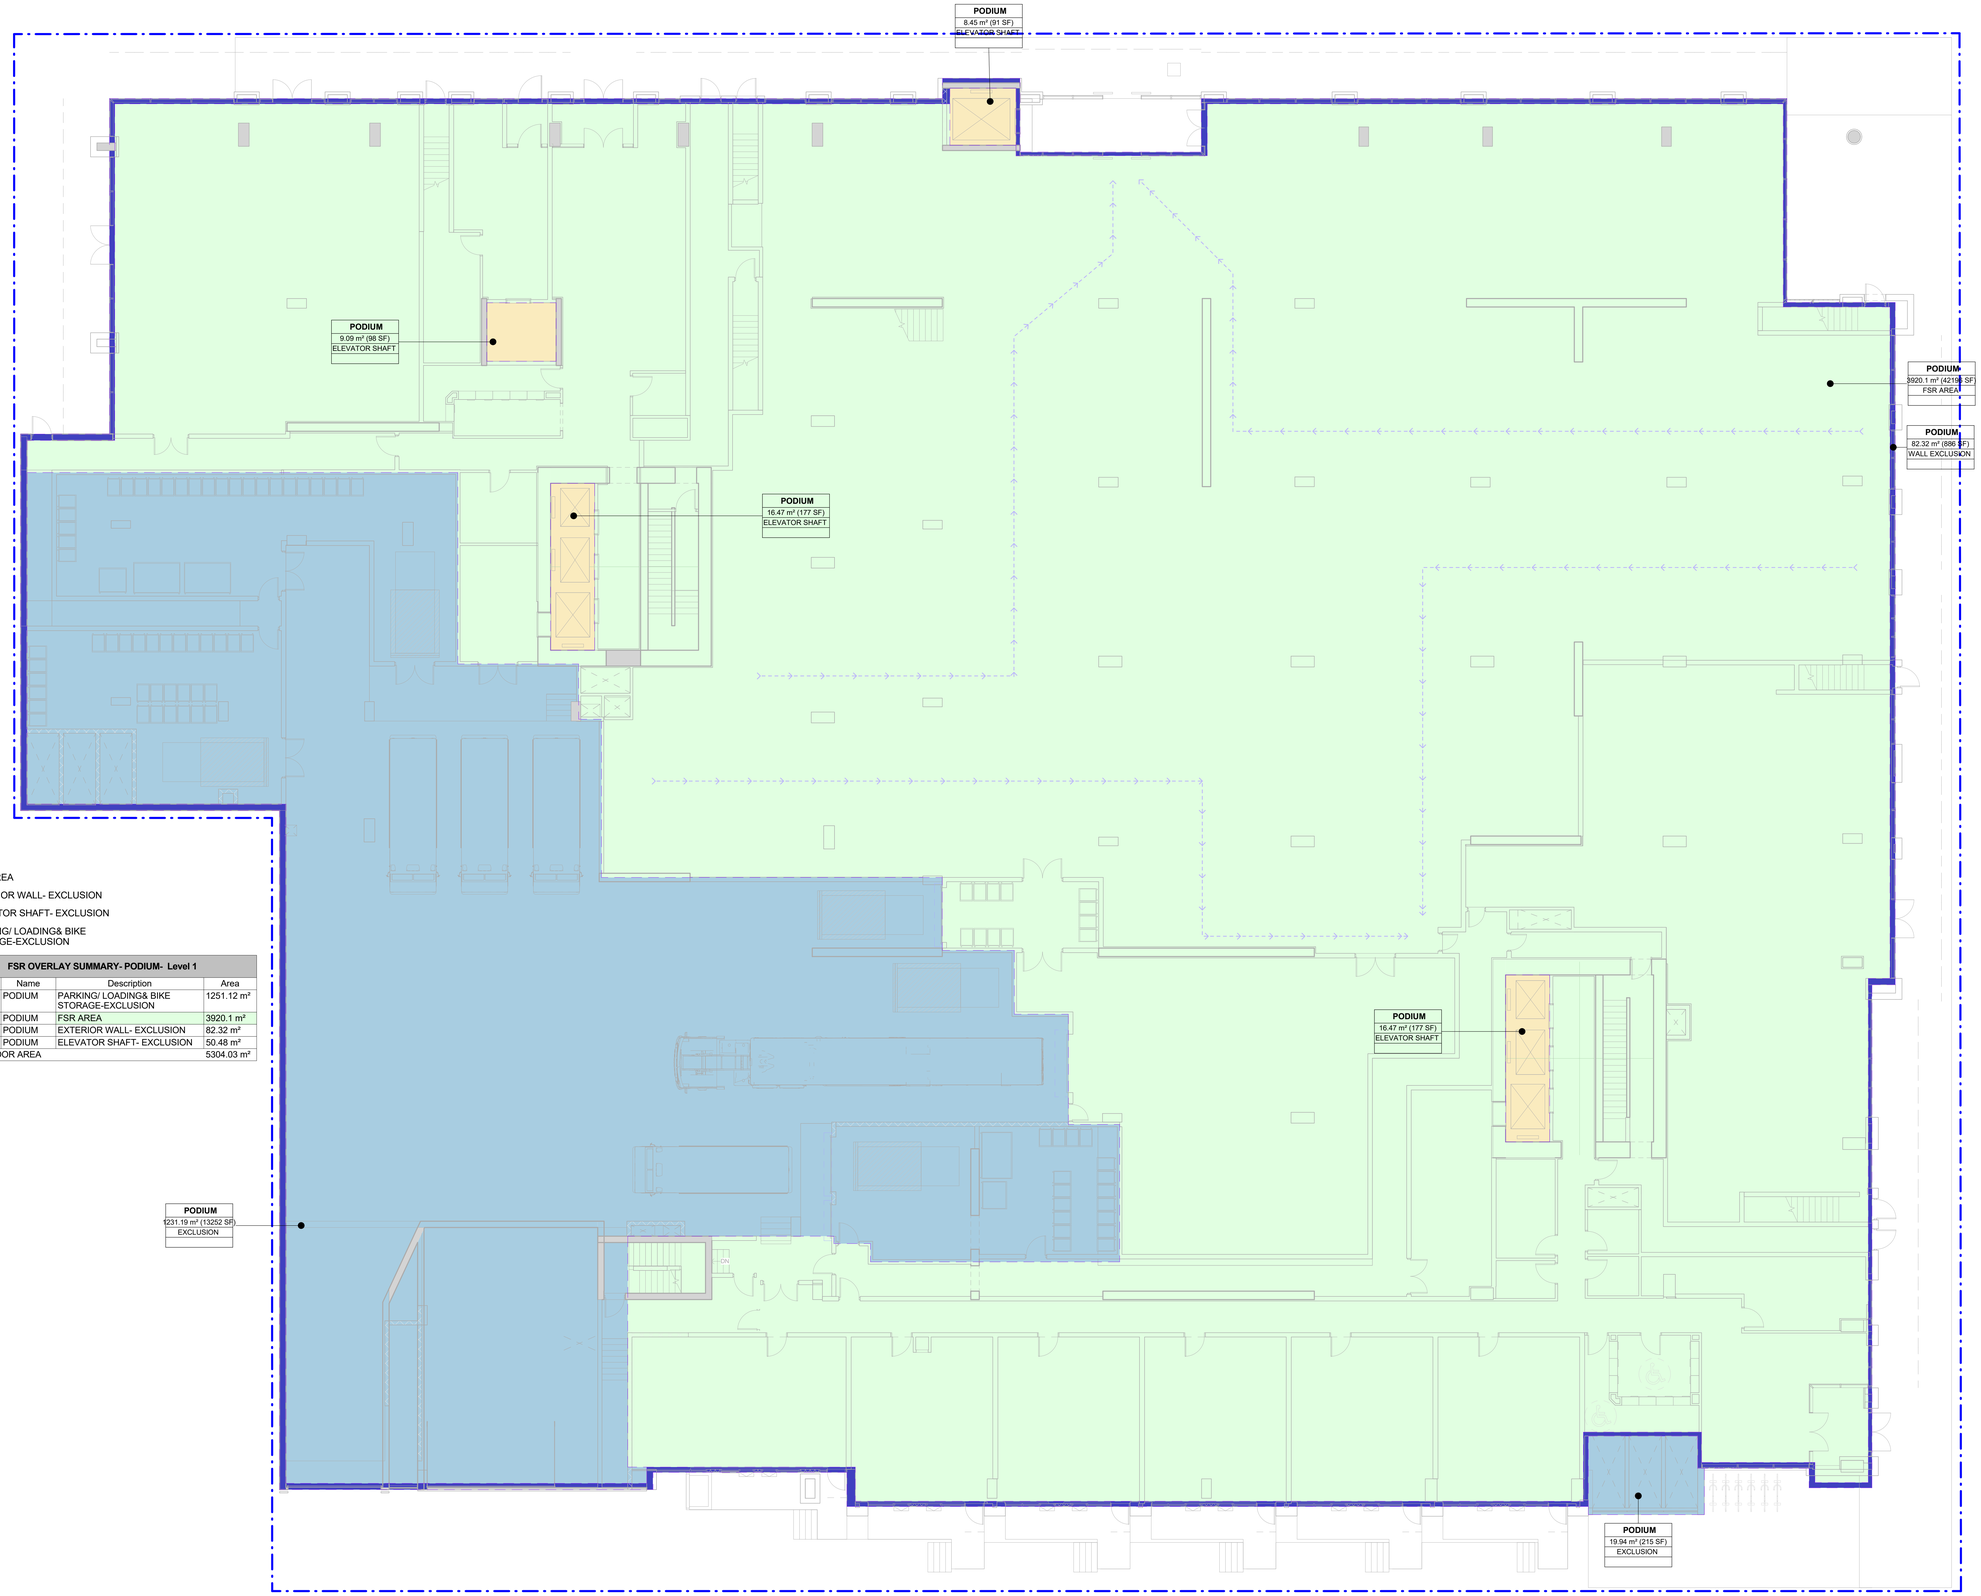

LEGEND

- FSR AREA
- EXTERIOR WALL- EXCLUSION
- ELEVATOR SHAFT- EXCLUSION
- PARKING/ LOADING& BIKE STORAGE-EXCLUSION

FSR OVERLAY SUMMARY- PODIUM- Level 1

Level	Name	Description	Area
LEVEL 01	PODIUM	PARKING/ LOADING& BIKE STORAGE-EXCLUSION	1251.12 m²
LEVEL 01	PODIUM	FSR AREA	3920.1 m²
LEVEL 01	PODIUM	EXTERIOR WALL- EXCLUSION	82.32 m²
LEVEL 01	PODIUM	ELEVATOR SHAFT- EXCLUSION	50.48 m²
GROSS FLOOR AREA			5304.03 m²

CLIENT

Starlight Developments

Starlight Developments
P.O. Box 1890 Station B Mississauga, Ontario, Canada
L4Y 3W8

COPYRIGHT:
This drawing has been prepared solely for the intended use, thus any reproduction or distribution for any purpose other than authorized by IBI Group is forbidden. Written dimensions shall have precedence over scaled dimensions. Contractors shall verify and be responsible for all dimensions and conditions on the job, and IBI Group shall be informed of any variations from the dimensions and conditions shown on the drawing. Shop drawings shall be submitted to IBI Group for general conformance before proceeding with fabrication.
IBI Group Architects (Canada) Inc.
is a member of the IBI Group of companies

NO.	DATE	DESCRIPTION
1	YYYY-MM-DD	

ISSUES

NO.	DATE	DESCRIPTION

REVISIONS

PROJECT NORTH

N

Issued For: Project Status

Date: 2021-03-05

SEAL

REGISTERED ARCHITECT JOHN GIMPEL BRITISH COLUMBIA
2021-03-06

SUB-CONSULTANT

PRIME CONSULTANT

IBI GROUP
ARCHITECTS (CANADA) INC.
700-1285 West Pender Street,
Vancouver, BC V6E 4B1, Canada
tel 604 683 8797 fax 604 683 0402
ibigroup.com

PROJECT TITLE

Harris Green Village
Phase 01
1045 Yates Street
Victoria, BC

PROJECT NO:	121123
DRAWN BY:	Author
CHK'D BY:	Checker
SCALE:	1 : 100
DATE:	2021-03-05

SHEET TITLE

FSR OVERLAY- Level 01

SHEET NUMBER

A7.01

REV

Last Saved: 2021-03-05 10:26:55 PM File Location: I:\BM-360-1\121123 - Yates Street - Harris Green Village Ph 1 R2020\121123_ YatesStA-Podium-2020.rvt

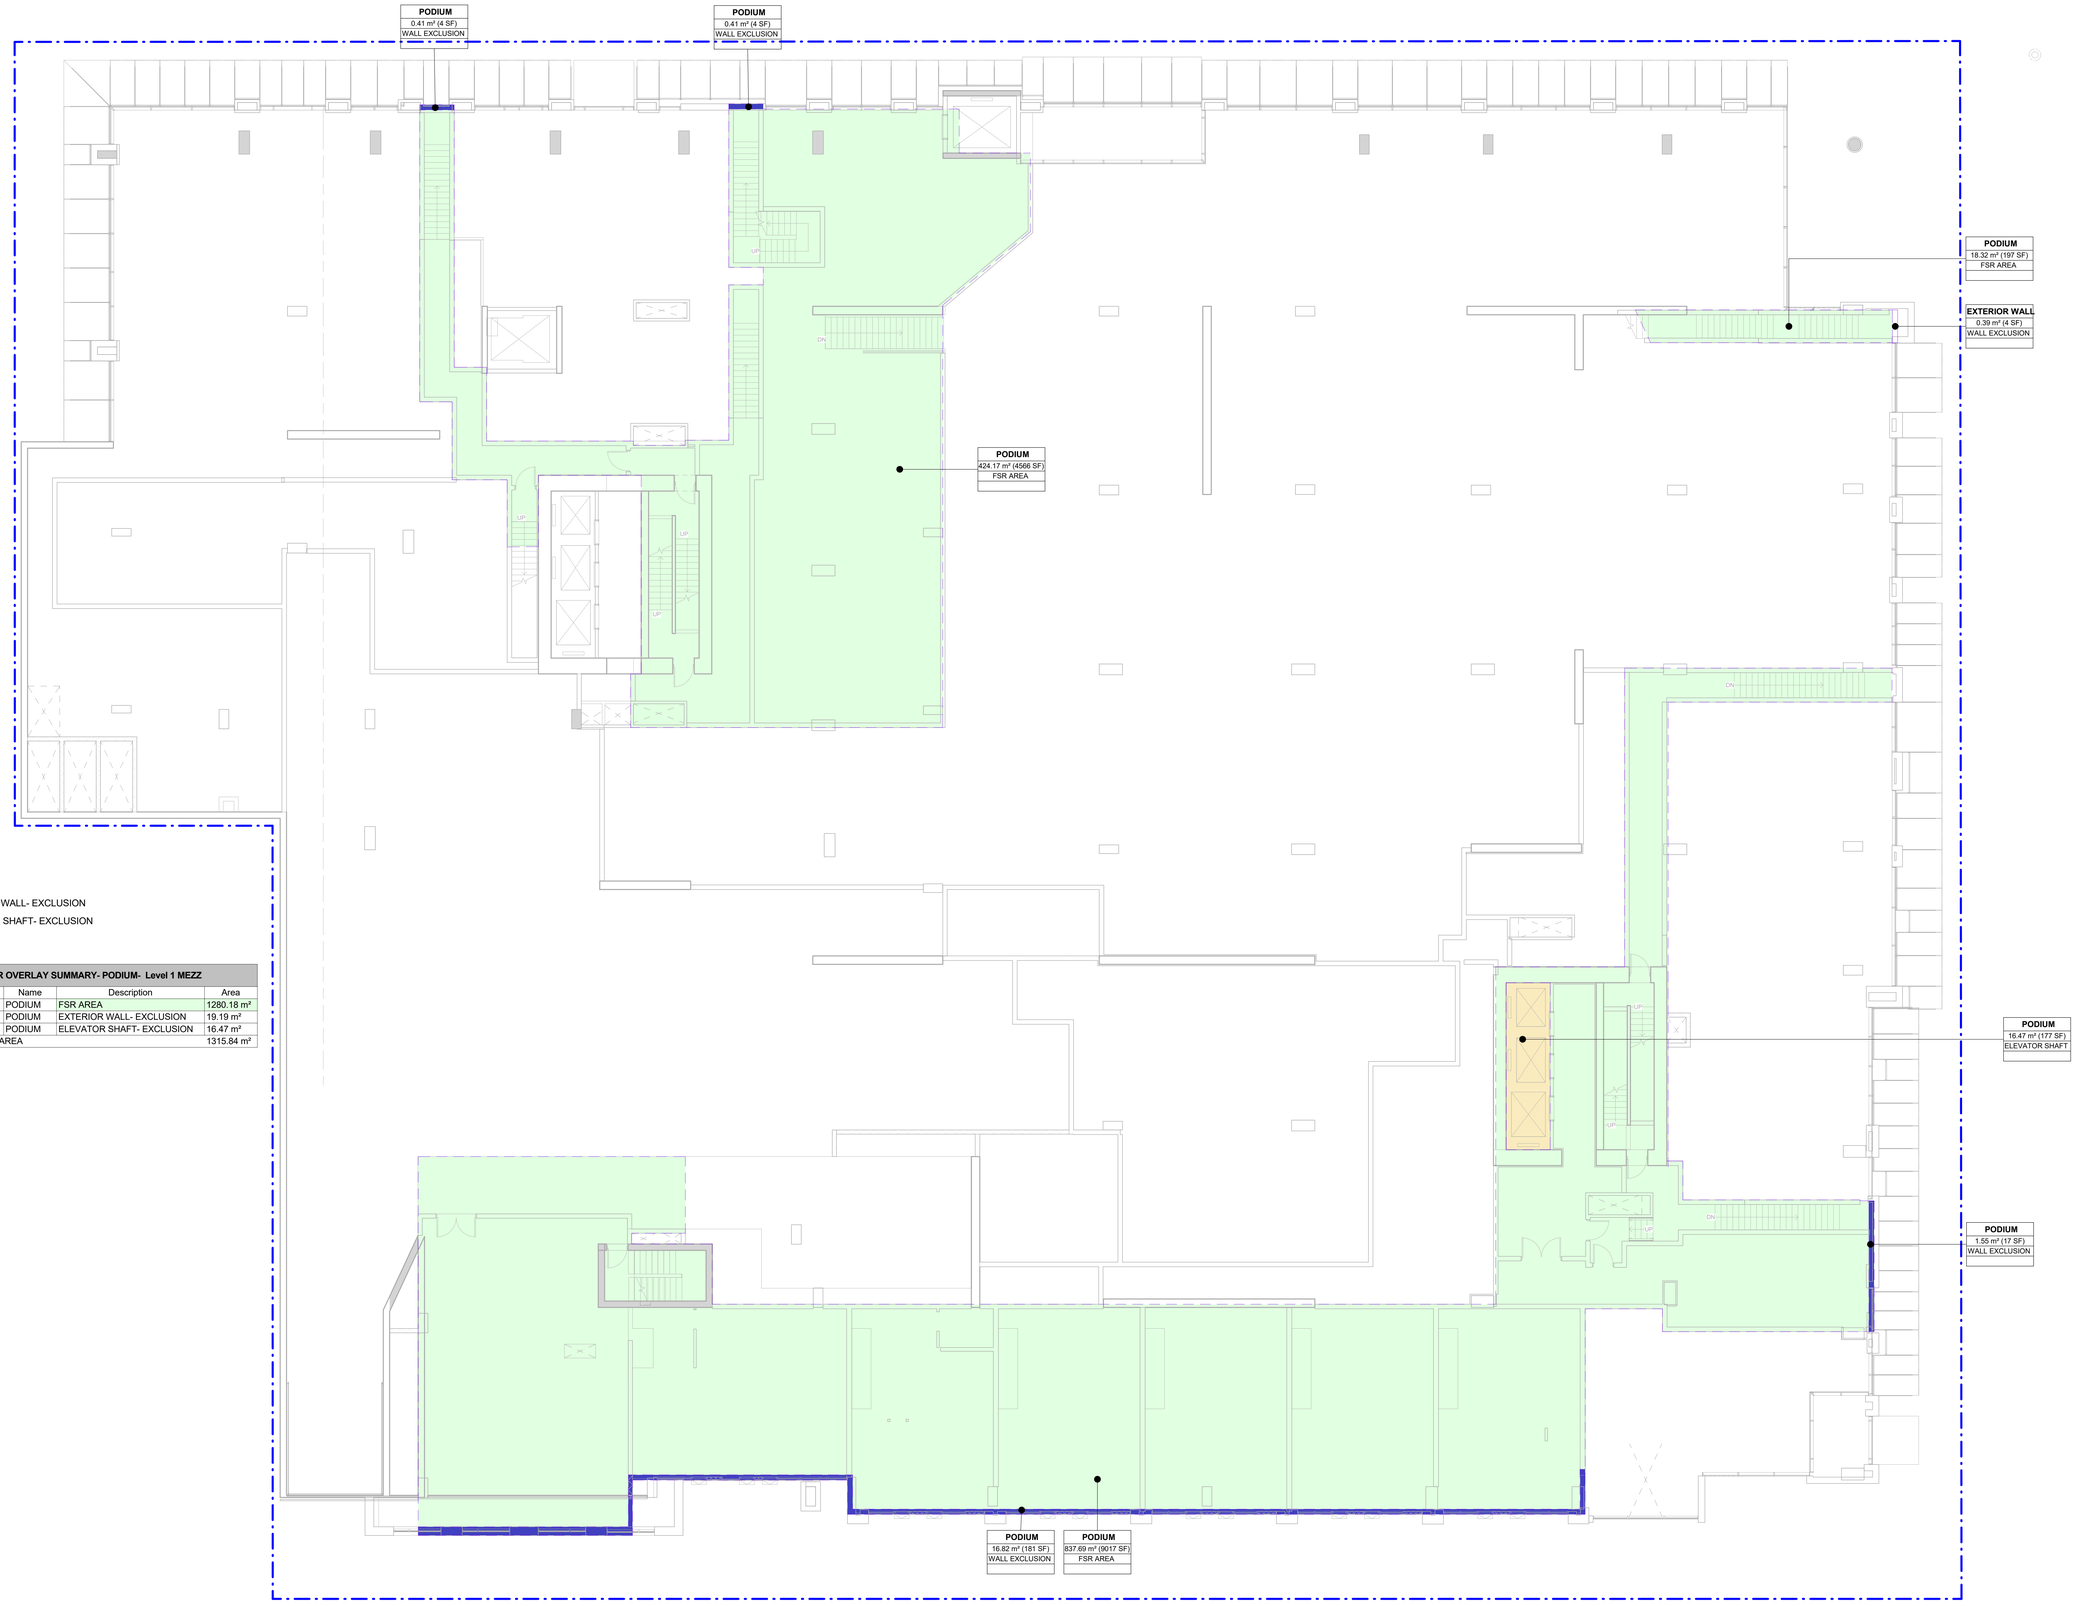

LEGEND

- FSR AREA
- EXTERIOR WALL- EXCLUSION
- ELEVATOR SHAFT- EXCLUSION

FSR OVERLAY SUMMARY- PODIUM- Level 1 MEZZ

Level	Name	Description	Area
LEVEL 01- Mezz	PODIUM	FSR AREA	1280.18 m²
LEVEL 01- Mezz	PODIUM	EXTERIOR WALL- EXCLUSION	19.19 m²
LEVEL 01- Mezz	PODIUM	ELEVATOR SHAFT- EXCLUSION	16.47 m²
GROSS FLOOR AREA			1315.84 m²

CLIENT

Starlight Developments

Starlight Developments

P.O. Box 1890 Station B Mississauga, Ontario, Canada L4Y 3W8

COPYRIGHT:
This drawing has been prepared solely for the intended use, thus any reproduction or distribution for any purpose other than authorized by IBI Group is forbidden. Written dimensions shall have precedence over scaled dimensions. Contractors shall verify and be responsible for all dimensions and conditions on the job, and IBI Group shall be informed of any variations from the dimensions and conditions shown on the drawing. Shop drawings shall be submitted to IBI Group for general conformance before proceeding with fabrication.
IBI Group Architects (Canada) Inc.
is a member of the IBI Group of companies

NO.	DATE	DESCRIPTION
1	YYYY-MM-DD	

ISSUES

NO.	DATE	DESCRIPTION

REVISIONS

PROJECT NORTH

N

Issued For: Project Status

Date: 2021-03-05

SEAL

REGISTERED ARCHITECT JOHN CHRISTOPHER WITHERS COLUMBIA

2021-03-06

SUB-CONSULTANT

PRIME CONSULTANT

IBI GROUP
ARCHITECTS (CANADA) INC.
700-1285 West Pender Street,
Vancouver, BC V6E 4B1, Canada
tel 604 683 8797 fax 604 683 0492
ibigroup.com

PROJECT TITLE

Harris Green Village Phase 01

1045 Yates Street
Victoria, BC

PROJECT NO:	121123
DRAWN BY:	Author
CHK'D BY:	Checker
SCALE:	1 : 100
DATE:	2021-03-05

SHEET TITLE

FSR OVERLAY- Level 01- Mezz

SHEET NUMBER

A7.02

REV

Last Saved: 2021-03-05 10:29:05 PM File Location: 8bit:360:121123 - Yates Street - Harris Green Village Ph 1 R2020:121123_ YatesStA-Podium-2020.rvt

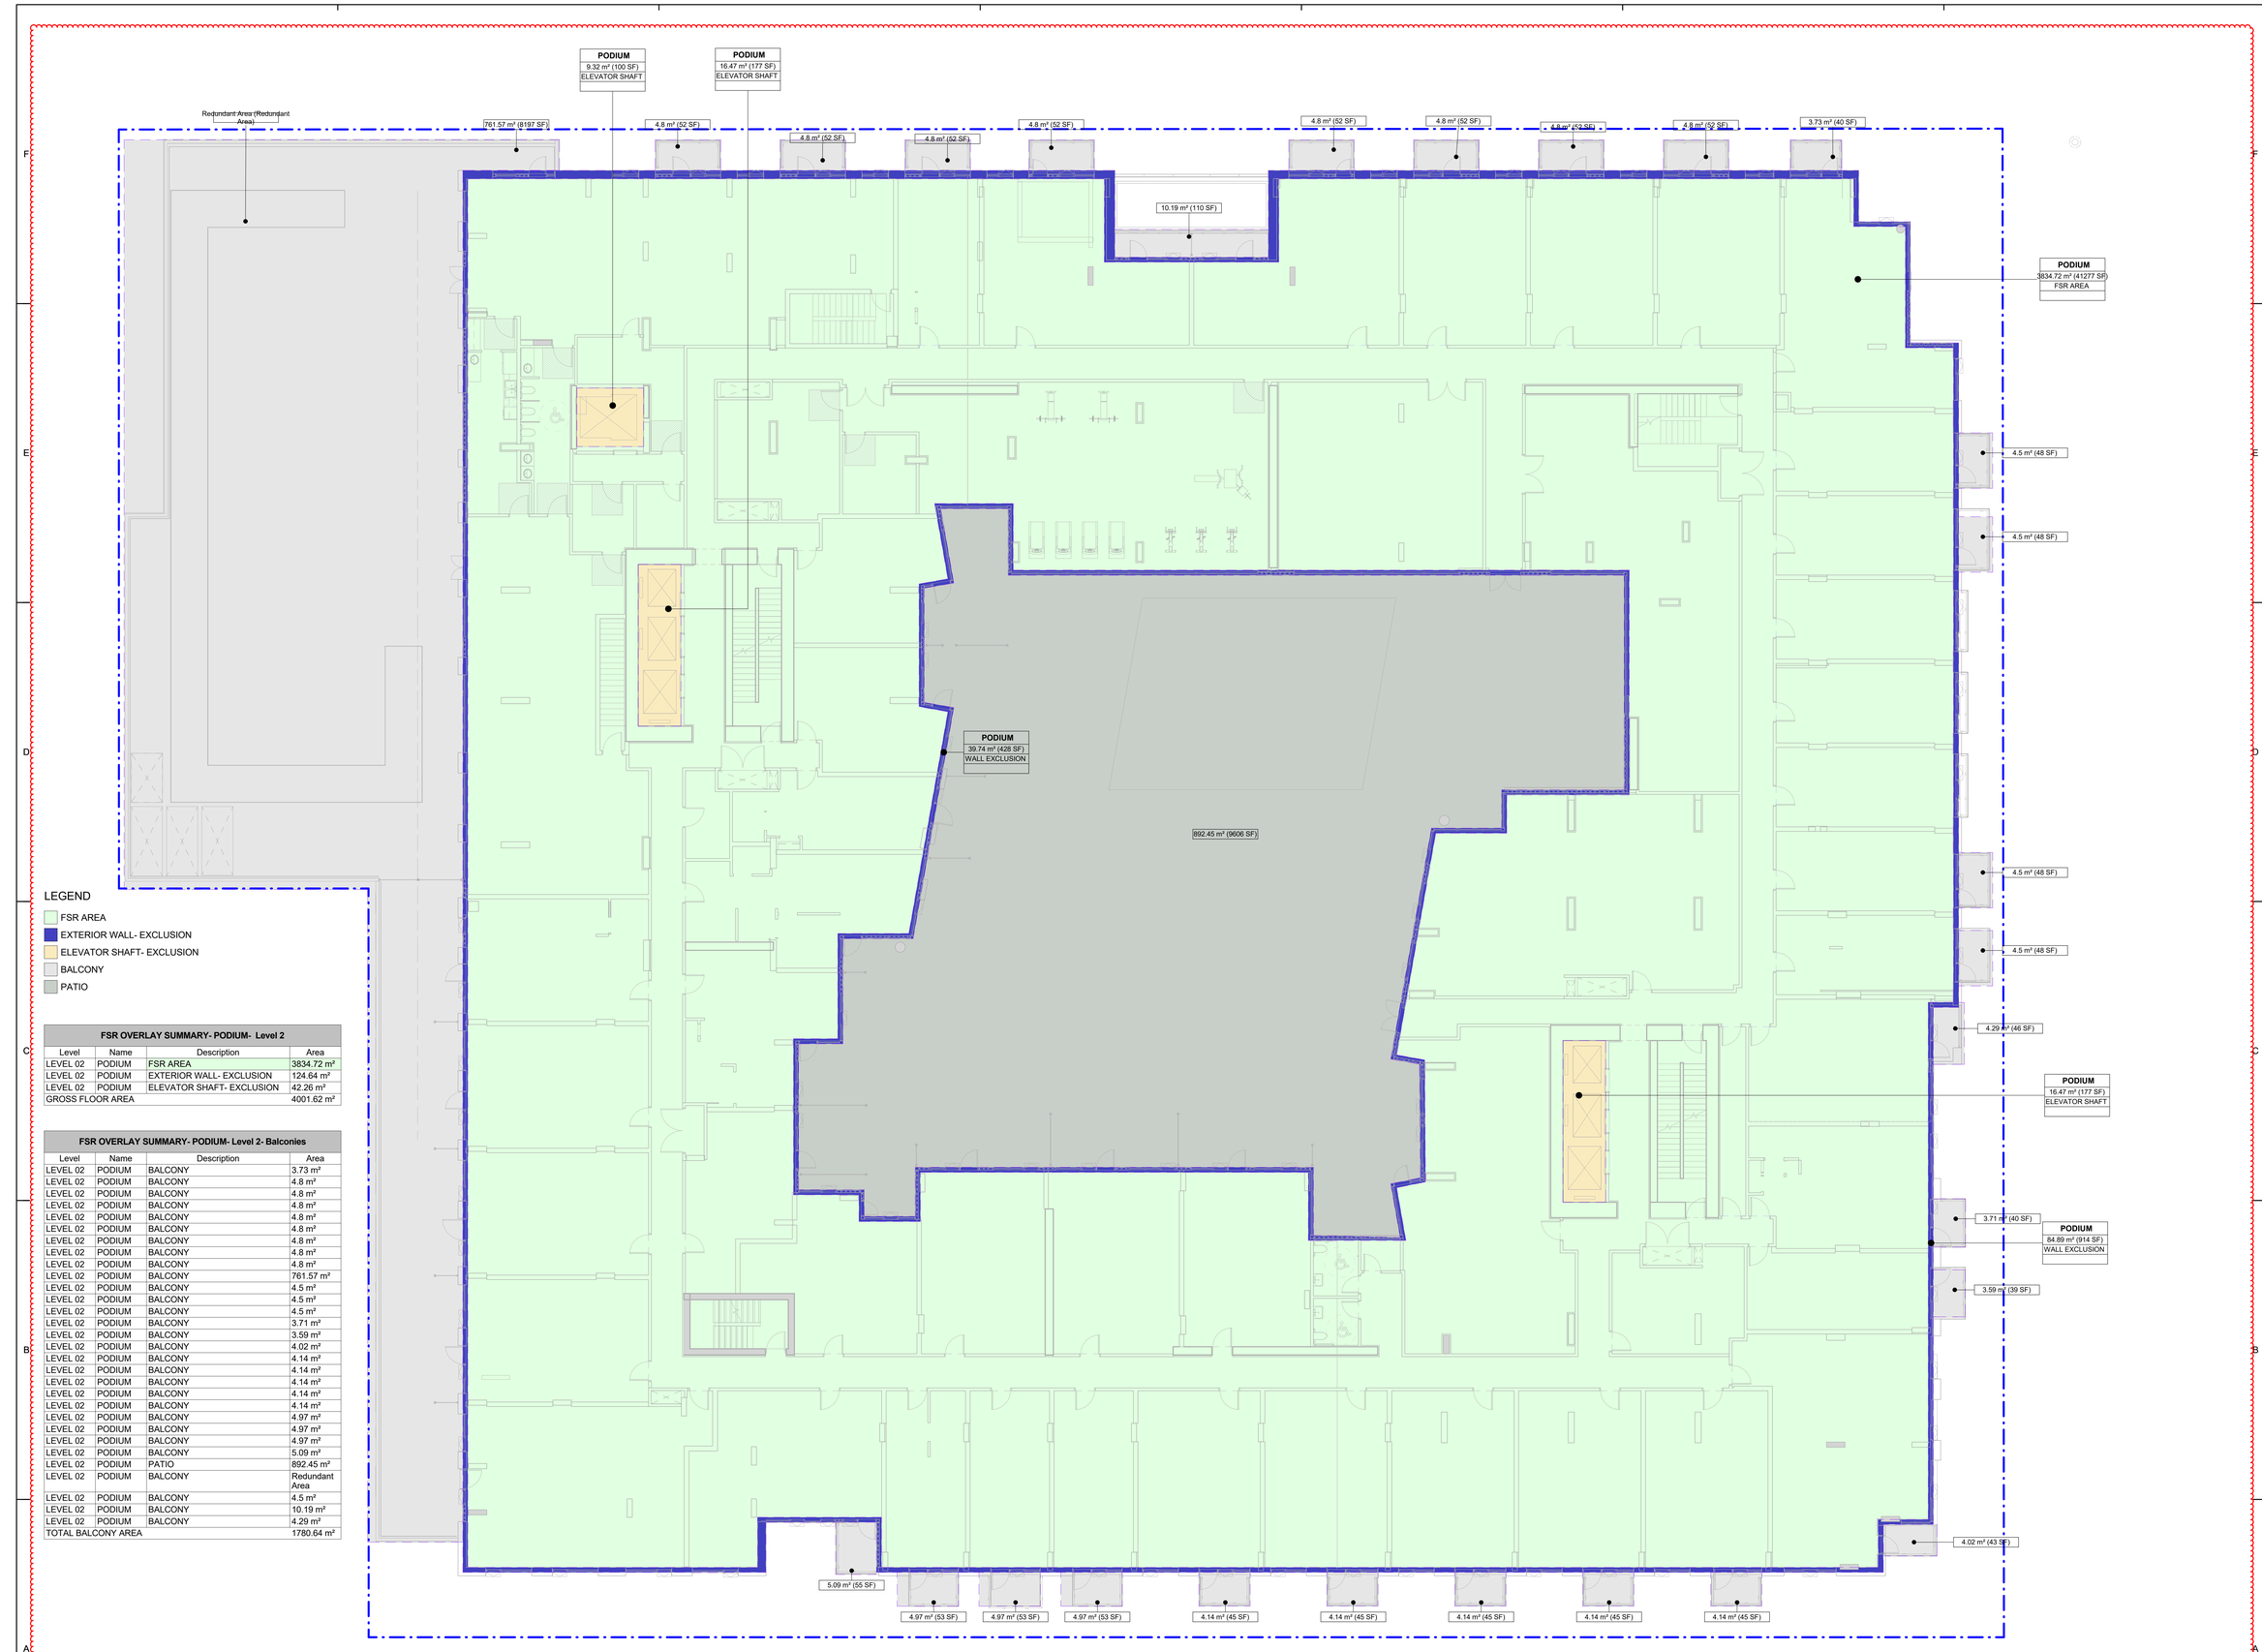

LEGEND

- FSR AREA
- EXTERIOR WALL- EXCLUSION
- ELEVATOR SHAFT- EXCLUSION
- BALCONY
- PATIO

FSR OVERLAY SUMMARY- PODIUM- Level 2

Level	Name	Description	Area
LEVEL 02	PODIUM	FSR AREA	3834.72 m²
LEVEL 02	PODIUM	EXTERIOR WALL- EXCLUSION	124.64 m²
LEVEL 02	PODIUM	ELEVATOR SHAFT- EXCLUSION	42.26 m²
GROSS FLOOR AREA			4001.62 m²

FSR OVERLAY SUMMARY- PODIUM- Level 2- Balconies

Level	Name	Description	Area
LEVEL 02	PODIUM	BALCONY	3.73 m²
LEVEL 02	PODIUM	BALCONY	4.8 m²
LEVEL 02	PODIUM	BALCONY	4.8 m²
LEVEL 02	PODIUM	BALCONY	4.8 m²
LEVEL 02	PODIUM	BALCONY	4.8 m²
LEVEL 02	PODIUM	BALCONY	4.8 m²
LEVEL 02	PODIUM	BALCONY	4.8 m²
LEVEL 02	PODIUM	BALCONY	4.8 m²
LEVEL 02	PODIUM	BALCONY	761.57 m²
LEVEL 02	PODIUM	BALCONY	4.5 m²
LEVEL 02	PODIUM	BALCONY	4.5 m²
LEVEL 02	PODIUM	BALCONY	4.5 m²
LEVEL 02	PODIUM	BALCONY	3.71 m²
LEVEL 02	PODIUM	BALCONY	3.59 m²
LEVEL 02	PODIUM	BALCONY	4.02 m²
LEVEL 02	PODIUM	BALCONY	4.14 m²
LEVEL 02	PODIUM	BALCONY	4.14 m²
LEVEL 02	PODIUM	BALCONY	4.14 m²
LEVEL 02	PODIUM	BALCONY	4.14 m²
LEVEL 02	PODIUM	BALCONY	4.14 m²
LEVEL 02	PODIUM	BALCONY	4.97 m²
LEVEL 02	PODIUM	BALCONY	4.97 m²
LEVEL 02	PODIUM	BALCONY	4.97 m²
LEVEL 02	PODIUM	BALCONY	5.09 m²
LEVEL 02	PODIUM	PATIO	892.45 m²
LEVEL 02	PODIUM	BALCONY	Redundant Area
LEVEL 02	PODIUM	BALCONY	4.5 m²
LEVEL 02	PODIUM	BALCONY	10.19 m²
LEVEL 02	PODIUM	BALCONY	4.29 m²
TOTAL BALCONY AREA			1780.64 m²

CLIENT

Starlight Developments

P.O. Box 1890 Station B Mississauga, Ontario, Canada L4Y 3W8

COPYRIGHT:
This drawing has been prepared solely for the intended use, thus any reproduction or distribution for any purpose other than authorized by IBI Group is forbidden. Written dimensions shall have precedence over scaled dimensions. Contractors shall verify and be responsible for all dimensions and conditions on the job, and IBI Group shall be informed of any variations from the dimensions and conditions shown on the drawing. Shop drawings shall be submitted to IBI Group for general conformance before proceeding with fabrication.
IBI Group Architects (Canada) Inc.
is a member of the IBI Group of companies

NO.	DATE	DESCRIPTION
1	YYYY-MM-DD	

ISSUES

NO.	DATE	DESCRIPTION

REVISIONS

PROJECT NORTH

N

Issued For: Project Status

Date: 2021-03-05

SEAL

REGISTERED ARCHITECT JOHN GWYN ARCHITECT PROVINCE OF BRITISH COLUMBIA

2021-03-05

SUB-CONSULTANT

PRIME CONSULTANT

IBI GROUP
ARCHITECTS (CANADA) INC.
700-1285 West Pender Street,
Vancouver, BC V6E 4B1, Canada
tel 604 683 8797 fax 604 683 0492
ibigroup.com

PROJECT TITLE

Harris Green Village Phase 01

1045 Yates Street
Victoria, BC

PROJECT NO:	121123
DRAWN BY:	Author
CHK'D BY:	Checker
SCALE:	1 : 100
DATE:	2021-03-05

SHEET TITLE

FSR OVERLAY- Level 02

SHEET NUMBER

A7.03

REV

Last Saved: 2021-03-05 10:29:14 PM File Location: BIM 360:121123 - Yates Street - Harris Green Village Ph 1 (02020)121123_YatesSt-A-Podium-2020.rvt

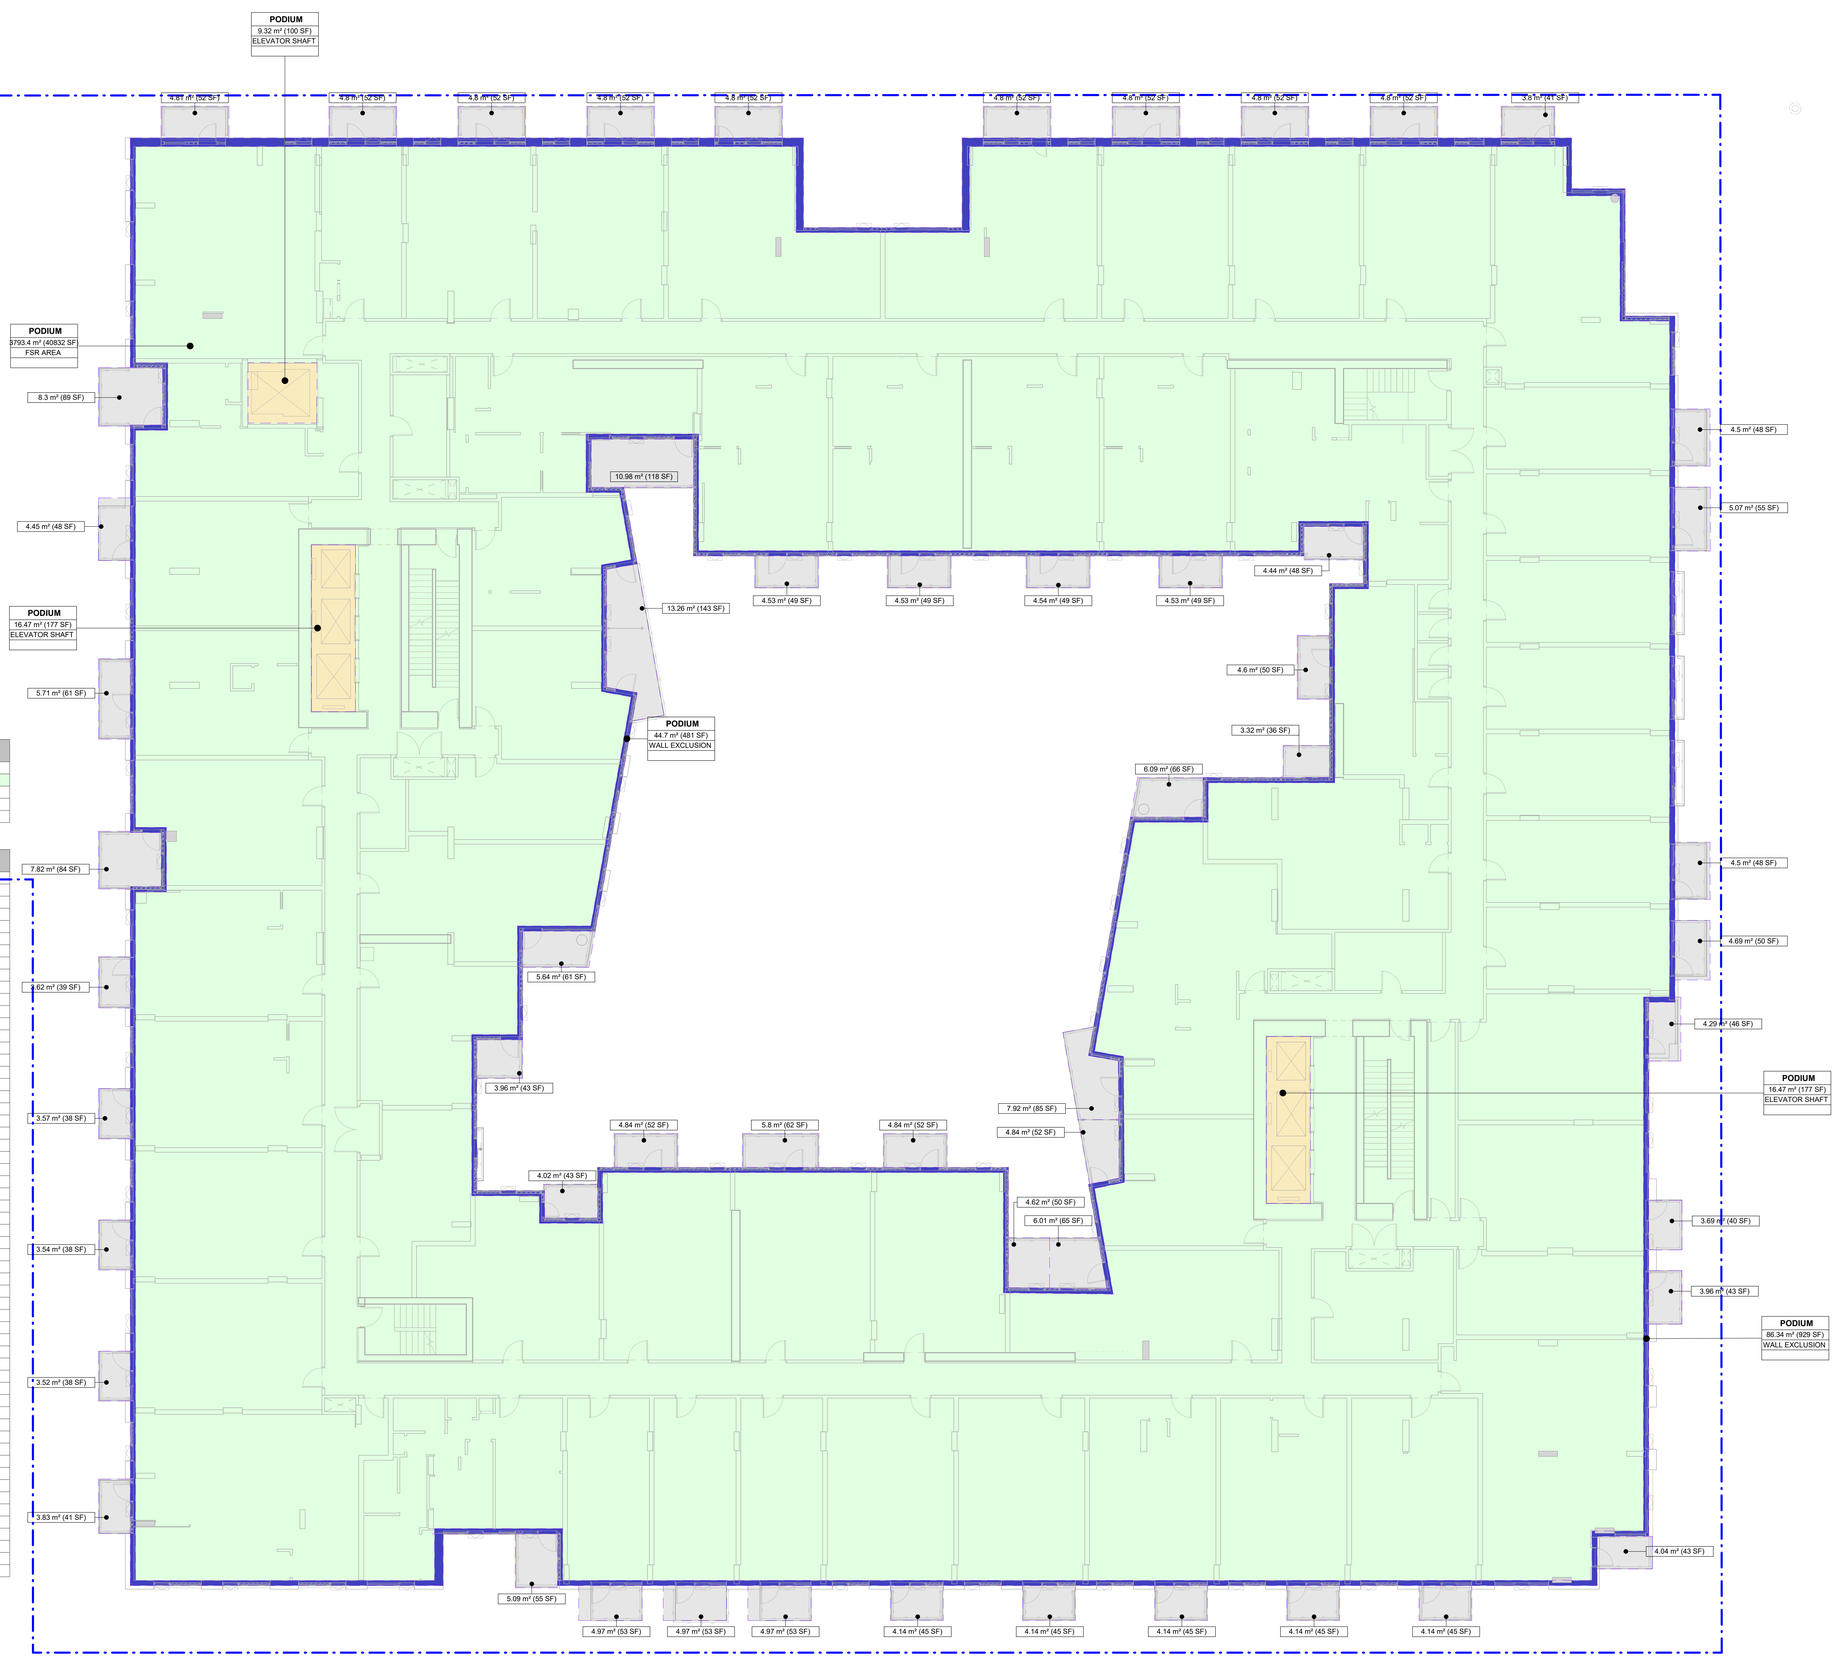

LEGEND

- FSR AREA
- EXTERIOR WALL- EXCLUSION
- ELEVATOR SHAFT- EXCLUSION
- BALCONY

FSR OVERLAY SUMMARY- PODIUM- Level 3

Level	Name	Description	Area
LEVEL 03	PODIUM	FSR AREA	3793.4 m²
LEVEL 03	PODIUM	EXTERIOR WALL- EXCLUSION	131.03 m²
LEVEL 03	PODIUM	ELEVATOR SHAFT- EXCLUSION	42.26 m²
GROSS FLOOR AREA			3966.7 m²

FSR OVERLAY SUMMARY- PODIUM- Level 3- Balconies

Level	Name	Description	Area
LEVEL 03	PODIUM	BALCONY	4.44 m²
LEVEL 03	PODIUM	BALCONY	4.53 m²
LEVEL 03	PODIUM	BALCONY	4.54 m²
LEVEL 03	PODIUM	BALCONY	4.53 m²
LEVEL 03	PODIUM	BALCONY	4.53 m²
LEVEL 03	PODIUM	BALCONY	10.98 m²
LEVEL 03	PODIUM	BALCONY	13.26 m²
LEVEL 03	PODIUM	BALCONY	5.64 m²
LEVEL 03	PODIUM	BALCONY	3.96 m²
LEVEL 03	PODIUM	BALCONY	3.57 m²
LEVEL 03	PODIUM	BALCONY	7.82 m²
LEVEL 03	PODIUM	BALCONY	5.71 m²
LEVEL 03	PODIUM	BALCONY	4.45 m²
LEVEL 03	PODIUM	BALCONY	8.3 m²
LEVEL 03	PODIUM	BALCONY	3.8 m²
LEVEL 03	PODIUM	BALCONY	4.8 m²
LEVEL 03	PODIUM	BALCONY	4.8 m²
LEVEL 03	PODIUM	BALCONY	4.8 m²
LEVEL 03	PODIUM	BALCONY	4.8 m²
LEVEL 03	PODIUM	BALCONY	4.8 m²
LEVEL 03	PODIUM	BALCONY	4.8 m²
LEVEL 03	PODIUM	BALCONY	4.8 m²
LEVEL 03	PODIUM	BALCONY	4.8 m²
LEVEL 03	PODIUM	BALCONY	4.81 m²
LEVEL 03	PODIUM	BALCONY	4.5 m²
LEVEL 03	PODIUM	BALCONY	5.07 m²
LEVEL 03	PODIUM	BALCONY	4.5 m²
LEVEL 03	PODIUM	BALCONY	3.69 m²
LEVEL 03	PODIUM	BALCONY	3.96 m²
LEVEL 03	PODIUM	BALCONY	4.04 m²
LEVEL 03	PODIUM	BALCONY	4.14 m²
LEVEL 03	PODIUM	BALCONY	4.14 m²
LEVEL 03	PODIUM	BALCONY	4.14 m²
LEVEL 03	PODIUM	BALCONY	4.14 m²
LEVEL 03	PODIUM	BALCONY	4.97 m²
LEVEL 03	PODIUM	BALCONY	4.97 m²
LEVEL 03	PODIUM	BALCONY	4.97 m²
LEVEL 03	PODIUM	BALCONY	5.09 m²
LEVEL 03	PODIUM	BALCONY	3.54 m²
LEVEL 03	PODIUM	BALCONY	3.52 m²
LEVEL 03	PODIUM	BALCONY	3.83 m²
LEVEL 03	PODIUM	BALCONY	6.09 m²
LEVEL 03	PODIUM	BALCONY	4.84 m²
LEVEL 03	PODIUM	BALCONY	5.8 m²
LEVEL 03	PODIUM	BALCONY	4.84 m²
LEVEL 03	PODIUM	BALCONY	4.02 m²
LEVEL 03	PODIUM	BALCONY	4.6 m²
LEVEL 03	PODIUM	BALCONY	7.92 m²
LEVEL 03	PODIUM	BALCONY	4.84 m²
LEVEL 03	PODIUM	BALCONY	6.01 m²
LEVEL 03	PODIUM	BALCONY	4.62 m²
LEVEL 03	PODIUM	BALCONY	4.69 m²
LEVEL 03	PODIUM	BALCONY	3.32 m²
LEVEL 03	PODIUM	BALCONY	3.62 m²
LEVEL 03	PODIUM	BALCONY	4.29 m²
TOTAL BALCONY AREA			280.1 m²

CLIENT

Starlight Developments

Starlight Developments
P.O. Box 1690 Station B Mississauga, Ontario, Canada
L4Y 3W8

COPYRIGHT:
This drawing has been prepared solely for the intended use, thus any reproduction or distribution for any purpose other than authorized by IBI Group is forbidden. Written dimensions shall have precedence over scaled dimensions. Contractors shall verify and be responsible for all dimensions and conditions on the job, and IBI Group shall be informed of any variations from the dimensions and conditions shown on the drawing. Shop drawings shall be submitted to IBI Group for general conformance before proceeding with fabrication.
IBI Group Architects (Canada) Inc.
is a member of the IBI Group of companies

NO.	DATE	DESCRIPTION
1	YYYY-MM-DD	

ISSUES

NO.	DATE	DESCRIPTION

REVISIONS

PROJECT NORTH
N

Issued For: Project Status
Date: 2021-03-05

SEAL

REGISTERED ARCHITECT JOHN GWYN HOOK BRITISH COLUMBIA
2021-03-06

SUB-CONSULTANT

PRIME CONSULTANT

IBI GROUP
ARCHITECTS (CANADA) INC.
700-1285 West Pender Street,
Vancouver, BC V6E 4B1, Canada
tel 604 683 8797 fax 604 683 0492
ibigroup.com

PROJECT TITLE
Harris Green Village
Phase 01
1045 Yates Street
Victoria, BC

PROJECT NO:	121123
DRAWN BY:	Author
CHK'D BY:	Checker
SCALE:	1 : 100
DATE:	2021-03-05

SHEET TITLE
FSR OVERLAY- Level 03

SHEET NUMBER
A7.04

REV

Last Saved: 2021-03-05 10:29:23 PM File Location: IBM 360 /121123 - Yates Street – Harris Green Village Ph 1/2020/121123_YatesStA-Podium2020.rvt

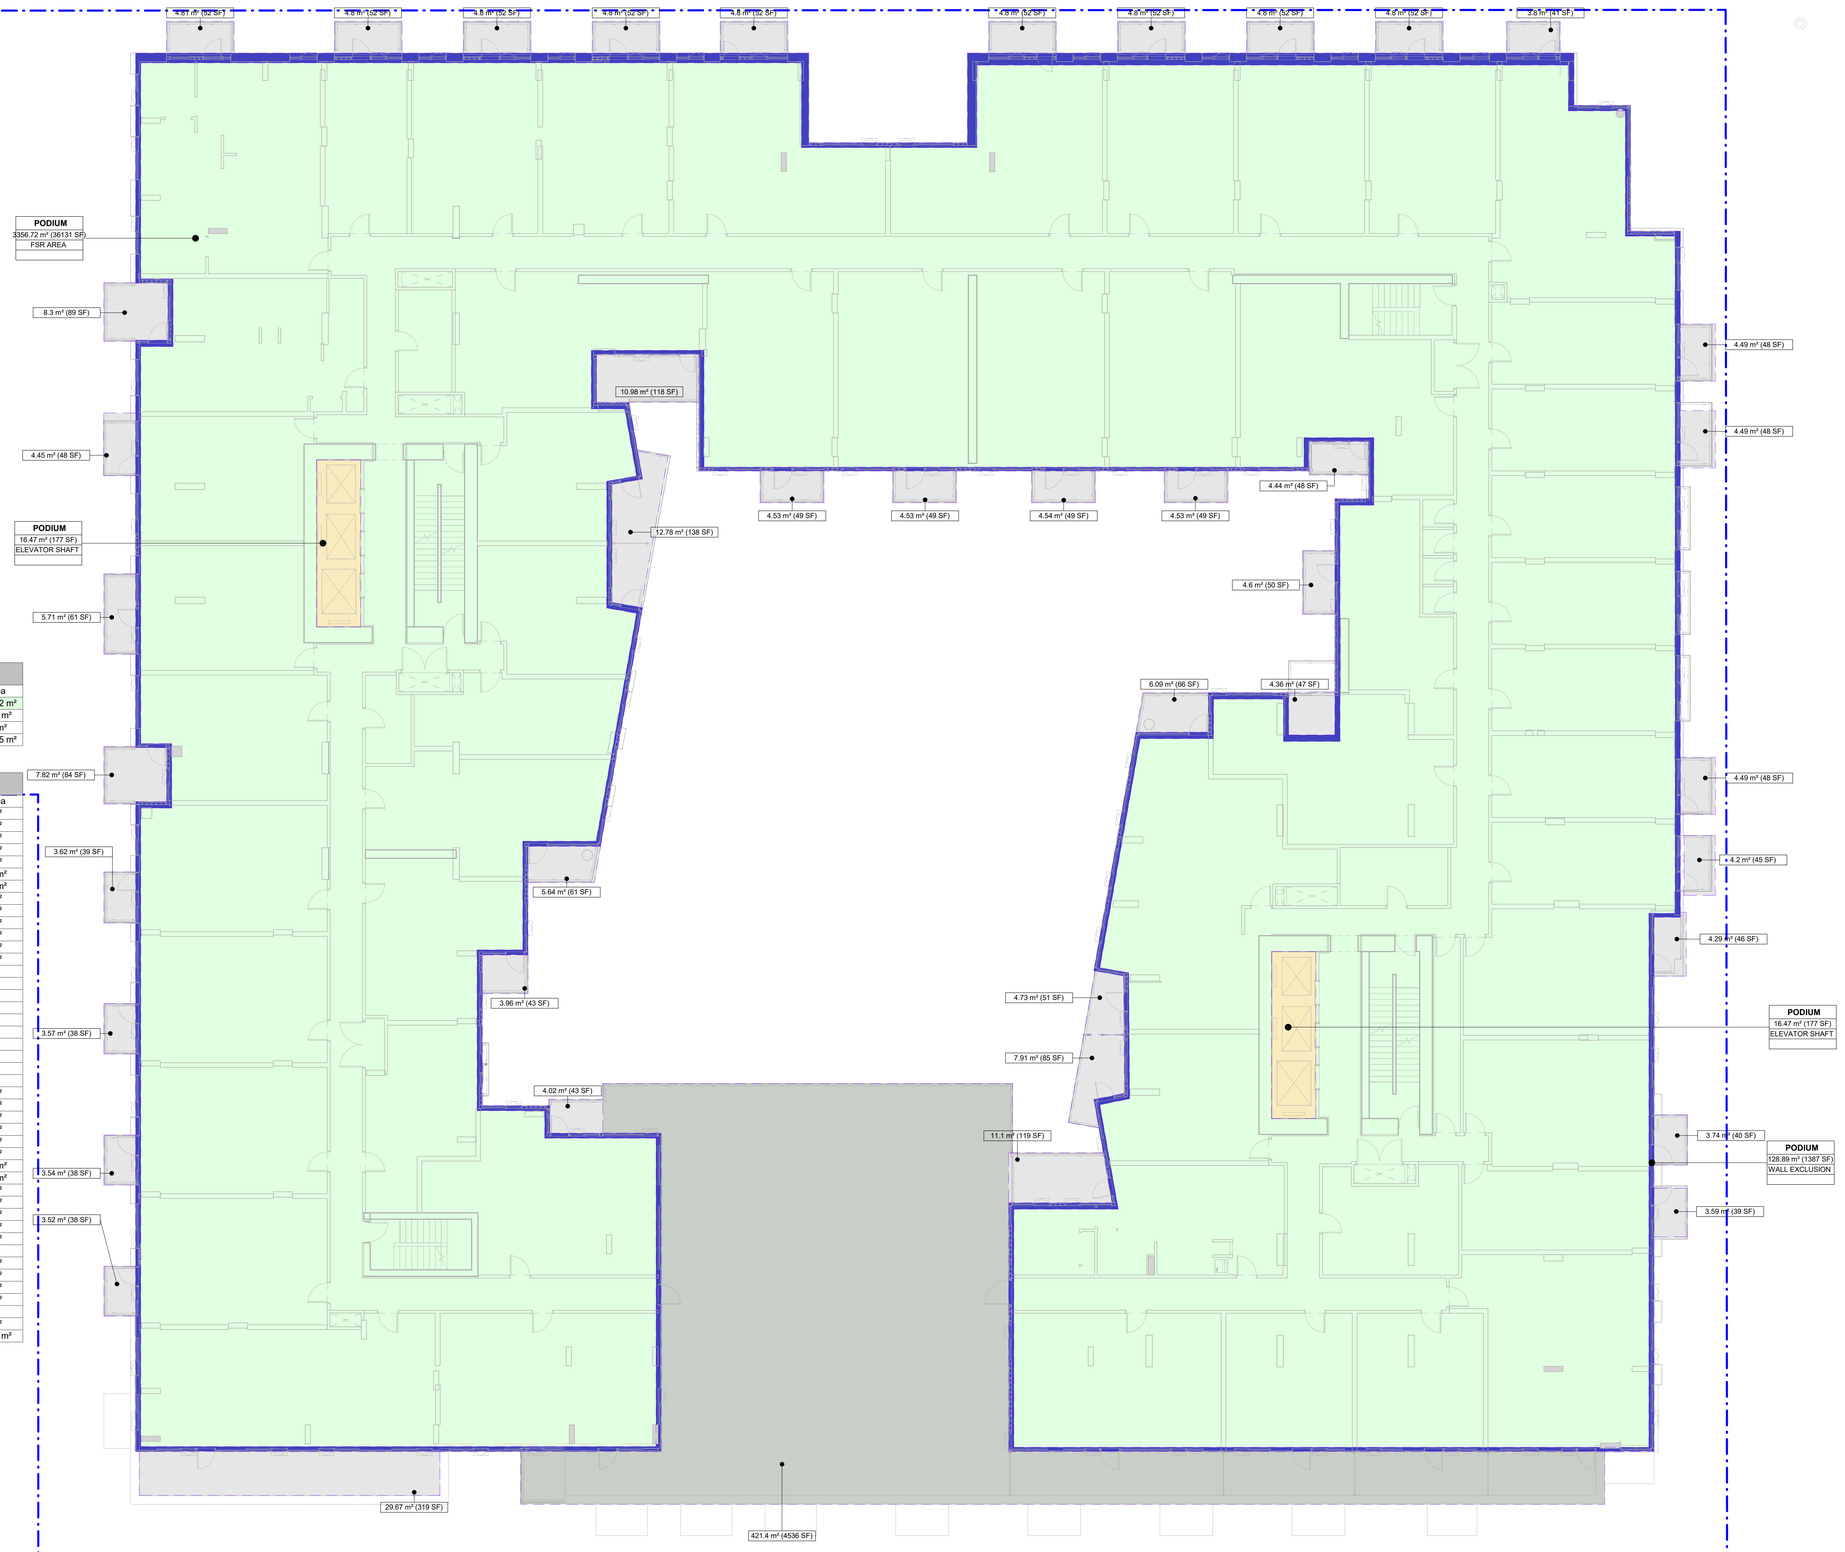

LEGEND

- FSR AREA
- EXTERIOR WALL- EXCLUSION
- ELEVATOR SHAFT- EXCLUSION
- BALCONY
- PATIO

FSR OVERLAY SUMMARY- PODIUM- Level 4

Level	Name	Description	Area
LEVEL 04	PODIUM	FSR AREA	3356.72 m²
LEVEL 04	PODIUM	EXTERIOR WALL- EXCLUSION	128.89 m²
LEVEL 04	PODIUM	ELEVATOR SHAFT- EXCLUSION	32.94 m²
GROSS FLOOR AREA			3518.55 m²

FSR OVERLAY SUMMARY- PODIUM- Level 4- Balconies

Level	Name	Description	Area
LEVEL 04	PODIUM	BALCONY	4.44 m²
LEVEL 04	PODIUM	BALCONY	4.53 m²
LEVEL 04	PODIUM	BALCONY	4.54 m²
LEVEL 04	PODIUM	BALCONY	4.53 m²
LEVEL 04	PODIUM	BALCONY	4.53 m²
LEVEL 04	PODIUM	BALCONY	10.98 m²
LEVEL 04	PODIUM	BALCONY	12.78 m²
LEVEL 04	PODIUM	BALCONY	5.64 m²
LEVEL 04	PODIUM	BALCONY	3.96 m²
LEVEL 04	PODIUM	BALCONY	3.57 m²
LEVEL 04	PODIUM	BALCONY	7.82 m²
LEVEL 04	PODIUM	BALCONY	5.71 m²
LEVEL 04	PODIUM	BALCONY	4.45 m²
LEVEL 04	PODIUM	BALCONY	8.3 m²
LEVEL 04	PODIUM	BALCONY	3.8 m²
LEVEL 04	PODIUM	BALCONY	4.8 m²
LEVEL 04	PODIUM	BALCONY	4.8 m²
LEVEL 04	PODIUM	BALCONY	4.8 m²
LEVEL 04	PODIUM	BALCONY	4.8 m²
LEVEL 04	PODIUM	BALCONY	4.8 m²
LEVEL 04	PODIUM	BALCONY	4.8 m²
LEVEL 04	PODIUM	BALCONY	4.8 m²
LEVEL 04	PODIUM	BALCONY	4.81 m²
LEVEL 04	PODIUM	BALCONY	4.49 m²
LEVEL 04	PODIUM	BALCONY	4.49 m²
LEVEL 04	PODIUM	BALCONY	4.49 m²
LEVEL 04	PODIUM	BALCONY	3.74 m²
LEVEL 04	PODIUM	BALCONY	3.59 m²
LEVEL 04	PODIUM	PATIO	421.4 m²
LEVEL 04	PODIUM	BALCONY	29.67 m²
LEVEL 04	PODIUM	BALCONY	3.54 m²
LEVEL 04	PODIUM	BALCONY	3.52 m²
LEVEL 04	PODIUM	BALCONY	6.09 m²
LEVEL 04	PODIUM	BALCONY	4.36 m²
LEVEL 04	PODIUM	BALCONY	4.02 m²
LEVEL 04	PODIUM	BALCONY	4.6 m²
LEVEL 04	PODIUM	BALCONY	4.73 m²
LEVEL 04	PODIUM	BALCONY	7.91 m²
LEVEL 04	PODIUM	BALCONY	11.1 m²
LEVEL 04	PODIUM	BALCONY	3.62 m²
LEVEL 04	PODIUM	BALCONY	4.2 m²
LEVEL 04	PODIUM	BALCONY	4.29 m²
TOTAL BALCONY AREA			666.64 m²

CLIENT

Starlight Developments

Starlight Developments
P.O. Box 1690 Station B Mississauga, Ontario, Canada
L4Y 3W8

COPYRIGHT:
This drawing has been prepared solely for the intended use, thus any reproduction or distribution for any purpose other than authorized by IBI Group is forbidden. Written dimensions shall have precedence over scaled dimensions. Contractors shall verify and be responsible for all dimensions and conditions on the job, and IBI Group shall be informed of any variations from the dimensions and conditions shown on the drawing. Shop drawings shall be submitted to IBI Group for general conformance before proceeding with fabrication.
IBI Group Architects (Canada) Inc.
is a member of the IBI Group of companies

NO.	DATE	DESCRIPTION
1	YYYY-MM-DD	

ISSUES

NO.	DATE	DESCRIPTION

REVISIONS

PROJECT NORTH
N

Issued For: Project Status
Date: 2021-03-05

SEAL

REGISTERED ARCHITECT JOHN GWYN BRITISH COLUMBIA
2021-03-06

SUB-CONSULTANT

PRIME CONSULTANT

IBI GROUP
ARCHITECTS (CANADA) INC.
700-1285 West Pender Street,
Vancouver, BC V6E 4B1, Canada
tel 604 683 8797 fax 604 683 0492
ibigroup.com

PROJECT TITLE
Harris Green Village
Phase 01
1045 Yates Street
Victoria, BC

PROJECT NO:	121123
DRAWN BY:	Author
CHK'D BY:	Checker
SCALE:	1 : 100
DATE:	2021-03-05

SHEET TITLE
FSR OVERLAY- Level 04

SHEET NUMBER
A7.05

REV

Last Saved: 2021-03-05 10:29:32 PM File Location: B:\M-Projects\121123_Yates\Bulk\Phase 01\Harris Green Village Ph 1 P2\2020\121123_YatesBulk-Podium-2020.rvt

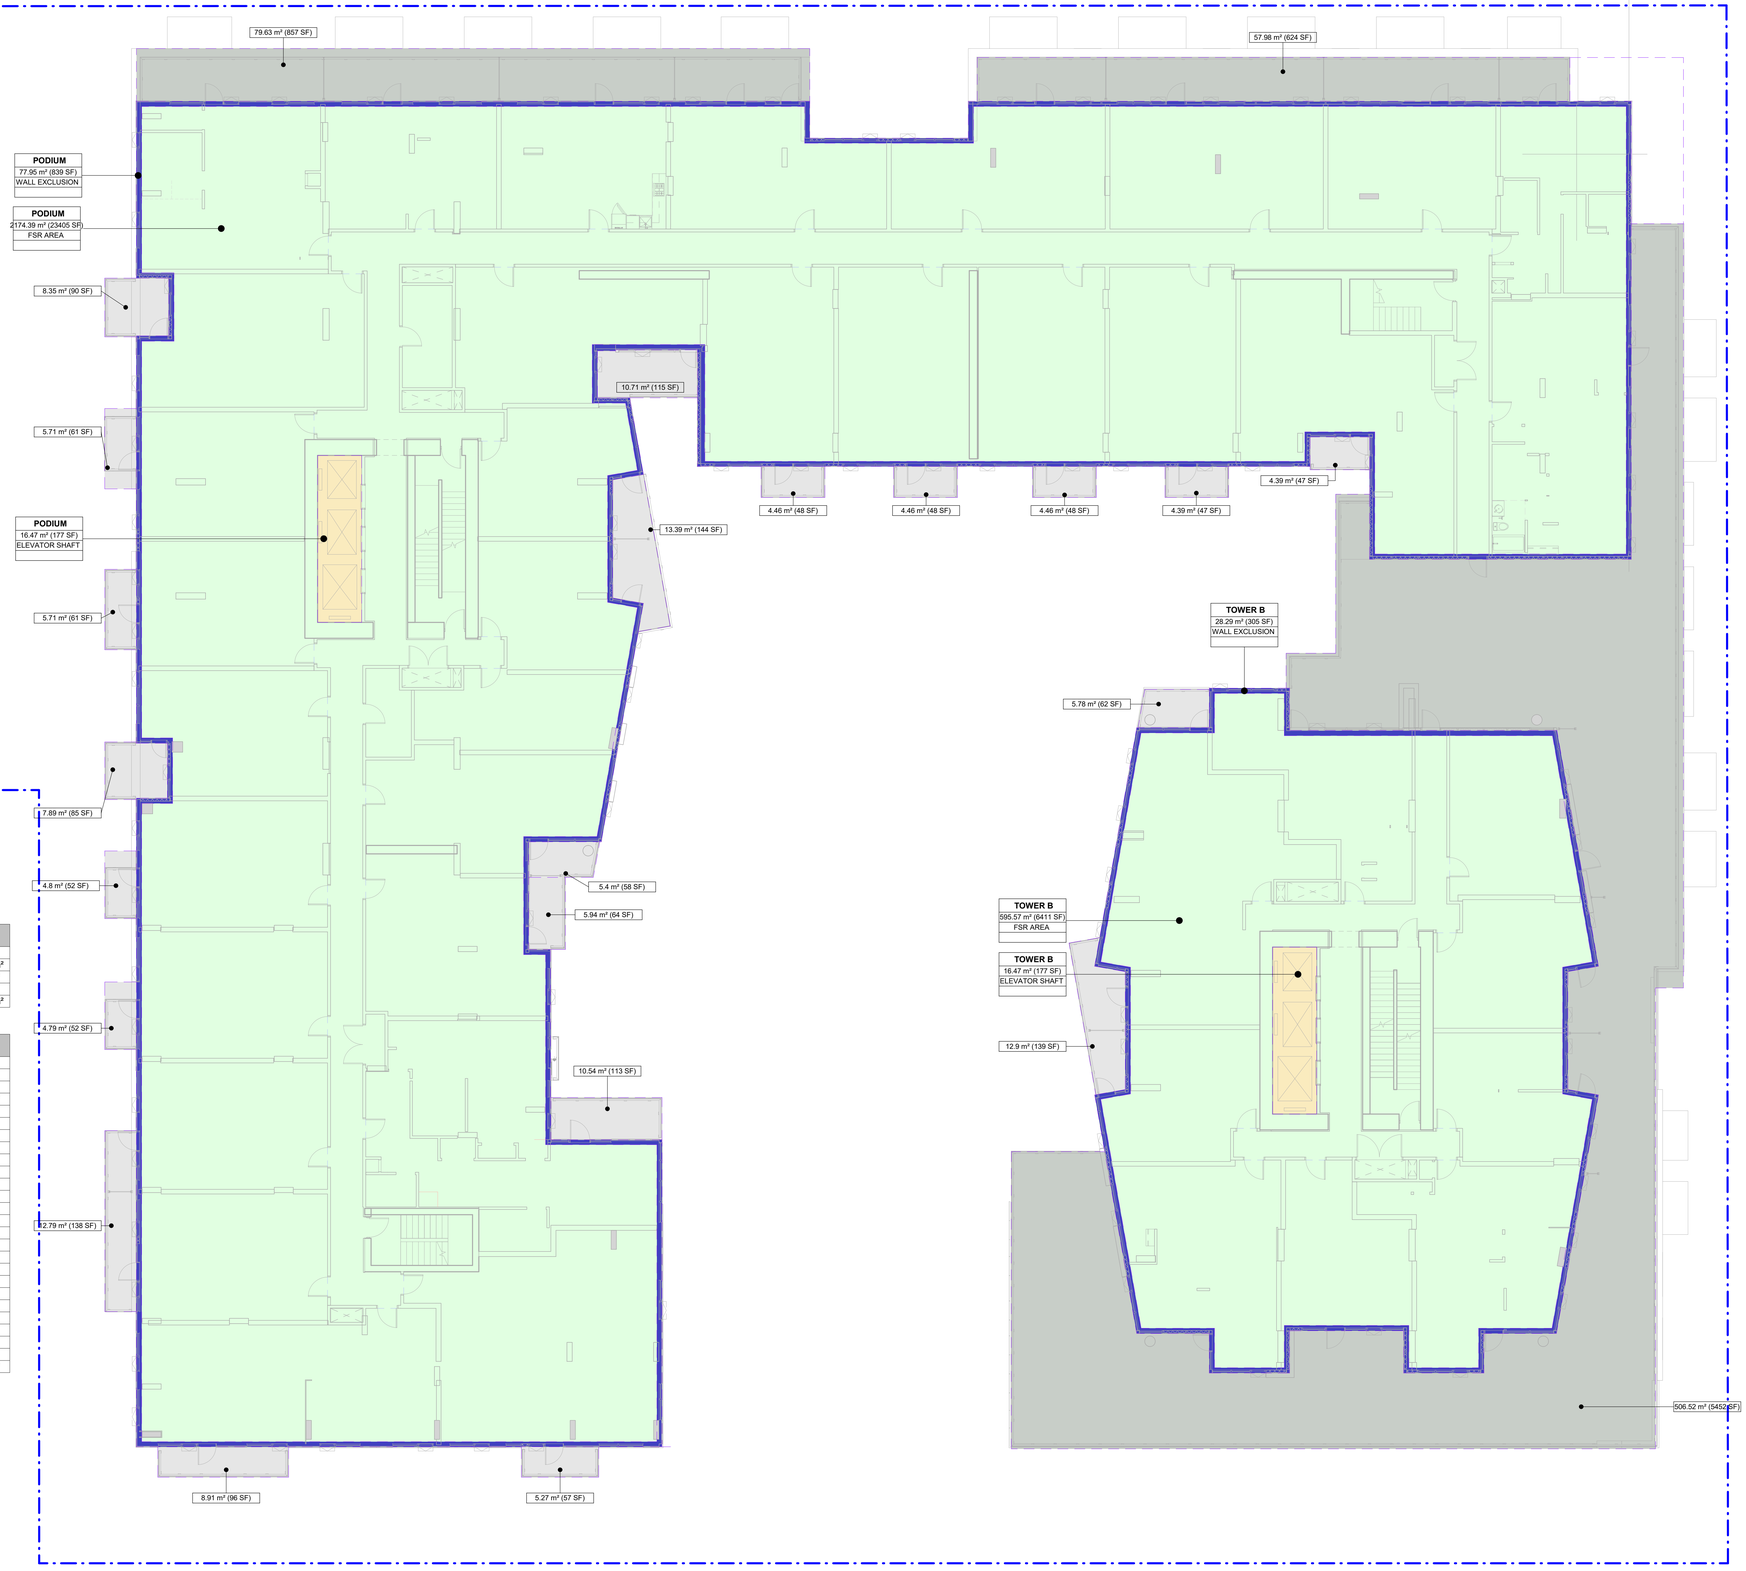

LEGEND

- FSR AREA
- EXTERIOR WALL- EXCLUSION
- ELEVATOR SHAFT- EXCLUSION
- BALCONY
- PATIO

FSR OVERLAY SUMMARY- PODIUM- Level 5

Level	Name	Description	Area
LEVEL 05		FSR AREA	2769.96 m²
LEVEL 05		EXTERIOR WALL- EXCLUSION	106.23 m²
LEVEL 05		ELEVATOR SHAFT- EXCLUSION	32.94 m²
GROSS FLOOR AREA			2909.14 m²

FSR OVERLAY SUMMARY- PODIUM- Level 5- Balconies

Level	Name	Description	Area
LEVEL 05	PODIUM	BALCONY	12.9 m²
LEVEL 05	PODIUM	BALCONY	5.78 m²
LEVEL 05	PODIUM	PATIO	506.52 m²
LEVEL 05	PODIUM	PATIO	79.63 m²
LEVEL 05	PODIUM	BALCONY	4.39 m²
LEVEL 05	PODIUM	BALCONY	4.39 m²
LEVEL 05	PODIUM	BALCONY	4.46 m²
LEVEL 05	PODIUM	BALCONY	4.46 m²
LEVEL 05	PODIUM	BALCONY	4.46 m²
LEVEL 05	PODIUM	BALCONY	10.71 m²
LEVEL 05	PODIUM	BALCONY	13.39 m²
LEVEL 05	PODIUM	BALCONY	5.4 m²
LEVEL 05	PODIUM	BALCONY	4.79 m²
LEVEL 05	PODIUM	BALCONY	7.89 m²
LEVEL 05	PODIUM	BALCONY	5.71 m²
LEVEL 05	PODIUM	BALCONY	5.71 m²
LEVEL 05	PODIUM	BALCONY	8.35 m²
LEVEL 05	PODIUM	BALCONY	12.79 m²
LEVEL 05	PODIUM	BALCONY	10.54 m²
LEVEL 05	PODIUM	BALCONY	5.94 m²
LEVEL 05	PODIUM	BALCONY	8.91 m²
LEVEL 05	PODIUM	BALCONY	5.27 m²
LEVEL 05	PODIUM	BALCONY	4.8 m²
LEVEL 05	PODIUM	PATIO	57.98 m²
TOTAL BALCONY AREA			795.17 m²

CLIENT

Starlight Developments

Starlight Developments
P.O. Box 1690 Station B Mississauga, Ontario, Canada
L4Y 3W8

COPYRIGHT:
This drawing has been prepared solely for the intended use, thus any reproduction or distribution for any purpose other than authorized by IBI Group is forbidden. Written dimensions shall have precedence over scaled dimensions. Contractors shall verify and be responsible for all dimensions and conditions on the job, and IBI Group shall be informed of any variations from the dimensions and conditions shown on the drawing. Shop drawings shall be submitted to IBI Group for general conformance before proceeding with fabrication.
IBI Group Architects (Canada) Inc.
is a member of the IBI Group of companies

NO.	DATE	DESCRIPTION
1	YYYY-MM-DD	

ISSUES

NO.	DATE	DESCRIPTION

REVISIONS

PROJECT NORTH
N

Issued For: Project Status
Date: 2021-03-05

SEAL

REGISTERED ARCHITECT JOHN GWYN HOLE BRITISH COLUMBIA
2021-03-06

SUB-CONSULTANT

PRIME CONSULTANT

IBI GROUP
ARCHITECTS (CANADA) INC.
700-1285 West Pender Street,
Vancouver, BC V6E 4B1, Canada
tel 604 683 8797 fax 604 683 0492
ibigroup.com

PROJECT TITLE
Harris Green Village
Phase 01
1045 Yates Street
Victoria, BC

PROJECT NO:	121123
DRAWN BY:	Author
CHK'D BY:	Checker
SCALE:	1 : 100
DATE:	2021-03-05

SHEET TITLE
FSR OVERLAY- Level 05

SHEET NUMBER
A7.06

REV

Last Saved: 2021-03-05 10:29:40 PM File Location: BIM 360://121123 - Yates Street – Harris Green Village Ph 1\20200121123_YatesStSvA-Podium-2020.rvt

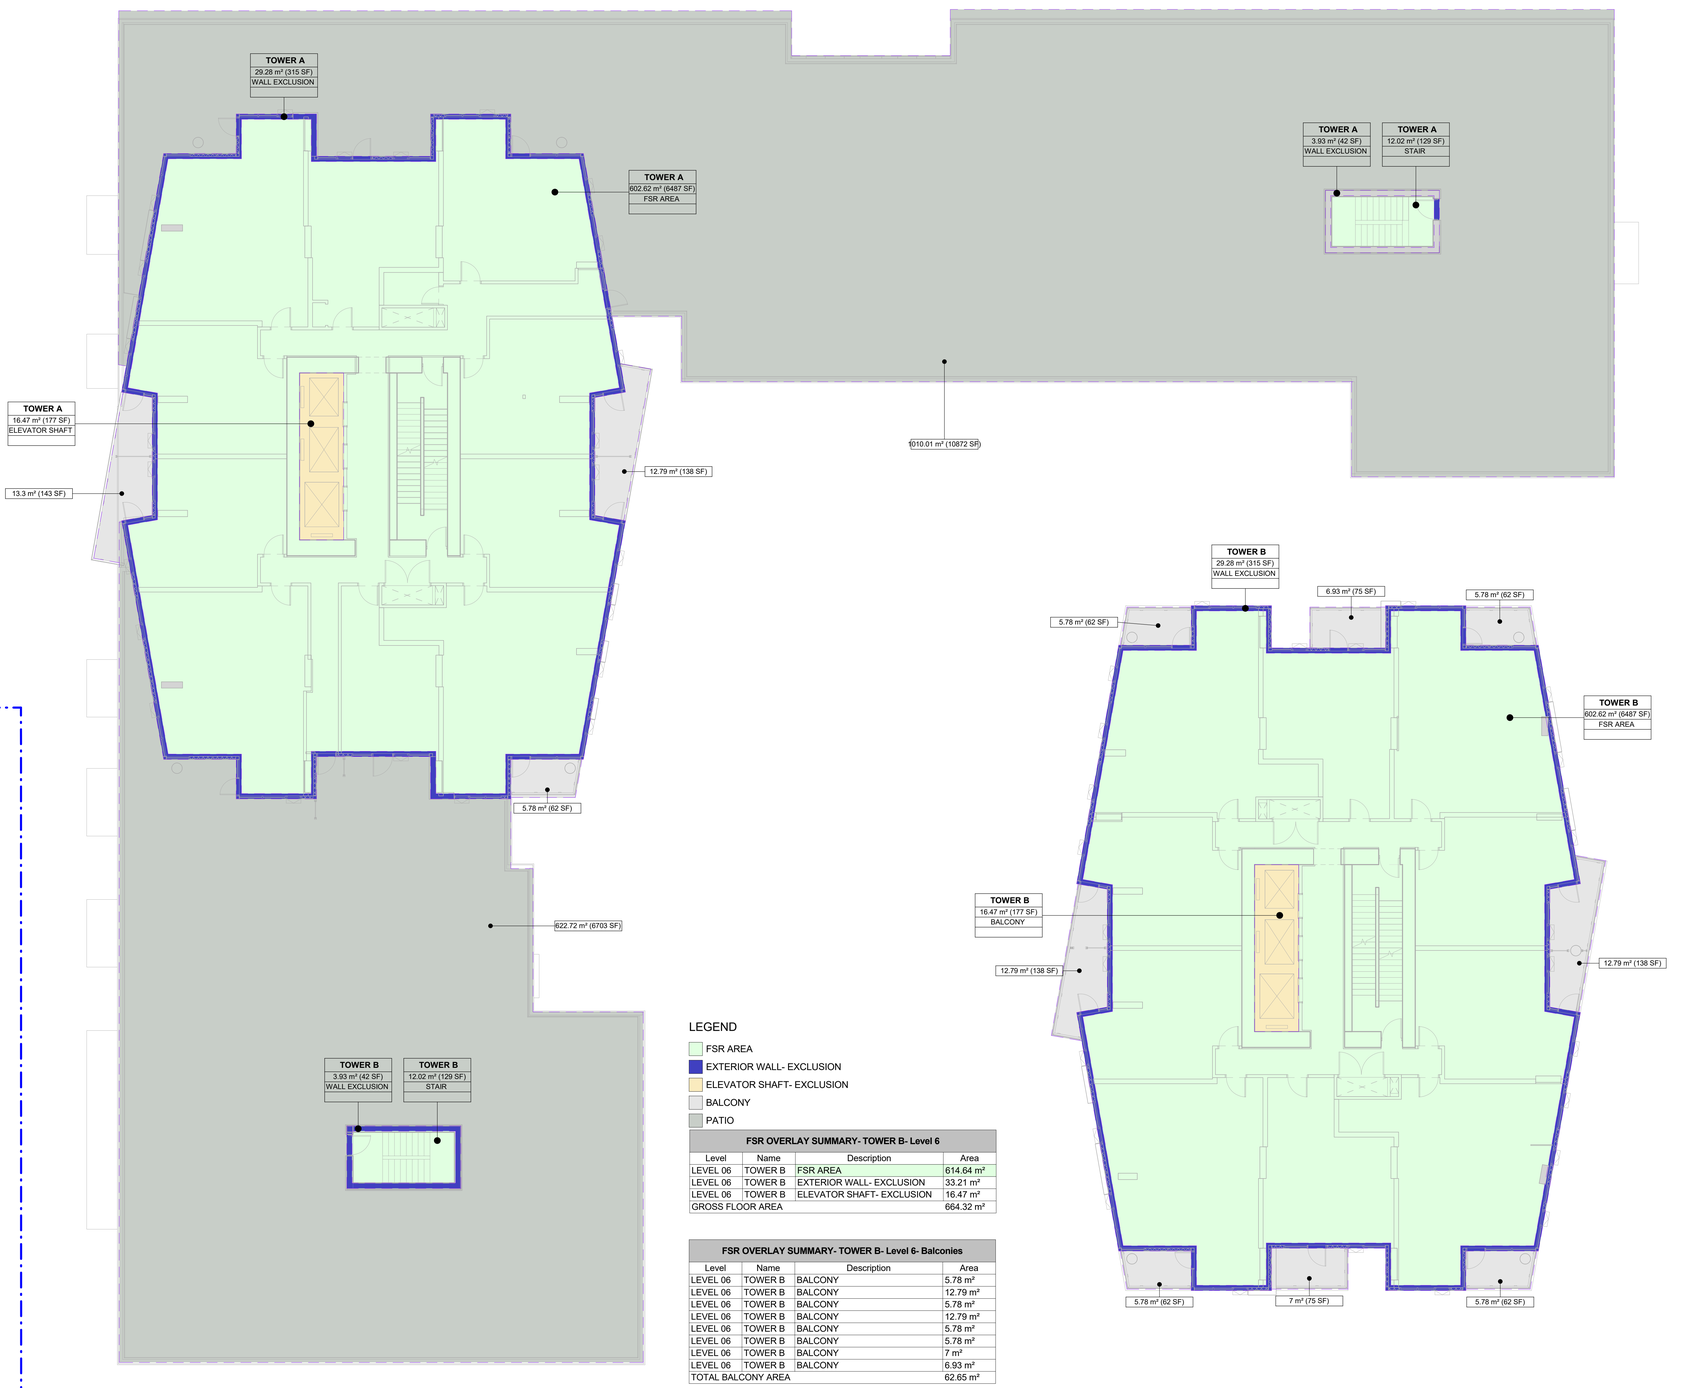

LEGEND

- FSR AREA
- EXTERIOR WALL- EXCLUSION
- ELEVATOR SHAFT- EXCLUSION
- BALCONY
- PATIO

FSR OVERLAY SUMMARY- TOWER A- Level 6

Level	Name	Description	Area
LEVEL 06	TOWER A	PATIO	1632.73 m²
LEVEL 06	TOWER A	FSR AREA	614.64 m²
LEVEL 06	TOWER A	EXTERIOR WALL- EXCLUSION	33.21 m²
LEVEL 06	TOWER A	ELEVATOR SHAFT- EXCLUSION	16.47 m²
GROSS FLOOR AREA			2297.06 m²

FSR OVERLAY SUMMARY- TOWER A- Level 6- Balconies

Level	Name	Description	Area
LEVEL 06	TOWER A	BALCONY	13.3 m²
LEVEL 06	TOWER A	BALCONY	12.79 m²
LEVEL 06	TOWER A	BALCONY	5.78 m²
TOTAL BALCONY AREA			31.87 m²

LEGEND

- FSR AREA
- EXTERIOR WALL- EXCLUSION
- ELEVATOR SHAFT- EXCLUSION
- BALCONY
- PATIO

FSR OVERLAY SUMMARY- TOWER B- Level 6

Level	Name	Description	Area
LEVEL 06	TOWER B	FSR AREA	614.64 m²
LEVEL 06	TOWER B	EXTERIOR WALL- EXCLUSION	33.21 m²
LEVEL 06	TOWER B	ELEVATOR SHAFT- EXCLUSION	16.47 m²
GROSS FLOOR AREA			664.32 m²

FSR OVERLAY SUMMARY- TOWER B- Level 6- Balconies

Level	Name	Description	Area
LEVEL 06	TOWER B	BALCONY	5.78 m²
LEVEL 06	TOWER B	BALCONY	12.79 m²
LEVEL 06	TOWER B	BALCONY	5.78 m²
LEVEL 06	TOWER B	BALCONY	12.79 m²
LEVEL 06	TOWER B	BALCONY	5.78 m²
LEVEL 06	TOWER B	BALCONY	5.78 m²
LEVEL 06	TOWER B	BALCONY	7 m²
LEVEL 06	TOWER B	BALCONY	6.93 m²
TOTAL BALCONY AREA			62.65 m²

CLIENT

Starlight Developments

Starlight Developments

P.O. Box 1690 Station B Mississauga, Ontario, Canada
L4Y 3W8

COPYRIGHT:
This drawing has been prepared solely for the intended use, thus any reproduction or distribution for any purpose other than authorized by IBI Group is forbidden. Written dimensions shall have precedence over scaled dimensions. Contractors shall verify and be responsible for all dimensions and conditions on the job, and IBI Group shall be informed of any variations from the dimensions and conditions shown on the drawing. Shop drawings shall be submitted to IBI Group for general conformance before proceeding with fabrication.
IBI Group Architects (Canada) Inc.
is a member of the IBI Group of companies

NO.	DATE	DESCRIPTION
1	YYYY-MM-DD	

ISSUES

NO.	DATE	DESCRIPTION

REVISIONS

PROJECT NORTH

N

Issued For: Project Status

Date: 2021-03-05

SEAL

REGISTERED ARCHITECT JOHN GIBSON ARCHITECT BRITISH COLUMBIA
2021-03-06

SUB-CONSULTANT

PRIME CONSULTANT

IBI GROUP
ARCHITECTS (CANADA) INC.
700-1285 West Pender Street,
Vancouver BC V6E 4B1, Canada
tel 604 683 8797 fax 604 683 0492
ibigroup.com

PROJECT TITLE

Harris Green Village Phase 01

1045 Yates Street
Victoria, BC

PROJECT NO:	121123
DRAWN BY:	Author
CHK'D BY:	Checker
SCALE:	1 : 100
DATE:	2021-03-05

SHEET TITLE

FSR OVERLAY- Level 06

SHEET NUMBER

A7.07

REV

Last Saved: 2021-03-05 10:29:48 PM File Location: Bld 360 I121123 - Yates Street – Harris Green Village Ph 1 R2020 I121123_ Yates-StA-Podium-2020.rvt

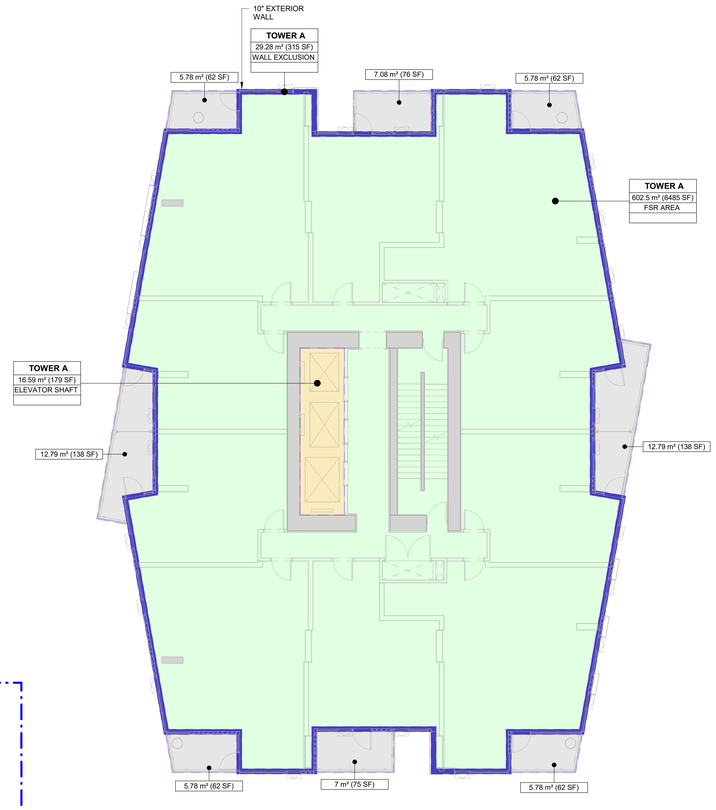

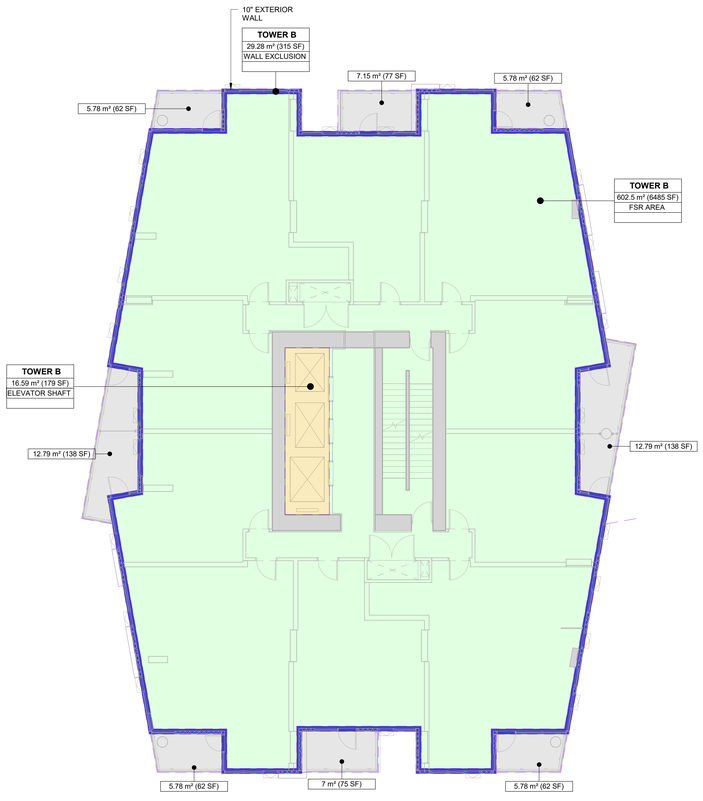

LEGEND

- FSR AREA
- EXTERIOR WALL- EXCLUSION
- ELEVATOR SHAFT- EXCLUSION
- BALCONY

FSR OVERLAY SUMMARY- TOWER A- Level 7-21

Level	Name	Description	Area
LEVEL 08	TOWER A	FSR AREA	602.5 m²
LEVEL 08	TOWER A	EXTERIOR WALL- EXCLUSION	29.28 m²
LEVEL 08	TOWER A	ELEVATOR SHAFT- EXCLUSION	16.59 m²
GROSS FLOOR AREA			648.38 m²

FSR OVERLAY SUMMARY- TOWER B- Level 7-19 (Typical Levels)

Level	Name	Description	Area
LEVEL 08	TOWER B	FSR AREA	602.5 m²
LEVEL 08	TOWER B	EXTERIOR WALL- EXCLUSION	29.28 m²
LEVEL 08	TOWER B	ELEVATOR SHAFT	16.59 m²
GROSS FLOOR AREA			648.38 m²

FSR OVERLAY SUMMARY- TOWER A- Level 7-20- Balconies

Level	Name	Description	Area
LEVEL 08	TOWER A	BALCONY	5.78 m²
LEVEL 08	TOWER A	BALCONY	12.79 m²
LEVEL 08	TOWER A	BALCONY	5.78 m²
LEVEL 08	TOWER A	BALCONY	12.79 m²
LEVEL 08	TOWER A	BALCONY	5.78 m²
LEVEL 08	TOWER A	BALCONY	5.78 m²
LEVEL 08	TOWER A	BALCONY	7 m²
LEVEL 08	TOWER A	BALCONY	7.08 m²
TOTAL BALCONY AREA			62.79 m²

FSR OVERLAY SUMMARY- TOWER B- Level 7-19 (Typical Levels)-...

Level	Name	Description	Area
LEVEL 08	TOWER B	BALCONY	5.78 m²
LEVEL 08	TOWER B	BALCONY	12.79 m²
LEVEL 08	TOWER B	BALCONY	5.78 m²
LEVEL 08	TOWER B	BALCONY	12.79 m²
LEVEL 08	TOWER B	BALCONY	5.78 m²
LEVEL 08	TOWER B	BALCONY	5.78 m²
LEVEL 08	TOWER B	BALCONY	7 m²
LEVEL 08	TOWER B	BALCONY	7.15 m²
TOTAL BALCONY AREA			62.87 m²

CLIENT

Starlight Developments

Starlight Developments

P.O. Box 1690 Station B Mississauga, Ontario, Canada L4Y 3W8

COPYRIGHT:
This drawing has been prepared solely for the intended use, thus any reproduction or distribution for any purpose other than authorized by IBI Group is forbidden. Written dimensions shall have precedence over scaled dimensions. Contractors shall verify and be responsible for all dimensions and conditions on the job, and IBI Group shall be informed of any variations from the dimensions and conditions shown on the drawing. Shop drawings shall be submitted to IBI Group for general conformance before proceeding with fabrication.
IBI Group Architects (Canada) Inc.
is a member of the IBI Group of companies

NO.	DATE	DESCRIPTION
1	YYYY-MM-DD	

ISSUES

NO.	DATE	DESCRIPTION

REVISIONS

PROJECT NORTH

N

Issued For: Project Status

Date: 2021-03-05

SEAL

REGISTERED ARCHITECT JOHN GIWA-AMU BRITISH COLUMBIA

2021-03-06

SUB-CONSULTANT

PRIME CONSULTANT

IBI GROUP ARCHITECTS (CANADA) INC.
700-1285 West Pender Street,
Vancouver, BC V6E 4B1, Canada
tel 604 683 8797 fax 604 683 0492
ibigroup.com

PROJECT TITLE

Harris Green Village Phase 01

1045 Yates Street
Victoria, BC

PROJECT NO:	121123
DRAWN BY:	Author
CHK'D BY:	Checker
SCALE:	1 : 100
DATE:	2021-03-05

SHEET TITLE

FSR OVERLAY- Typical Levels

SHEET NUMBER

A7.08

REV

Last Saved: 2021-03-05 10:29:56 PM File Location: I:\BIM-360 Docs\121123_ Yates Street - Harris Green Village Ph 1 R2020\121123_ Yates Street - Harris Green Village Ph 1 R2020_Yates-Site-Podium-2020.rvt

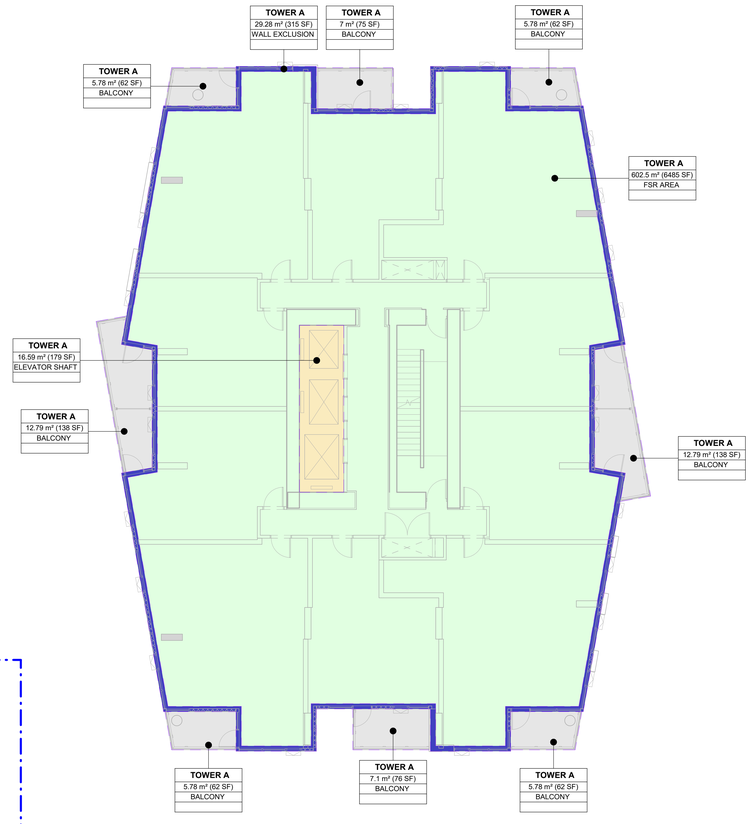

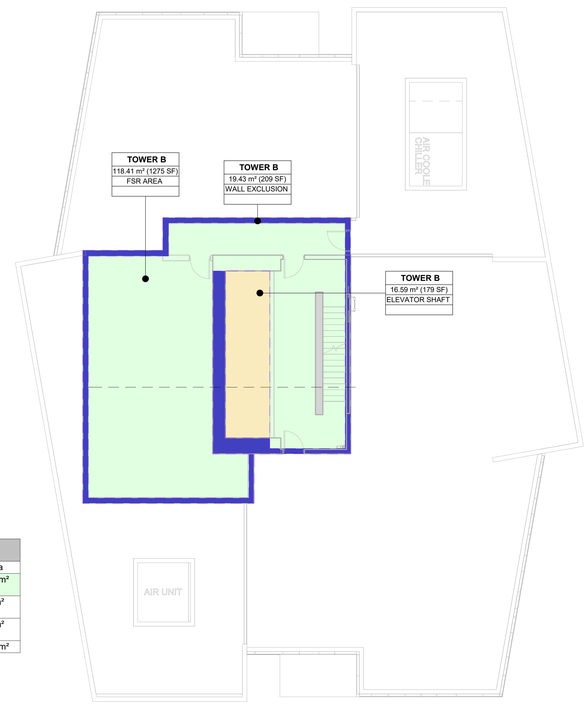

LEGEND

- FSR AREA
- EXTERIOR WALL- EXCLUSION
- ELEVATOR SHAFT- EXCLUSION
- BALCONY

FSR OVERLAY SUMMARY- TOWER A- Level 7-21

Level	Name	Description	Area
LEVEL 08	TOWER A	FSR AREA	602.5 m²
LEVEL 08	TOWER A	EXTERIOR WALL- EXCLUSION	29.28 m²
LEVEL 08	TOWER A	ELEVATOR SHAFT- EXCLUSION	16.59 m²
GROSS FLOOR AREA			648.38 m²

FSR OVERLAY SUMMARY- TOWER A- Level 7-20- Balconies

Level	Name	Description	Area
LEVEL 08	TOWER A	BALCONY	5.78 m²
LEVEL 08	TOWER A	BALCONY	12.79 m²
LEVEL 08	TOWER A	BALCONY	5.78 m²
LEVEL 08	TOWER A	BALCONY	12.79 m²
LEVEL 08	TOWER A	BALCONY	5.78 m²
LEVEL 08	TOWER A	BALCONY	5.78 m²
LEVEL 08	TOWER A	BALCONY	7 m²
LEVEL 08	TOWER A	BALCONY	7.08 m²
TOTAL BALCONY AREA			62.79 m²

FSR OVERLAY SUMMARY- TOWER B- Level 21

Level	Name	Description	Area
TWR (A) LEVEL 21 & (B) MECH. TWR	TOWER B	FSR AREA	118.41 m²
TWR (A) LEVEL 21 & (B) MECH. TWR	TOWER B	EXTERIOR WALL- EXCLUSION	19.43 m²
TWR (A) LEVEL 21 & (B) MECH. TWR	TOWER B	ELEVATOR SHAFT- EXCLUSION	16.59 m²
GROSS FLOOR AREA			154.43 m²

CLIENT

Starlight Developments

P.O. Box 1690 Station B Mississauga, Ontario, Canada L4Y 3W8

COPYRIGHT:
This drawing has been prepared solely for the intended use, thus any reproduction or distribution for any purpose other than authorized by IBI Group is forbidden. Written dimensions shall have precedence over scaled dimensions. Contractors shall verify and be responsible for all dimensions and conditions on the job, and IBI Group shall be informed of any variations from the dimensions and conditions shown on the drawing. Shop drawings shall be submitted to IBI Group for general conformance before proceeding with fabrication.
IBI Group Architects (Canada) Inc.
is a member of the IBI Group of companies

NO.	DATE	DESCRIPTION
1	YYYY-MM-DD	

ISSUES

NO.	DATE	DESCRIPTION

REVISIONS

PROJECT NORTH

N

Issued For: Project Status

Date: 2021-03-05

SEAL

REGISTERED ARCHITECT JOHN GWYN BRITISH COLUMBIA
2021-03-06

SUB-CONSULTANT

PRIME CONSULTANT

IBI GROUP
ARCHITECTS (CANADA) INC.
700-1285 West Pender Street,
Vancouver, BC V6E 4B1, Canada
tel 604 683 8797 fax 604 683 0492
ibigroup.com

PROJECT TITLE

Harris Green Village Phase 01

1045 Yates Street
Victoria, BC

PROJECT NO:	121123
DRAWN BY:	Author
CHK'D BY:	Checker
SCALE:	1 : 100
DATE:	2021-03-05

SHEET TITLE

FSR OVERLAY- LEVEL 21 (Tower B Roof)

SHEET NUMBER

A7.09

REV

Last Saved: 2021-03-05 10:30:03 PM File Location: BIM 360://121123 - Yates Street – Harris Green Village Ph 1 R23/2021-121123_Yates/03-A-Podium-2020.rvt

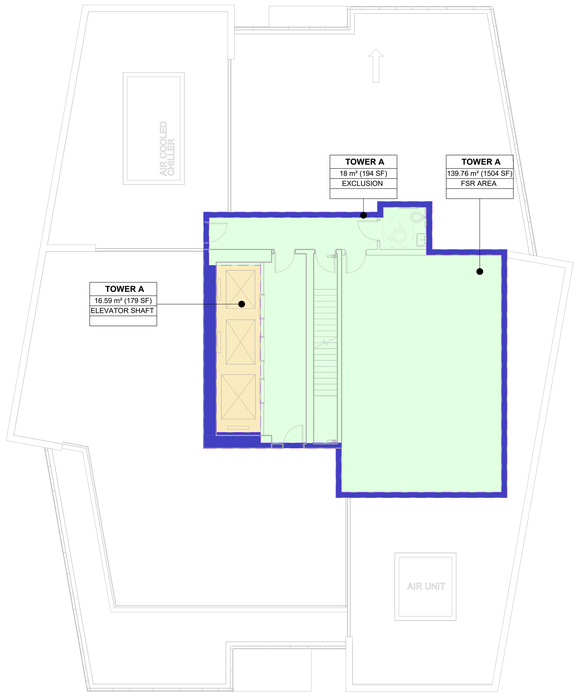

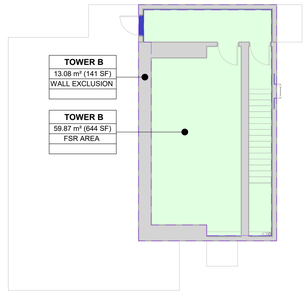

LEGEND

- FSR AREA
- EXTERIOR WALL- EXCLUSION
- ELEVATOR SHAFT- EXCLUSION

FSR OVERLAY SUMMARY- TOWER A- Level 22

Level		Name	Description	Area
TWR (A) MECH. &	TWR (B) UPPER MECH.	TOWER A	FSR AREA	139.76 m²
TWR (A) MECH. &	TWR (B) UPPER MECH.	TOWER A	EXTERIOR WALL- EXCLUSION	18 m²
TWR (A) MECH. &	TWR (B) UPPER MECH.	TOWER A	ELEVATOR SHAFT- EXCLUSION	16.59 m²
GROSS FLOOR AREA				174.34 m²

CLIENT

Starlight Developments

Starlight Developments

P.O. Box 1690 Station B Mississauga, Ontario, Canada L4Y 3W8

COPYRIGHT:
This drawing has been prepared solely for the intended use, thus any reproduction or distribution for any purpose other than authorized by IBI Group is forbidden. Written dimensions shall have precedence over scaled dimensions. Contractors shall verify and be responsible for all dimensions and conditions on the job, and IBI Group shall be informed of any variations from the dimensions and conditions shown on the drawing. Shop drawings shall be submitted to IBI Group for general conformance before proceeding with fabrication.
IBI Group Architects (Canada) Inc.
is a member of the IBI Group of companies

NO.	DATE	DESCRIPTION
1	YYYY-MM-DD	

ISSUES

NO.	DATE	DESCRIPTION

REVISIONS

PROJECT NORTH

N

Issued For: Project Status

Date: 2021-03-05

SEAL

REGISTERED ARCHITECT JOHN CHRISTIAN GRAY BRITISH COLUMBIA
2021-03-06

SUB-CONSULTANT

PRIME CONSULTANT

IBI GROUP
ARCHITECTS (CANADA) INC.
700-1285 West Pender Street
Vancouver, BC V6E 4B1, Canada
tel 604 683 8797 fax 604 683 0492
ibigroup.com

PROJECT TITLE

Harris Green Village Phase 01

1045 Yates Street
Victoria, BC

PROJECT NO:	121123
DRAWN BY:	Author
CHK'D BY:	Checker
SCALE:	1 : 100
DATE:	2021-03-05

SHEET TITLE

FSR OVERLAY- LEVEL 22 - ROOF TWR (A) - TWR (B) MECH. ROOF

SHEET NUMBER

A7.10

REV

Last Saved: 2021-03-05 10:30:07 PM File Location: BIM 360:\121123 - Yates Street – Harris Green Village Ph 1 R2020\121123_YatesStA-Podium-2020.rvt

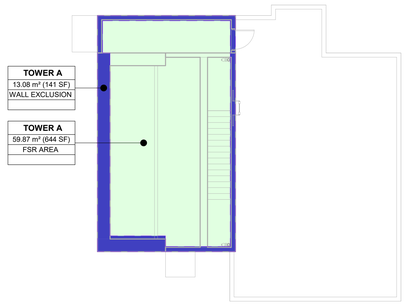

LEGEND

- FSR AREA
- EXTERIOR WALL- EXCLUSION

FSR OVERLAY SUMMARY- TOWER A- Level 23				
Level		Name	Description	Area
TWR (A) UPPER MECH. & T.O.P	TWR (B)	TOWER A	FSR AREA	59.87 m²
TWR (A) UPPER MECH. & T.O.P	TWR (B)	TOWER A	EXTERIOR WALL- EXCLUSION	13.08 m²
GROSS FLOOR AREA				72.95 m²

CLIENT

Starlight Developments

Starlight Developments
P.O. Box 1690 Station B Mississauga, Ontario, Canada
L4Y 3W8

COPYRIGHT:
This drawing has been prepared solely for the intended use, thus any reproduction or distribution for any purpose other than authorized by IBI Group is forbidden. Written dimensions shall have precedence over scaled dimensions. Contractors shall verify and be responsible for all dimensions and conditions on the job, and IBI Group shall be informed of any variations from the dimensions and conditions shown on the drawing. Shop drawings shall be submitted to IBI Group for general conformance before proceeding with fabrication.
IBI Group Architects (Canada) Inc.
is a member of the IBI Group of companies

NO.	DATE	DESCRIPTION
1	YYYY-MM-DD	

ISSUES

NO.	DATE	DESCRIPTION

REVISIONS

PROJECT NORTH
N

Issued For: Project Status
Date: 2021-03-05

SEAL

REGISTERED ARCHITECT JOHN GIMPEL BRITISH COLUMBIA
2021-03-06

SUB-CONSULTANT

PRIME CONSULTANT

IBI GROUP
ARCHITECTS (CANADA) INC.
700-1285 West Pender Street,
Vancouver, BC V6E 4B1, Canada
tel 604 683 8797 fax 604 683 0492
ibigroup.com

PROJECT TITLE
Harris Green Village Phase 01
1045 Yates Street
Victoria, BC

PROJECT NO:	121123
DRAWN BY:	Author
CHK'D BY:	Checker
SCALE:	1 : 100
DATE:	2021-03-05

SHEET TITLE
FSR OVERLAY- LEVEL 23 - TWR (A) MECH. ROOF - TRW (B) UPPER ROOF

SHEET NUMBER
A7.11

REV

Last Saved: 2021-03-05 10:30:10 PM File Location: Bld 360 I121123 - Yates Street – Harris Green Village Ph 1 I2020\121123_ YatesStA-Podium-2020.rvt

1045 Yates Street Landscape Drawings

Issued For DP - March 1, 2021

DRAWING LIST

Landscape
L0.00 - Landscape Rationale
L0.01 - Tree Management Plan

L1.01 - Illustrative Plan | Ground Level
L1.02 - Illustrative Plan | Level 2
L1.03 - Illustrative Plan | Level 4
L1.04 - Illustrative Plan | Level 5
L1.05 - Illustrative Plan | Level 6

L1.11 - Materials Plan | Ground Level
L1.12 - Materials Plan | Level 2
L1.13 - Materials Plan | Level 4
L1.14 - Materials Plan | Level 5
L1.15 - Materials Plan | Level 6

L1.21 - Layout Plan | Ground Level
L1.22 - Layout Plan | Level 2
L1.23 - Layout Plan | Level 4
L1.24 - Layout Plan | Level 5
L1.25 - Layout Plan | Level 6

L1.31 - Grading Plan | Ground Level

L1.41 - Planting Plan | Ground Level
L1.42 - Planting Plan | Level 2
L1.43 - Planting Plan | Level 4
L1.44 - Planting Plan | Level 5
L1.45 - Planting Plan | Level 6

L2.11 - Landscape Sections | Ground Level and Level 2
L3.11 - Landscape Details | Paving & Stairs
L3.12 - Landscape Details | Site Furnishings
L3.13 - Landscape Details | Planting

HAPA COLLABORATIVE
Landscape Architecture
Urban Design
403 - 375 West Fifth Avenue
Vancouver BC. V6Y 1J6
604 909 4150
hapacobo.com

No.	Description	Date
3	Issued for DP	Mar 1/21
1	Issued for DP	Nov 6/20
1	Issued for DP	May 22/20

Copyright Reserved. This drawing is and remains at all times the exclusive property of Hapa Collaborative and cannot be used modified or copied without the expressed written consent of the landscape architect.

Harris Green Village
1045 Yates Street
Victoria, BC

Cover Page

Date	May. 22/20	Drawing Number
Project No.	1932	L
Scale		
Drawn|Checked	kw | gc | JF	

Landscape Rationale

Connections

Incorporate the site into a larger network, which becomes the backbone of the Town Centre. Design elements on the streetscape will draw from and expand on the New Town Standard to allow for better integration into the existing urban fabric.

Edge Enclosure

Utilize design elements to enclose the sidewalk and commercial frontage zone making it feel contained and comfortable. Street trees, rain gardens and site furnishings in the streetscape will assist in creating this sense of enclosure.

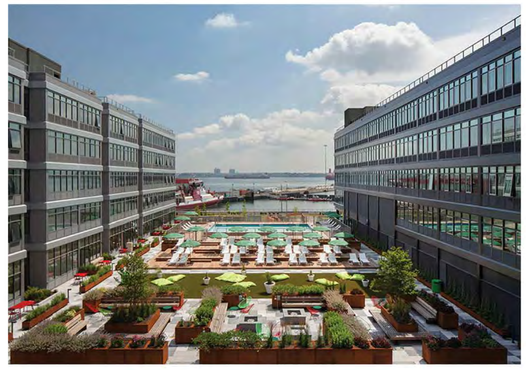

Flexibility

Accomodate a wide variety of activities including small scale events and the every day in amenity areas on the podium and rooftops. Including urban agriculture, a variety of seating types, site furnishings, lounge and recreational areas.

Invitation

Design the commercial frontage zone and outdoor amenity areas to be welcoming and inviting for people of all different ages, interests and backgrounds. Lush roof terrace planting provide inviting spaces for residents.

Protection

Generous sidewalk widths, rain garden planting and street trees can assist in protecting and buffering pedestrian areas and the commercial frontage zone from vehicular traffic and noise from busy streets.

Comfort

Incorporate weather protection for all seasons, adequate lighting and plenty of seating to provide comfort for end users to allow them linger.

HAPA COLLABORATIVE
Landscape Architecture
Urban Design
403 - 375 West Fifth Avenue
Vancouver BC. V6Y 1J6
604 909 4150
hapacobo.com

No.	Description	Date
3	Issued for DP	Mar 1/21
1	Issued for DP	Nov 6/20
1	Issued for DP	May 22/20

Copyright Reserved. This drawing is and remains at all times the exclusive property of Hapa Collaborative and cannot be used modified or copied without the expressed written consent of the landscape architect.

Harris Green Village
1045 Yates Street
Victoria, BC

Landscape Rationale

Date	May. 22/20	Drawing Number
Project No.	1932	L0.00
Scale		
Drawn|Checked	kw | gc | JF	

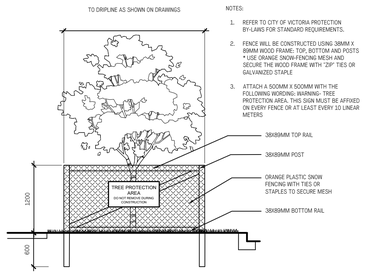

NOTES:

1. REFER TO CITY OF VICTORIA PROTECTION BY-LAWS FOR STANDARD REQUIREMENTS.
2. FENCE WILL BE CONSTRUCTED USING 38MM X 89MM WOOD FRAME: TOP, BOTTOM AND POSTS * USE ORANGE SNOW-FENCING MESH AND SECURE THE WOOD FRAME WITH "ZIP" TIES OR GALVANIZED STAPLE
3. ATTACH A 500MM X 500MM WITH THE FOLLOWING WORDING: WARNING- TREE PROTECTION AREA. THIS SIGN MUST BE AFFIXED ON EVERY FENCE OR AT LEAST EVERY 10 LINEAR METERS

TREE PROTECTION FENCING
NTS

TREE INVENTORY

TREE I.D. (Municipal I.D.)	Common Name	DBH (cm)	Crown (m) Spread	CRZ (m)	Health	Structure	Bylaw Status	Recommended Action
Nt53 (26217)	Richmond Canoe Birch	39	10	4.0	Good	Good	Municipal	Remove
Nt54 (26216)	Japanese Tree Lilac	6	1	1.0	Good	Good	Municipal	Remove
Nt55 (26215)	Richmond Canoe Birch	48	14	5.0	Good	Good	Municipal	Remove
Nt56 (26214)	Richmond Canoe Birch	42	13	4.0	Good	Good	Municipal	Remove
Nt57 (26213)	Richmond Canoe Birch	19	6	2.0	Good	Good	Municipal	Remove
Nt1 (26314)	Horse Chestnut	75	11	6.0	Good	Fair	Municipal	Protect & Retain
Nt2 (26317)	Horse Chestnut	74	15	6.0	Good	Fair	Municipal	Protect & Retain
Nt3 (26316)	Horse Chestnut	84	15	6.5	Good	Fair	Municipal	Protect & Retain
Nt4 (26238)	Horse Chestnut	74	17	6.0	Good	Fair	Municipal	Protect & Retain
Nt5 (26233)	Lindsay Plum	43	7	4.5	Fair	Fair	Municipal	Remove
Nt6 (26232)	Lindsay Plum	54	11	5.5	Fair	Poor	Municipal	Remove
Nt7 (26231)	Lindsay Plum	56	13	5.5	Fair	Fair	Municipal	Remove
Nt8 (26230)	Lindsay Plum	53	12	5.5	Fair	Poor	Municipal	Remove
Nt9 (26299)	Persian Ironwood	12	3	1.5	Good	Good	Municipal	Remove
Nt10 (Private)	Flowering Plum	36	11	3.5	Good	Fair	Bylaw-protected	Remove

TREE PROTECTION LEGEND

	QTY.	DESCRIPTION
+	4	EXISTING STREET TREE TO REMAIN
×	8	EXISTING STREET TREE TO REMOVE
		TREE PROTECTION FENCING
		CRITICAL ROOT ZONE (CRZ)

NOTES

1. NO STORAGE OF BUILDING /CONSTRUCTION MATERIALS WITHIN OR AGAINST PROTECTION BARRIER.
2. ANY PRUNING OF BRANCHES OR ROOTS MUST BE DONE BY AN ISA CERTIFIED ARBORIST.
3. PROTECTION FENCE IS NOT TO BE LIFTED OR REMOVED AT ANY TIME FOR VEHICULAR ACCESS. VEHICLES AND HEAVY EQUIPMENT CAN CAUSE SOIL COMPACTION IN THE ROOT ZONE DEPLETING THE AIR SPACE THAT IS ESSENTIAL TO THE TREE'S HEALTH. REFER TO TREE PROTECTION SPECIFICATIONS.
4. WHEN REMOVING ASPHALT, PAVING OR OTHER MATERIALS FROM DIRECT CONTACT WITH TREE ROOTS OR PROTECTION ZONES - CONSULT WITH ARBORIST ON SITE.
5. REFER TO ARBORIST'S INVENTORY/ASSESSMENT REPORT PREPARED BY PROJECT ARBORIST FOR TREE SPECIES AND GENERAL CONDITIONS. THIS PLAN SHOULD BE READ IN CONJUNCTION WITH AN ARBORIST REPORT.

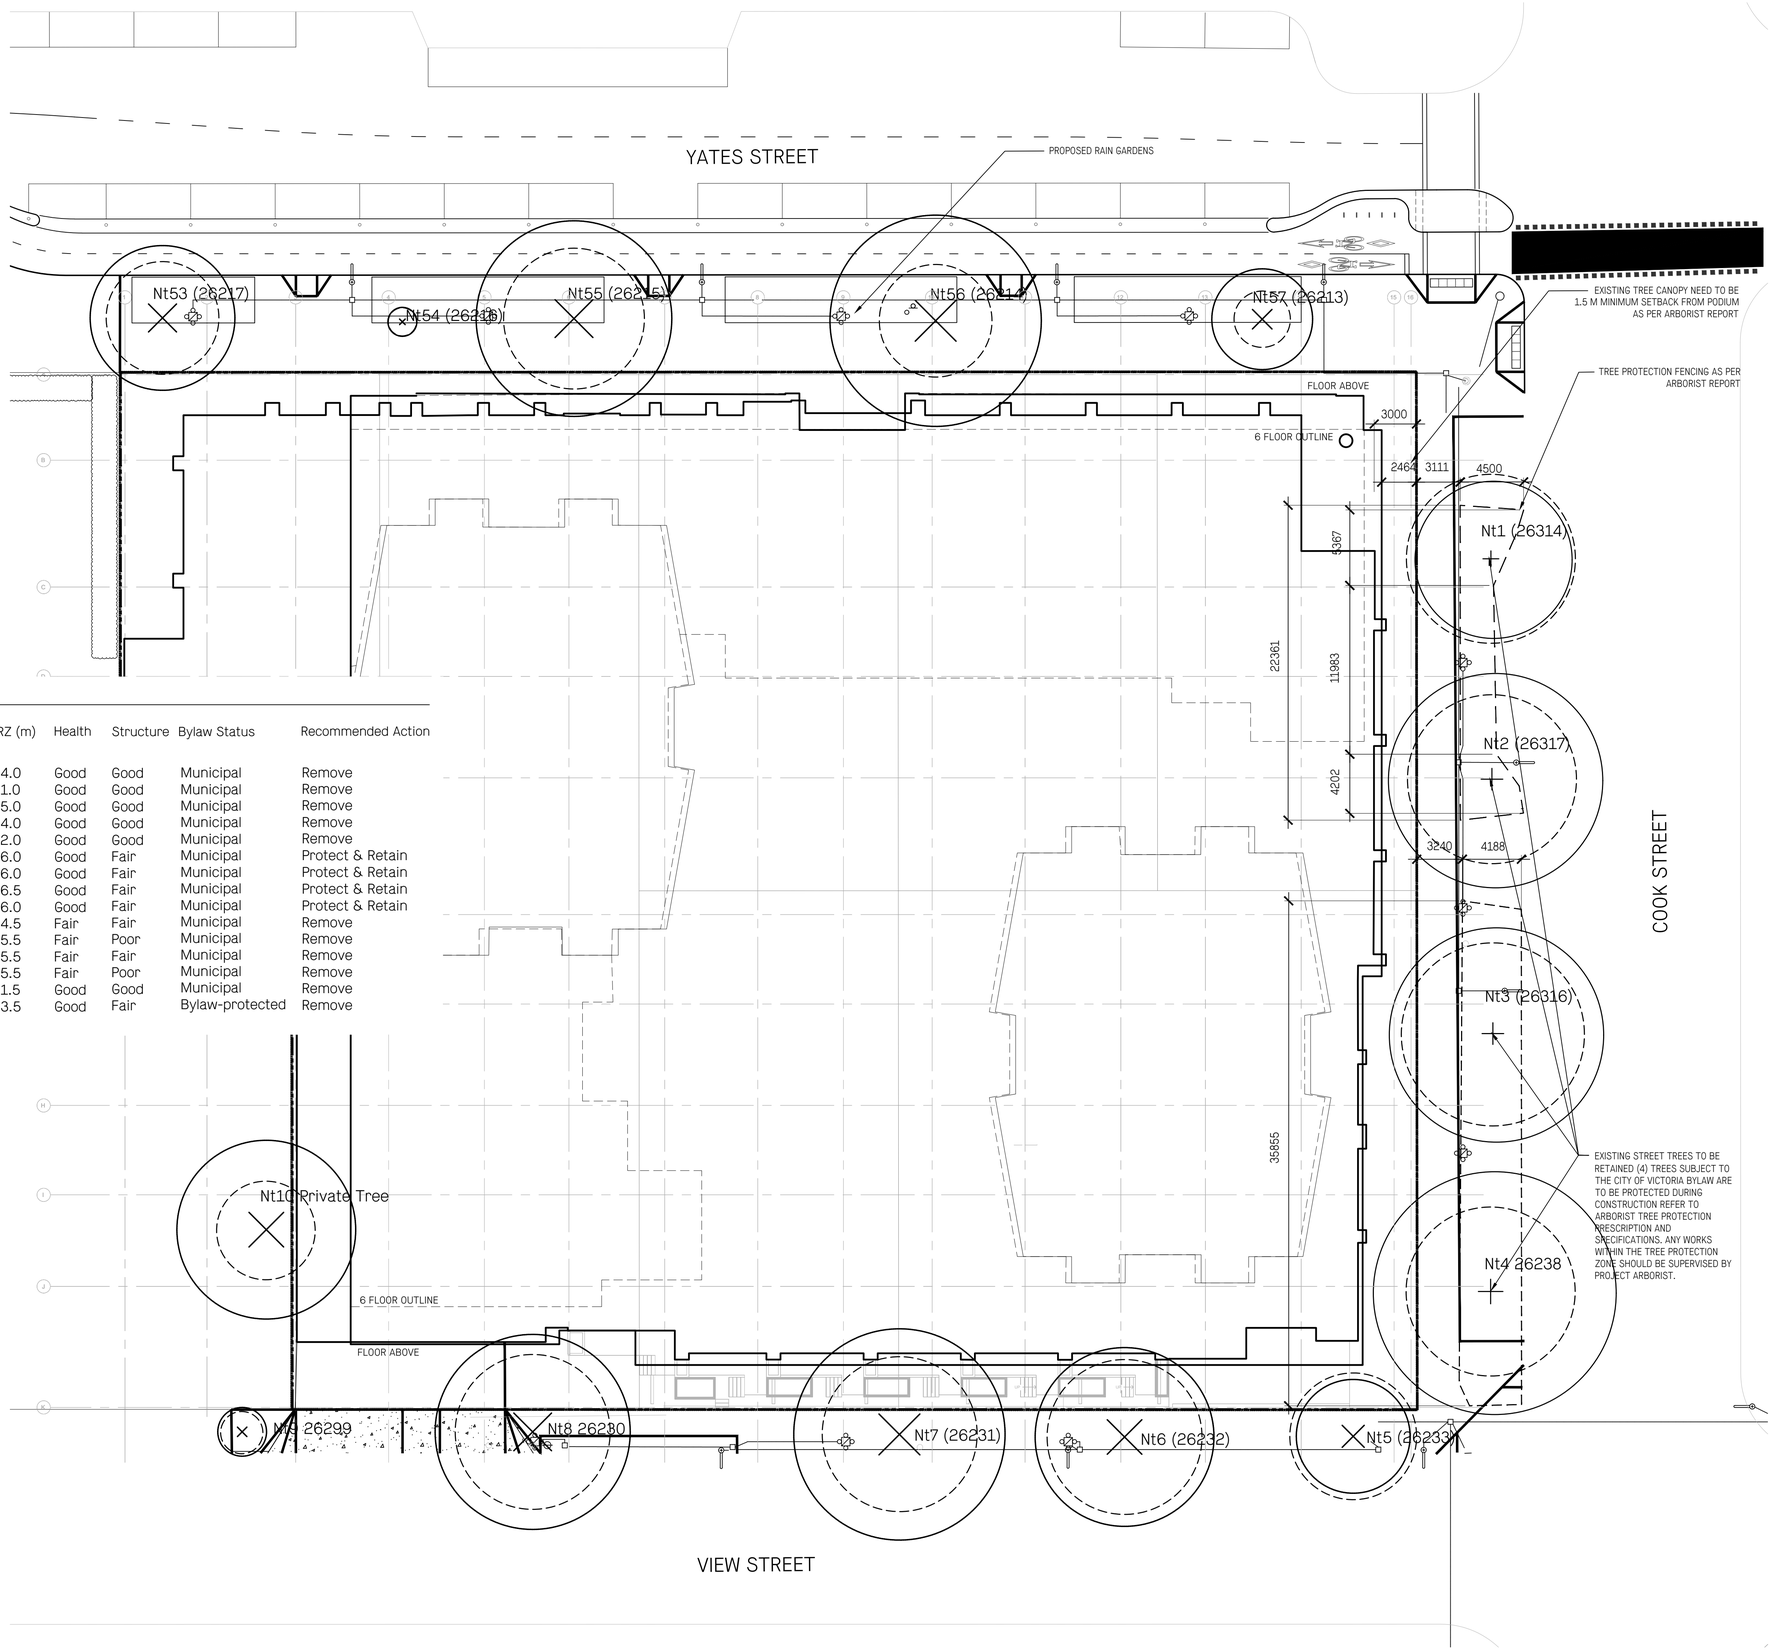

HAPA COLLABORATIVE
604 909 4150
hapacobo.com
403 - 375 West Fifth Avenue
Vancouver BC, V6Y 1J6
Landscape Architecture
Urban Design

Information on this Record Drawing regarding the locations of landscape architectural features is based on the IFC drawings, Change Orders and Site Instructions issued after the issuance of the IFC drawings, and on information provided by the Contractor. This drawing is intended for general guidance only; no guarantee is given of its accuracy.

No.	Description	Date
3	Issued for DP	Mar 1/21
1	Issued for DP	Nov 6/20
1	Issued for DP	May 22/20

Copyright Reserved. This drawing is and remains at all times the exclusive property of Hapa Collaborative and cannot be used modified or copied without the expressed written consent of the landscape architect.

Harris Green Village
1045 Yates Street
Victoria, BC

Tree Management
Level 1

Date	May. 22/20	Drawing Number
Project No.	1932	L0.01
Scale	1:200	
Drawn|Checked	kw | gc | JF	

LEGEND

PROPERTY LINE

ELEVATION

DETAIL SECTION

DETAIL NUMBER

SHEET ON WHICH DETAIL IS SHOWN

PRIMARY SECTION

REVISION

00.00
00.00 (EXT)
0.0 %
10.0 %

NEW STREET TREE IN RAIN GARDEN

PEDESTRIAN LIGHT NEW TOWN STANDARD

RAIN GARDEN TYP.

SIDEWALK

YATES STREET

CUSTOM WOOD BENCHES TYP.

PERMEABLE PAVERS

NEW TOWN STANDARD PAVING

CORNER TREATMENT AS PER DPRP NEW TOWN STANDARD

TRASH BIN

CUSTOM WOOD BENCH

BOLLARD, TYP.

NEW TOWN STANDARD PAVING

PRE DESIGN FOR POTENTIAL OUTDOOR PATIO [PENDING TENANT]

EXISTING PRIVACY HEDGE ON NEIGHBORING PROPERTY

PLANTER DIVIDERS

WOOD BENCH

BASALT PAVING BAND WITH STREET NAME TYP.

FLOOR ABOVE

CLASS B BIKE RACKS (2 BIKE CAPACITY PER RACK, 16 BIKE PARKING SPOTS)

COOK STREET

EXISTING UTILITY POLE TO REMAIN

EXISTING STREET TREE TO BE RETAINED (2)

TRASH BIN

CUSTOM WOOD BENCH

BOLLARD, TYP.

CORNER TREATMENT AS PER DPRP NEW TOWN STANDARD

TOWNHOUSE CONCRETE RAISED PLANTERS TYP.

TOWNHOUSE PATIO TYP.

RAISED CONCRETE PLANTER

RAISED CONCRETE PLANTER

WOOD SEATING PLATFORM

RAMP REFER TO ARCH.

EXISTING UTILITY POLE. TO BE RELOCATED

RAIN GARDEN PLANTING

PROPOSED STREET TREE IN SP-48 DOBNEY TREE GRATE WITH METAL TREE GUARD PER COV STANDARD

VIEW STREET

LOW PLANTING

BASALT PAVING BAND WITH STREET NAME TYP.

CLASS B BIKE RACKS (4 BIKE RACKS, 8 BIKE PARKING SPOTS)

METAL PLANTER

BIKE RACKS (3)

NEW TOWN PAVING STANDARD

HAPA COLLABORATIVE

Landscape Architecture
Urban Design

403 - 375 West Fifth Avenue
Vancouver BC, V6Y 1J6

604 909 4150
hapacobo.com

No.	Description	Date
3	Issued for DP	Mar 1/21
1	Issued for DP	Nov 6/20
1	Issued for DP	May 22/20

Copyright Reserved. This drawing is and remains at all times the exclusive property of Hapa Collaborative and cannot be used modified or copied without the expressed written consent of the landscape architect.

Harris Green Village

1045 Yates Street
Victoria, BC

Illustrative Plan

Level 1

Date	May. 22/20	Drawing Number	
Project No.	1932		L1.01
Scale	1:200		
Drawn|Checked	kw | gc | JF		

HAPA COLLABORATIVE

Landscape Architecture
Urban Design

403 - 375 West Fifth Avenue
Vancouver BC, V6Y 1J6

604 909 4150
hapacobo.com

Information on this Record Drawing regarding the locations of landscape architectural features is based on the IFC drawings, Change Orders and Site Instructions issued after the issuance of the IFC drawings, and on information provided by the Contractor. This drawing is intended for general guidance only; no guarantee is given of its accuracy.

No.	Description	Date
3	Issued for DP	Mar 1/21
1	Issued for DP	Nov 6/20
1	Issued for DP	May 22/20

Copyright Reserved. This drawing is and remains at all times the exclusive property of Hapa Collaborative and cannot be used modified or copied without the expressed written consent of the landscape architect.

Harris Green Village
1045 Yates Street
Victoria, BC

Illustrative Plan
Level 2

Date	May. 22/20	Drawing Number
Project No.	1932	L1.02
Scale	1:200	
Drawn|Checked	kw | gc | JF	

HAPA COLLABORATIVE

Landscape Architecture
Urban Design

403 - 375 West Fifth Avenue
Vancouver BC, V6Y 1J6

604 909 4150
hapacobo.com

Information on this Record Drawing regarding the locations of landscape architectural features is based on the IFC drawings, Change Orders and Site Instructions issued after the issuance of the IFC drawings, and on information provided by the Contractor. This drawing is intended for general guidance only; no guarantee is given of its accuracy.

No.	Description	Date
3	Issued for DP	Mar 1/21
1	Issued for DP	Nov 6/20
1	Issued for DP	May 22/20

Copyright Reserved. This drawing is and remains at all times the exclusive property of Hapa Collaborative and cannot be used modified or copied without the expressed written consent of the landscape architect.

Harris Green Village
1045 Yates Street
Victoria, BC

Illustrative Plan
Level 4

Date	May. 22/20	Drawing Number	
Project No.	1932		L1.03
Scale	1:200		
Drawn|Checked	kw | gc | JF		

HAPA COLLABORATIVE
Landscape Architecture
Urban Design
403 - 375 West Fifth Avenue
Vancouver BC, V6Y 1J6
604 909 4150
hapacobo.com

Information on this Record Drawing regarding the locations of landscape architectural features is based on the IFC drawings, Change Orders and Site Instructions issued after the issuance of the IFC drawings, and on information provided by the Contractor. This drawing is intended for general guidance only; no guarantee is given of its accuracy.

No.	Description	Date
3	Issued for DP	Mar 1/21
1	Issued for DP	Nov 6/20
1	Issued for DP	May 22/20

Copyright Reserved. This drawing is and remains at all times the exclusive property of Hapa Collaborative and cannot be used modified or copied without the expressed written consent of the landscape architect.

Harris Green Village
1045 Yates Street
Victoria, BC

Illustrative Plan
Level 5

Date	May. 22/20	Drawing Number
Project No.	1932	L1.04
Scale	1:200	
Drawn|Checked	kw | gc | JF	

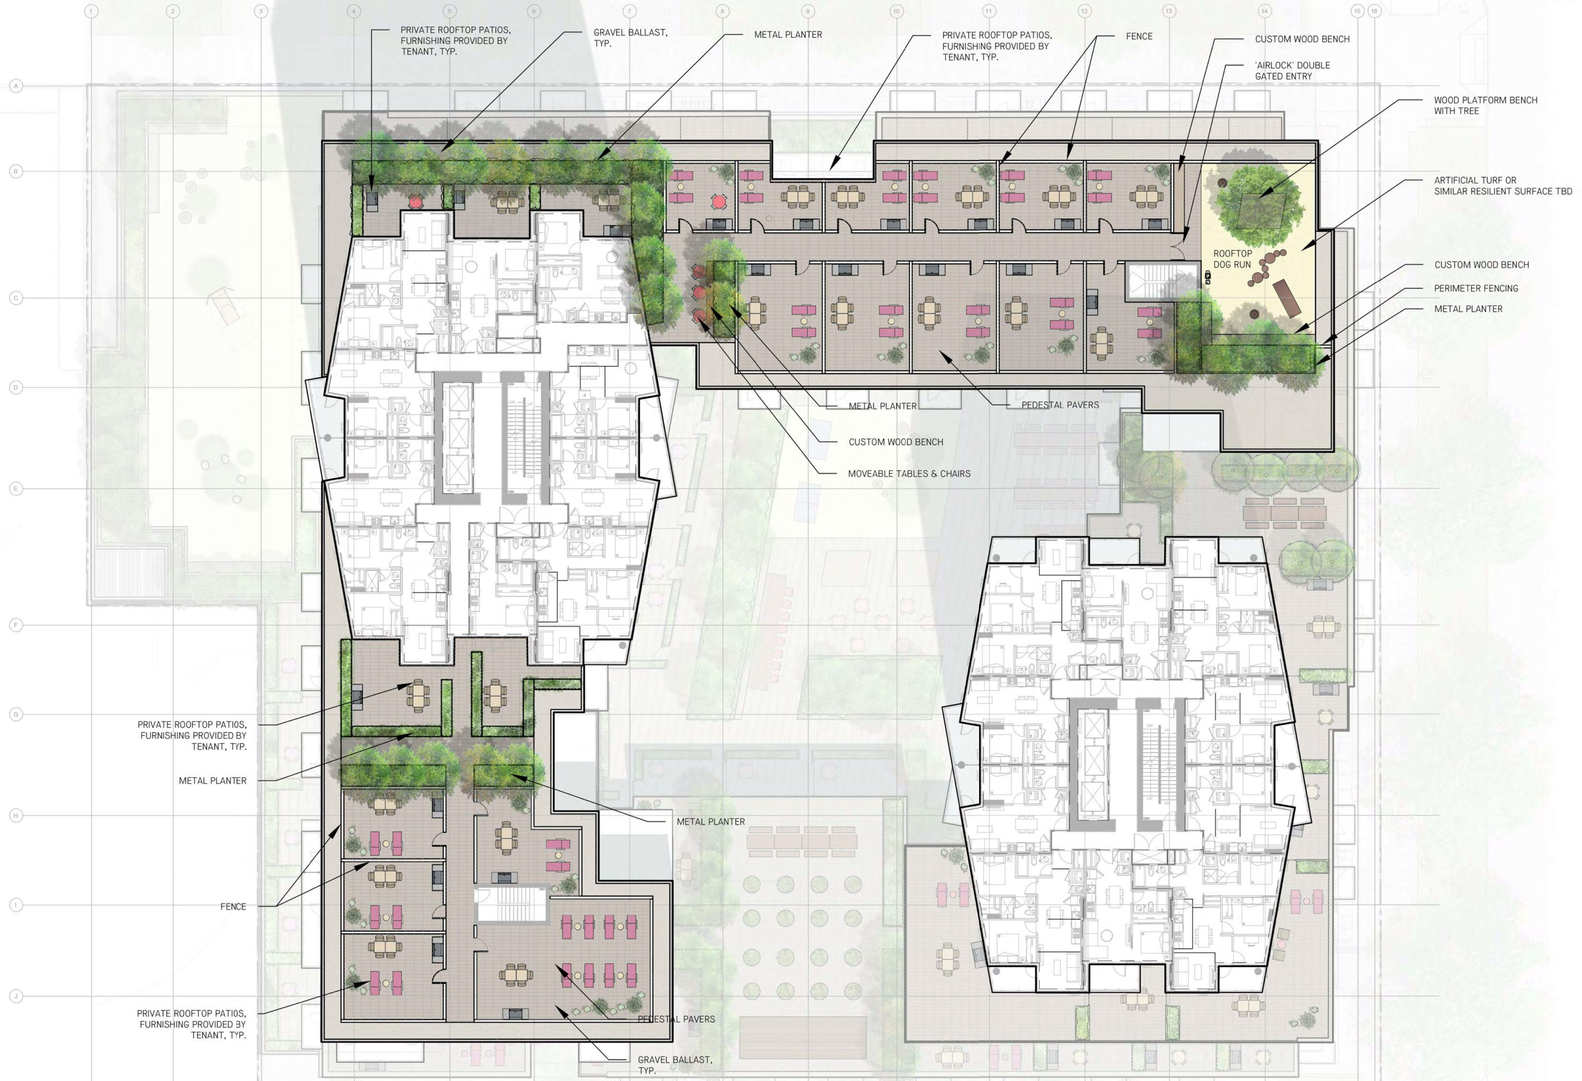

HAPA COLLABORATIVE
Landscape Architecture
Urban Design
403 - 375 West Fifth Avenue
Vancouver BC, V6Y 1J6
604 909 4150
hapacobo.com

No.	Description	Date
3	Issued for DP	Mar 1/21
1	Issued for DP	Nov 6/20
1	Issued for DP	May 22/20

Copyright Reserved. This drawing is and remains at all times the exclusive property of Hapa Collaborative and cannot be used modified or copied without the expressed written consent of the landscape architect.

Harris Green Village
1045 Yates Street
Victoria, BC

Illustrative Plan
Level 6

Date	May. 22/20	Drawing Number	
Project No.	1932		L1.05
Scale	1:200		
Drawn|Checked	kw | gc | JF		

LEGEND

PROPERTY LINE

ELEVATION

DETAIL SECTION

DETAIL NUMBER

SHEET ON WHICH DETAIL IS SHOWN

PRIMARY SECTION

REVISION

20.00
20.00 (EXT)
0.0 %
0.0 %

NEW STREET TREE IN RAIN GARDEN

PEDESTRIAN LIGHT NEW TOWN STANDARD

RAIN GARDEN TYP.

SIDEWALK

YATES STREET

CUSTOM WOOD BENCHES TYP.

PERMEABLE PAVERS

NEW TOWN STANDARD PAVING

CORNER TREATMENT AS PER DPRP NEW TOWN STANDARD

TRASH BIN

CUSTOM WOOD BENCH

BOLLARD, TYP.

NEW TOWN STANDARD PAVING

PRE DESIGN FOR POTENTIAL OUTDOOR PATIO [PENDING TENANT]

EXISTING PRIVACY HEDGE ON NEIGHBORING PROPERTY

PLANTER DIVIDERS

WOOD BENCH

CLASS B BIKE RACKS (2 BIKE CAPACITY PER RACK, 16 BIKE PARKING SPOTS)

BASALT PAVING BAND WITH STREET NAME TYP.

FLOOR ABOVE

COOK STREET

EXISTING UTILITY POLE TO REMAIN

EXISTING STREET TREE TO BE RETAINED (2)

TRASH BIN

CUSTOM WOOD BENCH

BOLLARD, TYP.

CORNER TREATMENT AS PER DPRP NEW TOWN STANDARD

TOWNHOUSE CONCRETE RAISED PLANTERS TYP.

TOWNHOUSE PATIO TYP.

RAISED CONCRETE PLANTER

RAISED CONCRETE PLANTER

WOOD SEATING PLATFORM

1.76m

2.19m

RAMP REFER TO ARCH.

EXISTING UTILITY POLE. TO BE RELOCATED

RAIN GARDEN PLANTING

PROPOSED STREET TREE IN SP-48 DOBNEY TREE GRATE WITH METAL TREE GUARD PER COV STANDARD

VIEW STREET

LOW PLANTING

BASALT PAVING BAND WITH STREET NAME TYP.

CLASS B BIKE RACKS (4 BIKE RACKS, 8 BIKE PARKING SPOTS)

NEW TOWN PAVING STANDARD

METAL PLANTER

BIKE RACKS (3)

HAPA COLLABORATIVE
Landscape Architecture
Urban Design
403 - 375 West Fifth Avenue
Vancouver BC, V6V 1J6
604 909 4150
hapacobo.com

No.	Description	Date
3	Issued for DP	Mar 1/21
2	Issued for DP	Nov 6/20
1	Issued for DP	May 22/20

Copyright Reserved. This drawing is and remains at all times the exclusive property of Hapa Collaborative and cannot be used modified or copied without the expressed written consent of the landscape architect.

Harris Green Village
1045 Yates Street
Victoria, BC

Materials Plan
Level 1

Date	May. 22/20	Drawing Number	
Project No.	1932		L1.11
Scale	1:200		
Drawn|Checked	kw | gc | JF		

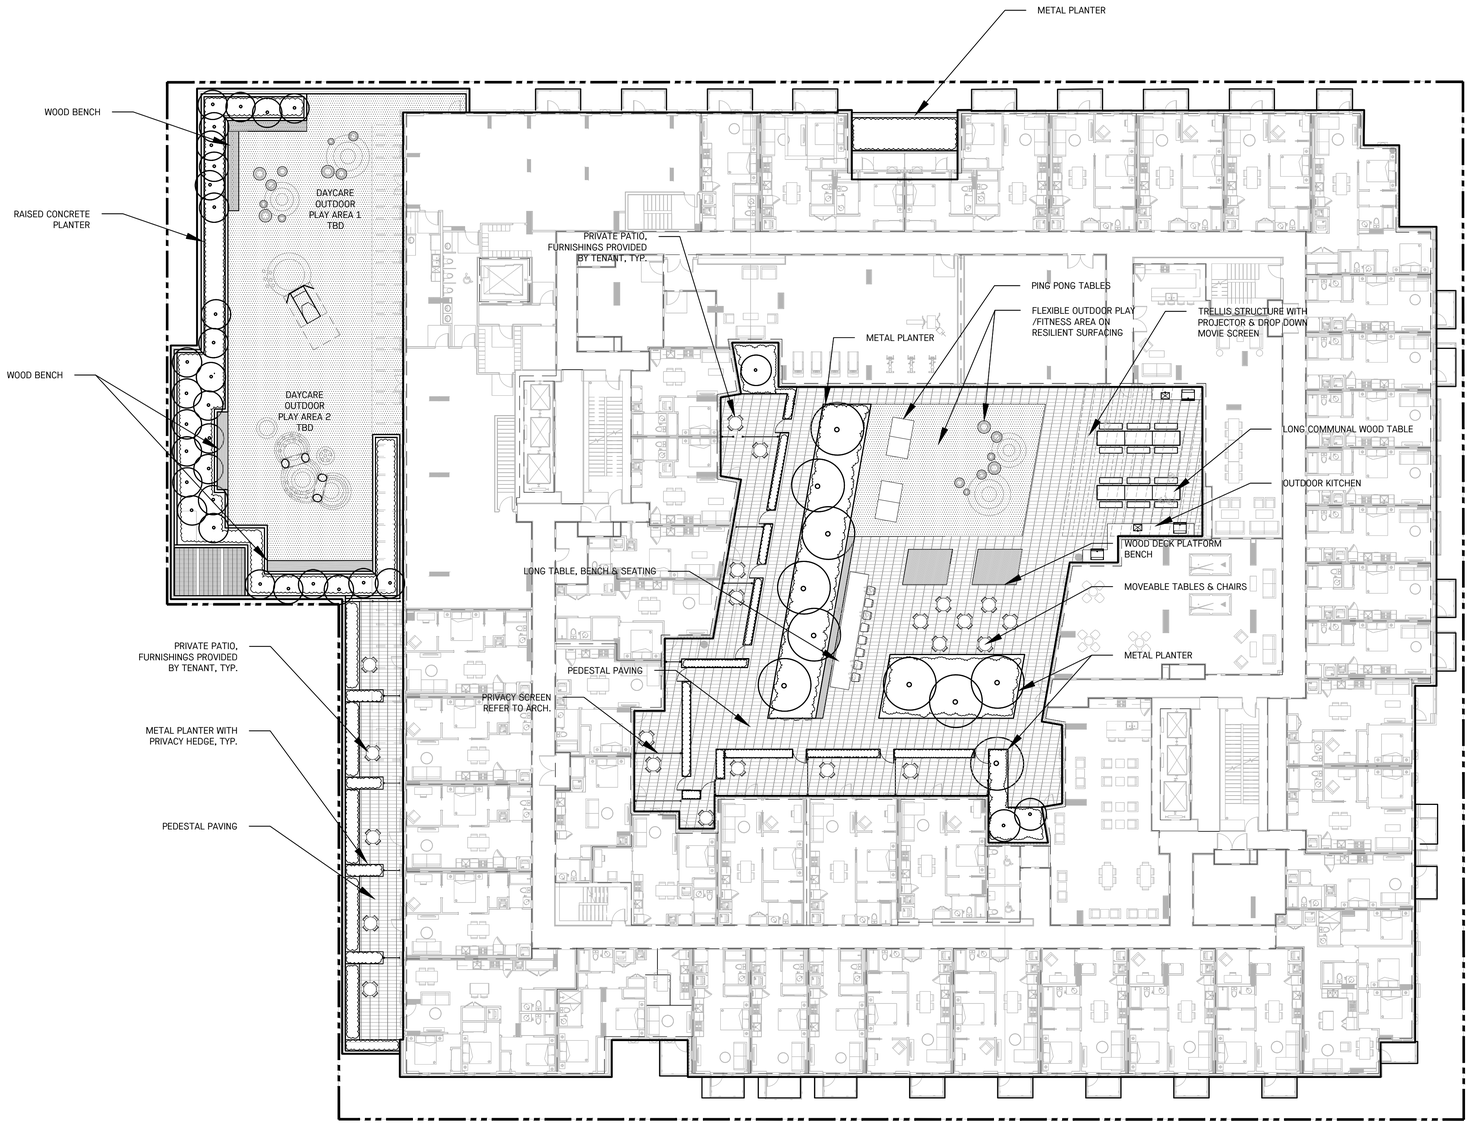

HAPA COLLABORATIVE
Landscape Architecture
Urban Design
403 - 375 West Fifth Avenue
Vancouver BC, V6Y 1J6
604 909 4150
hapacobo.com

Information on this Record Drawing regarding the locations of landscape architectural features is based on the IFC drawings, Change Orders and Site Instructions issued after the issuance of the IFC drawings, and on information provided by the Contractor. This drawing is intended for general guidance only; no guarantee is given of its accuracy.

No.	Description	Date
3	Issued for DP	Mar 1/21
1	Issued for DP	Nov 6/20
1	Issued for DP	May 22/20

Copyright Reserved. This drawing is and remains at all times the exclusive property of Hapa Collaborative and cannot be used modified or copied without the expressed written consent of the landscape architect.

Harris Green Village
1045 Yates Street
Victoria, BC

Materials Plan
Level 2

Date	May. 22/20
Project No.	1932
Scale	1:200
Drawn|Checked	kw | gc | JF

Drawing Number
L1.12

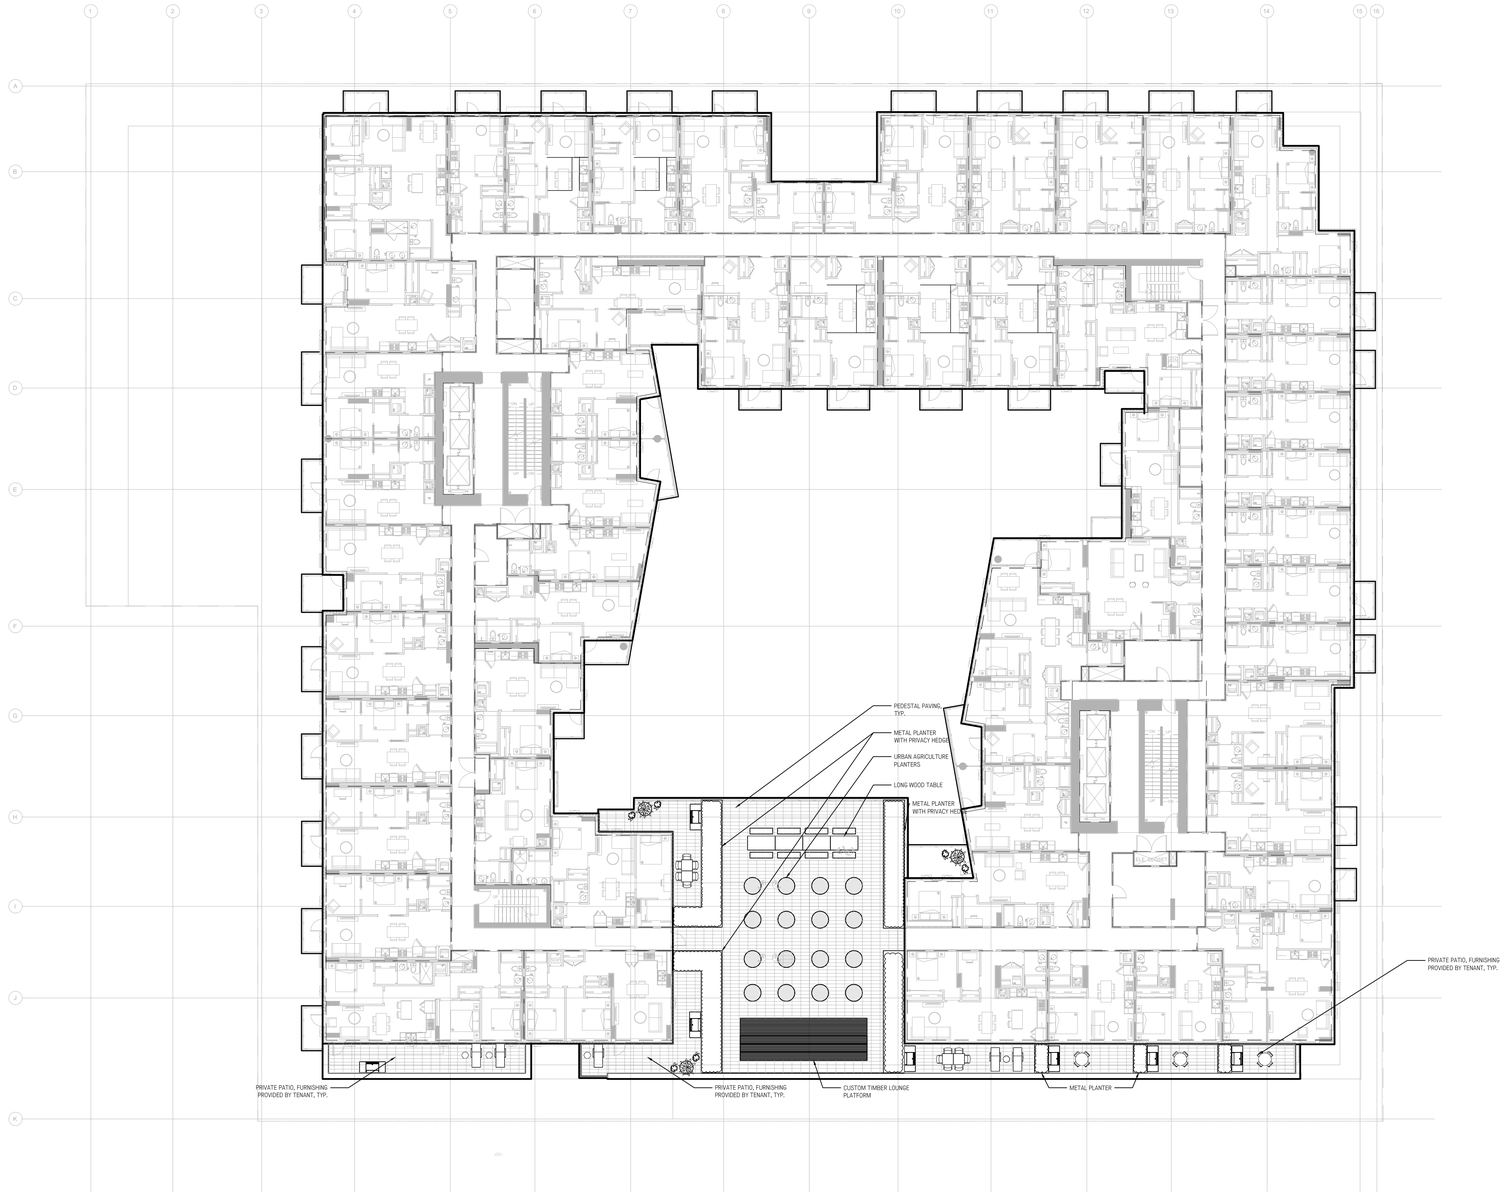

HAPA COLLABORATIVE
Landscape Architecture
Urban Design
403 - 375 West Fifth Avenue
Vancouver BC, V6Y 1J6
604 909 4150
hapacobo.com

Information on this Record Drawing regarding the locations of landscape architectural features is based on the IFC drawings, Change Orders and Site Instructions issued after the issuance of the IFC drawings, and on information provided by the Contractor. This drawing is intended for general guidance only; no guarantee is given of its accuracy.

No.	Description	Date
3	Issued for DP	Mar 1/21
1	Issued for DP	Nov 6/20
1	Issued for DP	May 22/20

Copyright Reserved. This drawing is and remains at all times the exclusive property of Hapa Collaborative and cannot be used modified or copied without the expressed written consent of the landscape architect.

Harris Green Village
1045 Yates Street
Victoria, BC

Materials Plan
Level 4

Date	May. 22/20	Drawing Number
Project No.	1932	L1.13
Scale	1:200	
Drawn|Checked	kw | gc | JF	

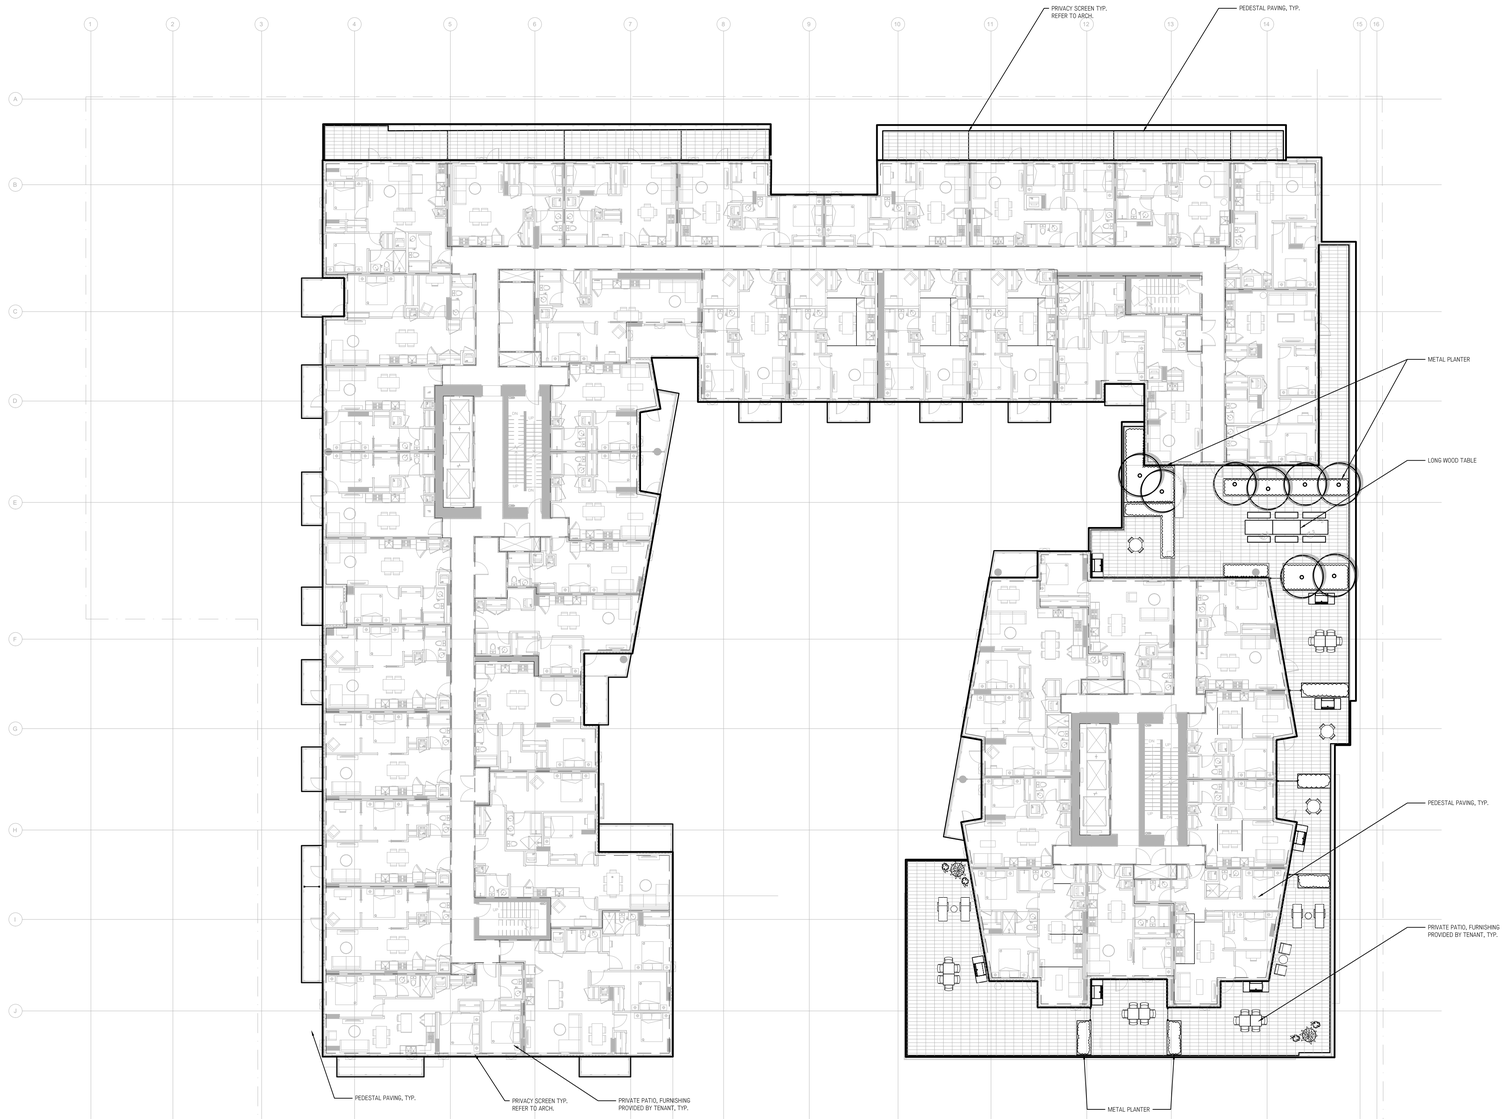

HAPA COLLABORATIVE
Landscape Architecture
Urban Design
403 - 375 West Fifth Avenue
Vancouver BC, V6Y 1J6
604 909 4150
hapacobo.com

Information on this Record Drawing regarding the locations of landscape architectural features is based on the IFC drawings, Change Orders and Site Instructions issued after the issuance of the IFC drawings, and on information provided by the Contractor. This drawing is intended for general guidance only; no guarantee is given of its accuracy.

No.	Description	Date
3	Issued for DP	Mar 1/21
1	Issued for DP	Nov 6/20
1	Issued for DP	May 22/20

Copyright Reserved. This drawing is and remains at all times the exclusive property of Hapa Collaborative and cannot be used modified or copied without the expressed written consent of the landscape architect.

Harris Green Village
1045 Yates Street
Victoria, BC

Materials Plan
Level 5

Date	May. 22/20	Drawing Number
Project No.	1932	L1.14
Scale	1:200	
Drawn|Checked	kw | gc | JF	

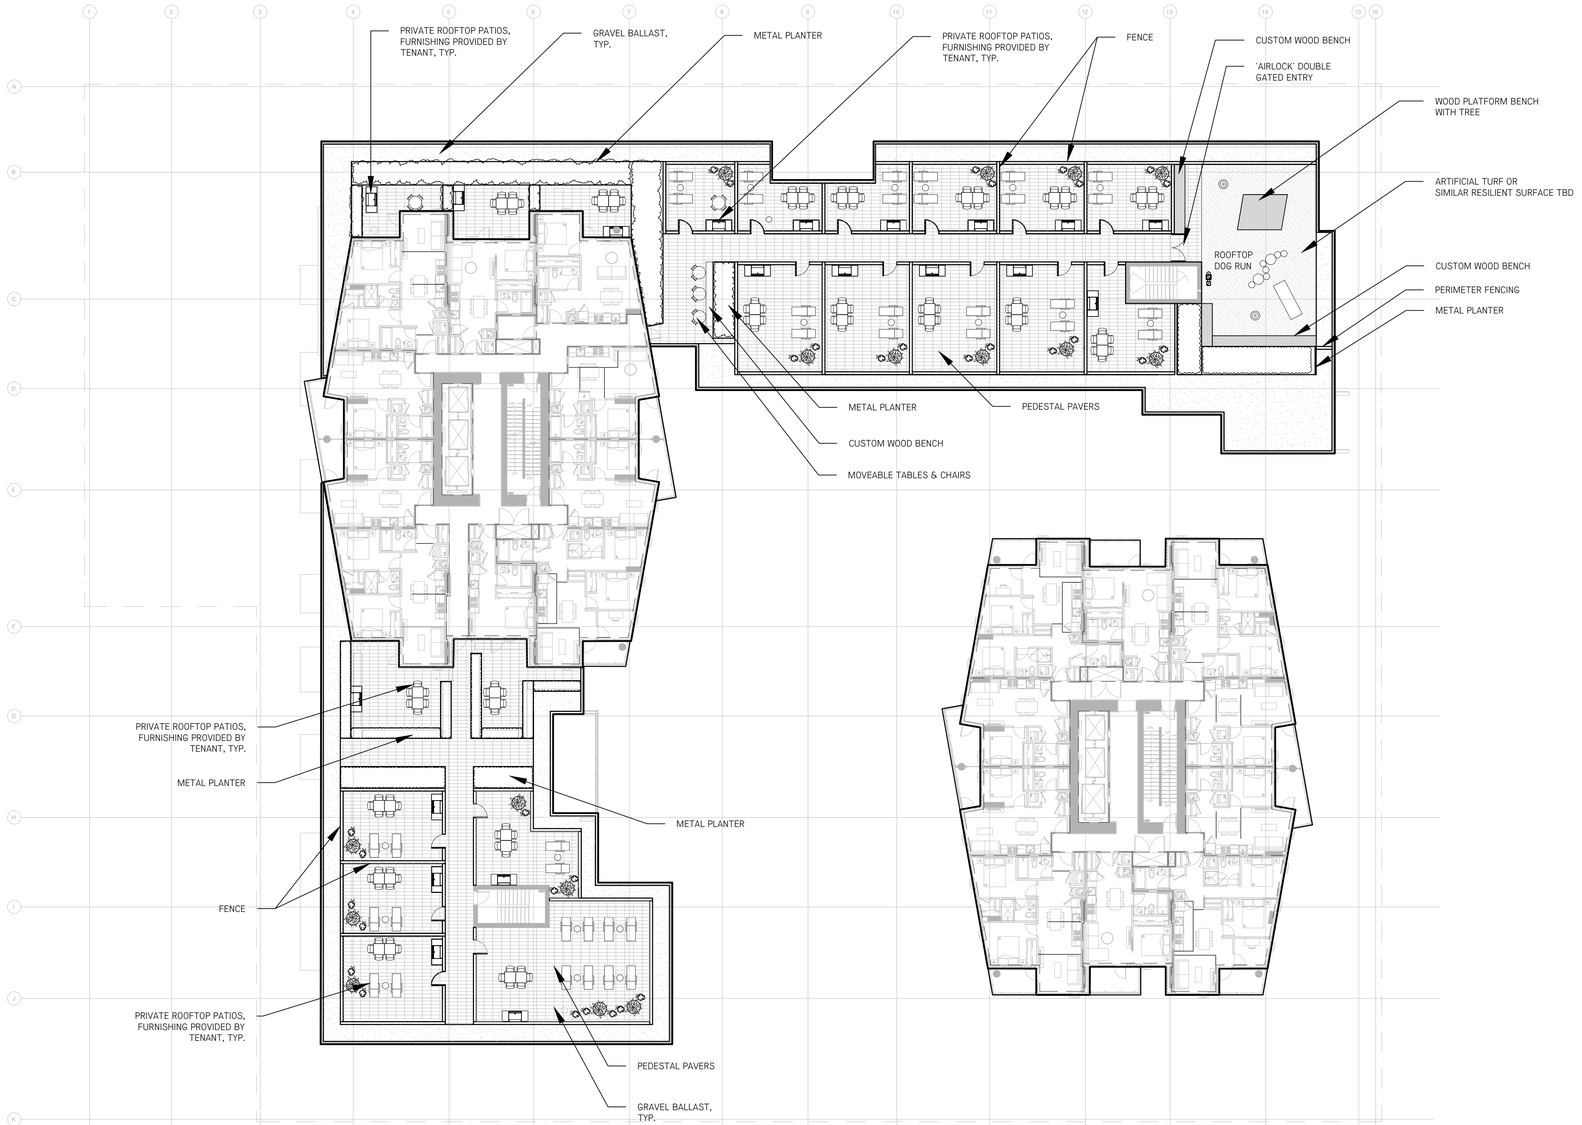

HAPA COLLABORATIVE
Landscape Architecture
Urban Design
403 - 375 West Fifth Avenue
Vancouver BC, V6V 1J6
604 909 4150
hapacobo.com

No.	Description	Date
3	Issued for DP	Mar 1/21
1	Issued for DP	Nov 6/20
1	Issued for DP	May 22/20

Copyright Reserved. This drawing is and remains at all times the exclusive property of Hapa Collaborative and cannot be used modified or copied without the expressed written consent of the landscape architect.

Harris Green Village
1045 Yates Street
Victoria, BC

Materials Plan
Level 6

Date	May. 22/20	Drawing Number
Project No.	1932	L1.15
Scale	1:200	
Drawn|Checked	kw | gc | JF	

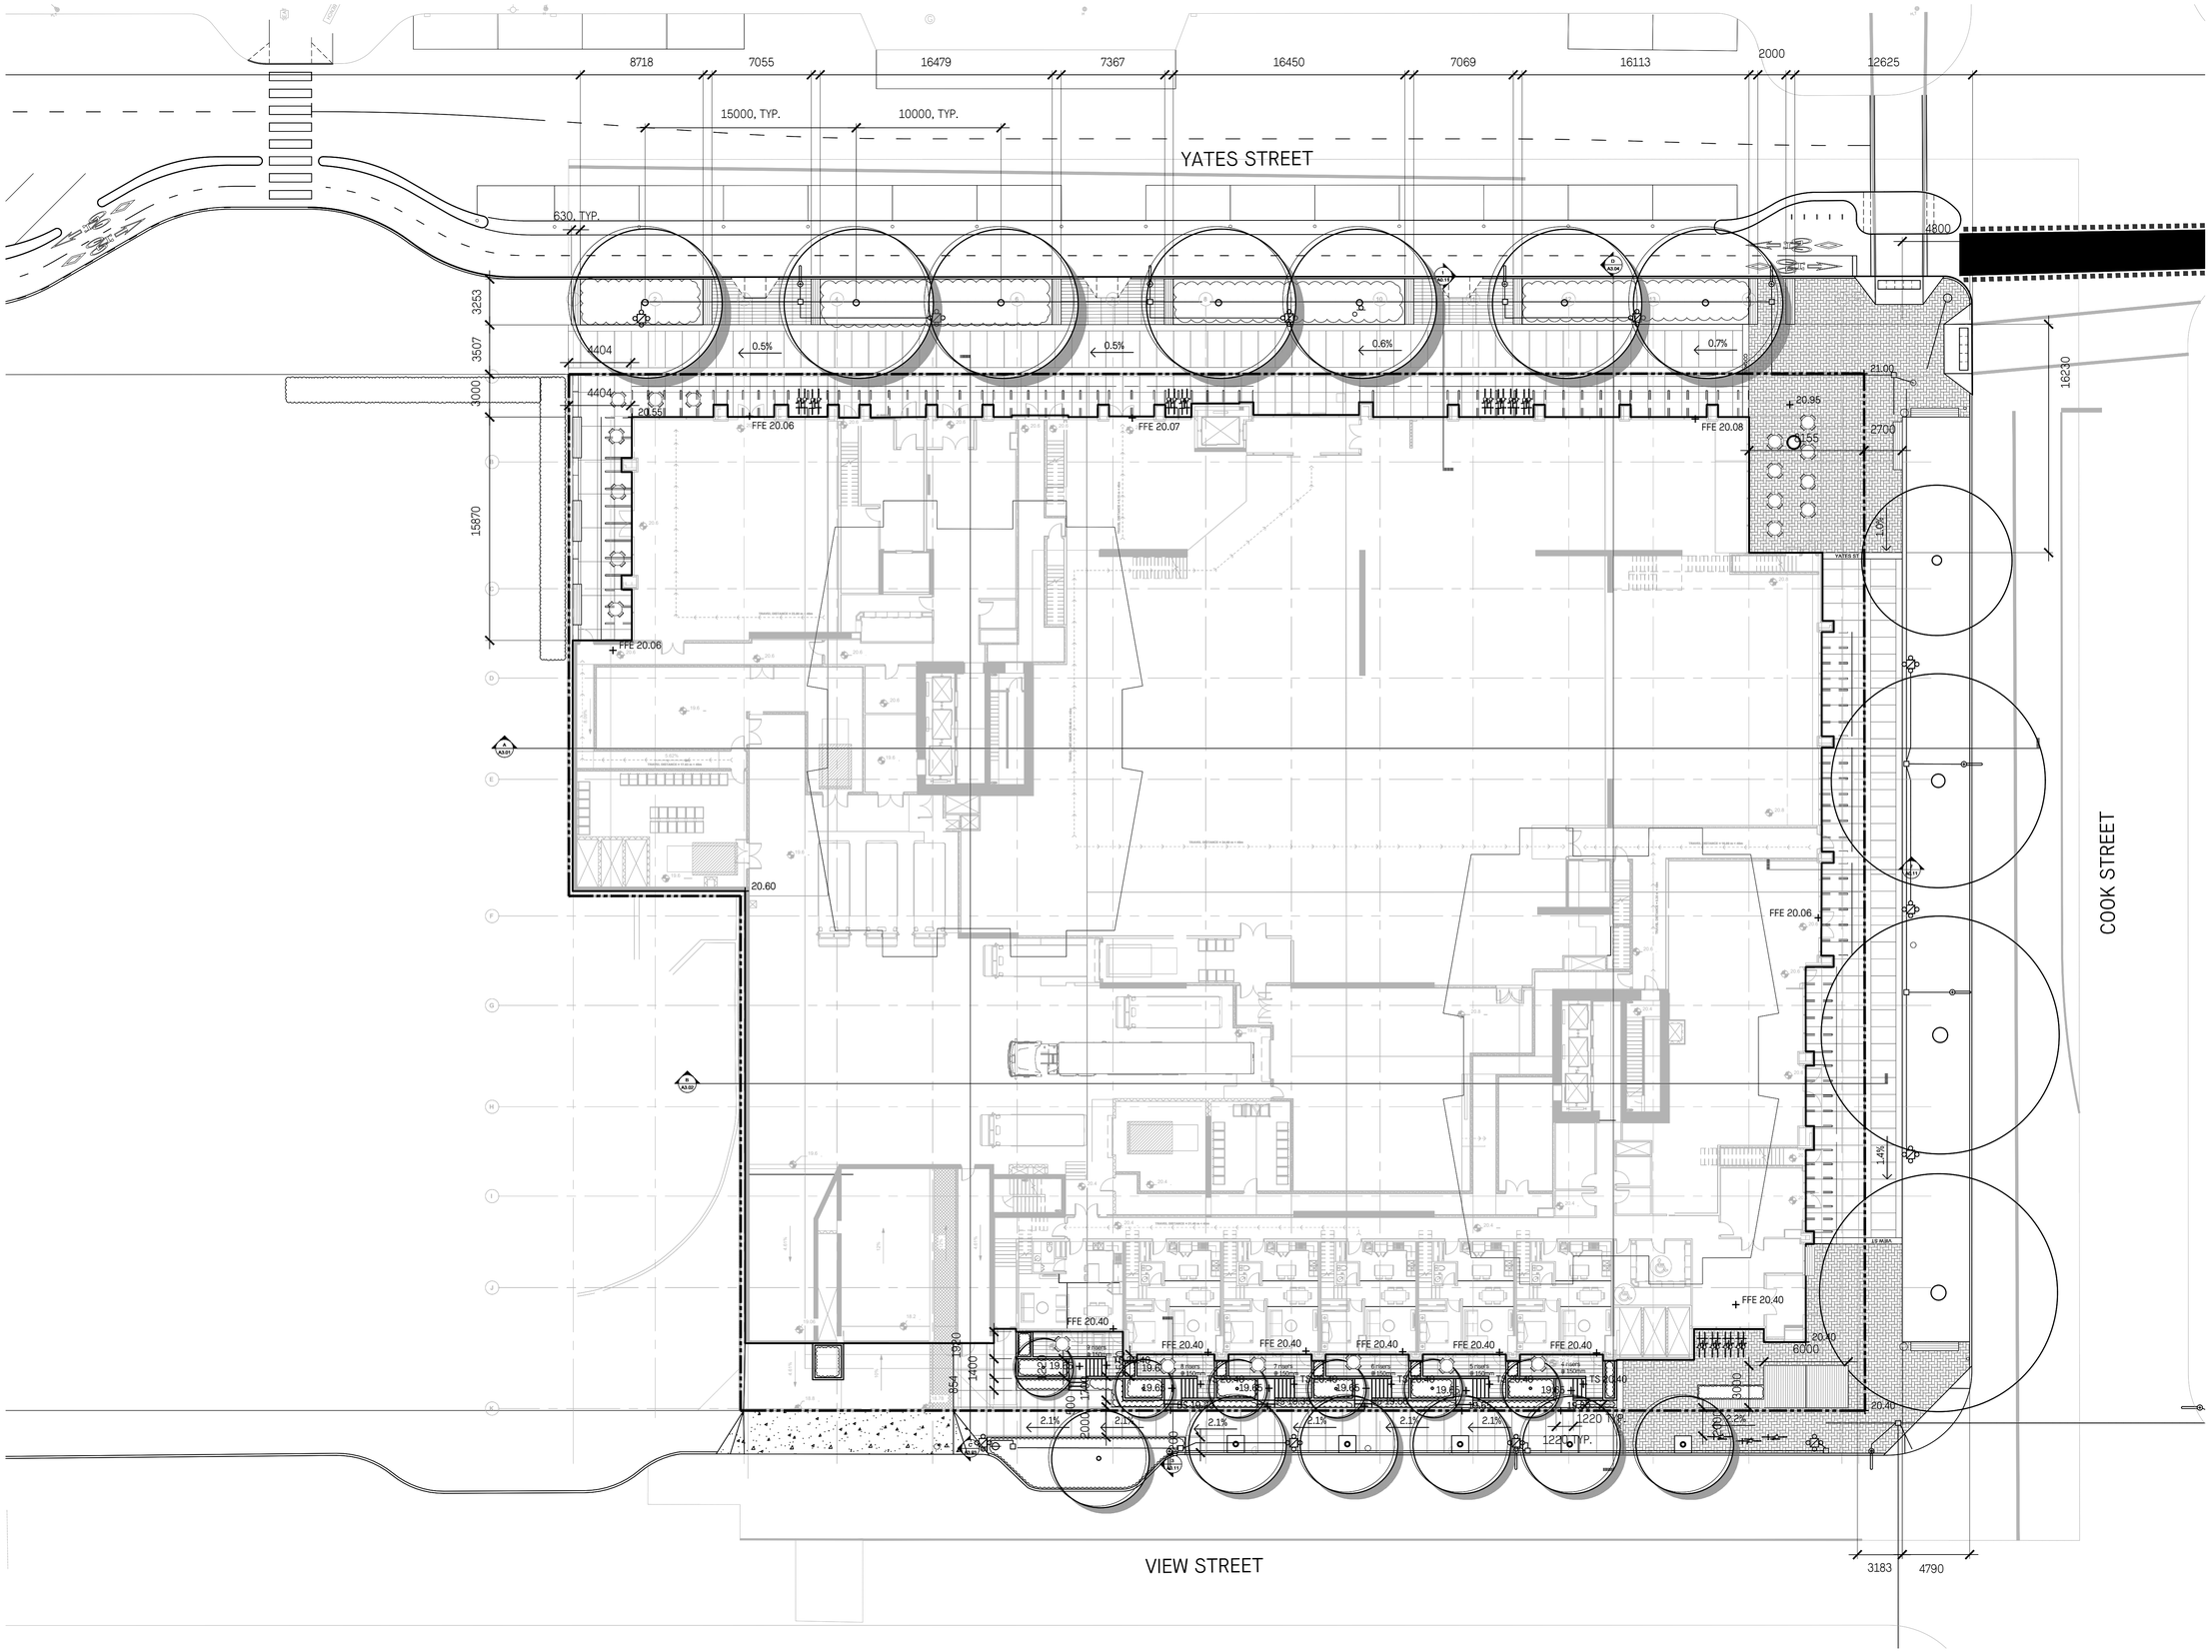

HAPA COLLABORATIVE

Landscape Architecture
Urban Design

403 - 375 West Fifth Avenue
Vancouver BC, V6Y 1J6

604 909 4150
hapacobo.com

No.	Description	Date
	Issued for DP	Mar 1/21
	Issued for DP	Nov 6/20
	Issued for DP	May 22/20

Copyright Reserved. This drawing is and remains at all times the exclusive property of Hapa Collaborative and cannot be used modified or copied without the expressed written consent of the landscape architect.

Harris Green Village

1045 Yates Street
Victoria, BC

Layout Plan

Level 1

Date	May. 22/20	Drawing Number
Project No.	1932	L1.21
Scale	1:200	
Drawn|Checked	kw | gc | JF	

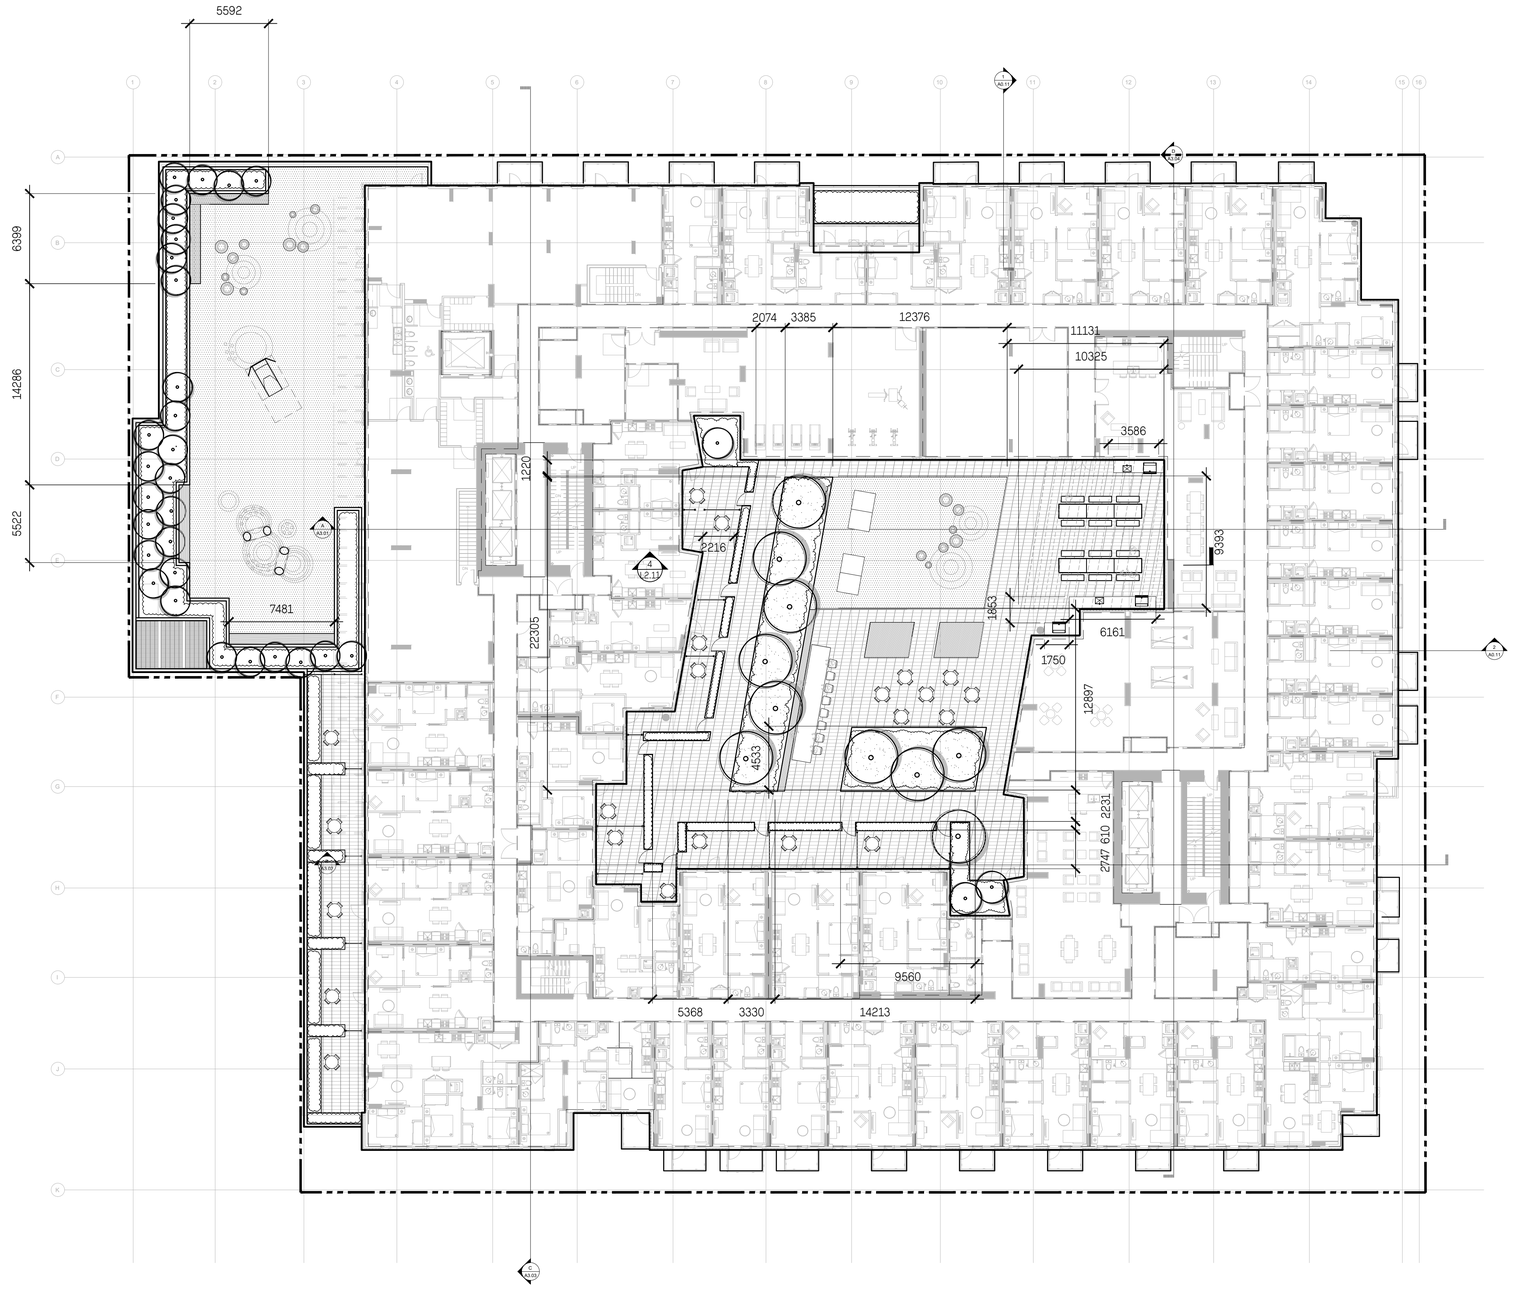

HAPA COLLABORATIVE

Landscape Architecture
Urban Design

403 - 375 West Fifth Avenue
Vancouver BC, V6Y 1J6

604 909 4150
hapacobo.com

Information on this Record Drawing regarding the locations of landscape architectural features is based on the IFC drawings, Change Orders and Site Instructions issued after the issuance of the IFC drawings, and on information provided by the Contractor. This drawing is intended for general guidance only; no guarantee is given of its accuracy.

No.	Description	Date
3	Issued for DP	Mar 1/21
1	Issued for DP	Nov 6/20
1	Issued for DP	May 22/20

Copyright Reserved. This drawing is and remains at all times the exclusive property of Hapa Collaborative and cannot be used modified or copied without the expressed written consent of the landscape architect.

Harris Green Village
1045 Yates Street
Victoria, BC

Layout Plan
Level 2

Date	May. 22/20
Project No.	1932
Scale	1:200
Drawn|Checked	kw | gc | JF

Drawing Number
L1.22

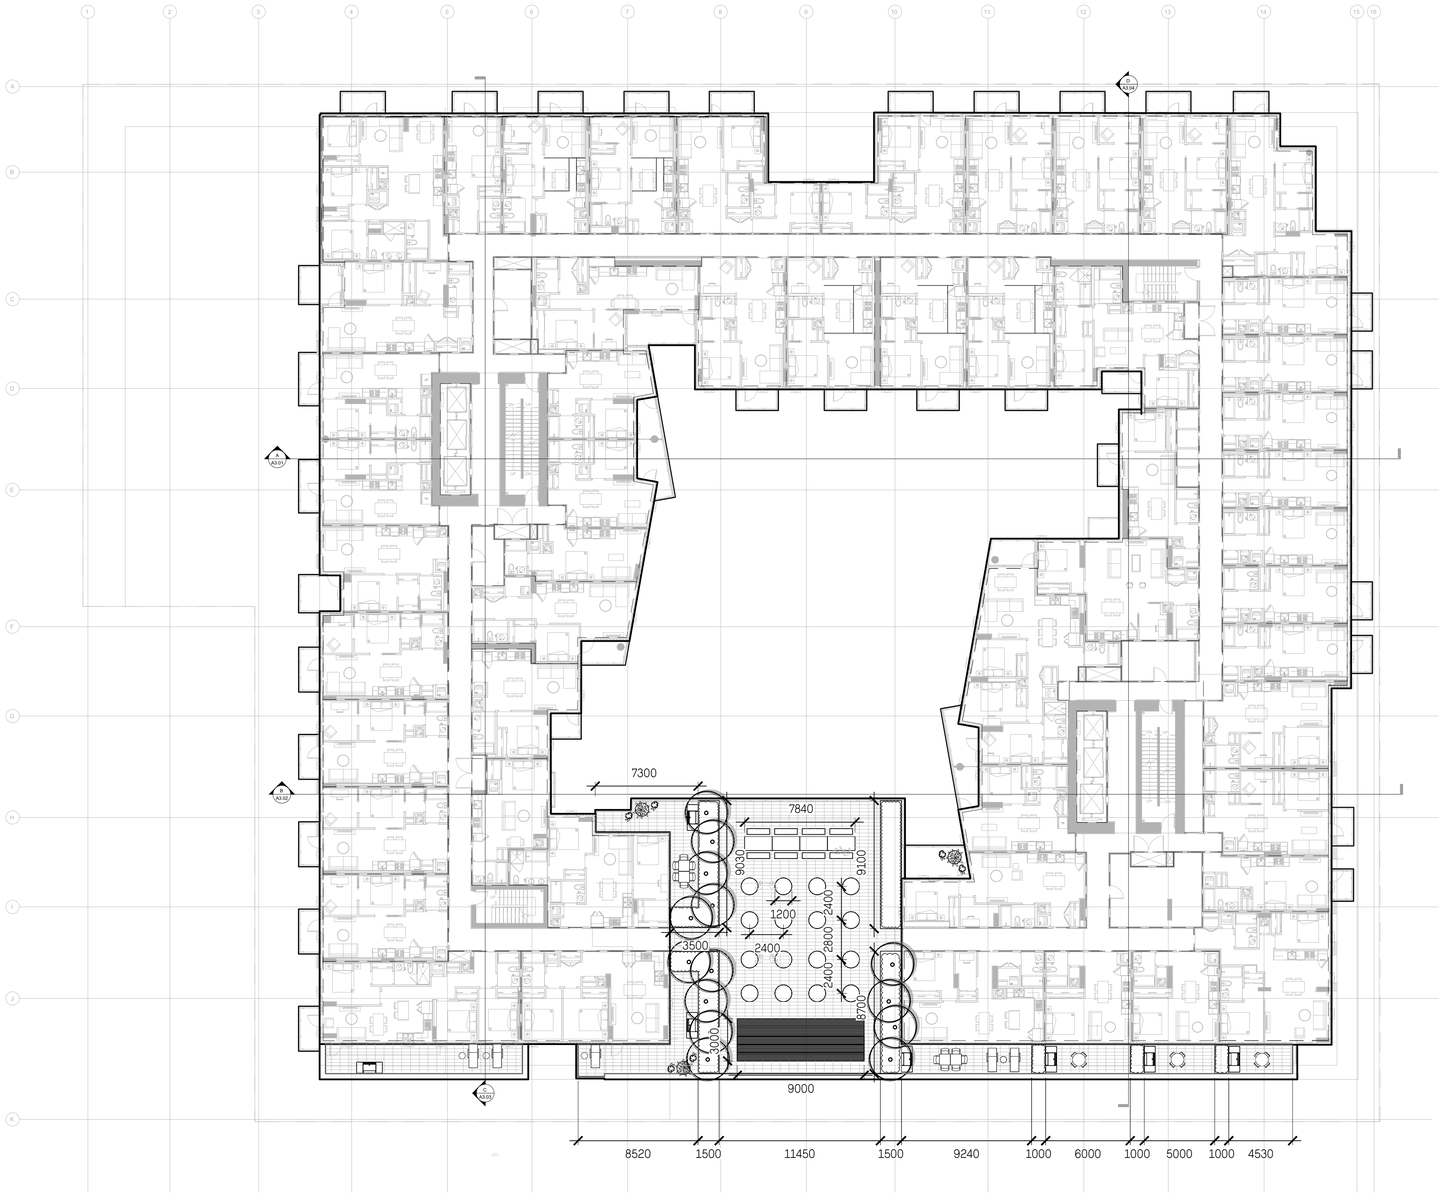

HAPA COLLABORATIVE
Landscape Architecture
Urban Design
403 - 375 West Fifth Avenue
Vancouver BC, V6Y 1J6
604 909 4150
hapacobo.com

No.	Description	Date
3	Issued for DP	Mar 1/21
1	Issued for DP	Nov 6/20
1	Issued for DP	May 22/20

Copyright Reserved. This drawing is and remains at all times the exclusive property of Hapa Collaborative and cannot be used modified or copied without the expressed written consent of the landscape architect.

Harris Green Village
1045 Yates Street
Victoria, BC

Layout Plan
Level 4

Date	May. 22/20	Drawing Number
Project No.	1932	L1.23
Scale	1:200	
Drawn|Checked	kw | gc | JF	

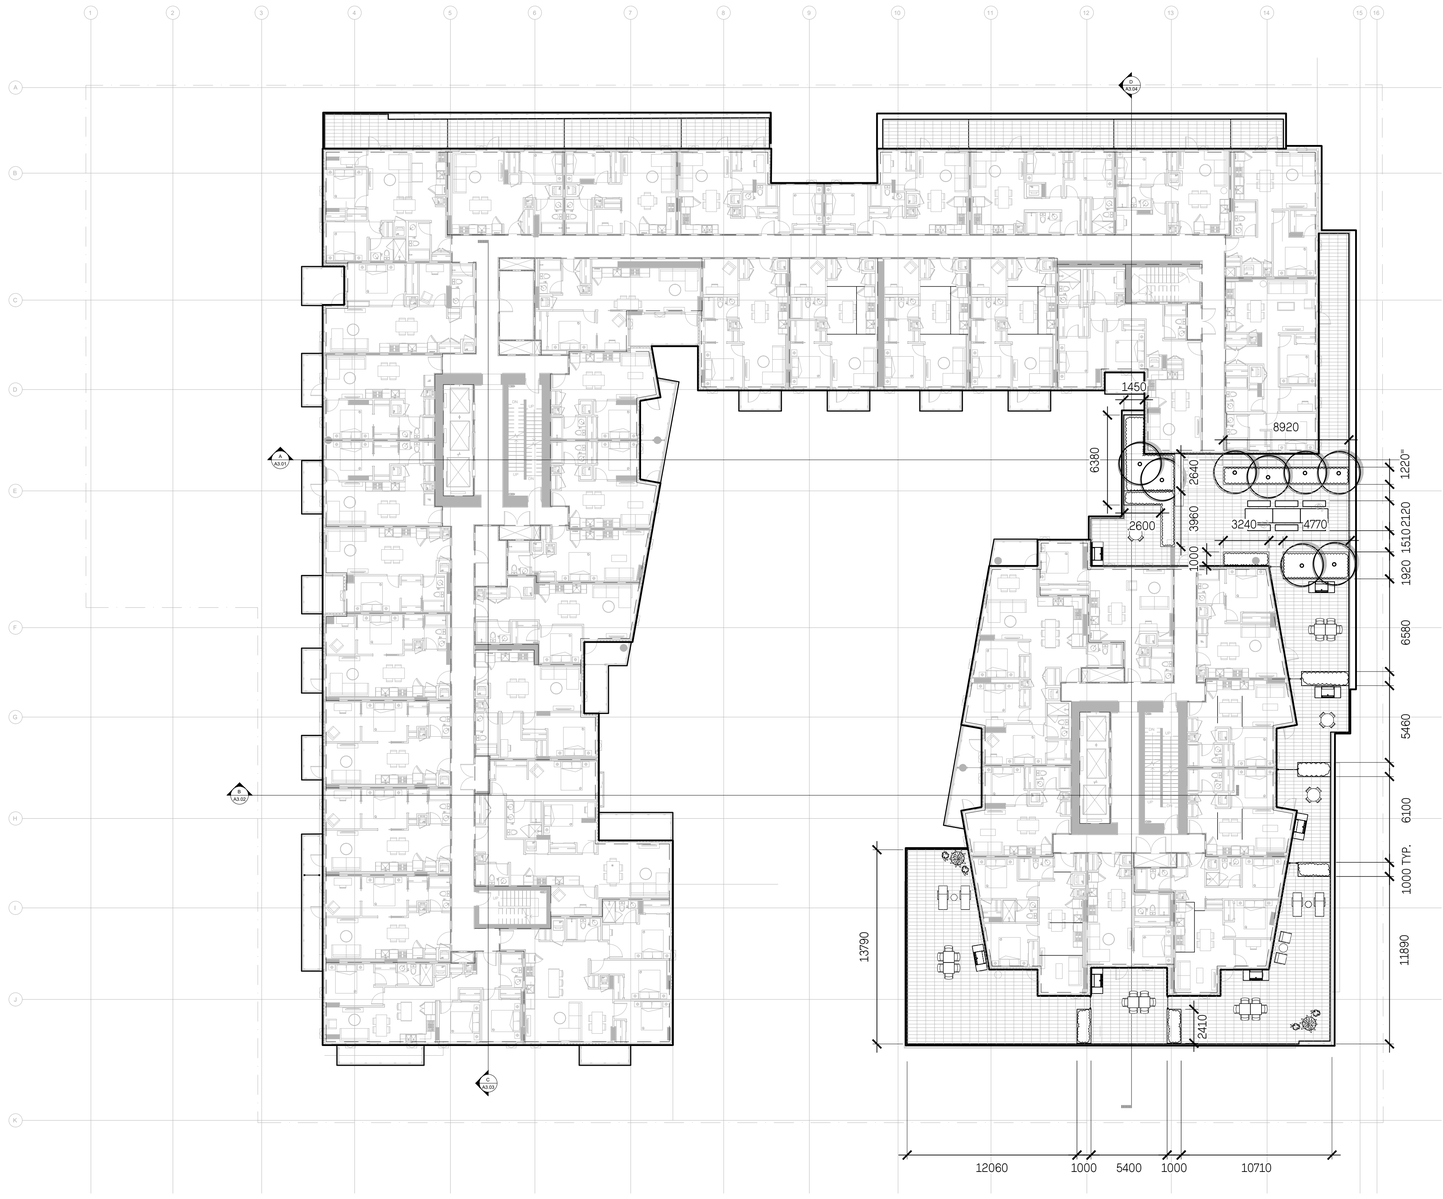

HAPA COLLABORATIVE
Landscape Architecture
Urban Design
403 - 375 West Fifth Avenue
Vancouver BC, V6Y 1J6
604 909 4150
hapacobo.com

No.	Description	Date
3	Issued for DP	Mar 1/21
1	Issued for DP	Nov 6/20
1	Issued for DP	May 22/20

Copyright Reserved. This drawing is and remains at all times the exclusive property of Hapa Collaborative and cannot be used modified or copied without the expressed written consent of the landscape architect.

Harris Green Village
1045 Yates Street
Victoria, BC

Layout Plan
Level 5

Date	May. 22/20
Project No.	1932
Scale	1:200
Drawn|Checked	kw | gc | JF

Drawing Number
L1.24

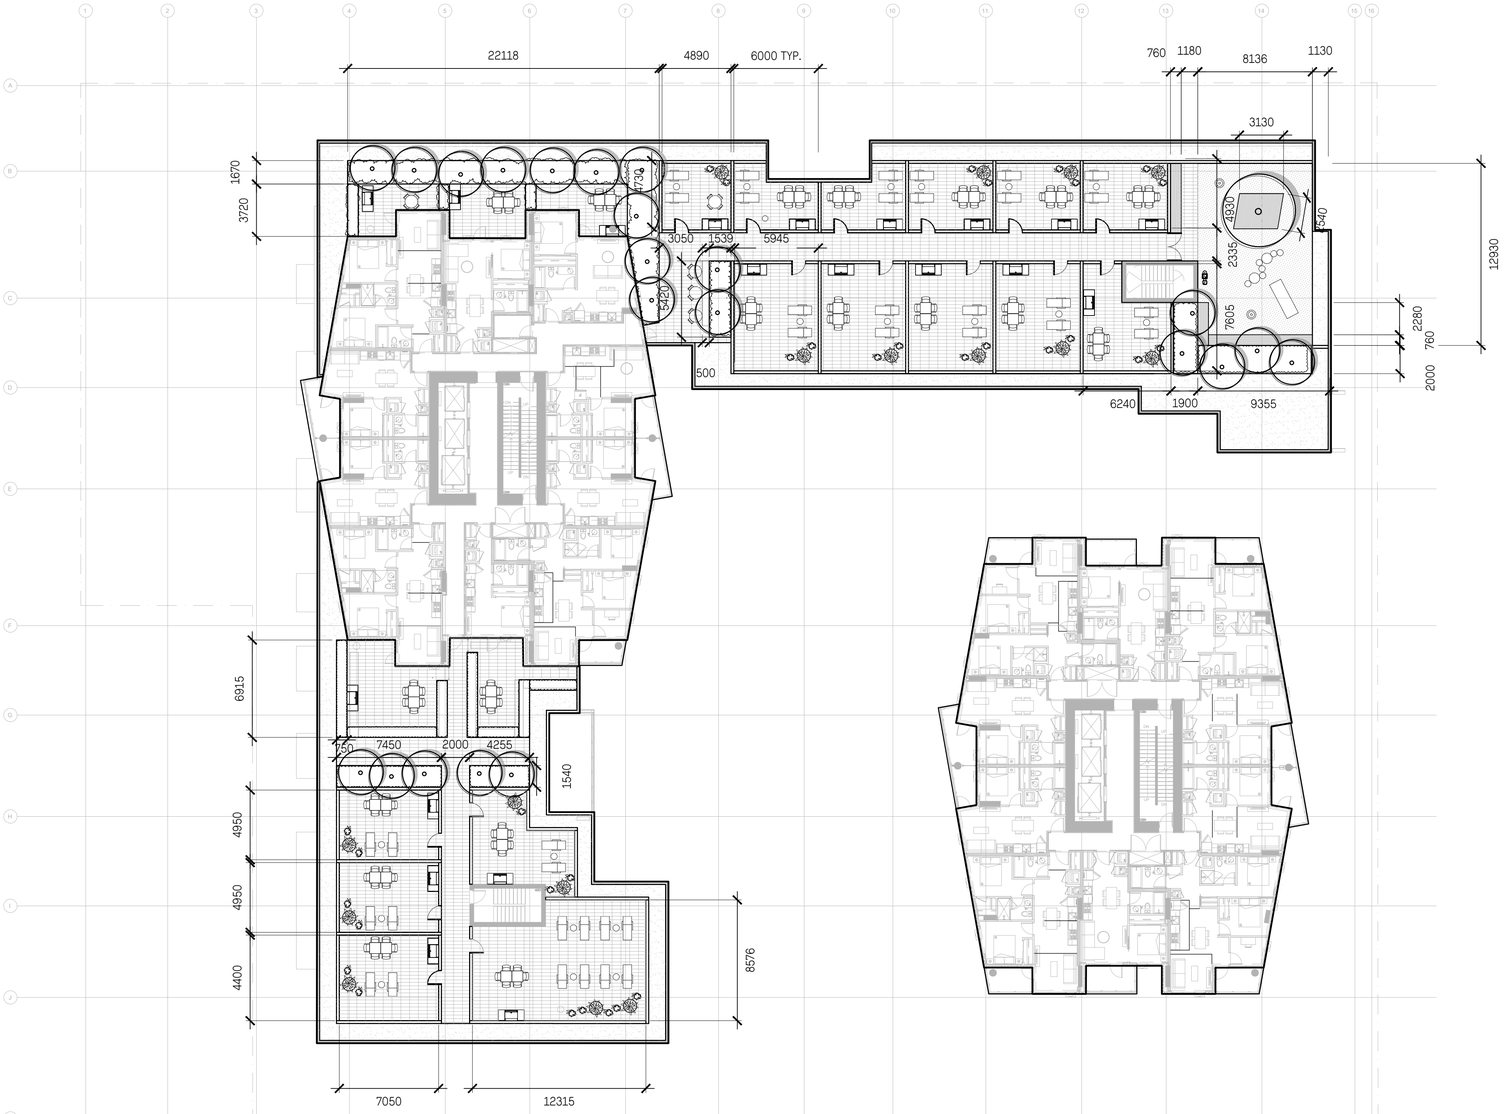

HAPA COLLABORATIVE

Landscape Architecture
Urban Design

403 - 375 West Fifth Avenue
Vancouver BC, V5Y 1J6

604 909 4150
hapacobo.com

No.	Description	Date
3	Issued for DP	Mar 1/21
1	Issued for DP	Nov 6/20
1	Issued for DP	May 22/20

Copyright Reserved. This drawing is and remains at all times the exclusive property of Hapa Collaborative and cannot be used modified or copied without the expressed written consent of the landscape architect.

Harris Green Village
1045 Yates Street
Victoria, BC

Layout Plan
Level 6

Date	May. 22/20	Drawing Number
Project No.	1932	L1.25
Scale	1:200	
Drawn|Checked	kw | gc | JF	

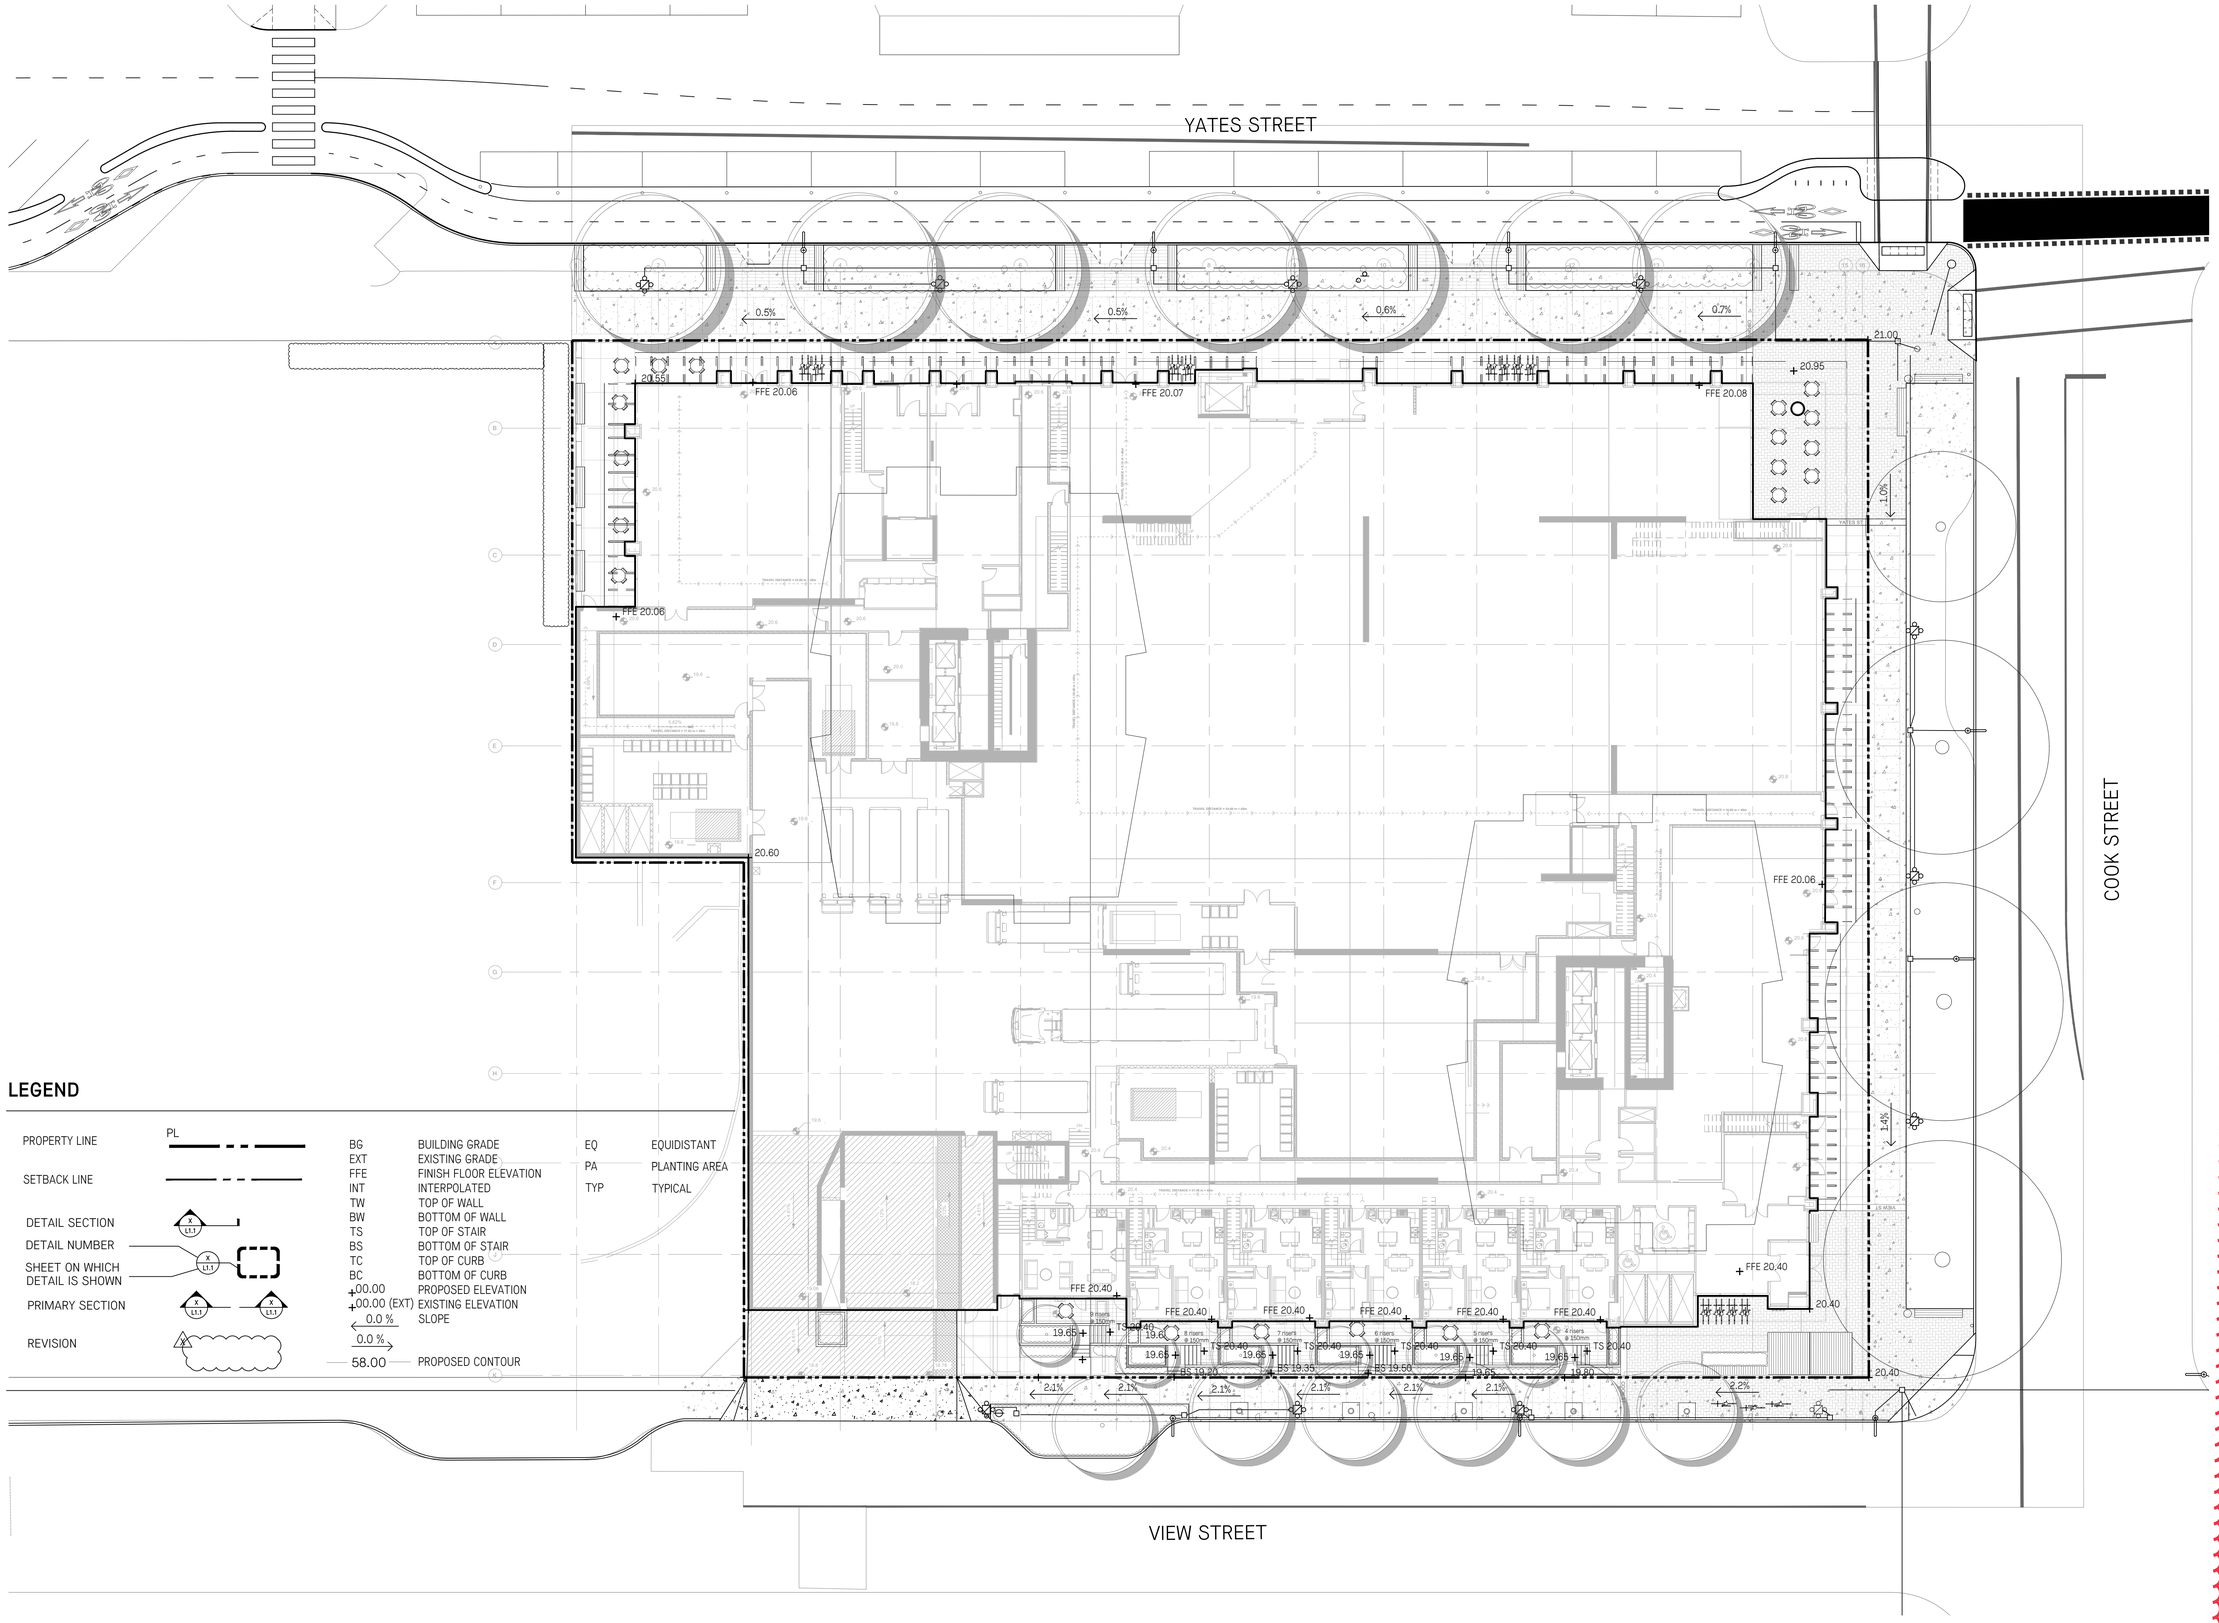

LEGEND

PROPERTY LINE	PL	BG	BUILDING GRADE	EQ	EQUIDISTANT
SETBACK LINE		EXT	EXISTING GRADE	PA	PLANTING AREA
		FFE	FINISH FLOOR ELEVATION	TYP	TYPICAL
		INT	INTERPOLATED		
		TW	TOP OF WALL		
		BW	BOTTOM OF WALL		
		TS	TOP OF STAIR		
		BS	BOTTOM OF STAIR		
		TC	TOP OF CURB		
		BC	BOTTOM OF CURB		
		+00.00	PROPOSED ELEVATION		
		+00.00 (EXT)	EXISTING ELEVATION		
		0.0 %	SLOPE		
DETAIL SECTION	X L1.1	0.0 %			
DETAIL NUMBER		58.00	PROPOSED CONTOUR		
SHEET ON WHICH DETAIL IS SHOWN	X L1.1				
PRIMARY SECTION	X L1.1 X L1.1				
REVISION	1				

HAPA COLLABORATIVE
Landscape Architecture
Urban Design
403 - 375 West Fifth Avenue
Vancouver BC, V5Y 1J6
604 909 4150
hapacobo.com

No.	Description	Date
3	Issued for DP	Mar 1/21
2	Issued for DP	Nov 6/20
1	Issued for DP	May 22/20

Copyright Reserved. This drawing is and remains at all times the exclusive property of Hapa Collaborative and cannot be used modified or copied without the expressed written consent of the landscape architect.

Harris Green Village
1045 Yates Street
Victoria, BC

Grading Plan
Level 1

Date	May. 22/20
Project No.	1932
Scale	1:200
Drawn|Checked	kw | gc | JF

Drawing Number
L1.31

TREES

PERENNIALS, FERNS, AND GRASSES

Cornus kousa 'satomi'/ Red Kousa Dogwood

Miscanthus Sinensis 'Morning Light'/ Eulalia Grass

Liriope gigantea / Giant Liriope

Polystichum munitum/ Western Sword Fern

SHRUBS

Salix purpurea 'Nana'/ Dwarf Arctic Willow

Lonicera pileata/ Privet Honeysuckle

Arctostaphylos uva ursi/ Kinnikinnick

Iris japonica/ Japanese Iris

Ceanothus thyrsiflorus/ Blue Blossom

Spiraea japonica/ Japanese Spirea

PLANT SCHEDULE - LEVEL 1

TREES	CODE	QTY	BOTANICAL / COMMON NAME	SIZE	SPACING	COMMENTS
	CN	6	Cornus nuttallii `Monarch` / Western Flowering Dogwood `Monarch`	5cm cal.	As Shown	B&B, Well Branched, Dens
	COV	13	Species TBD / By City of Victoria Parks	6cm cal.	As Shown	B&B, Specimen, Densly B

SHRUBS	CODE	QTY	BOTANICAL / COMMON NAME	SIZE	SPACING	COMMENTS
	Au	52	Arctostaphylos uva-ursi / Kinnikinnick	1 gal. pot		
	Ij	145	Iris japonica / Japanese Iris	#1 Pot	30cm	Full
	Lp	18	Lonicera pileata / Privet Honeysuckle	#2 Pot	60cm	Full
	Mm	28	Miscanthus sinensis `Morning Light` / Eulalia Grass	#1 Pot	45cm	Full
	Pm	1	Polystichum munitum / Western Sword Fern	1 gal. pot		
	Ct2	92	Ceanothus thyrsiflorus / Blue Blossom	#1 POT		
	Lg	80 118	Liriope gigantea / Giant Liriope	#1 Pot	30cm	Full

YATES STREET

COOK STREET

Le 188.6 m²

COV 7

Lp 8

Lp 12

Ij 123

CN 6

Ct2 92

COV 6

EXISTING STREET TREES (4) TO BE RETAINED

TYPICAL SOIL MEETS VOLUME REQUIREMENTS

VIEW STREET

SOIL CELLS PROPOSED TO MEET SOIL VOLUME REQUIREMENTS

HAPA COLLABORATIVE

604 909 4150
hapacobo.com

403 - 375 West Fifth Avenue
Vancouver BC, V6Y 1J6

Landscape Architecture
Urban Design

Information on this Record Drawing regarding the locations of landscape architectural features is based on the IFC drawings, Change Orders and Site Instructions issued after the issuance of the IFC drawings, and on information provided by the Contractor. This drawing is intended for general guidance only; no guarantee is given of its accuracy.

No.	Description	Date
3	Issued for DP	Mar 1/21
1	Issued for DP	Nov 6/20
1	Issued for DP	May 22/20

Copyright Reserved. This drawing is and remains at all times the exclusive property of Hapa Collaborative and cannot be used modified or copied without the expressed written consent of the landscape architect.

Harris Green Village

1045 Yates Street
Victoria, BC

Planting Plan

Level 1

Date	May. 22/20	Drawing Number	
Project No.	1932		L1.41
Scale	1:200		
Drawn|Checked	kw | gc | JF		

PLANT SCHEDULE - LEVEL 2

TREES	CODE	QTY	BOTANICAL / COMMON NAME	SIZE	SPACING	COMMENTS
	AC	2	Acer circinatum / Vine Maple	3.0m ht.	As Shown	B&B, Multi-Stemmed, Dense Tree
	AO	9	Acer palmatum `Osakazuki` / Osakazuki Japanese Maple	3.0m ht.	As Shown	B&B, Multi-Stemmed, Dense Tree
	CN	31	Cornus nuttallii `Monarch` / Western Flowering Dogwood `Monarch`	5cm cal.	As Shown	B&B, Well Branched, Dense Tree

SHRUBS	CODE	QTY	BOTANICAL / COMMON NAME	SIZE	SPACING	COMMENTS
	Hm	127	Hakonechloa macra / Japanese Forest Grass	#2 Pot	45cm	Full
	Ho	40	Helleborus orientalis / Lenten Rose	#1 Pot	30cm	Full
	Ij	128	Iris japonica / Japanese Iris	#1 Pot	30cm	Full
	Lp	177	Lonicera pileata / Privet Honeysuckle	#2 Pot	60cm	Full
	Mm	32	Miscanthus sinensis `Morning Light` / Eulalia Grass	#1 Pot	45cm	Full
	Ra	111	Rhododendron x `Hino-white` / White Hino Azalea	1 gal. pot		
	Tx	91	Taxus x media / Dense Yew	1 gal. pot		

VINES	CODE	QTY	BOTANICAL / COMMON NAME	SIZE	SPACING	COMMENTS
	Aq	36	Akebia quinata / Chocolate Vine	#1 Pot	30cm	Well Established
	Ce	56	Clematis armandii / Evergreen Clematis	#1 Pot	30cm	Well Established

Acer palmatum 'osazuki'/ Japanese Maple

Acer circinatum/ Vine Maple

Cornus nutalliii/ Western Flowering Dogwood

HEDGE

Taxus x media/ Yew

SHRUBS

Iris japonica/ Japanese Iris

Lonicera pileata/ Privet Honeysuckle

Ceanothus thyrsiflorus/ Blue Blossom

Rhododendron x 'Hino-white'/ White Hino Azalea

PERENNIALS, FERNS, GRASSES & GROUNDCOVERS

Hakonechloa macra/ Japanese Forest Grass

Helleborus orientalis/ Lenten Rose

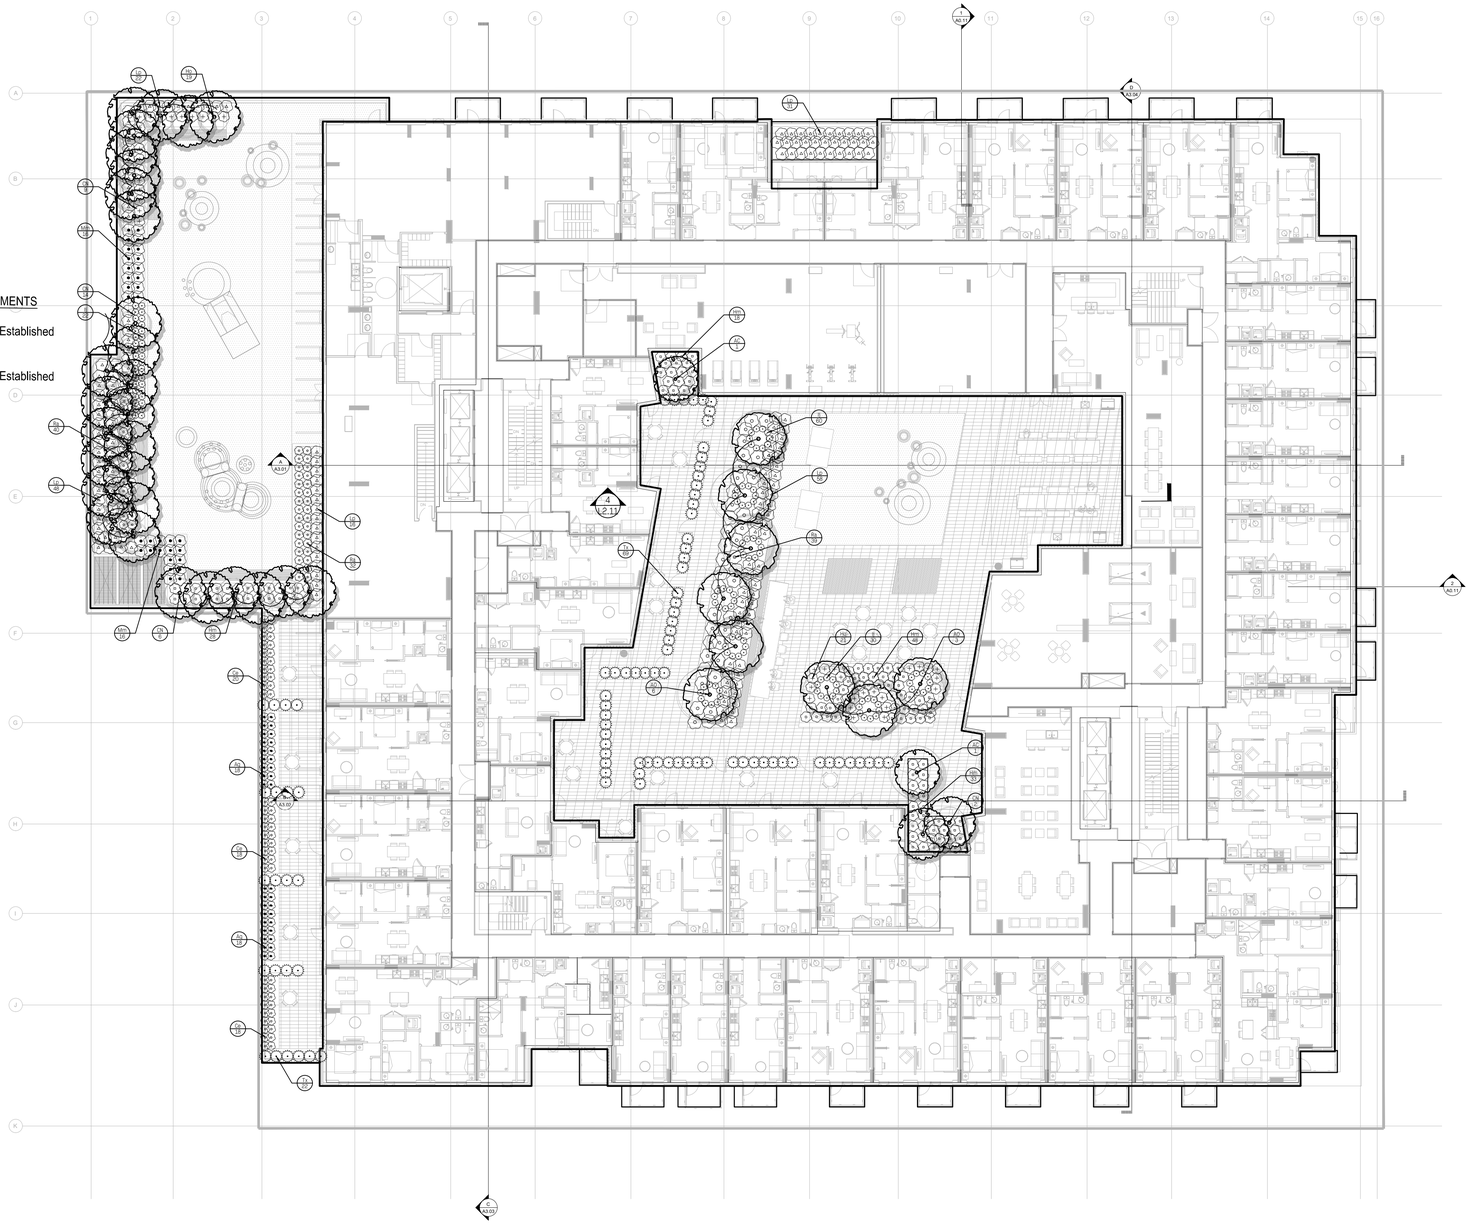

HAPA COLLABORATIVE
Landscape Architecture
Urban Design
403 - 375 West Fifth Avenue
Vancouver BC, V6Y 1J6
604 909 4150
hapacobo.com

No.	Description	Date
3	Issued for DP	Mar 1/21
1	Issued for DP	Nov 6/20
1	Issued for DP	May 22/20

Copyright Reserved. This drawing is and remains at all times the exclusive property of Hapa Collaborative and cannot be used modified or copied without the expressed written consent of the landscape architect.

Harris Green Village
1045 Yates Street
Victoria, BC

Planting Plan
Level 2

Date	May. 22/20	Drawing Number
Project No.	1932	L1.42
Scale	1:200	
Drawn|Checked	kw | gc | JF	

PLANT SCHEDULE

TREES	CODE	QTY	BOTANICAL / COMMON NAME	SIZE	SPACING	COMMENTS
	AC	4	Acer circinatum / Vine Maple	2.4m ht	As Shown	
	CN	10	Cornus nuttallii / Western Flowering Dogwood	5cm cal.	As Shown	B&B, Well Branched, Dense Tree

SHRUBS	CODE	QTY	BOTANICAL / COMMON NAME	SIZE	SPACING	COMMENTS
	Hm	33	Hakonechloa macra / Japanese Forest Grass	1 gal. pot	30cm	
	Lp	44	Lonicera pileata / Privet Honeysuckle	1 gal. pot		
	Ra	32	Rhododendron x `Hino-white` / White Hino Azalea	1 gal. pot		
	Td2	14	Taxus x media / Dense Yew	1 gal. pot		

SHRUB AREAS	CODE	QTY	BOTANICAL / COMMON NAME	SIZE	SPACING	COMMENTS
	Fc	224	Fragaria chiloensis / Beach Strawberry	#1 Pot	30cm	Full

TREES

Acer circinatum/
Vine Maple

Cornus nuttallii/
Western Flowering
Dogwood

HEDGE

Taxus x media/
Yew

SHRUBS

Rhododendron x
'Hino-white'/ White
Hino Azalea

Lonicera pileata/
Privet Honeysuckle

PERENNIALS, FERNS, GRASSES & GROUNDCOVERS

Fragaria
chiloensis/ Beach
Strawberry

Hakonechloa
macra/ Japanese
Forest Grass

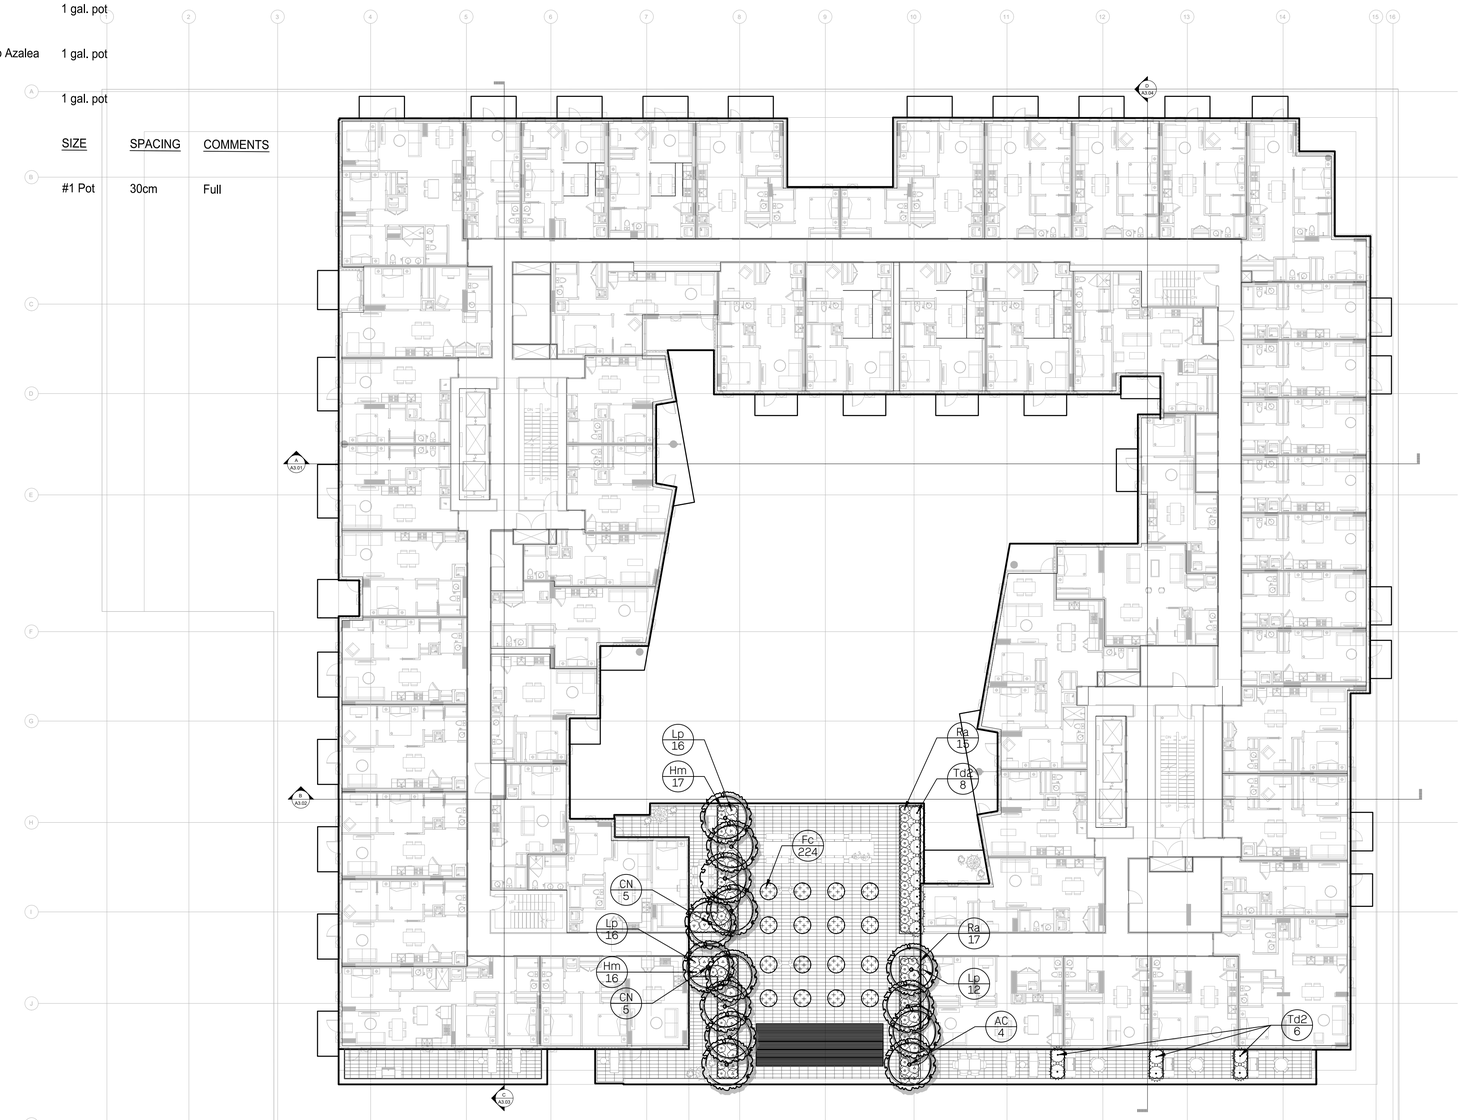

HAPA COLLABORATIVE
Landscape Architecture
Urban Design
403 - 375 West Fifth Avenue
Vancouver BC, V5Y 1J6
604 909 4150
hapacobo.com

No.	Description	Date
3	Issued for DP	Mar 1/21
1	Issued for DP	Nov 6/20
1	Issued for DP	May 22/20

Copyright Reserved. This drawing is and remains at all times the exclusive property of Hapa Collaborative and cannot be used modified or copied without the expressed written consent of the landscape architect.

Harris Green Village
1045 Yates Street
Victoria, BC

Planting Plan
Level 4

Date	May. 22/20	Drawing Number
Project No.	1932	L1.43
Scale	1:200	
Drawn|Checked	kw | gc | JF	

PLANT SCHEDULE

TREES	CODE	QTY	BOTANICAL / COMMON NAME	SIZE	SPACING	COMMENTS
	AC	6	Acer circinatum / Vine Maple	2.4m ht	As Shown	
	CN	2	Cornus nuttallii / Western Flowering Dogwood	5cm cal.	As Shown	B&B, Well Branched, Dense Tree

SHRUBS	CODE	QTY	BOTANICAL / COMMON NAME	SIZE	SPACING	COMMENTS
	Hm	13	Hakonechloa macra / Japanese Forest Grass	1 gal. pot	30cm	
	Ra	15	Rhododendron x `Hino-white` / White Hino Azalea	1 gal. pot		
	Td2	25	Taxus x media / Dense Yew	1 gal. pot		

TREES

Acer circinatum/
Vine Maple

Cornus nuttallii/
Western Flowering
Dogwood

HEDGE

Taxus x media/
Yew

SHRUBS

Rhododendron x
'Hino-white'/ White
Hino Azalea

Lonicera pileata/
Privet Honeysuckle

PERENNIALS, FERNS, GRASSES & GROUNDCOVERS

Fragaria
chiloensis/ Beach
Strawberry

Hakonechloa
macra/ Japanese
Forest Grass

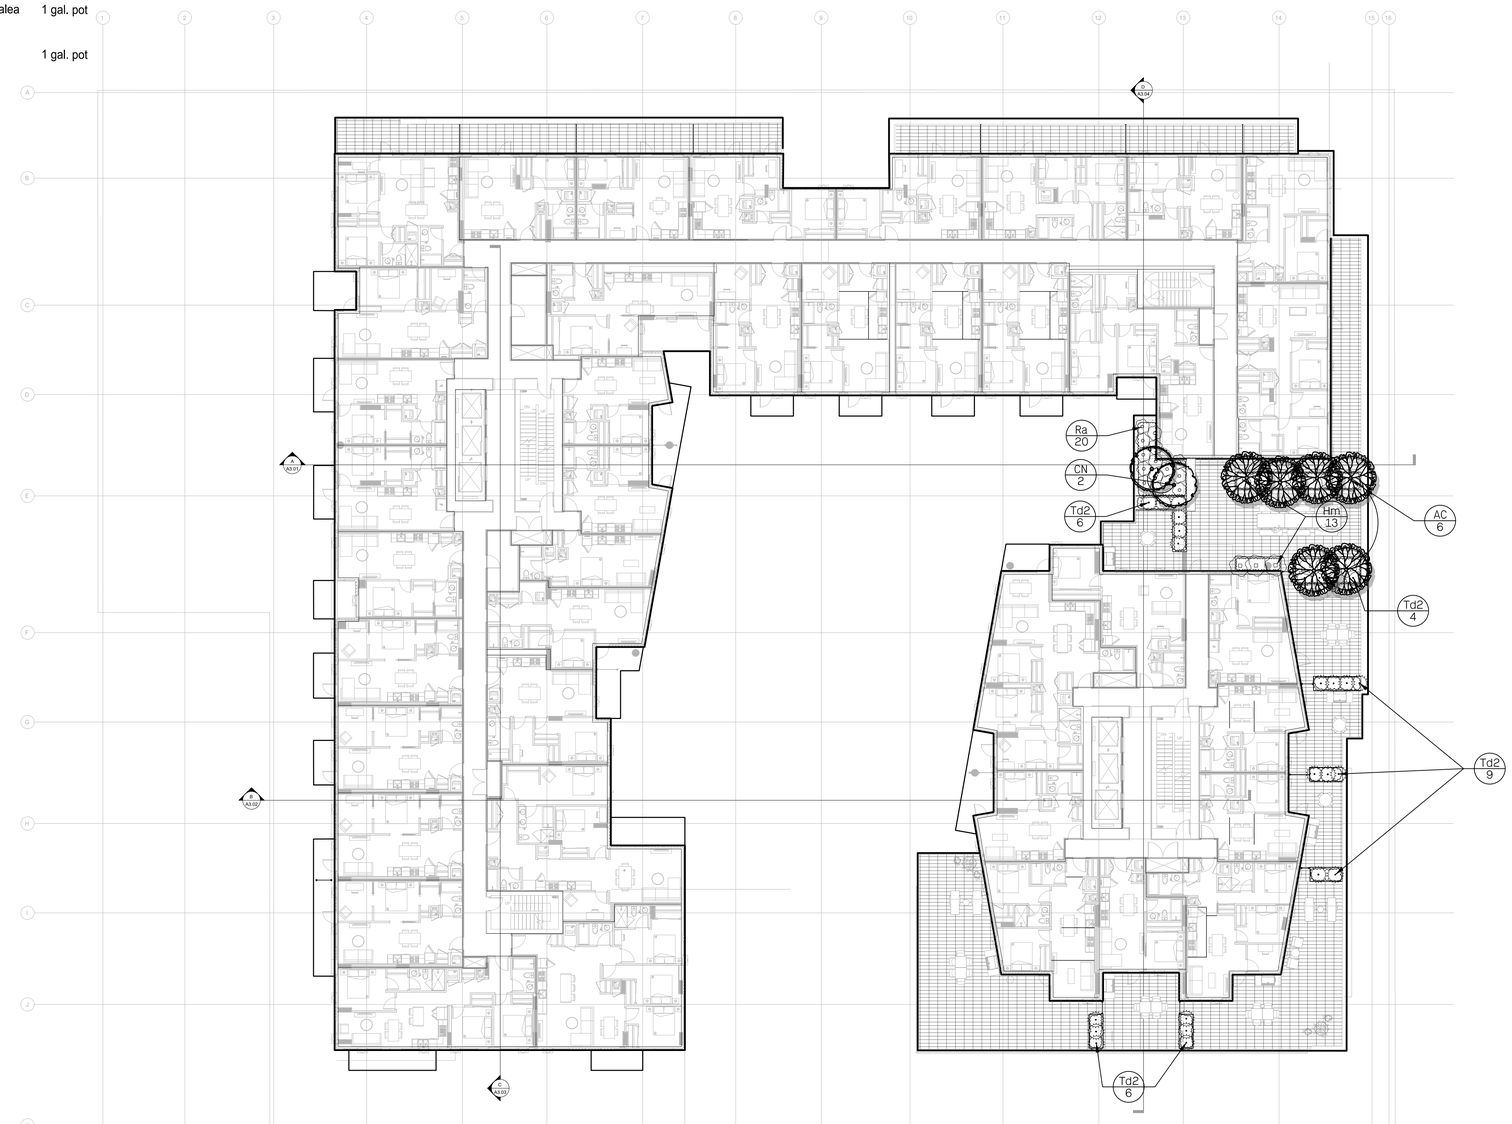

HAPA COLLABORATIVE
Landscape Architecture
Urban Design
403 - 375 West Fifth Avenue
Vancouver BC, V6Y 1J6
604 909 4150
hapacobo.com

No.	Description	Date
3	Issued for DP	Mar 1/21
1	Issued for DP	Nov 6/20
1	Issued for DP	May 22/20

Copyright Reserved. This drawing is and remains at all times the exclusive property of Hapa Collaborative and cannot be used modified or copied without the expressed written consent of the landscape architect.

Harris Green Village
1045 Yates Street
Victoria, BC

Planting Plan
Level 5

Date	May. 22/20	Drawing Number
Project No.	1932	L1.44
Scale	1:200	
Drawn|Checked	kw | gc | JF	

PLANT SCHEDULE

TREES	CODE	QTY	BOTANICAL / COMMON NAME	SIZE	SPACING	COMMENTS
	AO	1	Acer palmatum `Osakazuki` / Osakazuki Japanese Maple	2.4m ht	As Shown	
	CN	11	Cornus nuttallii / Western Flowering Dogwood	5cm cal.	As Shown	B&B, Well Branched, Dense Tree
	NT	10	Nyssa sylvatica `Haymanred` / Sour Gum	6cm cal.	As Shown	
SHRUBS	**CODE**	**QTY**	**BOTANICAL / COMMON NAME**	**SIZE**	**SPACING**	**COMMENTS**
	Hm	48	Hakonechloa macra / Japanese Forest Grass	1 gal. pot	30cm	
	Lp	27	Lonicera pileata / Privet Honeysuckle	1 gal. pot		
	Td2	42	Taxus x media / Dense Yew	1 gal. pot		

TREES

Acer palmatum 'osazuki'/ Japanese Maple

Cornus nuttallii/ Western Flowering Dogwood

Nyssa sylvatica 'Haymanred'/ Sour Gum

HEDGE

Taxus x media/ Yew

SHRUB

Lonicera pileata/ Privet Honeysuckle

FERNS, GRASSES & GROUNDCOVERS

Hakonechloa macra/ Japanese Forest Grass

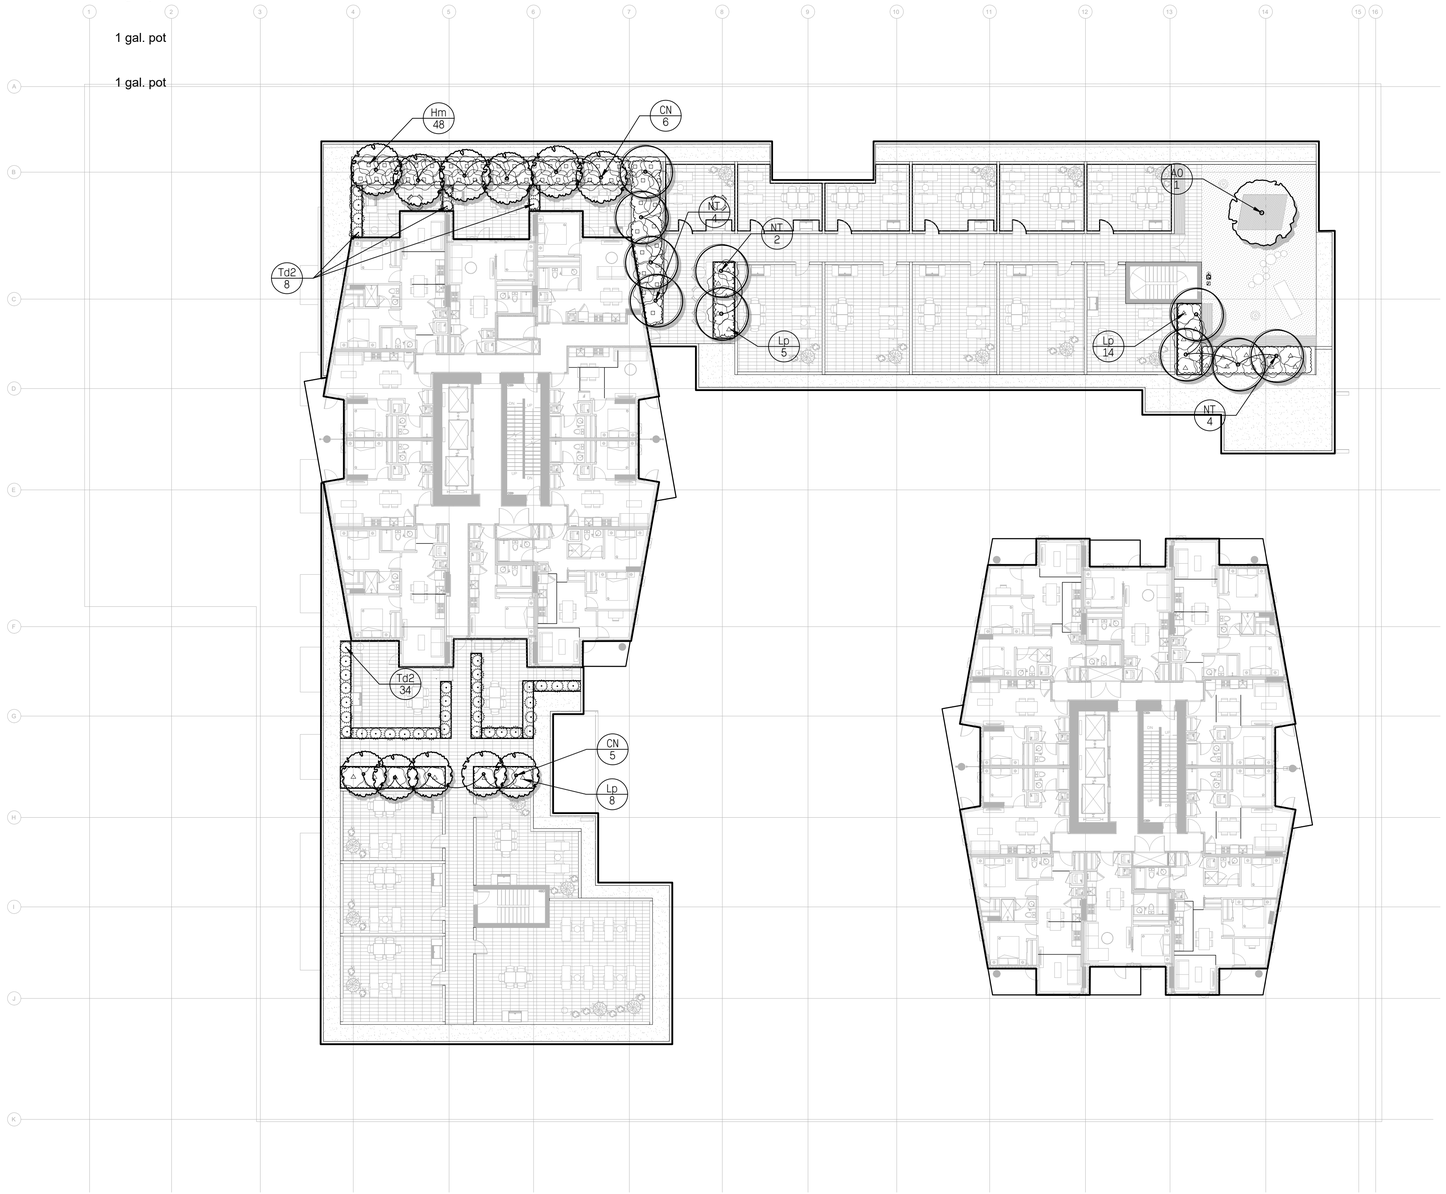

HAPA COLLABORATIVE
Landscape Architecture
Urban Design
403 - 375 West Fifth Avenue
Vancouver BC, V5Y 1J6
604 909 4150
hapacobo.com

No.	Description	Date
3	Issued for DP	Mar 1/21
1	Issued for DP	Nov 6/20
1	Issued for DP	May 22/20

Copyright Reserved. This drawing is and remains at all times the exclusive property of Hapa Collaborative and cannot be used modified or copied without the expressed written consent of the landscape architect.

Harris Green Village
1045 Yates Street
Victoria, BC

Planting Plan
Level 6

Date	May. 22/20
Project No.	1932
Scale	1:200
Drawn|Checked	kw | gc | JF

Drawing Number
L1.45

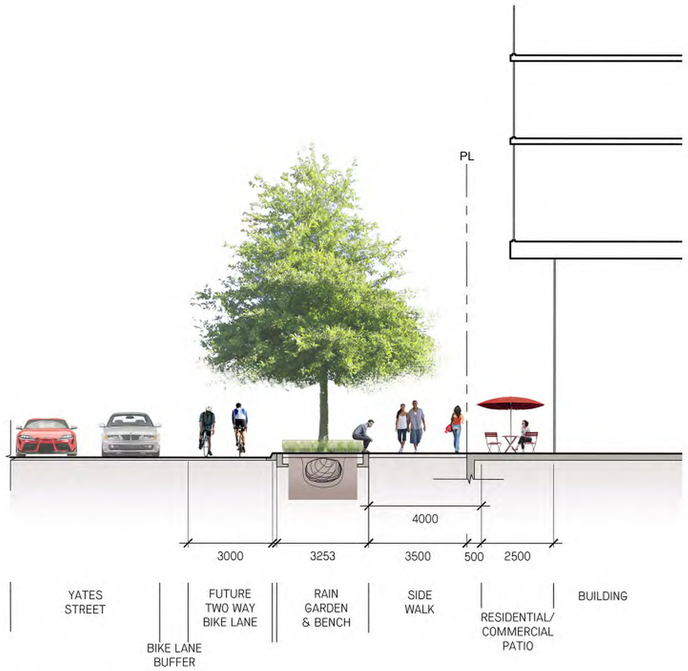

1 L2.11 YATES STREET
1:100

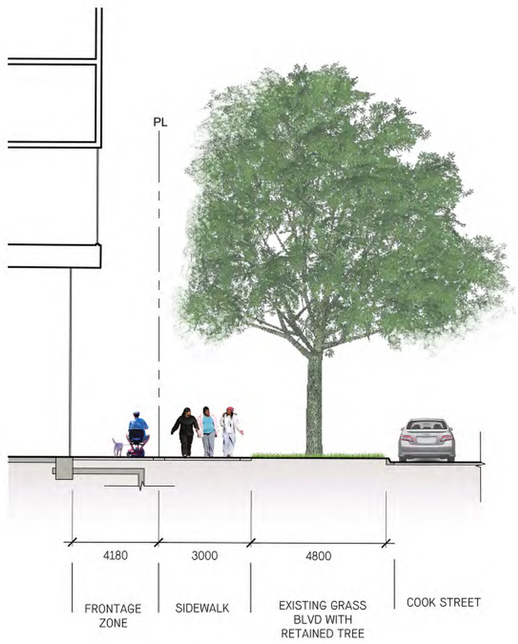

2 L2.11 COOK STREET
1:100

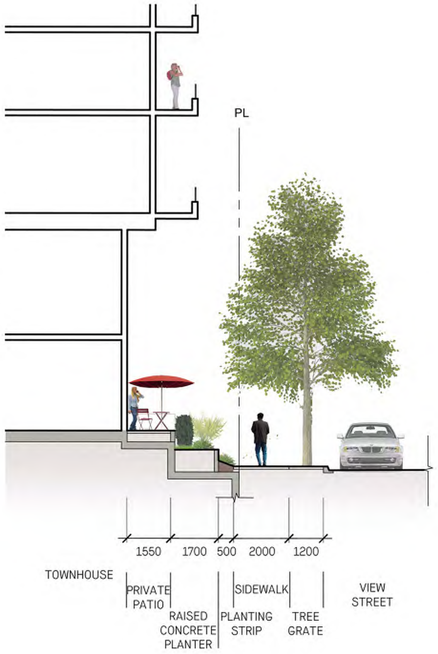

3 L2.11 VIEW STREET
1:100

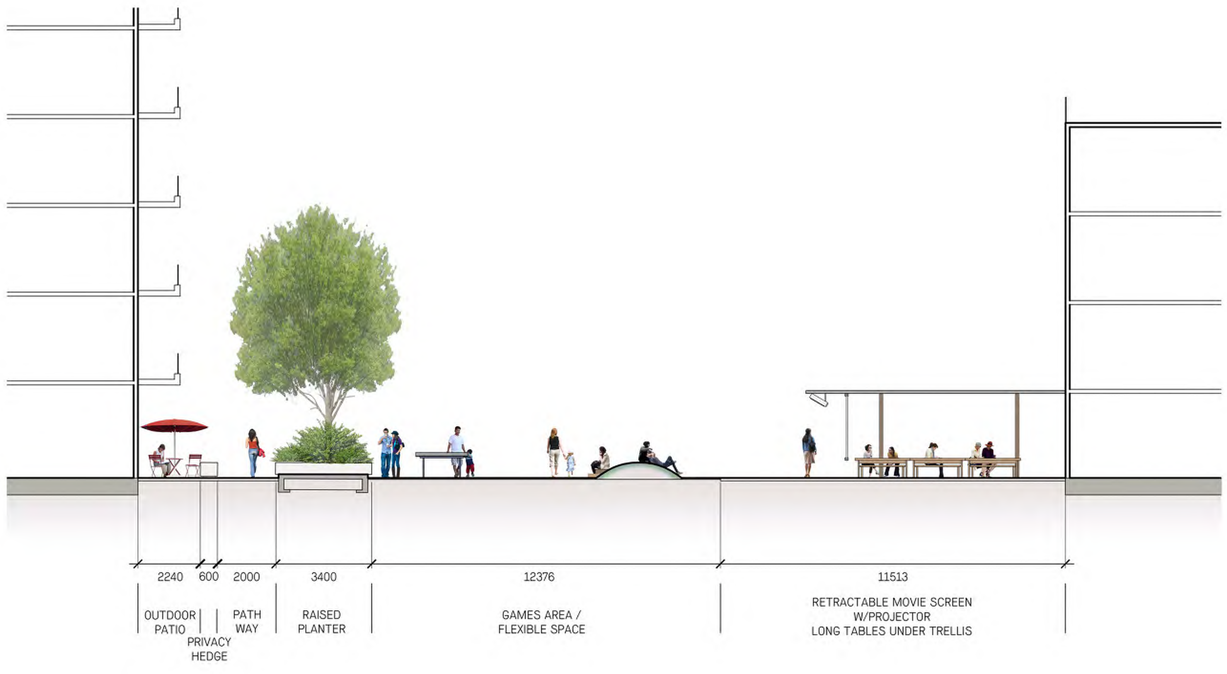

4 L2.11 LEVEL 2 AMENITY
1:100

HAPA COLLABORATIVE
Landscape Architecture
Urban Design
403 - 375 West Fifth Avenue
Vancouver BC, V5Y 1J6
604 909 4150
hapacobo.com

Information on this Record Drawing regarding the locations of landscape architectural features is based on the IFC drawings, Change Orders and Site Instructions issued after the issuance of the IFC drawings, and on information provided by the Contractor. This drawing is intended for general guidance only; no guarantee is given of its accuracy.

No.	Description	Date
1	Issued for DP	Nov 6/20
1	Issued for DP	May 22/20

Copyright Reserved. This drawing is and remains at all times the exclusive property of Hapa Collaborative and cannot be used modified or copied without the expressed written consent of the landscape architect.

Harris Green Village
1045 Yates Street
Victoria, BC

Sections
Ground Level & Level 2

Date	May. 22/20	Drawing Number	
Project No.	1932		L2.11
Scale	1:100		
Drawn|Checked	kw | gc | JF		

NOTES:

1. REFER TO SPECIFICATION FOR GENERAL CONDITIONS;
2. CONSTRUCT ALL CONTROL JOINTS AT CONSISTENT WIDTH;
3. CUT JOINTS BEFORE RANDOM CRACKING OCCURS.

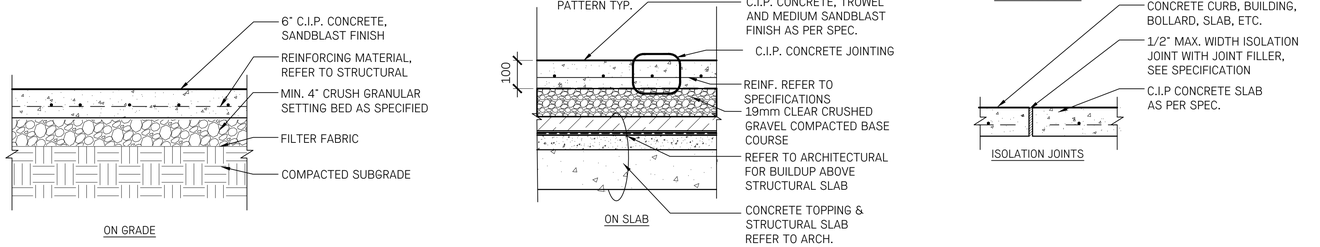

1 L2.10 **C.I.P. CONCRETE, TYP.**
1:10

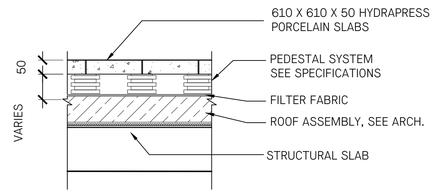

2 L2.10 **PAVING ON PEDESTALS**
1:10

NOTES:

1. REFER TO GRADING PLAN FOR TOP/BOTTOM OF STAIR ELEVATIONS;
2. REFER TO SPECIFICATIONS FOR CONCRETE FINISHES;
3. REFER TO STRUCTURAL FOR CONCRETE REINFORCEMENT.

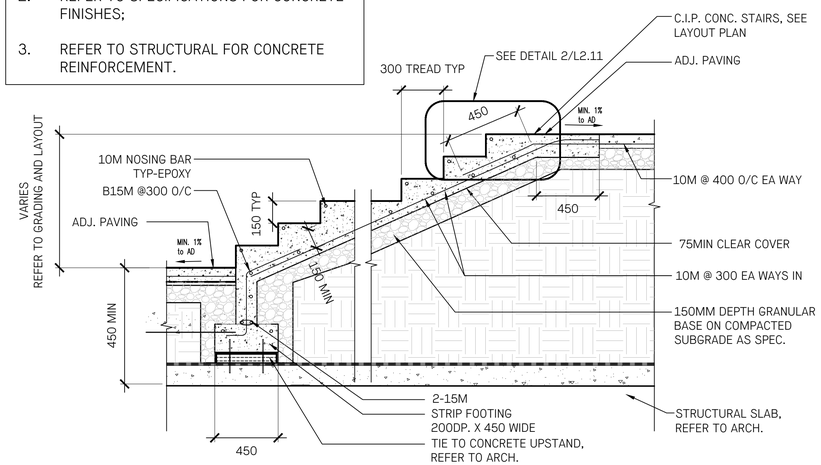

3 L2.10 **C.I.P. CONCRETE STAIRS, TYP.**
1:20

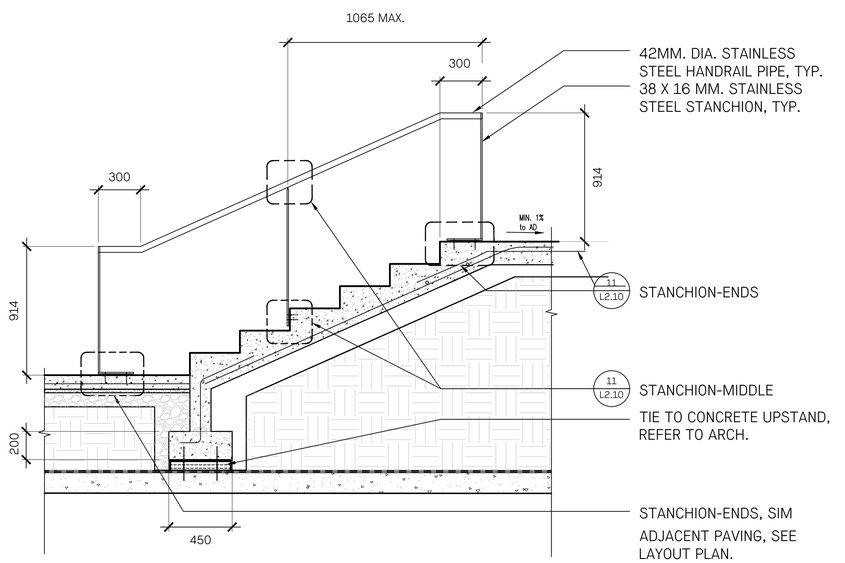

4 L2.10 **HANDRAIL, TYP.**
1:20

HAPA COLLABORATIVE
Landscape Architecture
Urban Design
604 909 4150
hapacollab.com
403 - 375 West Fifth Avenue
Vancouver BC, V5Y 1J6

No.	Description	Date
3	Issued for DP	Mar 1/2
1	Issued for DP	Nov 6/2(
1	Issued for DP	May 22/2(

Copyright Reserved. This drawing is and remains at all times the exclusive property of Hapa Collaborative and cannot be used modified or copied without the expressed written consent of the landscape architect.

Harris Green Village
1045 Yates Street
Victoria, BC

Details
Paving

Date	May. 22/20	Drawing Number
Project No.	1932	L3.11
Scale	As Shown	
Drawn|Checked	kw | gc | JF	

NOTE:
INSTALL AS PER MANUFACTURER.
PROVIDE SHOP DRAWING

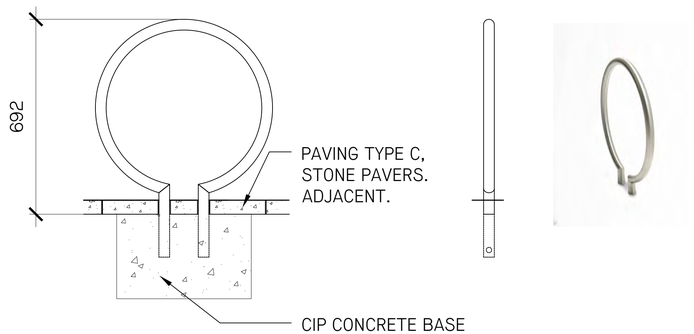

1 L2.11 RING BIKE RACK
NTS

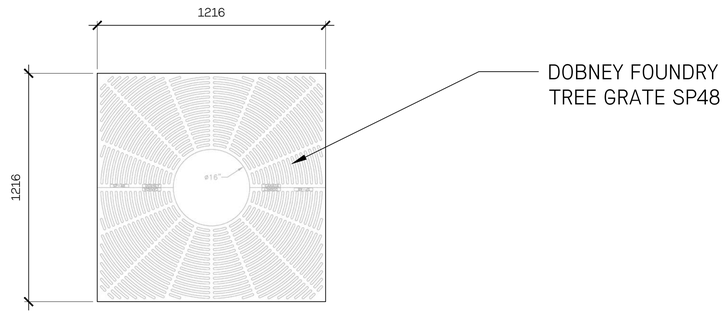

2 L2.11 TREE GRATE
1:15

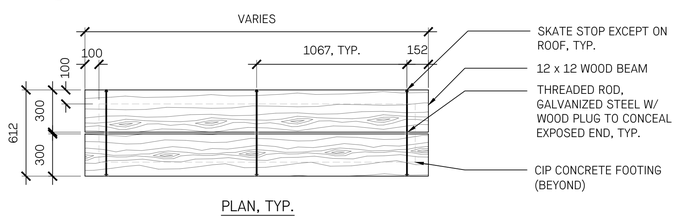

PLAN, TYP.

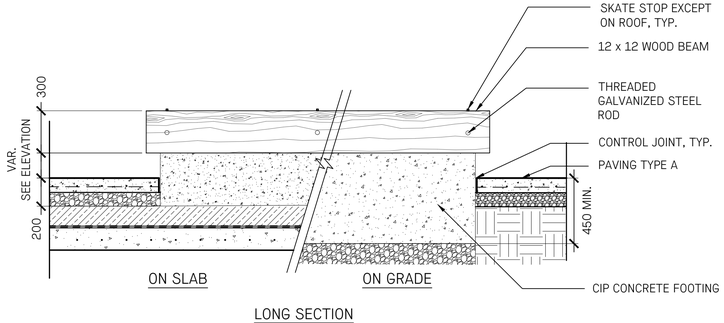

LONG SECTION

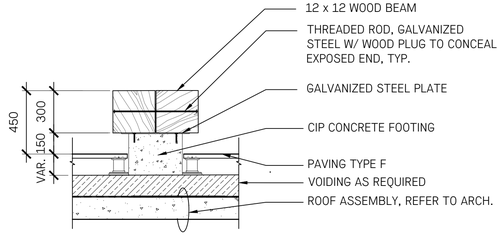

ON ROOF ASSEMBLY

SHORT SECTION

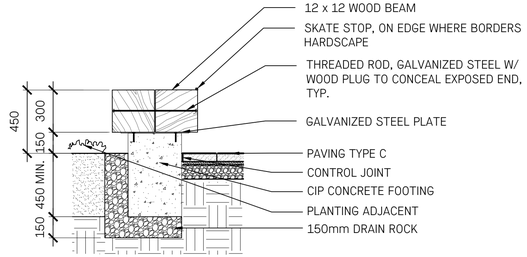

ON GRADE

SHORT SECTION

3 L2.11 CUSTOM WOOD BENCH TYPE I, TYP.
1:20

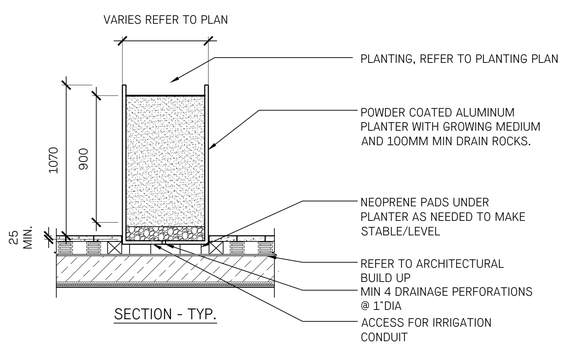

SECTION - TYP.

4 L2.11 METAL PLANTER, TYP.
1:20

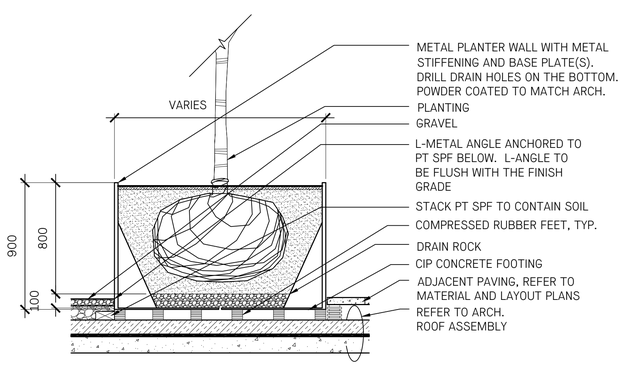

5 L2.11 METAL PLANTER - TREE
1:20

HAPA COLLABORATIVE
Landscape Architecture
Urban Design
403 - 375 West Fifth Avenue
Vancouver BC, V5Y 1J6
604 909 4150
hapacobo.com

No.	Description	Date
3	Issued for DP	Mar 1/21
1	Issued for DP	Nov 6/20
1	Issued for DP	May 22/20

Copyright Reserved. This drawing is and remains at all times the exclusive property of Hapa Collaborative and cannot be used modified or copied without the expressed written consent of the landscape architect.

Harris Green Village
1045 Yates Street
Victoria, BC

Details
Site Furnishings

Date	May. 22/20	Drawing Number	
Project No.	1932		L3.12
Scale	As Shown		
Drawn|Checked	kw | gc | JF		

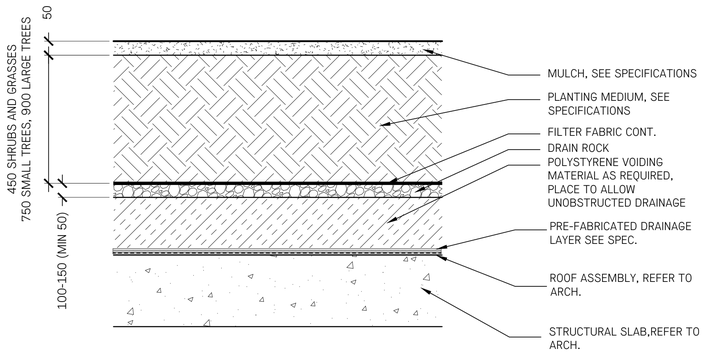

SHRUB AND TREE PLANTING ON SLAB

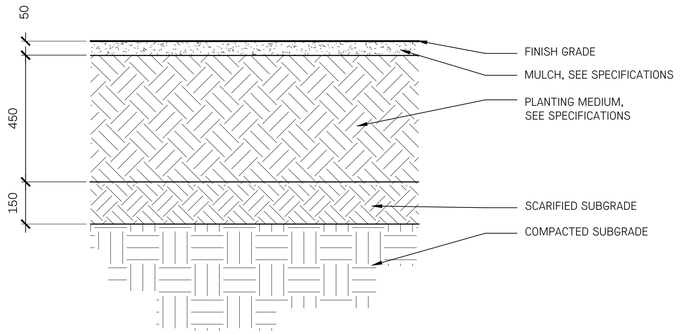

SHRUB PLANTING AREAS

1 L2.12 SOIL PROFILES
NTS

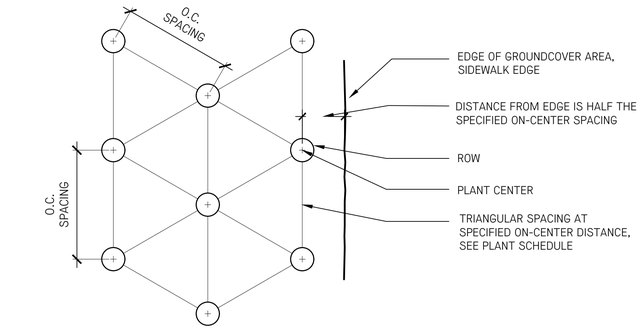

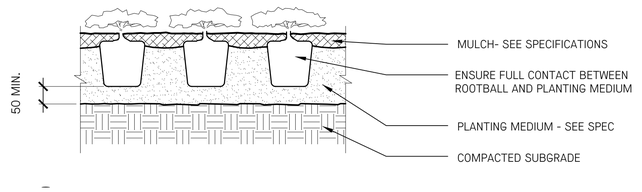

2 L2.11 GROUNDCOVER PLANTING
NTS

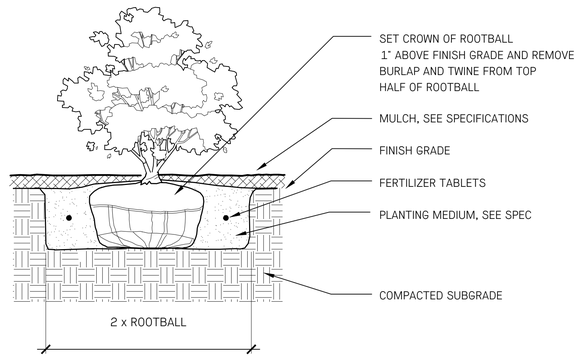

3 L2.11 SHRUB PLANTING
NTS

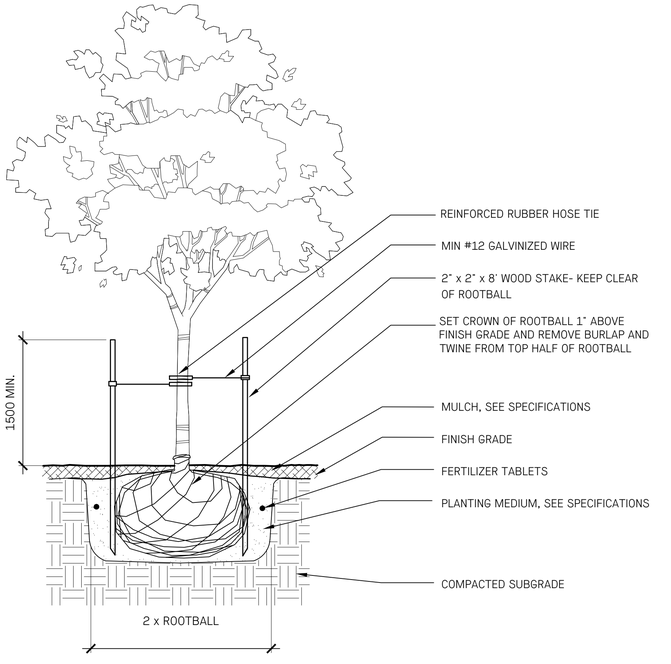

4 L2.11 TREE PLANTING - ON GRADE
NTS

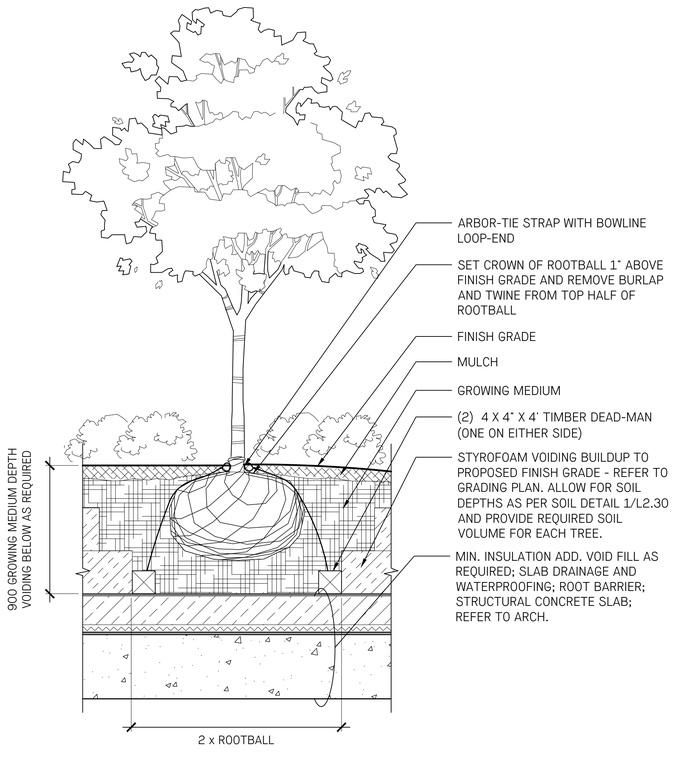

5 L2.11 TREE PLANTING - ON SLAB
NTS

CITY OF VICTORIA

SUPPLEMENTARY STANDARD DETAIL DRAWINGS

PREPARATION NOTES:

1. CONTAINER GROWN:
   REMOVE COMPLETELY FROM CONTAINER
2. BURLAP AND ROPE:
   REMOVE TOP ⅓ OF COVERING
3. WIRE AND BURLAP:
   REMOVE TOP ⅓ OF WIRE, ROPE AND BURLAP COVERING WITHOUT DAMAGING ROOTBALL. REMOVE ALL TWINE.

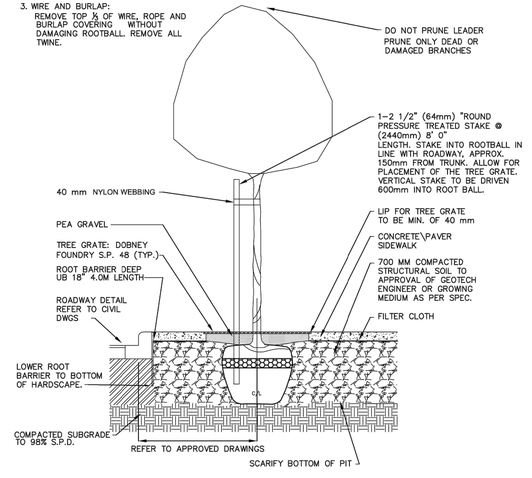

NOTES:
ALL TREES SHALL MEET OR EXCEED THE CITY OF VICTORIA TREE SPECIFICATIONS

2011

TREE PLANTING IN SIDEWALK	REVISIONS	DRAWING NUMBER: SD P5

6 L1.41 OFFSITE TREE PLANTING - CITY OF VICTORIA STANDARD
NTS

HAPA COLLABORATIVE
Landscape Architecture
Urban Design
403 - 375 West Fifth Avenue
Vancouver BC, V5Y 1J6
604 909 4150
hapacobo.com

No.	Description	Date
3	Issued for DP	Mar 1/2
1	Issued for DP	Nov 6/2
1	Issued for DP	May 22/2

Copyright Reserved. This drawing is and remains at all times the exclusive property of Hapa Collaborative and cannot be used modified or copied without the expressed written consent of the landscape architect.

Harris Green Village
1045 Yates Street
Victoria, BC

Details
Planting

Date	May. 22/20	Drawing Number	
Project No.	1932		L3.13
Scale	As Shown		
Drawn|Checked	kw | gc | JF		

LEGEND

EXISTING	PROPOSED	DESCRIPTION
		EDGE OF PAVEMENT
CURB		CURB AND GUTTER
		EDGE OF GRAVEL
TB/BB		TOP/BOTTOM OF BANK
CB		CATCH BASIN
WV		WATER VALVE
FH		FIRE HYDRANT
		CAPPED END
		UTILITY POLE AND STREET LIGHT (LABELLED PP,TP,PP/LS ETC.)
MH		MANHOLE
CO		CLEANOUT
SSIC/SDIC	SSIC/SDIC	SANITARY/STORM INSPECTION CHAMBER (200ø RISER)
JB		JUNCTION BOX
AR	AR	AIR VALVE
WM	WM	WATER METER

EXISTING	PROPOSED	DESCRIPTION
		REDUCER
		FENCE
		DITCH/SWALE
WM	WM	WATERMAIN (SIZE AND MATERIAL NOTED)
SS	SS	SANITARY SEWER (SIZE AND MATERIAL NOTED)
SD	SD	STORM DRAIN (SIZE AND MATERIAL NOTED)
UT	UT	UNDERGROUND TELEPHONE
UH	UH	UNDERGROUND HYDRO
	IRR	IRRIGATION SLEEVES
⊙		MONUMENT
		PROPERTY LINE
	5+100 5+110	CENTERLINE AND STATIONING
		SANITARY SEWER SERVICE CONNECTION AT MAIN
+32.75	(43.170)+	ELEVATIONS
		PAVEMENT REMOVAL
		NEW ASPHALT

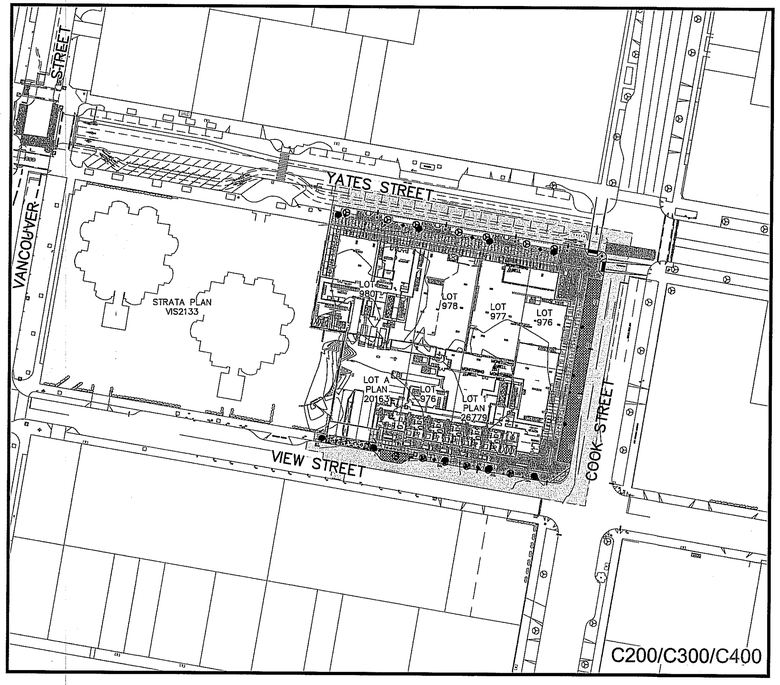

KEY PLAN
1:1000

1:1000 0 20 60m

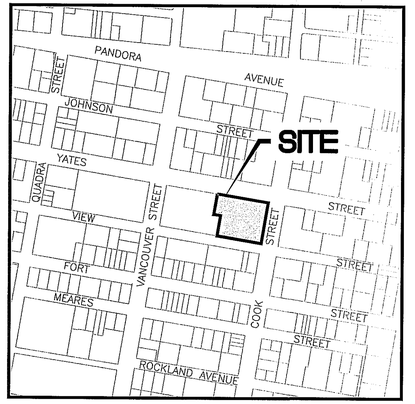

LOCATION PLAN
NTS

LIST OF DRAWINGS

DWG No.	DESCRIPTION
C100	GENERAL NOTES, LOCATION PLAN, KEY PLAN, DRAWINGS LIST & LEGEND
C200	SITE SERVICING PLAN
C300	SURFACE WORKS AND GRADING PLAN
#46 C301	MISCELLANEOUS CITY OF VICTORIA DETAILS
C400	BC HYDRO INFORMATION PLAN - TO FOLLOW

CIVIC ADDRESS:	1045 YATES STREET
LEGAL:	LOT A, OF LOTS 785, 786 AND 787, VICTORIA CITY, PLAN 36505.
ZONING:	S-1
PROPOSED ZONE:	CD
LAND USE:	RESIDENTIAL
PROPOSED:	510 UNIT 19 STOREY RESIDENTIAL BUILDING
SITE AREA:	6337m²
DWELLING FOOTPRINT AREA:	5328m²
MAIN FLOOR ELEVATION:	17.60m

PLAN TO ACCOMPANY DEVELOPMENT PERMIT APPLICATION

GENERAL NOTES:

1. ALL WORK AND MATERIALS ARE TO BE IN ACCORDANCE WITH THE CITY OF VICTORIA (CoV) SPECIFICATIONS, ITS SUPPLEMENTARY MASTER MUNICIPAL SPECIFICATIONS, STANDARD DETAIL DRAWINGS AND MMCD UNLESS OTHERWISE NOTED. IF A CONFLICT BETWEEN SPECIFICATIONS ARISES, THE MOST STRINGENT SHALL APPLY.
2. THE ENGINEER SHALL BE NOTIFIED 48 HOURS PRIOR TO COMMENCEMENT OF WORK.
3. SIGNATURE BLOCK FOR SHALLOW UTILITIES TO BE SIGNED AND DATED PRIOR TO CONSTRUCTION.
4. PERMITS TO CONSTRUCT WORKS ON THE CoV RIGHT OF WAY MUST BE OBTAINED FROM THE CoV ENGINEERING DEPARTMENT PRIOR TO COMMENCING WORK. PERMITS MUST BE ON SITE FOR REVIEW AS REQUIRED.
5. CONFIRM LOCATION AND ELEVATION OF ALL EXISTING UTILITIES AT ALL CROSSINGS AND CONNECTIONS AND REPORT ANY DISCREPANCIES TO THE ENGINEER PRIOR TO CONSTRUCTION.
6. CONFIRM THAT ELEVATION, LOCATION AND GRADIENT OF ASPHALT MATCH EXISTING PRIOR TO PLACEMENT OF ASPHALT OR CONCRETE.
7. ALL TREES NOT BEING REMOVED IN THE CONSTRUCTION AREA SHALL BE PROTECTED. CARE TO BE TAKEN TO RETAIN AS MANY TREES AS POSSIBLE.
8. ADJUST ALL MANHOLES, WATER VALVES, HYDRO VAULTS, ETC. TO MATCH NEW CONSTRUCTION.
9. ALL LOCATIONS AND ELEVATIONS OF EXISTING UTILITIES SHOWN ARE APPROXIMATE ONLY AND SHOULD BE CONFIRMED BY USE OF A PIPE LOCATOR AND MANUAL DIGGING. ALL OR ANY STRUCTURES NOT NECESSARILY SHOWN.
5. ALL EXCAVATED TRENCH AND SUBEXCAVATION MATERIALS TO BE DISPOSED OF OFFSITE.
6. ALL ELEVATIONS ARE BASED ON GEODETIC DATUM CVD28BC AND DERIVED FROM OCM 16-147.
7. DATA SOURCES:
   - TOPOGRAPHIC SURVEY COMPLETED BY WEY MAYENBURG LAND SURVEYORS INC., JULY 2019.
   - DIGITAL GIS PROVIDED BY CoV.
   - BC 1 CALL DATA FOR SHALLOW UTILITIES.

ROAD NOTES:

1. CONSTRUCT ALL SIDEWALK AND DRIVEWAY CROSSINGS IN ACCORDANCE WITH CoV AND MMCD STANDARDS AS NOTED ON DRAWINGS.
2. MAINTAIN VEHICULAR AND PEDESTRIAN ACCESS ALONG YATES, COOK AND VIEW STREETS DURING CONSTRUCTION.
3. ROAD RESTORATION FOR VIEW STREET TO CoV SUPPLEMENTAL DWG. No. SD G5a AND G5b.
4. THE PROVISION OF APPROVED SIGNS AND CERTIFIED TRAFFIC CONTROL PERSONNEL IS THE CONTRACTOR'S SOLE RESPONSIBILITY.
5. ALL PAVEMENT EXCAVATIONS TO BE SAWCUT.
6. PROJECT FRONTAGE TO BE RESTORED AS NOTED ON CIVIL, LANDSCAPE AND ARCHITECTURAL DRAWINGS AS PER CoV "NEW TOWN" SPECIFICATIONS.
7. PEDESTRIAN WALKING AREA TO BE DELINEATED DURING THE CONSTRUCTION OF THE WORKS AND MUST BE EASILY RECOGNIZABLE BY THE PUBLIC AND CONTAIN NO OBSTRUCTIONS TO MOBILITY SCOOTERS OR WHEELCHAIRS AND NO HAZARDOUS CONDITIONS. THE PUBLIC USING THESE AREAS MUST BE ADEQUATELY PROTECTED FROM TRAFFIC.

WATER NOTES:

1. WATER SERVICE CONNECTION TO BE PER CoV STD. DWG. No. W2d SS.
2. CONTRACTOR TO CONFIRM THAT EXISTING WATER SERVICES HAVE BEEN CAPPED BY CONTRACTOR/DEVELOPER AND INSPECTED BY CoV PLUMBING DEPARTMENT AT DEVELOPER'S EXPENSE.

STORM DRAIN AND SANITARY SEWER NOTES:

1. CONTRACTOR TO CONFIRM THAT EXISTING SANITARY AND STORM DRAIN SERVICES HAVE BEEN CAPPED BY CONTACTOR/DEVELOPER AND INSPECTED BY CoV PLUMBING DEPARTMENT AT DEVELOPER'S EXPENSE.
2. STORM DRAIN AND SANITARY SEWER CONNECTIONS TO BE AS PER CoV STD. DWG. No. S7 SS.
3. STORM DRAIN CONNECTION TO BE 150ø PVC SDR28 AT A MINIMUM GRADE OF 2.00%.
4. SANITARY SEWER CONNECTION TO BE 200ø PVC SDR28 AT A MINIMUM GRADE OF 2.00%.
5. UNDERGROUND SERVICES TO BE LOCATED, EXPOSED AND ELEVATIONS CONFIRMED AT CROSSINGS PRIOR TO INSTALLATION OF CONNECTIONS.

SHALLOW UTILITY AND STREET LIGHT NOTES:

1. EXISTING BC HYDRO, TELUS, SHAW CABLE AND FORTIS BC INFRASTRUCTURE INFORMATION SHOWN ON DRAWINGS IS SCHEMATIC AND FOR INFORMATION ONLY.
2. REFER TO UTILITY COMPANY DESIGN DRAWINGS FOR CONSTRUCTION DETAILS. CONSTRUCT UNDERGROUND UTILITIES AS SPECIFIED AND IN ACCORDANCE WITH BC HYDRO, TELUS, SHAW CABLE SPECIFICATIONS AND DRAWINGS.
3. CONFIRM AND COORDINATE WITH CoV FORCES REINSTATEMENT OF LAMP STANDARDS AS PER CoV SUPPLEMENTARY STANDARD DETAIL DRAWINGS, INCLUDING BASES, CONDUIT AND JUNCTION BOX.
4. CONTACT BC 1 CALL AT 1-800-474-6886 A MINIMUM OF 48 HOURS PRIOR TO CONSTRICTION.
5. CONTACT BC HYDRO, TELUS, SHAW CABLE AND FORTIS BC 48 HOURS PRIOR TO THE START OF ANY EXCAVATION.
6. BC HYDRO TO COORDINATE AND PROVIDE LIAISON WITH CoV PRIOR TO AND DURING CONSTRUCTION.

ISSUES

No.	DATE YYYY.MM.DD	ISSUED FOR
1	2020.05.22	DEVELOPMENT PERMIT
2	2020.11.23	DEVELOPMENT PERMIT RESUBMISSION
3	2021.03.08	DEVELOPMENT PERMIT RESUBMISSION

CLIENT

ISSUED FOR DEVELOPMENT PERMIT

HARRIS GREEN VILLAGE
1045 YATES STREET
VICTORIA, BC

STARLIGHT DEVELOPMENTS LTD.

HEROLD ENGINEERING
1051 Vancouver St, Victoria, BC V8V 4T6
Tel: 250-590-4875 Fax: 250-590-4392
Email: mail@heroldengineering.com

©Copyright reserved. This drawing remains the exclusive property of Herold Engineering Limited and may not be reused or reproduced without written consent of Herold Engineering Limited.

GENERAL NOTES, LOCATION PLAN, KEY PLAN, DRAWINGS LIST & LEGEND

DESIGNED SAC	ENGINEER'S SEAL
DESIGN REVIEW JR	
DRAFTED LM	
DRAFTING REVIEW SAC	
PROJECT No. 5168-001	CLIENT DRAWING No.
SCALE H: AS NOTED V: --	PERMIT No.
HEL DRAWING No. C100	1 OF 5 REVISION 3

DESTROY ALL DRAWINGS SHOWING PREVIOUS REVISION

IDP

File: J:\Projects\5168-001 Harris Green Development\04C Drawings\5168-001 HGV 1000 Block-civil.dwg Plot Time: Mar. 8, 21 1:58 PM User: Sarah Campden

NOTES:

1. FOR GENERAL NOTES SEE SHEET C100.
2. FOR SURFACE WORKS AND GRADING PLAN SEE SHEET C300.
3. SEE ELECTRICAL DESIGN DRAWINGS FOR ELECTRICAL DETAILS.
4. SEE LANDSCAPE DESIGN DRAWINGS FOR LANDSCAPE DETAILS.
5. SEE MECHANICAL DESIGN DRAWINGS FOR CONNECTION DETAILS.
6. ALL EXISTING SANITARY, DRAIN AND WATER LOCATIONS TO BE CONFIRMED IN THE FIELD PRIOR TO CONSTRUCTION.
7. CONTRACTOR TO CONFIRM THAT ALL EXISTING SANITARY AND STORM DRAIN SERVICES HAVE BEEN CAPPED AND REMOVED BY DEVELOPER AND INSPECTED BY CoV PLUMBING DEPARTMENT AT DEVELOPER'S EXPENSE (TYP. 3 EXISTING CONNECTIONS)
8. FOR SHALLOW UTILITIES DESIGN, SEE INDIVIDUAL UTILITY DESIGN DRAWINGS.
9. CONTRACTOR TO CONFIRM THAT SANITARY AND STORM DRAIN SERVICES HAVE BEEN CAPPED ON-SITE AND INSPECTED BY CoV FORCES.
10. BC HYDRO INFRASTRUCTURE TO PROVIDE BOTH TEMPORARY AND POST CONSTRUCTION SERVICES. TEMPORARY UNDERGROUND INFRASTRUCTURE TO REMAIN ABANDONED IN PLACE. SEE BC HYDRO DETAILED DESIGN DRAWINGS XXX-XXX-XXXXX FOR DETAILS.

UNDERGROUND SERVICE INFORMATION

INFORMATION IS AT PROPERTY LINE	STORM DRAIN		SANITARY SEWER	
EXISTING DEPTH (m)				
PROPOSED DEPTH (m)				
PROPOSED INVERT ELEVATION (m)				
MAXIMUM DEPTH REQUESTED	YES	NO	YES	NO

WORKS AND SERVICES CHECKLIST

		PLAN CHECKER	AUTHORIZED REPRESENTATIVE NAME	AUTHORIZED REPRESENTATIVE NAME	DATE
UTILITY	HYDRO ELECTRICAL COMPANY				
	TELEPHONE COMPANY				
	GAS COMPANY				
	CABLE COMPANY				
MUNICIPAL	UNDERGROUND SERVICES				
	TRAFFIC				
	HIGHWAYS				

SDMH 1
REPLACE EXISTING MANHOLE AS PER MMCD STD. DWG. No. S1 (TYP. 2)
E INV. ELEV.=XX.XXm
W INV. ELEV.=XX.XXm

EXISTING STORM DRAIN SERVICE TO BE RECAPPED AND REMOVED BY DEVELOPER AND INSPECTED BY CoV PLUMBING DEPARTMENT AT DEVELOPER'S EXPENSE

REINSTATE CATCH BASIN AS PER CoV STD. DWG. No. SD S11B
INV. ELEV.=XX.XXm

FUTURE CITY OF VICTORIA CYCLING INFRASTRUCTURE. BY OTHERS

EXISTING WATER SERVICE TO BE CAPPED AND ABANDONED

REINSTATE CATCH BASIN AS PER CoV STD. DWG. No. SD S11B
INV. ELEV.=XX.XXm

SDMH 2
W INV. ELEV.=XX.XXm

19ø IRRIGATION SERVICE c/w BACKFLOW PREVENTER BY CoV FORCES AT DEVELOPER'S EXPENSE. DEPTH TO BE CONFIRMED WITH CoV FORCES

EXISTING WATER SERVICE TO BE CAPPED AND ABANDONED

EXISTING WATER SERVICE TO BE CAPPED AND ABANDONED

EXISTING IRRIGATION SERVICE TO BE CAPPED AND ABANDONED. EXISTING GATE VALVES TO BE REMOVED.

FIRE/DOMESTIC WATER SERVICE TO PROPERTY LINE AND METER VAULT c/w WATER METER AS PER CoV STD. DWG. No. SD W2j & SD W2f. TO BE INSTALLED BY CoV FORCES AT DEVELOPER'S EXPENSE. SIZES TO BE DETERMINED

REINSTATE CATCH BASIN AS PER CoV STD. DWG. No. SD S11b
INV. ELEV.=XX.XXm

19ø IRRIGATION SERVICE c/w BACKFLOW PREVENTER BY CoV FORCES AT DEVELOPER'S EXPENSE. DEPTH TO BE CONFIRMED WITH CoV FORCES

100ø PVC IRRIGATION SLEEVES (TYP.)

CONTRACTOR TO CONFIRM THAT ALL EXISTING SANITARY AND STORM DRAIN SERVICE HAVE BEEN CAPPED AND REMOVED BY DEVELOPER AND INSPECTED BY CoV PLUMBING DEPARTMENT AT DEVELOPER'S EXPENSE

FIRE HYDRANT INSTALLATION MMCD. DWG. No. W4 TO BE INSTALLED BY CoV FORCES AT DEVELOPER'S EXPENSE

REINSTATE CATCH BASIN AS PER CoV STD. DWG. NO. SD S11B
INV. ELEV.=XX.XXm

REINSTATE CATCH BASIN AS PER CoV STD. DWG. No. SD S11B
INV. ELEV.=XX.XXm

CoV FORCES TO INSTALL PVC SANITARY SERVICE IN COMMON TRENCH c/w INSPECTION CHAMBER AT DEVELOPER'S EXPENSE. SIZE TO BE DETERMINED

CoV FORCES TO INSTALL PVC STORM SERVICE IN COMMON TRENCH c/w INSPECTION CHAMBER AT DEVELOPER'S EXPENSE. SIZE TO BE DETERMINED

PROPOSED PARKING LEVEL OUTLINE

PROPERTY LINE

PROPOSED MAIN FLOOR ELEVATION=17.60m

1045 YATES STREET
LOT A, OF LOTS 785, 786 AND 787, VICTORIA CITY, PLAN 36505.

1045 YATES STREET
HARRIS DODGE DEALERSHIP

YATES STREET

VIEW STREET

COOK STREET

1039 VIEW STREET

1011 COOK STREET

RETAINING WALL

6.00m DRAIN
5.00m SANITARY

8.83m TREE TO IRRIGATION

1.50m FIRE HYDRANT

ISSUES		
No.	DATE mm/dd/yr	ISSUED FOR
1	2020.05.22	DEVELOPMENT PERMIT
2	2020.11.23	DEVELOPMENT PERMIT RESUBMISSION
3	2021.03.08	DEVELOPMENT PERMIT RESUBMISSION

CLIENT

ISSUED FOR DEVELOPMENT PERMIT

1:200 (0, 4, 12)

HARRIS GREEN VILLAGE
1045 YATES STREET
VICTORIA, BC
STARLIGHT DEVELOPMENTS LTD.

HEROLD ENGINEERING
1051 Vancouver St, Victoria, BC V8V 4T6
Tel: 250-590-4875 Fax: 250-590-4392
Email: mail@heroldengineering.com

©Copyright reserved. This drawing remains the exclusive property of Herold Engineering Limited and may not be reused or reproduced without written consent of Herold Engineering Limited.

SITE SERVICING PLAN

DESIGNED SAC	ENGINEER'S SEAL
DESIGN REVIEW JR	
DRAFTED LM	
DRAFTING REVIEW SAC	
PROJECT No. 5168-001	CLIENT DRAWING No.
SCALE H: AS NOTED V: —	PERMIT No.
HEL DRAWING No. C200 2 OF 5	REVISION 3

DESTROY ALL DRAWINGS SHOWING PREVIOUS REVISION

Files: J:\Projects\5168-001 Harris Green Development\04C Drawings\5168-001 HGV 1000 Block-civil.dwg Plot Time: Mar. 8, 21 1:58 PM User: Sarah Campden

NOTES:

1. FOR GENERAL NOTES SEE SHEET C100.
2. FOR SITE SERVICING SEE SHEET C200.
3. SEE ELECTRICAL DESIGN DRAWINGS FOR ELECTRICAL DETAILS.
4. SEE LANDSCAPE DESIGN DRAWINGS FOR LANDSCAPE DETAILS.
5. SEE MECHANICAL DESIGN DRAWINGS FOR CONNECTION DETAILS.
6. ALL EXISTING SANITARY, DRAIN AND WATER LOCATIONS TO BE CONFIRMED IN THE FIELD PRIOR TO CONSTRUCTION.
7. CONTRACTOR TO CONFIRM THAT ALL EXISTING SANITARY AND STORM DRAIN SERVICES HAVE BEEN CAPPED AND REMOVED BY DEVELOPER AND INSPECTED BY CoV PLUMBING DEPARTMENT AT DEVELOPER'S EXPENSE (TYP. 3 EXISTING CONNECTIONS)
8. FOR SHALLOW UTILITIES DESIGN, SEE INDIVIDUAL UTILITY DESIGN DRAWINGS.
9. CONTRACTOR TO CONFIRM THAT SANITARY AND STORM DRAIN SERVICES HAVE BEEN CAPPED ON-SITE AND INSPECTED BY CoV-FORCES.
10. BC HYDRO INFRASTRUCTURE TO PROVIDE BOTH TEMPORARY AND POST-CONSTRUCTION SERVICES. TEMPORARY UNDERGROUND INFRASTRUCTURE TO REMAIN ABANDONED IN PLACE. SEE BC HYDRO DETAILED DESIGN DRAWINGS XXX-XXX-XXXXX FOR DETAILS.

REINSTATE PAINT MARKINGS (TYP.)

#53 CLUSTER LAMPS, JUNCTION BOXES AND CONDUIT AS PER ELECTRICAL DESIGN DRAWINGS (TYP. 10)

EXISTING DRIVEWAY CROSSINGS TO BE REMOVED

#48 CURB CUTS FOR STORM WATER (TYP. YATES AND VIEW). SEE LANDSCAPE DESIGN DRAWINGS FOR DETAILS

CONCRETE REINSTATEMENT AS PER CoV "NEW TOWN" STREETSCAPE SPECIFICATIONS (TYP.). SEE LANDSCAPE DESIGN DRAWINGS FOR DETAILS

YATES STREET

FUTURE CITY OF VICTORIA CYCLING INFRASTRUCTURE. BY OTHERS

EXISTING DRIVEWAY CROSSING TO BE REMOVED

#51 #63 #64 DAVIT LIGHTS, JUNCTION BOXES AND CONDUIT AS PER ELECTRICAL DESIGN DRAWINGS (TYP. 12)

EXISTING DRIVEWAY CROSSING TO BE REMOVED

#66 PROVIDE SIDEWALK LETDOWN AT CORNER AS PER CoV "NEW TOWN" STREETSCAPE SPECIFICATIONS INCLUDING IN-SIDEWALK STREET SIGNAGE AS PER CoV STD DWG. No. C9MOD AND AS PER DETAILS ON SHEET C301

REMOVE EXISTING SIDEWALK. REPLACE ON BOTH YATES STREET AND VANCOUVER STREET FRONTAGES AS PER CoV "NEW TOWN" STREETSCAPE SPECIFICATIONS

#50

EXISTING TREE TO BE REMOVED (TYP.)

PARKING STALL NUMBER POSTS ON YATES STREET TO BE REMOVED (TYP. 7)

RAIN GARDEN AND TREES. SEE LANDSCAPE DRAWINGS FOR DETAILS (TYP.)

EXISTING CLUSTER LAMP TO BE REMOVED, STORED OFF-SITE, PAINTED BLACK AND REINSTATED c/w NEW JUNCTION BOX AND ELECTRICAL CONDUIT. SEE ELECTRICAL DESIGN FOR DETAILS (TYP.)

PROPOSED MAIN FLOOR ELEVATION=17.60m

1045 YATES STREET
LOT A, OF LOTS 785, 786 AND 787, VICTORIA CITY, PLAN 36505.

1045 YATES STREET
HARRIS DODGE DEALERSHIP

BENCHES AND SURFACE TREATMENTS. SEE LANDSCAPE DESIGN DRAWINGS FOR DETAILS

REINSTATE PAINT MARKINGS (TYP.)

EXISTING DRIVEWAY CROSSINGS TO BE REMOVED

1020 VIEW STREET

PROPOSED PARKING LEVEL OUTLINE

PROPERTY LINE

INSTALL DRIVEWAY CROSSING AS PER CoV STD. DWG. No. SD C7b. FINISH TREATMENT TO MATCH "NEW TOWN" PATTERN, WITH THE EXCEPTION OF THE CONCRETE FLARES WHICH ARE TO BE BRUSHED CONCRETE. SEE ARCHITECTURAL AND LANDSCAPE DESIGN DRAWINGS FOR ON-SITE DETAILS

3.00m SIGHT TRIANGLE AS PER CoV HIGHWAY ACCESS BYLAW SCHEDULE C. TYPICAL BOTH SIDES OF DRIVEWAY

RELOCATE EXISTING PARKING STALL NUMBER POSTS (TYP. 2)

#72 #59 5.5%

#72 #59 20.7%

#72 #59 -3.0%

#72 #59 4.0%

RELOCATE UTILITY POLE

RELOCATE EXISTING PARKING METER PAY STATION

#49

REINSTATE PAINT MARKINGS (TYP.)

#48 #58 CURB CUTS FOR STORM WATER (TYP. YATES AND VIEW). SEE LANDSCAPE DESIGN DRAWINGS FOR DETAILS

#60 NEW BARRIER CURB AS PER MMCD STD. DWG. No. C5 (TYP.). CURB PLACEMENT AND STRUCTURE TO BE CONFIRMED WITH FORTIS BC GAS

VIEW STREET

REMOVE EXISTING SIDEWALK. REPLACE VIEW STREET FRONTAGES AS PER CoV "NEW TOWN" STREETSCAPE SPECIFICATIONS.

TREES. SEE LANDSCAPE DRAWINGS FOR DETAILS. (TYP.)

7 PARALLEL PARKING STALLS C/W RELOCATED PARKING STALL NUMBER POSTS (TYP.)

#66 PROVIDE SIDEWALK LETDOWN AT CORNER AS PER CoV "NEW TOWN" STREETSCAPE SPECIFICATIONS INCLUDING IN-SIDEWALK STREET SIGNAGE AS PER CoV STD DWG. No. C9MOD AND AS PER DETAIL ON SHEET C301

EXISTING UTILITY POLE TO BE RELOCATED AS PER BC HYDRO DESIGN. SEE BC HYDRO DESIGN DRAWINGS FOR DETAILS

#56 PAVEMENT RESTORATION AS PER CoV STD. DWG. No. SD G5a TO CENTRELINE OF YATES, COOK AND VIEW STREETS (TYP.)

#71 FUTURE LIGHTING FOR INTERSECTION WORKS (TYP. BY OTHERS)

1039 VIEW STREET

COOK STREET

1011 COOK STREET

EXISTING DRIVEWAY CROSSINGS TO BE REMOVED

REINSTATE GRASS BOULEVARD. SEE LANDSCAPE DESIGN DRAWINGS FOR DETAILS

BENCHES AND SURFACE TREATMENTS. SEE LANDSCAPE DESIGN DRAWINGS FOR DETAILS

ISSUES		
No.	DATE YYYY.MM.DD	ISSUED FOR
1	2020.05.22	DEVELOPMENT PERMIT
2	2020.11.23	DEVELOPMENT PERMIT RESUBMISSION
3	2021.03.08	DEVELOPMENT PERMIT RESUBMISSION

CLIENT

ISSUED FOR DEVELOPMENT PERMIT

1:200 0 4 12

HARRIS GREEN VILLAGE
1045 YATES STREET
VICTORIA, BC
STARLIGHT DEVELOPMENTS LTD.

HEROLD ENGINEERING
1051 Vancouver St, Victoria, BC V8V 4T6
Tel: 250-590-4875 Fax: 250-590-4392
Email: mail@heroldengineering.com

©Copyright reserved. This drawing remains the exclusive property of Herold Engineering Limited and may not be reused or reproduced without written consent of Herold Engineering Limited.

SURFACE WORKS AND GRADING PLAN

DESIGNED SAC	ENGINEER'S SEAL
DESIGN REVIEW JR	
DRAFTED LM	
DRAFTING REVIEW SAC	
PROJECT No. 5168-001	CLIENT DRAWING No.
SCALE H: AS NOTED V: —	PERMIT No.
HEL DRAWING No. C300 3 OF 5	REVISION 3

DESTROY ALL DRAWINGS SHOWING PREVIOUS REVISION

File: J:\Projects\5168-001 Harris Green Development\04C Drawings\5168-001 HGV 1000 Block-civil.dwg Plot Time: Mar. 8, 21 1:59 PM User: Sarah Campden

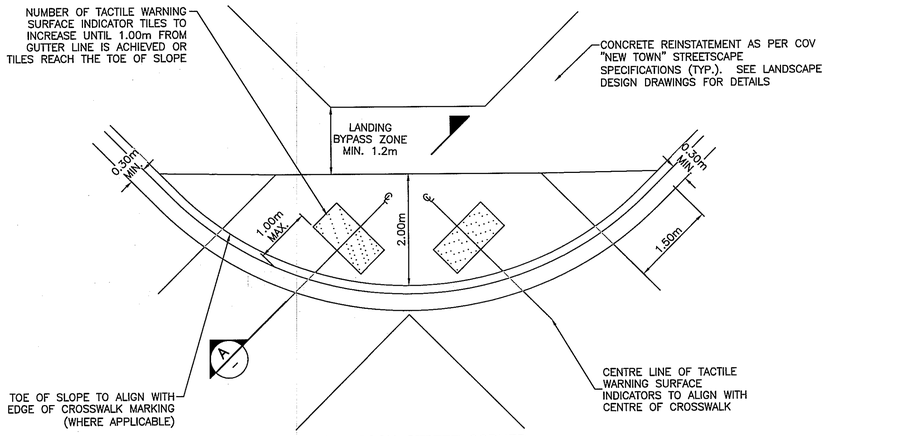

VIEW & COOK STREET CORNER
NTS

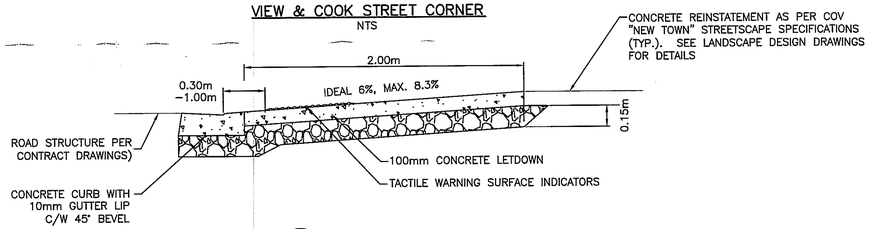

A SECTION
NTS

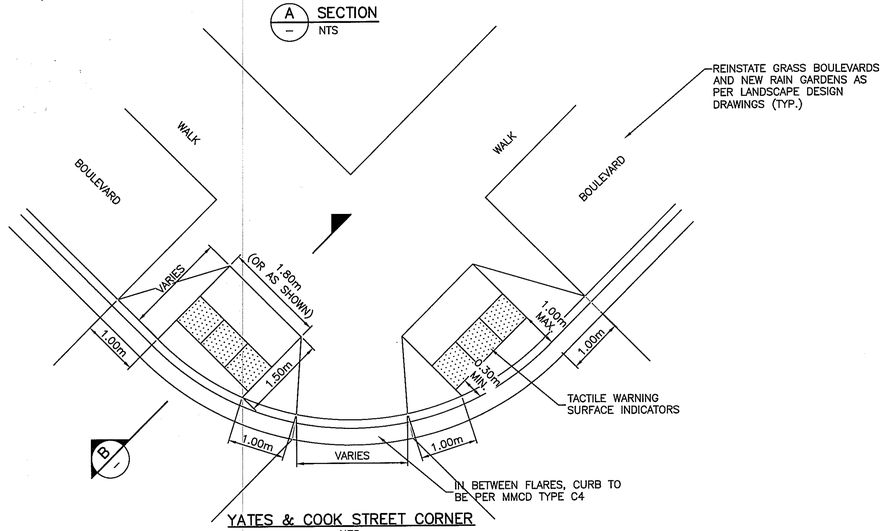

YATES & COOK STREET CORNER
NTS

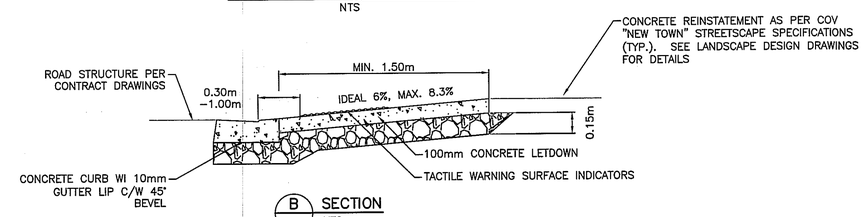

B SECTION
NTS

#46

ISSUES		
No.	DATE YYYY.MM.DD	ISSUED FOR
1	2020.05.22	DEVELOPMENT PERMIT
2	2020.11.23	DEVELOPMENT PERMIT RESUBMISSION
3	2021.03.08	DEVELOPMENT PERMIT RESUBMISSION

CLIENT

HARRIS GREEN VILLAGE
1045 YATES STREET
VICTORIA, BC
STARLIGHT DEVELOPMENTS LTD.

HEROLD ENGINEERING
1051 Vancouver St, Victoria, BC V8V 4T6
Tel: 250-590-4875 Fax: 250-590-4392
Email: mail@heroldengineering.com

©Copyright reserved. This drawing remains the exclusive property of Herold Engineering Limited and may not be reused or reproduced without written consent of Herold Engineering Limited.

MISCELLANEOUS DETAILS

DESIGNED SAC	ENGINEER'S SEAL
DESIGN REVIEW JR	
DRAFTED LM	
DRAFTING REVIEW SAC	
PROJECT No. 5168-001	CLIENT DRAWING No.
SCALE H: AS NOTED V: —	PERMIT No.
HEL DRAWING No. C301 4 of 5	REVISION 3

DESTROY ALL DRAWINGS SHOWING PREVIOUS REVISION

File: J:\Projects\5168-001 Harris Green Development\04C Drawings\5168-001 HGV 1000 Block-civil.dwg Plot Time: Mar. 8, 21 1:58 PM User: Sarah Campden